

Levels Table			
No.	Min. Level	Max. Level	Colour
1	0.300	0.500	
2	0.500	1.000	
3	1.000	1.250	




**AS
 CONSTRUCTED**

© COPYRIGHT. THE INFORMATION CONTAINED ON THIS DRAWING IS THE INTELLECTUAL PROPERTY OF TOMKINSON GROUP. COPYING OR USING THIS DRAWING IN WHOLE OR IN PART WITHOUT THE EXPRESS WRITTEN PERMISSION OF TOMKINSON GROUP INFRINGES COPYRIGHT

REV	REVISION	DES	DWG	CHK	DATE
A	AS SUBMITTED TO CLIENT	NB	RK	ME	8/11/16

tomkinson Group
 PROJECT MANAGERS DEVELOPMENT PLANNERS ISO 9001:2008
 LICENSED SURVEYORS CIVIL ENGINEERS FS520488
 FREECALL: 1800 810 170 TEL: (03) 5445 8700 FAX: (03) 5441 3648
 PO BOX 421, BENDIGO 3552 57 MYERS STREET, BENDIGO 3550
 WEB: www.tomkinson.com EMAIL: bendigo@tomkinson.com

Principal STRATHFIELDSAYE HOLDINGS PTY LTD

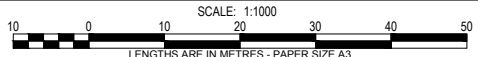

IMAGINE STAGE 6
 TERRAPEE LANE
 AS CONSTRUCTED FILL PLAN

Municipality & Ref:
 CITY OF
 GREATER BENDIGO
 DS/834/2012 & DS/791/2012
 SHT 1 of 1 REV A
 Drawing No.
 1065306F01

NOTE: THIS PLAN IS AN UNCONTROLLED DOCUMENT AND WILL NOT BE UPDATED. IT IS THE RESPONSIBILITY OF THE USER TO CONFIRM THAT THIS IS A CURRENT COPY AND SUITABLE FOR THE PROPOSED USE. THIS SHEET MUST BE READ IN CONJUNCTION WITH ALL SHEETS OF THIS SET AND ANY ACCOMPANYING DOCUMENTS. PLOT DATE: 08/11/2016 FILE: P:\JOB DATA\1065306F01\JOB DATA\1065306F01\DOCUMENTS\CONSTRUCTED FILL PLAN\HATCH.DWG