


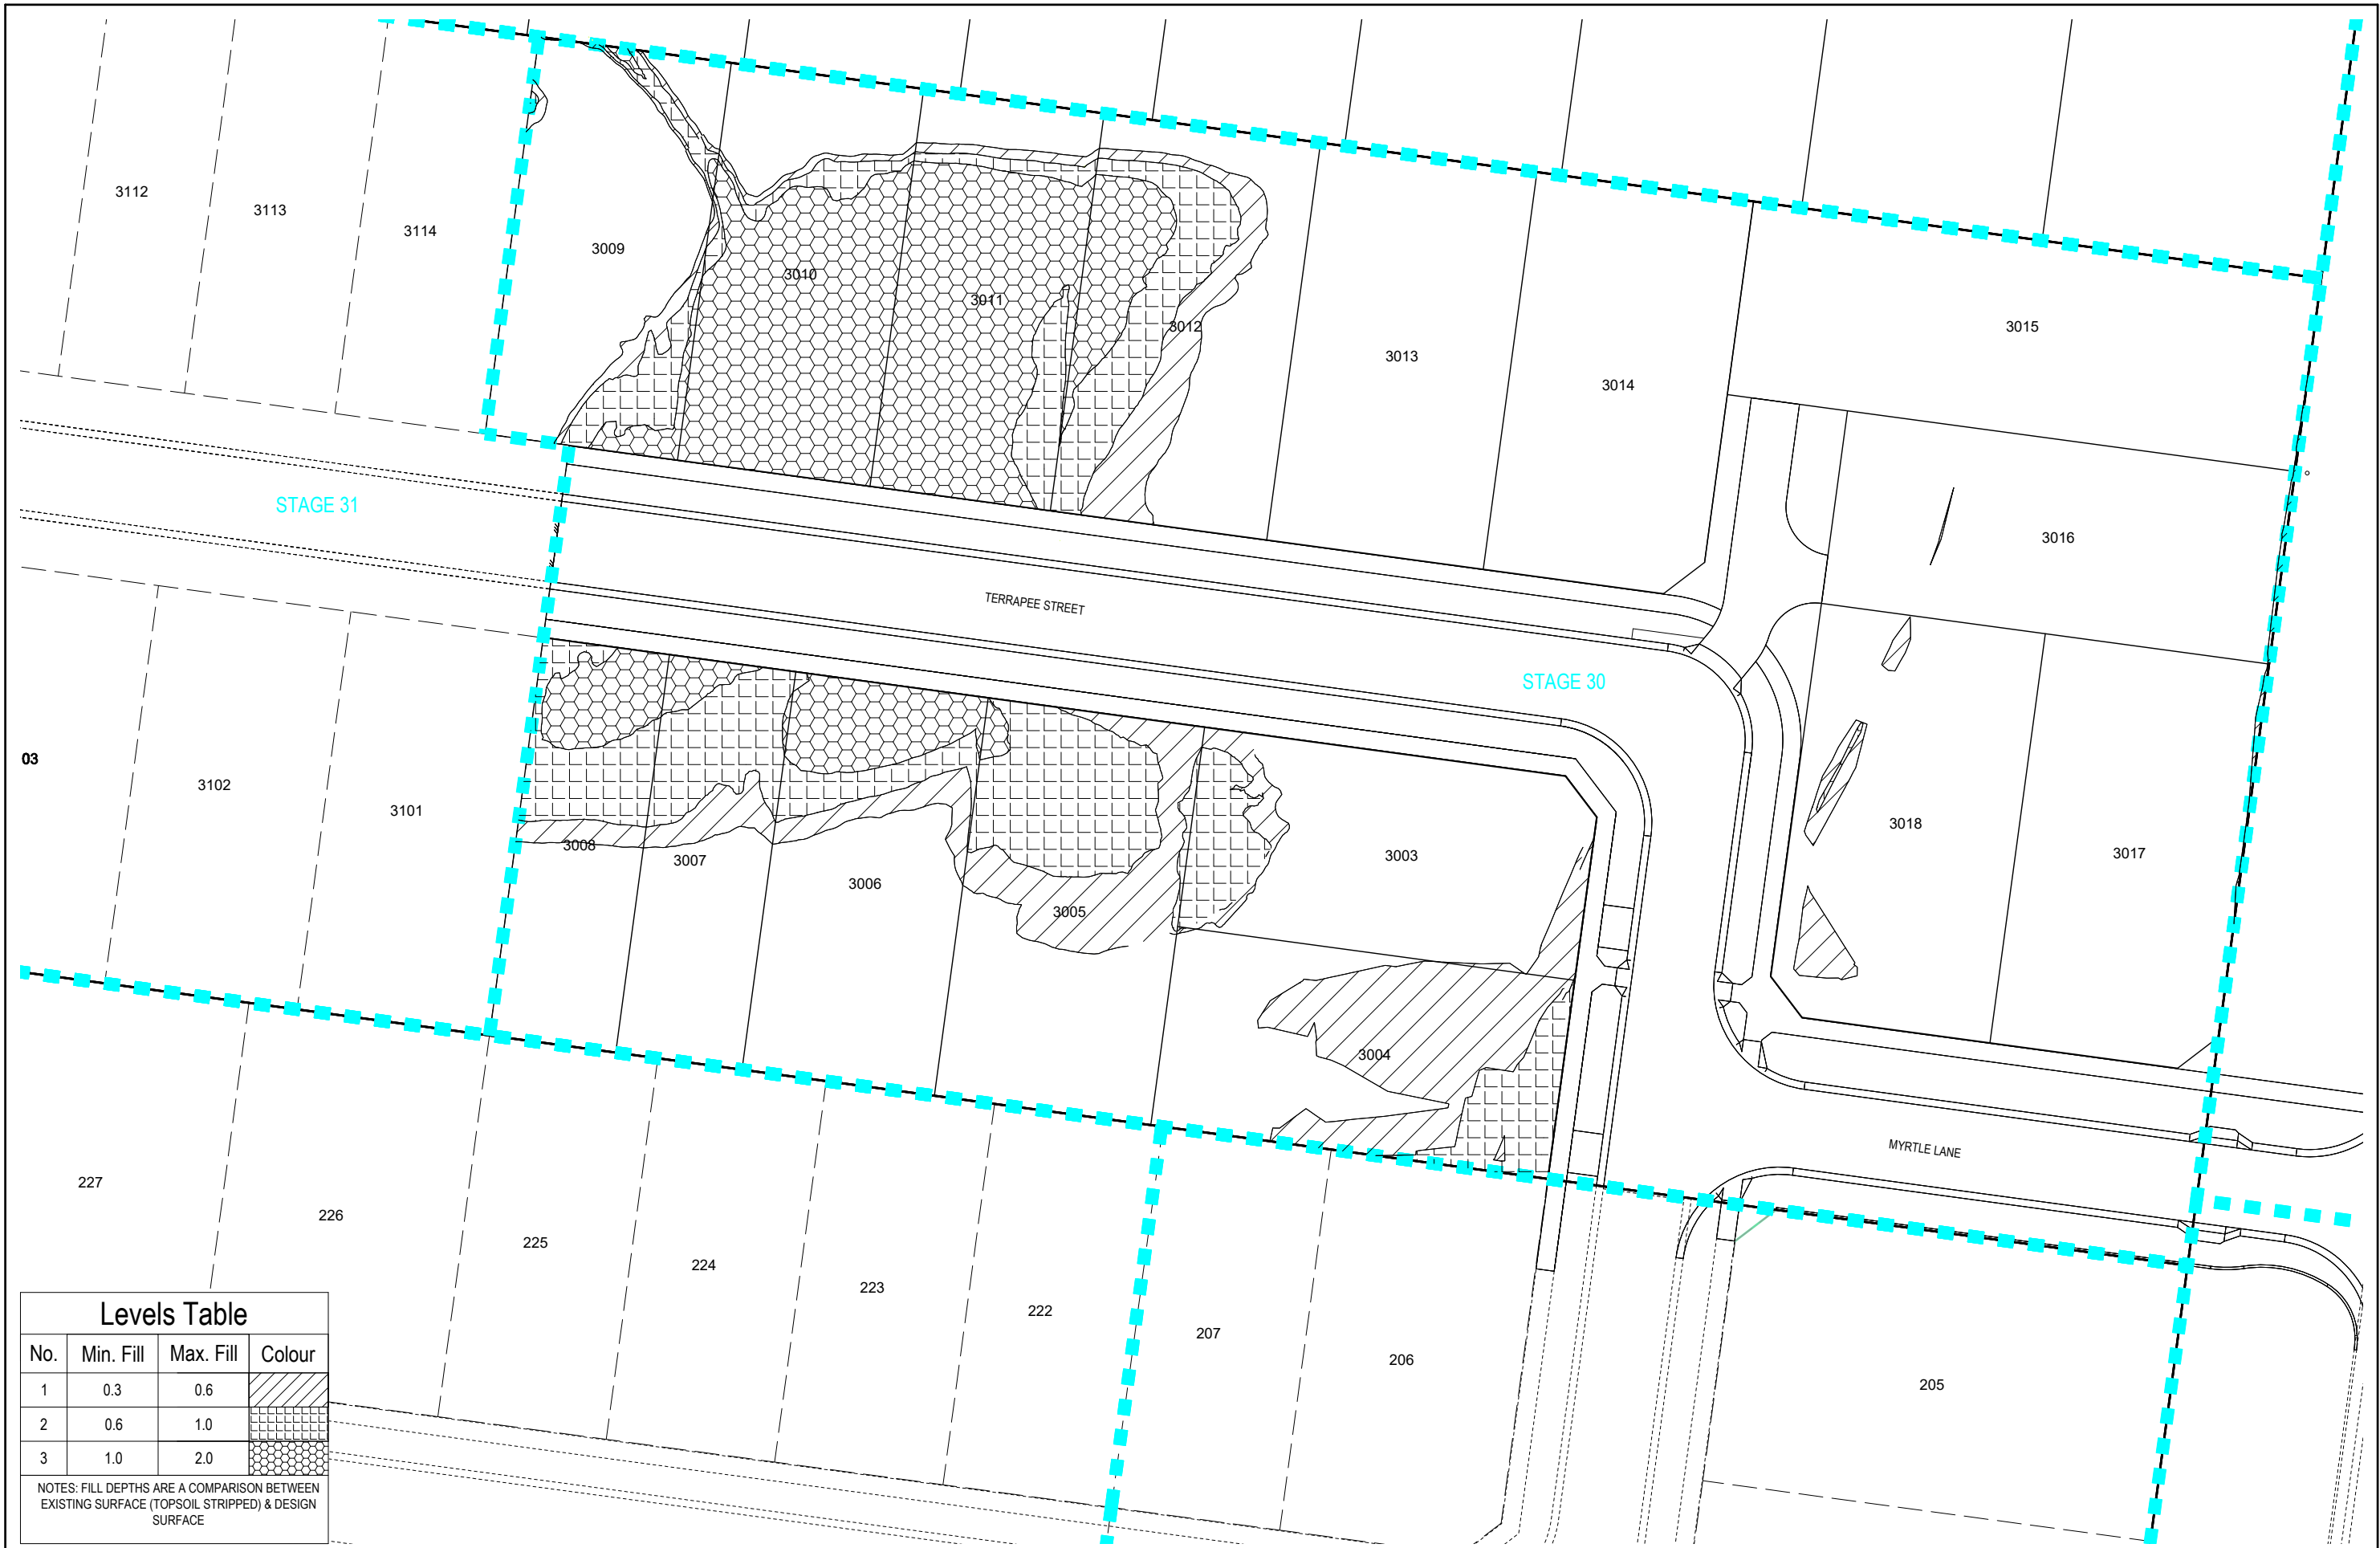

Levels Table			
No.	Min. Fill	Max. Fill	Colour
1	0.3	0.6	
2	0.6	1.0	
3	1.0	2.0	
NOTES: FILL DEPTHS ARE A COMPARISON BETWEEN EXISTING SURFACE (TOPSOIL STRIPPED) & DESIGN SURFACE			

AS SUBMITTED TO GTS

REV

BB HB

04/06/25

DES

DWG

CHK

AUTH

DATE

REVISION

RPE:-

SURVEY > ENGINEERING > PLANNING > PROJECT MANAGEMENT

HEAD OFFICE: 57 MYERS STREET BENDIGO PH 03 5445 8700
ABN 11 103 336 358 WWW.TOMKINSON.COM

STRATHFIELDSAYE

SCALE 1:500
LENGTHS ARE IN METRES - PAPER SIZE A3

IMAGINE STAGE 30
53 DUKES LANE STRATHFIELDSAYE
AS CONSTRUCTED FILL PLAN
CITY OF GREATER BENDIGO REF: DS/188/216
EMU CREEK HOLDINGS 2 PTY LTD

DWG STATUS:
AS CONSTRUCTED

PROJECT & DWG No:
1352030FP01 / 01

REV:
A

NOTE: THIS IS AN UNCONTROLLED DOCUMENT AND WILL NOT BE UPDATED. IT IS THE RESPONSIBILITY OF THE USER TO CONFIRM THAT THIS IS A CURRENT COPY AND SUITABLE FOR THE PROPOSED USE - THIS SHEET MUST BE READ IN CONJUNCTION WITH ALL SHEETS OF THIS SET AND ANY ACCOMPANYING DOCUMENTS

PLOT DATE: 04/06/2025 FILE: C:\USERS\BBROWN\BENDIGO\1352030\1352030 STG 30 AC FILL PLAN REV.DWG