


Alamora Estate Stage 8, Sayers Road, Tarneit

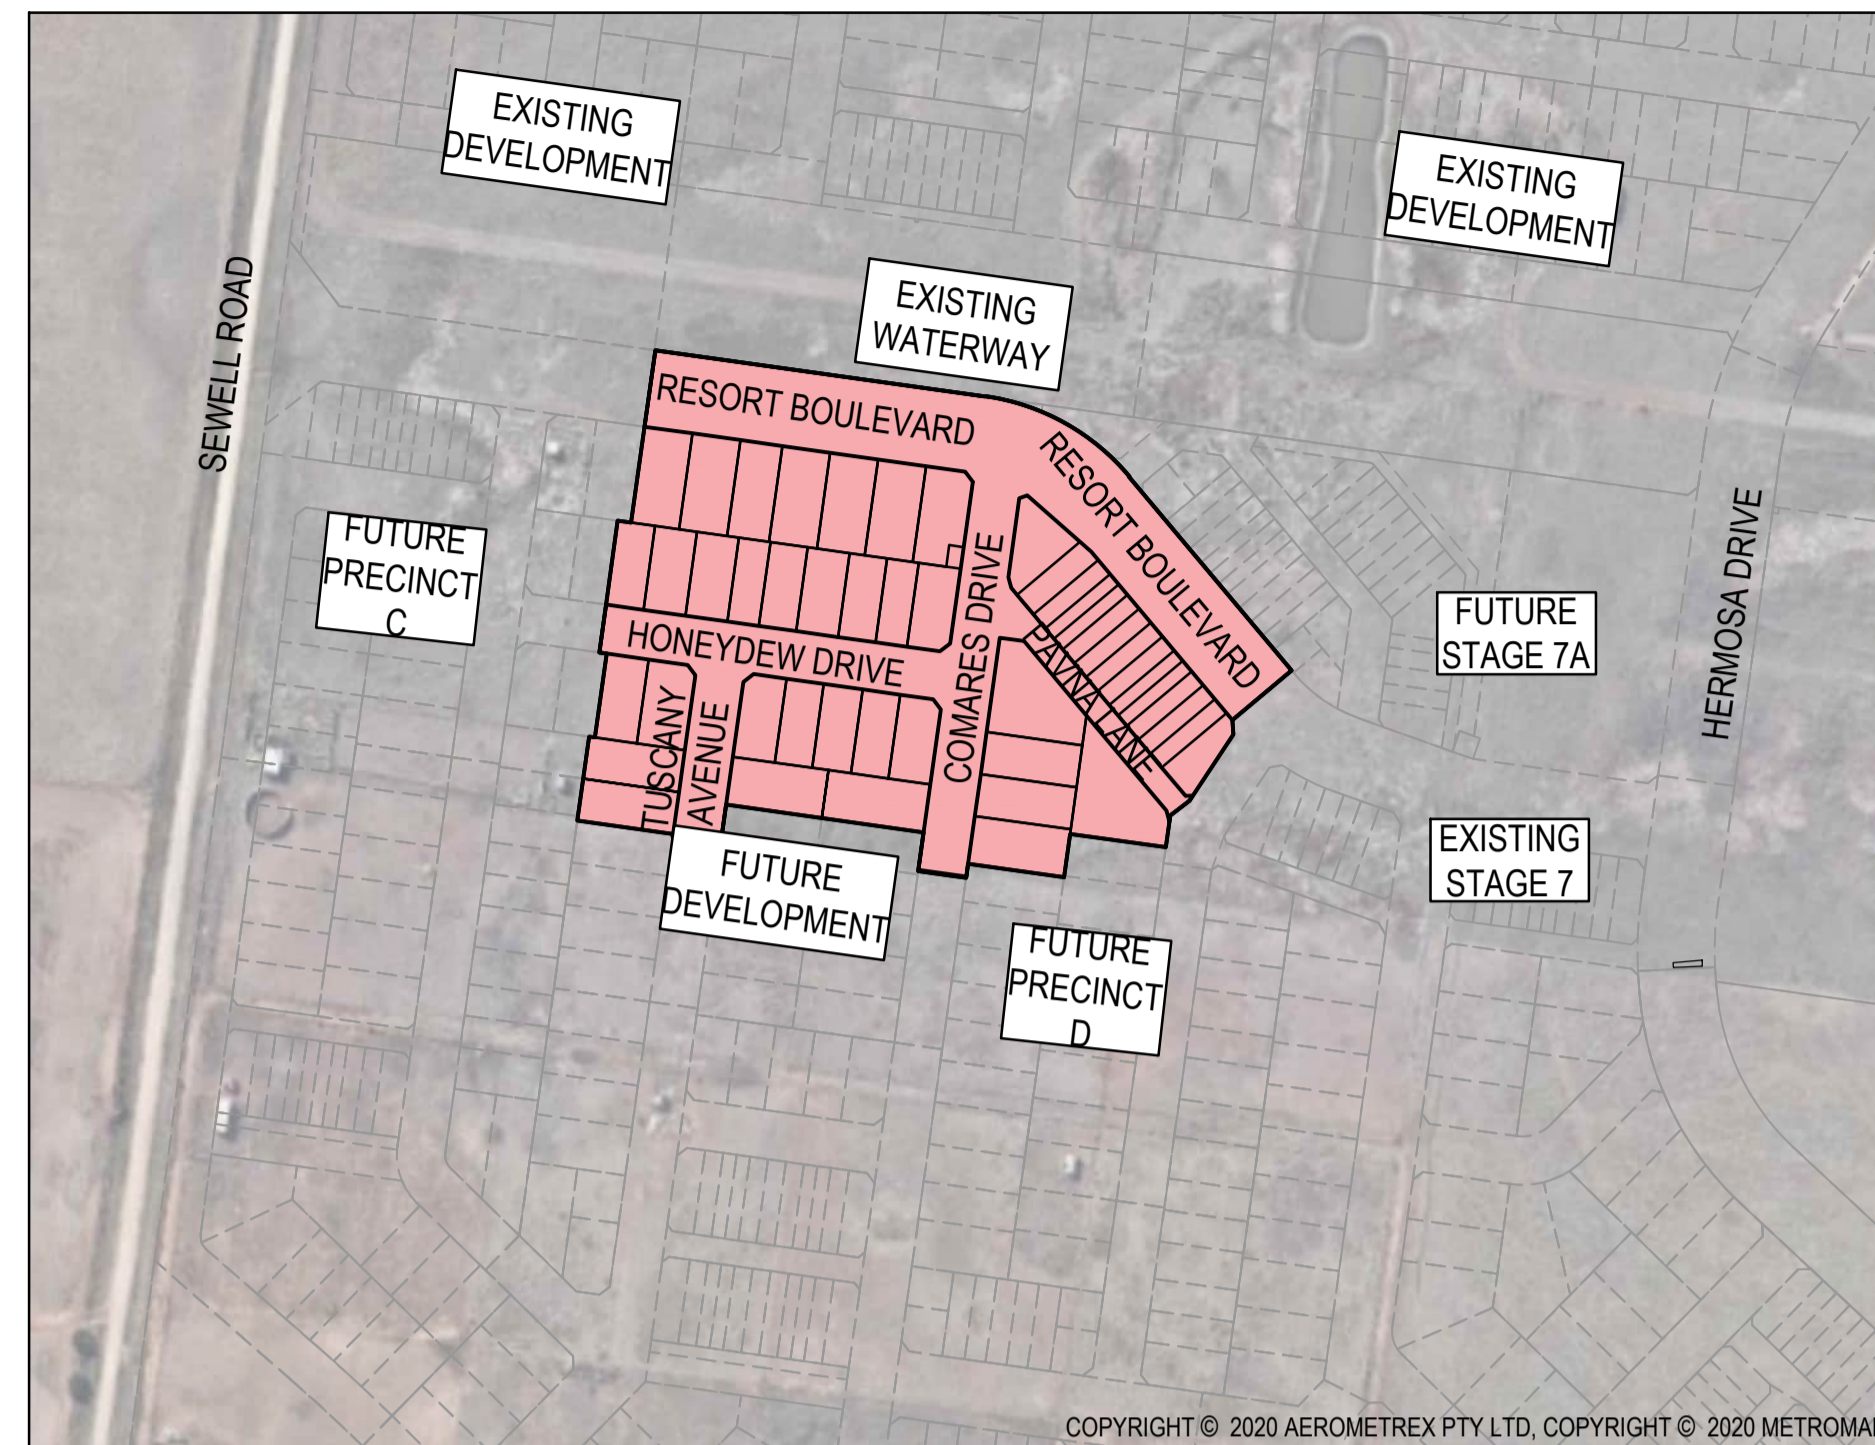

GENERAL NOTES (WYNDHAM CITY COUNCIL)

- THE WORKS SHALL BE CONSTRUCTED IN ACCORDANCE WITH THE CURRENT EDM ADDENDUM STANDARD DRAWINGS AND SPECIFICATIONS. WORKS TO BE CARRIED OUT TO THE SATISFACTION OF COUNCIL'S SUPERVISING OFFICER.
- THE CONTRACTOR IS RESPONSIBLE FOR SAFETY OF WORK ON SITE IN ACCORDANCE WITH APPROPRIATE LEGISLATION. THE CONTRACTOR SHALL ERECT AND MAINTAIN ALL SHORING, PLANKING AND STRUTTING, DEWATERING DEVICES, BARRICADES, SIGNS, LIGHTS, ETC. NECESSARY TO KEEP WORKS IN A SAFE AND STABLE CONDITION AND TO PROTECT THE PUBLIC FROM HAZARDS ASSOCIATED WITH THE WORKS.
- THE CONTRACTOR SHALL:
 - COMPLY WITH THE SAFETY REQUIREMENTS OF THE MINES ACT, GENERAL REGULATIONS AND STATUTORY RULES, AND THE MINES (TRENCHES) REGULATIONS 1982.
 - NOTIFY THE OCCUPATIONAL HEALTH AND SAFETY AUTHORITY OF HIS INTENTION TO COMMENCE TRENCHING OPERATIONS WHERE TRENCHES ARE 1.5 METRES OR DEEPER.
 - ENSURE THAT THE MINE MANAGER OR HIS DEPUTY AS REQUIRED BY THE REGULATIONS IS IN ATTENDANCE WHEN TRENCHING OPERATIONS ARE IN PROGRESS.
- THE CONTRACTOR IS TO NOTIFY COUNCIL AND ALL SERVICE AUTHORITIES SEVEN (7) DAYS PRIOR TO COMMENCEMENT OF CONSTRUCTION.
- THE LOCATION OF EXISTING SERVICES SHOULD BE DETERMINED BY THE CONTRACTOR PRIOR TO COMMENCING ANY EXCAVATION BY CONTACTING ALL RELEVANT SERVICE AUTHORITIES. ANY EXISTING SERVICES SHOWN ON THE DRAWINGS ARE OFFERED AS A GUIDE ONLY AND ARE NOT GUARANTEED AS CORRECT.
- TREES MARKED ON THE APPROVED PLANS FOR REMOVAL MUST BE REMOVED FROM THE SITE PRIOR TO THE COMMENCEMENT OF WORKS. NO EXCAVATION SHALL BE CARRIED OUT WITHIN 5.0m OF ANY EXISTING TREE UNTIL APPROVAL HAS BEEN GIVEN BY COUNCIL'S SUPERVISING OFFICER.
- ALL ROAD CHAINAGES ARE MEASURED ALONG THE ROAD CENTRELINE EXCEPT KERB RETURNS AND COURTHHEADS, WHERE LIP OF KERB CHAINAGES ARE SPECIFIED. ALL DIMENSIONS AND RADII ARE GIVEN TO THE LIP OF KERB. DO NOT SCALE OFF THESE DRAWINGS. WRITTEN DIMENSIONS ONLY SHALL BE USED.
- CONDUIT LOCATIONS ARE SUBJECT TO AMENDMENT AND CONDUITS SHALL NOT BE LAID UNTIL WRITTEN APPROVAL IS GIVEN BY THE SUPERINTENDENT. BOTH KERBS ARE TO BE MARKED WITH THE LETTERS E,G,H,R,T&W ABOVE CONDUIT LOCATIONS AS SPECIFIED. RESPECTIVE LETTERS TO BE INDICATED ABOVE RELEVANT CONDUITS AS PER STANDARD DRAWING EDM 303. CONDUITS TO BE PLACED MINIMUM OF 5m FROM BOUNDARIES WHERE POSSIBLE AND TO THE SATISFACTION OF THE SUPERINTENDENT IN ACCORDANCE WITH COUNCIL STANDARD DRAWINGS.
- SUBSOIL DRAINS SHALL BE INSTALLED BEHIND OR BELOW ALL KERB AND CHANNEL AS PER STANDARD DRAWINGS EDM 202 (EXPANSIVE SUBGRADE).
- ALL LINEMARKING, SIGNING AND TRAFFIC CONTROL DEVICES TO BE IN ACCORDANCE WITH VICROADS REQUIREMENTS WITH LATERAL WORKS AND ARROWS BEING GOLD APPLIED PLASTIC TROWELLED INTO PLACE (MATERIAL DEGAOUR OR PLASTELINE) AND LONGITUDINAL LINES BEING EXTRUDED THERMOPLASTIC MATERIAL (VICROADS SPECIFICATION SEE SECTION 7108722).
- ALL LEVELS ARE TO AUSTRALIAN HEIGHT DATUM.
- THE CONTRACTOR WHEN ENGAGED IN BLASTING OPERATION, SHALL NOT BLAST WITHIN 4.5m OF AN EXISTING LINE OF WATER, GAS OR SEWER PIPES OR WITHIN 15m OF ANY COMPLETED PART OF THE WORKS WITHOUT THE CONSENT OF THE ENGINEER.
- ALL EXCAVATED OR FILLED AREAS OUTSIDE THE ROAD RESERVE SHALL BE SURFACED WITH A 100mm MINIMUM TO 200mm MAXIMUM LAYER OF TOPSOIL AS SPECIFIED. ALL FILLING ON ALLOTMENTS TO BE COMPACTED TO 95% STANDARD COMPACTION IN 150mm LAYERS AND AS PER THE SPECIFICATION. WHERE THERE IS FILL IN EXCESS OF 300mm IN DEPTH, THE CONTRACTOR IS TO CARRY OUT SOIL TESTS TO THE REQUIREMENTS OF APPENDIX B AS SPECIFIED IN THE AUSTRALIAN STANDARD AS 3798 TO SHOW THAT LEVEL 1 COMPACTION STANDARDS HAVE BEEN ACHIEVED. TEST RESULTS AND LOCATION OF TESTS FOR EACH ALLOTMENT SHALL BE APPROVED BY THE CONTRACTOR AND FORWARDED TO COUNCIL.
- FILL MATERIAL USED UNDER PAVEMENTS AND FOOTPATHS MUST BE AN APPROVED MATERIAL TO THE STANDARD OF WYNDHAM CITY COUNCIL. ALL SUCH MATERIAL IS TO BE COMPACTED AS PER THE REQUIREMENTS OF THE SPECIFICATION APPROVED WITH THESE DRAWINGS PRIOR TO FORMWORK BEING PLACED. COMPACTION TESTS TO BE COMPLETED AND PROVIDED TO SUPERINTENDENT.
- FILL & CUT BATTERS ARE NOT TO EXCEED 1 IN 6 SLOPE, UNLESS SHOWN OTHERWISE.
- ALL ALLOTMENTS SHALL BE SMOOTHED, GRADED AND SHAPED TO AN EVEN SURFACE WITH A MINIMUM FALL OF 1 IN 150 TO THE DRAINAGE OUTLET SHOWN.
- ALL DRAINAGE PIPES ARE CLASS 2 RCP PIPES, RUBBER RING JOINTED UNLESS OTHERWISE SPECIFIED.
- DRAINAGE PITS SHALL BE CAST MONOLITHICALLY. CEMENT RENDER SHALL ONLY BE USED TO REPAIR DEFECTS.
- BACKFILLING OF TRENCHES WHERE DRAINAGE AND SEWERAGE ARE IN CLOSE PROXIMITY ARE TO BE BACKFILLED AS PER WYNDHAM CITY COUNCIL STANDARD DRAWING SD6-10.
- ALL SERVICING TRENCHES UNDER ROADS, FOOTPATHS, DRIVEWAYS, PARKING BAYS ETC. ARE TO BE BACKFILLED WITH CLASS 2 F.C.R.
- ALL HOUSE DRAIN CONNECTIONS TO BE INSTALLED AT 6m FROM THE LOW SIDE BOUNDARY U.N.O.
- INVERT OF PROPERTY INLETS TO BE 500mm MINIMUM BELOW FINISHED SURFACE UNLESS NOTED OTHERWISE.
- VEHICLE CROSSINGS TO BE CONSTRUCTED IN ACCORDANCE WITH STANDARD DRAWINGS EDM 501 TO 503. DRIVEWAYS TO BE LOCATED MIN 0.75m FROM BUILDING LINE UNLESS SPECIFIED OTHERWISE AND CLEAR OF DRAINAGE PITS, SEWER MAINTENANCE HOLES AND EXISTING TREES. DOUBLE DRIVEWAY WIDTH TO BE 7.0m AT FRONT OF PATH/BUILDING LINE.
- ADDITIONAL AND OVER-EXCAVATION SHALL BE BACKFILLED IN ACCORDANCE WITH THE PROVISIONS OF THE SPECIFICATION.
- FOOTPATH CROSSFALL TO BE 1:50
- ALL FOOTPATHS AND SHARED PEDESTRIAN/BICYCLE PATHS ARE TO BE CONSTRUCTED AS PER CITY OF WYNDHAM SPECIFICATIONS AND MPA STANDARD DRAWINGS EDM 401 TO 403.
- ALL EXOTIC (NON NATIVE) TREES AND SHRUBS, INCLUDING DEAD TREES, NOT SHOWN ON THE DRAWINGS BUT LOCATED WITHIN THE WORKS ARE TO BE REMOVED AND DISPOSED OFFSITE.
- INSTALL BLUE RAISED REFLECTIVE PAVEMENT MARKER (BRP) ON ROAD CENTRELINE AND "GROUND BALL" MARKER POST TO INDICATE LOCATION OF FIREPLUG.
- THE CONTRACTOR IS TO ENSURE THAT THEIR CONSTRUCTION PROCEDURES AND STANDARDS CONTROL THE VOLUME AND LOCATION FOR COLLECTION OF SEDIMENT RUNOFF ACCORDING TO CURRENT EPA - ENVIRONMENTAL GUIDELINES FOR MAJOR CONSTRUCTION SITES.
- UPON COMPLETION OF CONSTRUCTION THE WHOLE SITE SHALL BE CLEANED UP, GRADED AND ALL RUBBISH REMOVED. THE SITE IS TO BE LEFT IN A CLEAN AND TIDY CONDITION TO THE SATISFACTION OF THE SUPERINTENDENT.
- EXISTING PAVEMENT OR DRAINAGE WORKS DAMAGED DURING CONSTRUCTION OR THE MAINTENANCE PERIOD TO BE REINSTATED TO THE SATISFACTION OF THE COUNCIL ENGINEER.
- THE LOWER SUB-BASE MATERIAL SHALL WILL BE N.D.C.R. FOR PAVEMENT MAKE UPS AS PER THE STANDARD DRAWINGS OF WYNDHAM CITY COUNCIL.
- TOTAL LENGTH OF ROADS CONSTRUCTED IS 723m
- TOTAL LENGTH OF DRAINS CONSTRUCTED IS 957m
- ALL TGS1 TO BE INSTALLED IN ACCORDANCE WITH AS1428.

WARNING
SAFETY MEASURES REQUIRED
Please note there are risks attached to the construction of this project, and any ongoing maintenance of structures. Consider the safety of all. For potential risks, consequences and controls refer to Safety in Design Risk Register SID P4.E6, 2070E-A08-500
ASSESS THE RISK - STAY SAFE

WARNING
BEWARE OF UNDERGROUND SERVICES
The locations of underground services are approximate only and their exact position should be proven on site. No guarantee is given that all existing services are shown. Locate all underground services before commencement of works
DIAL 1100 BEFORE YOU DIG
www.1100.com.au

These designs and drawings are the copyright of SMEC Australia Pty Ltd. The drawing shall not be reproduced or copied, in whole or part, without the written permission of SMEC Australia Pty Ltd. The contents of this drawing are electronically generated, are confidential and may only be used for the purpose for which they are intended.

REV	DRAWING NO.	DRAWING TITLE
	2070E-A08-101	Cover Plan & General Notes Sheet Index
	2070E-A08-111	Layout Plan
	2070E-A08-171	Signage & Linemarking Plan
	2070E-A08-181	Intersection Detail Plan - 1
	2070E-A08-182	Intersection Detail Plan - 2
	2070E-A08-201	Longitudinal Sections - 1
	2070E-A08-202	Longitudinal Sections - 2
	2070E-A08-251	Cross Sections: Comares Drive Ch 0.00 - Ch 185.72
	2070E-A08-252	Cross Sections: Honeydew Drive Ch 11.80 - Ch 122.50 Resort Boulevard Ch 156.20 - Ch 181.24
	2070E-A08-253	Cross Sections: Resort Boulevard Ch 206.74 - Ch 287.57
	2070E-A08-254	Cross Sections: Resort Boulevard Ch 315.91 - Ch 393.91
	2070E-A08-255	Cross Sections: Tuscany Avenue Ch 11.80 - Ch 64.00 PAVNA Lane Ch 28.35 - Ch 82.35
	2070E-A08-301	Drainage Longitudinal Sections - 1
	2070E-A08-302	Drainage Longitudinal Sections - 2
	2070E-A08-303	Drainage Longitudinal Sections - 3
	2070E-A08-351	Drain Pit Schedule
	2070E-A08-411	Pavement Details
	2070E-A08-421	General Details - 1
	2070E-A08-422	General Details - 2
	2070E-A08-500	Safety In Design

ROAD NAME	SERVICES OFFSET TABLE					
	GAS OFFSET (m)	WATER OFFSET (m)	RECYCLED WATER OFFSET (m)	ELECTRICITY OFFSET (m)	OPTIC FIBRE OFFSET (m)	SEWER OFFSET (m)
TUSCANY AENUE	2.10 W	3.10 W	2.60 W	2.50E	1.80E	-
HONEYDEW DRIVE	2.10 N	3.10 N	2.60 N	2.50 S	1.80 S	-
COMARES DRIVE	2.10 W	3.10 W	2.60 W	2.50 E	1.80 E	1.00 W
RESORT BOULEVARD	2.10 S	3.10 S	2.60 S	2.50 N	1.80 N	-
PAVNA LANE	-	-	-	-	-	1.00 N

ROAD NAME	ROAD RESERVE WIDTH (m)	ROAD WIDTH (m)				KERB TYPE		VERGE WIDTH (m)	
		LIP TO LIP	INV TO INV	BACK TO BACK	NTH/WEST	STH/EAST	NTH/WEST	STH/EAST	
TUSCANY AENUE	16.00	6.40	7.30	7.60	B2	B2	4.35	4.35	
HONEYDEW DRIVE	16.00	6.40	7.30	7.60	B2	B2	4.35	4.35	
COMARES DRIVE	16.00	6.40	7.30	7.60	B2	B2	4.35	4.35	
RESORT BOULEVARD	25.50	6.40	7.30	7.60	B2	B2	4.20	4.20	
PAVNA LANE	8.00	-	-	-	-	-	-	-	

(GAS) - STANDARD NOTES

- GAS MAINS, FITTINGS AND MARKER TAPE ARE TO BE SUPPLIED BY THE GAS AUTHORITY.
- EXCAVATION, SUPPLY AND PLACEMENT OF REQUIRED BACKFILL TO BE UNDERTAKEN BY OTHERS.
- NOTIFICATION MUST BE GIVEN TO THE GAS AUTHORITY TWO WEEKS PRIOR TO THE COMMENCEMENT OF EXCAVATION WORKS.

REINFORCED CONCRETE PIPE

- ALL STORMWATER DRAINAGE PIPES SHALL NOT BE SUBJECTED TO CONSTRUCTION TRAFFIC LOADING DURING CONSTRUCTION UNLESS THE PIPE STRENGTH CHARACTERISTICS HAVE BEEN COMPUTED AND APPROVED BY THE CONTRACTORS ENGINEER. COMPUTATIONS ARE TO ACCORD WITH AS 3725-2007. LOADS ON BURIED PIPES.
- CONCRETE PIPES DAMAGED DUE TO CONSTRUCTION LOADS SHALL BE REPLACED & RELAID AT THE CONTRACTOR'S COST.

AS CONSTRUCTED PLANS



The purpose of these as-constructed plans is to update the design drawings to show significant changes which occurred during construction. Note that the levels shown on these plans are design levels, and have not been verified by survey. All information shown on these plans should be verified on site. SMEC Australia Pty Ltd accept no responsibility for loss or damages resulting from the inappropriate usage of these plans.



PLAN OF SUB. NO.
PS841640V/S16
PERMIT REF. NO.
WYP10107_17.02


AS CONSTRUCTED

0 25 50 100
Scale 1:2500
SCALE AS SHOWN AT A1

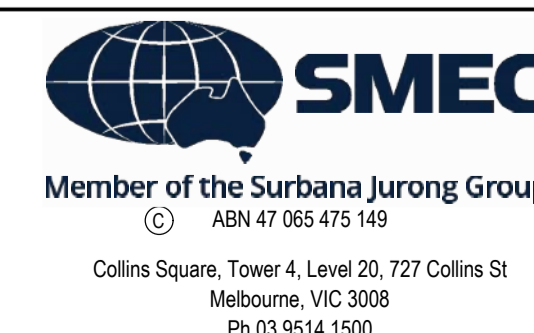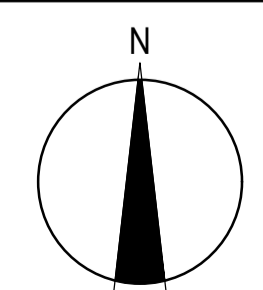

Alamora - Stage 8, Sayers Road, Tarneit
Wyndham City Council
Road and Drainage
Cover Plan & General Notes
Sheet Index

MELWAYS REF 234 D6	PROJECT / DRAWING No. 2070E-A08-101	SHEET No. 01 of 20	REVISION 3
------------------------------	---	------------------------------	----------------------

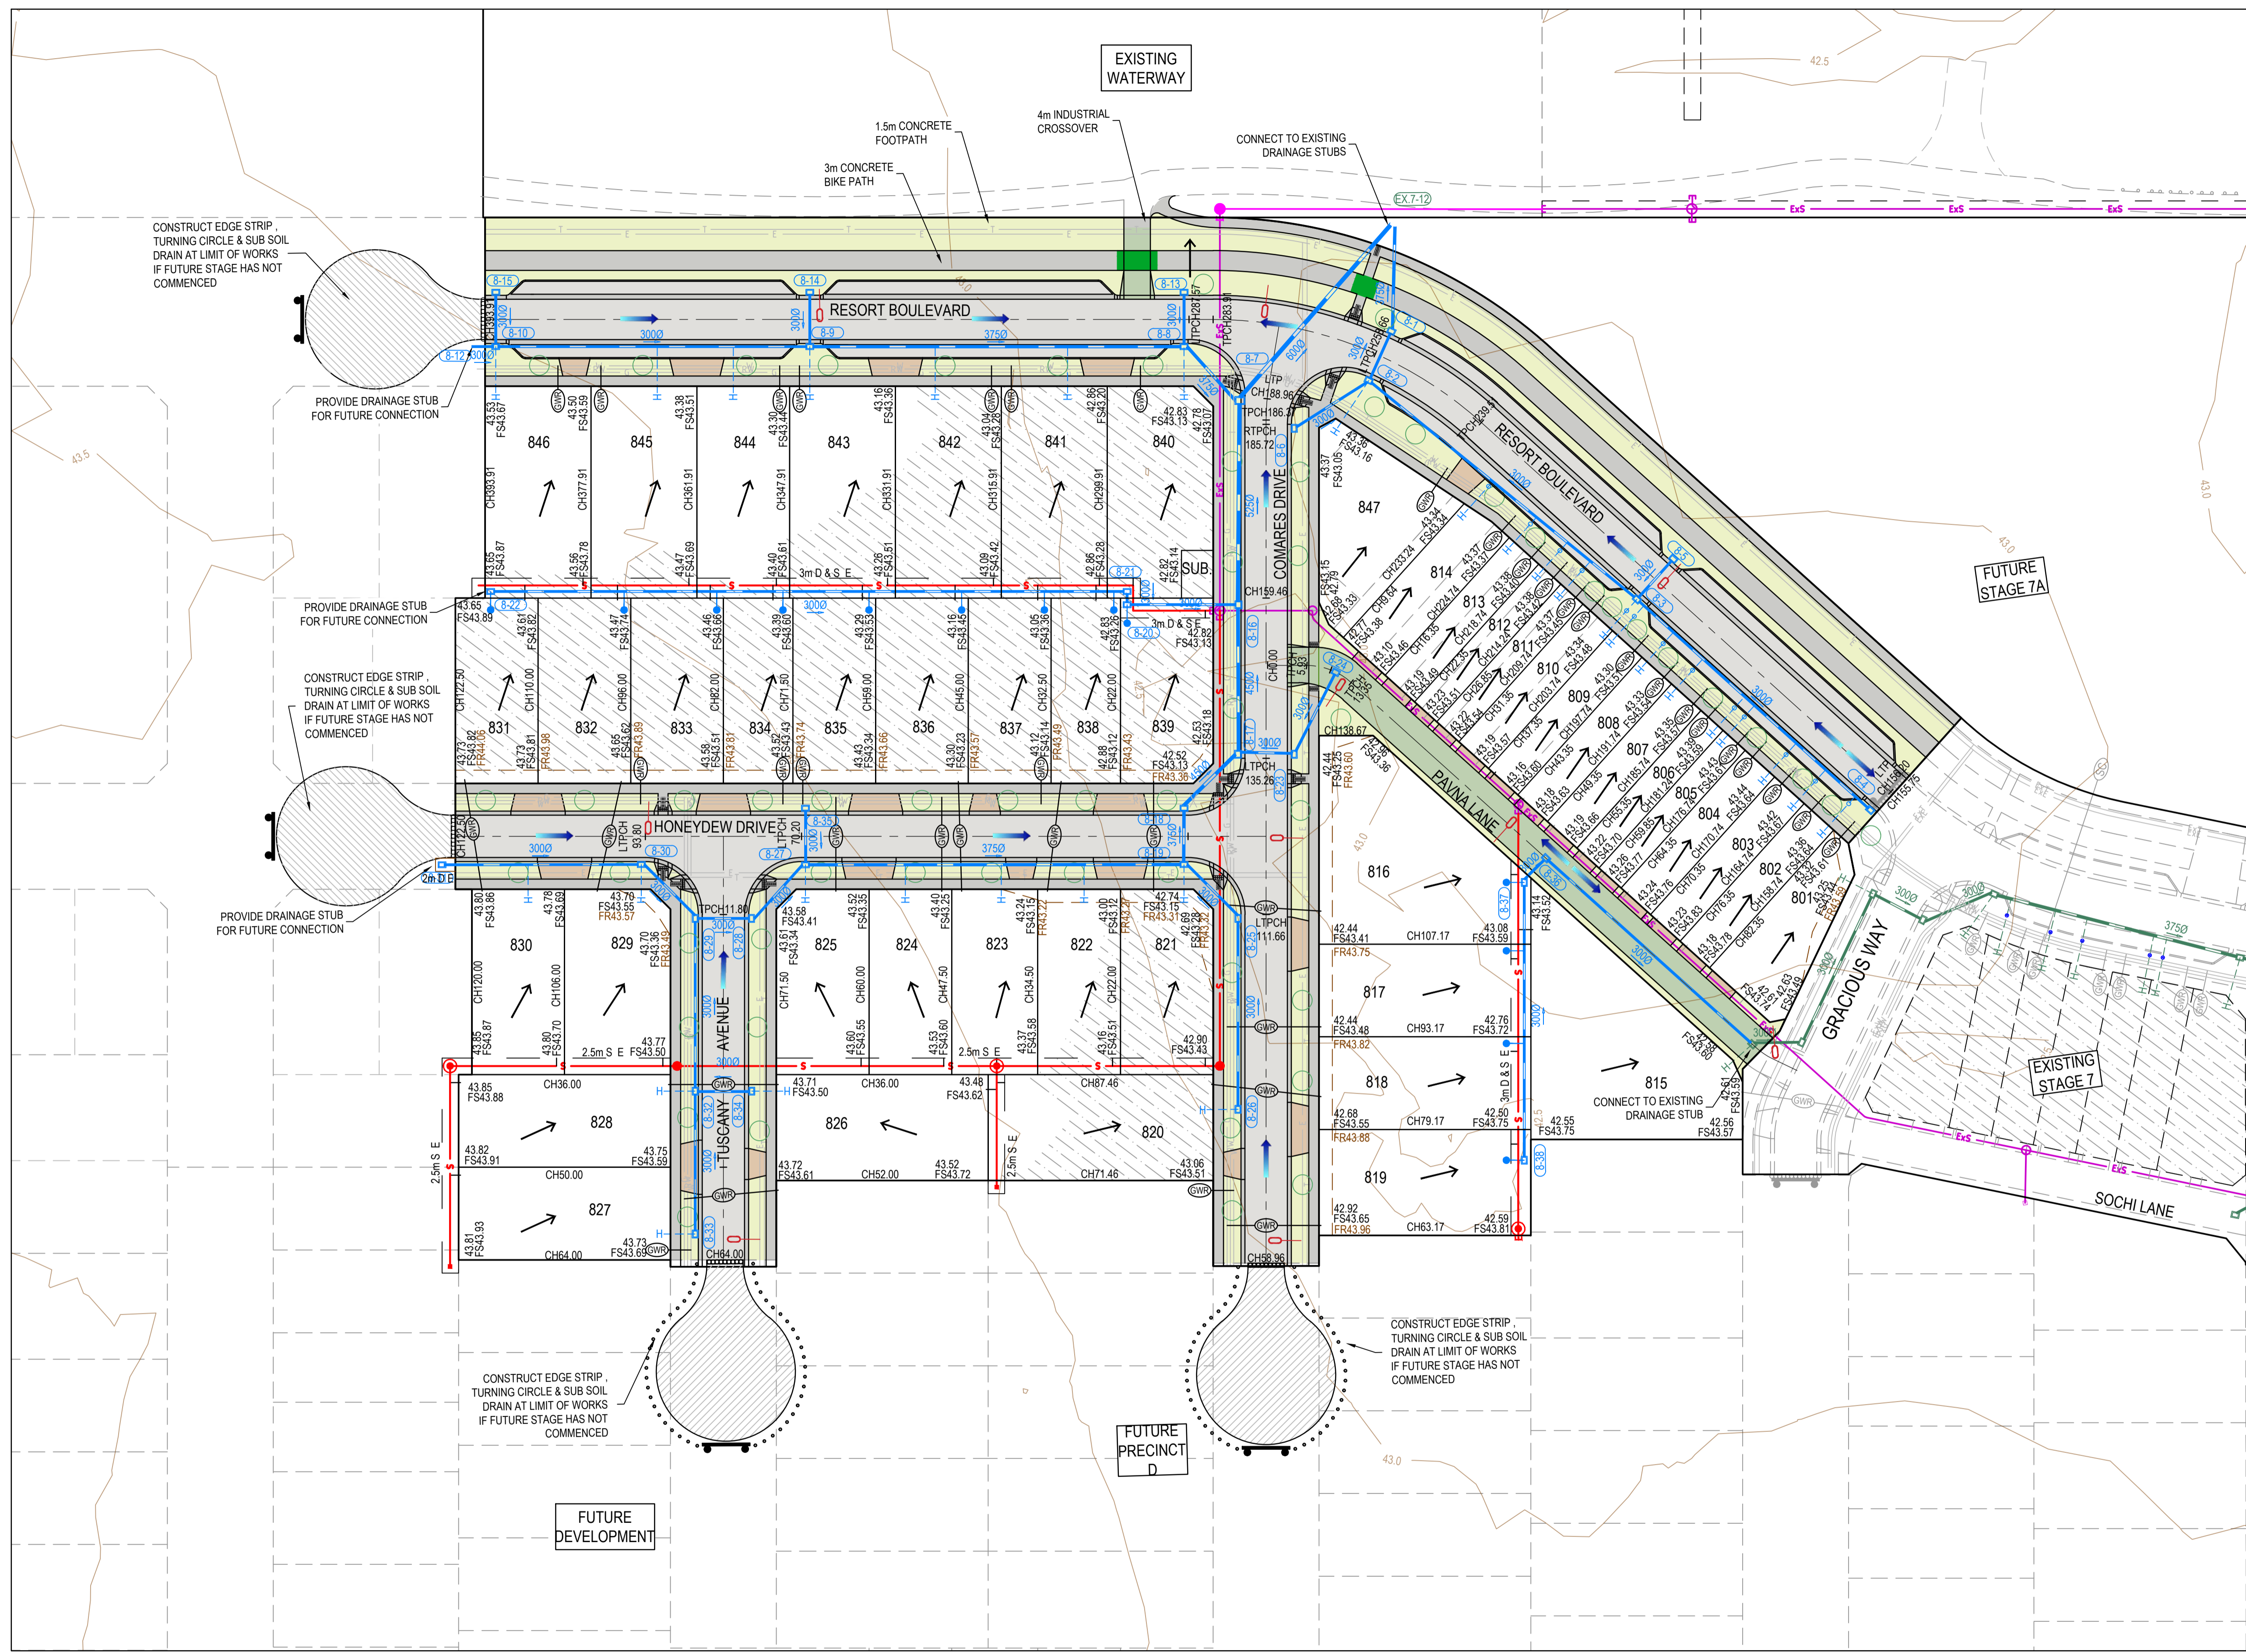

LEGEND - LAYOUT PLAN

ALL PROPOSED, FUTURE & EXISTING SERVICE LOCATIONS ARE SHOWN INDICATIVELY

	STORMWATER DRAIN, PIT & PROPERTY INLET
	MAIN DRAIN
	SWALE DRAIN
	SEWER & MAINTENANCE STRUCTURES
	HOUSE DRAIN
	ELECTRICITY (U.GROUND)
	ELECTRICITY (O.HEAD)
	GAS
	TELSTRA
	OPTIC FIBRE
	WATER
	RECYCLE WATER
	AG. DRAIN
	SERVICE CONDUITS
	TACTILE PAVERS
	EXISTING STORMWATER DRAIN
	EXISTING MAIN DRAIN
	EXISTING SWALE DRAIN
	EXISTING SEWER & MAINTENANCE STRUCTURES
	EXISTING HOUSE DRAIN
	EXISTING ELECTRICITY (UNDER GROUND)
	EXISTING ELECTRICITY OVERHEAD
	EXISTING GAS
	EXISTING TELSTRA
	EXISTING OPTIC FIBRE
	EXISTING WATER
	EXISTING RECYCLED WATER
	EXISTING AG. DRAIN
	EXISTING SERVICE CONDUITS
	EXISTING TACTILE PAVERS
	FUTURE STORMWATER DRAIN
	FUTURE MAIN DRAIN
	FUTURE SWALE DRAIN
	FUTURE SEWER & MAINTENANCE STRUCTURES
	FUTURE HOUSE DRAIN
	FUTURE ELECTRICITY (UNDER GROUND)
	FUTURE ELECTRICITY OVERHEAD
	FUTURE GAS
	FUTURE TELSTRA
	FUTURE OPTIC FIBRE
	FUTURE WATER
	FUTURE RECYCLED WATER
	FUTURE AG. DRAIN
	FUTURE SERVICE CONDUITS
	FUTURE TACTILE PAVERS
	ZERO LOT LINES
	141.34 EXISTING SURFACE LEVEL
	FS140.35 FINISHED BUILDING LINE LEVEL
	FR157.40 FINISHED RIDGE LINE LEVEL
	CH270.00 CHAINAGE
	TW159.60 TOP OF RETAINING WALL LEVEL
	BW159.00 BOTTOM OF RETAINING WALL LEVEL
	EXISTING RETAINING WALL
	RETAINING WALL
	FUTURE RETAINING WALL
	STRUCTURAL FILL > 200mm DEEP
	EXISTING STRUCTURAL FILL > 200mm DEEP
	CUT > 200mm DEEP
	DIRECTION OF FALL
	OVERLAND FLOW
	GRADED IN DIRECTION OF FALL TO LEVEL INDICATED
	EDGE STRIP, SUBSOIL DRAIN, "NO ROAD" SIGN & BARRIER
	EXISTING TREE TO BE RETAINED
	EXISTING TREE TO BE REMOVED
	PERMANENT SURVEY MARK
	TEMPORARY BENCH MARK
	PROPOSED DRIVEWAY & FOOTPATH
	PROPOSED INDUSTRIAL DRIVEWAY
	PROPOSED SHARED FOOTPATH
	PROPOSED ROAD PAVING
	EXISTING ROAD PAVING
	PROPOSED PL POLE

WARNING
BEWARE OF UNDERGROUND SERVICES
 The locations of underground services are approximate only and their exact position should be proven on site. No guarantee is given that all existing services are shown. Locate all underground services before commencement of works
DIAL 1100 BEFORE YOU DIG
www.1100.com.au

AS CONSTRUCTED PLANS

The purpose of these as-constructed plans is to update the design drawings to show significant changes which occurred during construction. Note that the levels shown on these plans are design levels, and have not been verified by survey. All information shown on these plans should be verified on site. SMEC Australia Pty Ltd accept no responsibility for loss or damages resulting from the inappropriate usage of these plans.

Quality Management ISO 9001
 OHS Management AS/NZS 4801
 Environmental Management ISO 14001

PLAN OF SUB. NO.
 PS841640V/S16
 PERMIT REF. NO.
 WYP10107_17.02

AS CONSTRUCTED

Scale 1:500
 SCALE AS SHOWN AT A1

SMEC
 Member of the Surlana Jurong Group
 ABN 47 065 475 149
 Collins Square, Tower 4, Level 20, 727 Collins St
 Melbourne, VIC 3008
 Ph 03 9514 1500



Alamora - Stage 8, Sayers Road, Tarnait
 Wyndham City Council
 Road and Drainage
 Layout Plan

MELWAYS REF 234 D6	PROJECT / DRAWING No. 2070E-A08-111	SHEET No. 02 of 20	REVISION 3
------------------------------	---	------------------------------	----------------------



LEGEND - SIGN AND LINEMARKING	
ALL PROPOSED, FUTURE & EXISTING SERVICE LOCATIONS ARE SHOWN INDICATIVELY	
	NO THROUGH ROAD G9-18A
	HAZARD MARKER D4-5
	STREET SIGNS
	GIVE WAY SIGN R1-2A



- NOTES**
- 90° BENDS TO HAVE CENTRELINE MARKING WITH RRPMS AT MAX 6m SPACING.
 - RRPMS TO BE IN ACCORDANCE WITH VICROADS TRAFFIC ENGINEERING MANUAL VOL 2.
 - ALL LINEMARKING & SIGNAGE TO BE IN ACCORDANCE WITH AUSTRALIAN STANDARD AS1742.

WARNING
BEWARE OF UNDERGROUND SERVICES
 The locations of underground services are approximate only and their exact position should be proven on site.
 No guarantee is given that all existing services are shown.
 Locate all underground services before commencement of works
DIAL 1100 BEFORE YOU DIG
www.1100.com.au

AS CONSTRUCTED PLANS
 The purpose of these as-constructed plans is to update the design drawings to show significant changes which occurred during construction. Note that the levels shown on these plans are design levels, and have not been verified by survey. All information shown on these plans should be verified on site. SMEC Australia Pty Ltd accept no responsibility for loss or damages resulting from the inappropriate usage of these plans.

PLAN OF SUB. NO.
 PS841640V/S16
 PERMIT REF. NO.
 WYP10107_17.02

AS CONSTRUCTED


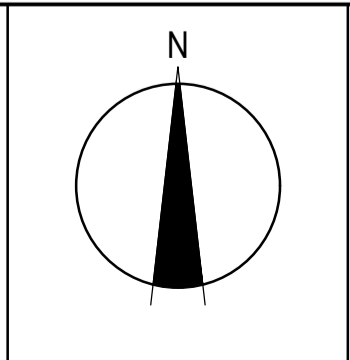
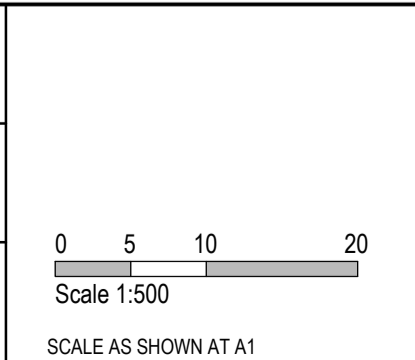


SMEC
 Member of the Surlana Jurong Group
 ABN 47 065 475 149
 Collins Square, Tower 4, Level 20, 727 Collins St
 Melbourne, VIC 3008
 Ph 03 9514 1500






Alamora - Stage 8, Sayers Road, Tarnait
 Wyndham City Council
 Road and Drainage
 Signage & Linemarking Plan

MELWAYS REF 234 D6	PROJECT / DRAWING No. 2070E-A08-171	SHEET No. 03 of 20	REVISION 3
------------------------------	---	------------------------------	----------------------

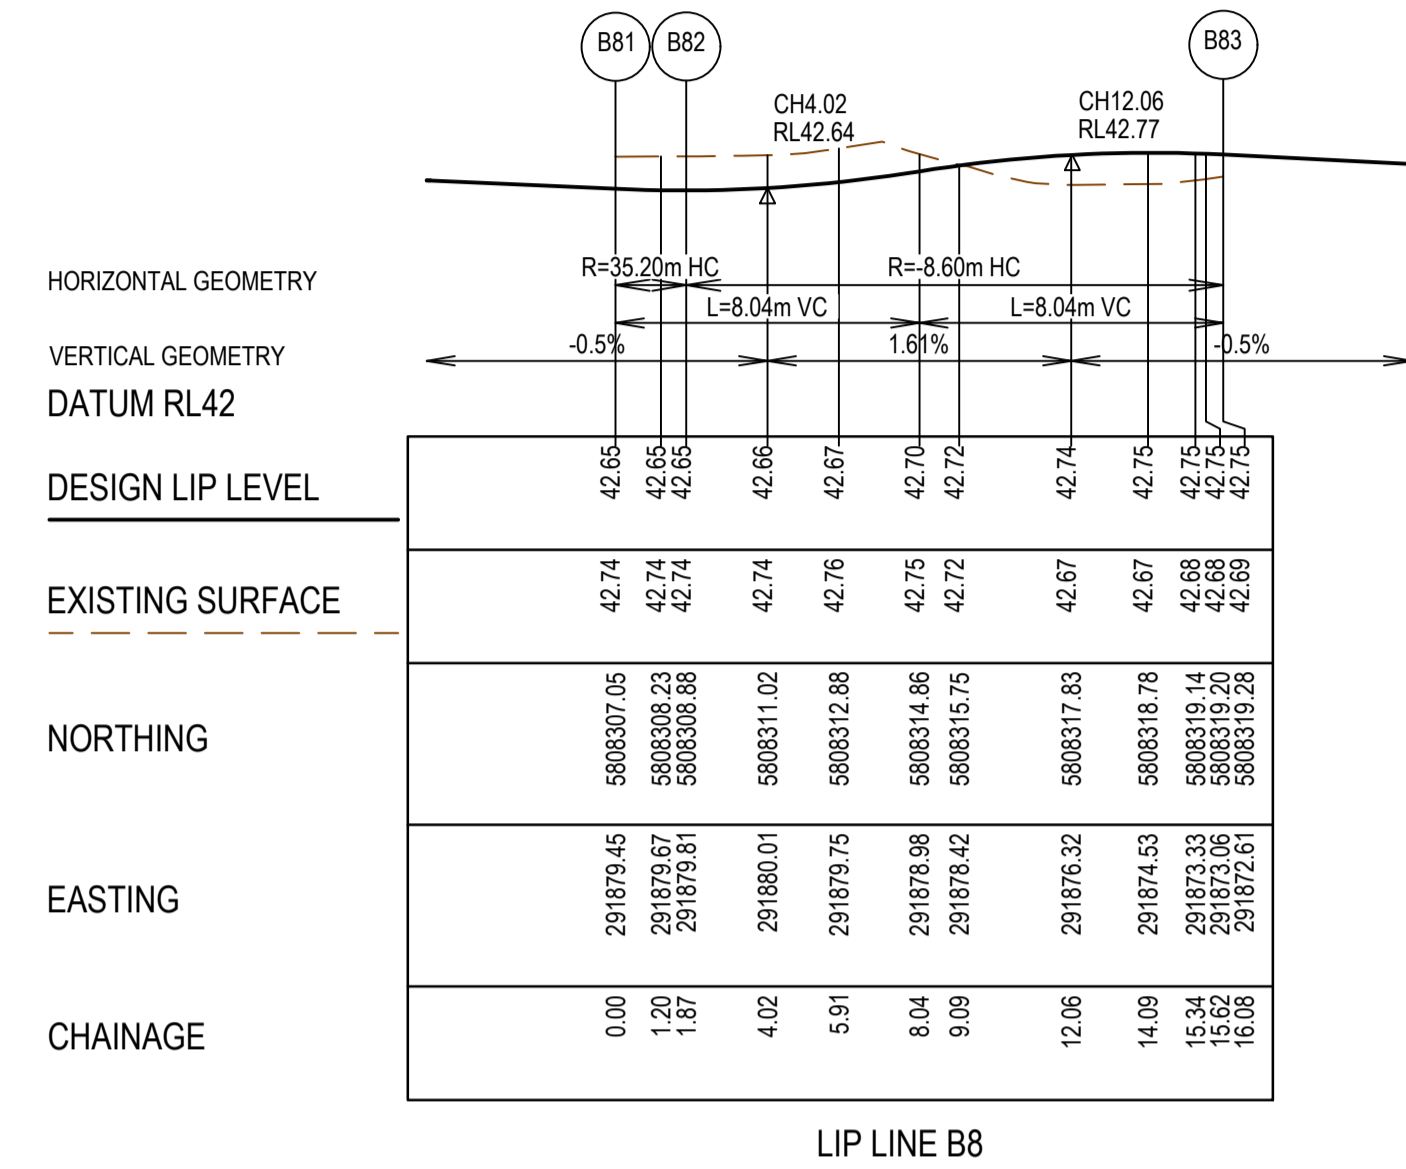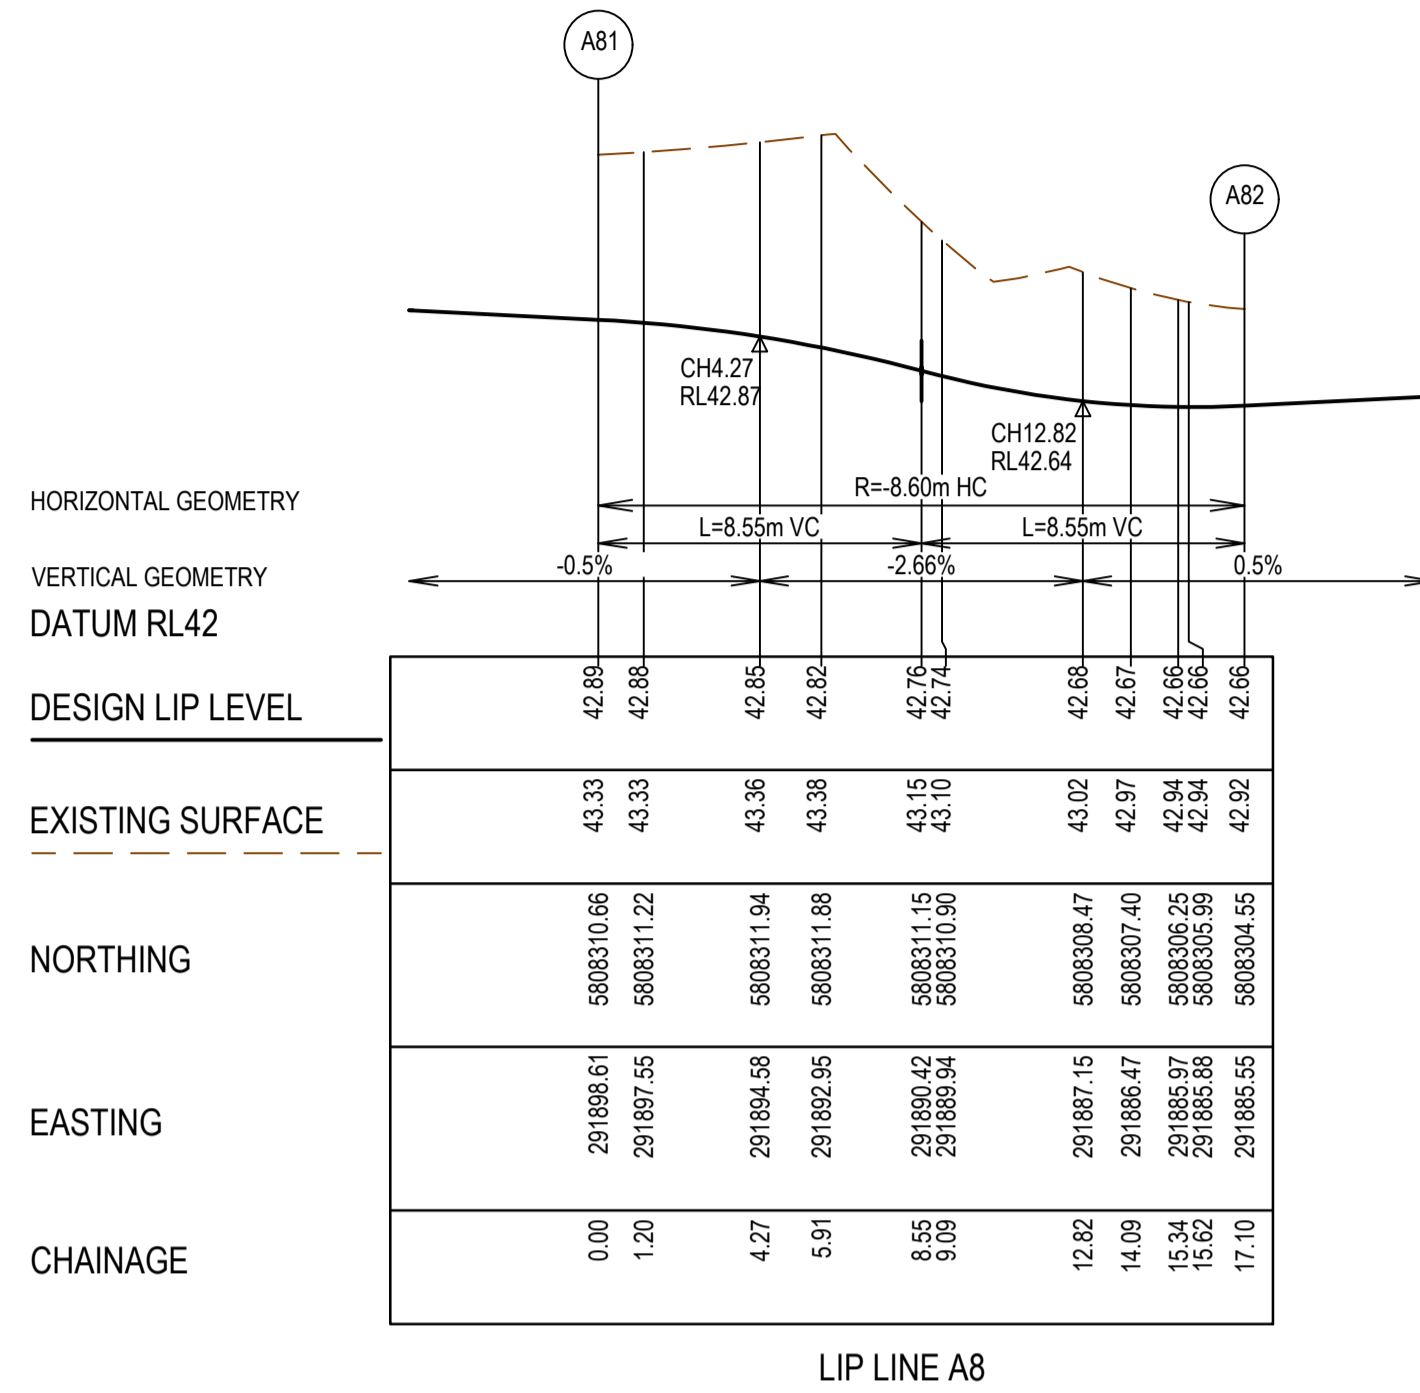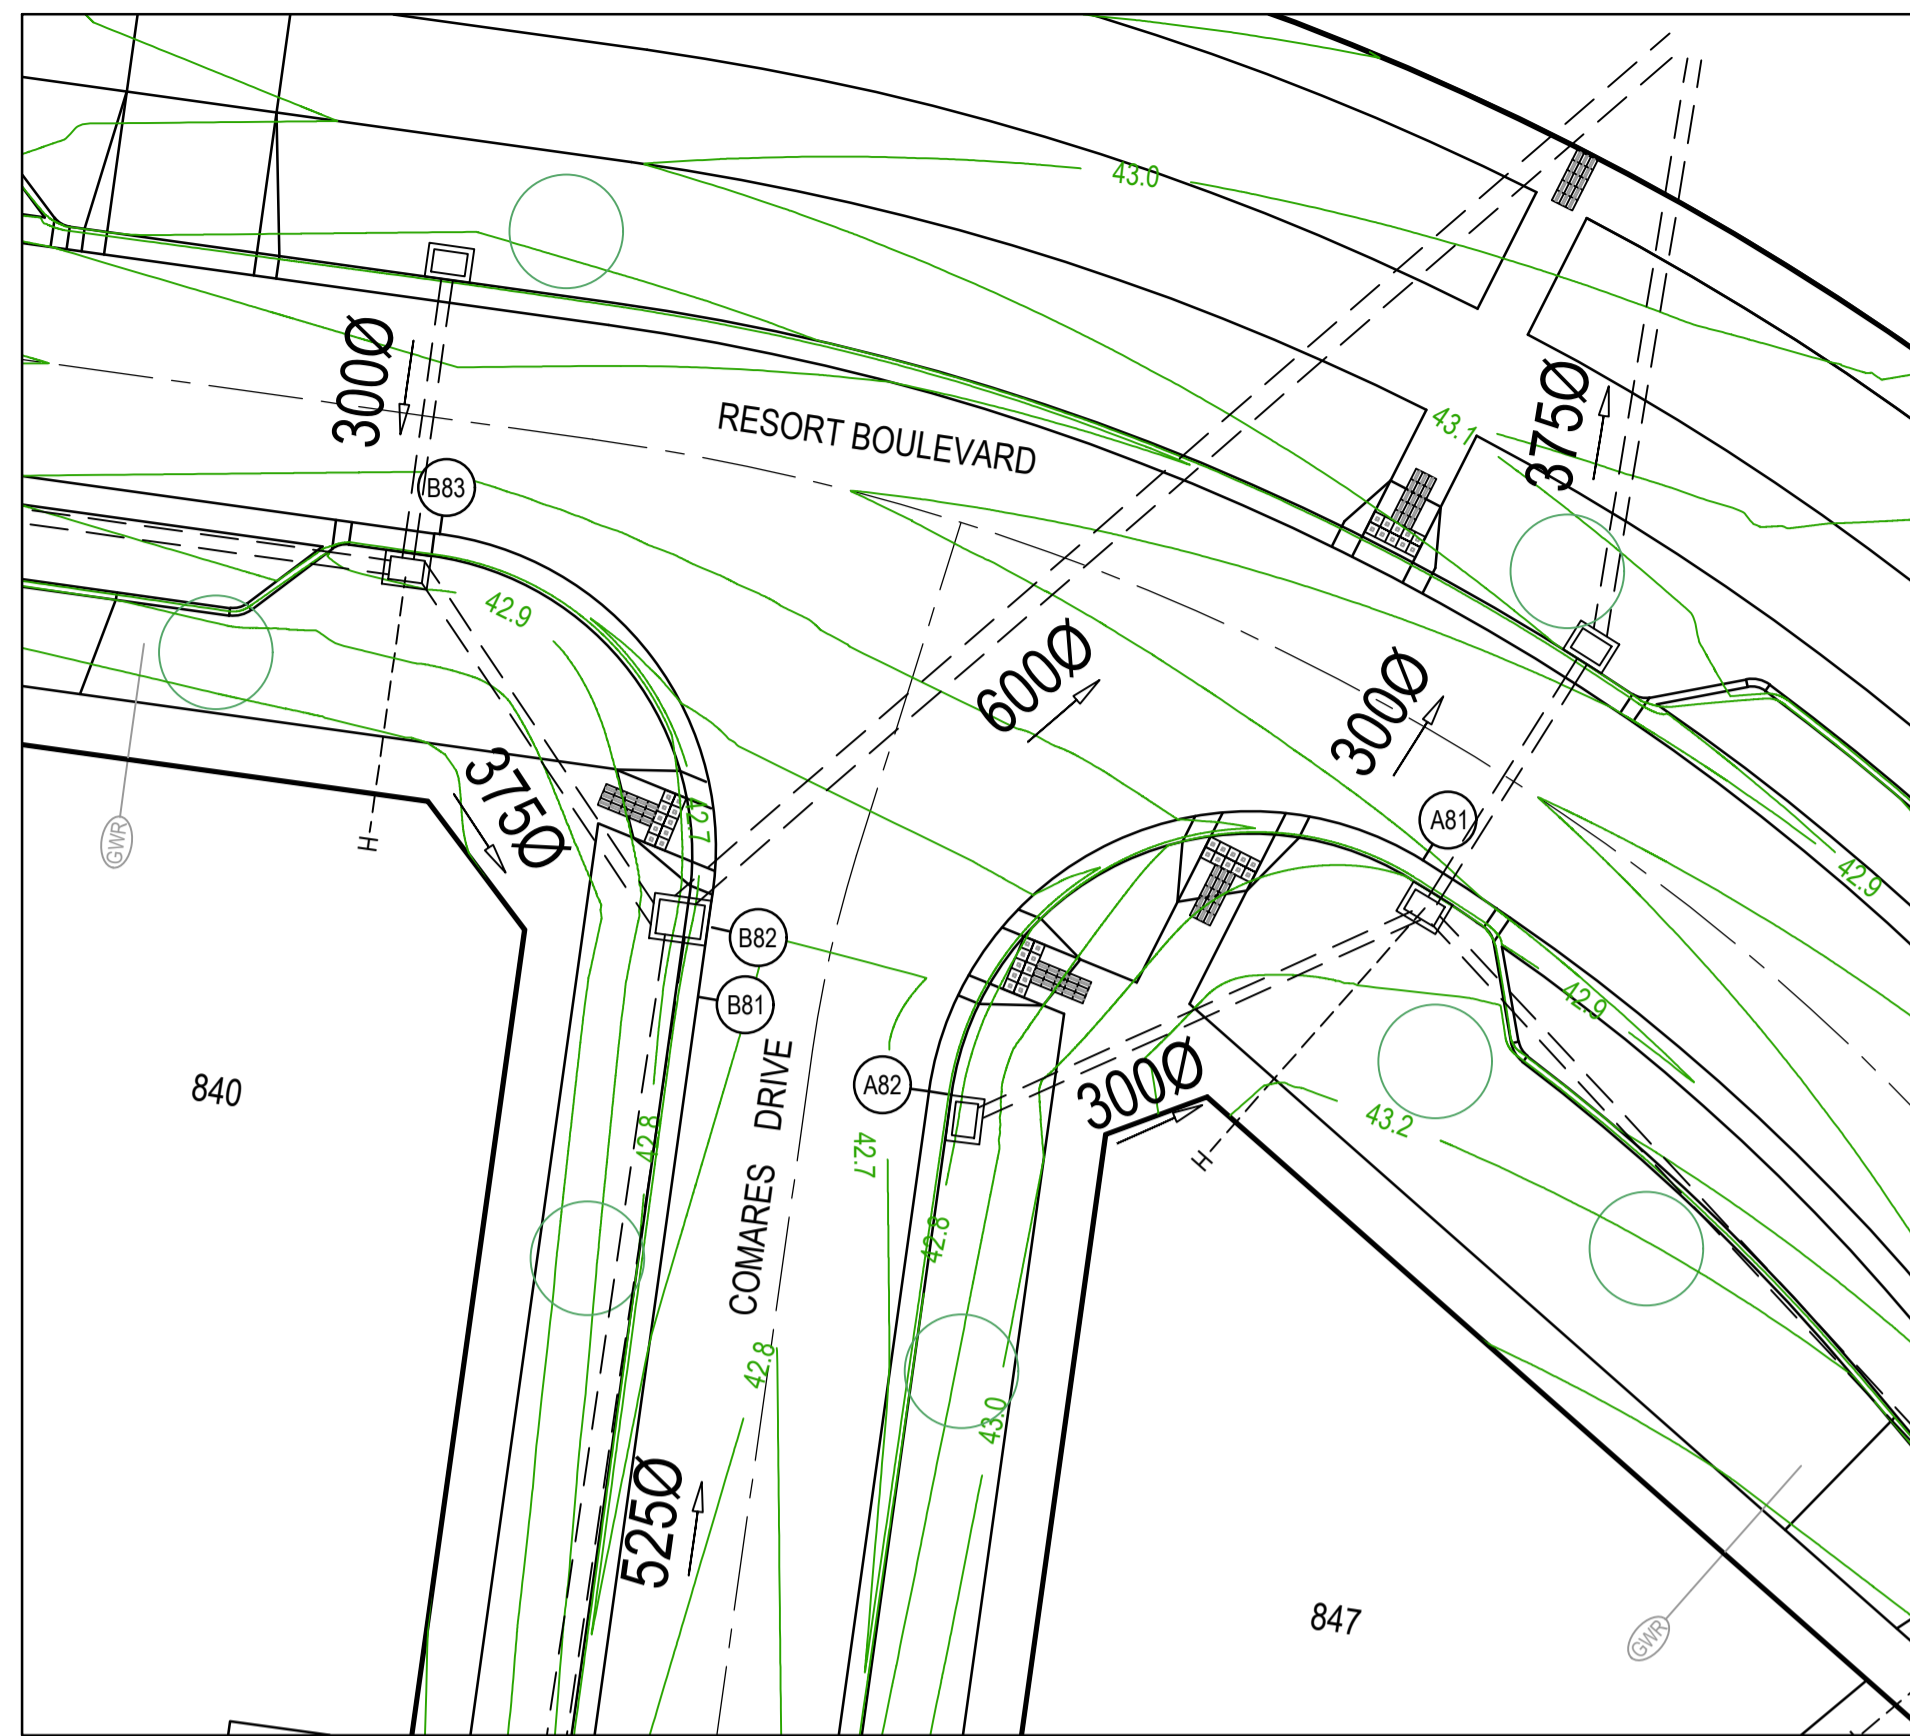

LEGEND - INTERSECTION DETAIL PLAN
ALL PROPOSED, FUTURE & EXISTING SERVICE LOCATIONS ARE SHOWN INDICATIVELY


	STORMWATER DRAIN, PIT & PROPERTY INLET
	MAIN DRAIN
	SEWER & MAINTENANCE STRUCTURES
	HOUSE DRAIN
	SERVICE CONDUITS
	TACTILE PAVERS
	EXISTING STORMWATER DRAIN
	EXISTING MAIN DRAIN
	EXISTING SEWER & MAINTENANCE STRUCTURES
	EXISTING SERVICE CONDUITS
	EXISTING TACTILE PAVERS
	FUTURE STORMWATER DRAIN
	FUTURE MAIN DRAIN
	FUTURE SEWER & MAINTENANCE STRUCTURES
	FUTURE HOUSE DRAIN
	FUTURE SERVICE CONDUITS
	FUTURE TACTILE PAVERS
	EXISTING RETAINING WALL
	RETAINING WALL
	FUTURE RETAINING WALL
	EDGE STRIP, SUBSOIL DRAIN, 'NO ROAD' SIGN & BARRIER
	PERMANENT SURVEY MARK
	TEMPORARY BENCH MARK
	PROPOSED DRIVEWAY & FOOTPATH

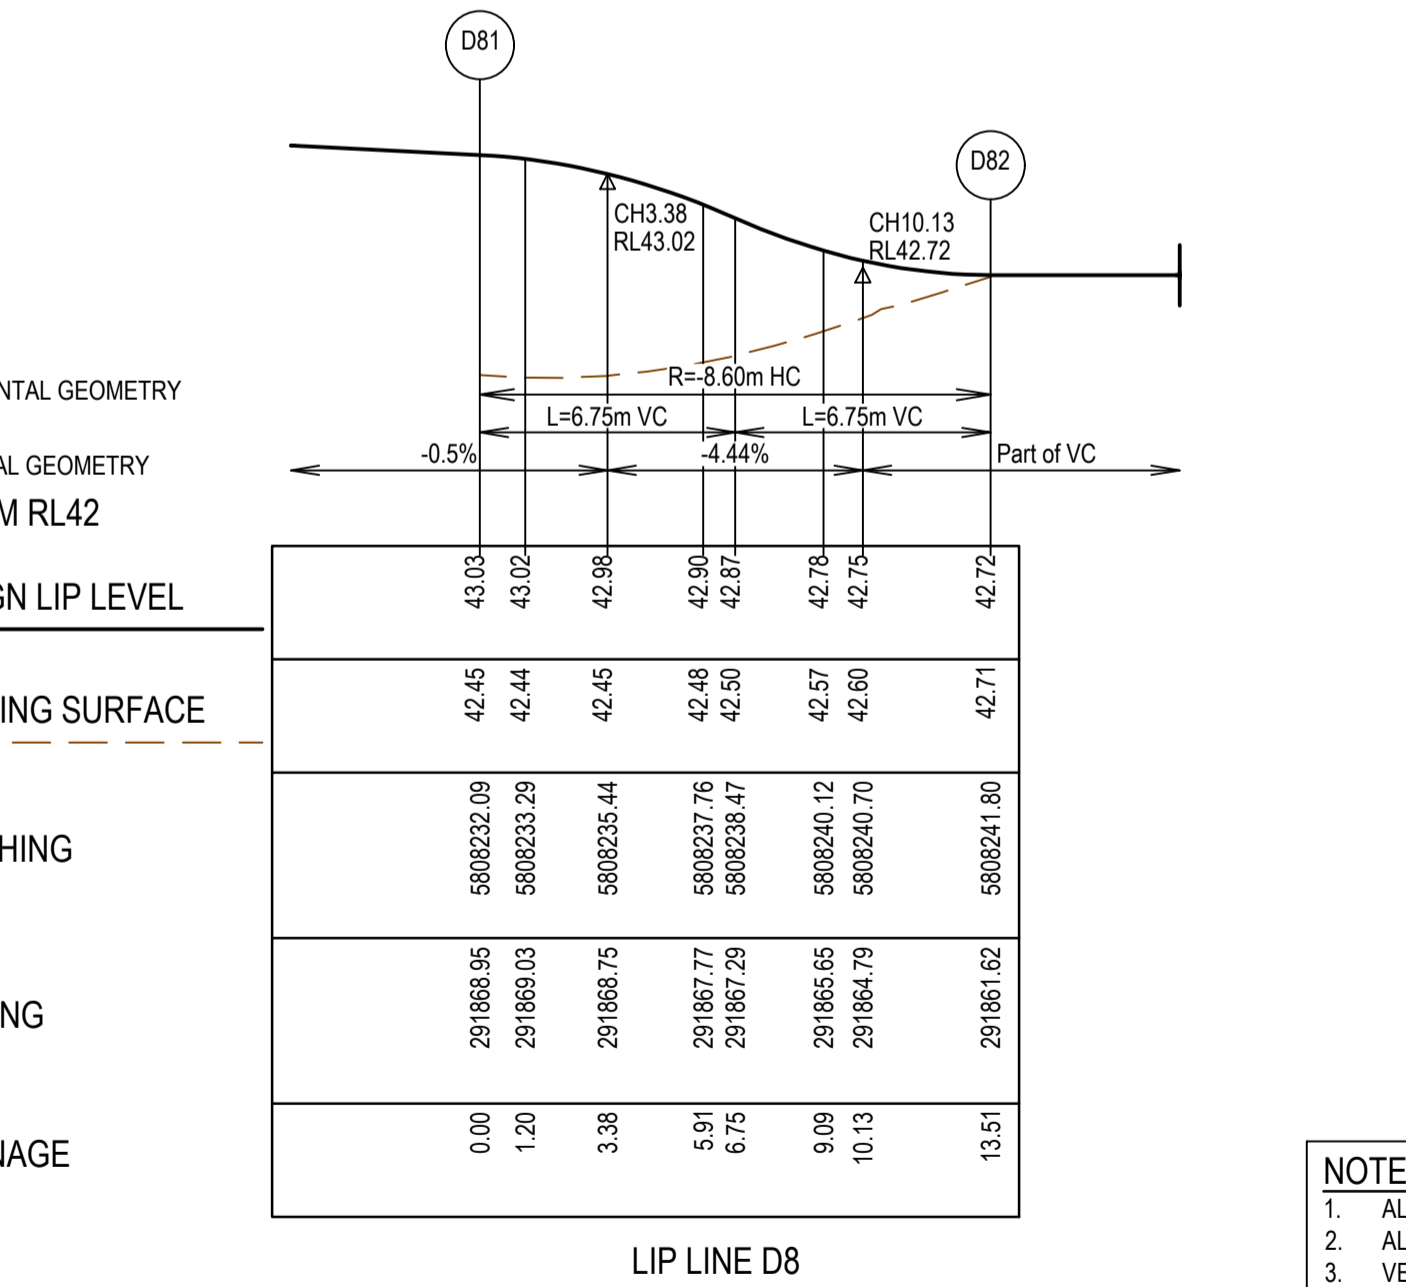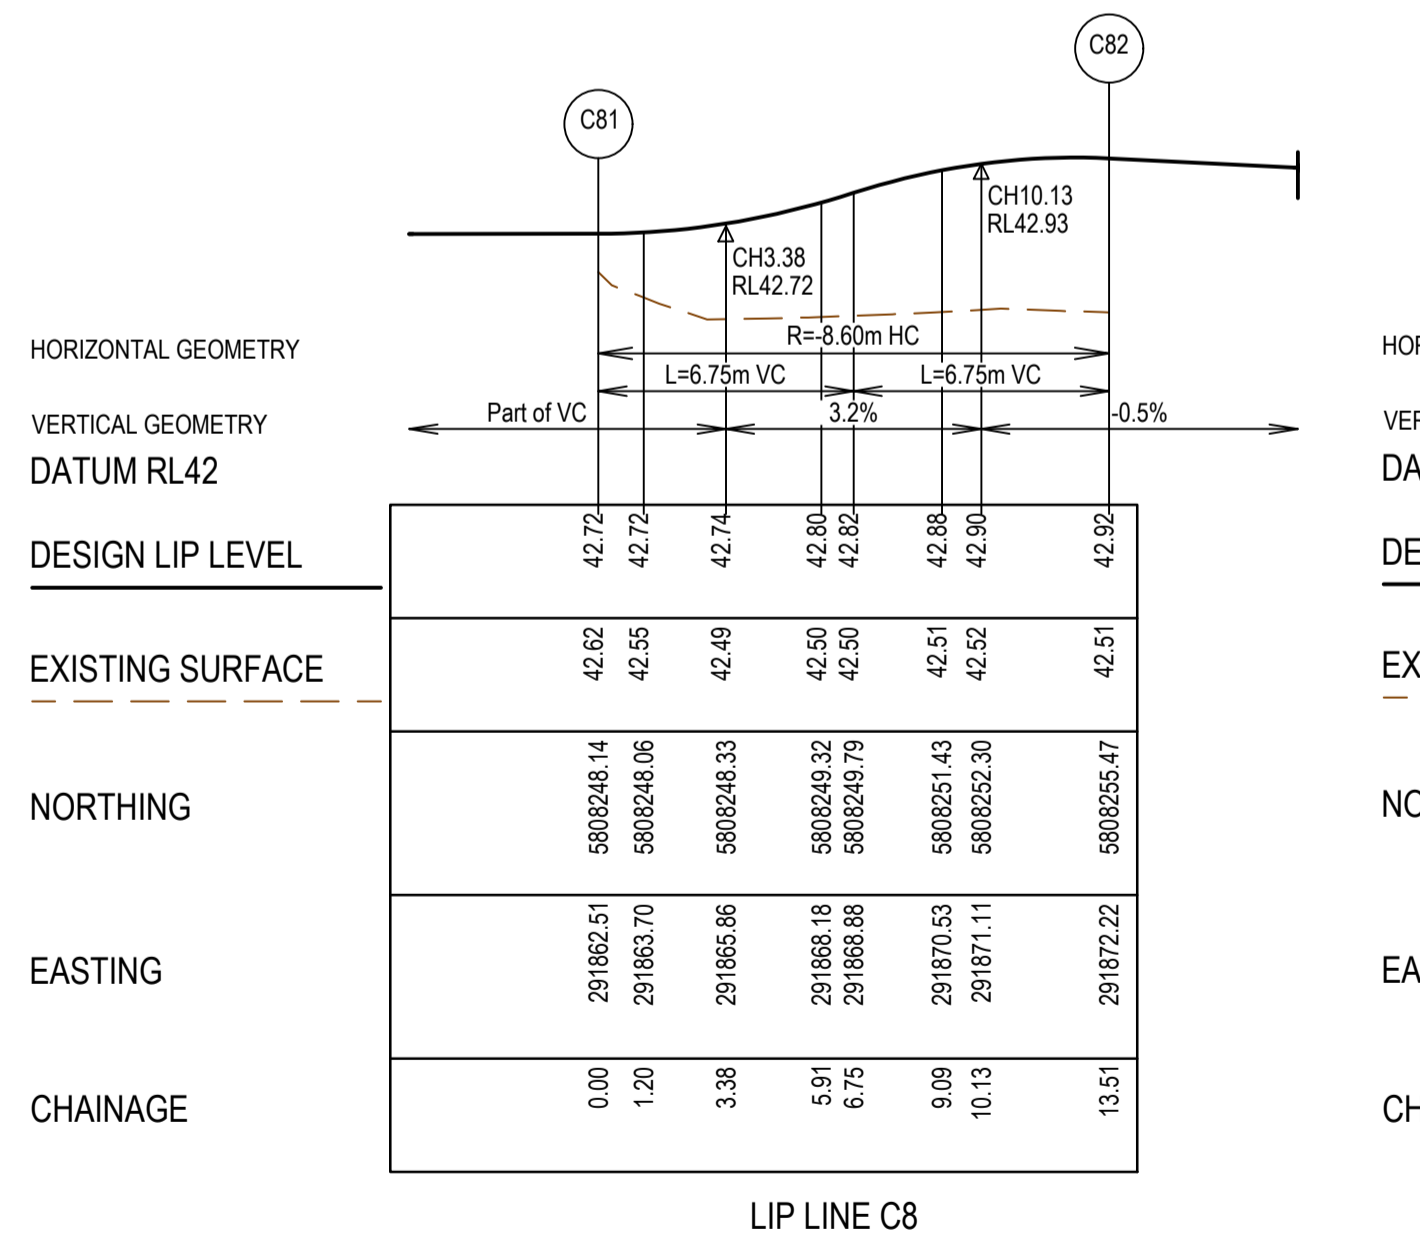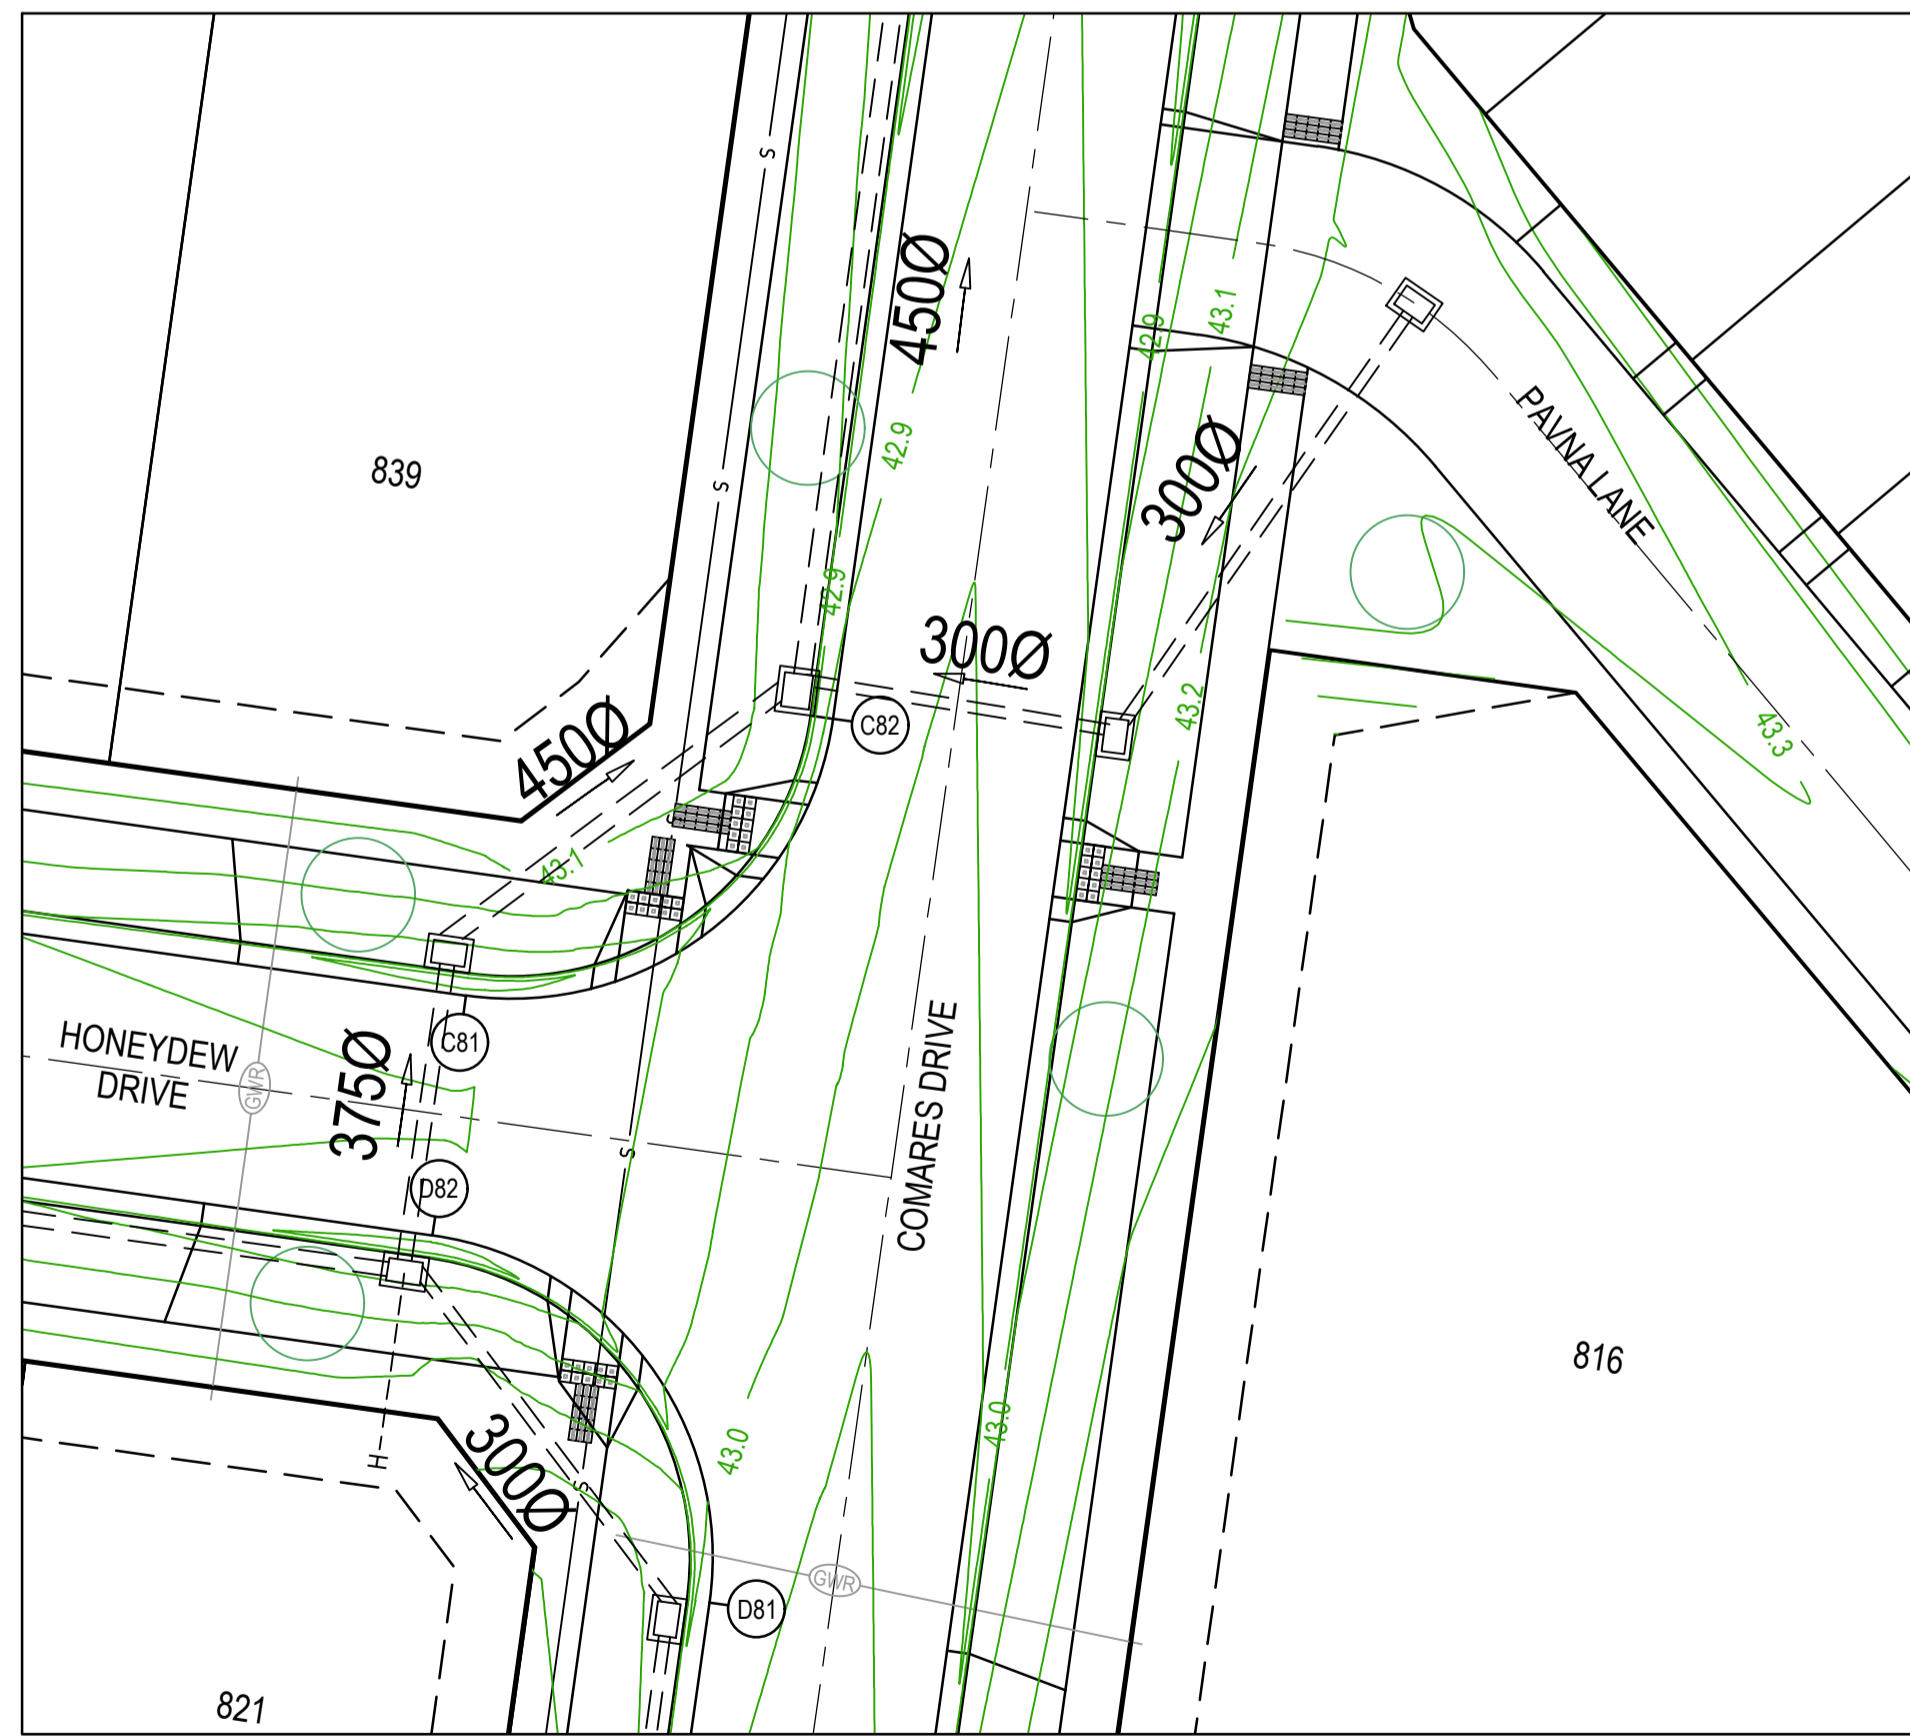

- NOTES**
- ALL VEHICLE CROSSINGS AND PRAM CROSSINGS TO BE MINIMUM OF 0.75m FROM PITS.
 - ALL PRAM CROSSINGS TO BE MINIMUM OF 2.0m FROM VEHICLE CROSSINGS.
 - VEHICLE EXCLUSION MEASURES BETWEEN ROAD RESERVE AND RESERVE TO FORM PART OF THE LANDSCAPE WORKS.
 - INDUSTRIAL DRIVEWAYS TO COUNCIL RESERVES TO BE PROVIDED AS PART OF LANDSCAPE WORKS.
 - SHARE PATH THROUGH CREEK CORRIDOR TO FORM PART OF LANDSCAPE WORKS.

AS CONSTRUCTED PLANS
The purpose of these as-constructed plans is to update the design drawings to show significant changes which occurred during construction. Note that the levels shown on these plans are design levels, and have not been verified by survey. All information shown on these plans should be verified on site. SMEC Australia Pty Ltd accept no responsibility for loss or damages resulting from the inappropriate usage of these plans.

Quality Management - ISO 9001
 OHS Management - AS/NZS 4801
 Environmental Management - ISO 14001
 PLAN OF SUB. NO. PS841640V/S16
 PERMIT REF. NO. WYP10107_17.02
AS CONSTRUCTED

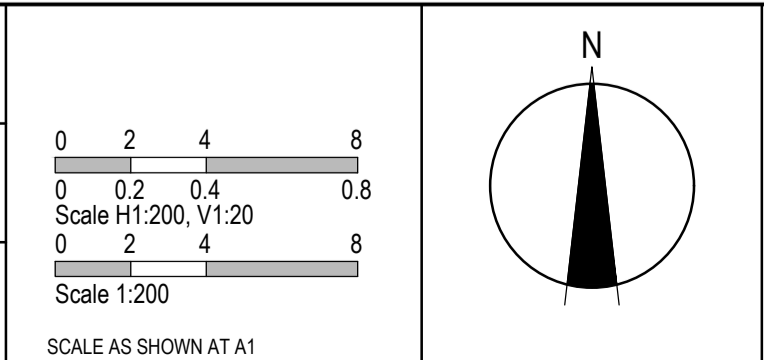

SMEC
Member of the Surlana Jurong Group
ABN 47 065 475 149
Collins Square, Tower 4, Level 20, 727 Collins St
Melbourne, VIC 3008
Ph 03 9514 1500




ALAMORA
Tarnait

Alamora - Stage 8, Sayers Road, Tarnait
Wyndham City Council
Road and Drainage
Intersection Detail Plan - 1

MELWAYS REF 234 D6	PROJECT / DRAWING No. 2070E-A08-181	SHEET No. 04 of 20	REVISION 3
------------------------------	---	------------------------------	----------------------

LEGEND - INTERSECTION DETAIL PLAN
ALL PROPOSED, FUTURE & EXISTING SERVICE LOCATIONS ARE SHOWN INDICATIVELY

	STORMWATER DRAIN, PIT & PROPERTY INLET
	MAIN DRAIN
	SEWER & MAINTENANCE STRUCTURES
	HOUSE DRAIN
	SERVICE CONDUITS
	TACTILE PAVERS
	EXISTING STORMWATER DRAIN
	EXISTING MAIN DRAIN
	EXISTING SEWER & MAINTENANCE STRUCTURES
	EXISTING SERVICE CONDUITS
	EXISTING TACTILE PAVERS
	FUTURE STORMWATER DRAIN
	FUTURE MAIN DRAIN
	FUTURE SEWER & MAINTENANCE STRUCTURES
	FUTURE HOUSE DRAIN
	FUTURE SERVICE CONDUITS
	FUTURE TACTILE PAVERS
	EXISTING RETAINING WALL
	RETAINING WALL
	FUTURE RETAINING WALL
	EDGE STRIP, SUBSOIL DRAIN, 'NO ROAD' SIGN & BARRIER
	PERMANENT SURVEY MARK
	TEMPORARY BENCH MARK
	PROPOSED DRIVEWAY & FOOTPATH

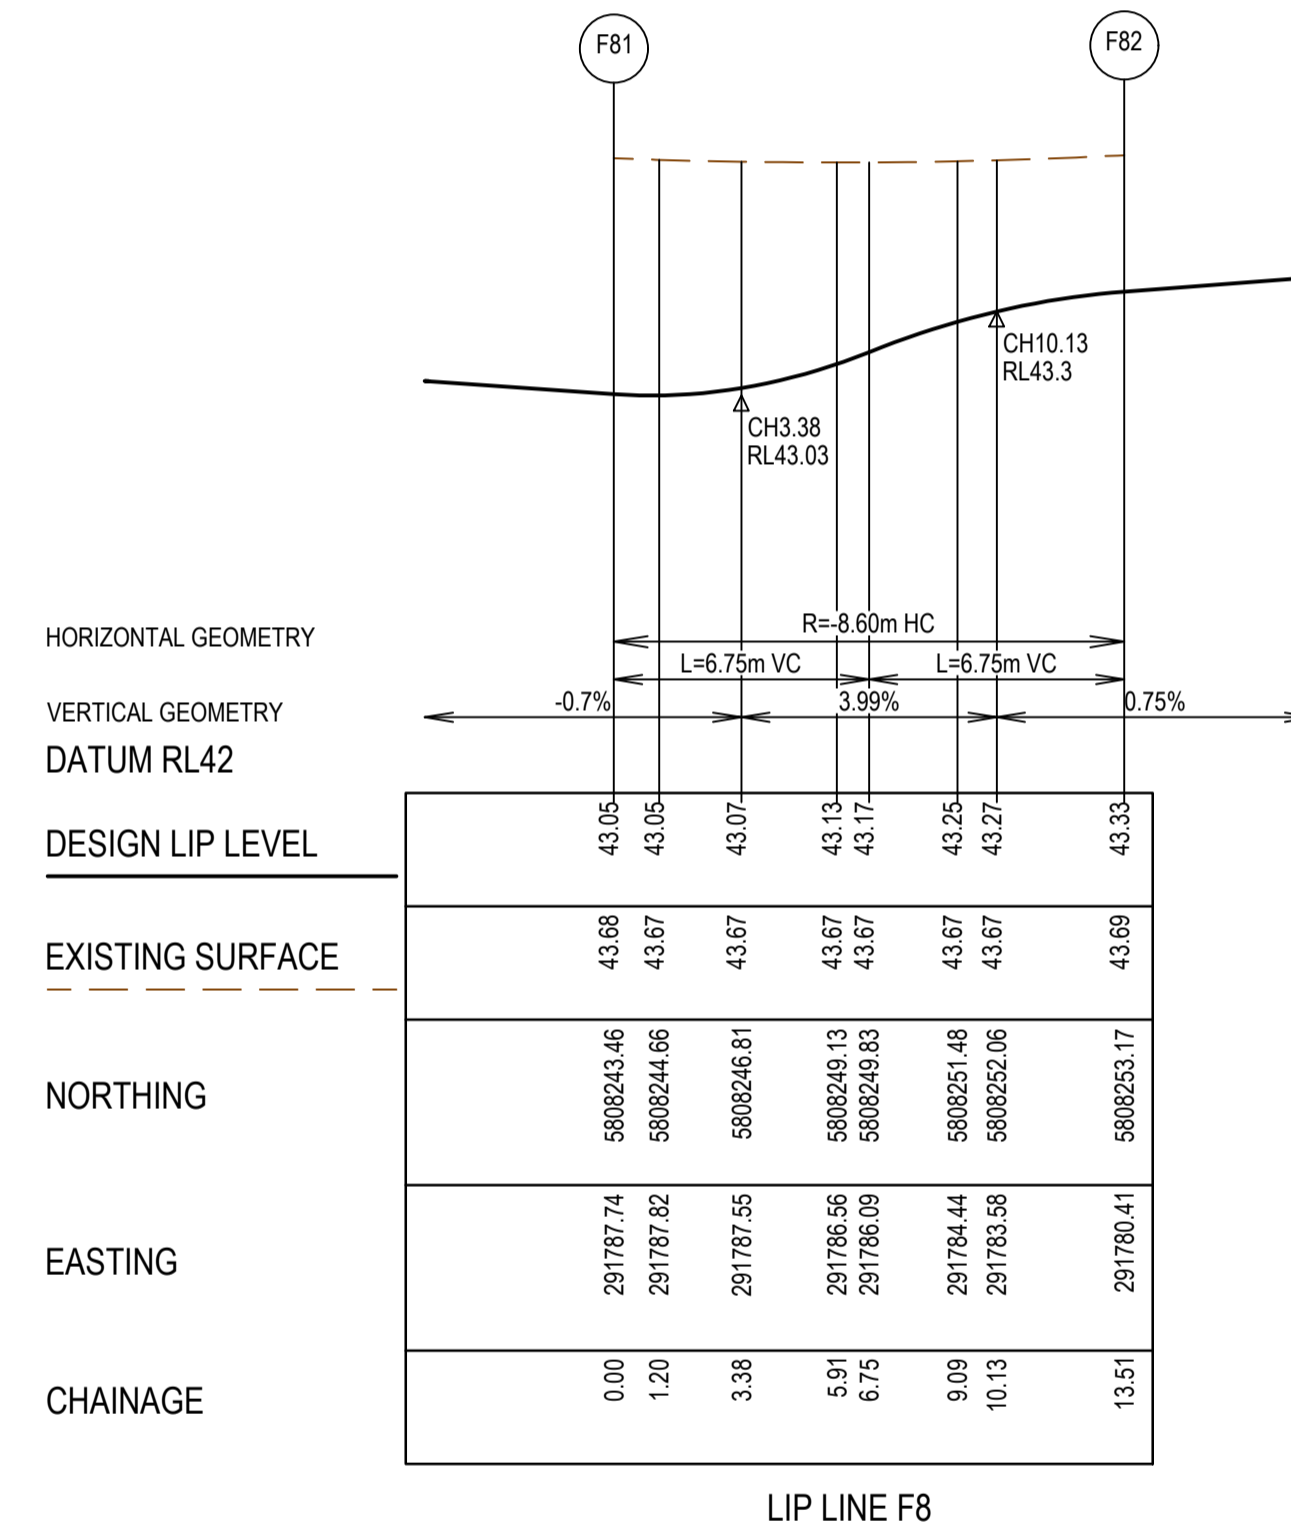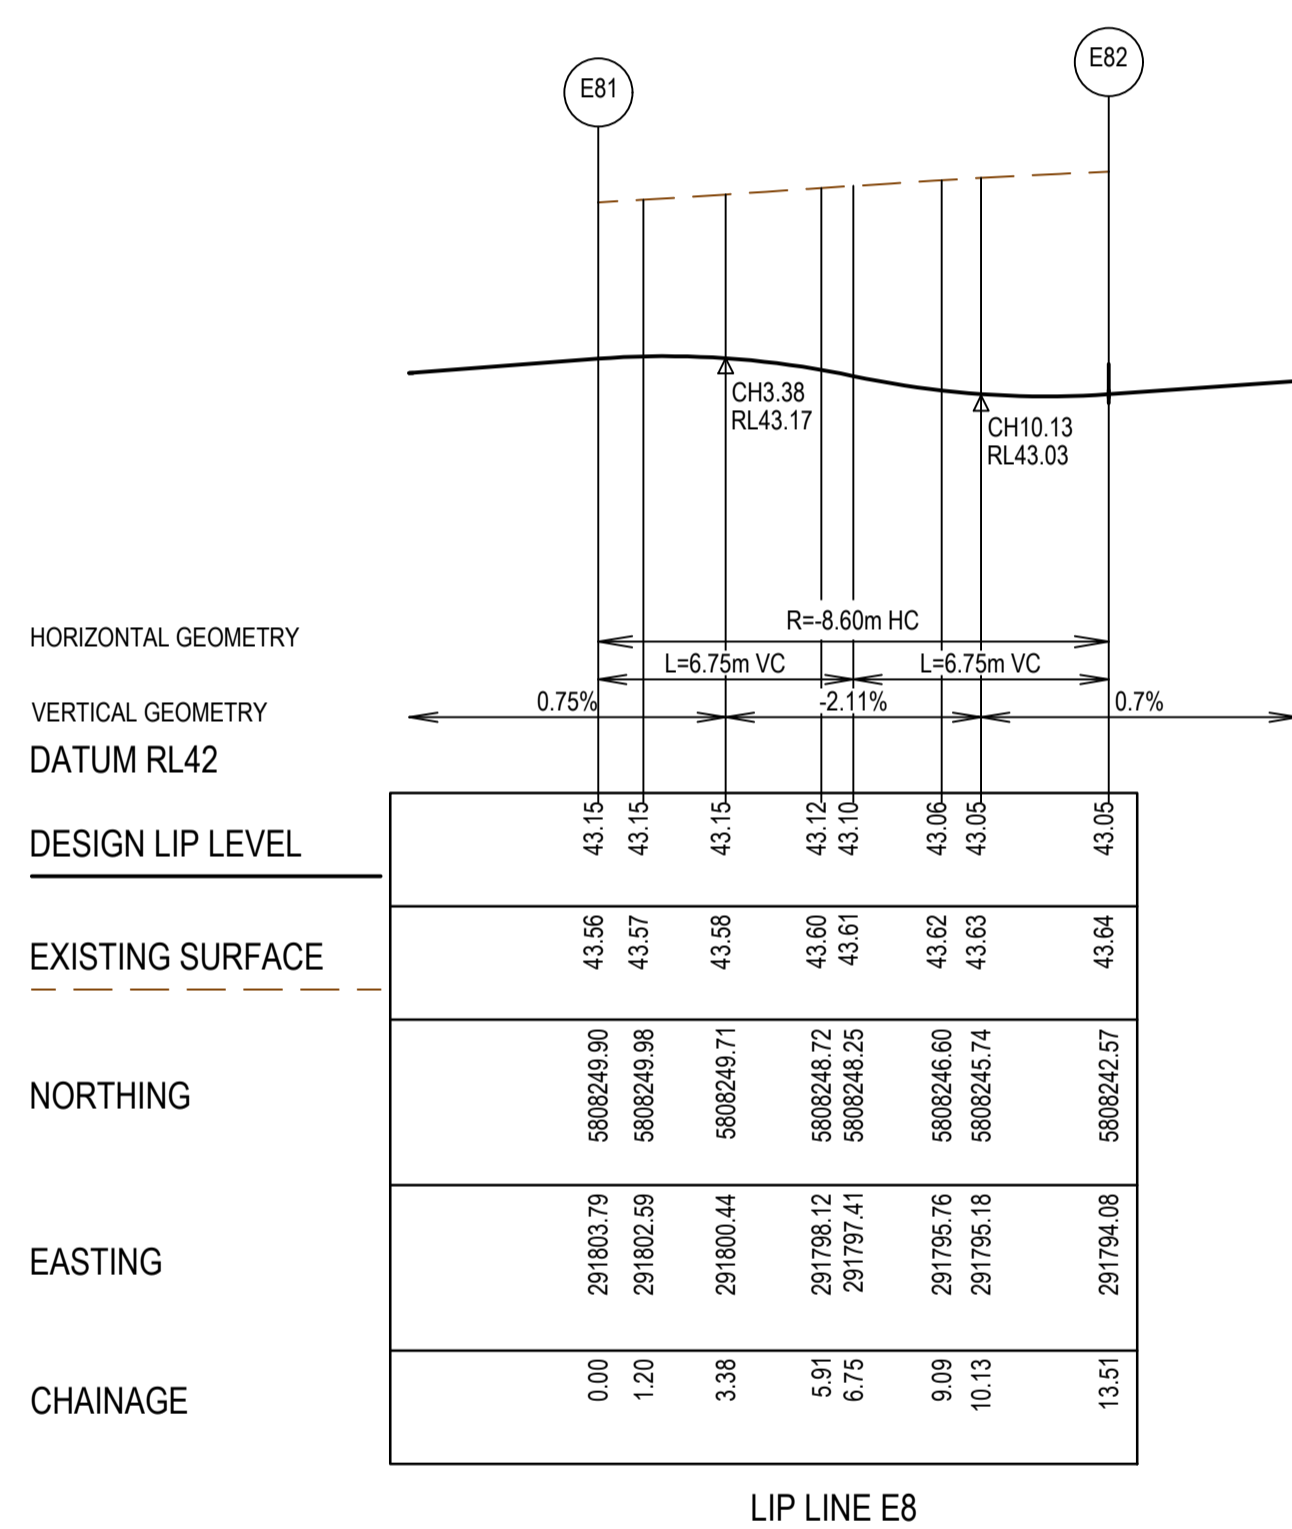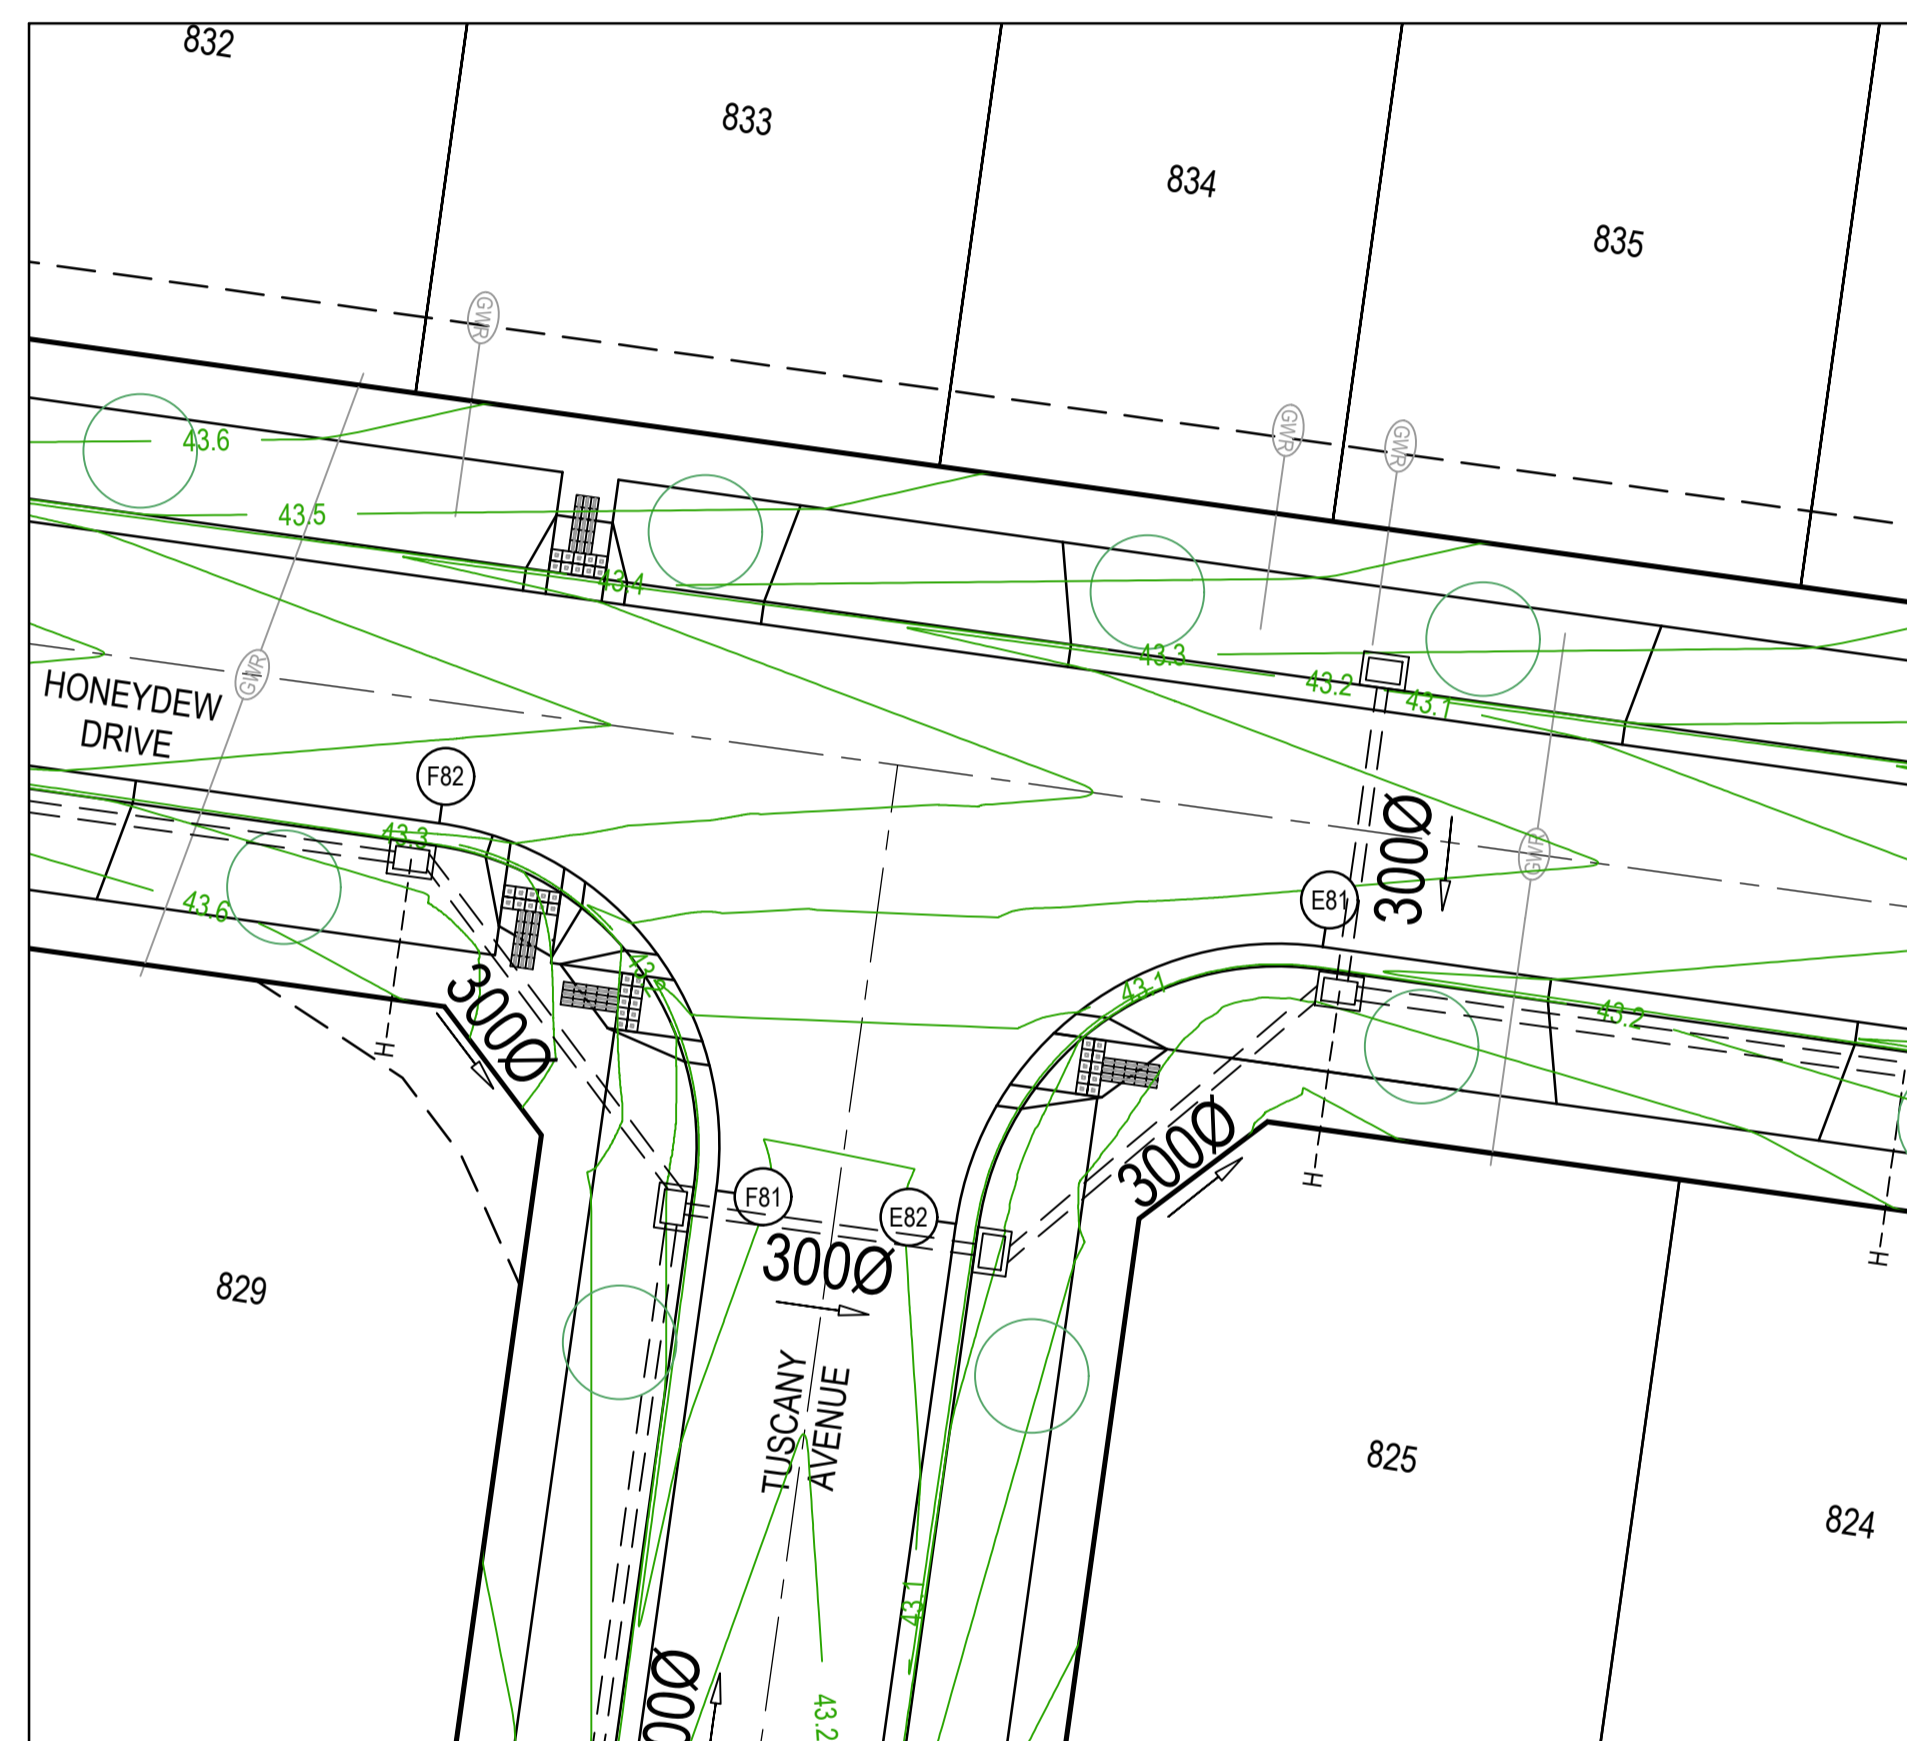

- NOTES**
- ALL VEHICLE CROSSINGS AND PRAM CROSSINGS TO BE MINIMUM OF 0.75m FROM PITS.
 - ALL PRAM CROSSINGS TO BE MINIMUM OF 2.0m FROM VEHICLE CROSSINGS.
 - VEHICLE EXCLUSION MEASURES BETWEEN ROAD RESERVE AND RESERVE TO FORM PART OF THE LANDSCAPE WORKS.
 - INDUSTRIAL DRIVEWAYS TO COUNCIL RESERVES TO BE PROVIDED AS PART OF LANDSCAPE WORKS.
 - SHARE PATH THROUGH CREEK CORRIDOR TO FORM PART OF LANDSCAPE WORKS.

AS CONSTRUCTED PLANS
The purpose of these as-constructed plans is to update the design drawings to show significant changes which occurred during construction. Note that the levels shown on these plans are design levels, and have not been verified by survey. All information shown on these plans should be verified on site. SMEC Australia Pty Ltd accept no responsibility for loss or damages resulting from the inappropriate usage of these plans.


Quality Management ISO 9001
OH&S Management AS/NZS 4801
Environmental Management ISO 14001

Global-Mark.com.au®

PLAN OF SUB. NO.
PS41640V/S16
PERMIT REF. NO.
WYP10107_17.02

AS CONSTRUCTED

SCALE AS SHOWN AT A1



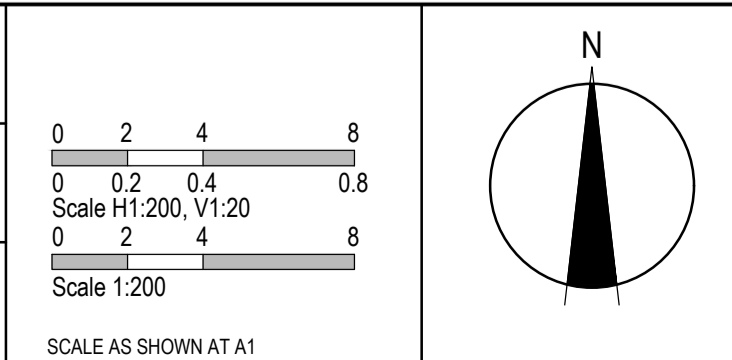


SMEC
Member of the Surlana Jurong Group
ABN 47 065 475 149
Collins Square, Tower 4, Level 20, 727 Collins St
Melbourne, VIC 3008
Ph 03 9514 1500



Alamora - Stage 8, Sayers Road, Tarnait
Wyndham City Council
Road and Drainage
Intersection Detail Plan - 2

MELWAYS REF 234 D6	PROJECT / DRAWING No. 2070E-A08-182	SHEET No. 05 of 20	REVISION 2
-----------------------	--	-----------------------	---------------

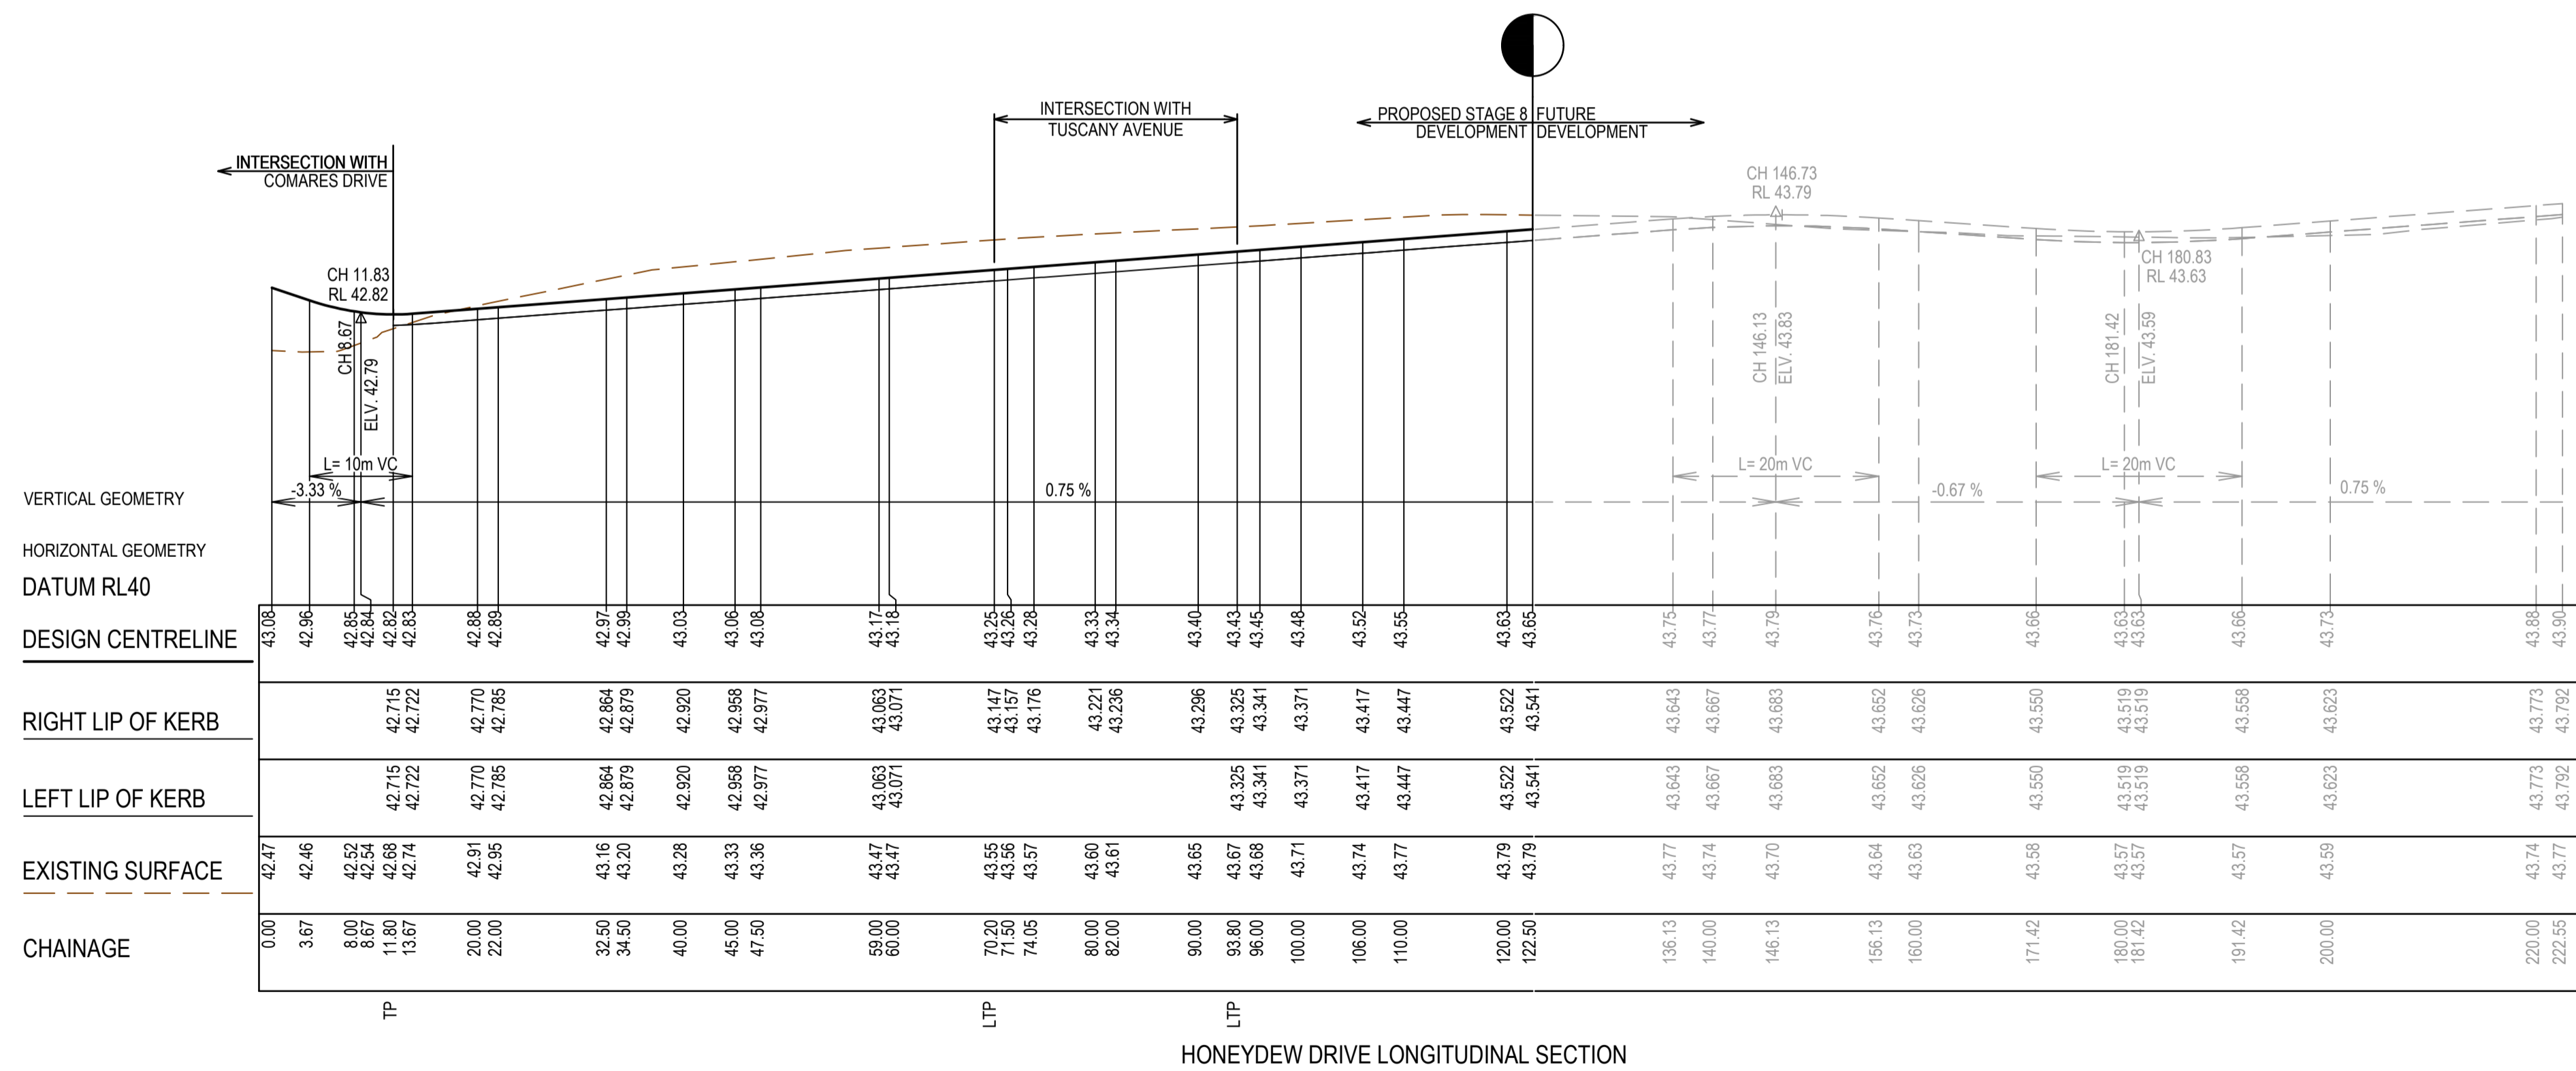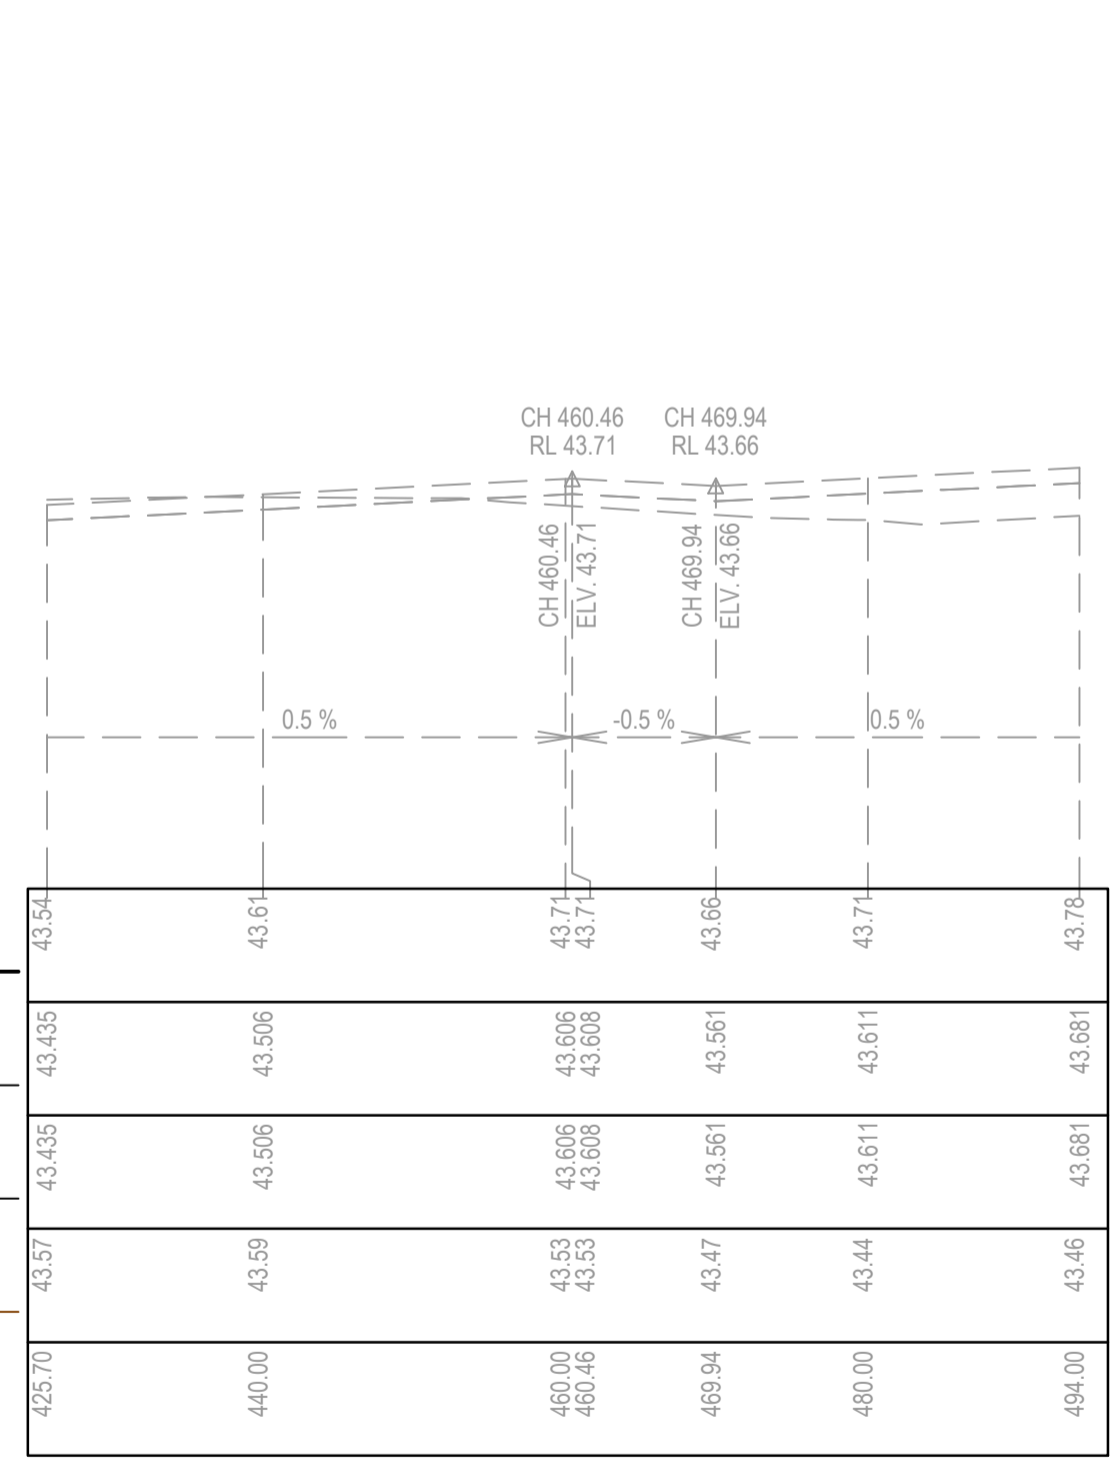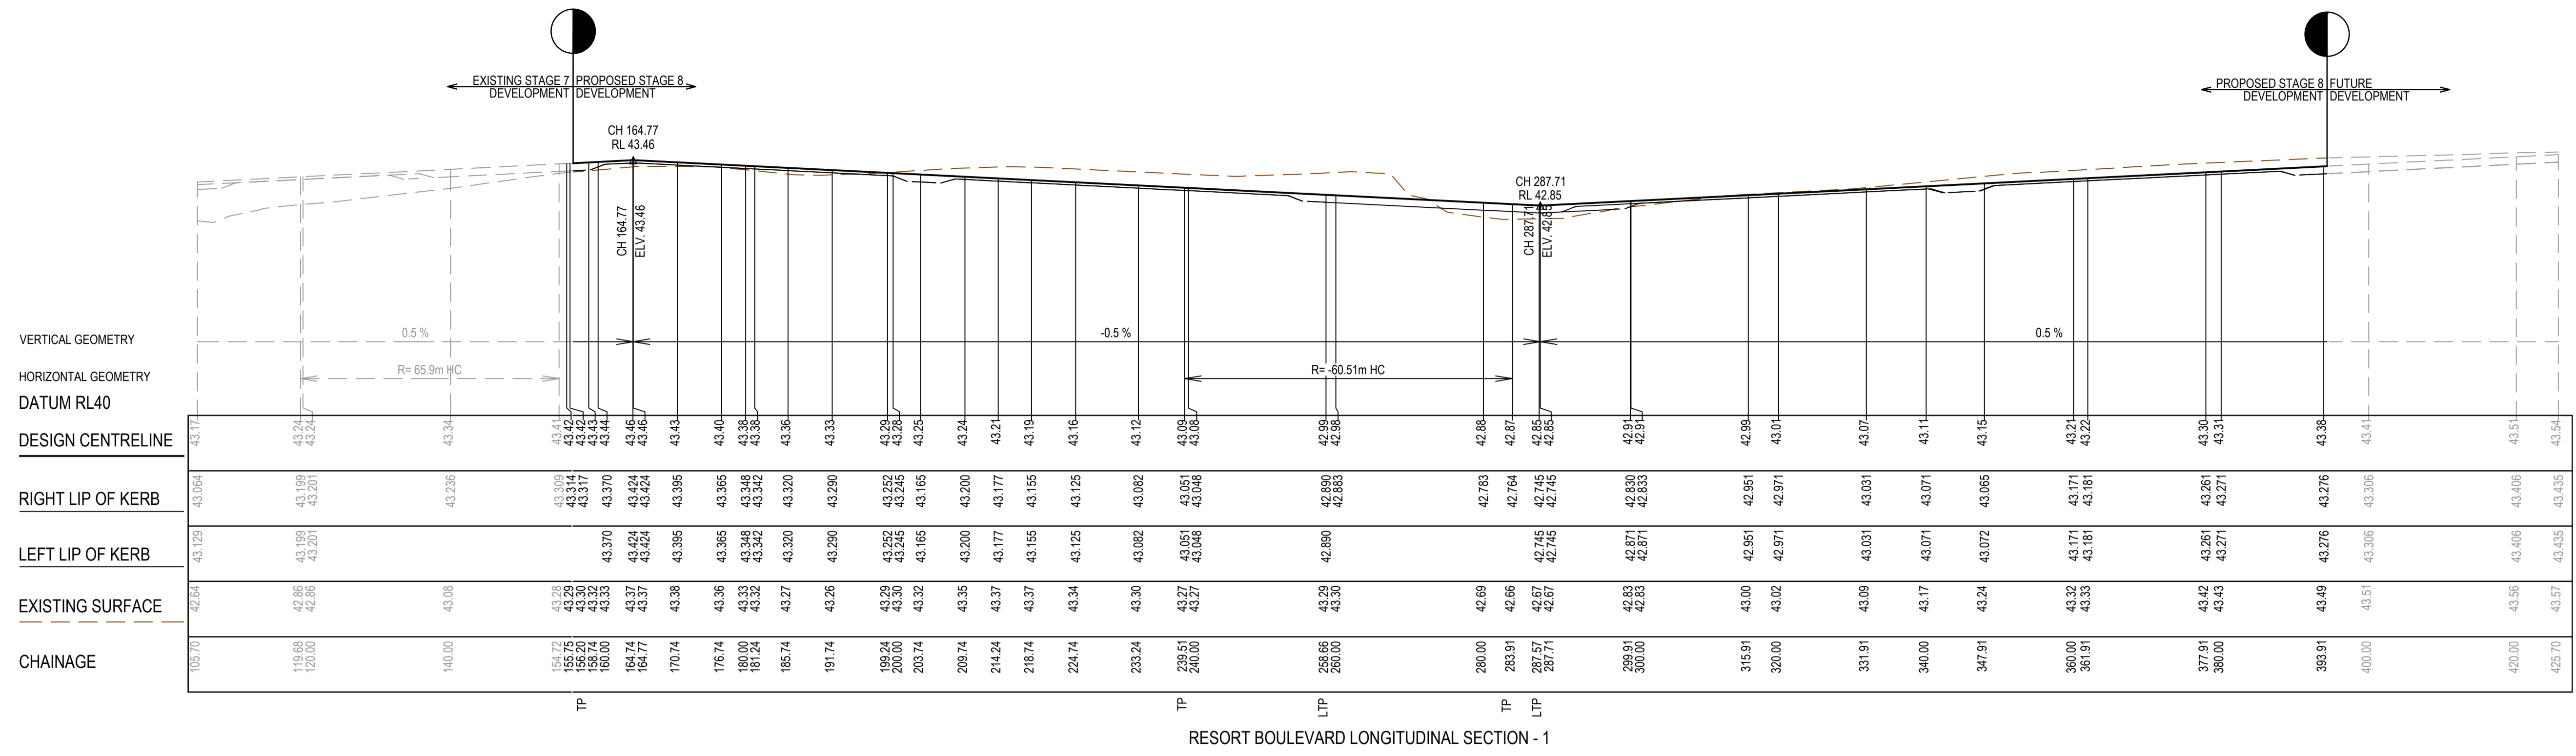

RESORT BOULEVARD LONGITUDINAL SECTION - 2

HONEYDEW DRIVE LONGITUDINAL SECTION

AS CONSTRUCTED PLANS

The purpose of these as-constructed plans is to update the design drawings to show significant changes which occurred during construction. Note that the levels shown on these plans are design levels, and have not been verified by survey. All information shown on these plans should be verified on site. SMEC Australia Pty Ltd accept no responsibility for loss or damages resulting from the inappropriate usage of these plans.

AS CONSTRUCTED

PLAN OF SUB. NO.
PS841640V/S16

PERMIT REF. NO.
WYP10107_17.02

SCALE AS SHOWN AT 1




Member of the **Surbana Jurong Group**

Collins Square, Tower 4, Level 20, 727 Collins St
Melbourne, VIC 3008
Ph 03 9514 1500

Alamora - Stage 8, Sayers Road, Tarnait
Wyndham City Council
Road and Drainage
Longitudinal Sections - 1

MELWAYS REF 234 D6	PROJECT / DRAWING No. 2070E-A08-201	SHEET No. 06 of 20	REVISION 3
------------------------------	---	------------------------------	----------------------

© SMEC 2021. Digital information supplied by this office is for information only, in the event of any discrepancies this should be discussed with the superintendent. Set out should be carried out in accordance with Relevant Authority standard drawings or as nominated by SMEC.

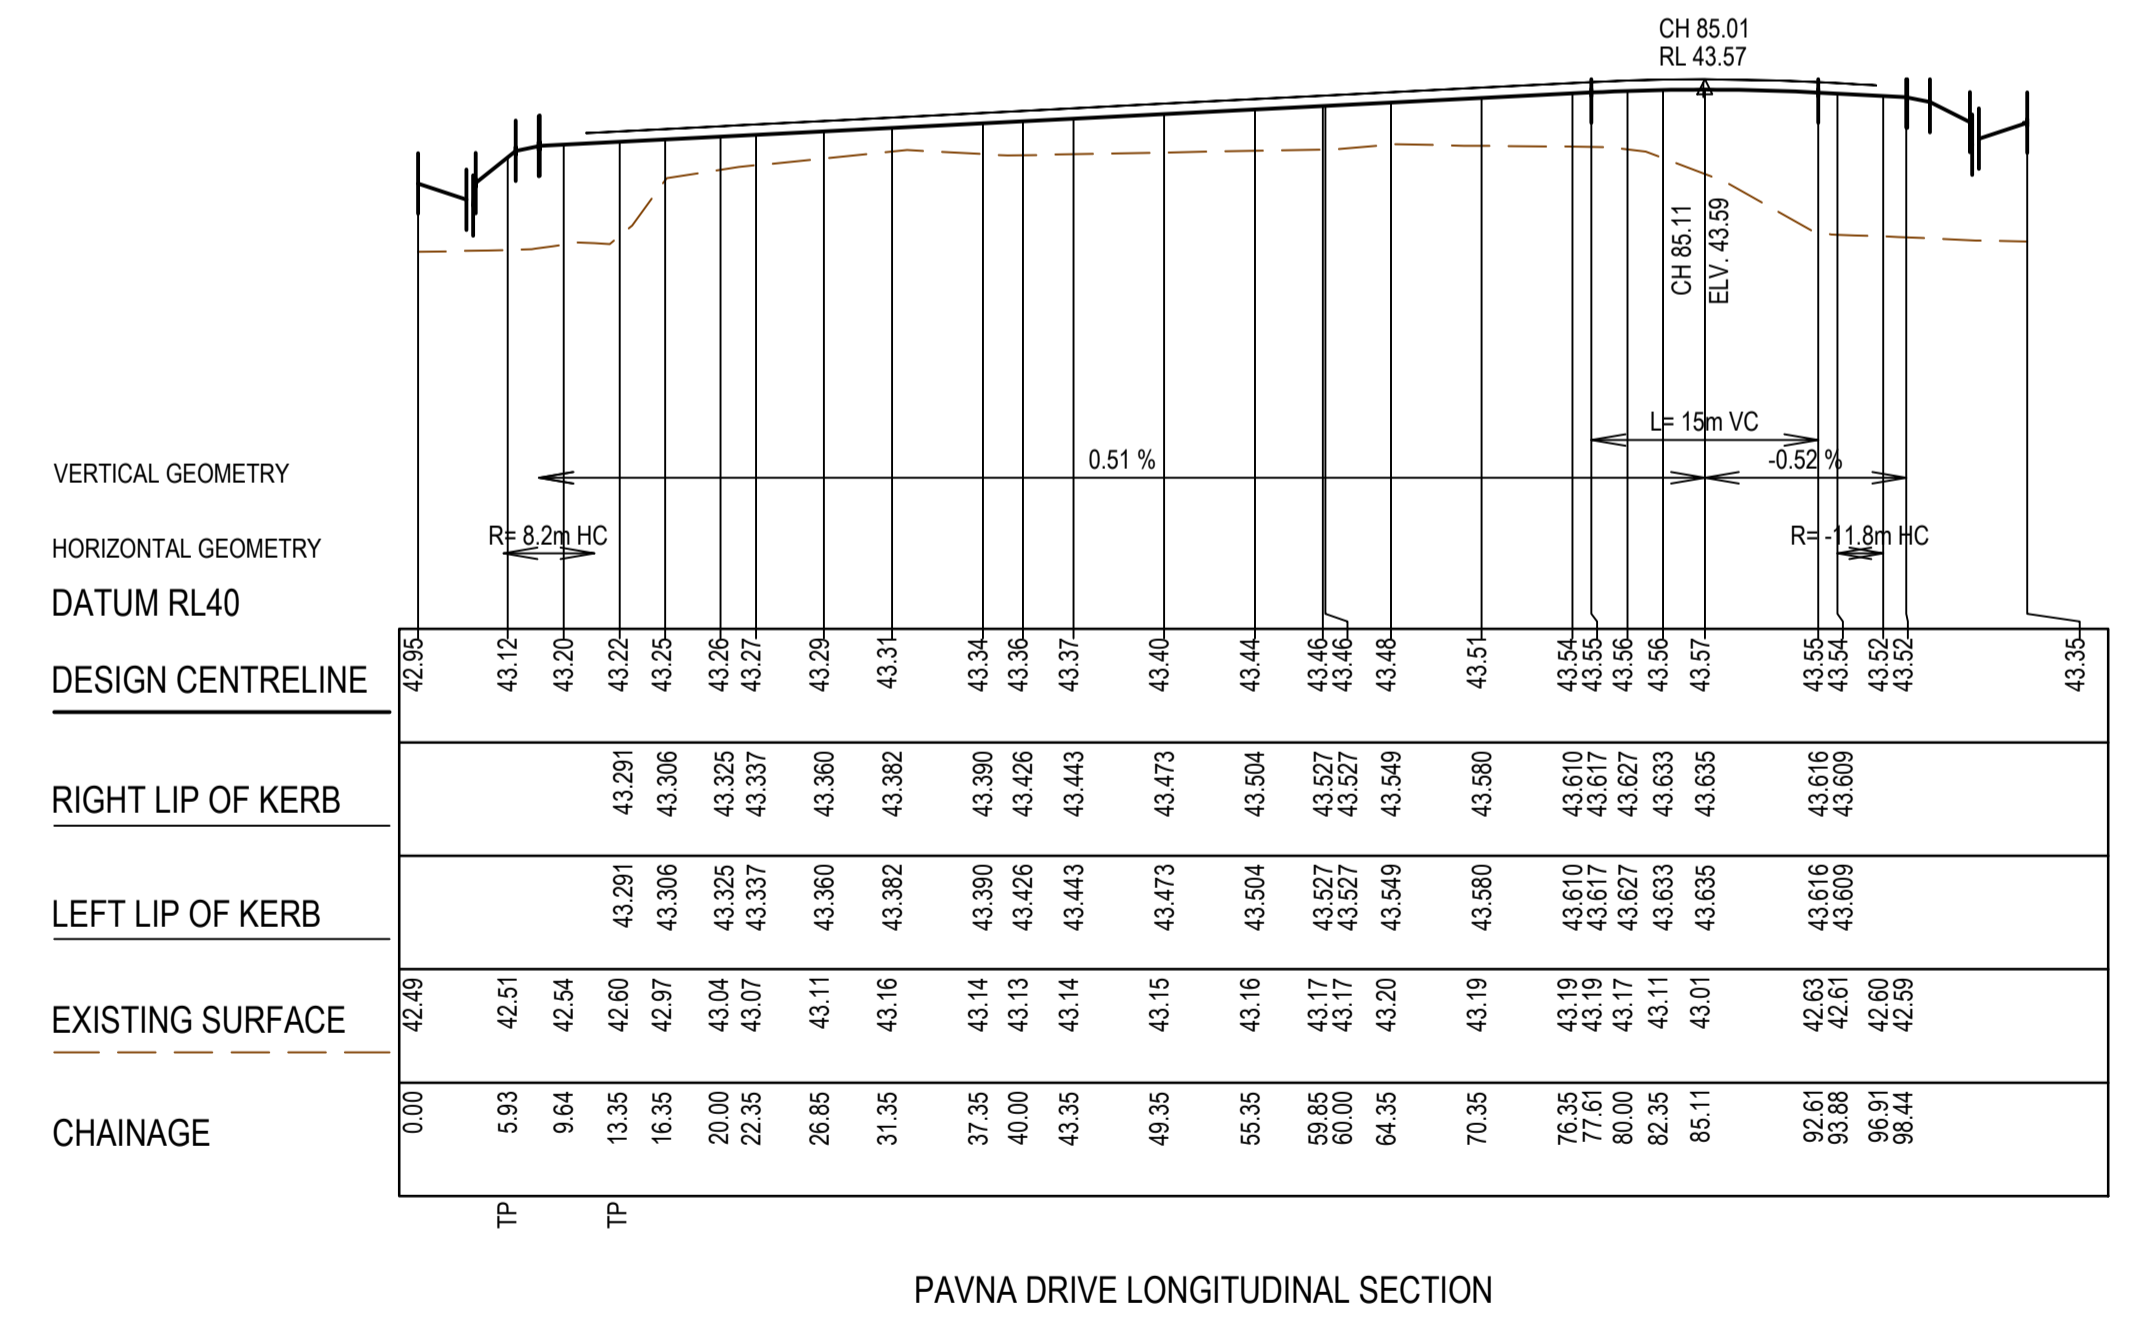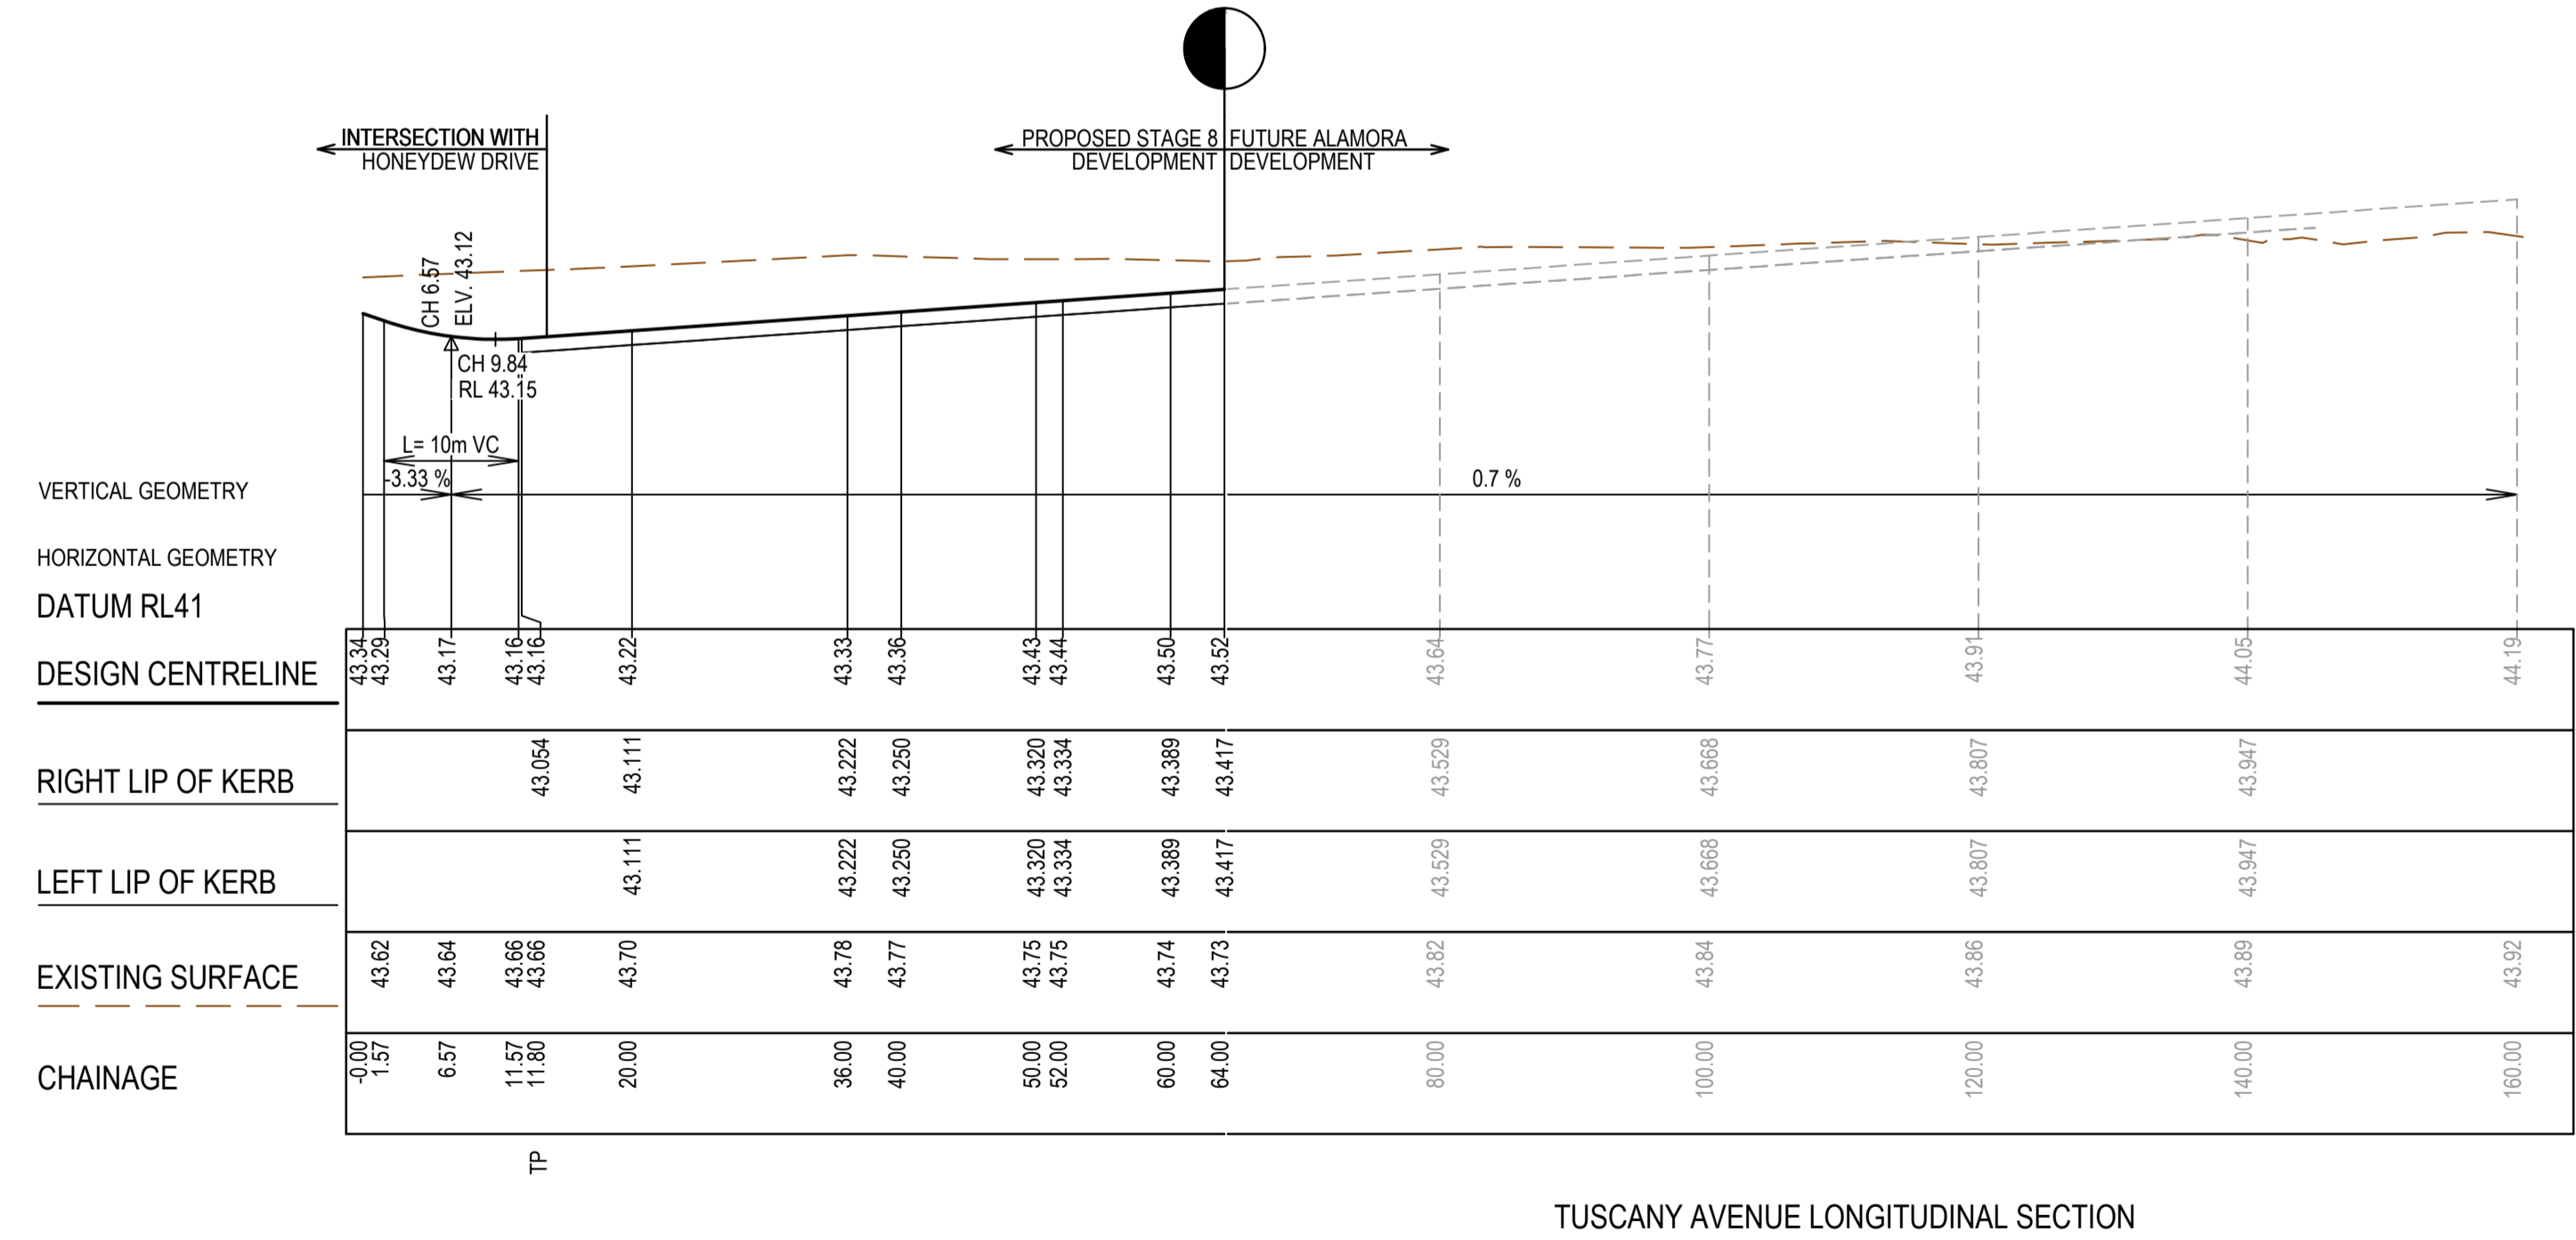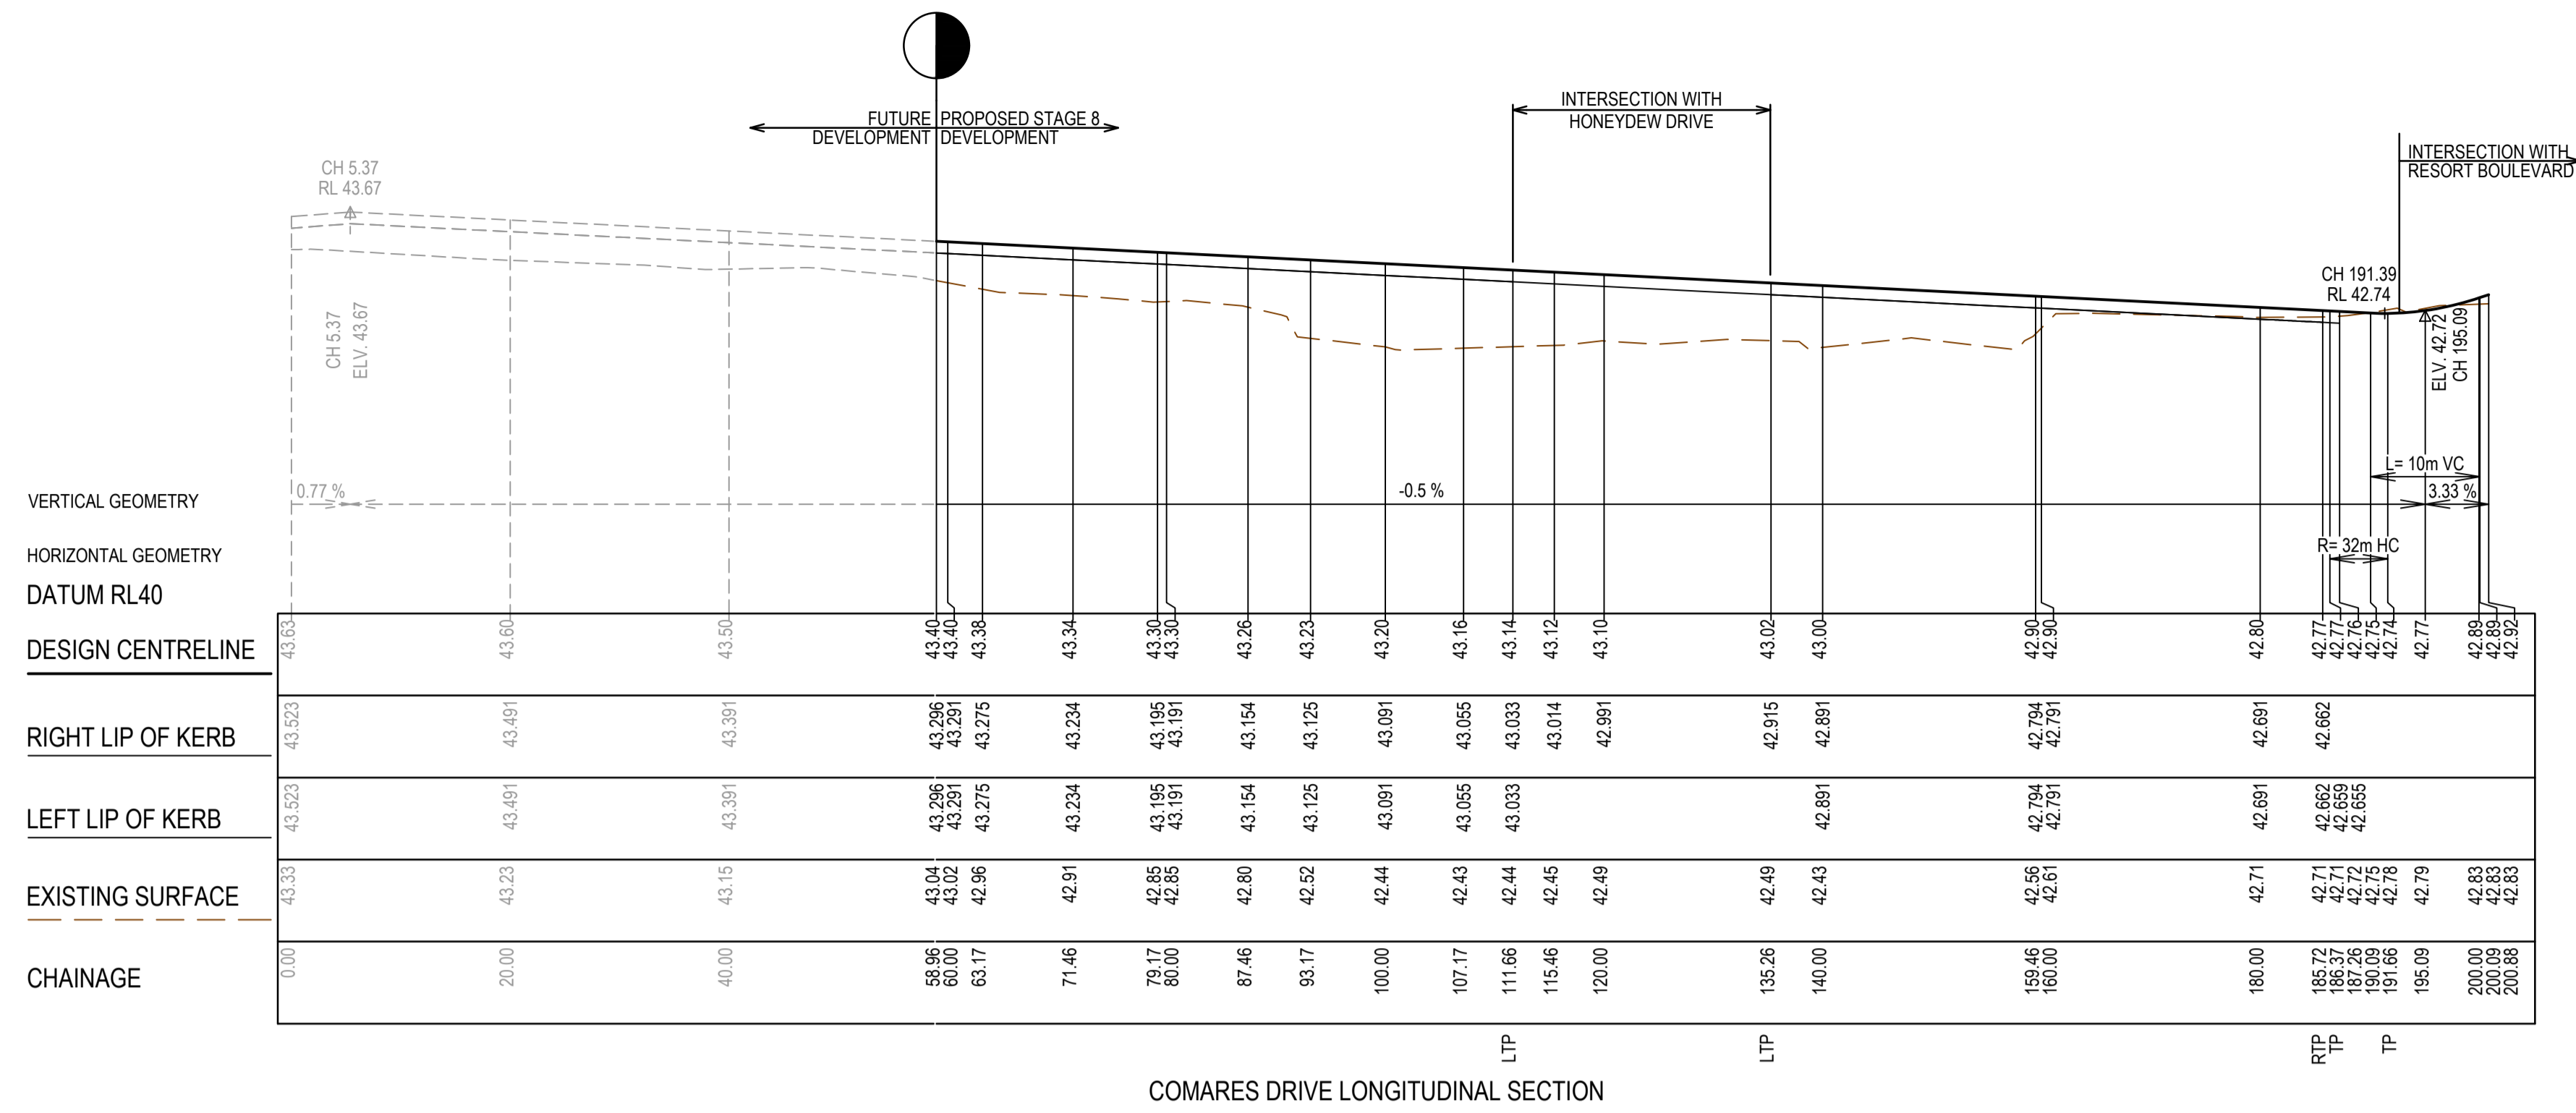

AS CONSTRUCTED PLANS
 The purpose of these as-constructed plans is to update the design drawings to show significant changes which occurred during construction. Note that the levels shown on these plans are design levels, and have not been verified by survey. All information shown on these plans should be verified on site. SMEC Australia Pty Ltd accept no responsibility for loss or damages resulting from the inappropriate usage of these plans.

Quality Management - ISO 9001
 OHS Management - AS/NZS 4801
 Environmental Management - ISO 14001
 Global-Mark.com.au®

AS CONSTRUCTED

PLAN OF SUB. NO. PS841640V/S16
 PERMIT REF. NO. WYP10107_17.02

Scale 0 5 10 20
 0 0.5 1 2
 Scale H1:500, V1:50
 SCALE AS SHOWN AT 1



SMEC
 Member of the Surlana Jurong Group
 ABN 47 065 475 149
 Collins Square, Tower 4, Level 20, 727 Collins St
 Melbourne, VIC 3008
 Ph 03 9514 1500

ALAMORA
 Tarnait


Alamora - Stage 8, Sayers Road, Tarnait
 Wyndham City Council
 Road and Drainage
 Longitudinal Sections - 2

MELBOURNE REF: 234 D6
 PROJECT / DRAWING No: 2070E-A08-202
 SHEET No: 07 of 20
 REVISION: 3


STRUCTURAL FILL REQUIRED UNDER PAVEMENT AND FOOTPATHS WHERE CONSTRUCTED ABOVE EXISTING SURFACE

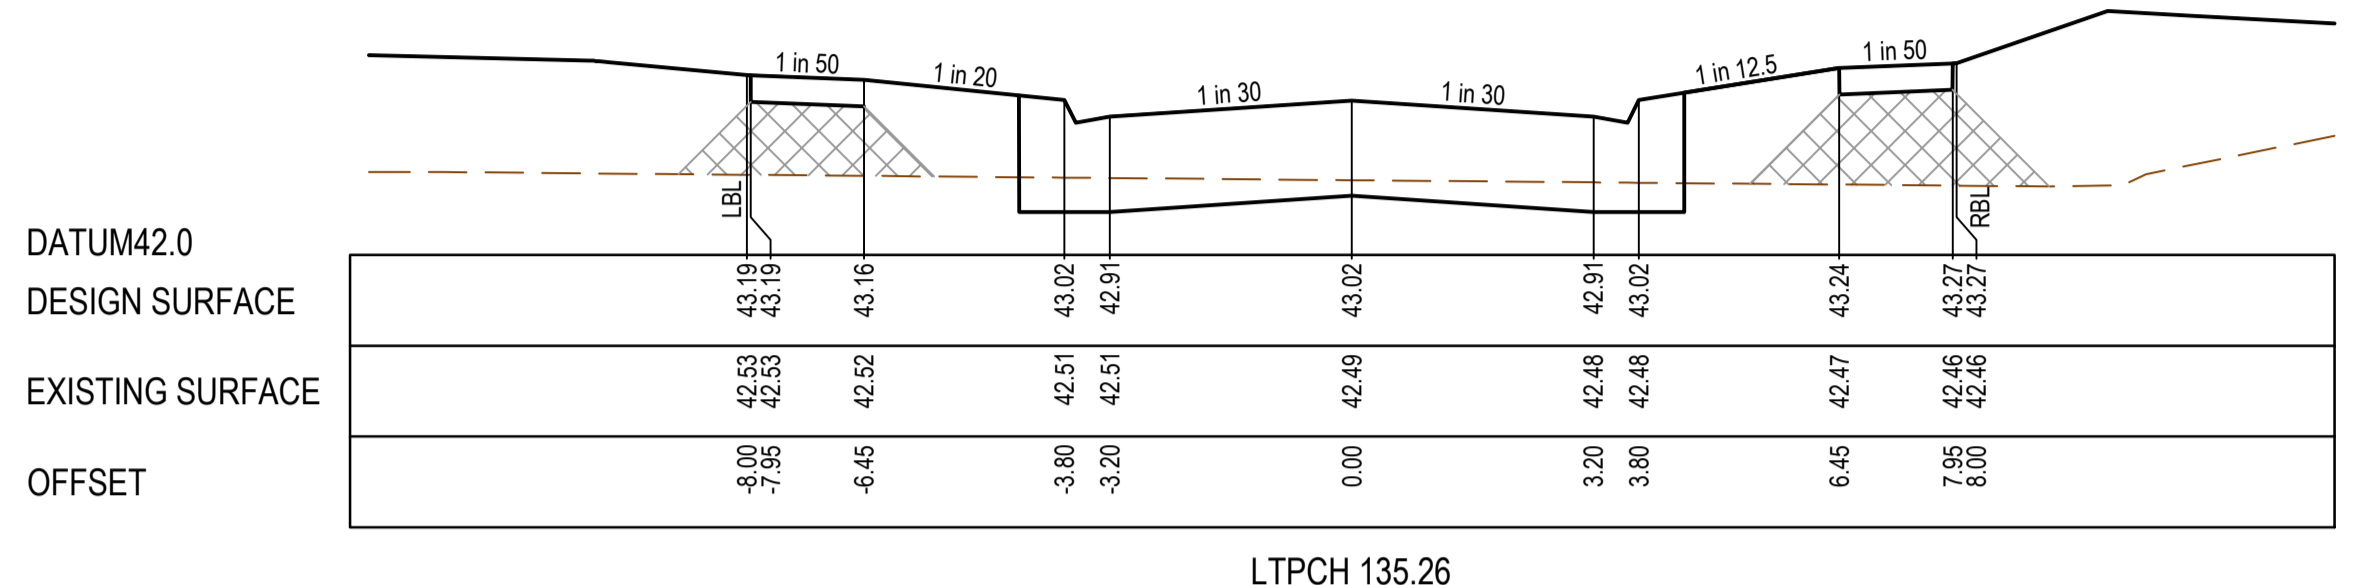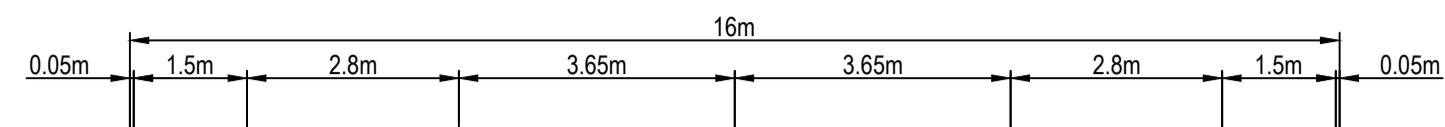


LTPCH 135.26

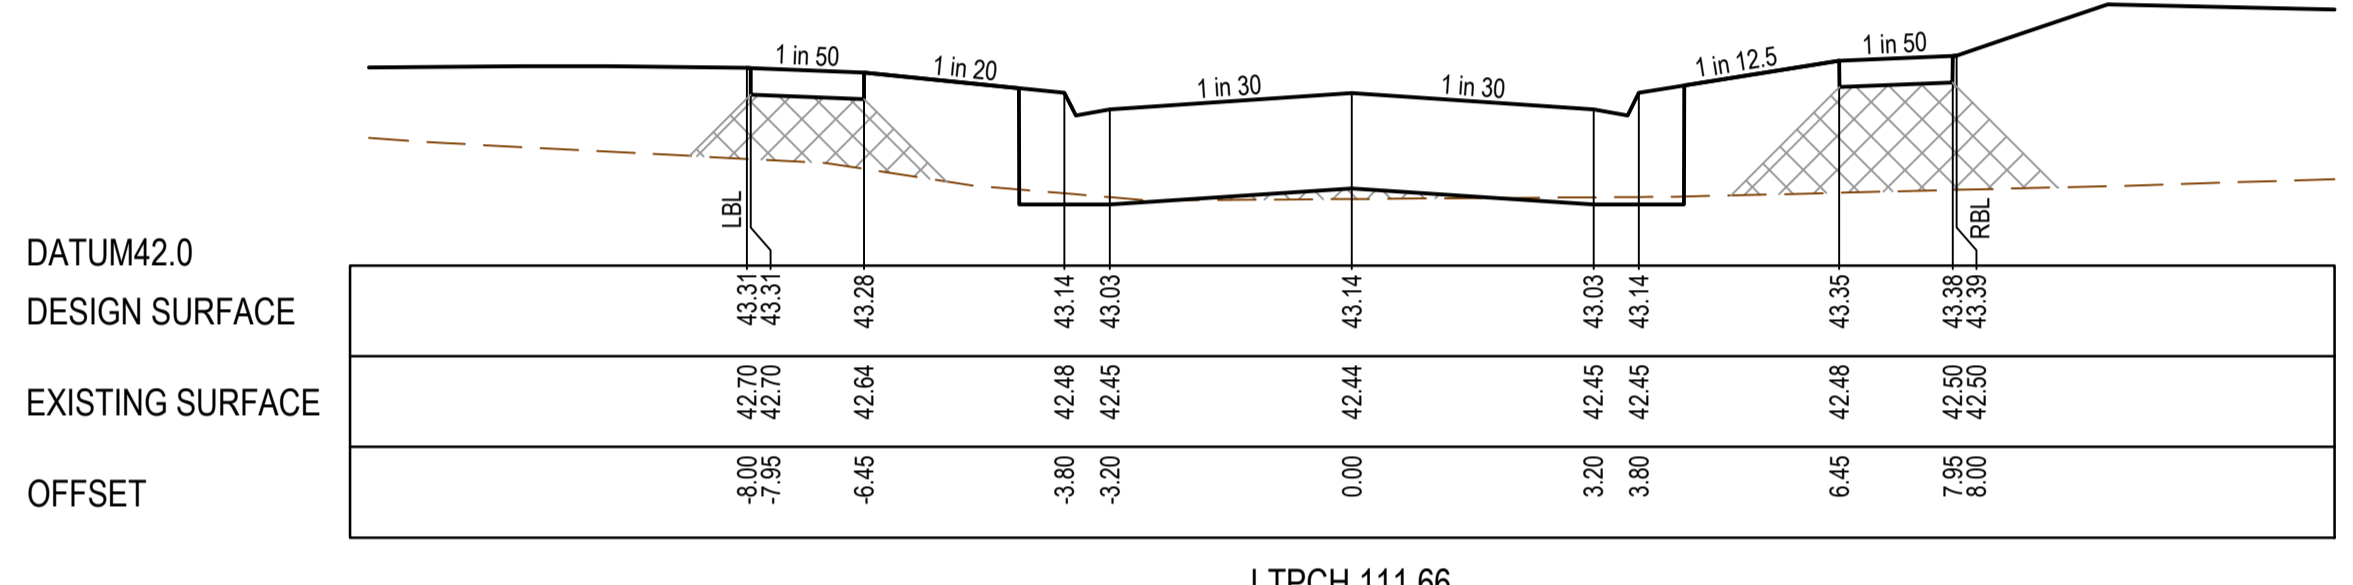



LTPCH 111.66

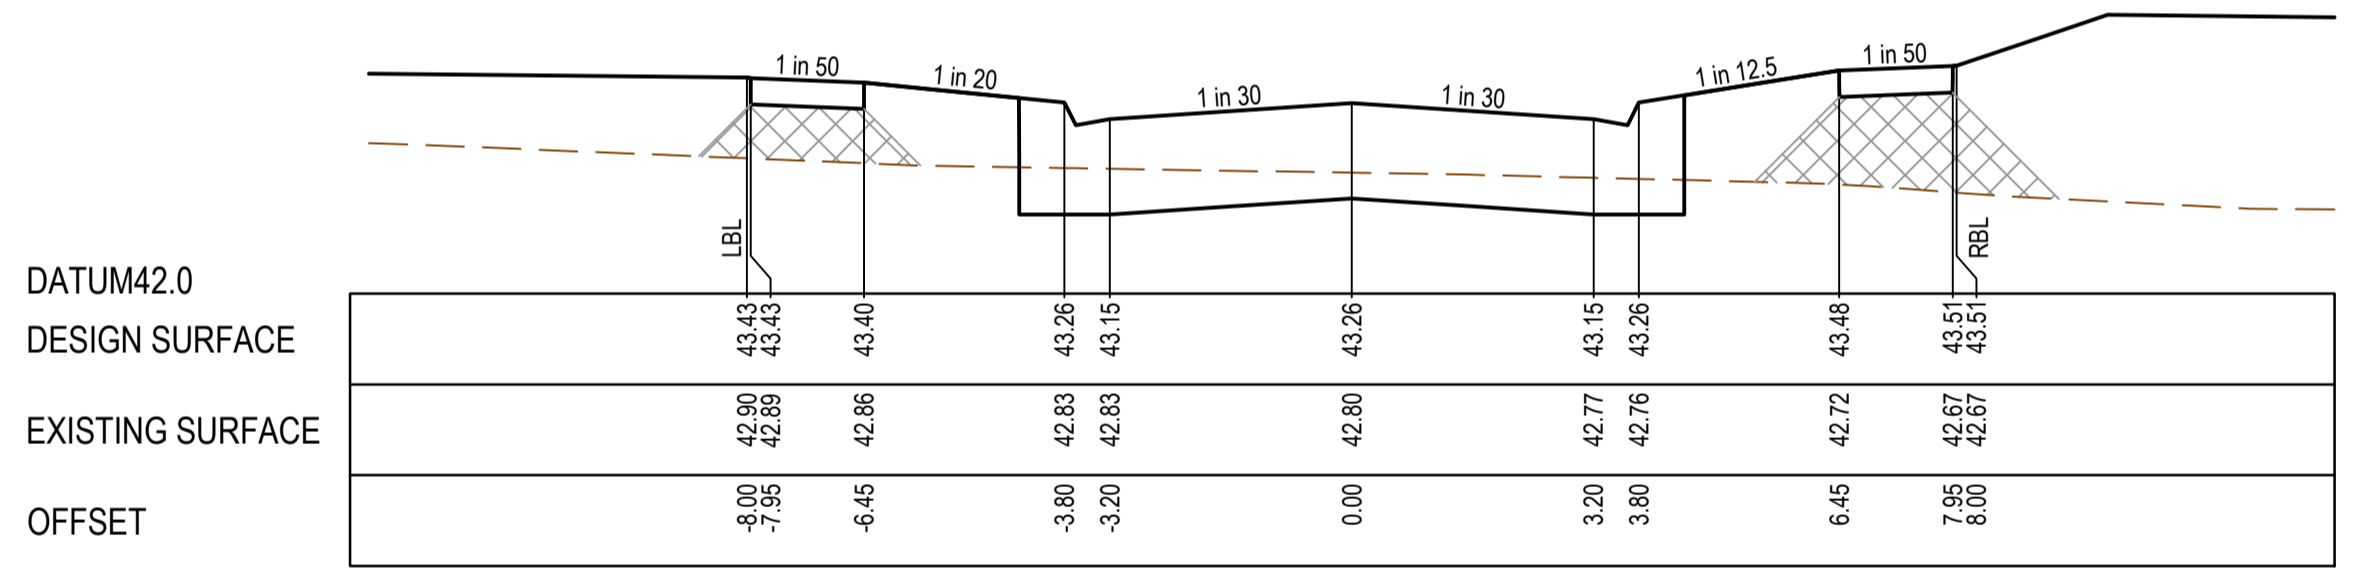


CH 87.46

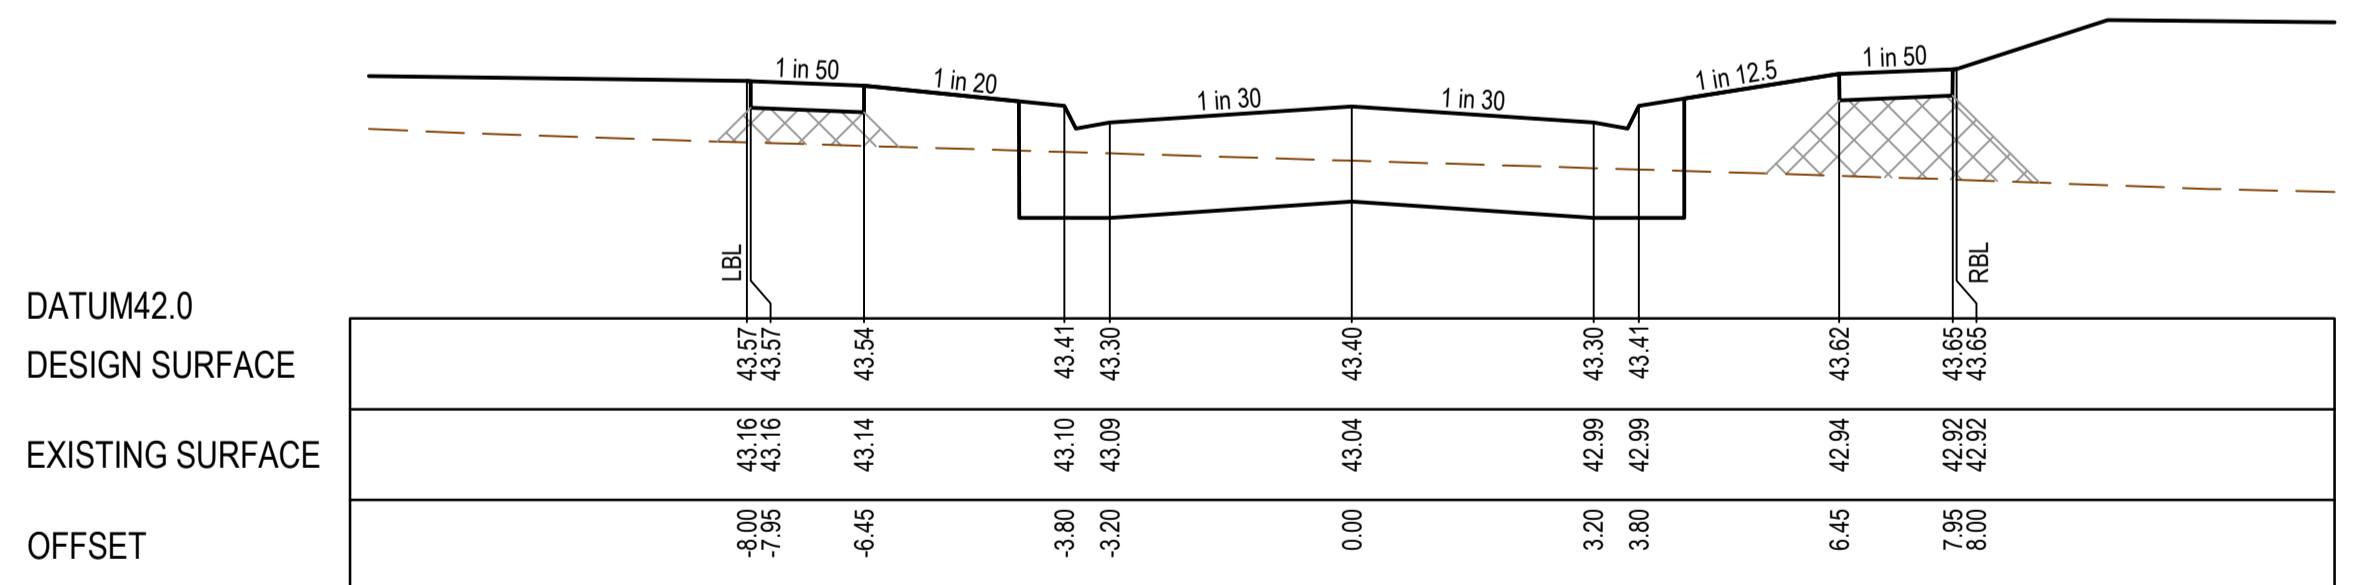

CH 58.96

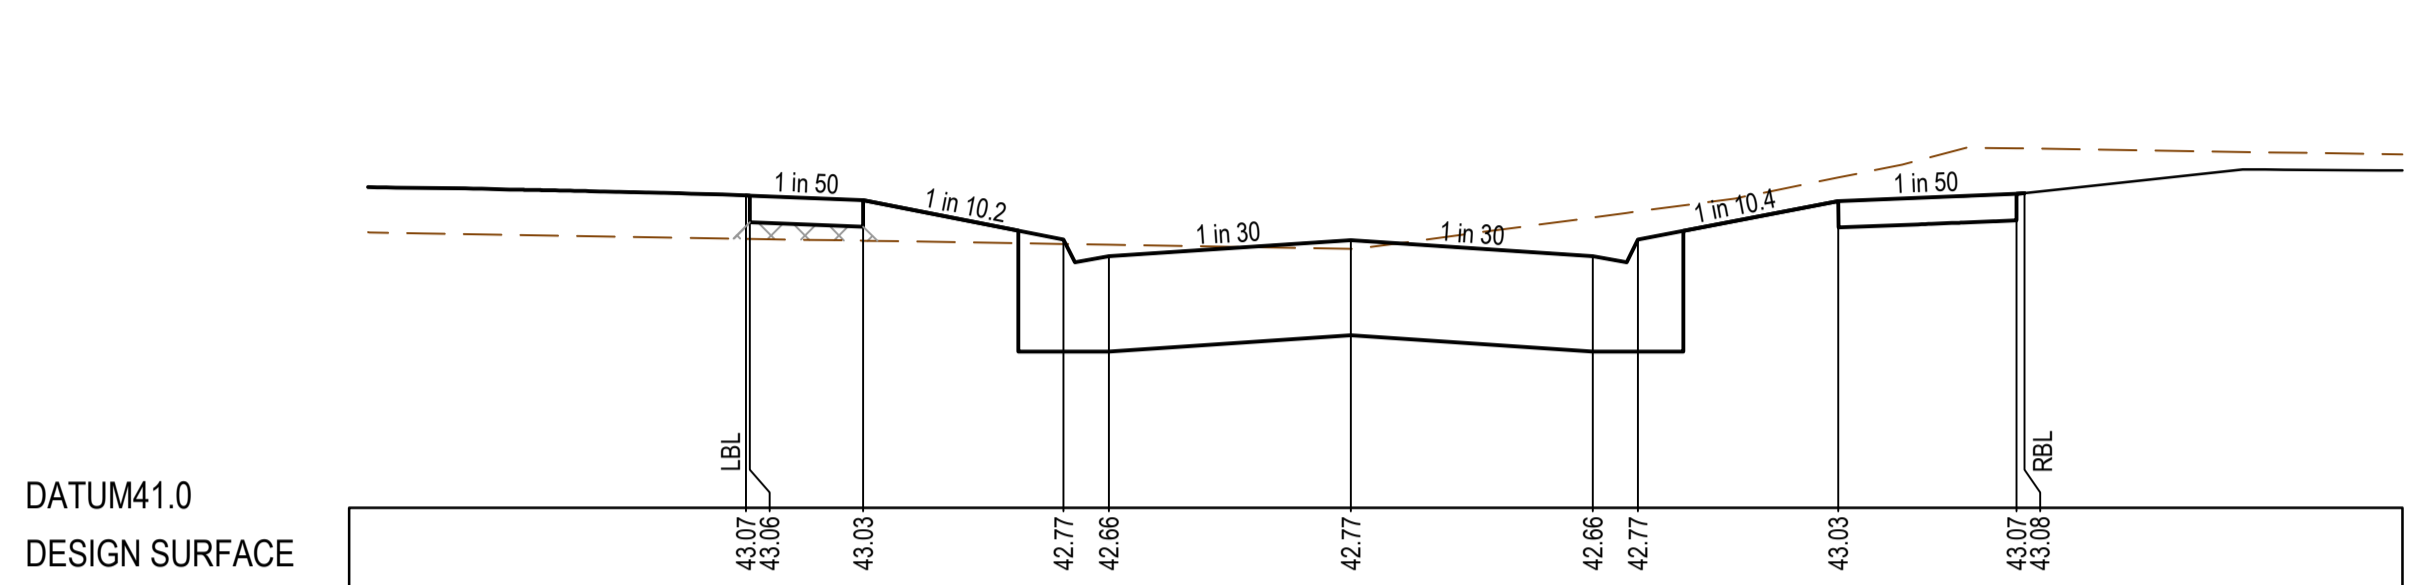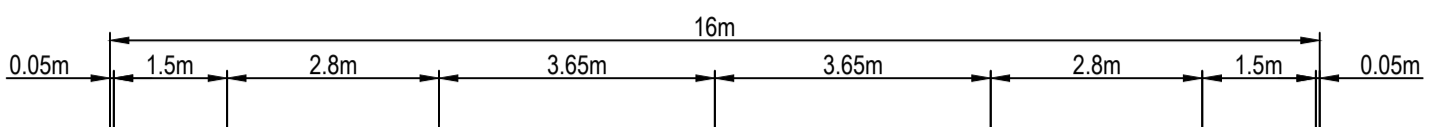

RTPCH 185.72

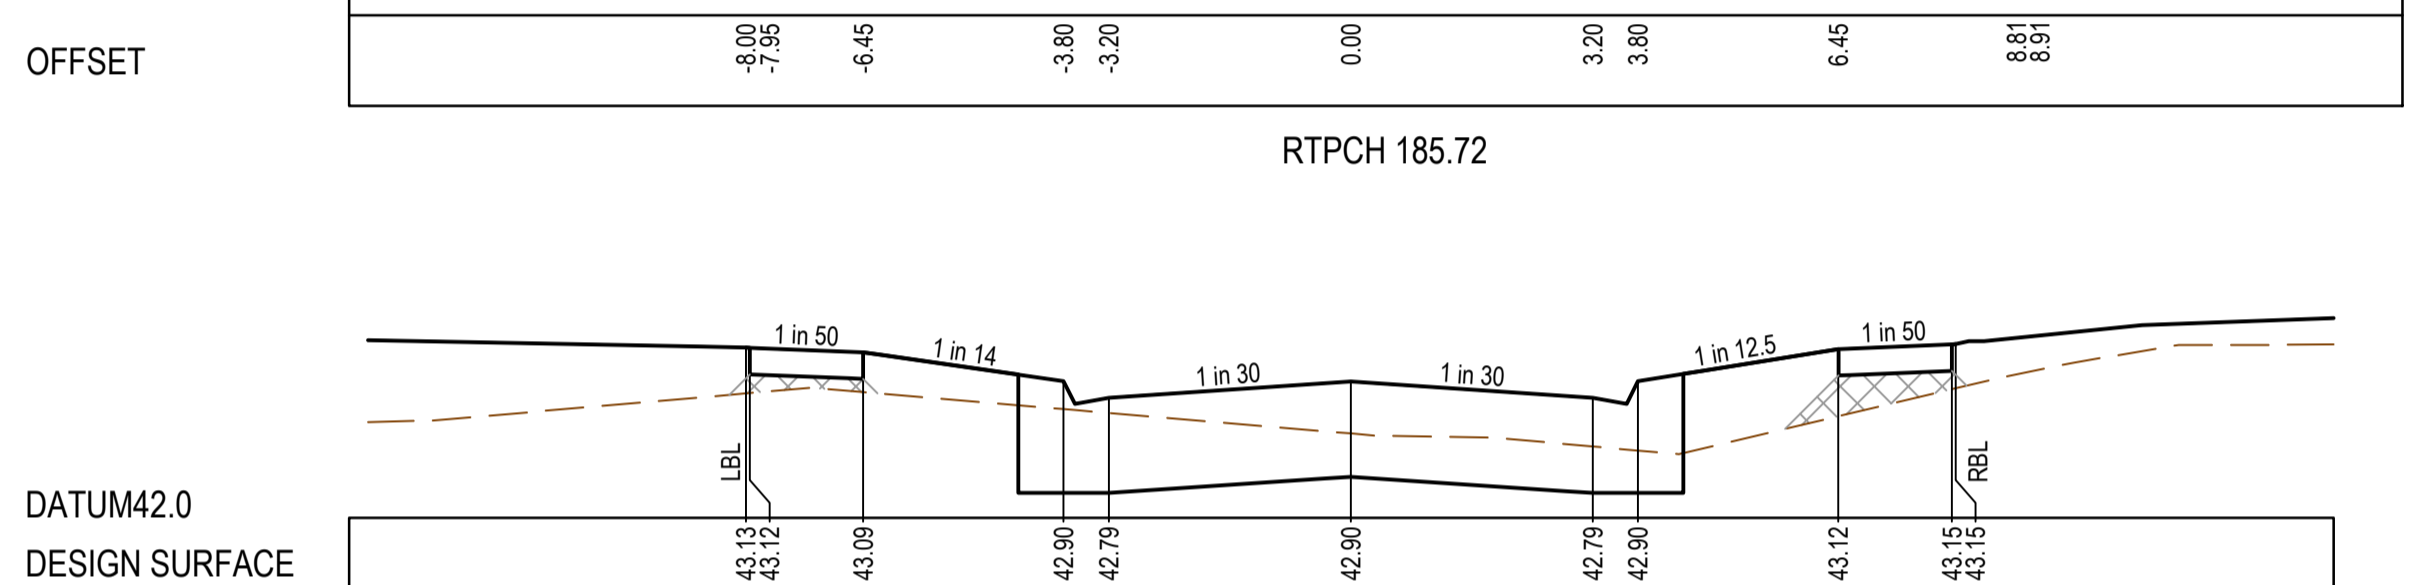


CH 159.46

AS CONSTRUCTED PLANS

The purpose of these as-constructed plans is to update the design drawings to show significant changes which occurred during construction. Note that the levels shown on these plans are design levels, and have not been verified by survey. All information shown on these plans should be verified on site. SMEC Australia Pty Ltd accept no responsibility for loss or damages resulting from the inappropriate usage of these plans.

PLAN OF SUB. NO.
PS841640V/S16
PERMIT REF. NO.
WYP10107_17.02

AS CONSTRUCTED

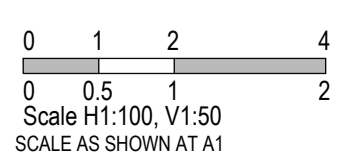



Member of the Surlana Jurong Group
Collins Square, Tower 4, Level 20, 727 Collins St
Melbourne, VIC 3008
Ph 03 9514 1500

ALAMORA
Tarnait

Alamora - Stage 8, Sayers Road, Tarnait
Wyndham City Council
Road and Drainage
Cross Sections: Comares Drive
Ch 0.00 - Ch 185.72

MELWAYS REF 234 D6	PROJECT / DRAWING No. 2070E-A08-251	SHEET No. 08 of 20	REVISION 2
------------------------------	---	------------------------------	----------------------

STRUCTURAL FILL REQUIRED UNDER PAVEMENT AND FOOTPATHS WHERE CONSTRUCTED ABOVE EXISTING SURFACE

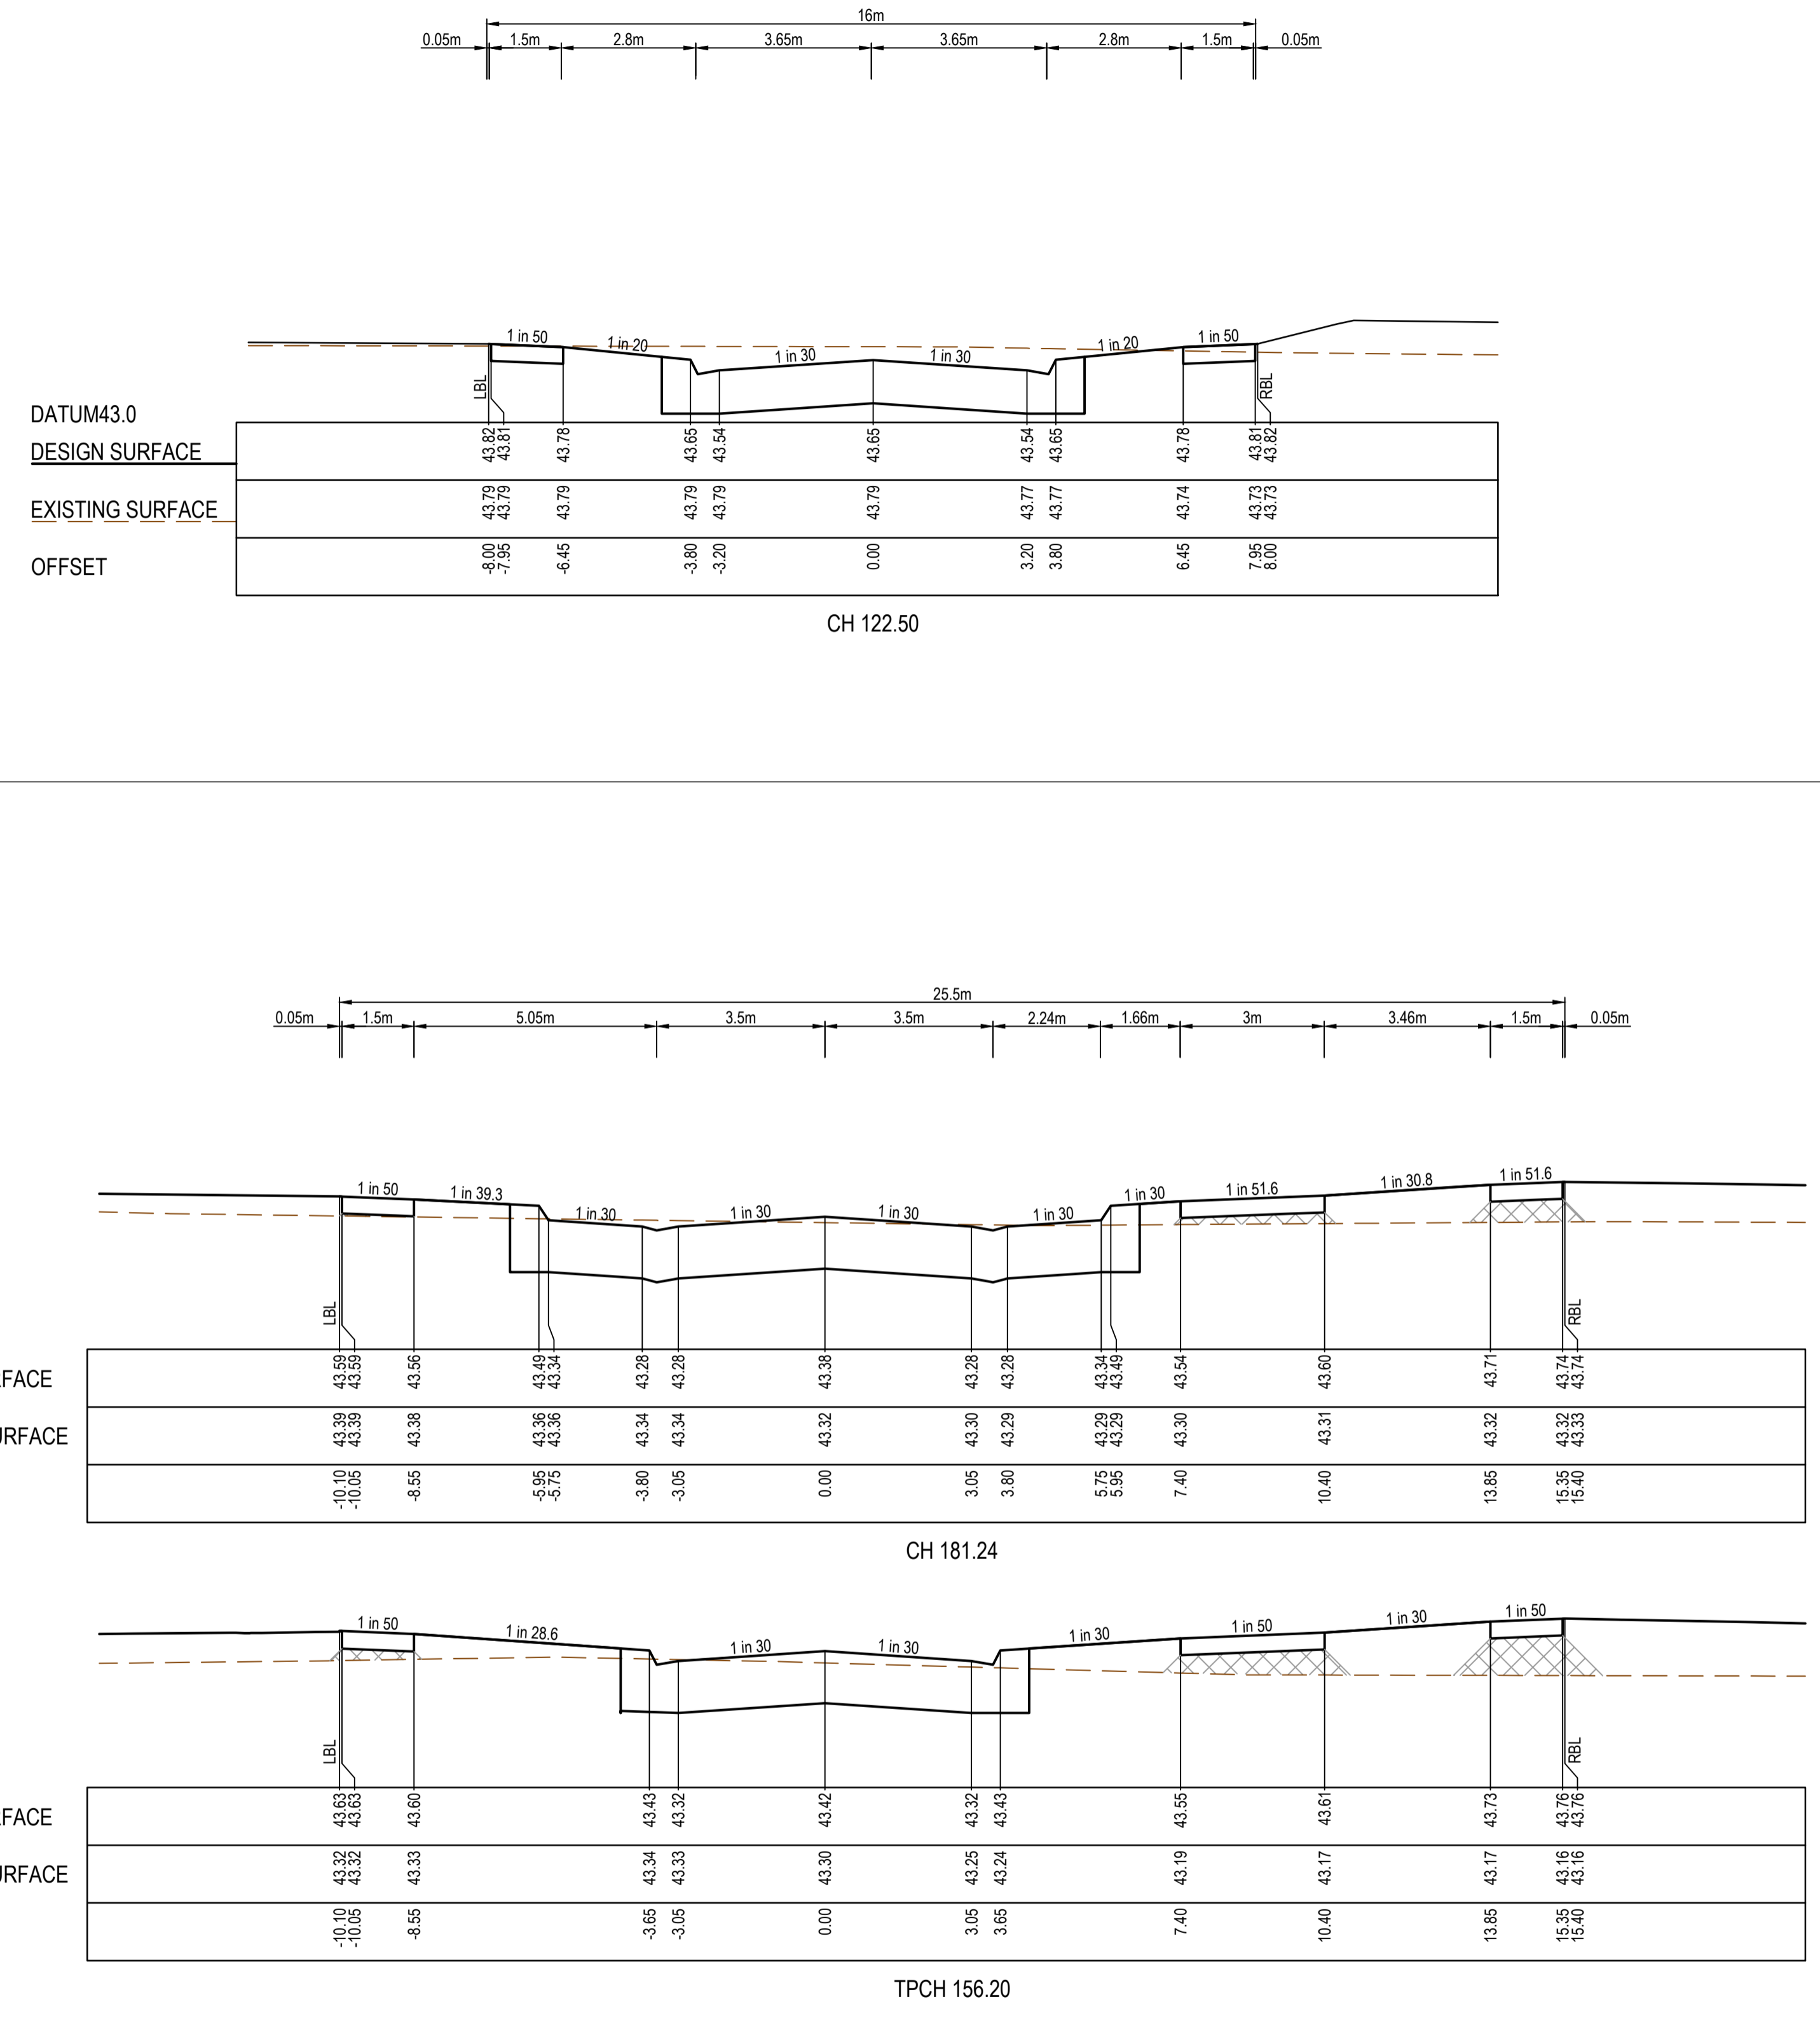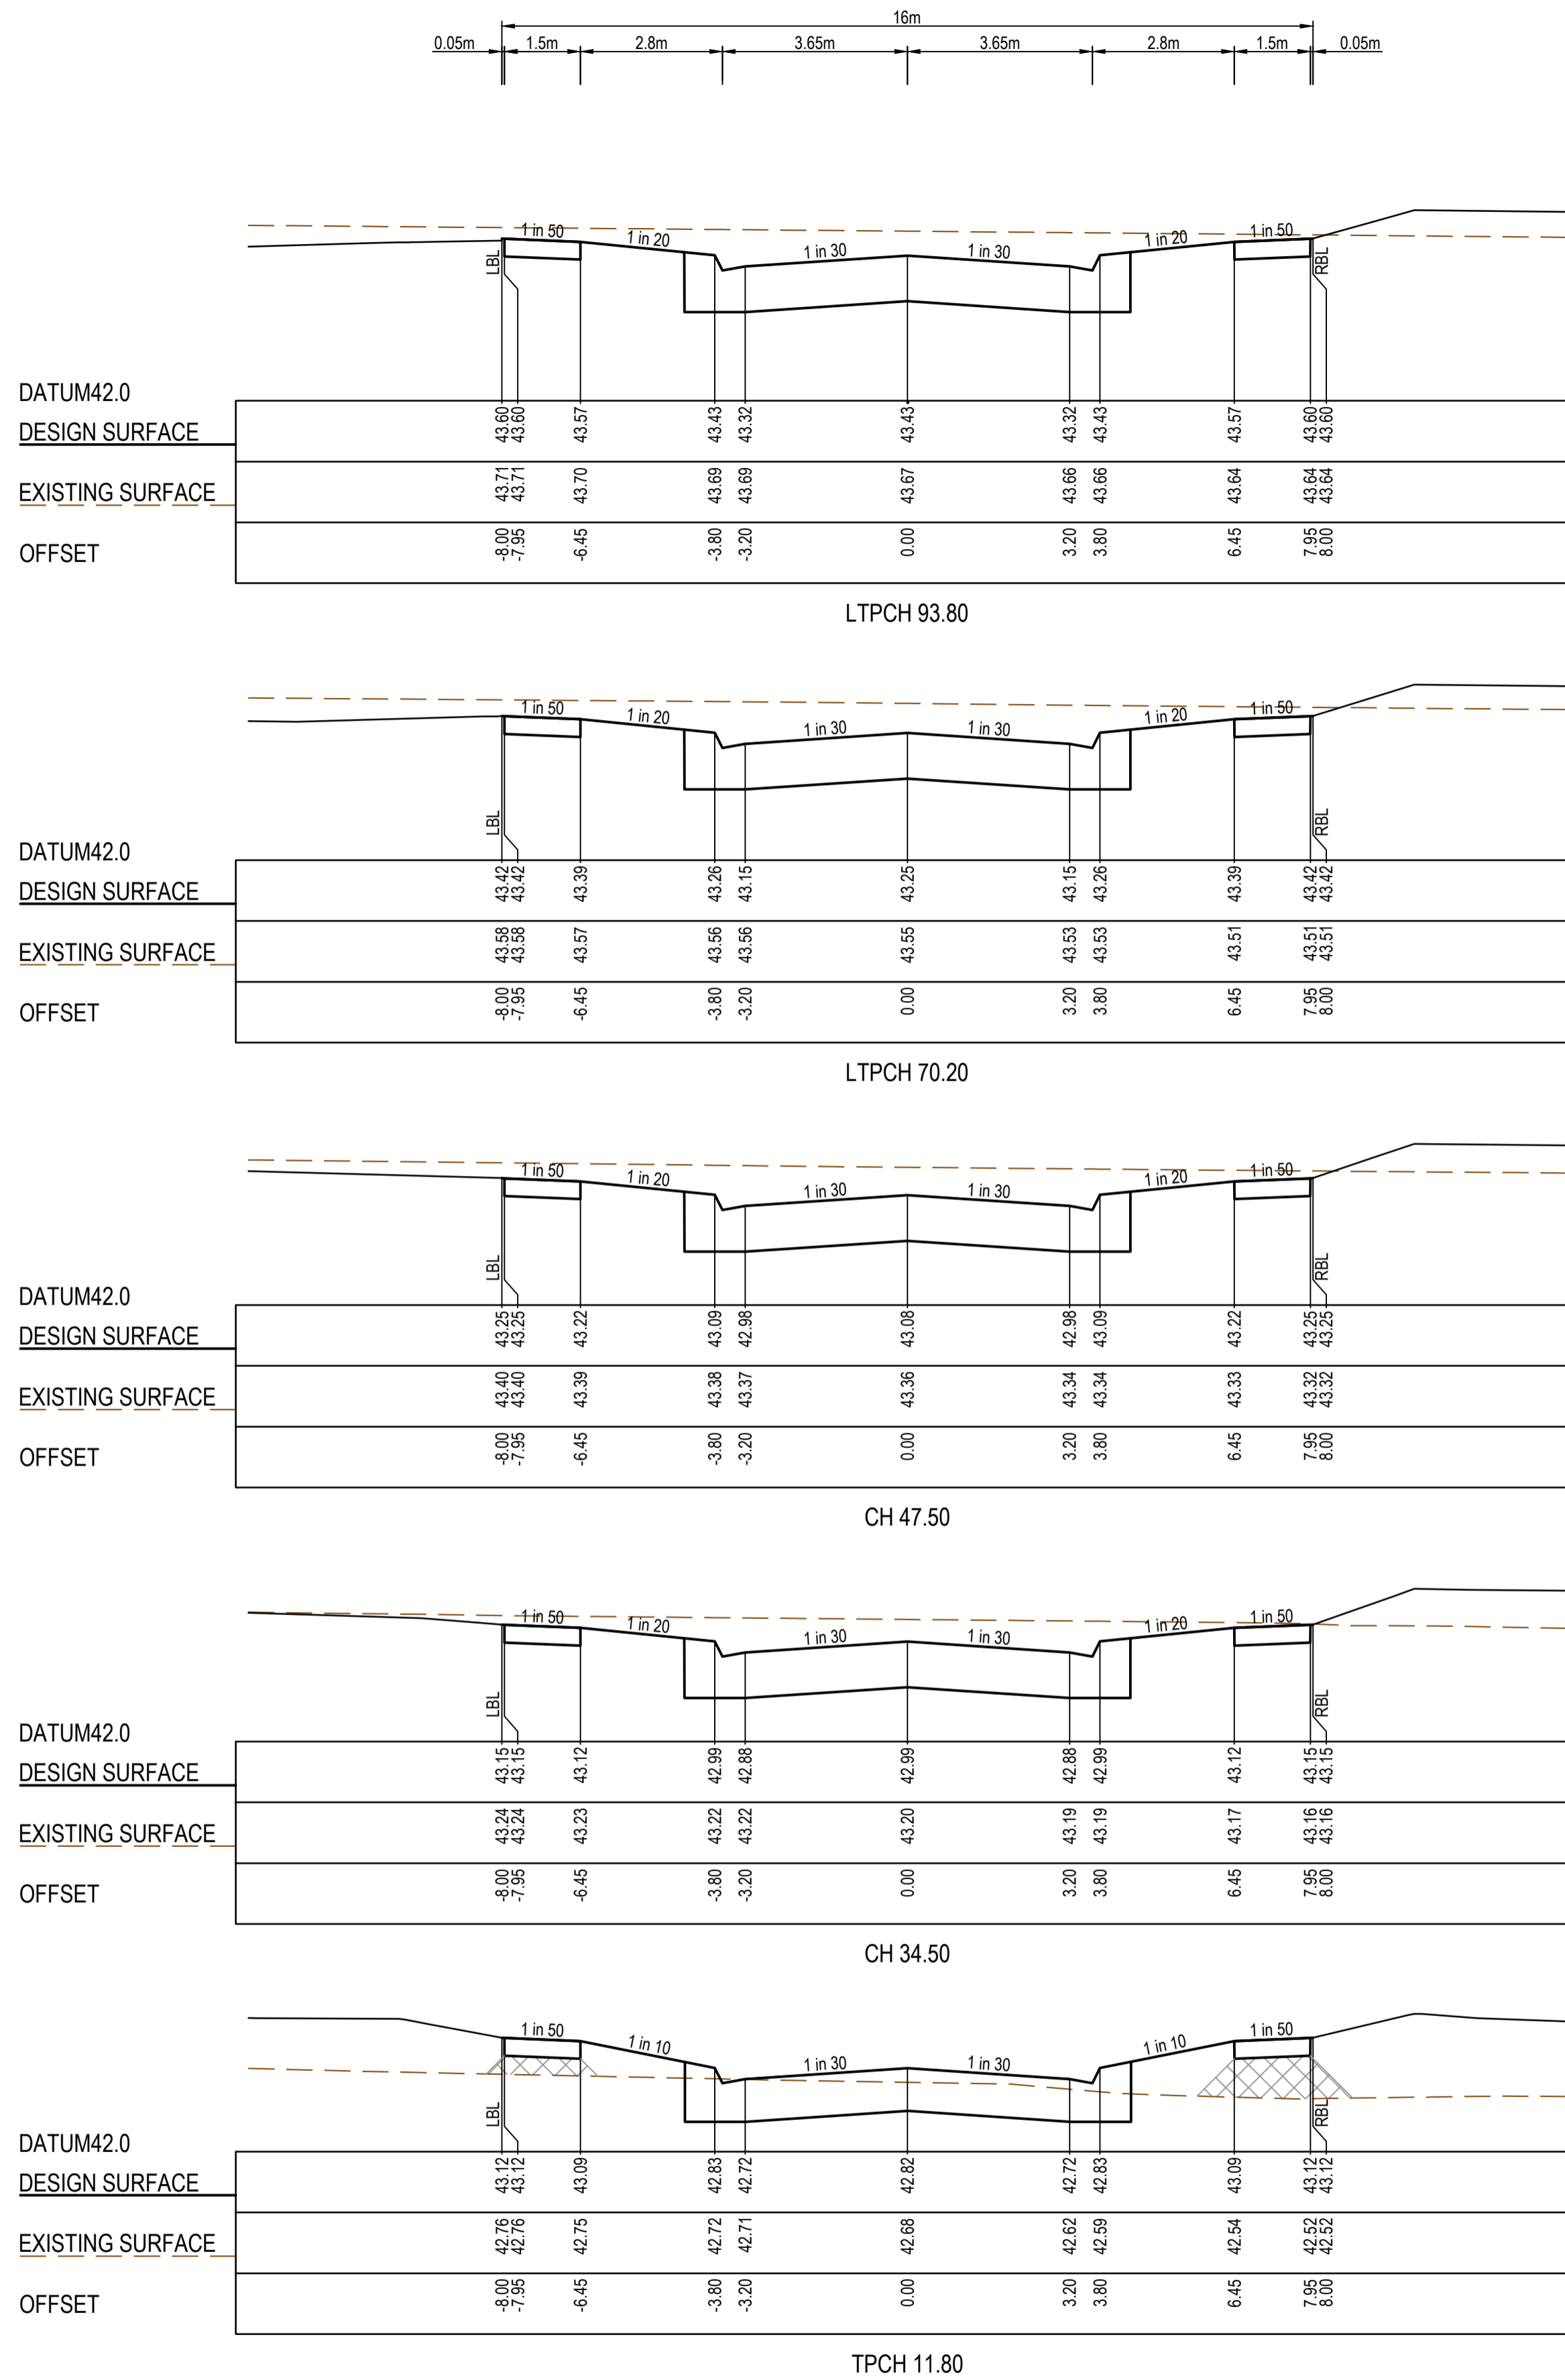


AS CONSTRUCTED PLANS

The purpose of these as-constructed plans is to update the design drawings to show significant changes which occurred during construction. Note that the levels shown on these plans are design levels, and have not been verified by survey. All information shown on these plans should be verified on site. SMEC Australia Pty Ltd accept no responsibility for loss or damages resulting from the inappropriate usage of these plans.

Quality Management - ISO 9001
 OHS Management - AS/NZS 4801
 Environmental Management - ISO 14001
 Global-Mark.com.au®

PLAN OF SUB. NO. PS841640V/S16
 PERMIT REF. NO. WYP10107_17.02

AS CONSTRUCTED

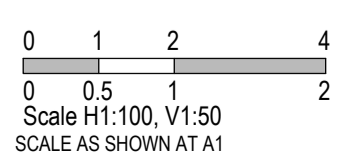



SMEC
 Member of the Surlana Jurong Group
 ABN 47 065 475 149
 Collins Square, Tower 4, Level 20, 727 Collins St
 Melbourne, VIC 3008
 Ph 03 9514 1500

ALAMORA
Tarneit


Alamora - Stage 8, Sayers Road, Tarneit
 Wyndham City Council
 Road and Drainage
 Cross Sections: Honeydew Drive Ch 11.80- Ch 122.50
 Resort Boulevard Ch 156.20 - Ch 181.24

MELWAYS REF: 234 D6
 PROJECT/DRAWING No: 2070E-A08-252
 SHEET No: 09 of 20
 REVISION: 3


STRUCTURAL FILL REQUIRED UNDER PAVEMENT AND FOOTPATHS WHERE CONSTRUCTED ABOVE EXISTING SURFACE

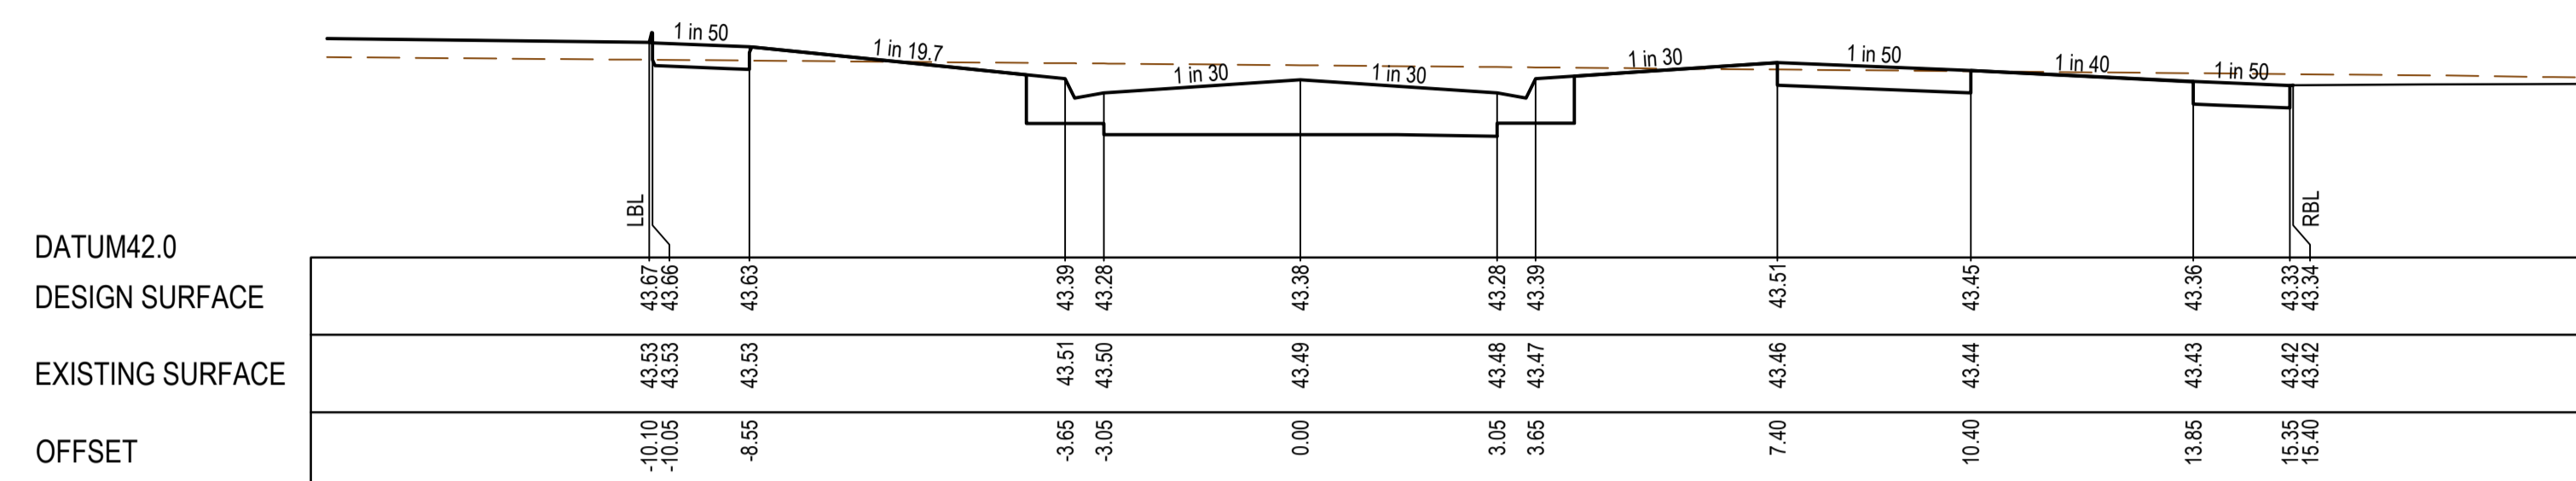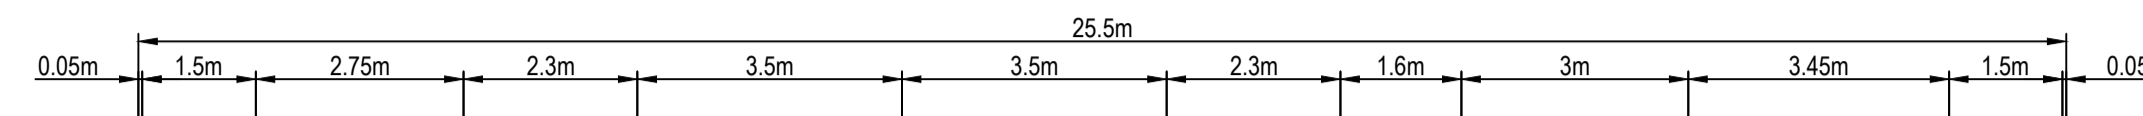


CH 393.91

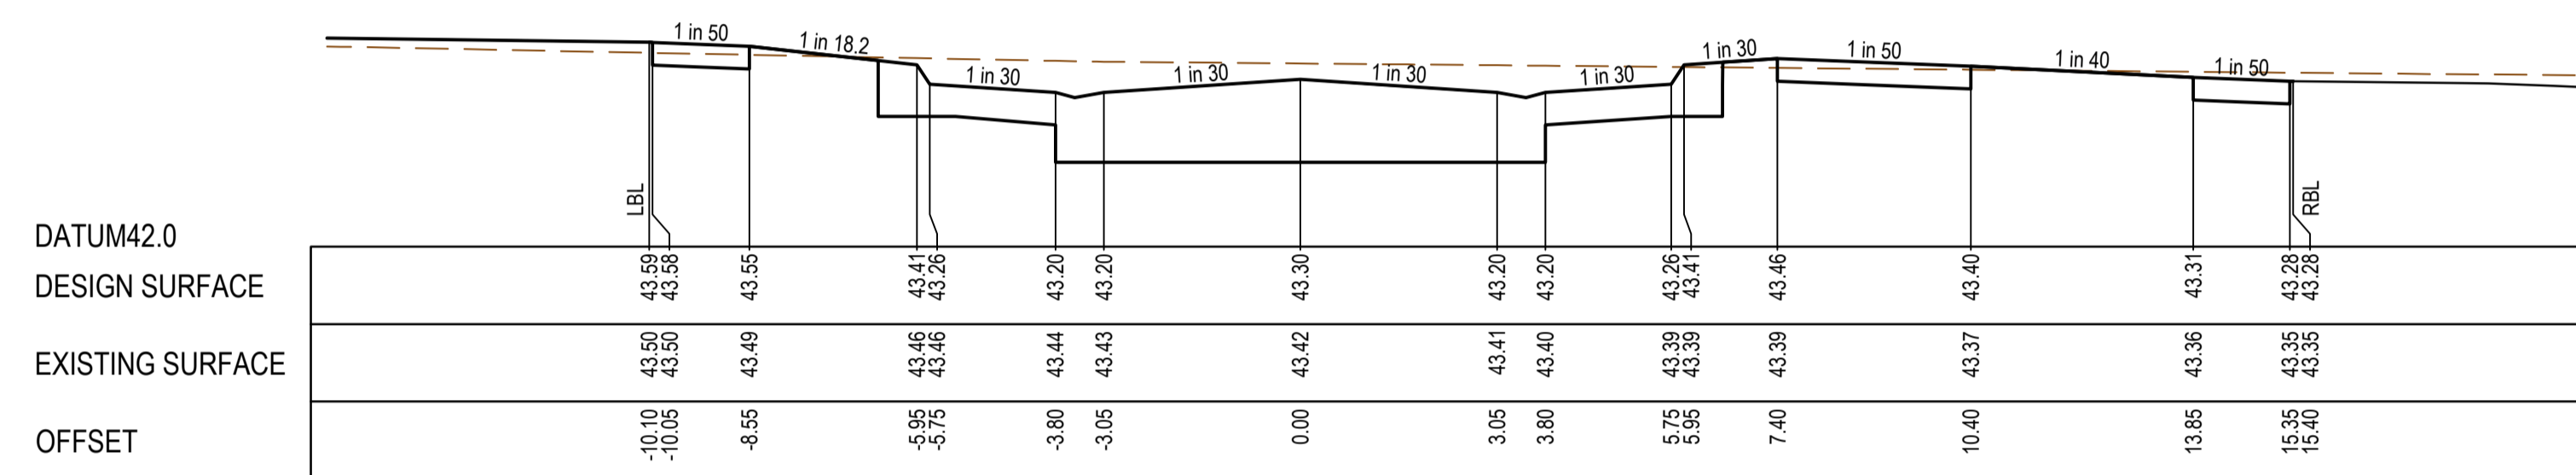

CH 377.91

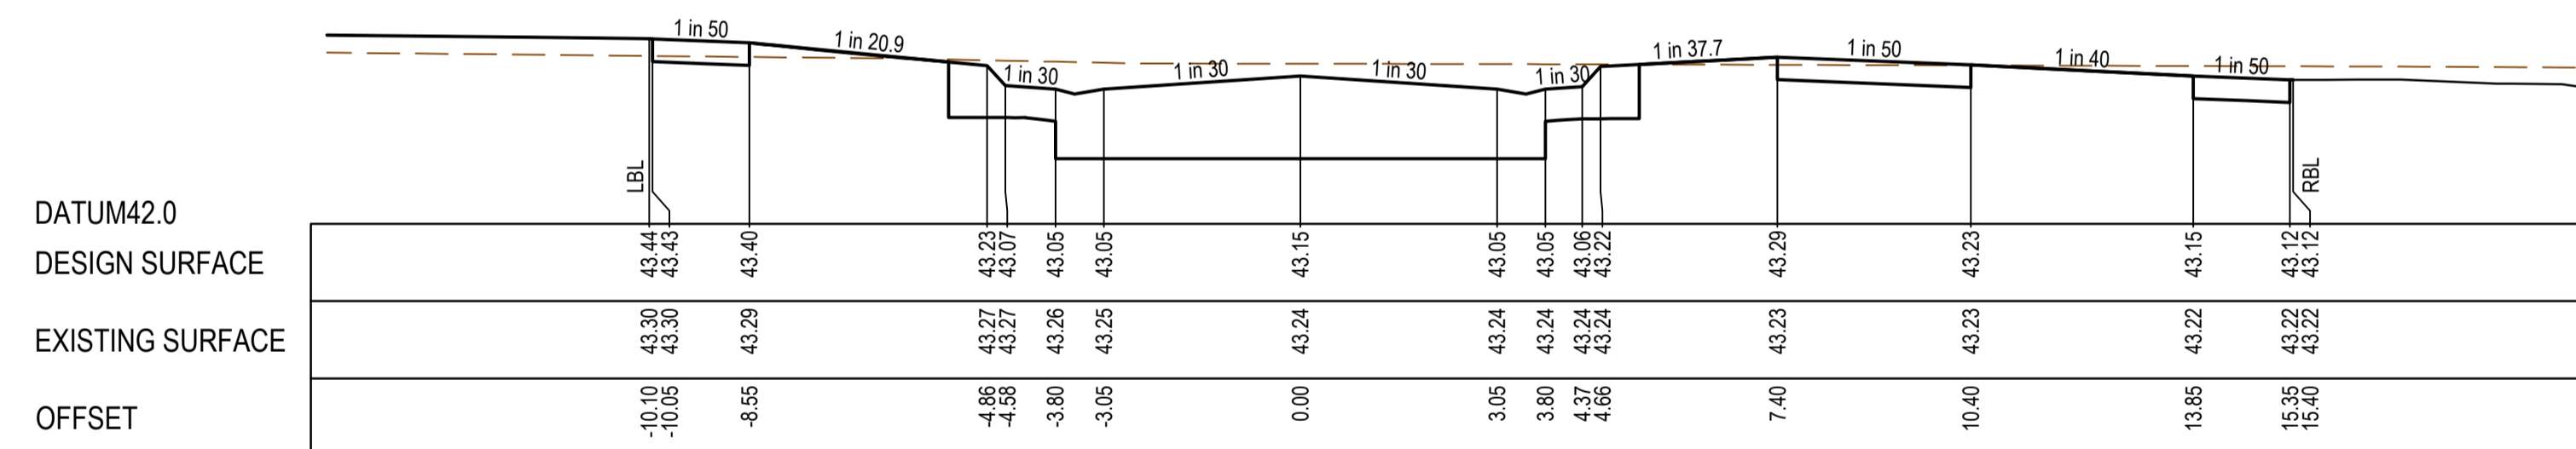

CH 347.91

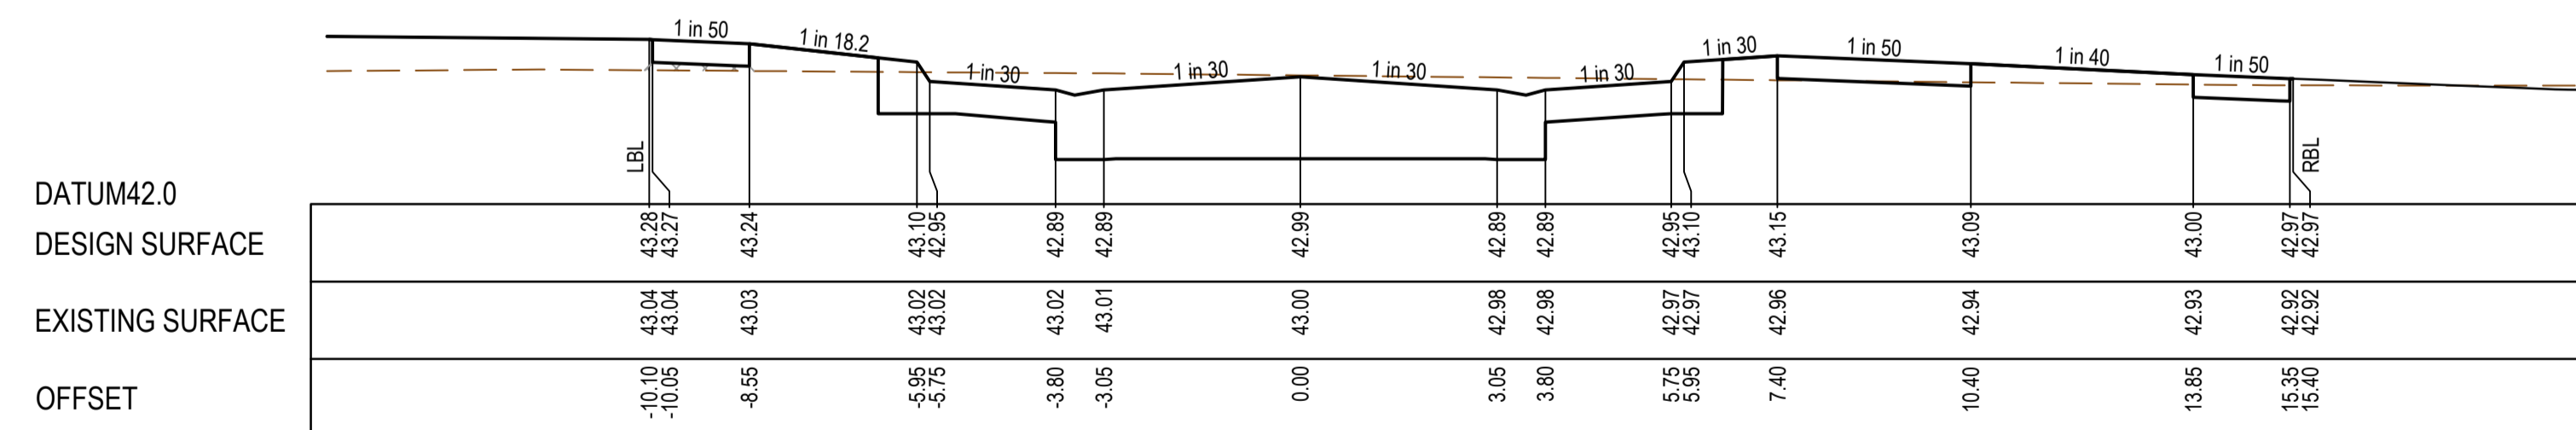

CH 315.91


AS CONSTRUCTED PLANS

The purpose of these as-constructed plans is to update the design drawings to show significant changes which occurred during construction. Note that the levels shown on these plans are design levels, and have not been verified by survey. All information shown on these plans should be verified on site. SMEC Australia Pty Ltd accept no responsibility for loss or damages resulting from the inappropriate usage of these plans.



AS CONSTRUCTED

PLAN OF SUB. NO.
PS841640/S16
PERMIT REF. NO.
WYP10107_17.02

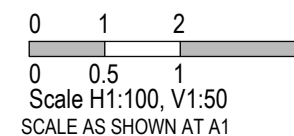



Collins Square, Tower 4, Level 20, 727 Collins St
Melbourne, VIC 3008
Ph 03 9514 1500




Alamora - Stage 8, Sayers Road, Tarnait
Wyndham City Council
Road and Drainage
Cross Sections: Resort Boulevard
Ch 315.91 - Ch 393.91

MELWAYS REF 234 D6	PROJECT / DRAWING No. 2070E-A08-254	SHEET No. 11 of 20	REVISION 3
------------------------------	---	------------------------------	----------------------


STRUCTURAL FILL REQUIRED UNDER PAVEMENT AND FOOTPATHS WHERE CONSTRUCTED ABOVE EXISTING SURFACE

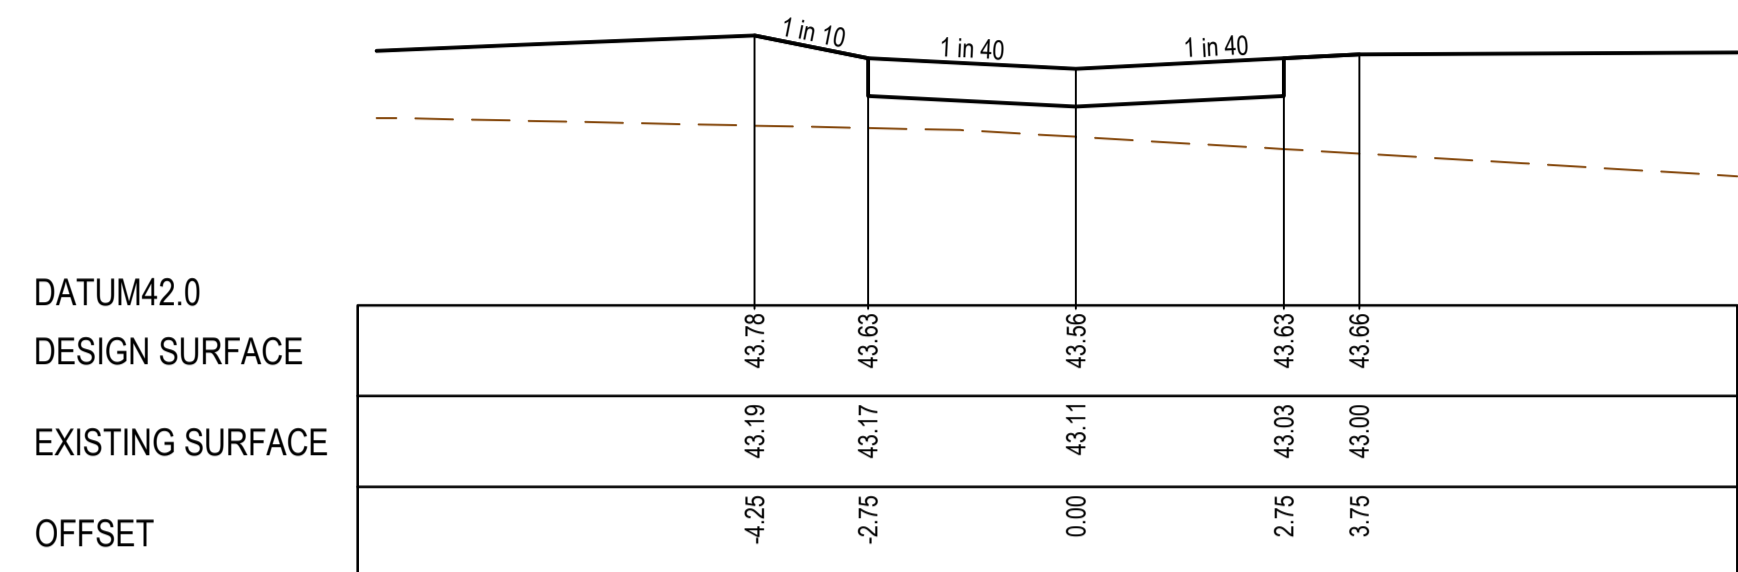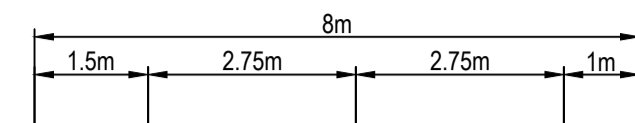


CH 82.35

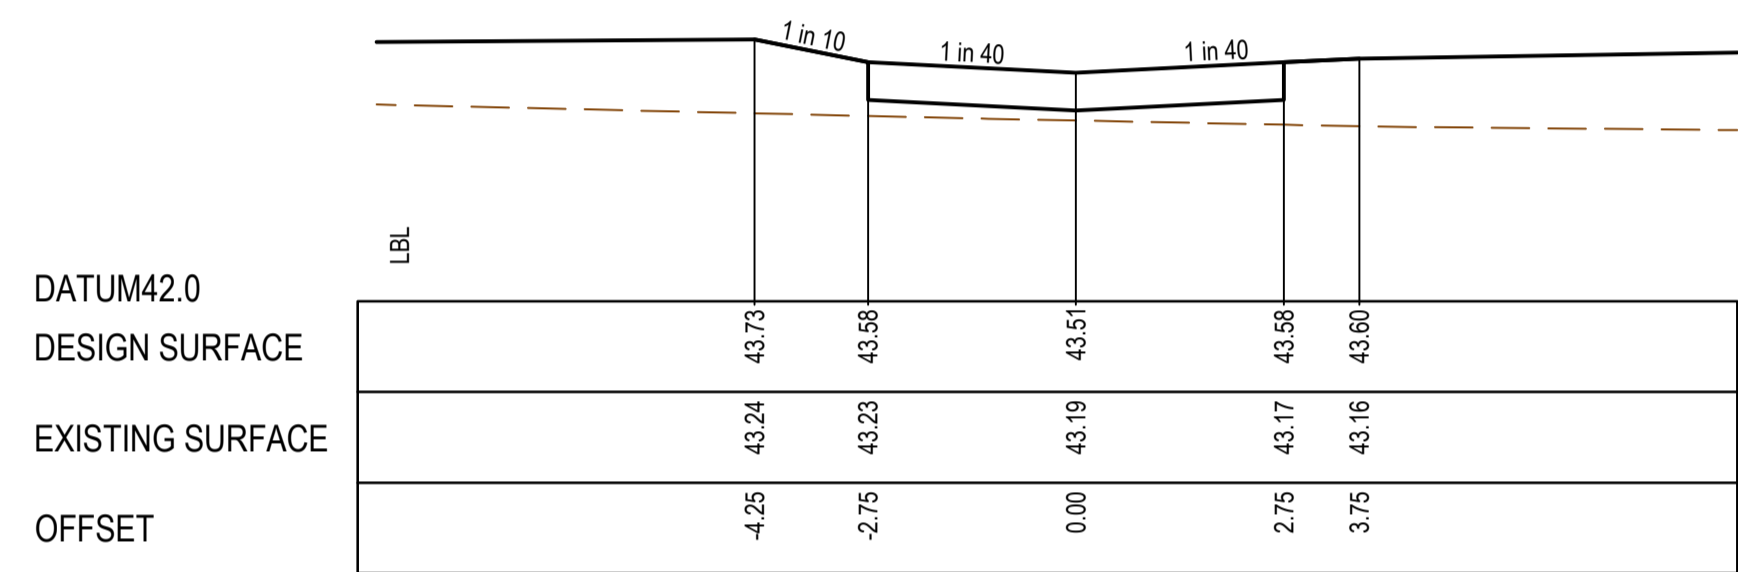



CH 70.35

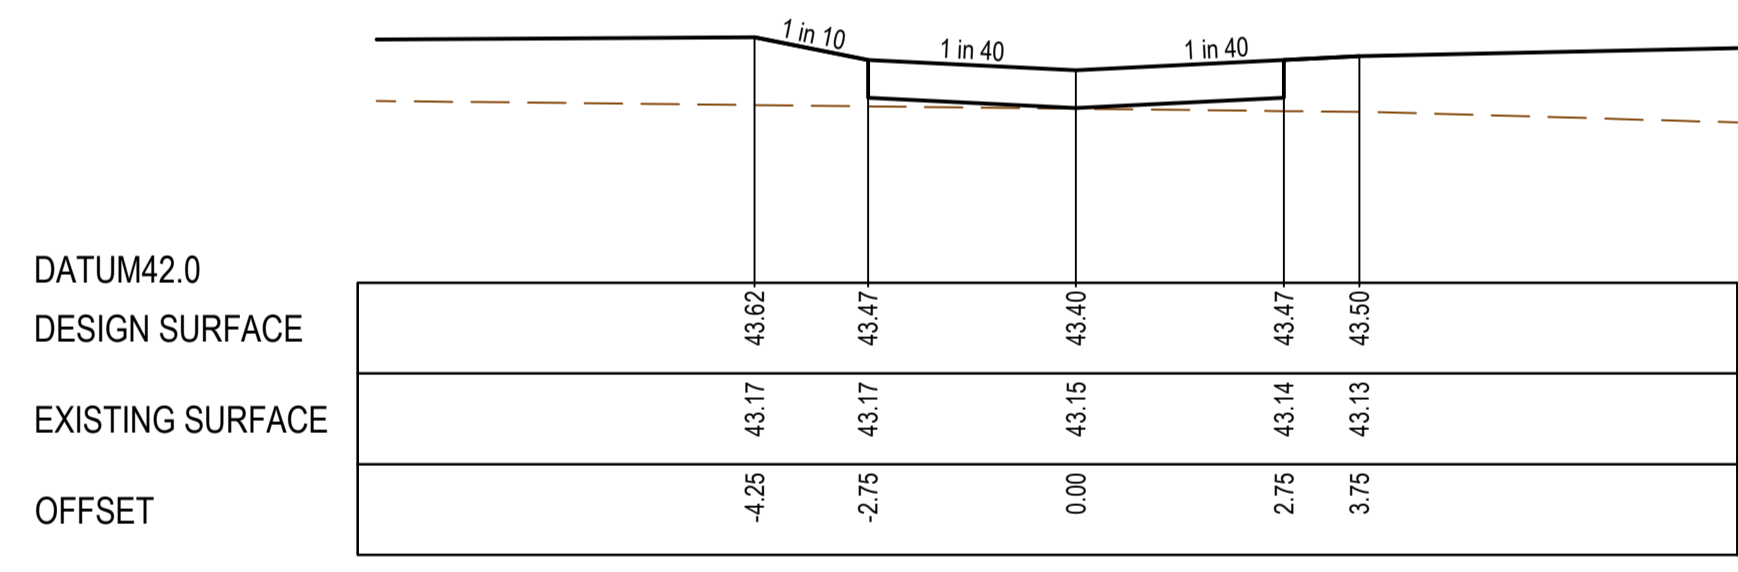


CH 49.35

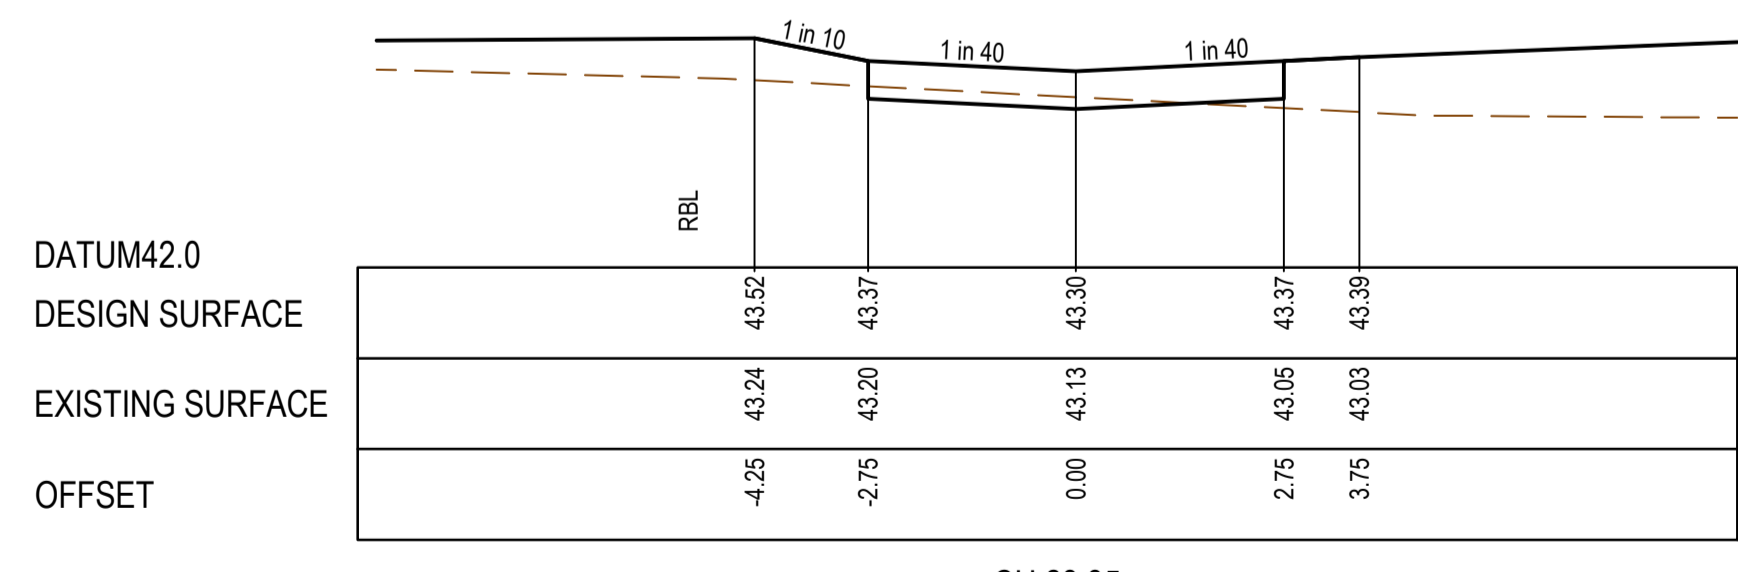


CH 28.35

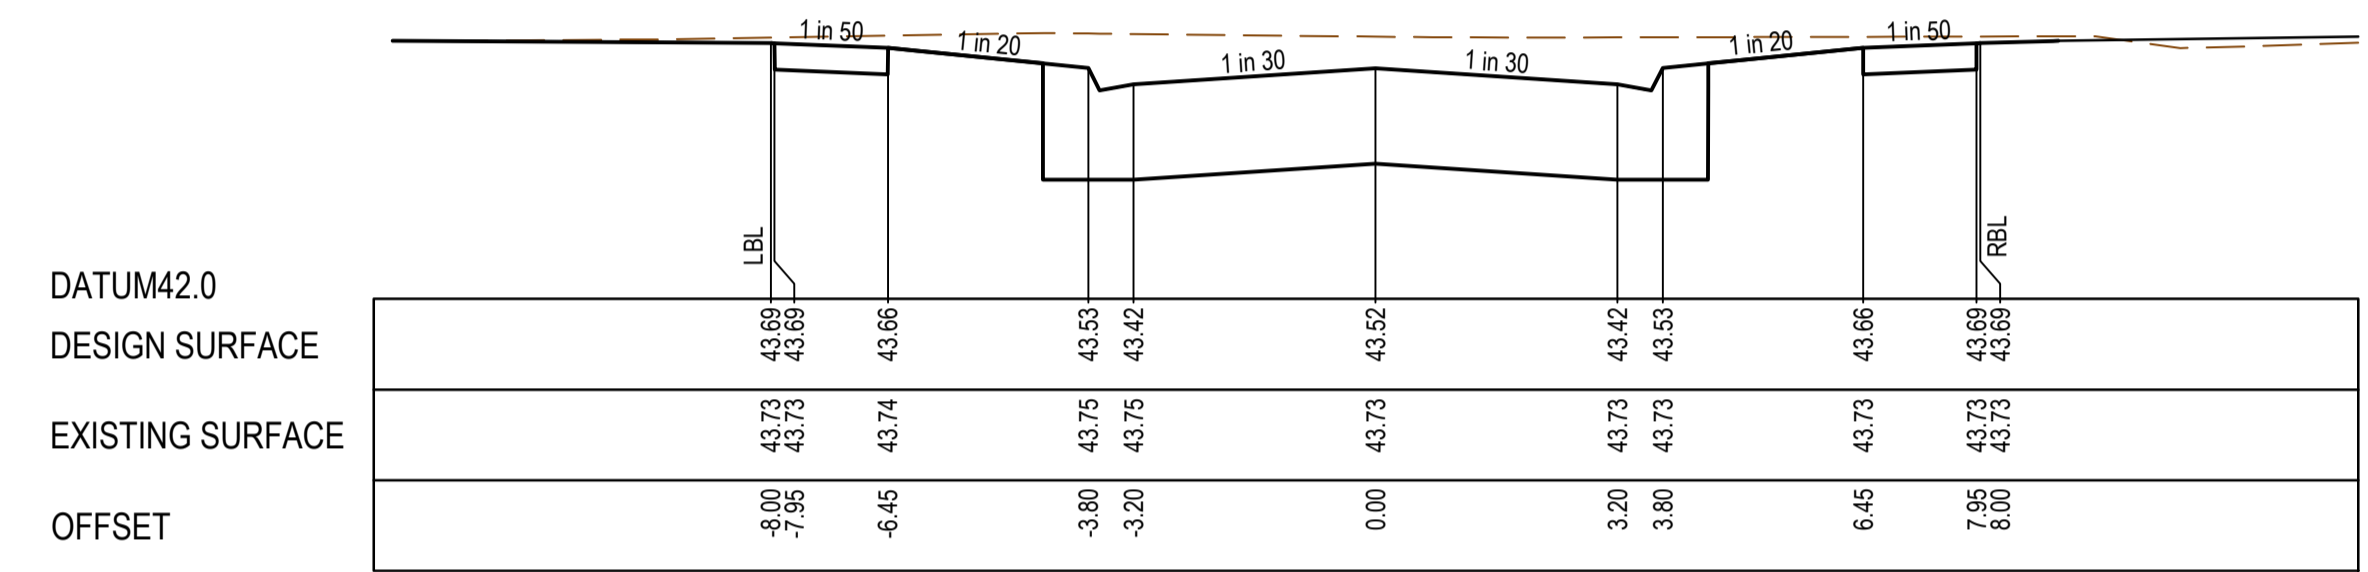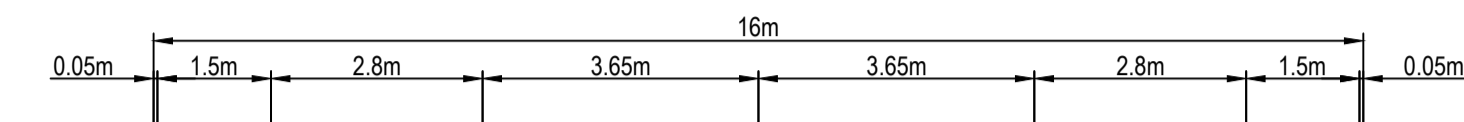

CH 64.00

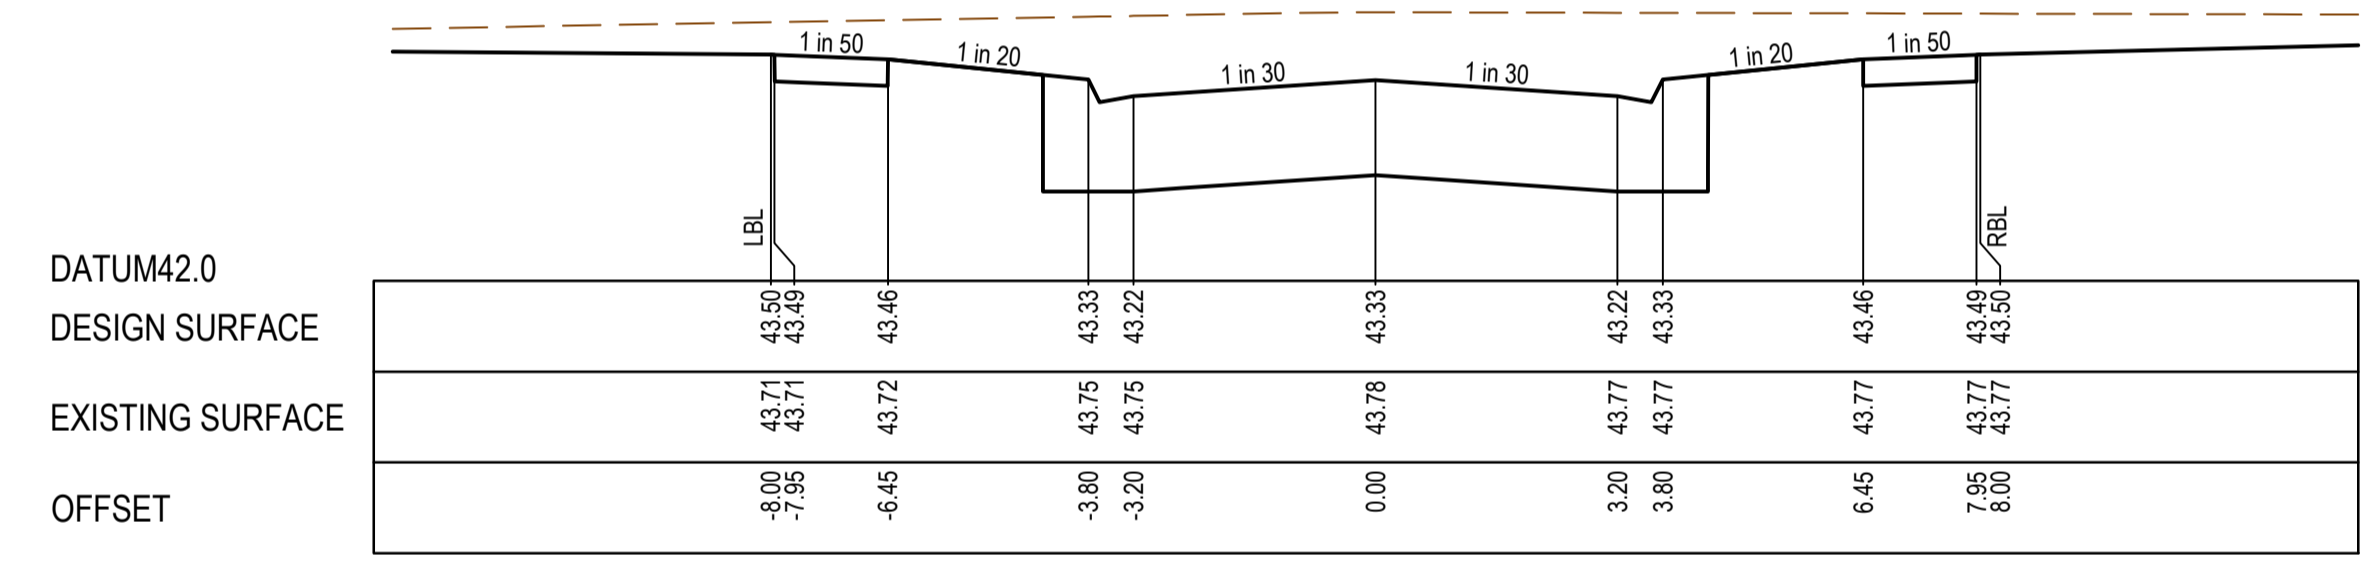

CH 36.00

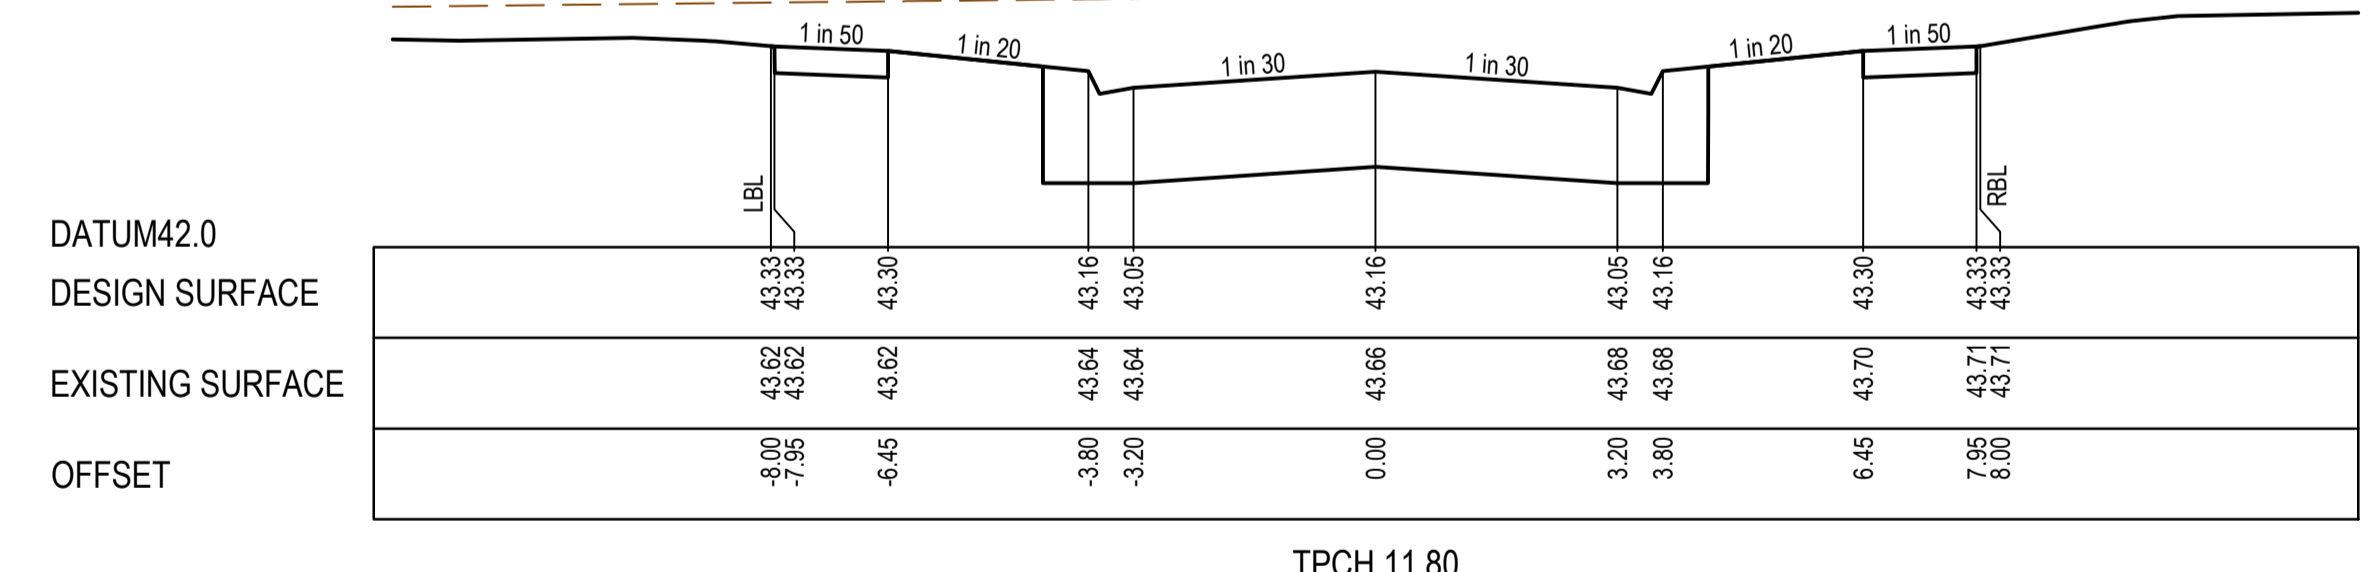

TPCH 11.80



AS CONSTRUCTED PLANS

The purpose of these as-constructed plans is to update the design drawings to show significant changes which occurred during construction. Note that the levels shown on these plans are design levels, and have not been verified by survey. All information shown on these plans should be verified on site. SMEC Australia Pty Ltd accept no responsibility for loss or damages resulting from the inappropriate usage of these plans.



PLAN OF SUB. NO.
PS841640V/S16
PERMIT REF. NO.
WYP10107_17.02


AS CONSTRUCTED

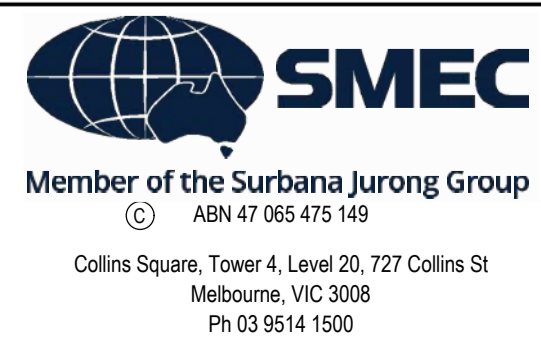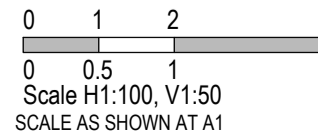

Alamora - Stage 8, Sayers Road, Tarnait
Wyndham City Council
Road and Drainage
Cross Sections: Tuscany Avenue Ch 11.80 - Ch 64.00
Pavna Lane Ch 28.35 - Ch 82.35

MELWAYS REF 234 D6	PROJECT / DRAWING No. 2070E-A08-255	SHEET No. 12 of 20	REVISION 2
------------------------------	---	------------------------------	----------------------

CRUSHED ROCK BACKFILL
 CRB INDICATES CRUSHED ROCK BACKFILL COMPACTED IN ACCORDANCE WITH COUNCIL STANDARDS & SPECIFICATIONS, CLASS 3 UNLESS SPECIFIED OTHERWISE

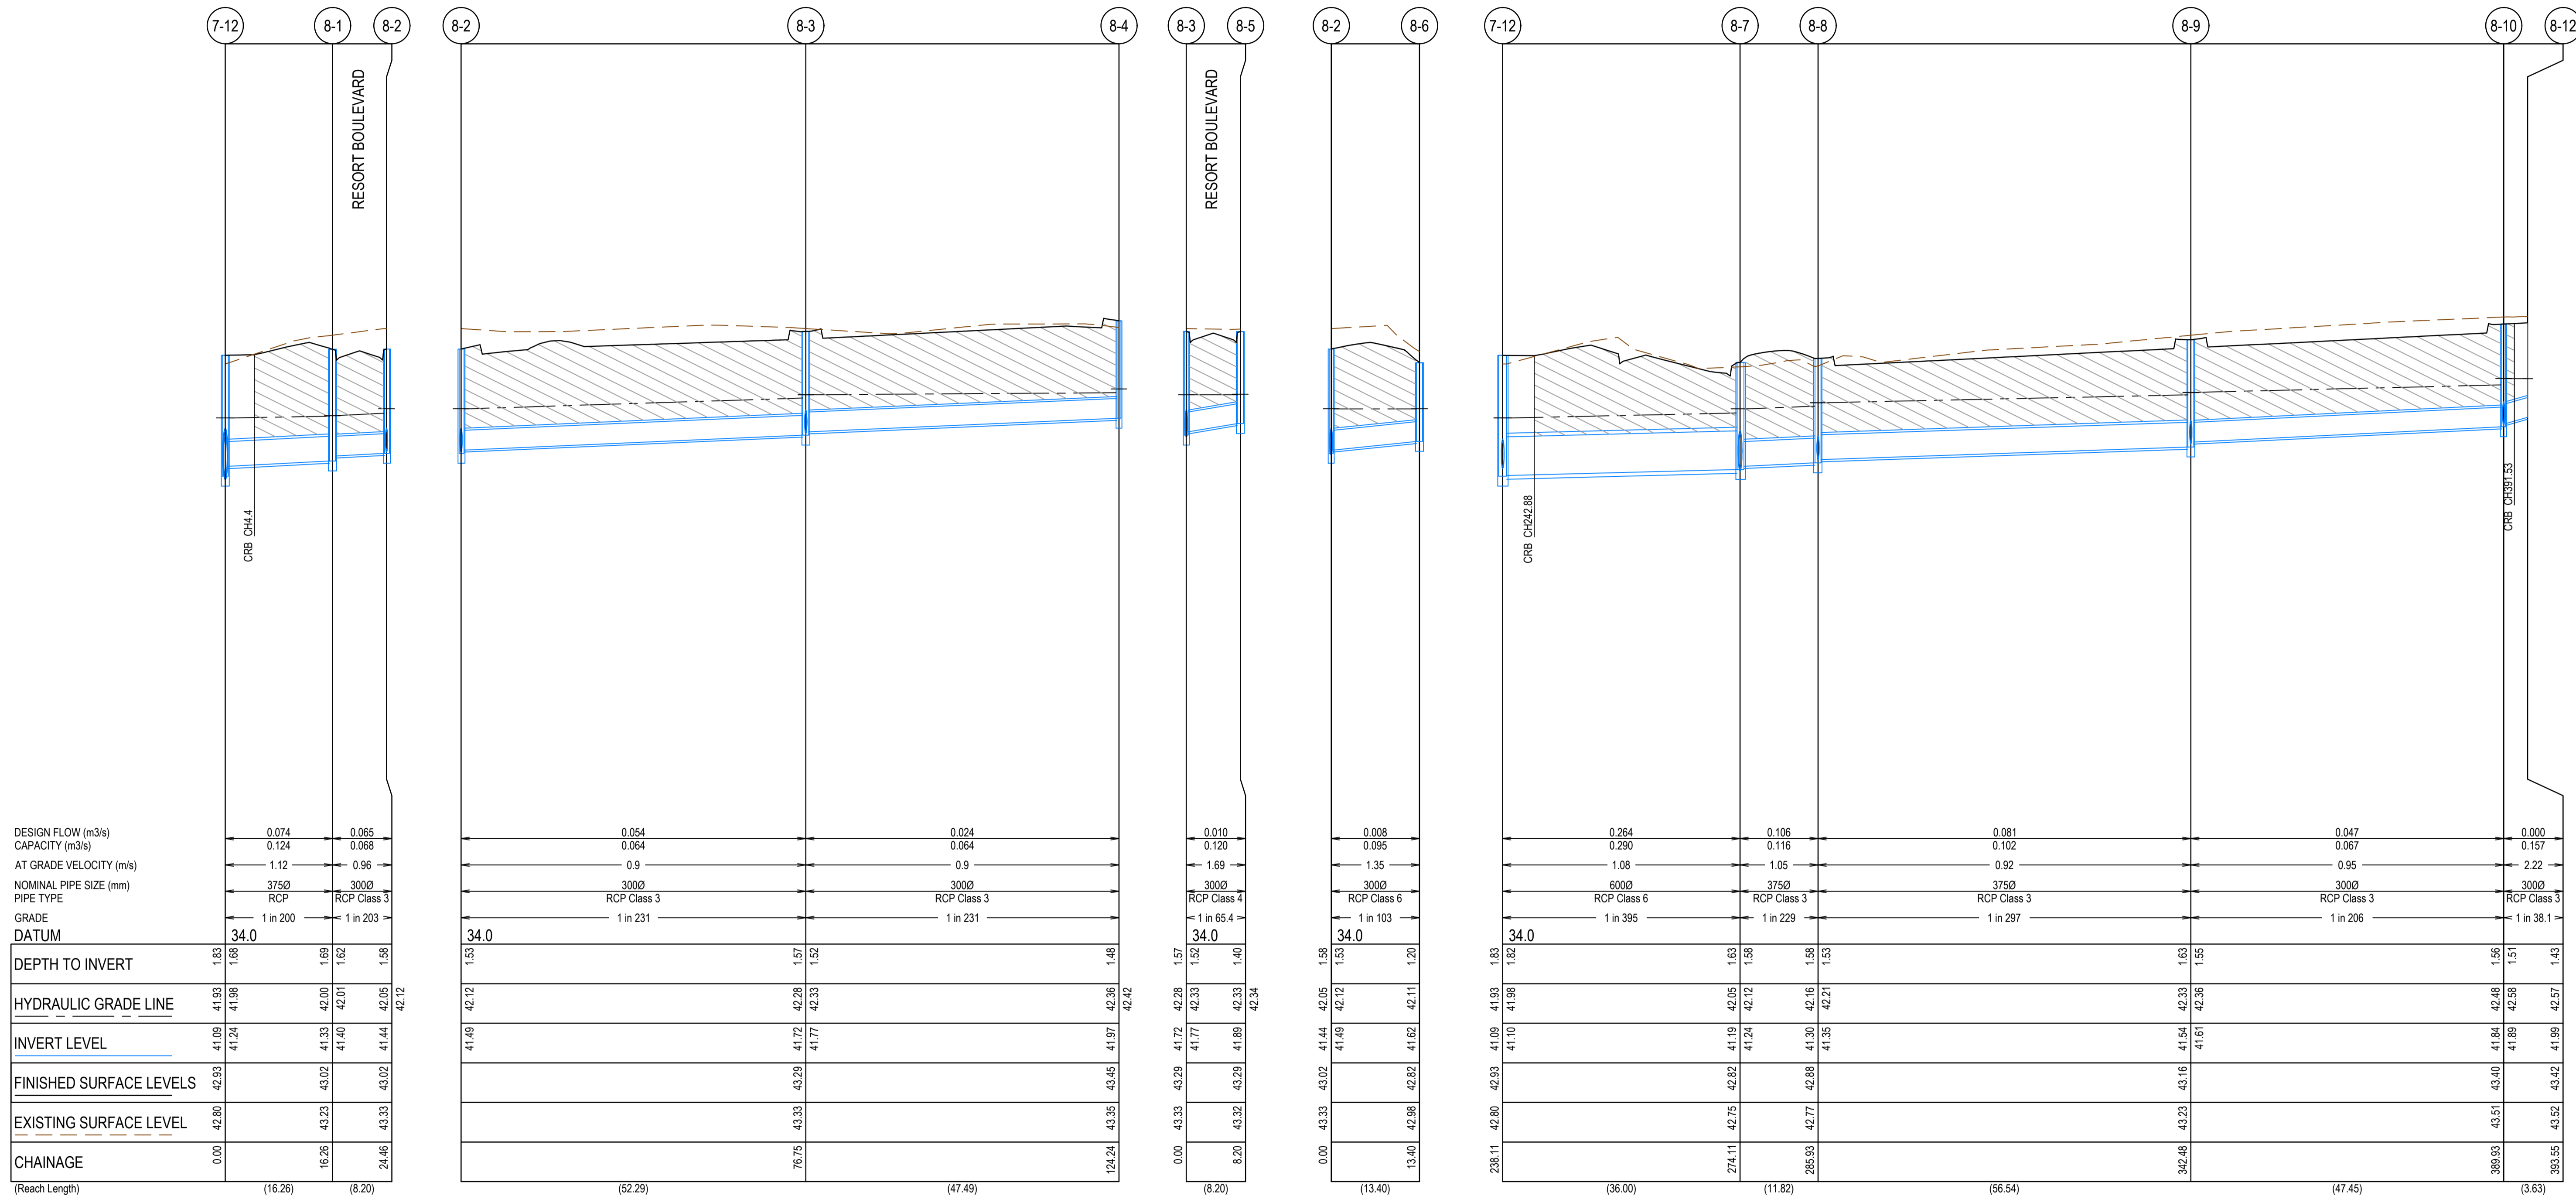



AS CONSTRUCTED PLANS

The purpose of these as-constructed plans is to update the design drawings to show significant changes which occurred during construction. Note that the levels shown on these plans are design levels, and have not been verified by survey. All information shown on these plans should be verified on site. SMEC Australia Pty Ltd accept no responsibility for loss or damages resulting from the inappropriate usage of these plans.



AS CONSTRUCTED


PLAN OF SUB. NO.
PS841640V/S16
PERMIT REF. NO.
WYP10107_17.02

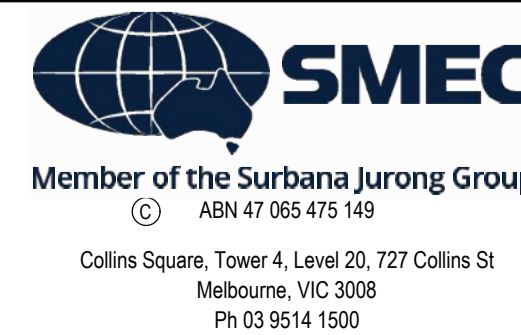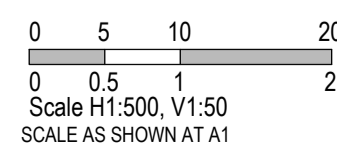

Alamora - Stage 8, Sayers Road, Tarnait
 Wyndham City Council
 Road and Drainage
 Drainage Longitudinal Sections - 1

MELWAYS REF 234 D6	PROJECT / DRAWING No. 2070E-A08-301	SHEET No. 13 of 20	REVISION 3
------------------------------	---	------------------------------	----------------------

CRUSHED ROCK BACKFILL
 CRB INDICATES CRUSHED ROCK BACKFILL COMPACTED IN ACCORDANCE WITH COUNCIL STANDARDS & SPECIFICATIONS, CLASS 3 UNLESS SPECIFIED OTHERWISE

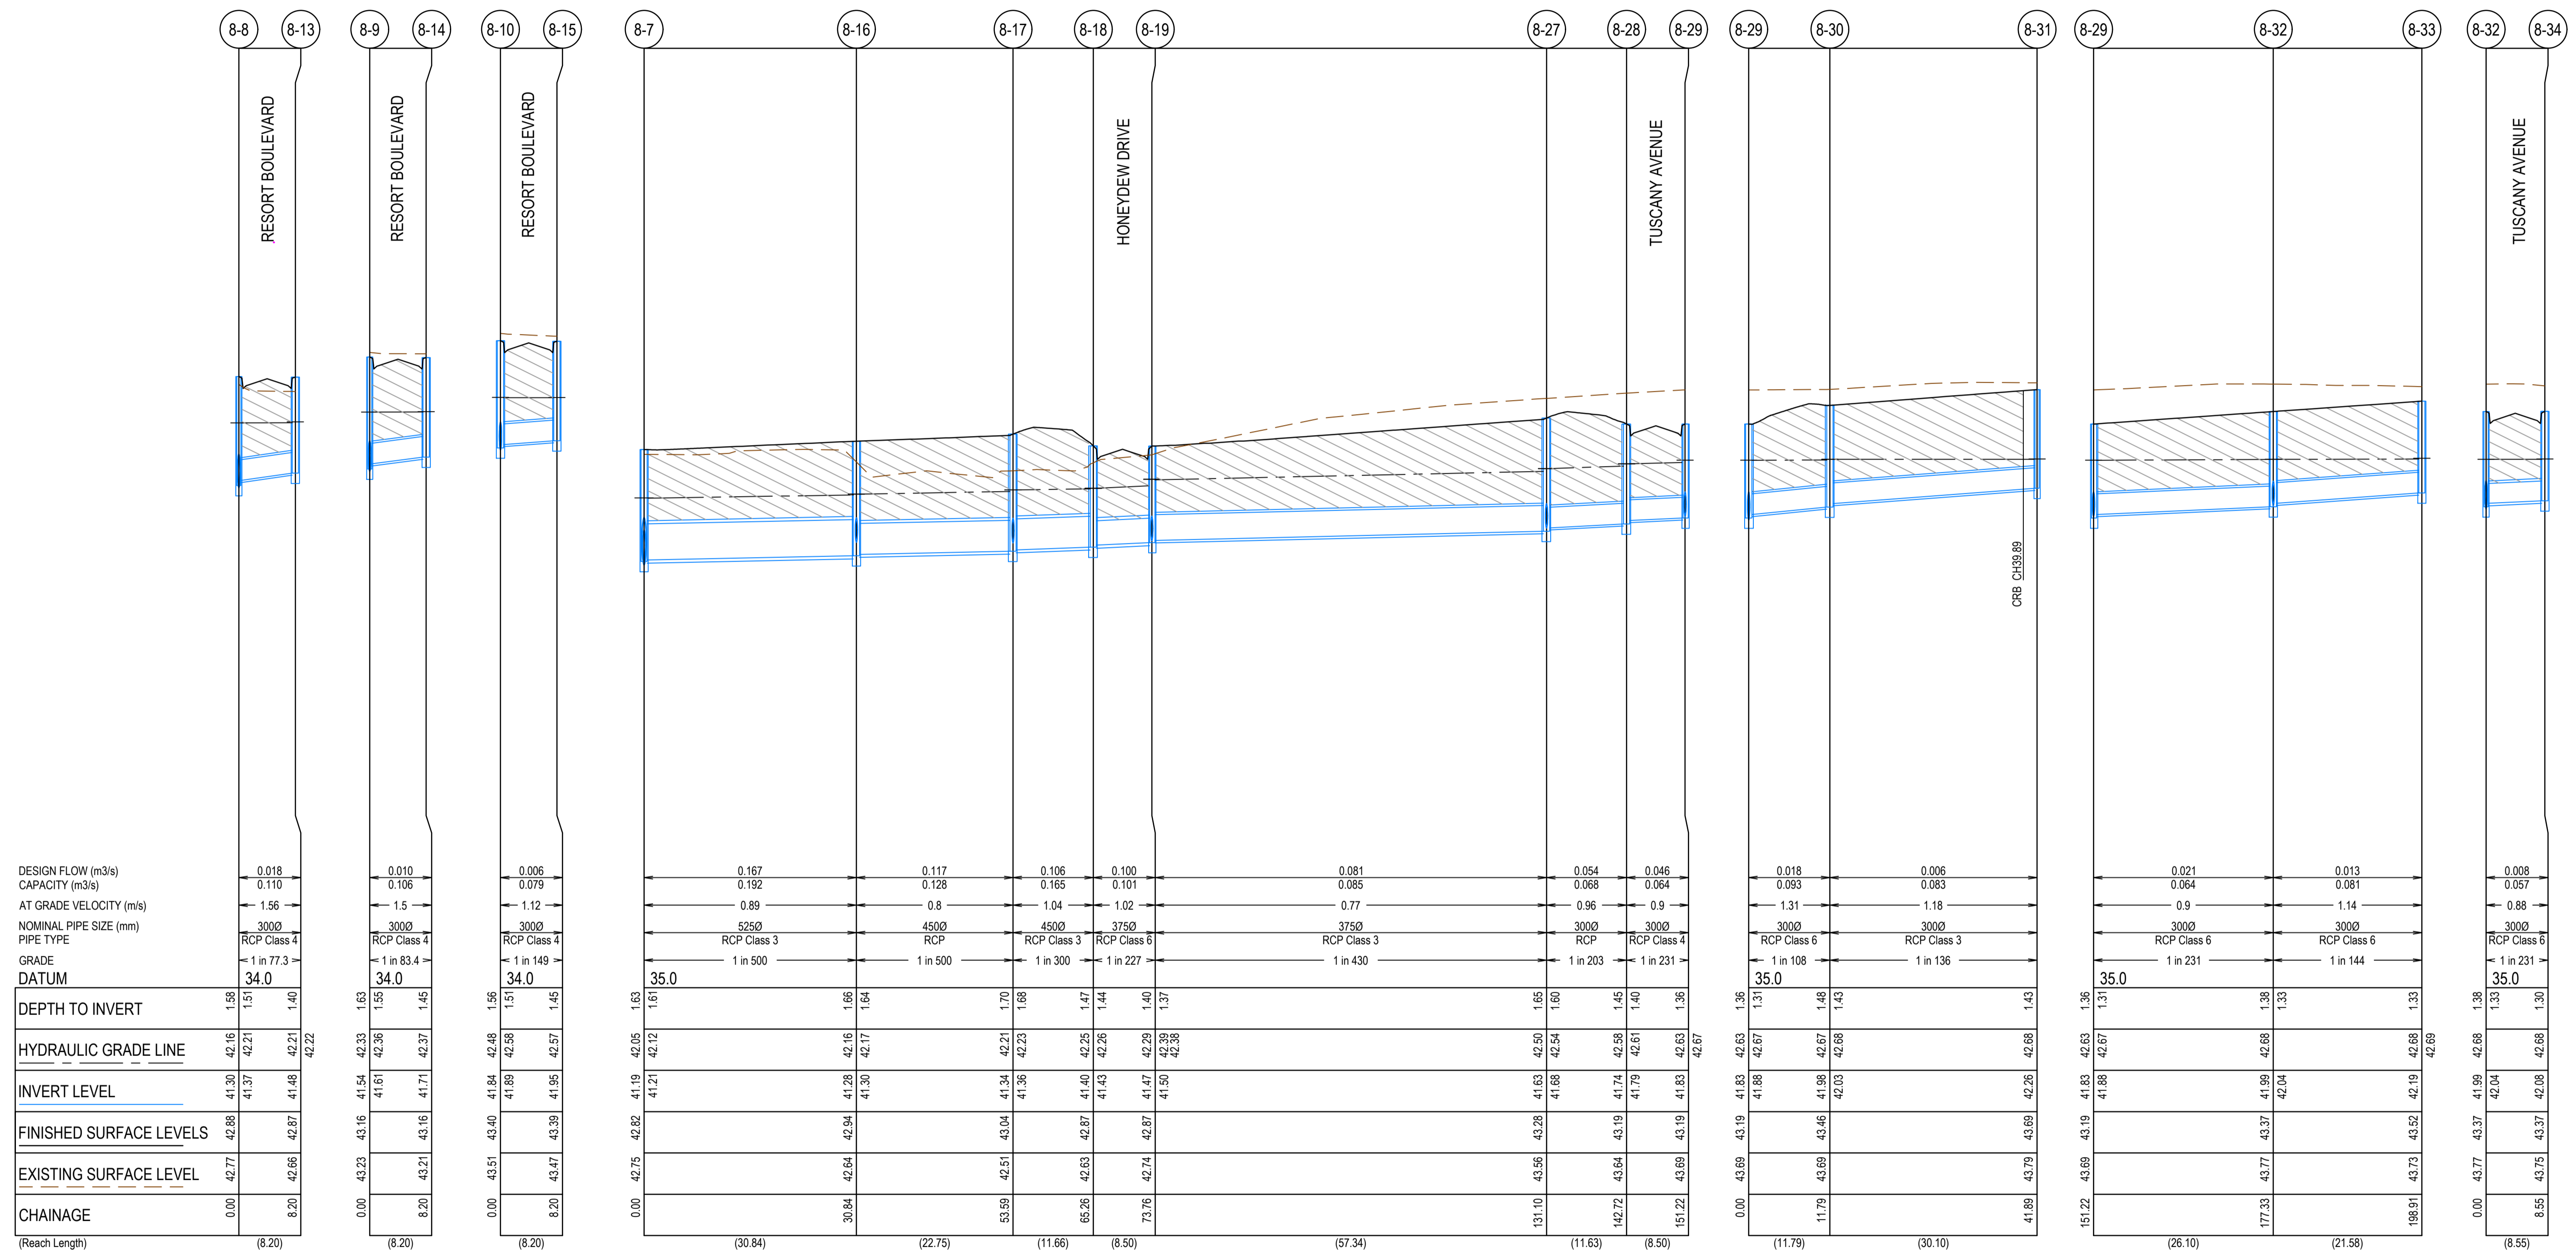

AS CONSTRUCTED PLANS

The purpose of these as-constructed plans is to update the design drawings to show significant changes which occurred during construction. Note that the levels shown on these plans are design levels, and have not been verified by survey. All information shown on these plans should be verified on site. SMEC Australia Pty Ltd accept no responsibility for loss or damages resulting from the inappropriate usage of these plans.

Quality Management ISO 9001
 OHS Management AS/NZS 4801
 Environmental Management ISO 14001

Global-Mark.com.au®

AS CONSTRUCTED

PLAN OF SUB. NO.
 PS841640V/S16
 PERMIT REF. NO.
 WYP10107_17.02

0 5 10 20
 0 0.5 1 2
 Scale H1:500, V1:50
 SCALE AS SHOWN AT A1


SMEC
 Member of the Surlana Jurong Group
 ABN 47 065 475 149
 Collins Square, Tower 4, Level 20, 727 Collins St
 Melbourne, VIC 3008
 Ph 03 9514 1500

ALAMORA
Tarnait

Alamora - Stage 8, Sayers Road, Tarnait
 Wyndham City Council
 Road and Drainage
 Drainage Longitudinal Sections - 2

MELWAYS REF 234 D6	PROJECT / DRAWING No. 2070E-A08-302	SHEET No. 14 of 20	REVISION 3
------------------------------	---	------------------------------	----------------------

CRUSHED ROCK BACKFILL
 CRB INDICATES CRUSHED ROCK BACKFILL COMPACTED IN ACCORDANCE WITH COUNCIL STANDARDS & SPECIFICATIONS, CLASS 3 UNLESS SPECIFIED OTHERWISE

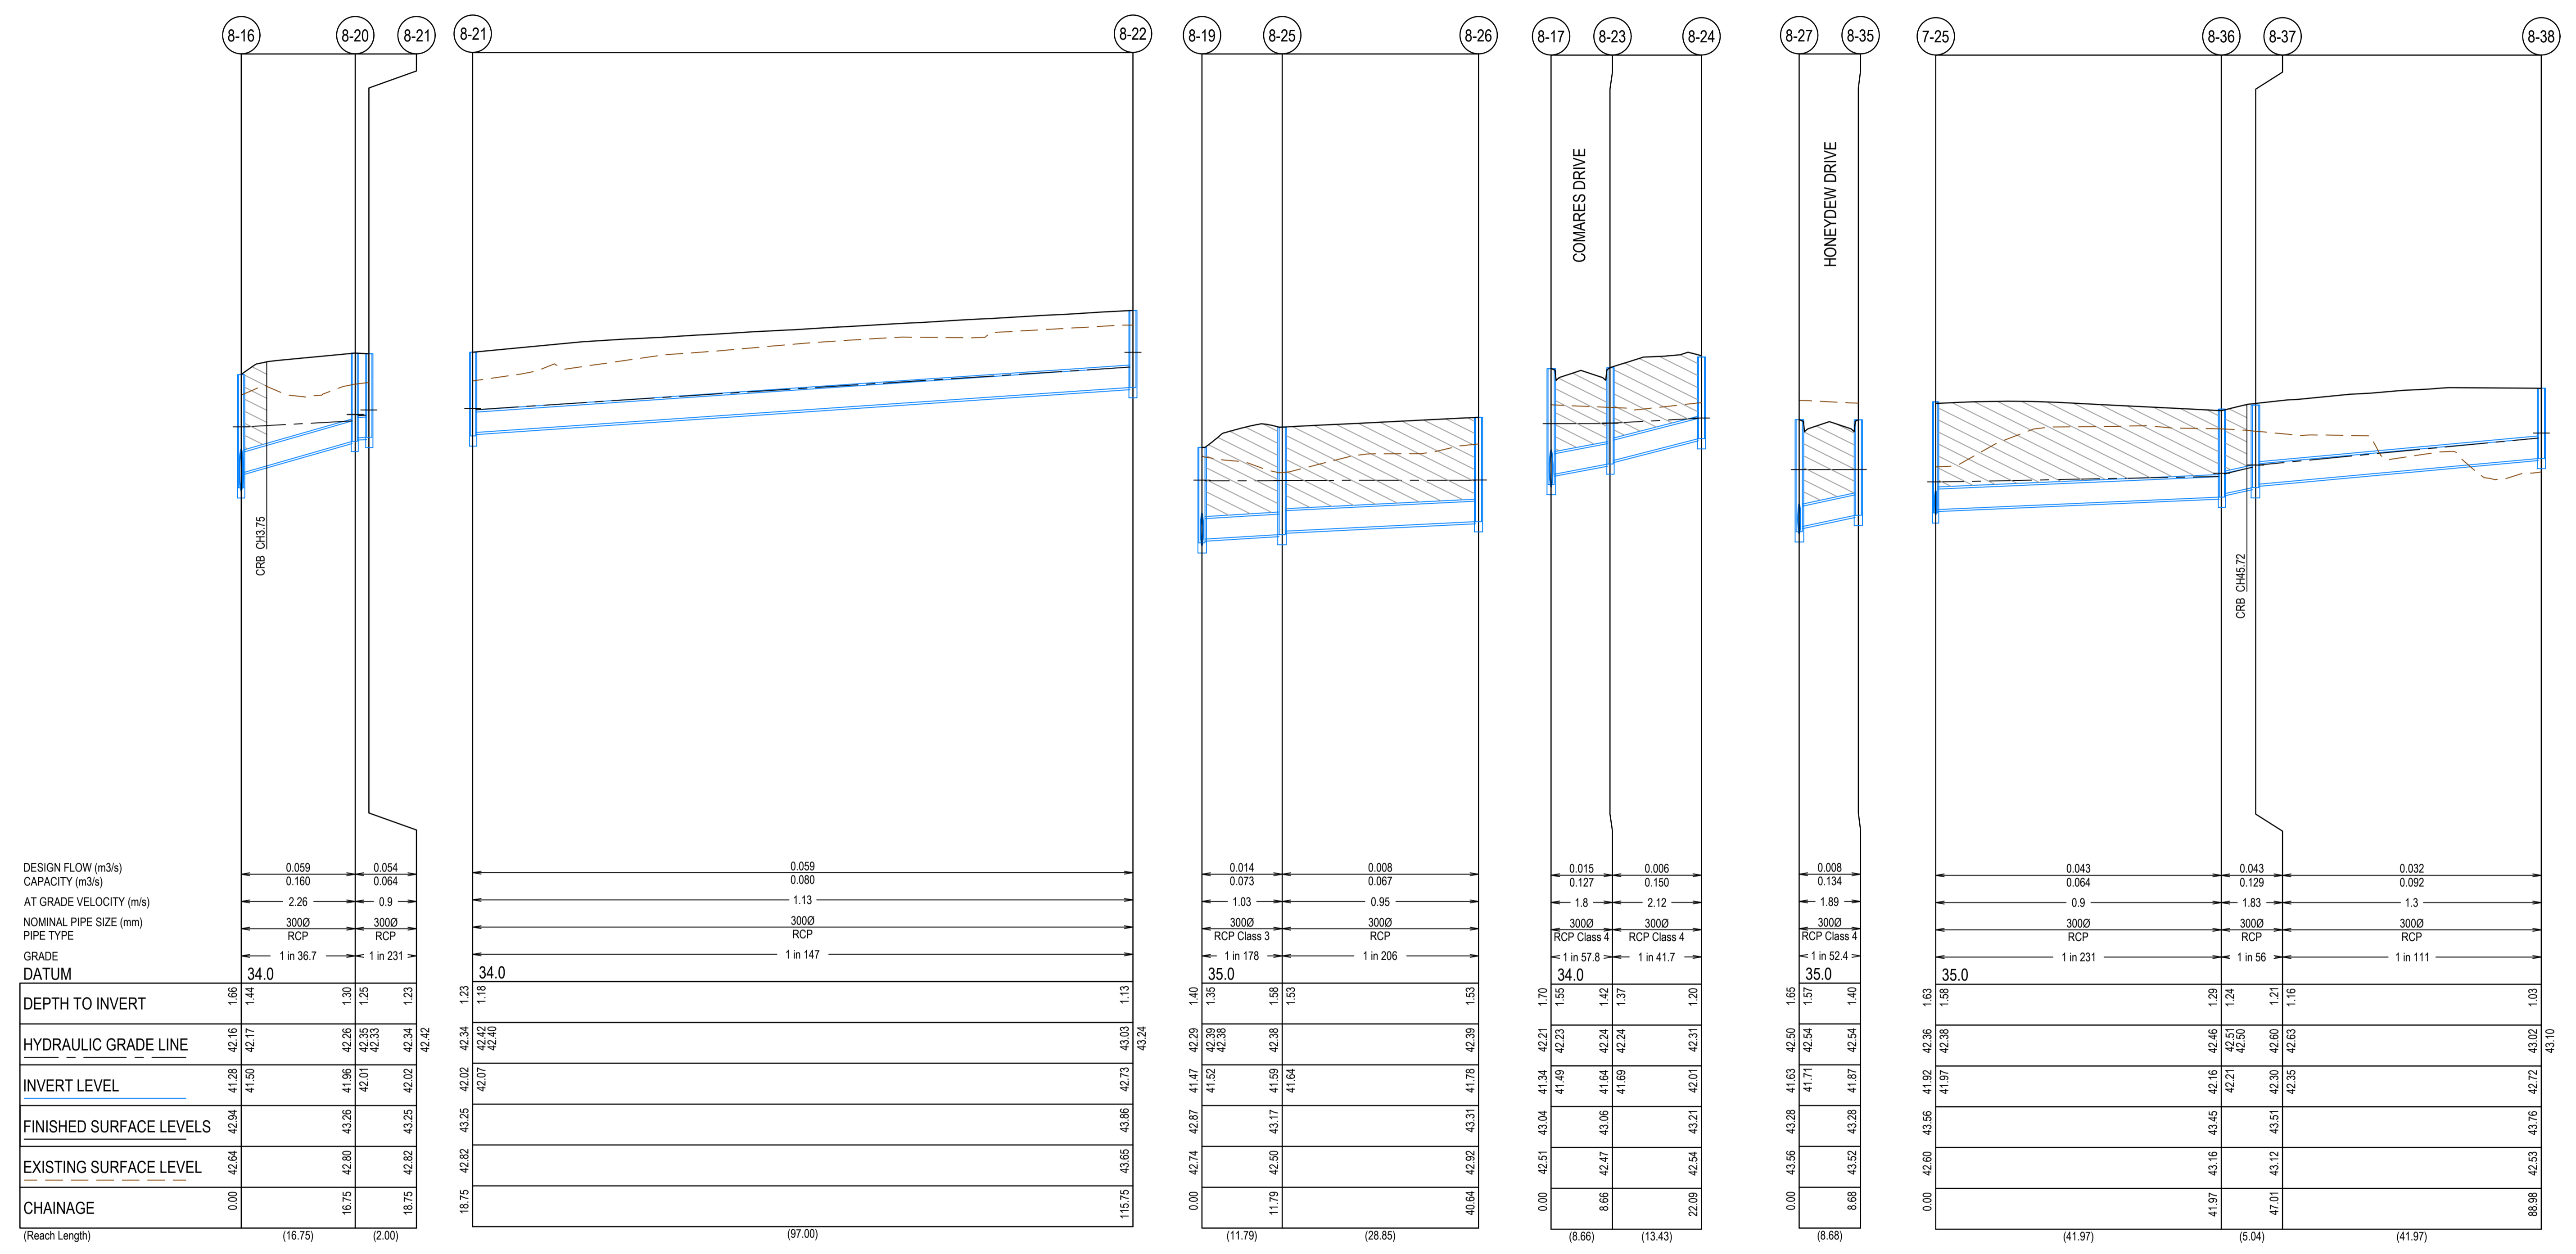


AS CONSTRUCTED PLANS

The purpose of these as-constructed plans is to update the design drawings to show significant changes which occurred during construction. Note that the levels shown on these plans are design levels, and have not been verified by survey. All information shown on these plans should be verified on site. SMEC Australia Pty Ltd accept no responsibility for loss or damages resulting from the inappropriate usage of these plans.



AS CONSTRUCTED

PLAN OF SUB. NO.	PS841640V/S16
PERMIT REF. NO.	WYP10107_17.02

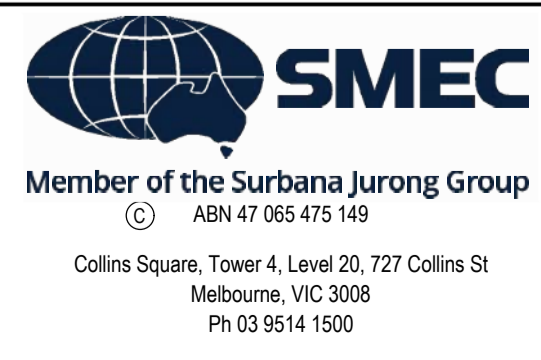

Alamora - Stage 8, Sayers Road, Tarnait
 Wyndham City Council
 Road and Drainage
 Drainage Longitudinal Sections - 3

MELWAYS REF	PROJECT / DRAWING No	SHEET No	REVISION
234 D6	2070E-A08-303	15 of 20	2

PIT NUMBER	TYPE	INTERNAL		INLET		OUTLET		F.S.L.	DEPTH	STANDARD DRAWING	REMARKS
		WIDTH (mm)	LENGTH (mm)	DIAMETER (mm)	INV R.L. (m)	DIAMETER (mm)	INV R.L. (m)				
		8-01	SIDE ENTRY PIT	600	900	300	41.4				
8-02	SIDE ENTRY PIT	600	900	300	41.49	300	41.44	43.022	1.581	EDCM 601	
8-03	SIDE ENTRY PIT	600	900	300	41.767	300	41.717	43.288	1.571	EDCM 601	
8-04	JUNCTION PIT	600	900			300	41.972	43.451	1.478	EDCM 605	
8-05	SIDE ENTRY PIT	600	900			300	41.892	43.287	1.395	EDCM 601	
8-06	DOUBLE SIDE ENTRY PIT	600	900			300	41.621	42.816	1.195	EDCM 602	
8-07	DOUBLE SIDE ENTRY PIT	900	1200	375	41.245	600	41.195	42.82	1.625	EDCM 602 & 607	PIT TO BE HAUNCHED TO 600x900 COVER TOWARDS PAVEMENT
8-08	DOUBLE SIDE ENTRY PIT	600	900	525	41.215	375	41.3	42.881	1.581	EDCM 602	
8-09	SIDE ENTRY PIT	600	900	300	41.35	375	41.375	42.881	1.581	EDCM 602	
8-09	SIDE ENTRY PIT	600	900	300	41.612	375	41.537	43.164	1.627	EDCM 601	
8-10	SIDE ENTRY PIT	600	900	300	41.612	300	41.845	43.401	1.556	EDCM 601	
8-10	SIDE ENTRY PIT	600	900	300	41.895	300	41.895	43.401	1.556	EDCM 601	
8-12	ENDPIPE					300	41.987	43.419	1.432		CAP END PIPE WITH STEEL PLATE FOR FUTURE CONNECTION
08-13	DOUBLE SIDE ENTRY PIT	600	900			300	41.477	42.873	1.395	EDCM 602	
08-14	SIDE ENTRY PIT	600	900			300	41.71	43.156	1.445	EDCM 601	
08-15	SIDE ENTRY PIT	600	900			300	41.947	43.393	1.445	EDCM 601	
08-16	JUNCTION PIT	750	900	450	41.296	525	41.276	42.941	1.664	EDCM 605 & 607	PIT TO BE HAUNCHED TO 600x900 COVER TOWARDS PAVEMENT
08-17	SIDE ENTRY PIT	750	900	300	41.501	450	41.342	43.044	1.702	EDCM 601 & 607	PIT TO BE HAUNCHED TO 600x900 COVER TOWARDS PAVEMENT
08-18	DOUBLE SIDE ENTRY PIT	600	900	355	41.362	450	41.401	42.872	1.472	EDCM 602	
08-19	DOUBLE SIDE ENTRY PIT	600	900	375	41.498	355	41.468	42.87	1.402	EDCM 602	
08-20	JUNCTION PIT	600	900	300	41.523	300	42.008	43.256	1.298	EDCM 605	
08-21	JUNCTION PIT	600	900	300	42.067	300	42.017	43.246	1.23	EDCM 605	
08-22	JUNCTION PIT	600	900			300	42.728	43.861	1.134	EDCM 605	
08-23	SIDE ENTRY PIT	600	900	300	41.692	300	41.642	43.058	1.416	EDCM 601	
08-24	GRADED PIT	600	900			300	42.013	43.215	1.201	EDCM 605	
08-25	SIDE ENTRY PIT	600	900	300	41.64	300	41.59	43.168	1.579	EDCM 601	
08-26	JUNCTION PIT	600	900			300	41.779	43.312	1.533	EDCM 605	
08-27	SIDE ENTRY PIT	600	900	300	41.682	375	41.632	43.278	1.646	EDCM 601	
08-28	DOUBLE SIDE ENTRY PIT	600	900	300	41.707	300	41.739	43.19	1.451	EDCM 602	
08-29	DOUBLE SIDE ENTRY PIT	600	900	300	41.789	300	41.739	43.19	1.451	EDCM 602	
08-29	DOUBLE SIDE ENTRY PIT	600	900	300	41.876	300	41.826	43.19	1.365	EDCM 602	
08-30	SIDE ENTRY PIT	600	900	300	41.876	300	41.984	43.462	1.478	EDCM 601	
08-31	SIDE ENTRY PIT	600	900	300	42.034	300	42.256	43.691	1.434	EDCM 601	
08-32	JUNCTION PIT	600	900	300	42.039	300	41.989	43.372	1.384	EDCM 605	
08-33	JUNCTION PIT	600	900			300	42.189	43.523	1.334	EDCM 605	
08-34	JUNCTION PIT	600	900			300	42.076	43.375	1.299	EDCM 605	
08-35	SIDE ENTRY PIT	600	900			300	41.872	43.275	1.403	EDCM 601	
08-36	JUNCTION PIT	600	900	300	42.206	300	42.156	43.449	1.292	EDCM 605	
08-37	JUNCTION PIT	600	900	300	42.346	300	42.296	43.508	1.212	EDCM 605	
08-38	JUNCTION PIT	600	900			300	42.724	43.756	1.031	EDCM 605	
7-12	JUNCTION PIT	900	1200	600	41.104	675	41.094	42.927	1.833	EDCM 605 & 607	PIT TO BE HAUNCHED TO 600x900 COVER TOWARDS PAVEMENT
				375	41.244						

AS CONSTRUCTED PLANS


The purpose of these as-constructed plans is to update the design drawings to show significant changes which occurred during construction. Note that the levels shown on these plans are design levels, and have not been verified by survey. All information shown on these plans should be verified on site. SMEC Australia Pty Ltd accept no responsibility for loss or damages resulting from the inappropriate usage of these plans.



PLAN OF SUB. NO.
PS841640V/S16
PERMIT REF. NO.
WYP10107_17.02


AS CONSTRUCTED

SCALE AS SHOWN AT A1

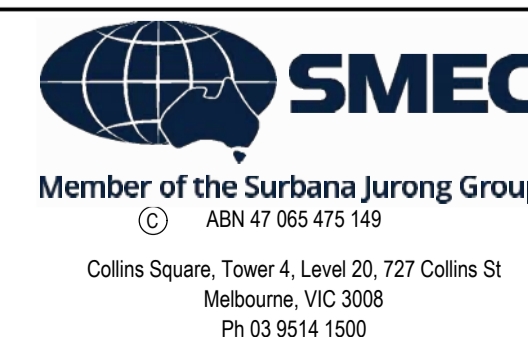

Alamora - Stage 8, Sayers Road, Tarnait
Wyndham City Council
Road and Drainage
Drain Pit Schedule

MELWAYS REF 234 D6	PROJECT / DRAWING No. 2070E-A08-351	SHEET No. 16 of 20	REVISION 2
------------------------------	---	------------------------------	----------------------

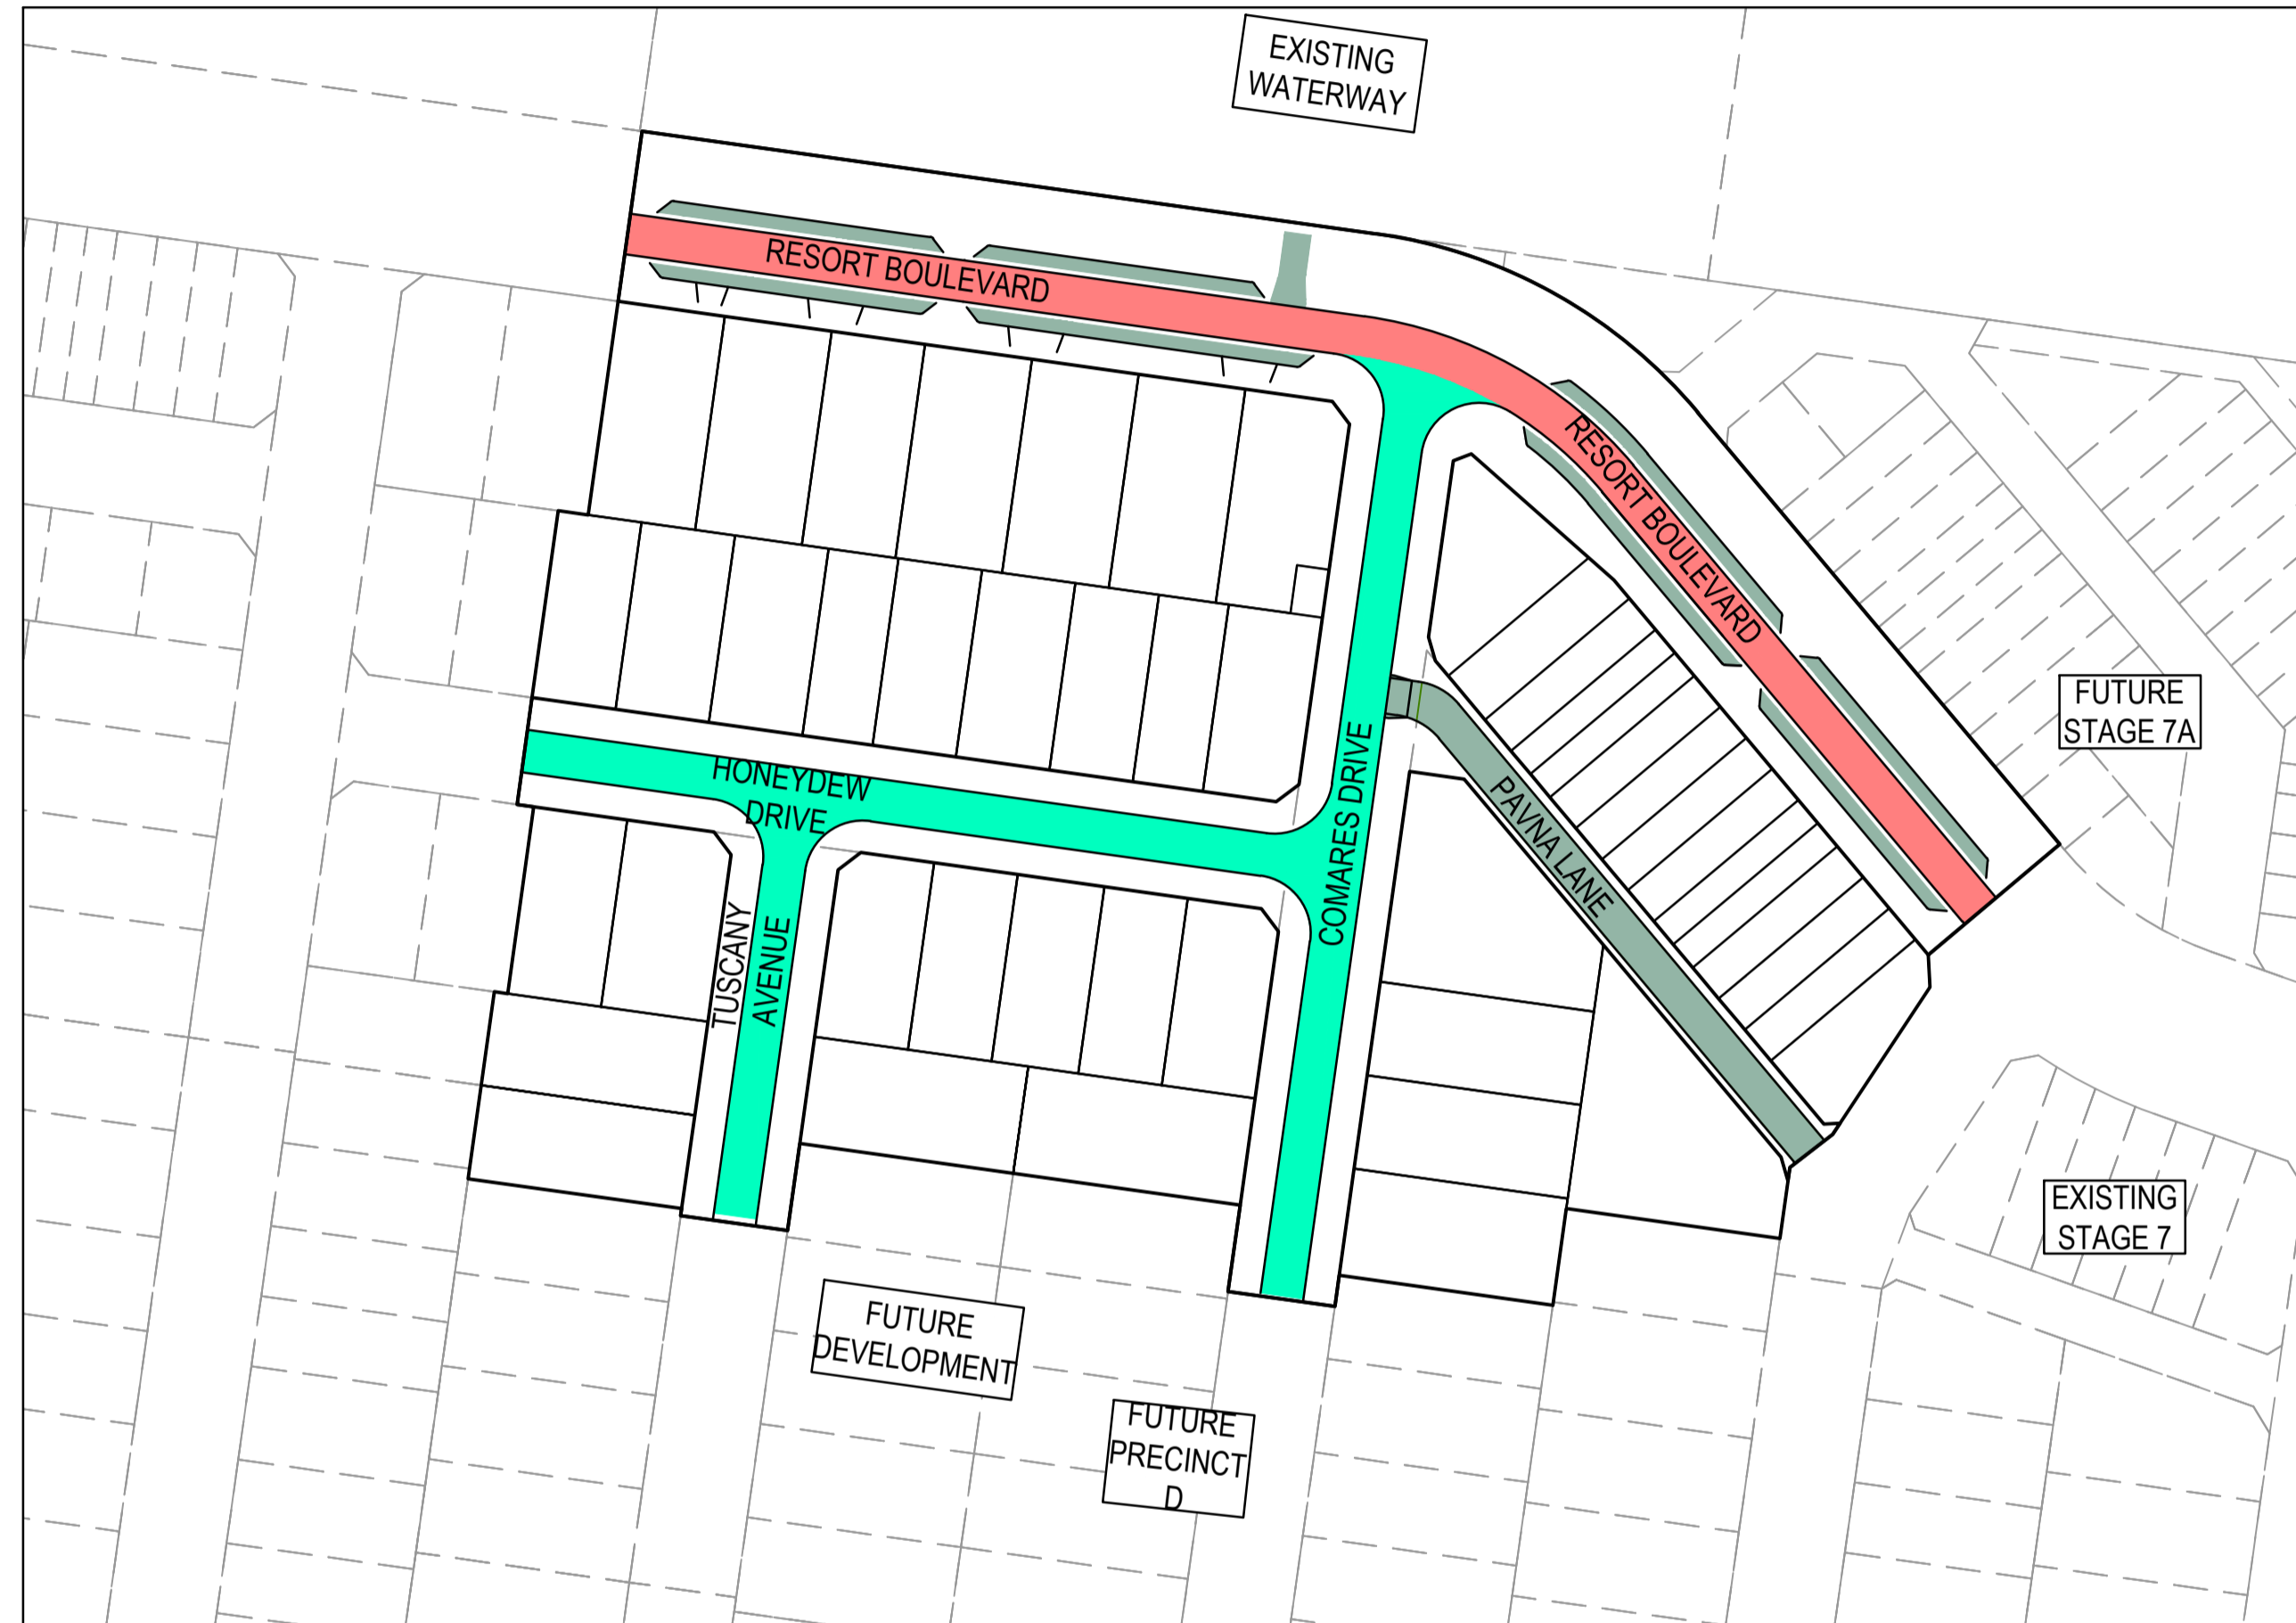

PARKING BAY AND PAVNA LANE PAVEMENT COMPOSITION			
300mm DEPTH PAVEMENT COMPOSITION		LAYER THICKNESS (mm)	MATERIAL
PAVEMENT LAYER			
CONCRETE	UPPER LAYER	200	CONCRETE. SL82 MESH. 40mm TOP COVER
CRUSHED ROCK	BASE	100	CLASS 3 CRUSHED ROCK 20mm NOM. SIZE



ACCESS PLACE - HONEYDEW DRIVE, COMARES DRIVE AND TUSCANY AVENUE			
530mm DEEP PAVEMENT (INCLUDING 200mm DEEP CAPPING) AND 200mm SUBGRADE		LAYER THICKNESS (mm)	MATERIAL
PAVEMENT LAYER			
ASPHALT	WEARING COURSE	30	SIZE 10 TYPE N ASPHALT CLASS 320 BINDER
	INTERMEDIATE COURSE	30	SIZE 10 TYPE N ASPHALT CLASS 320 BINDER
	SAMI SEAL	-	SIZE 10 SAMI SEAL S18RF
	BITUMINOUS PRIME	-	BITUMINOUS PRIME
BASE COURSE		130	SIZE 20 CLASS 2 CRUSHED ROCK. COMPACTED TO A MINIMUM DENSITY RATIO OF 98% (MODIFIED) AS1289, 5.2.1
SUBBASE COURSE		140	SIZE 20 CLASS 3 CRUSHED ROCK. COMPACTED TO A MINIMUM DENSITY RATIO OF 96% (MODIFIED) AS1289, 5.2.1
CAPPING		200	RIPPED ROCK (SELECT FILL) OR STABILISED CLAY MEETING THE FOLLOWING PROPERTIES: CBR >=7%, PERMEABILITY k < 1x10 ⁻⁹ m/s AND SWELL < 1.5% MATERIAL. COMPACTED TO A MINIMUM DENSITY RATIO 98% (STANDARD) AS1289, 5.1.1
SUBGRADE/CONSTRUCTION LAYER		200	RIPPED ROCK OR STABILISED CLAY MEETING THE FOLLOWING PROPERTIES: CBR >=7%, PERMEABILITY k < 1x10 ⁻⁹ m/s AND SWELL < 1.5% MATERIAL. COMPACTED TO A MINIMUM DENSITY RATIO 98% (STANDARD) AS1289, 5.1.1

CONNECTOR ROAD - HERMOSA DRIVE AND RESORT BOULEVARD PAVEMENT COMPOSITION			
550mm DEPTH PAVEMENT COMPOSITION		LAYER THICKNESS (mm)	MATERIAL
PAVEMENT LAYER			
ASPHALT	WEARING COURSE	40	SIZE 14 TYPE N CLASS 320 ASPHALT
	INTERMEDIATE COURSE	75	SIZE 20 TYPE SI ASPHALT CLASS 320 ASPHALT
	BASE COURSE	75	SIZE 20 TYPE SI ASPHALT CLASS 320 ASPHALT
	SAMI SEAL	-	-
	BITUMINOUS PRIME	-	-
SUBBASE COURSE	UPPER	100	SIZE 20 CLASS 3 CEMENT TREATED CRUSHED ROCK (CTCR) 3% CEMENT. COMPACTED TO A MINIMUM DENSITY RATIO OF 98% (MODIFIED) AS1289, 5.2.1
	LOWER	110	SIZE 20 CLASS 3 CRUSHED ROCK. COMPACTED TO A MINIMUM DENSITY OF 96% (MODIFIED) AS1289, 5.2.1
CAPPING	CAPPING LAYER	150	RIPPED ROCK OR STABILISED CLAY MEETING THE FOLLOWING PROPERTIES: CBR >=7%, PERMEABILITY k < 1x10 ⁻⁹ m/s AND SWELL < 1.5% MATERIAL. COMPACTED TO A MINIMUM DENSITY RATIO 98% (STANDARD) AS1289, 5.1.1
SUBGRADE/CONSTRUCTION LAYER	SUBGRADE/CONSTRUCTION LAYER	200	RIPPED ROCK OR STABILISED CLAY MEETING THE FOLLOWING PROPERTIES: CBR >=7%, PERMEABILITY k < 1x10 ⁻⁹ m/s AND SWELL < 1.5% MATERIAL. COMPACTED TO A MINIMUM DENSITY RATIO 98% (STANDARD) AS1289, 5.1.1

WARNING
BEWARE OF UNDERGROUND SERVICES
 The locations of underground services are approximate only and their exact position should be proven on site.
 No guarantee is given that all existing services are shown.
 Locate all underground services before commencement of works
DIAL 1100 BEFORE YOU DIG
www.1100.com.au

AS CONSTRUCTED PLANS
 The purpose of these as-constructed plans is to update the design drawings to show significant changes which occurred during construction. Note that the levels shown on these plans are design levels, and have not been verified by survey. All information shown on these plans should be verified on site. SMEC Australia Pty Ltd accept no responsibility for loss or damages resulting from the inappropriate usage of these plans.

PLAN OF SUB. NO. PS41640V/S16
 PERMIT REF. NO. WYP10107_17.02
AS CONSTRUCTED

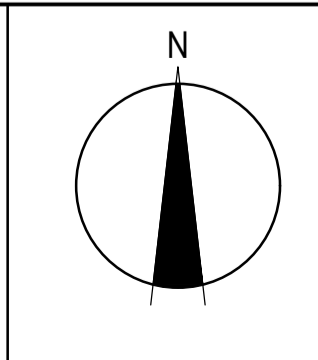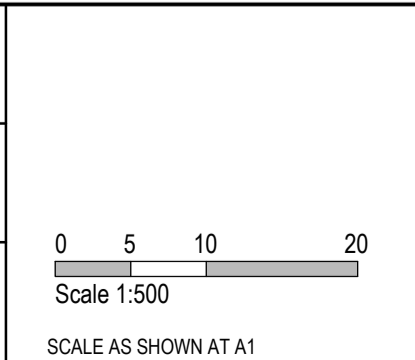


Member of the **Surbana Jurong Group**
 ABN 47 065 475 149
 Collins Square, Tower 4, Level 20, 727 Collins St
 Melbourne, VIC 3008
 Ph 03 9514 1500




Alamora - Stage 8, Sayers Road, Tarnait
 Wyndham City Council
 Road and Drainage
 Pavement Details


MELWAYS REF 234 D6	PROJECT / DRAWING No. 2070E-A08-411	SHEET No. 17 of 20	REVISION 3
------------------------------	---	------------------------------	----------------------

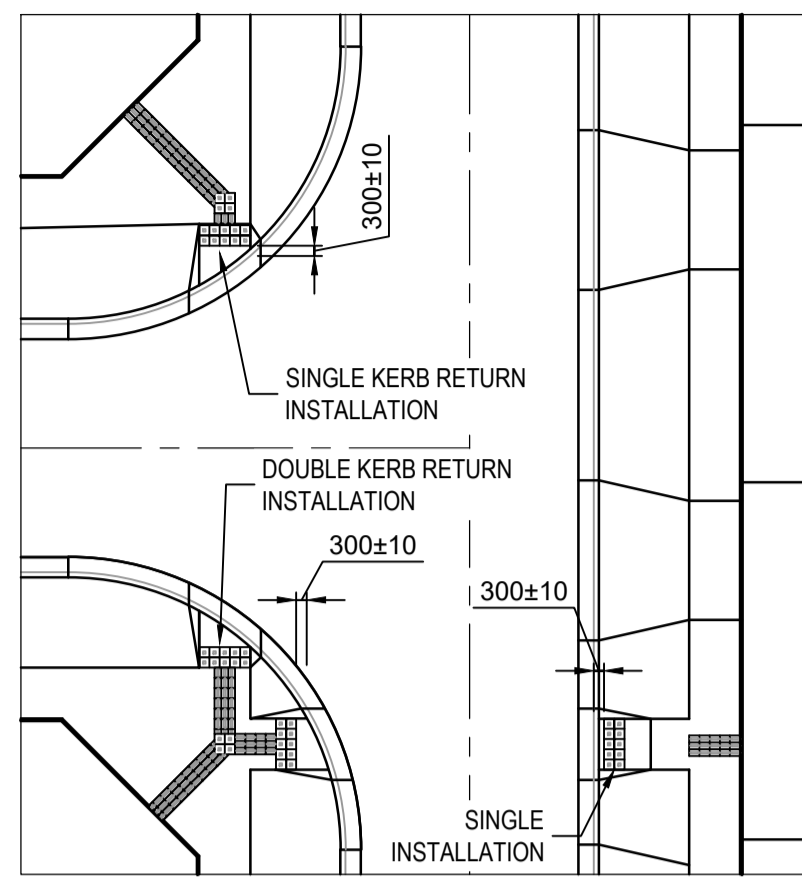


TYPICAL TCSI LAYOUT
N.T.S
REFER TO NOTE 34

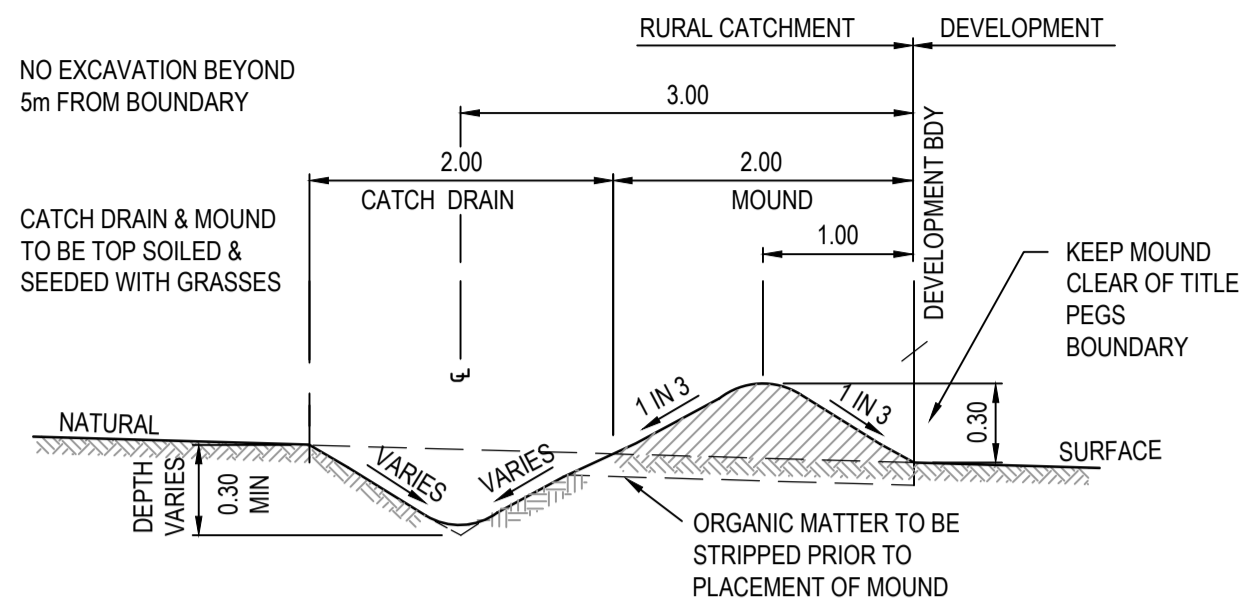

TYPICAL SECTION THROUGH CATCH DRAIN
NOT TO SCALE

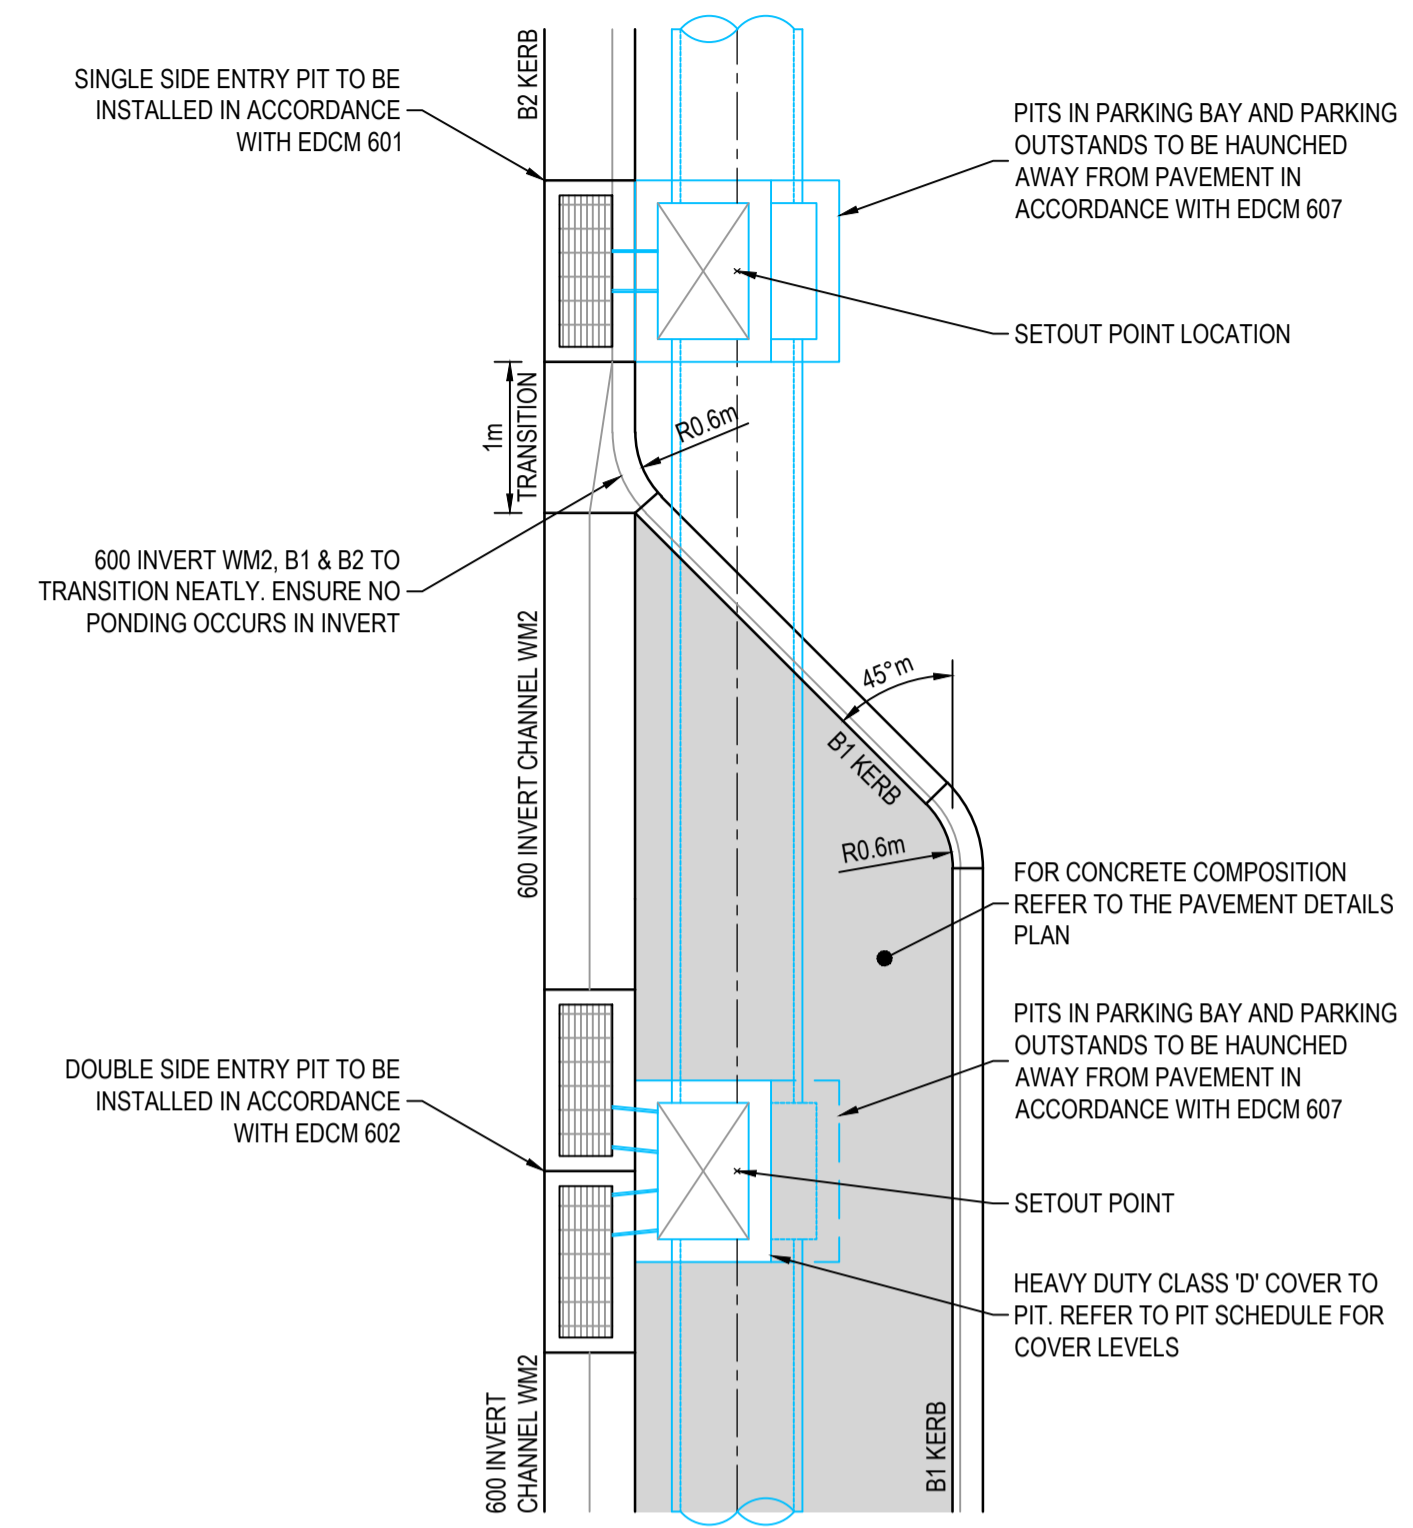


TYPICAL PARKING BAY & DRAINAGE PIT LAYOUT
SCALE 1:50

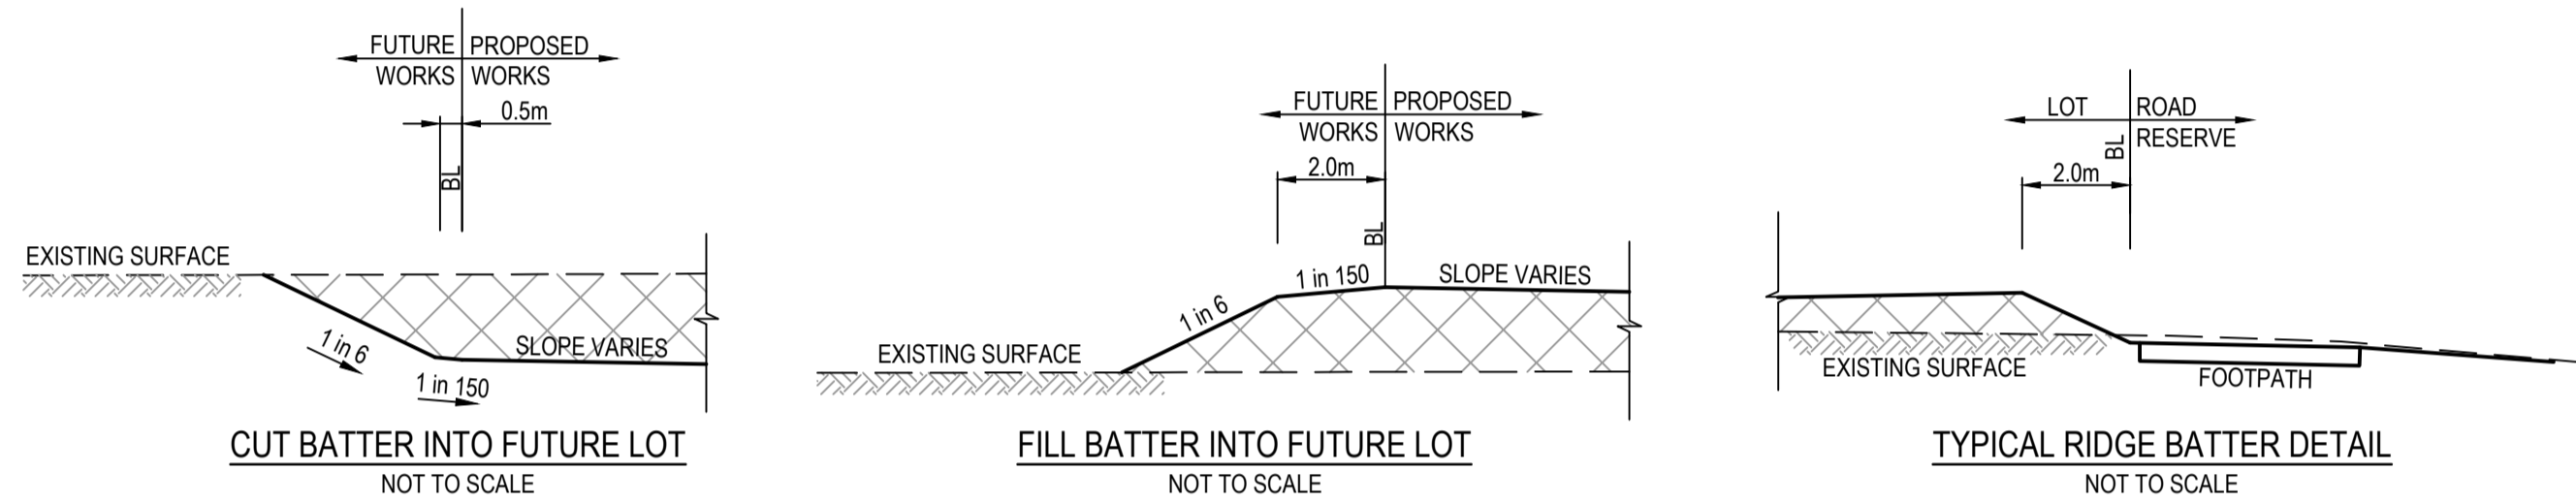

CUT BATTER INTO FUTURE LOT
NOT TO SCALE


FILL BATTER INTO FUTURE LOT
NOT TO SCALE

TYPICAL RIDGE BATTER DETAIL
NOT TO SCALE

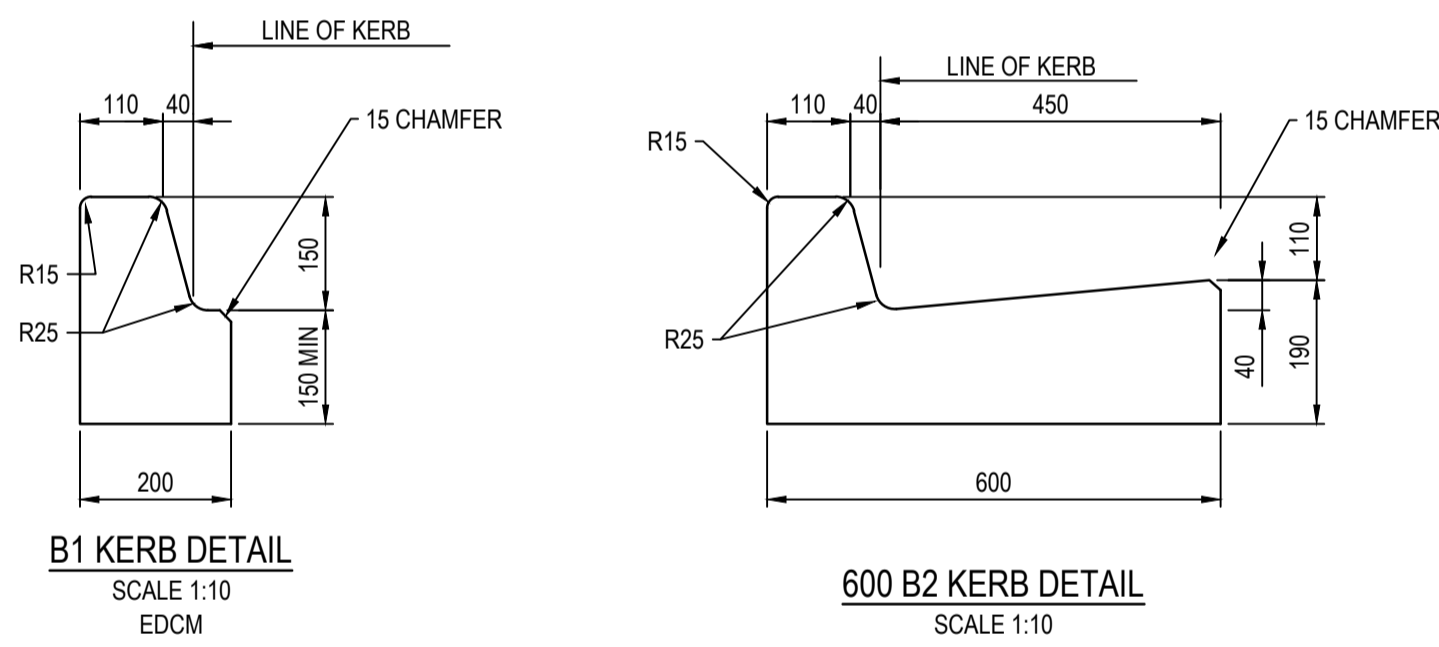


B1 KERB DETAIL
SCALE 1:10
EDCM

600 B2 KERB DETAIL
SCALE 1:10
EDCM

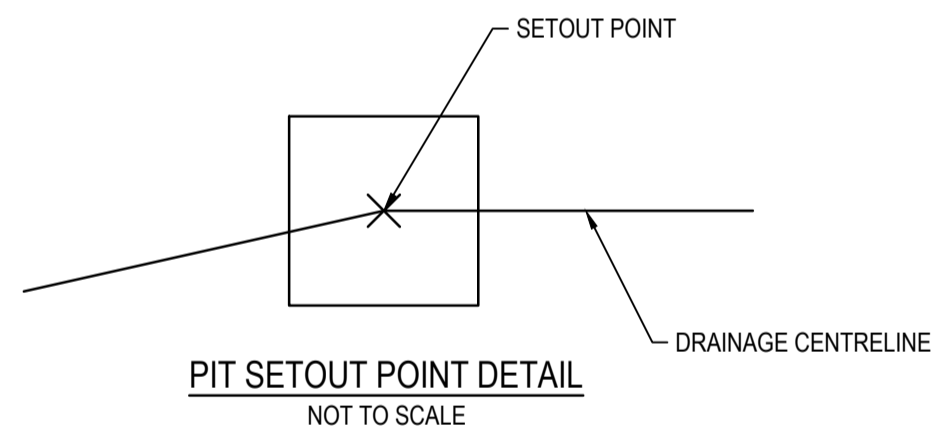


PIT SETOUT POINT DETAIL
NOT TO SCALE

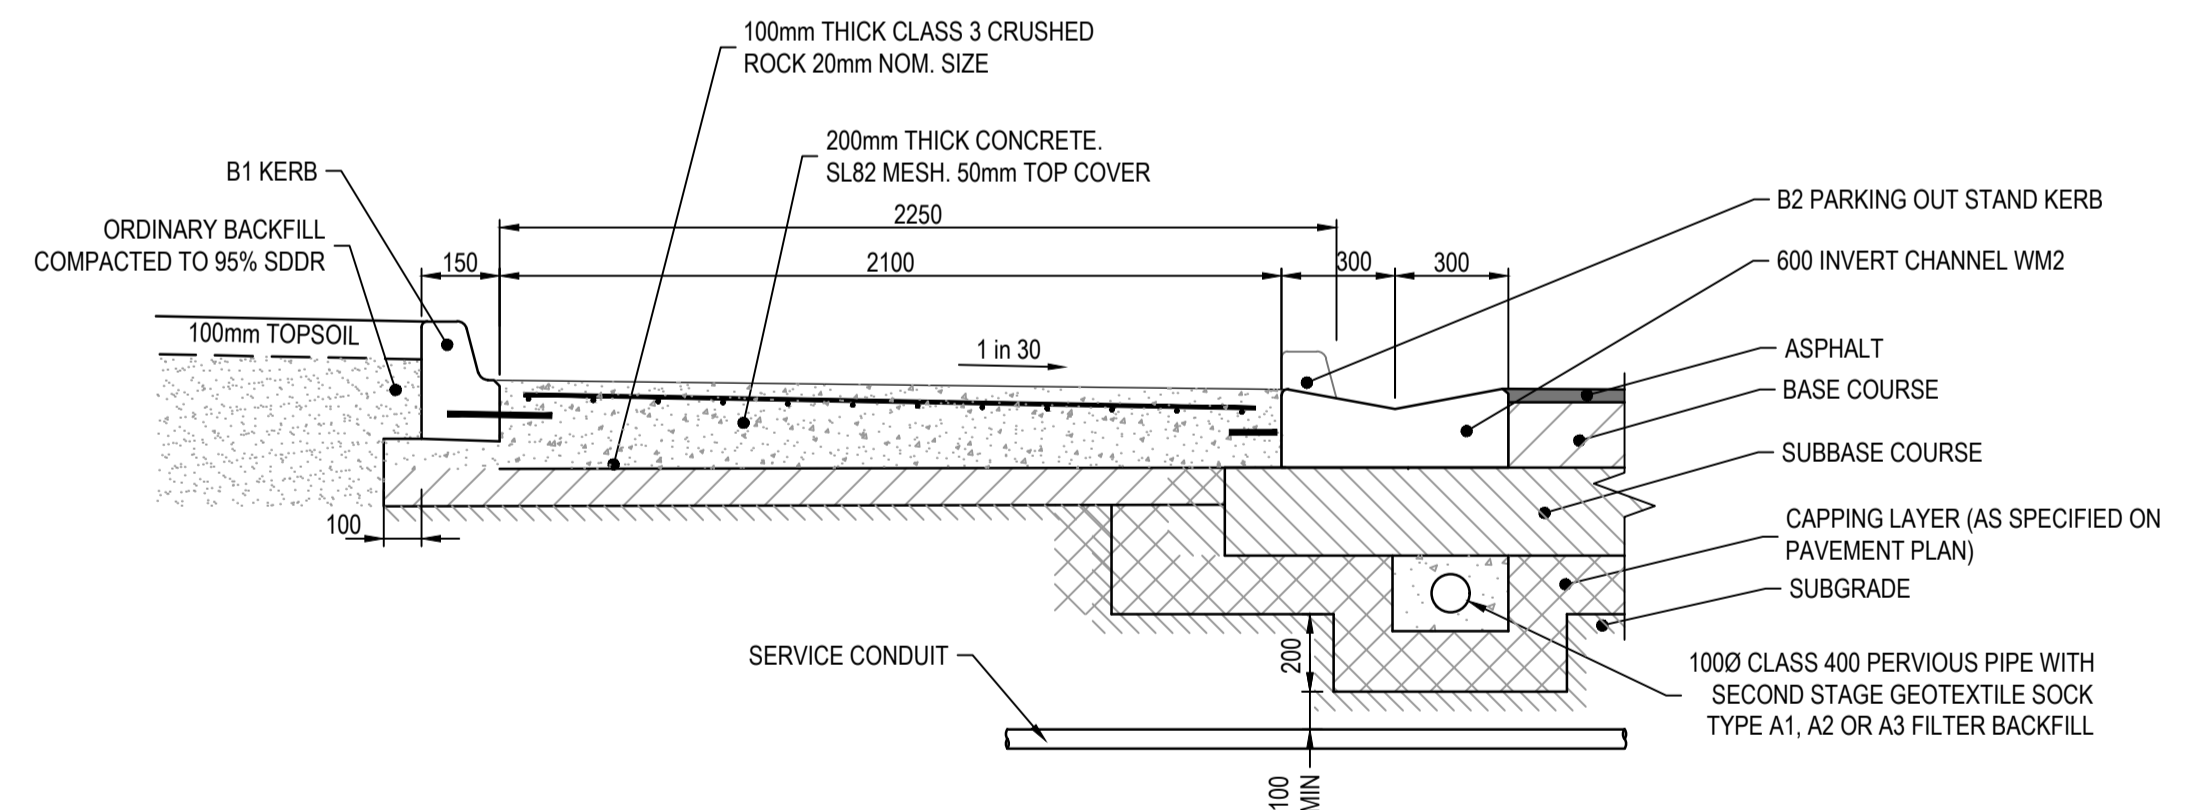


SECTION THROUGH PARKING
NOT TO SCALE

NOTES:
CONDUITS FOR GAS, WATER, ELECTRICITY AND TELECOM SERVICES TO BE LOCATED CLEAR OF PAVEMENT AND THE SUBSURFACE DRAIN

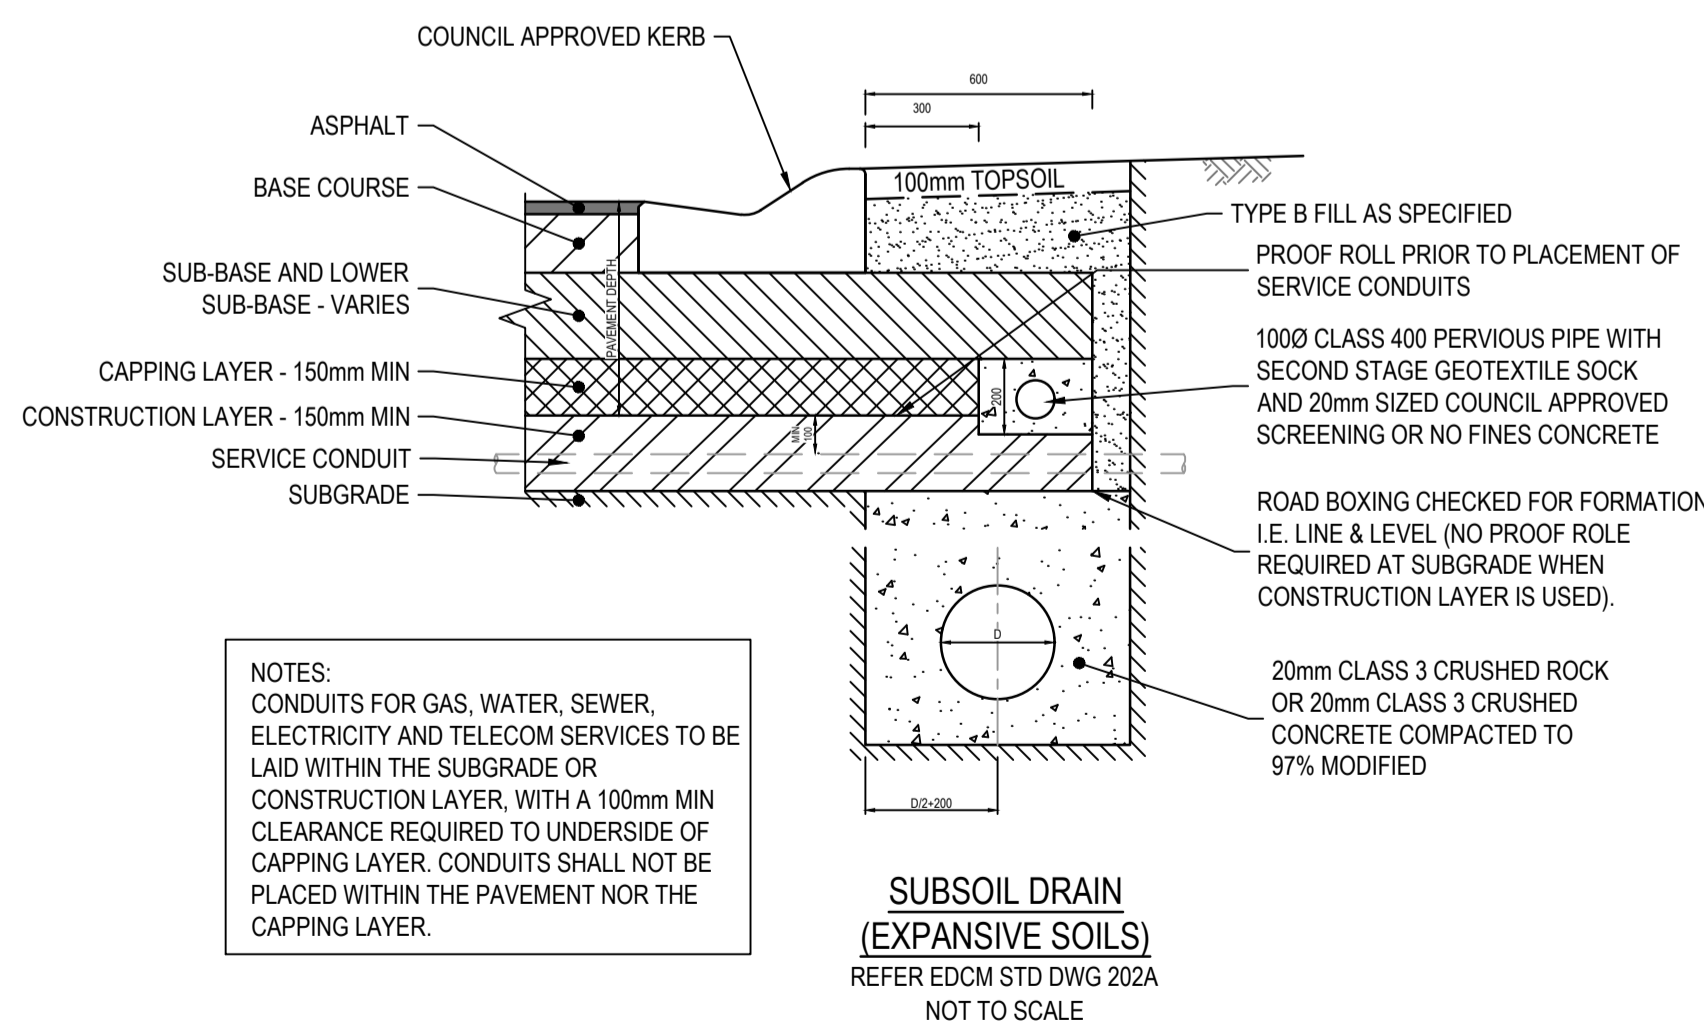

SUBSOIL DRAIN (EXPANSIVE SOILS)
REFER EDM STD DWG 2024
NOT TO SCALE

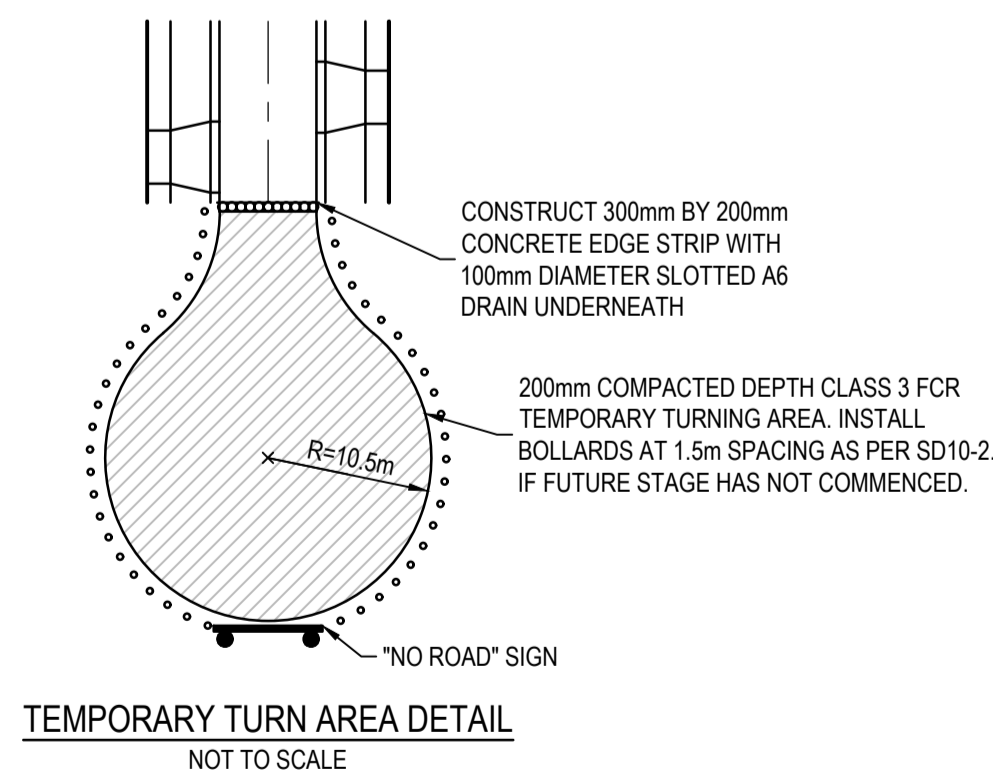

TEMPORARY TURN AREA DETAIL
NOT TO SCALE

NOTES:
CONDUITS FOR GAS, WATER, SEWER, ELECTRICITY AND TELECOM SERVICES TO BE LAID WITHIN THE SUBGRADE OR CONSTRUCTION LAYER, WITH A 100mm MIN CLEARANCE REQUIRED TO UNDERSIDE OF CAPPING LAYER. CONDUITS SHALL NOT BE PLACED WITHIN THE PAVEMENT NOR THE CAPPING LAYER.

WARNING
BEWARE OF UNDERGROUND SERVICES
The locations of underground services are approximate only and their exact position should be proven on site. No guarantee is given that all existing services are shown. Locate all underground services before commencement of works **DIAL 1100 BEFORE YOU DIG**
www.1100.com.au

AS CONSTRUCTED PLANS


The purpose of these as-constructed plans is to update the design drawings to show significant changes which occurred during construction. Note that the levels shown on these plans are design levels, and have not been verified by survey. All information shown on these plans should be verified on site. SMEC Australia Pty Ltd accept no responsibility for loss or damages resulting from the inappropriate usage of these plans.



AS CONSTRUCTED

PLAN OF SUB. NO.
PS841640V/S16
PERMIT REF. NO.
WYP10107_17.02

SCALE AS SHOWN AT A1

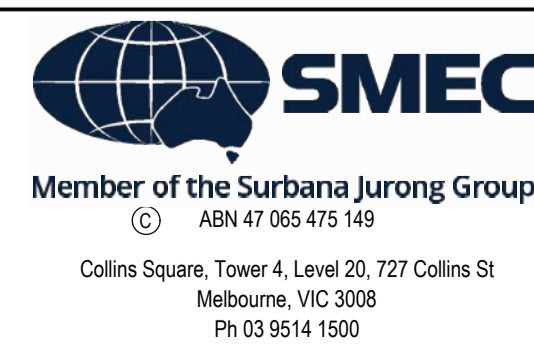

Alamora - Stage 8, Sayers Road, Tarnait
Wyndham City Council
Road and Drainage
General Details - 1

MELWAYS REF 234 D6	PROJECT / DRAWING No. 2070E-A08-421	SHEET No. 18 of 20	REVISION 2
------------------------------	---	------------------------------	----------------------

PHASE	DISCIPLINE CODE	RISK REGISTER - CONSTRUCTION / OPERATIONS / MAINTENANCE			RISK OWNER	POTENTIAL CONSEQUENCES	POTENTIAL ELIMINATION MEASURE, DESIGN INITIATIVE or CONTROL (Identify any Standard or Code of practice used)	HOW ISSUE ADDRESSED IN DESIGN AND/OR CONSTRUCTION OF THE WORKS	IS THE RISK ELIMINATED YES/NO	Score remaining residual risk		
		POTENTIAL RISK								Residual Risk Likelihood (0-5)	Residual Risk Consequence (0-5)	Residual Risk Rating
Road Furniture / Roadside features												
Construction	RD	Roads	Construction close to live traffic	New works will be constructed adjacent to live traffic when abutting existing stages.	Contractor	Disruptions to live traffic, construction incident involving live traffic.	Provide safe temporary traffic control (TCP)	TCP provided within contract	N	5	3	15
Construction	RD	Roads	Culverts	Potential risk from culverts under construction and height / fall hazards	Contractor	Falling from a height	Temporary barriers to be provided	Temporary barrier provided in contract	N	2	5	10
Construction	US	Utilities or Services	Utilities become a hazard within clear zones	Vehicle conflict with utility / pit	Contractor	Personal injury, vehicle damage	Sequence works and protect with temp barrier or traffic control (TCP)	TCP provided within contract	N	1	5	5
Operational	RD	Roads	Sight Lines	Inadequate drivers response time.	Road Authority	Increased potential for accidents	Ensure design complies with relevant standard. Undertake thorough Safety Audit	Vis lines checked and discussed with approval authority as part of design approval process	N	1	4	4
Operational	LS	Lines and Signs	Signs and street lights	Potential for drivers / riders to strike signs and street lights	Road Authority	Increased potential for accidents	Ensure design complies with relevant standard. Undertake thorough Safety Audit	Refer to appropriate standard for sign and lighting offsets	N	1	4	4
Operational	RF	Road Furniture	Headwalls	Potential vehicle conflict within clear zone	Road Authority	Increased potential for accidents	Establish adequate clear zone provision	Adequate barrier provided as per appropriate standard where within clear zone. Culvert headwall selection in accordance with authority standard	N	2	4	8
Operational	RD	Roads	Culverts	Potential fall hazard during maintenance, by vehicles and pedestrians	Relevant Authority	Falling from a height	Barriers to be provided in accordance with road standards	Barriers to be provided and safe batter slopes (>1:3)	N	2	5	10
Retaining Walls												
Construction	RW	Retaining Walls	Retaining Wall Alignment	Falling from height during construction or commissioning of walls and adjacent structures eg. sewer manholes	Contractor	Falling from a height	Provide temporary and permanent fencing at top of wall.	Provide fencing (at heights) during design process	N	1	1	1
Operational	RW	Retaining Walls	Retaining Wall Alignment	Lack of safe access/setback from road	Road/ Local Authority	Increased potential for accidents	Establish adequate and accessible clear zone provision. Provide guardrail where required	Wall located in suitable position during design process and approved by authority	N	1	1	1
Operational	RW	Retaining Walls	Retaining Wall Height	Potential for falling from height	Road/ Local Authority	Personal injury	Provide temporary and permanent fencing at top of wall.	Provide fencing (at heights) during design process	N	1	5	5
Operational	RW	Retaining Walls	Retaining Wall Design	Potential for wall failure	Road/ Local Authority	Increased potential for accidents	Structural design in accordance with standards, geotechnical conditions, end use and good practise.	Refer to structural drawings and calculations	N	1	5	5
Drainage												
Operational	DR	Drainage	Grated Pits	Trip/fall hazard with large spaced grate	Relevant Authority	Increased potential for accidents	Provide pedestrian/bicycle friendly grates where applicable. Refer to pit schedule	Design in accordance with authority and manufacturers standards	N	3	2	6
Operational	DR	Drainage	Non Standard Large Pits	Potential for pit failure	Relevant Authority	Increased risk to maintenance crews/ vehicles	Structural design in accordance with relevant design principles.	Refer to structural drawings and calculations	N	1	4	4
Operational	DR	Drainage	Culvert Endwalls/Headwalls	Potential for falling from height	Relevant Authority	Increased potential for accidents	Fencing to be provided where culverts/headwalls are at height in accordance with relevant authority standards	Allow for fencing in Design Process	N	1	4	4
Operational	DR	Drainage	Culvert Endwall/Headwall Outlets	Children playing in large pipes / watercourses and access for maintenance	Relevant Authority	Increased potential for accidents	Grate provided to authority standards	Design in accordance with authority and manufacturers standards	N	2	5	10
Maintenance	DR	Drainage	Access to Pits	Lack of safe access for maintenance	Relevant Authority	Increased risk to maintenance crews	Provide safe working conditions for maintenance. Provide safe landing/ access arrangements as per relevant authority standards	Where possible design pit in location for easy access and outside of permanent water bodies	N	2	5	10
Maintenance	DR	Drainage	Deep Pits	Lack of safe entry for maintenance	Relevant Authority	Increased potential for accidents	Contractor to be certified for work in confined spaces, step irons to be provided to appropriate authority standards. Refer to pit schedule	Design in accordance with authority standards	N	1	5	5
Maintenance	DR	Drainage	Access to drains / culverts	Lack of safe access for maintenance	Relevant Authority	Increased risk to maintenance crews	Provide safe working conditions for maintenance. Access as approved by authority	Design pit in location for easy access as agreed with authority	N	2	3	6
Sewer												
Construction	SE	Sewer	Sewer Manhole located adjacent to Retaining Wall Alignment	Falling from height during construction or commissioning of adjacent sewer manholes	Contractor	Falling from a height	Provide temporary fencing until such time that permanent fencing is constructed	Provide fencing (at heights) during design process	N	1	1	1
Maintenance	SE	Sewer	Deep Manholes	Lack of safe entry for maintenance	Relevant Authority	Increased potential for accidents	Contractor to be certified for work in confined spaces, landings and step access provided as per authority standards and schedule	Design in accordance with authority standards. Refer pit schedule on drawings	N	1	5	5
Maintenance	SE	Sewer	Access to Manholes	Lack of safe access for maintenance	Relevant Authority	Increased risk to maintenance crews	Provide safe working conditions for maintenance. Manholes located in compliance with authority standards	Where possible design manhole in location for easy access	N	1	5	5
Maintenance	SE	Sewer	Pump Station Access	Lack of safe access for maintenance	Relevant Authority	Increased risk to maintenance crews	Provide safe working conditions for maintenance	Design pump station in location for easy access	N	2	4	8
Electricity												
Operational	ES	Electrical Services	Electrical Design	Location of assets within clear zones e.g. pits/ substations	Relevant Authority	Increased potential for accidents	Electrical designed by sub consultant with appropriate accreditation and in accordance with authority standards	Pits designed below ground. Where above ground adequate offset from vehicle clear zones has been provided or barrier protection provided	N	2	3	6
Telstra												
Operational	TE	Telstra	Telstra Design	Location of assets within clear zones e.g. pits	Relevant Authority	Increased potential for accidents	Telecommunications designed by authority consultant with appropriate accreditation and in accordance with authority standards	Pits designed below ground. Where above ground adequate offset from vehicle clear zones has been provided or barrier protection provided	N	2	3	6
Water												
Operational	WA	Water	Water Design	Location of assets within clear zones e.g. pits/ substations	Relevant Authority	Increased potential for accidents	Water pits designed in accordance with authority standards	Pits designed below ground. Where above ground adequate offset from vehicle clear zones has been provided or barrier protection provided	N	2	3	6
Gas												
Operational	GA	Gas	Gas Design	Location of assets within clear zones e.g. pits/ substations	Relevant Authority	Increased potential for accidents	Water pits designed in accordance with authority standards	Pits designed below ground. Where above ground adequate offset from vehicle clear zones has been provided or barrier protection provided	N	1	1	1

AS CONSTRUCTED PLANS


The purpose of these as-constructed plans is to update the design drawings to show significant changes which occurred during construction. Note that the levels shown on these plans are design levels, and have not been verified by survey. All information shown on these plans should be verified on site. SMEC Australia Pty Ltd accept no responsibility for loss or damages resulting from the inappropriate usage of these plans.



PLAN OF SUB. NO.
PS841640V/S16
PERMIT REF. NO.
WYP10107_17.02

AS CONSTRUCTED

SCALE AS SHOWN AT A1

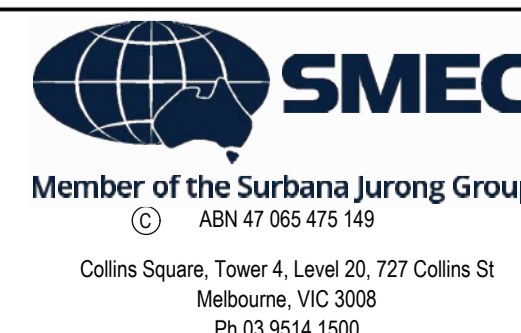

Alamora - Stage 8, Sayers Road, Tarnait
Wyndham City Council
Road and Drainage
Safety In Design

MELWAYS REF
234 D6

PROJECT / DRAWING No.
2070E-A08-500

SHEET No.
20 of 20

REVISION
2