


# Alamora Estate

## Stage 9, Sayers Road, Tarneit

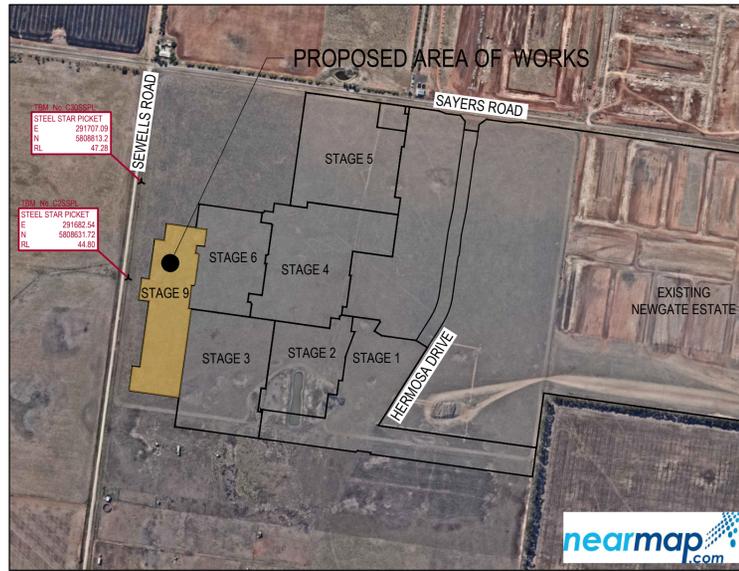

Locality Plan  
N.T.S

ROAD NAME	SERVICES OFFSET TABLE				
	GAS OFFSET (m)	WATER OFFSET (m)	RECYCLED WATER OFFSET (m)	ELECTRICITY OFFSET (m)	OPTIC FIBRE OFFSET (m)
ARAGON ROAD	2.10 N	3.10 N	2.60 N	1.00 S	0.30 S
FERONIA AVENUE	2.10 N	3.10 N	2.60 N	2.50 S	1.80 S
PROSECCO STREET	2.10 S	3.10 S	2.60 S	2.50 N	1.80 N
SAFRANO STREET	2.10 W	3.10 W	2.60 W	2.50 E	1.80 E

ROAD NAME	ROAD RESERVE WIDTH (m)	ROAD WIDTH (m)				KERB TYPE		VERGE WIDTH (m)	
		LIP TO LIP	INV TO INV	BACK TO BACK	NTH/WEST	STH/EAST	NTH/WEST	STH/EAST	
ARAGON ROAD	14.50	6.40	7.30	7.60	B2	B2	4.20	4.20	
FERONIA AVENUE	16.00	6.40	7.30	7.60	B2	B2	4.20	4.20	
PROSECCO STREET	16.00	6.40	7.30	7.60	B2	B2	4.20	4.20	
SAFRANO STREET	16.00	6.40	7.30	7.60	B2	B2	4.20	4.20	

POINT	SURVEY CONTROL POINTS			DESCRIPTION
	EASTING	NORTHING	RL (AHD)	
C2SSPL	291,682.54	5,808,631.72	44.80	STEEL STAR PICKET
C3OSSPL	291,707.09	5,808,813.2	47.28	STEEL STAR PICKET






**WARNING**  
**BEWARE OF UNDERGROUND SERVICES**  
The locations of underground services are approximate only and their exact position should be proven on site.  
No guarantee is given that all existing services are shown.  
Locate all underground services before commencement of works  
**DIAL 1100 BEFORE YOU DIG**  
www.1100.com.au

**WARNING**  
**SAFETY MEASURES REQUIRED**  
Please note there are risks attached to the construction of this project, and any ongoing maintenance of structures.  
Consider the safety of all. For potential risks, consequences and controls refer to Safety In Design Risk Register SID P4.E6.2070E-A06-85  
**ASSESS THE RISK - STAY SAFE**

These designs and drawings are the copyright of SMEC Australia Pty Ltd. The drawing shall not be reproduced or copied, in whole or part, without the written permission of SMEC Australia Pty Ltd. The contents of this drawing are electronically generated, are confidential and may only be used for the purpose for which they are intended.

### Drawing Index

- 2070E-A09-101 Cover Plan
- 2070E-A09-111 Layout Plan
- 2070E-A09-131 Earthworks Setout Plan
- 2070E-A09-171 Signage & Linemarking Plan
- 2070E-A09-181 Intersection Detail Plan
- 2070E-A09-201 Road Longitudinal Sections - 1
- 2070E-A09-202 Road Longitudinal Sections - 2
- 2070E-A09-251 Cross Sections: Safrano Street Ch 13.27 - Ch 186.97
- 2070E-A09-252 Cross Sections: Prosecco Street Ch 240.14 - 305.64 & Feronia Avenue Ch 472.16 - Ch 433.65
- 2070E-A09-253 Cross Sections: Aragon Road Ch 250.91 - Ch 314.91
- 2070E-A09-301 Drainage Longitudinal Sections - 1
- 2070E-A09-302 Drainage Longitudinal Sections - 2
- 2070E-A09-351 Pit Schedule
- 2070E-A09-411 Pavement Details
- 2070E-A09-421 General Details
- 2070E-A09-500 Safety In Design

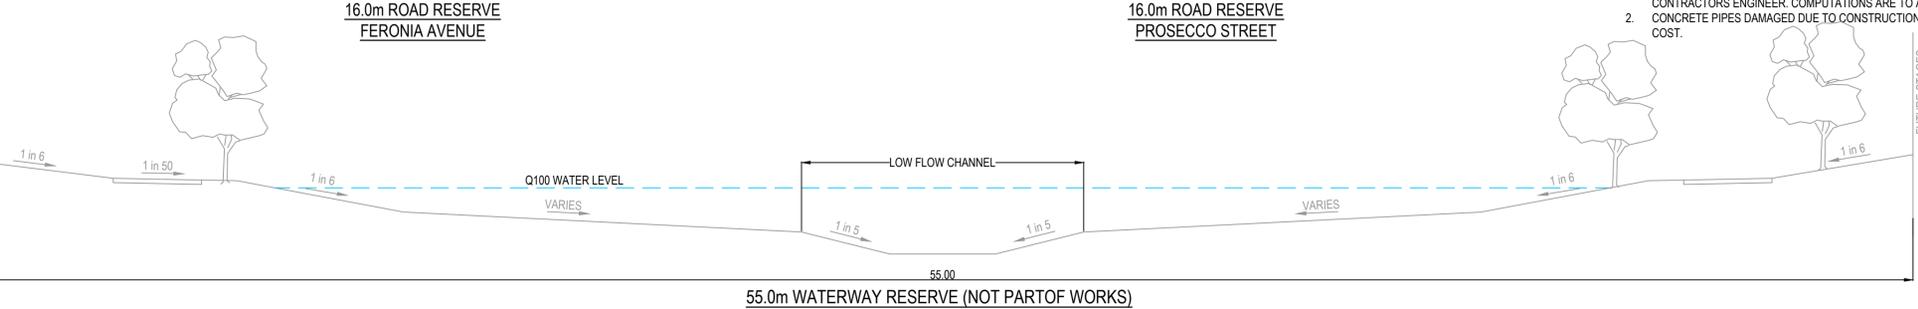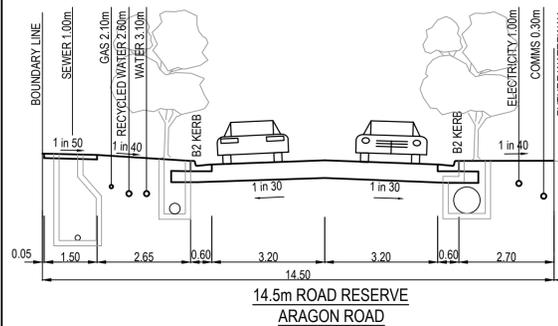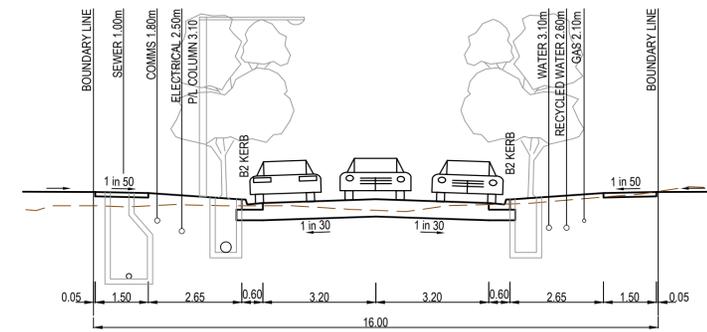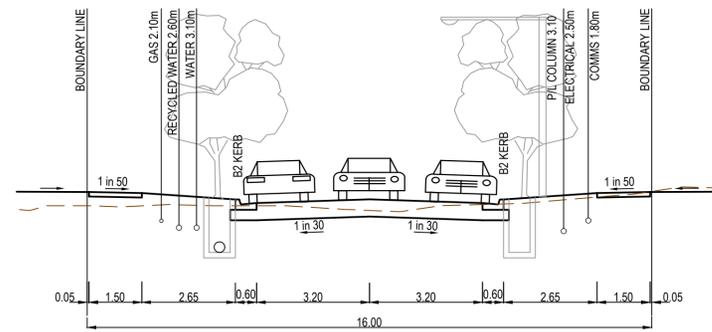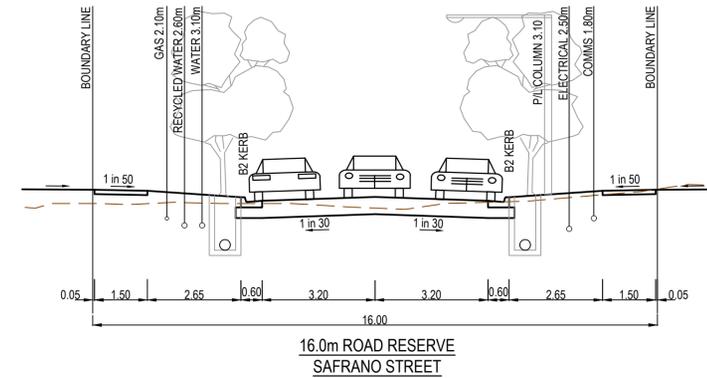

### GENERAL NOTES (WYNDHAM CITY COUNCIL)

- THE WORKS SHALL BE CONSTRUCTED IN ACCORDANCE WITH THE CURRENT EDM ADDENDUM STANDARD DRAWINGS AND SPECIFICATIONS. WORKS TO BE CARRIED OUT TO THE SATISFACTION OF COUNCIL'S SUPERVISING OFFICER.
- THE CONTRACTOR IS RESPONSIBLE FOR SAFETY OF WORK ON SITE IN ACCORDANCE WITH APPROPRIATE LEGISLATION. THE CONTRACTOR SHALL ERECT AND MAINTAIN ALL SHORING, PLANKING AND STRUTTING, DEWATERING DEVICES, BARRICADES, SIGNS, LIGHTS, ETC. NECESSARY TO KEEP WORKS IN A SAFE AND STABLE CONDITION, AND TO PROTECT THE PUBLIC FROM HAZARDS ASSOCIATED WITH THE WORKS.
- THE CONTRACTOR SHALL:
  - COMPLY WITH THE SAFETY REQUIREMENTS OF THE MINES ACT, GENERAL REGULATIONS AND STATUTORY RULES, AND THE MINES (TRENCHES) REGULATIONS 1982.
  - NOTIFY THE OCCUPATIONAL HEALTH AND SAFETY AUTHORITY OF HIS INTENTION TO COMMENCE TRENCHING OPERATIONS WHERE TRENCHES ARE 1.5 METRES OR DEEPER.
  - ENSURE THAT THE MINE MANAGER OR HIS DEPUTY AS REQUIRED BY THE REGULATIONS IS IN ATTENDANCE WHEN TRENCHING OPERATIONS ARE IN PROGRESS.
- THE CONTRACTOR IS TO NOTIFY COUNCIL AND ALL SERVICE AUTHORITIES SEVEN (7) DAYS PRIOR TO COMMENCEMENT OF CONSTRUCTION.
- THE LOCATION OF EXISTING SERVICES SHOULD BE DETERMINED BY THE CONTRACTOR PRIOR TO COMMENCING ANY EXCAVATION BY CONTACTING ALL RELEVANT SERVICE AUTHORITIES. ANY EXISTING SERVICES SHOWN ON THE DRAWINGS ARE OFFERED AS A GUIDE ONLY AND ARE NOT GUARANTEED AS CORRECT.
- TREES MARKED ON THE APPROVED PLANS FOR REMOVAL MUST BE REMOVED FROM THE SITE PRIOR TO THE COMMENCEMENT OF WORKS. NO EXCAVATION SHALL BE CARRIED OUT WITHIN 5.0m OF ANY EXISTING TREE UNTIL APPROVAL HAS BEEN GIVEN BY COUNCIL'S SUPERVISING OFFICER.
- ALL ROAD CHAINAGES ARE MEASURED ALONG THE ROAD CENTRELINE EXCEPT KERB RETURNS AND COURTHEDS, WHERE LIP OF KERB CHAINAGES ARE SPECIFIED. ALL DIMENSIONS AND RADII ARE GIVEN TO THE LIP OF KERB. DO NOT SCALE OFF THESE DRAWINGS. WRITTEN DIMENSIONS ONLY SHALL BE USED.
- CONDUIT LOCATIONS ARE SUBJECT TO AMENDMENT AND CONDUITS SHALL NOT BE LAID UNTIL WRITTEN APPROVAL IS GIVEN BY THE SUPERINTENDENT. BOTH KERBS ARE TO BE MARKED WITH THE LETTERS E.G.H.R.T&W ABOVE CONDUIT LOCATIONS AS SPECIFIED. RESPECTIVE LETTERS TO BE INDICATED ABOVE RELEVANT CONDUITS AS PER STANDARD DRAWING EDM 303. CONDUITS TO BE PLACED MINIMUM OF 5m FROM BOUNDARIES WHERE POSSIBLE AND TO THE SATISFACTION OF THE SUPERINTENDENT IN ACCORDANCE WITH COUNCIL STANDARD DRAWINGS.
- SUBSOIL DRAINS SHALL BE INSTALLED BEHIND OR BELOW ALL KERB AND CHANNEL AS PER STANDARD DRAWINGS EDM 202 (EXPANSIVE SUBGRADE).
- ALL LINEMARKING, SIGNING AND TRAFFIC CONTROL DEVICES TO BE IN ACCORDANCE WITH VICROADS REQUIREMENTS WITH LATERAL WORKS AND APPROVED WORKS. ALL MATERIAL IS TO BE COMPACTED TO 95% STANDARD COMPACTION IN 150mm LAYERS AND AS PER THE SPECIFICATION. WHERE THERE IS FILL IN EXCESS OF 300mm IN DEPTH, THE CONTRACTOR IS TO CARRY OUT SOIL TESTS TO THE REQUIREMENTS OF APPENDIX B AS SPECIFIED IN THE AUSTRALIAN STANDARD AS 3798 TO SHOW THAT LEVEL 1 COMPACTION STANDARDS HAVE BEEN ACHIEVED. TEST RESULTS AND LOCATION OF TESTS FOR EACH ALLOTMENT SHALL BE APPROVED BY THE CONTRACTOR AND FORWARDED TO COUNCIL.
- ALL EXCAVATED OR FILLED AREAS OUTSIDE THE ROAD RESERVES SHALL BE SURFACED WITH A 100mm MINIMUM TO 200mm MAXIMUM LAYER OF TOPSOIL AS SPECIFIED. ALL FILLING ON ALLOTMENTS TO BE COMPACTED TO 95% STANDARD COMPACTION IN 150mm LAYERS AND AS PER THE SPECIFICATION. WHERE THERE IS FILL IN EXCESS OF 300mm IN DEPTH, THE CONTRACTOR IS TO CARRY OUT SOIL TESTS TO THE REQUIREMENTS OF APPENDIX B AS SPECIFIED IN THE AUSTRALIAN STANDARD AS 3798 TO SHOW THAT LEVEL 1 COMPACTION STANDARDS HAVE BEEN ACHIEVED. TEST RESULTS AND LOCATION OF TESTS FOR EACH ALLOTMENT SHALL BE APPROVED BY THE CONTRACTOR AND FORWARDED TO COUNCIL.
- FILL MATERIAL USED UNDER PAVEMENTS AND FOOTPATHS MUST BE AN APPROVED MATERIAL TO THE STANDARD OF WYNDHAM CITY COUNCIL. ALL SUCH MATERIAL IS TO BE COMPACTED AS PER THE REQUIREMENTS OF THE SPECIFICATION APPROVED WITH THESE DRAWINGS PRIOR TO FORMWORK BEING PLACED. COMPACTION TESTS TO BE COMPLETED AND PROVIDED TO SUPERINTENDENT.
- FILL & CUT BATTERS ARE NOT TO EXCEED 1 in 6 SLOPE, UNLESS SHOWN OTHERWISE.
- ALL ALLOTMENTS SHALL BE SMOOTHED, GRADED AND SHAPED TO AN EVEN SURFACE WITH A MINIMUM FALL OF 1 in 150 TO THE DRAINAGE OUTLET SHOWN.
- ALL DRAINAGE PIPES ARE CLASS 2 RCP PIPES, RUBBER RING JOINTED UNLESS OTHERWISE SPECIFIED.
- DRAINAGE PITS SHALL BE CAST MONOLITHICALLY. CEMENT RENDER SHALL ONLY BE USED TO REPAIR DEFECTS.
- BACKFILLING OF TRENCHES WHERE DRAINAGE AND SEWERAGE ARE IN CLOSE PROXIMITY ARE TO BE BACKFILLED AS PER WYNDHAM CITY COUNCIL STANDARD DRAWING SD6-10.
- ALL SERVICING TRENCHES UNDER ROADS, FOOTPATHS, DRIVEWAYS, PARKING BAYS ETC. ARE TO BE BACKFILLED WITH CLASS 2 F.C.R.
- ALL HOUSE DRAIN CONNECTIONS TO BE INSTALLED AT 6m FROM THE LOW SIDE BOUNDARY U.N.O.
- INVERT OF PROPERTY INLETS TO BE 500mm MINIMUM BELOW FINISHED SURFACE UNLESS NOTED OTHERWISE.
- VEHICLE CROSSINGS TO BE CONSTRUCTED IN ACCORDANCE WITH STANDARD DRAWINGS EDM 501 TO 503. DRIVEWAYS TO BE LOCATED MIN 0.75m FROM BUILDING LINE UNLESS SPECIFIED OTHERWISE AND CLEAR OF DRAINAGE PITS, SEWER MAINTENANCE HOLES AND EXISTING TREES. DOUBLE DRIVEWAY WIDTH TO BE 7.0m AT FRONT OF PATHBUILDING LINE.
- ADDITIONAL AND OVER-EXCAVATION SHALL BE BACKFILLED IN ACCORDANCE WITH THE PROVISIONS OF THE SPECIFICATION.
- FOOTPATH CROSSFALL TO BE 1:50
- ALL FOOTPATHS AND SHARED PEDESTRIAN/BICYCLE PATHS ARE TO BE CONSTRUCTED AS PER CITY OF WYNDHAM SPECIFICATIONS AND MPA STANDARD DRAWINGS EDM 401 TO 403.
- ALL EXOTIC (NON NATIVE) TREES AND SHRUBS, INCLUDING DEAD TREES, NOT SHOWN ON THE DRAWINGS BUT LOCATED WITHIN THE WORKS ARE TO BE REMOVED AND DISPOSED OFFSITE.
- INSTALL BLUE RAISED REFLECTIVE PAVEMENT MARKER (BRRPM) ON ROAD CENTRELINE AND "GROUND BALL" MARKER POST TO INDICATE LOCATION OF FIREPLUG.
- THE CONTRACTOR IS TO ENSURE THAT THEIR CONSTRUCTION PROCEDURES AND STANDARDS CONTROL THE VOLUME AND LOCATION FOR COLLECTION OF SEDIMENT RUNOFF ACCORDING TO CURRENT EPA - ENVIRONMENTAL GUIDELINES FOR MAJOR CONSTRUCTION SITES.
- UPON COMPLETION OF CONSTRUCTION THE WHOLE SITE SHALL BE CLEANED UP, GRADED AND ALL RUBBISH REMOVED. THE SITE IS TO BE LEFT IN A CLEAN AND TIDY CONDITION TO THE SATISFACTION OF THE SUPERINTENDENT.
- EXISTING PAVEMENT OR DRAINAGE WORKS DAMAGED DURING CONSTRUCTION OR THE MAINTENANCE PERIOD TO BE REINSTATED TO THE SATISFACTION OF THE COUNCIL ENGINEER.
- THE LOWER SUB-BASE MATERIAL SHALL WILL BE N.D.C.R. FOR PAVEMENT MAKE UPS AS PER THE STANDARD DRAWINGS OF WYNDHAM CITY COUNCIL.
- TOTAL LENGTH OF ROADS CONSTRUCTED IS 478m
- TOTAL LENGTH OF DRAINS CONSTRUCTED IS 776m
- ALL TGS1 TO BE INSTALLED IN ACCORDANCE WITH AS1428.

### (GAS) - STANDARD NOTES

- GAS MAINS, FITTINGS AND MARKER TAPE ARE TO BE SUPPLIED BY THE GAS AUTHORITY.
- EXCAVATION, SUPPLY AND PLACEMENT OF REQUIRED BACKFILL TO BE UNDERTAKEN BY OTHERS.
- NOTIFICATION MUST BE GIVEN TO THE GAS AUTHORITY TWO WEEKS PRIOR TO THE COMMENCEMENT OF EXCAVATION WORKS.

### REINFORCED CONCRETE PIPE


- ALL STORMWATER DRAINAGE PIPES SHALL NOT BE SUBJECT TO CONSTRUCTION TRAFFIC LOADING DURING CONSTRUCTION UNLESS THE PIPE STRENGTH CHARACTERISTICS HAVE BEEN COMPUTED AND APPROVED BY THE CONTRACTORS ENGINEER. COMPUTATIONS ARE TO ACCORD WITH AS 3725-2007, LOADS ON BURIED PIPES.
- CONCRETE PIPES DAMAGED DUE TO CONSTRUCTION LOADS SHALL BE REPLACED & RELAID AT THE CONTRACTOR'S COST.

### AS CONSTRUCTED PLANS

The purpose of these as-constructed plans is to update the design drawings to show significant changes which occurred during construction. Note that the levels shown on these plans are design levels, and have not been verified by survey. All information shown on these plans should be verified on site. SMEC Australia Pty Ltd accept no responsibility for loss or damages resulting from the inappropriate usage of these plans.

Quality Management - ISO 9001  
 OHS Management - AS/NZS 4501  
 Environmental Management - ISO 14001  
 PLAN OF SUB. NO. PS841640V/S7  
 PERMIT REF. NO. WYP10107\_17.02  
**AS CONSTRUCTED**

Scale 1:100  
 SCALE AS SHOWN AT A1


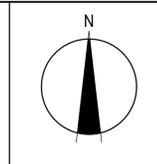


**SMEC**  
 Member of the Surlana Jurong Group  
 ABN 47 065 475 149  
 Collins Square, Tower 4, Level 20, 727 Collins St  
 Melbourne, VIC 3008  
 Ph 03 9514 1500



Alamora - Stage 9  
 Wyndham City Council  
 Road and Drainage  
 Cover Plan


MELWAYS REF <b>234 D5</b>	PROJECT / DRAWING No. <b>2070E-A09-101</b>	SHEET No. <b>01 of 16</b>	REVISION <b>1</b>
------------------------------	---	------------------------------	----------------------

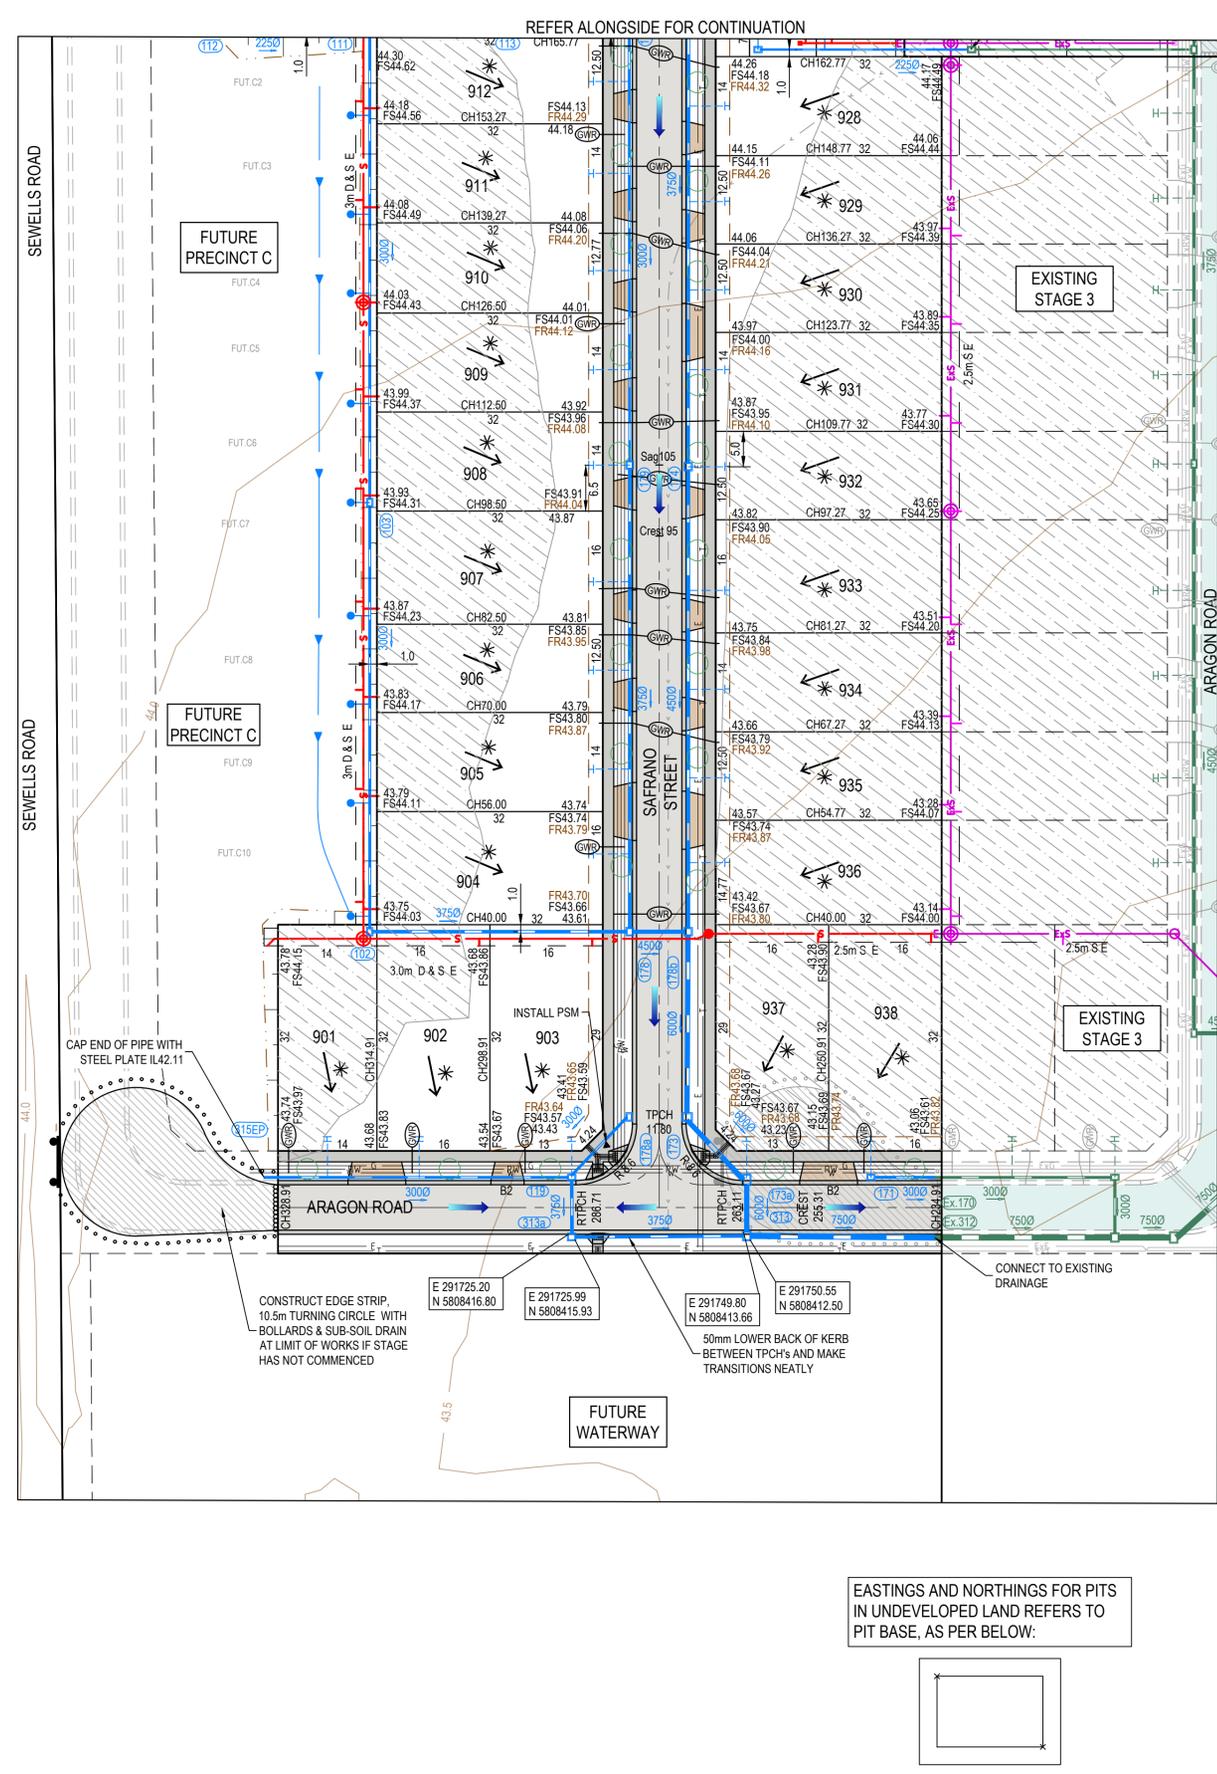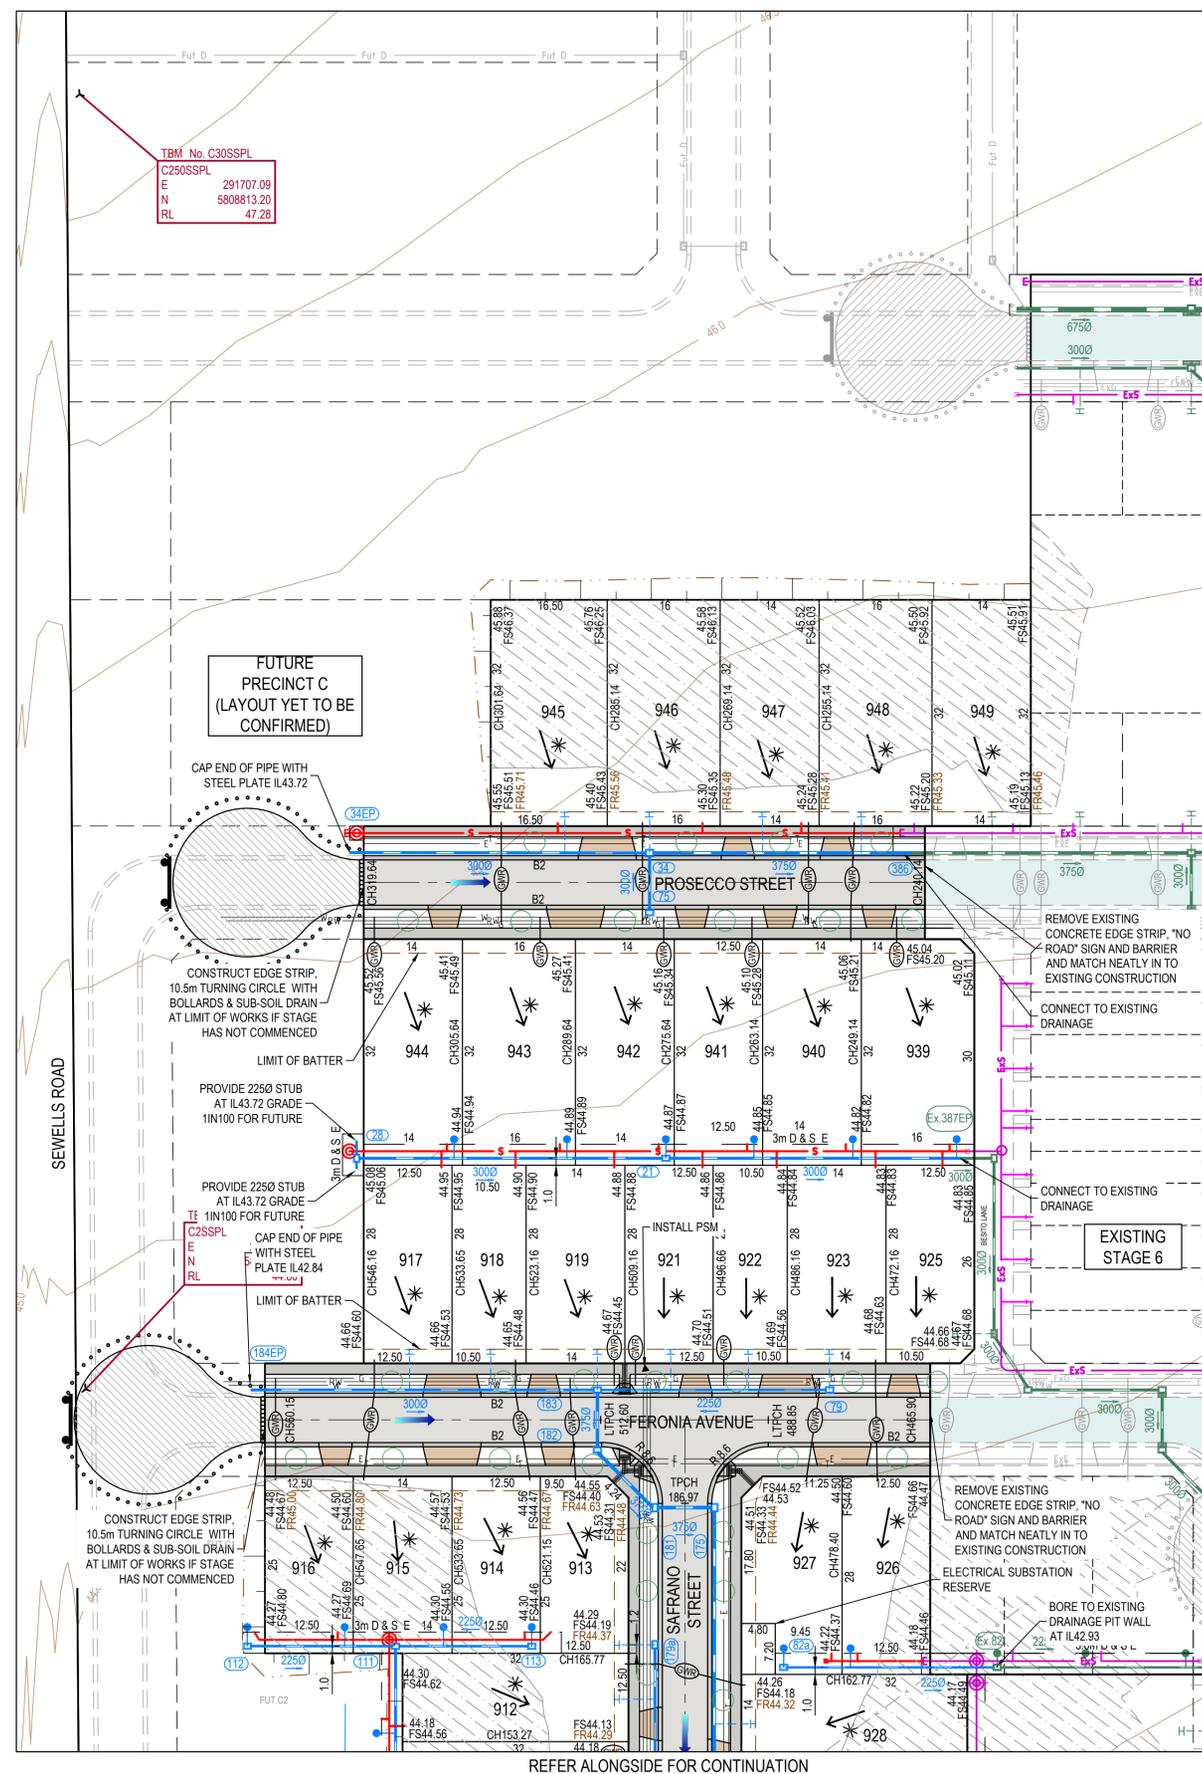

**LEGEND - LAYOUT PLAN**  
ALL PROPOSED, FUTURE & EXISTING SERVICE LOCATIONS ARE SHOWN INDICATIVELY

- STORMWATER DRAIN, PIT & PROPERTY INLET
- MAIN DRAIN
- SWALE DRAIN
- SEWER & MAINTENANCE STRUCTURES
- HOUSE DRAIN
- ELECTRICITY (U.GROUND)
- ELECTRICITY (O.HEAD)
- GAS
- TELSTRA
- OPTIC FIBRE
- WATER
- RECYCLE WATER
- AG DRAIN
- SERVICE CONDUITS
- TACTILE PAVERS
- EXISTING STORMWATER DRAIN
- EXISTING MAIN DRAIN
- EXISTING SWALE DRAIN
- EXISTING SEWER & MAINTENANCE STRUCTURES
- EXISTING HOUSE DRAIN
- EXISTING ELECTRICITY (UNDER GROUND)
- EXISTING ELECTRICITY OVERHEAD
- EXISTING GAS
- EXISTING TELSTRA
- EXISTING OPTIC FIBRE
- EXISTING WATER
- EXISTING RECYCLED WATER
- EXISTING AG DRAIN
- EXISTING SERVICE CONDUITS
- EXISTING TACTILE PAVERS
- FUTURE STORMWATER DRAIN
- FUTURE MAIN DRAIN
- FUTURE SWALE DRAIN
- FUTURE SEWER & MAINTENANCE STRUCTURES
- FUTURE HOUSE DRAIN
- FUTURE ELECTRICITY (UNDER GROUND)
- FUTURE ELECTRICITY OVERHEAD
- FUTURE GAS
- FUTURE TELSTRA
- FUTURE OPTIC FIBRE
- FUTURE WATER
- FUTURE RECYCLED WATER
- FUTURE AG DRAIN
- FUTURE SERVICE CONDUITS
- FUTURE TACTILE PAVERS
- ZERO LOT LINES
- 141.34 EXISTING SURFACE LEVEL
- FS140.35 FINISHED BUILDING LINE LEVEL
- FR157.40 FINISHED RIDGE LINE LEVEL
- CH270.00 CHAINAGE
- TW159.60 TOP OF RETAINING WALL LEVEL
- BW159.00 BOTTOM OF RETAINING WALL LEVEL
- EXISTING RETAINING WALL
- RETAINING WALL
- FUTURE RETAINING WALL
- STRUCTURAL FILL > 200mm DEEP
- EXISTING STRUCTURAL FILL > 200mm DEEP
- CUT > 200mm DEEP
- DIRECTION OF FALL
- OVERLAND FLOW
- GRADED IN DIRECTION OF FALL TO LEVEL INDICATED
- EDGE STRIP, SUBSOIL DRAIN, "NO ROAD" SIGN & BARRIER
- EXISTING TREE TO BE RETAINED
- EXISTING TREE TO BE REMOVED
- PERMANENT SURVEY MARK
- TEMPORARY BENCH MARK
- PROPOSED DRIVEWAY & FOOTPATH
- PROPOSED INDUSTRIAL DRIVEWAY
- PROPOSED SHARED FOOTPATH
- PROPOSED ROAD PAVING
- EXISTING ROAD PAVING
- 3m DIAMETER TREE ZONE

EASTINGS AND NORTHINGS FOR PITS IN UNDEVELOPED LAND REFERS TO PIT BASE, AS PER BELOW:

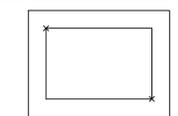

**WARNING**  
**BEWARE OF UNDERGROUND SERVICES**  
The locations of underground services are approximate only and their exact position should be proven on site. No guarantee is given that all existing services are shown. Locate all underground services before commencement of works. **DIAL 1100 BEFORE YOU DIG**  
www.1100.com.au



**AS CONSTRUCTED PLANS**  
The purpose of these as-constructed plans is to update the design drawings to show significant changes which occurred during construction. Note that the levels shown on these plans are design levels, and have not been verified by survey. All information shown on these plans should be verified on site. SMEC Australia Pty Ltd accept no responsibility for loss or damages resulting from the inappropriate usage of these plans.

Quality Management ISO 9001  
OH&S Management AS/NZS 4804  
Environmental Management ISO 14001

Global-Mark.com.au® Global-Mark.com.au® Global-Mark.com.au®

**AS CONSTRUCTED**

PLAN OF SUB. NO. PS841640V/S7  
PERMIT REF. NO. WYP10107\_17.02

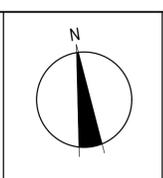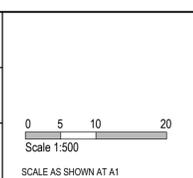


**SMEC**  
Member of the Surlana Jurong Group  
ABN 47 065 475 149  
Collins Square, Tower 4, Level 20, 727 Collins St  
Melbourne, VIC 3008  
Ph 03 9514 1500

**ALAMORA**  
Tarnait

Alamora - Stage 9  
Wyndham City Council  
Road and Drainage  
Layout Plan

MELWAYS REF 234 D5 PROJECT / DRAWING No. 2070E-A09-111 SHEET No. 02 of 16 REVISION 3

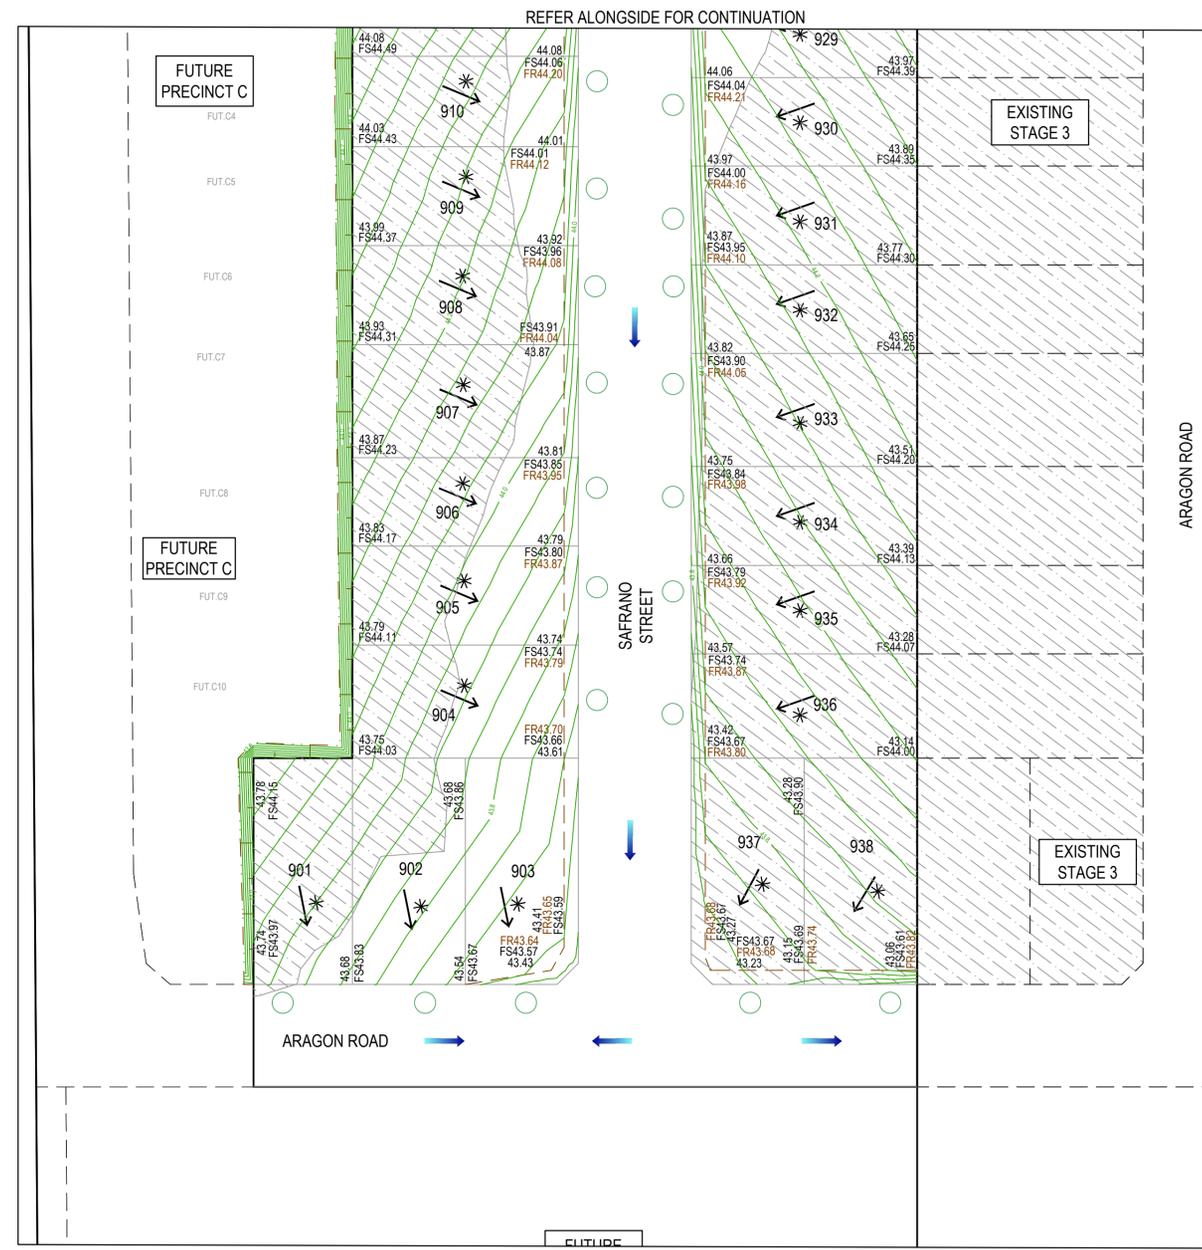

**LEGEND - EARTHWORKS PLAN**  
ALL PROPOSED, FUTURE & EXISTING SERVICE LOCATIONS ARE SHOWN INDICATIVELY

	STORMWATER DRAIN, PIT & PROPERTY INLET
	SWALE DRAIN
	SEWER & MAINTENANCE STRUCTURES
	HOUSE DRAIN
	ELECTRICITY (U.GROUND)
	ELECTRICITY (O.HEAD)
	GAS
	TELSTRA
	OPTIC FIBRE
	WATER
	RECYCLE WATER
	AG. DRAIN
	SERVICE CONDUITS
	TACTILE PAVERS
	EXISTING STORMWATER DRAIN
	EXISTING SWALE DRAIN
	EXISTING SEWER & MAINTENANCE STRUCTURES
	EXISTING HOUSE DRAIN
	EXISTING ELECTRICITY (UNDER GROUND)
	EXISTING ELECTRICITY OVERHEAD
	EXISTING GAS
	EXISTING TELSTRA
	EXISTING OPTIC FIBRE
	EXISTING WATER
	EXISTING RECYCLED WATER
	EXISTING AG. DRAIN
	EXISTING SERVICE CONDUITS
	EXISTING TACTILE PAVERS
	FUTURE STORMWATER DRAIN
	FUTURE SWALE DRAIN
	FUTURE SEWER & MAINTENANCE STRUCTURES
	FUTURE HOUSE DRAIN
	FUTURE ELECTRICITY (UNDER GROUND)
	FUTURE ELECTRICITY OVERHEAD
	FUTURE GAS
	FUTURE TELSTRA
	FUTURE OPTIC FIBRE
	FUTURE WATER
	FUTURE RECYCLED WATER
	FUTURE AG. DRAIN
	FUTURE SERVICE CONDUITS
	FUTURE TACTILE PAVERS
	ZERO LOT LINES
	141.34 EXISTING SURFACE LEVEL
	FS140.35 FINISHED BUILDING LINE LEVEL
	FR157.40 FINISHED RIDGE LINE LEVEL
	CH270.00 CHAINAGE
	STRUCTURAL FILL > 200mm DEEP
	EXISTING STRUCTURAL FILL > 200mm DEEP
	CUT > 200mm DEEP
	DIRECTION OF FALL
	OVERLAND FLOW
	GRADED IN DIRECTION OF FALL TO LEVEL INDICATED
	EDGE STRIP, SUBSOIL DRAIN, "NO ROAD" SIGN & BARRIER
	EXISTING TREE TO BE RETAINED
	EXISTING TREE TO BE REMOVED
	PERMANENT SURVEY MARK
	TEMPORARY BENCH MARK
	PROPOSED DRIVEWAY & FOOTPATH
	PROPOSED INDUSTRIAL DRIVEWAY
	PROPOSED SHARED FOOTPATH
	PROPOSED ROAD PAVING
	EXISTING ROAD PAVING

**PROPOSED SURFACE LEVELS SHOWN ARE SUBJECT TO CHANGE UPON DETAILED DESIGN AND THEREFORE SHOULD NOT BE RELIED ON AS FINAL SURFACE LEVELS**

**WARNING**  
**BEWARE OF UNDERGROUND SERVICES**  
The locations of underground services are approximate only and their exact position should be proven on site. No guarantee is given that all existing services are shown. Locate all underground services before commencement of works  
**DIAL 1100 BEFORE YOU DIG**  
www.1100.com.au

**AS CONSTRUCTED PLANS**  
The purpose of these as-constructed plans is to update the design drawings to show significant changes which occurred during construction. Note that the levels shown on these plans are design levels, and have not been verified by survey. All information shown on these plans should be verified on site. SMEC Australia Pty Ltd accept no responsibility for loss or damages resulting from the inappropriate usage of these plans.

Quality Management ISO 9001  
Global-Mark.com.au

OH&S Management AS/NZS 4500  
Global-Mark.com.au

Environmental Management ISO 14001  
Global-Mark.com.au

PLAN OF SUB. NO.  
PS841640V/S7  
PERMIT REF. NO.  
WYP10107\_17.02

**AS CONSTRUCTED**



Scale 1:500  
Scale AS SHOWN AT A1

**SMEC**  
Member of the Surlana Jurong Group  
ABN 47 065 475 149  
Collins Square, Tower 4, Level 20, 727 Collins St  
Melbourne, VIC 3008  
Ph 03 9514 1500

**ALAMORA**  
Tarnait

Alamora - Stage 9  
Wyndham City Council  
Road and Drainage  
Earthworks Setout Plan

MELWAYS REF <b>234 D5</b>	PROJECT / DRAWING No. <b>2070E-A09-131</b>	SHEET No. <b>03 of 16</b>	REVISION <b>1</b>
------------------------------	---	------------------------------	----------------------

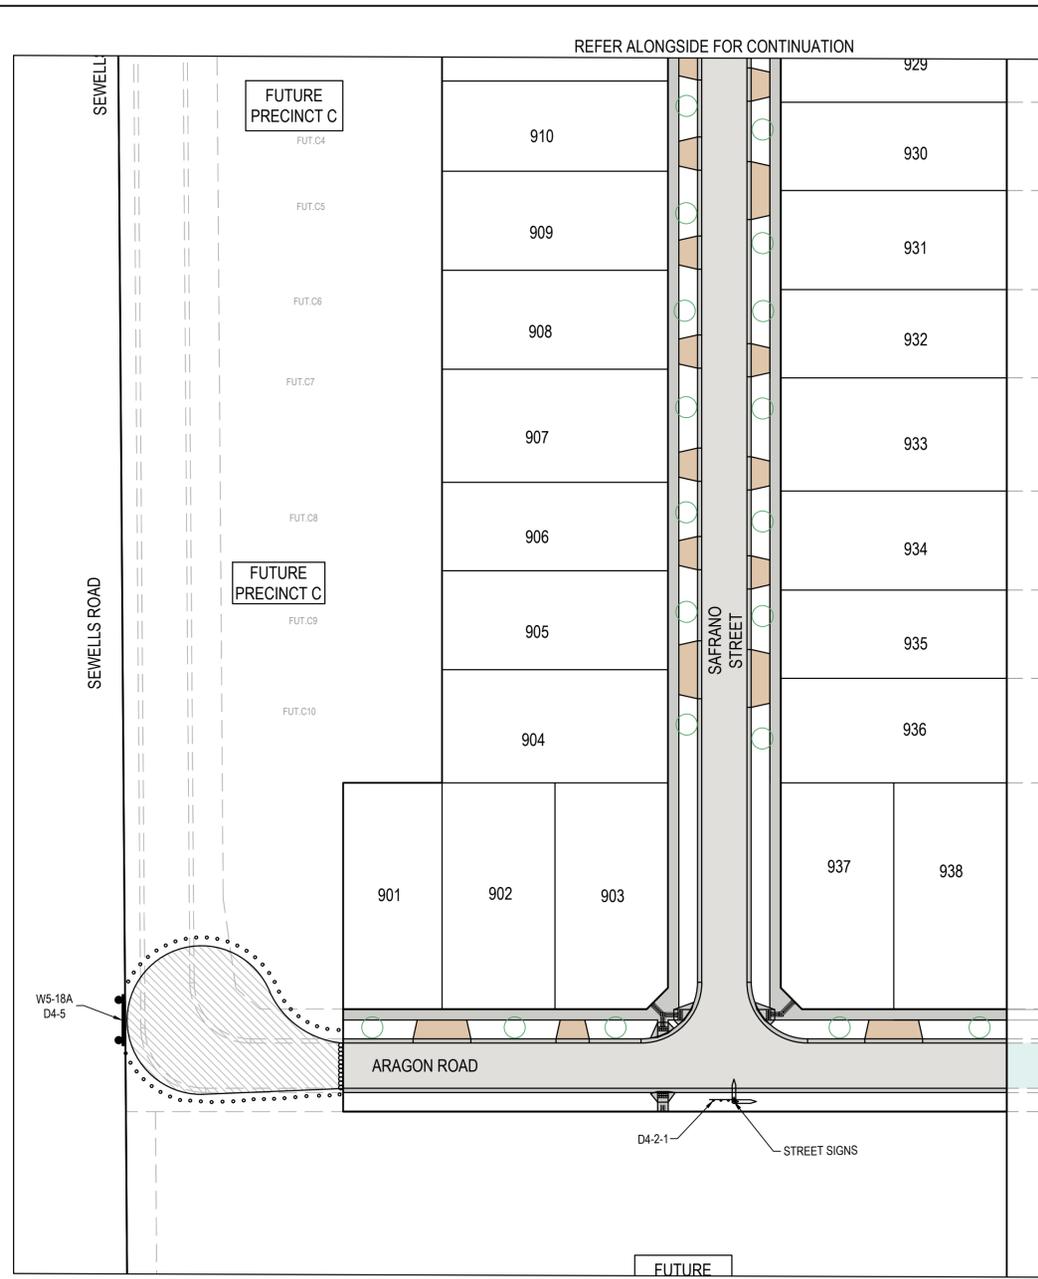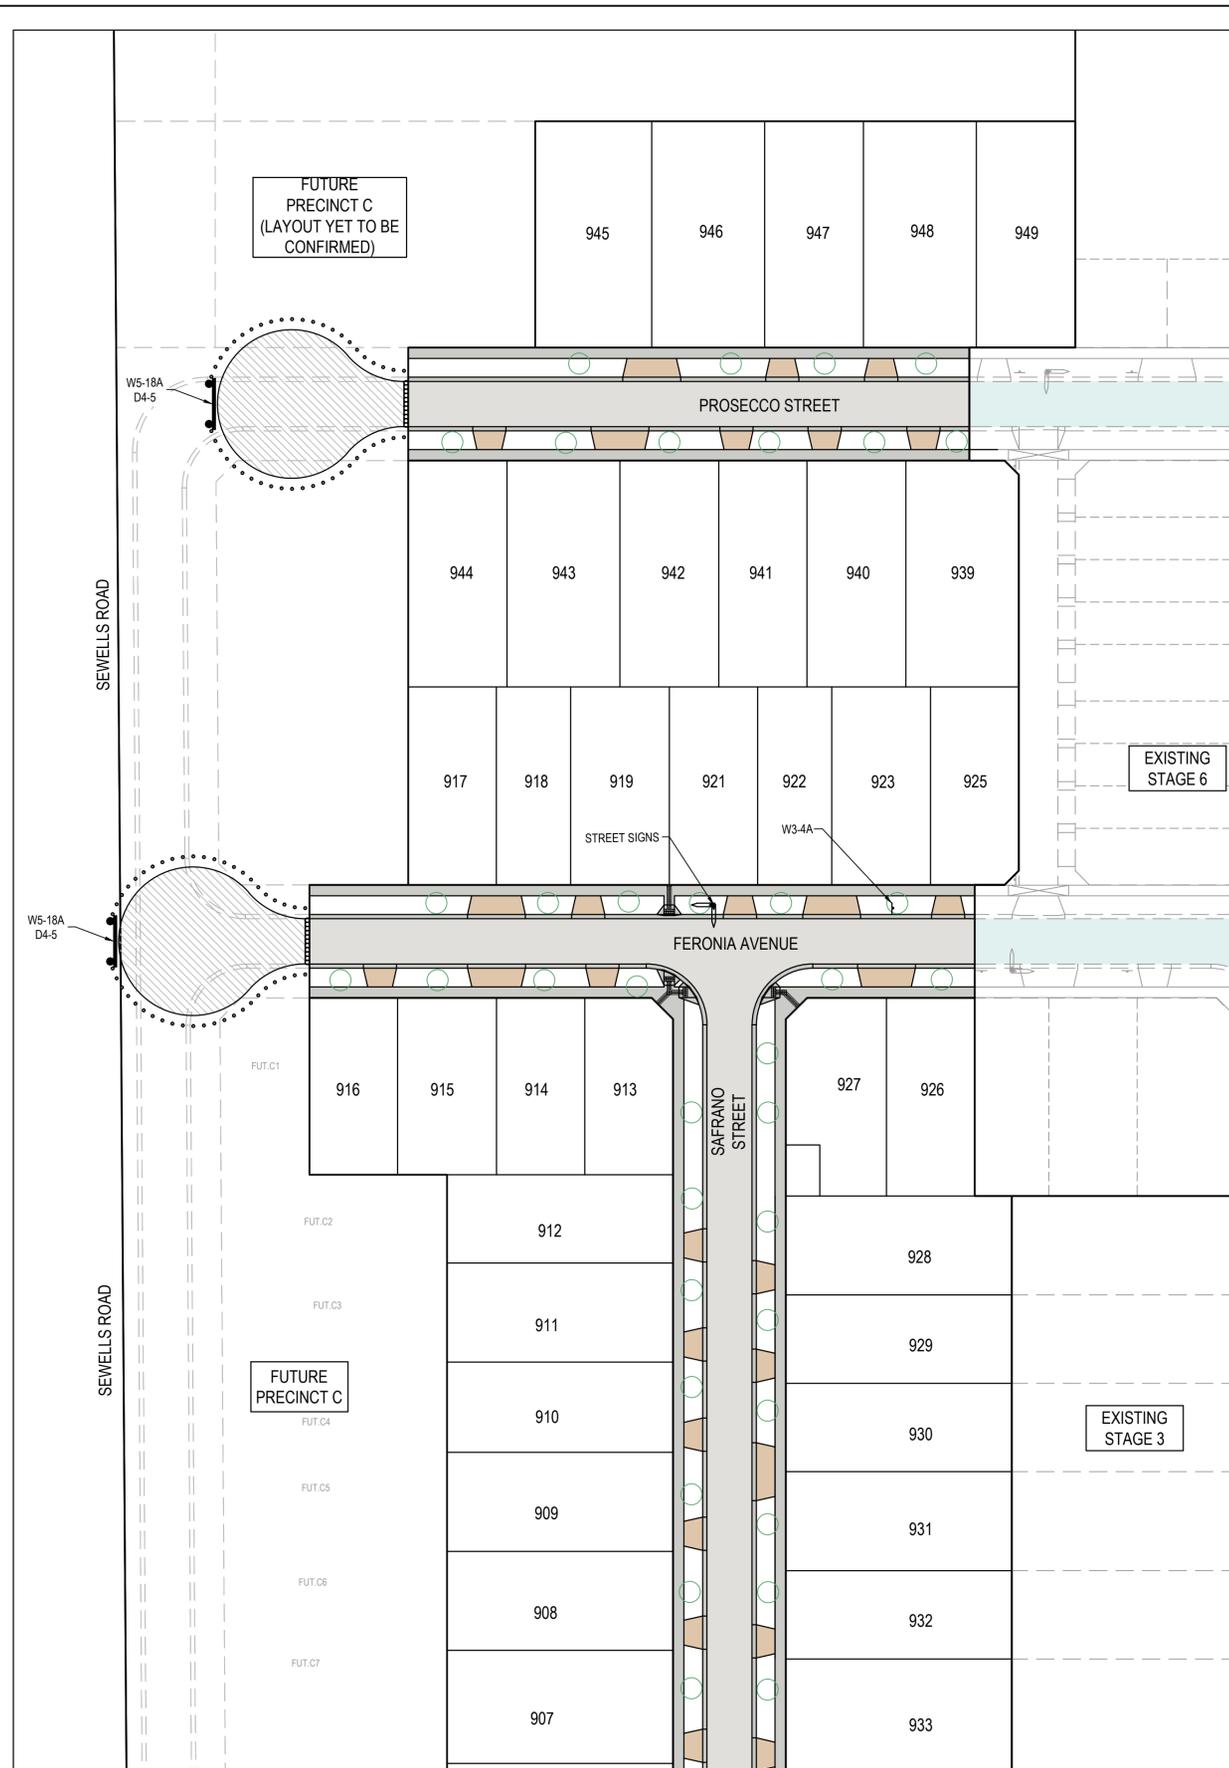



LEGEND - SIGN AND LINEMARKING	
ALL PROPOSED, FUTURE & EXISTING SERVICE LOCATIONS ARE SHOWN INDICATIVELY	
	ROAD ENDS
W5-18A	
	OBSTRUCTION MARKER
D4-5	
	TWO-WAY HAZARD MARKER
D4-2-1	
	SPEED HUMP AHEAD
W3-4A	

PROPOSED SURFACE LEVELS SHOWN ARE SUBJECT TO CHANGE UPON DETAILED DESIGN AND THEREFORE SHOULD NOT BE RELIED ON AS FINAL SURFACE LEVELS

**WARNING**  
**BEWARE OF UNDERGROUND SERVICES**  
 The locations of underground services are approximate only and their exact position should be proven on site. No guarantee is given that all existing services are shown. Locate all underground services before commencement of works **DIAL 1100 BEFORE YOU DIG**  
[www.1100.com.au](http://www.1100.com.au)

**AS CONSTRUCTED PLANS**  
 The purpose of these as-constructed plans is to update the design drawings to show significant changes which occurred during construction. Note that the levels shown on these plans are design levels, and have not been verified by survey. All information shown on these plans should be verified on site. SMEC Australia Pty Ltd accept no responsibility for loss or damages resulting from the inappropriate usage of these plans.







PLAN OF SUB. NO. PS841640V/S7  
 PERMIT REF. NO. WYP10107\_17.02  
**AS CONSTRUCTED**

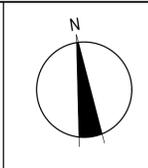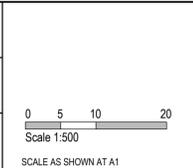

Member of the Surlana Jurong Group  
 ABN 47 065 475 149  
 Collins Square, Tower 4, Level 20, 727 Collins St  
 Melbourne, VIC 3008  
 Ph 03 9514 1500

Alamora - Stage 9  
 Wyndham City Council  
 Road and Drainage  
 Signage & Linemarking Plan

MELWAYS REF 234 D5	PROJECT / DRAWING No. 2070E-A09-171	SHEET No. 04 of 16	REVISION 1
-----------------------	--	-----------------------	---------------

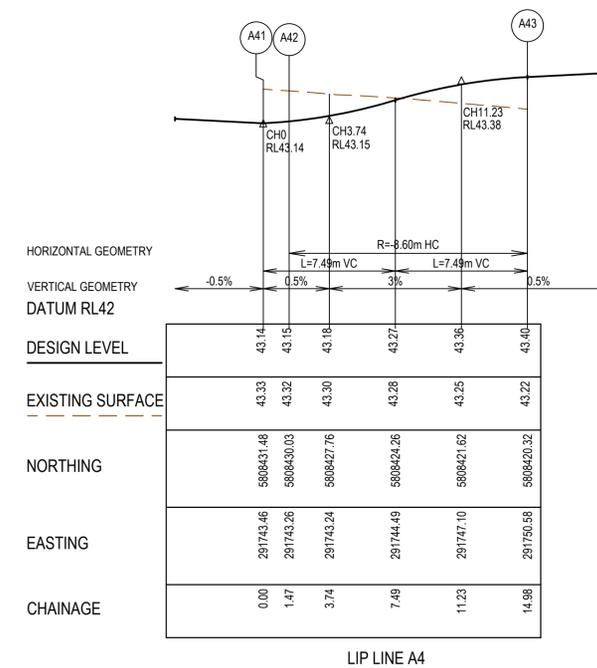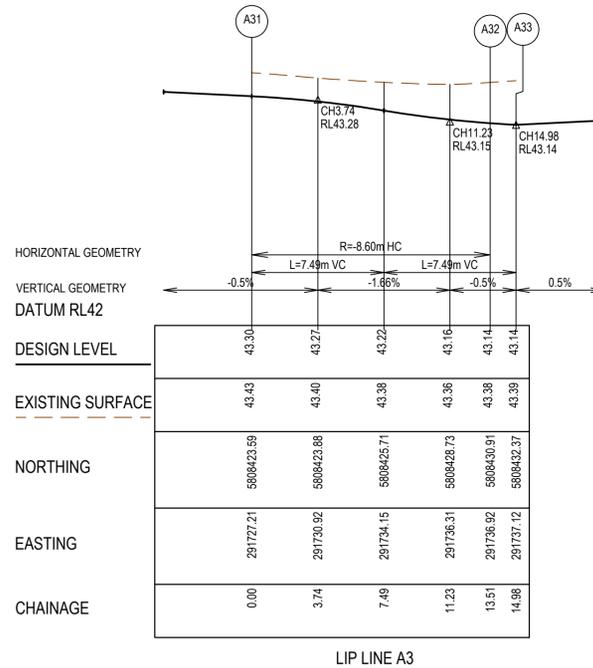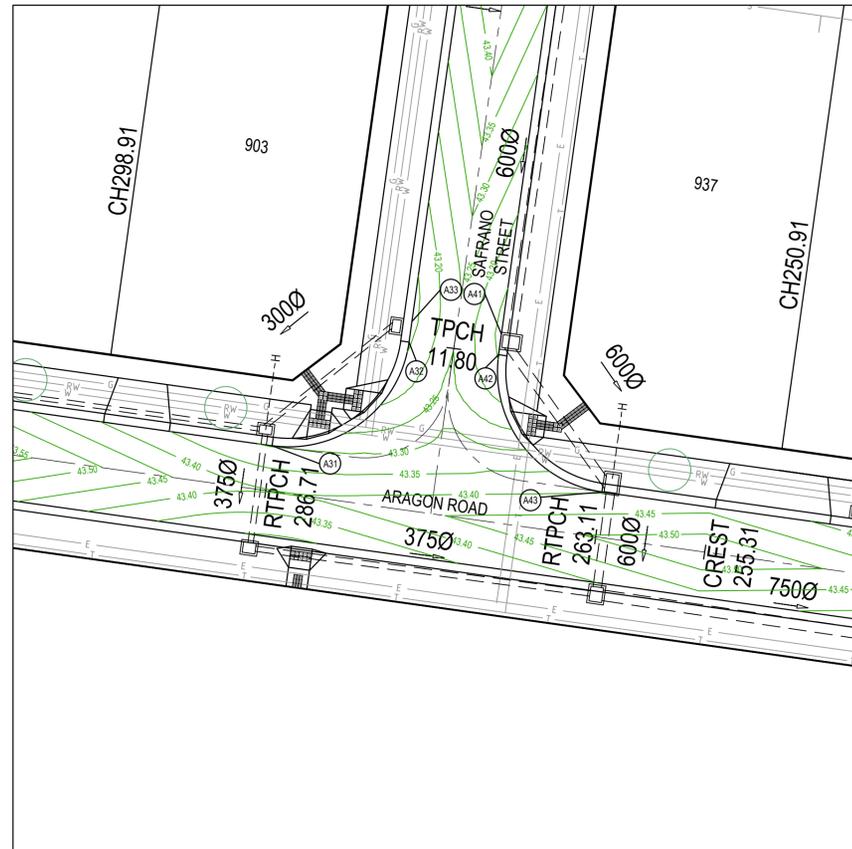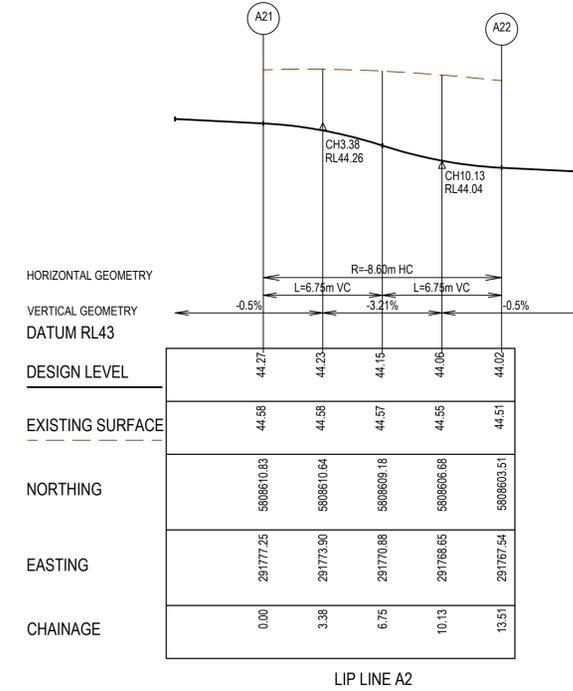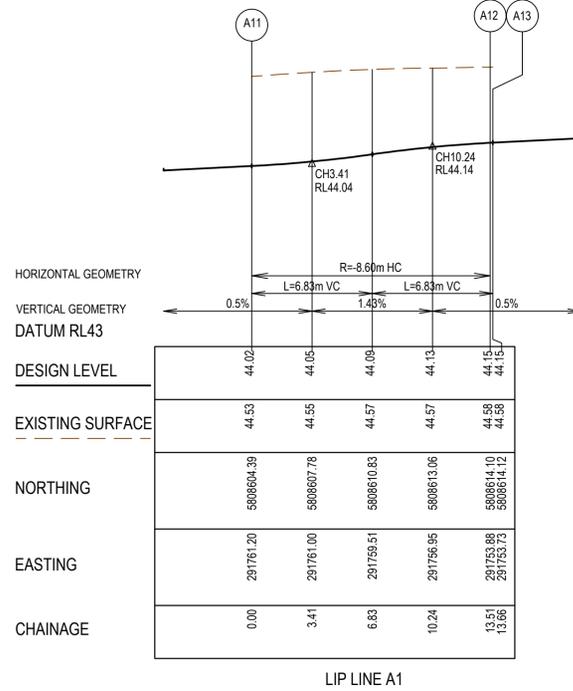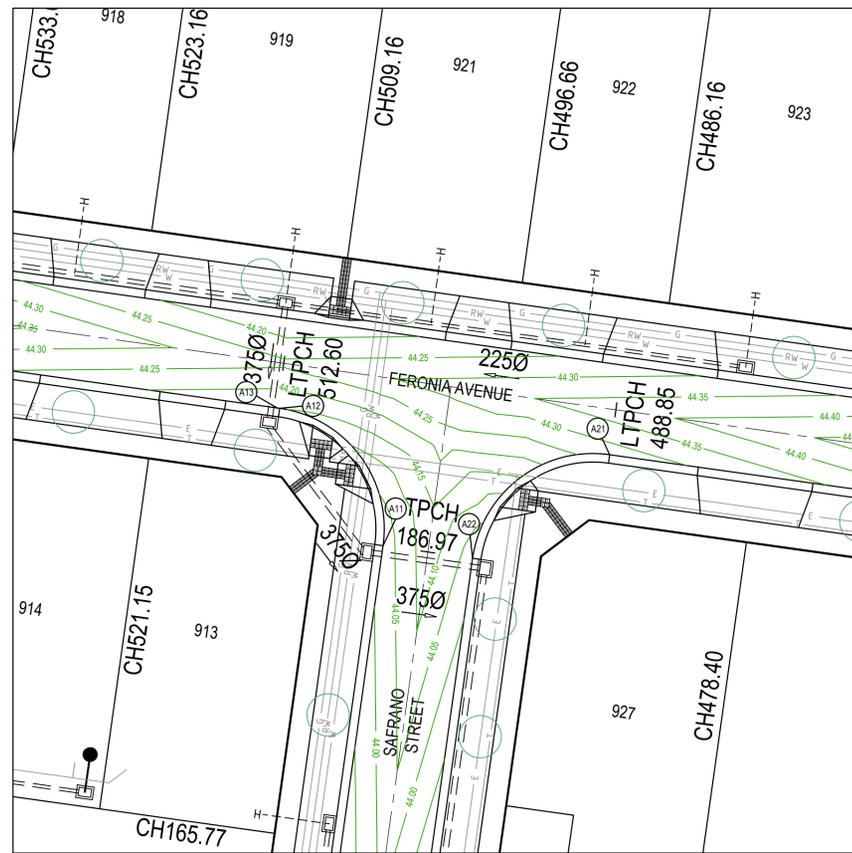

**LEGEND - INTERSECTION DETAIL PLAN**  
ALL PROPOSED, FUTURE & EXISTING SERVICE LOCATIONS ARE SHOWN INDICATIVELY

	STORMWATER DRAIN, PIT & PROPERTY INLET
	MAIN DRAIN
	SEWER & MAINTENANCE STRUCTURES
	HOUSE DRAIN
	SERVICE CONDUITS
	TACTILE PAVERS
	EXISTING STORMWATER DRAIN
	EXISTING MAIN DRAIN
	EXISTING SEWER & MAINTENANCE STRUCTURES
	EXISTING SERVICE CONDUITS
	EXISTING TACTILE PAVERS
	FUTURE STORMWATER DRAIN
	FUTURE MAIN DRAIN
	FUTURE SEWER & MAINTENANCE STRUCTURES
	FUTURE HOUSE DRAIN
	FUTURE SERVICE CONDUITS
	FUTURE TACTILE PAVERS
	EDGE STRIP, SUBSOIL DRAIN, "NO ROAD" SIGN & BARRIER
	PERMANENT SURVEY MARK
	TEMPORARY BENCH MARK
	PROPOSED DRIVEWAY & FOOTPATH

**WARNING**  
**Beware of Underground Services**  
The locations of underground services are approximate only and their exact position should be proven on site. No guarantee is given that all existing services are shown. Locate all underground services before commencement of works. **DIAL 1100 BEFORE YOU DIG**  
www.1100.com.au



**AS CONSTRUCTED PLANS**

The purpose of these as-constructed plans is to update the design drawings to show significant changes which occurred during construction. Note that the levels shown on these plans are design levels, and have not been verified by survey. All information shown on these plans should be verified on site. SMEC Australia Pty Ltd accept no responsibility for loss or damages resulting from the inappropriate usage of these plans.





**AS CONSTRUCTED**

PLAN OF SUB. NO.  
PS841640V/S7  
PERMIT REF. NO.  
WYP10107\_17.02

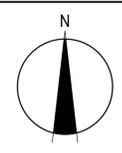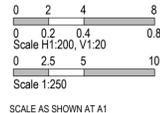

Alamora - Stage 9  
Wyndham City Council  
Road and Drainage  
Intersection Detail Plan

MELWAYS REF <b>234 D5</b>	PROJECT / DRAWING No. <b>2070E-A09-181</b>	SHEET No. <b>05 of 16</b>	REVISION <b>1</b>
------------------------------	---	------------------------------	----------------------

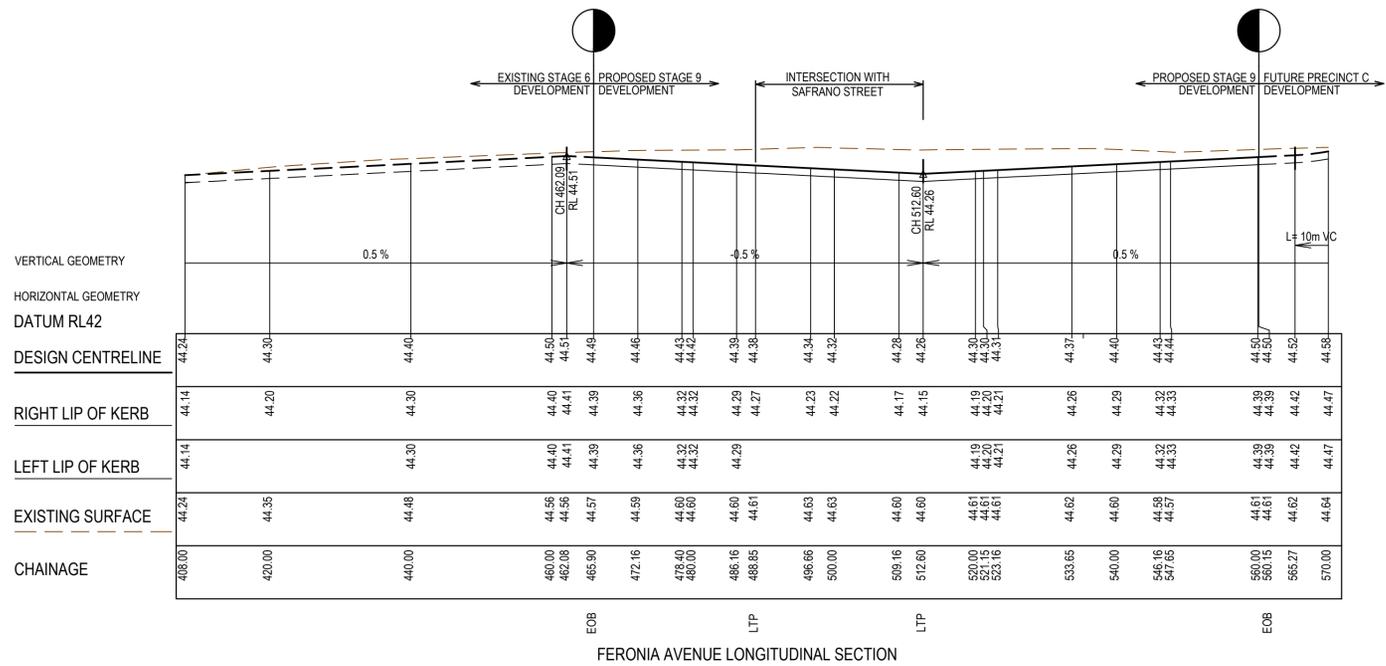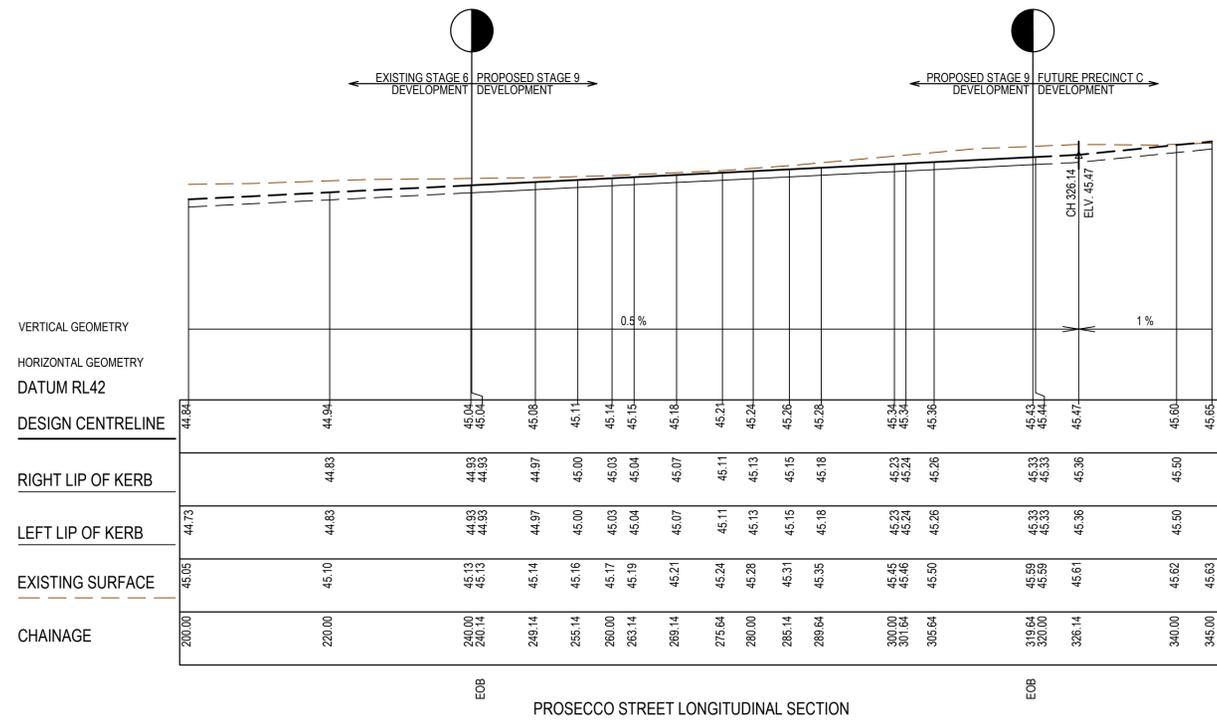

**AS CONSTRUCTED PLANS**  
 The purpose of these as-constructed plans is to update the design drawings to show significant changes which occurred during construction. Note that the levels shown on these plans are design levels, and have not been verified by survey. All information shown on these plans should be verified on site. SMEC Australia Pty Ltd accept no responsibility for loss or damages resulting from the inappropriate usage of these plans.





PLAN OF SUB. NO.  
 PS841640V/S7  
 PERMIT REF. NO.  
 WYP10107\_17.02

**AS CONSTRUCTED**



0 5 10 20  
 0 0.5 1 2  
 Scale H1:500, V1:50  
 SCALE AS SHOWN AT 1

  
 Member of the Surlana Jurong Group  
 ABN 47 065 475 149  
 Collins Square, Tower 4, Level 20, 727 Collins St  
 Melbourne, VIC 3008  
 Ph 03 9514 1900



Alamora - Stage 9  
 Wyndham City Council  
 Road and Drainage  
 Road Longitudinal Sections - 1

MELWAYS REF <b>234 D5</b>	PROJECT / DRAWING No. <b>2070E-A09-201</b>	SHEET No. <b>06 of 16</b>	REVISION <b>1</b>
------------------------------	---	------------------------------	----------------------

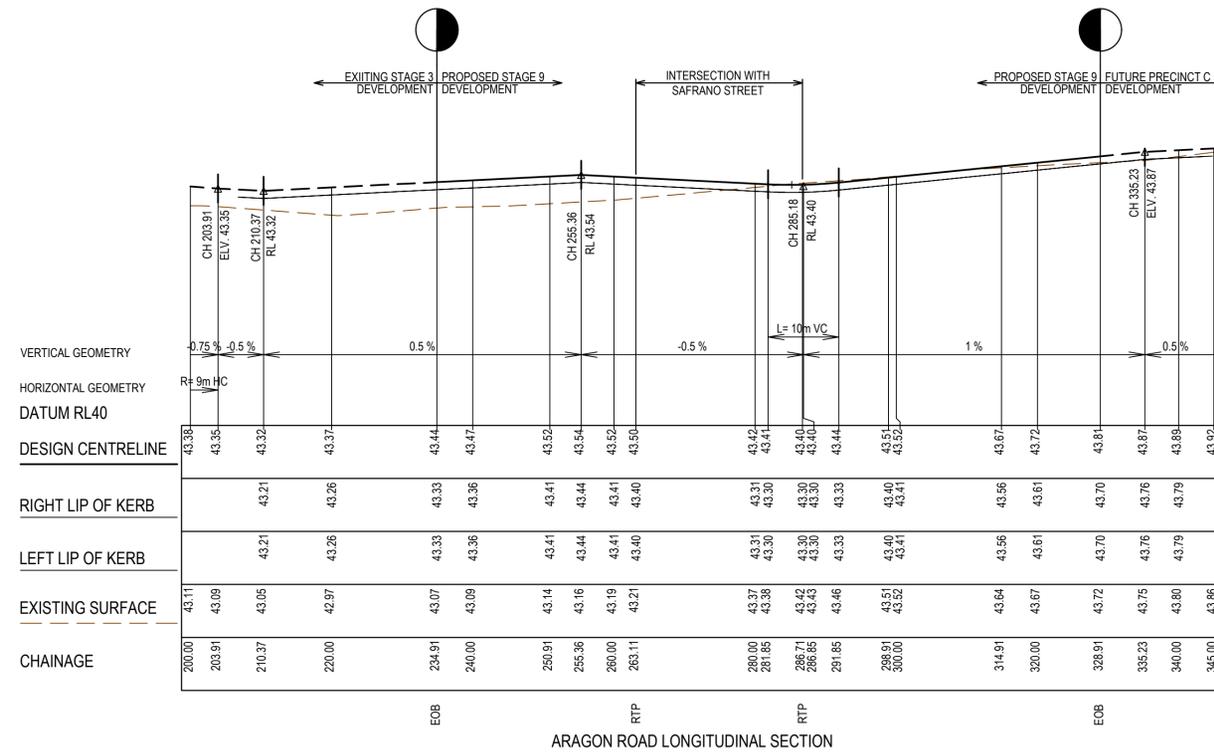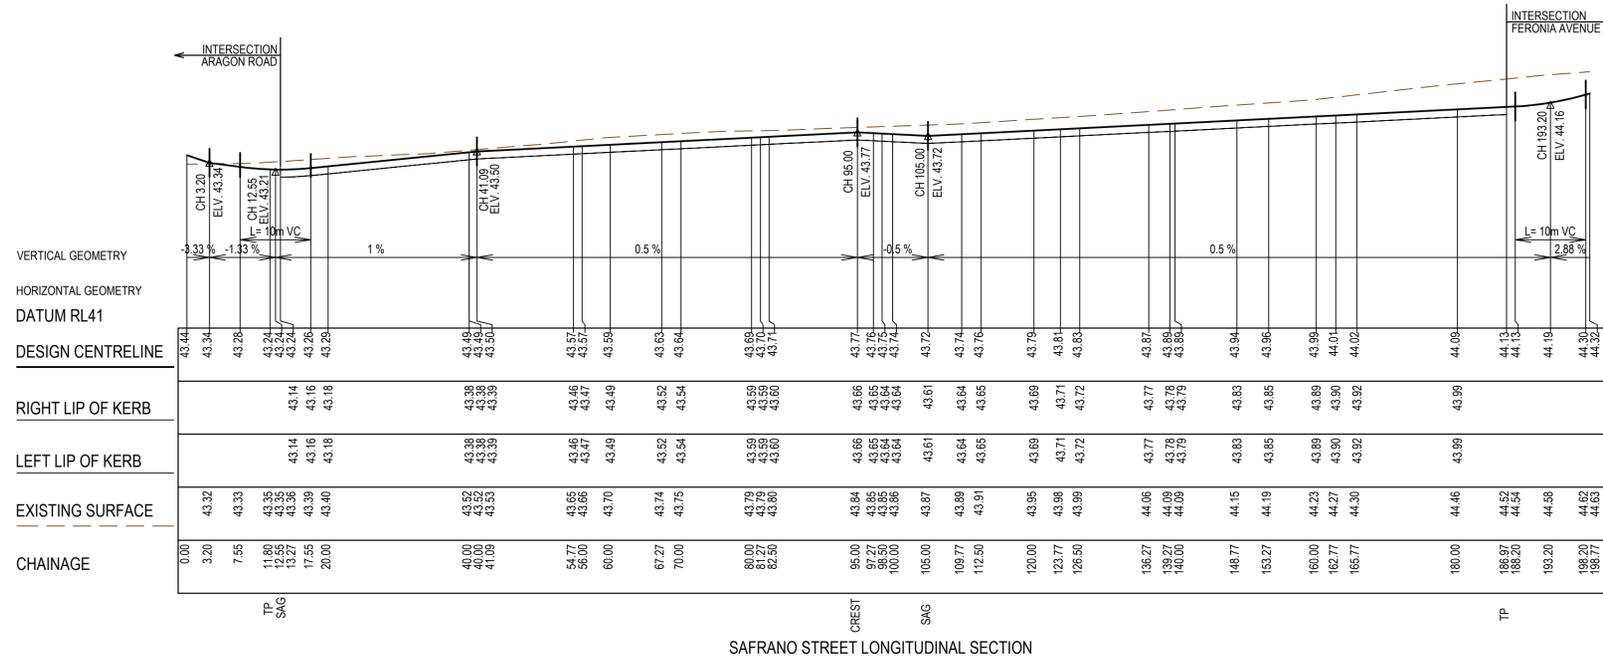

**AS CONSTRUCTED PLANS**

The purpose of these as-constructed plans is to update the design drawings to show significant changes which occurred during construction. Note that the levels shown on these plans are design levels, and have not been verified by survey. All information shown on these plans should be verified on site. SMEC Australia Pty Ltd accept no responsibility for loss or damages resulting from the inappropriate usage of these plans.

**AS CONSTRUCTED**


PLAN OF SUB. NO.	PS841640V/S7
PERMIT REF. NO.	WYP10107_17.02

**SMEC**  
Member of the Surlana Jurong Group  
ABN 47 065 475 149  
Collins Square, Tower 4, Level 20, 727 Collins St  
Melbourne, VIC 3008  
Ph 03 9514 1500


**ALAMORA**  
Yarnit

Alamora - Stage 9 Wyndham City Council Road and Drainage Road Longitudinal Sections - 2		MELWAYS REF <b>234 D5</b>	PROJECT / DRAWING No. <b>2070E-A09-202</b>	SHEET No. <b>07 of 16</b>	REVISION <b>1</b>
--	--	------------------------------	---	------------------------------	----------------------


STRUCTURAL FILL REQUIRED UNDER PAVEMENT AND FOOTPATHS WHERE CONSTRUCTED ABOVE EXISTING SURFACE

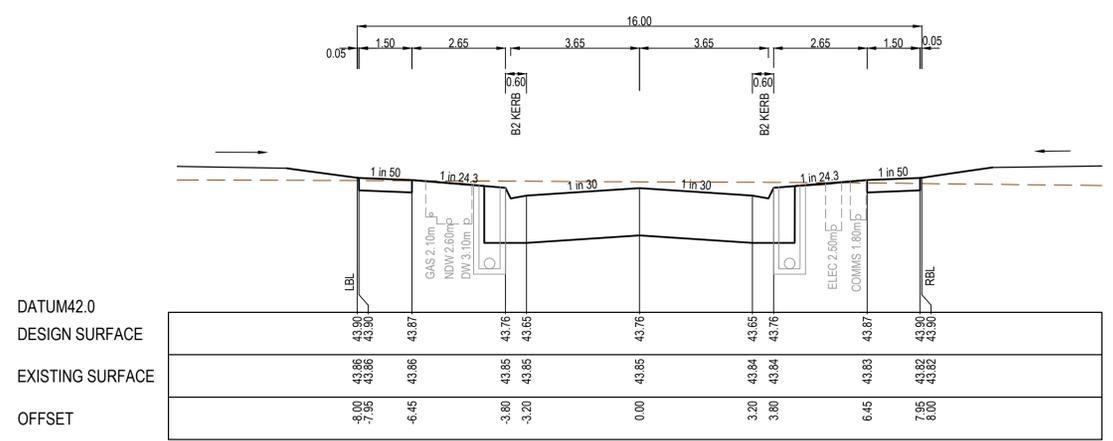


CH 97.27

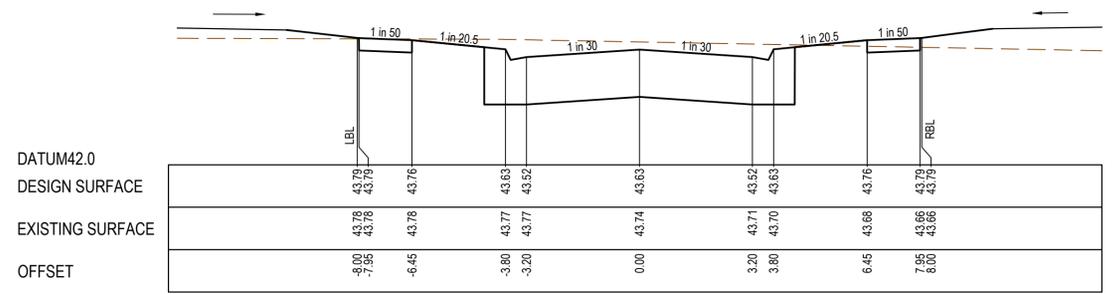


CH 67.27

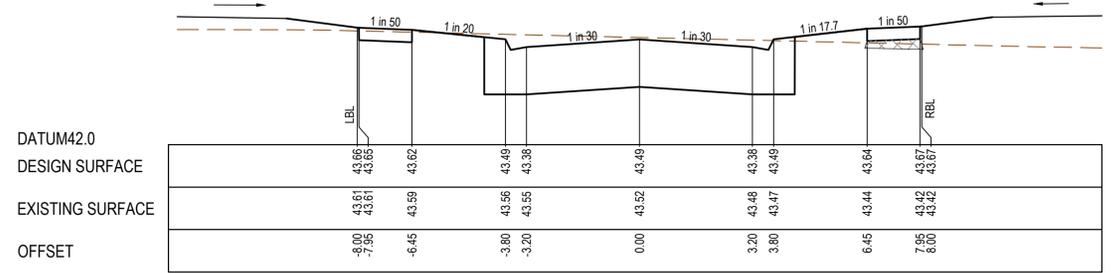


CH 40.00

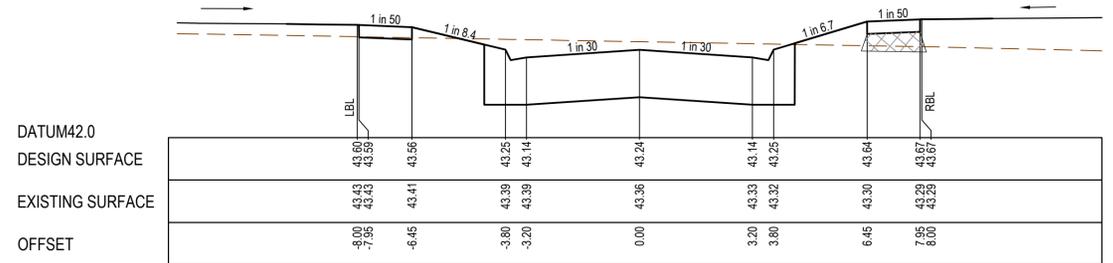


TPCH 13.27

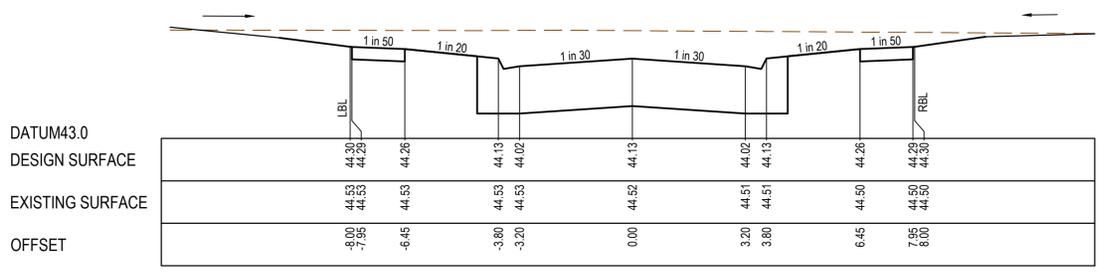

TPCH 186.97

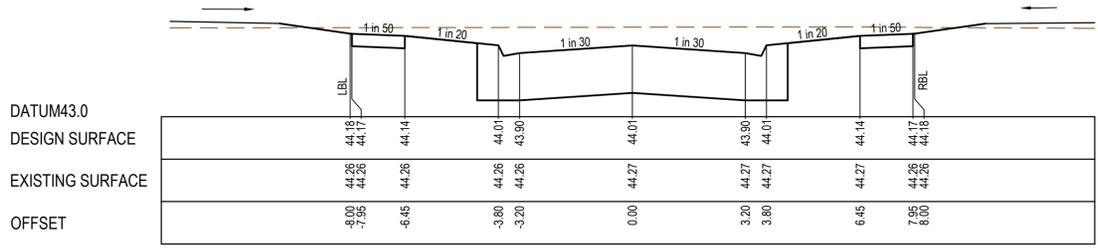

CH 162.77

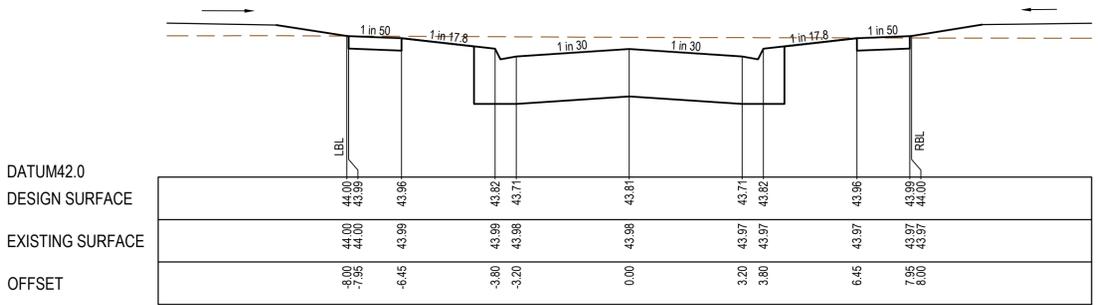


CH 123.77

**AS CONSTRUCTED PLANS**

The purpose of these as-constructed plans is to update the design drawings to show significant changes which occurred during construction. Note that the levels shown on these plans are design levels, and have not been verified by survey. All information shown on these plans should be verified on site. SMEC Australia Pty Ltd accept no responsibility for loss or damages resulting from the inappropriate usage of these plans.

PLAN OF SUB. NO.  
PS841640V/S7  
PERMIT REF. NO.  
WYP10107\_17.02

**AS CONSTRUCTED**

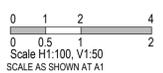

**SMEC**  
Member of the Surlana Jurong Group  
ABN 47 065 475 149  
Collins Square, Tower 4, Level 20, 727 Collins St  
Melbourne, VIC 3008  
Ph 03 9514 1500





Alamora - Stage 9  
Wyndham City Council  
Road and Drainage  
Cross Sections: Safrano Street  
Ch 13.27 - Ch 186.97

MELWAYS REF <b>234 D5</b>	PROJECT / DRAWING No. <b>2070E-A09-251</b>	SHEET No. <b>08 of 16</b>	REVISION <b>1</b>
------------------------------	---	------------------------------	----------------------





**CRUSHED ROCK BACKFILL**  
 CRB INDICATES CRUSHED ROCK BACKFILL COMPACTED IN ACCORDANCE WITH WYNDHAM CITY COUNCIL STANDARDS & SPECIFICATION CLASS 2 UNDER ROAD PAVEMENT & CLASS 3 BEHIND KERB

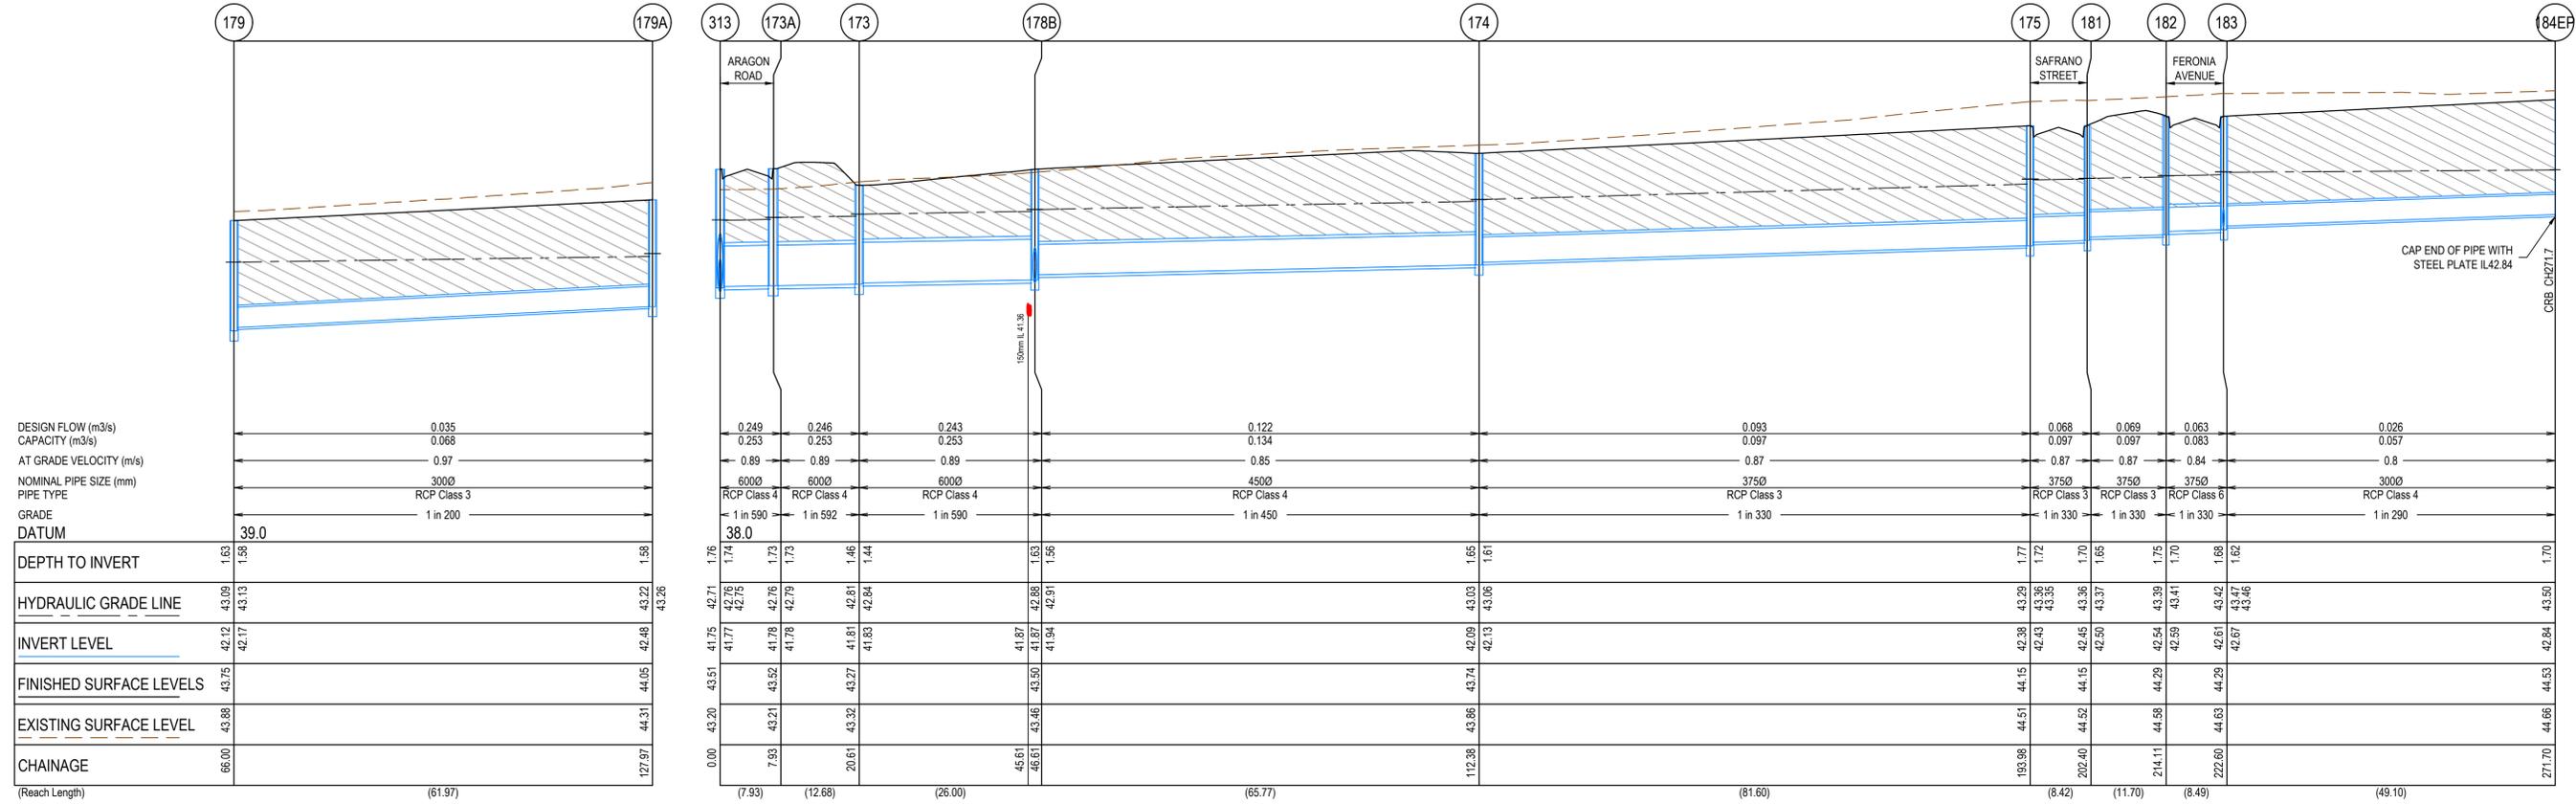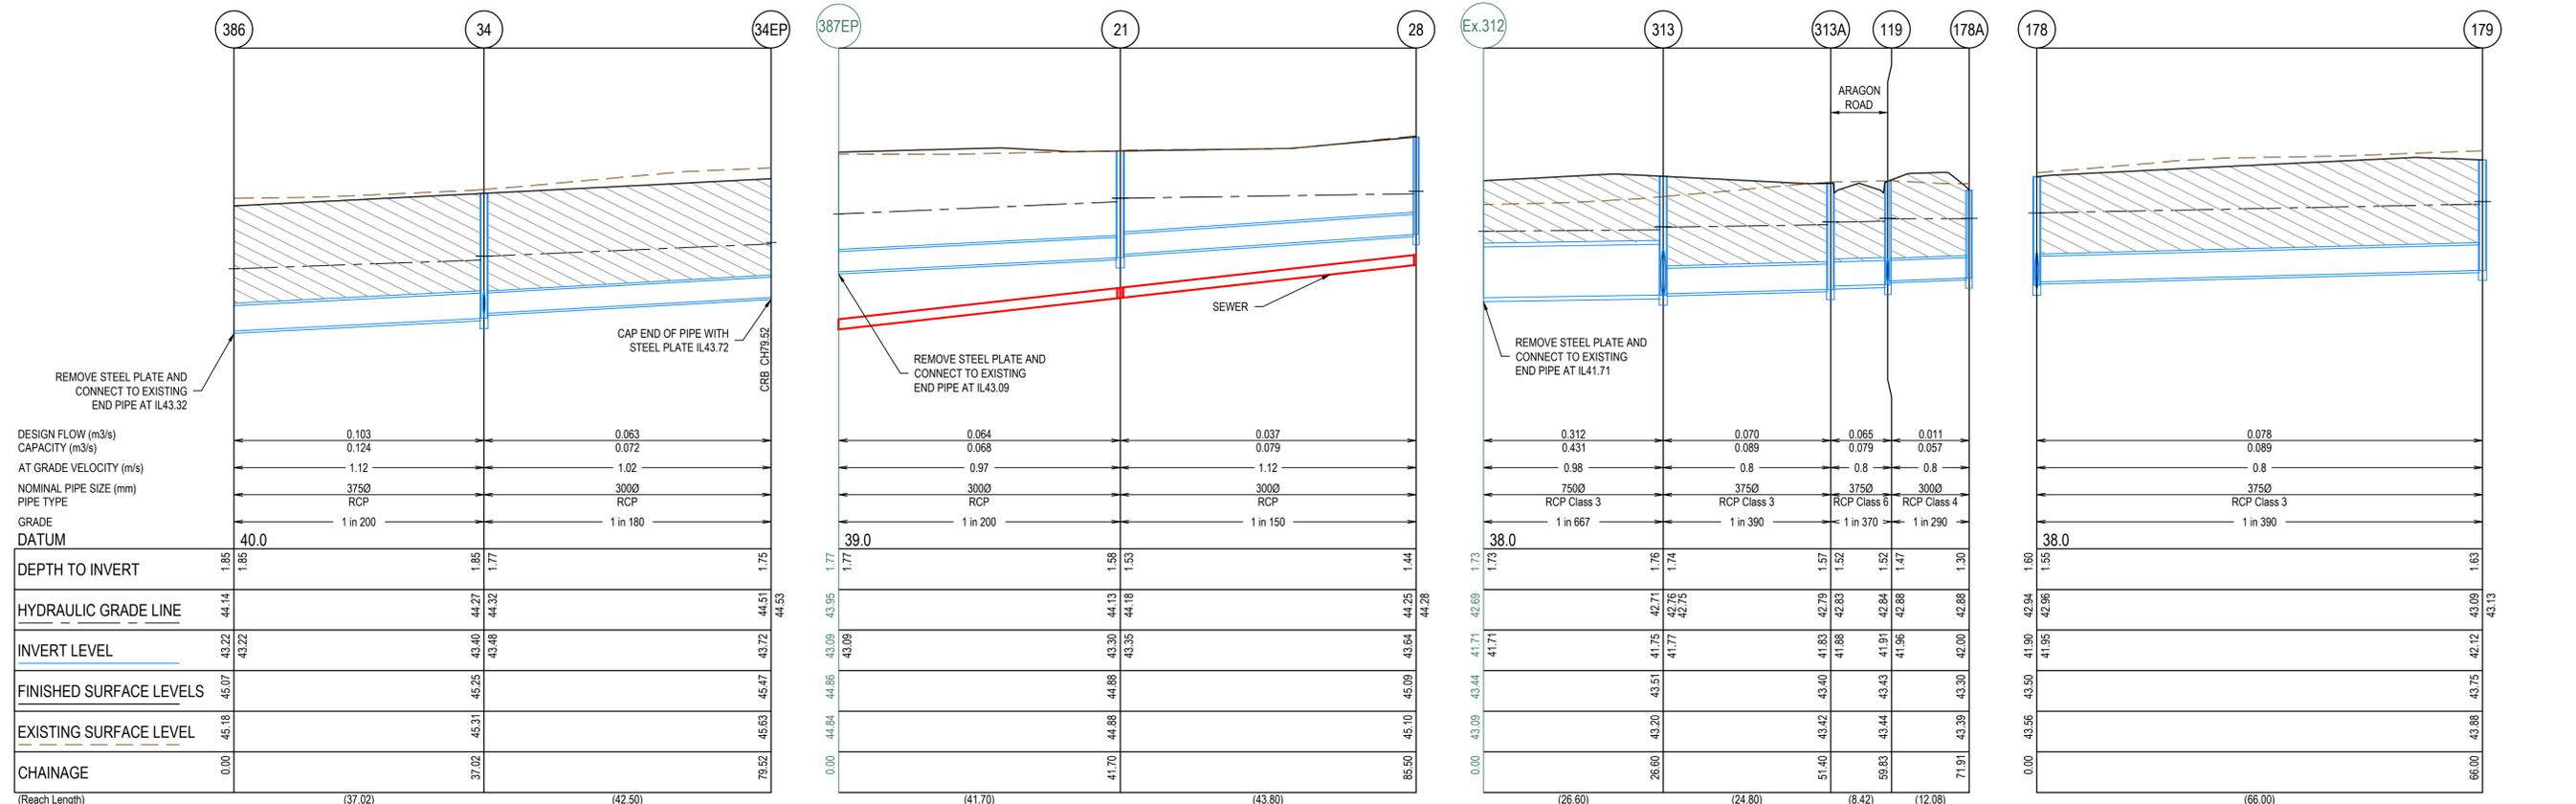

**AS CONSTRUCTED PLANS**

The purpose of these as-constructed plans is to update the design drawings to show significant changes which occurred during construction. Note that the levels shown on these plans are design levels, and have not been verified by survey. All information shown on these plans should be verified on site. SMEC Australia Pty Ltd accept no responsibility for loss or damages resulting from the inappropriate usage of these plans.

PLAN OF SUB. NO. PS841640/S7  
 PERMIT REF. NO. WYP10107\_17.02  
**AS CONSTRUCTED**






Member of the Surlana Jurong Group  
 ABN 47 065 475 149  
 Collins Square, Tower 4, Level 20, 727 Collins St  
 Melbourne, VIC 3008  
 Ph 03 9514 1500

**ALAMORA**  
*Partners*

Alamora - Stage 9  
 Wyndham City Council  
 Road and Drainage  
 Drainage Longitudinal Sections - 1

MELWAYS REF <b>234 D5</b>	PROJECT / DRAWING No. <b>2070E-A09-301</b>	SHEET No. <b>11 of 16</b>	REVISION <b>1</b>
------------------------------	---	------------------------------	----------------------

**CRUSHED ROCK BACKFILL**  
 CRB INDICATES CRUSHED ROCK BACKFILL COMPACTED IN ACCORDANCE WITH WYNDHAM CITY COUNCIL STANDARDS & SPECIFICATION CLASS 2 UNDER ROAD PAVEMENT & CLASS 3 BEHIND KERB

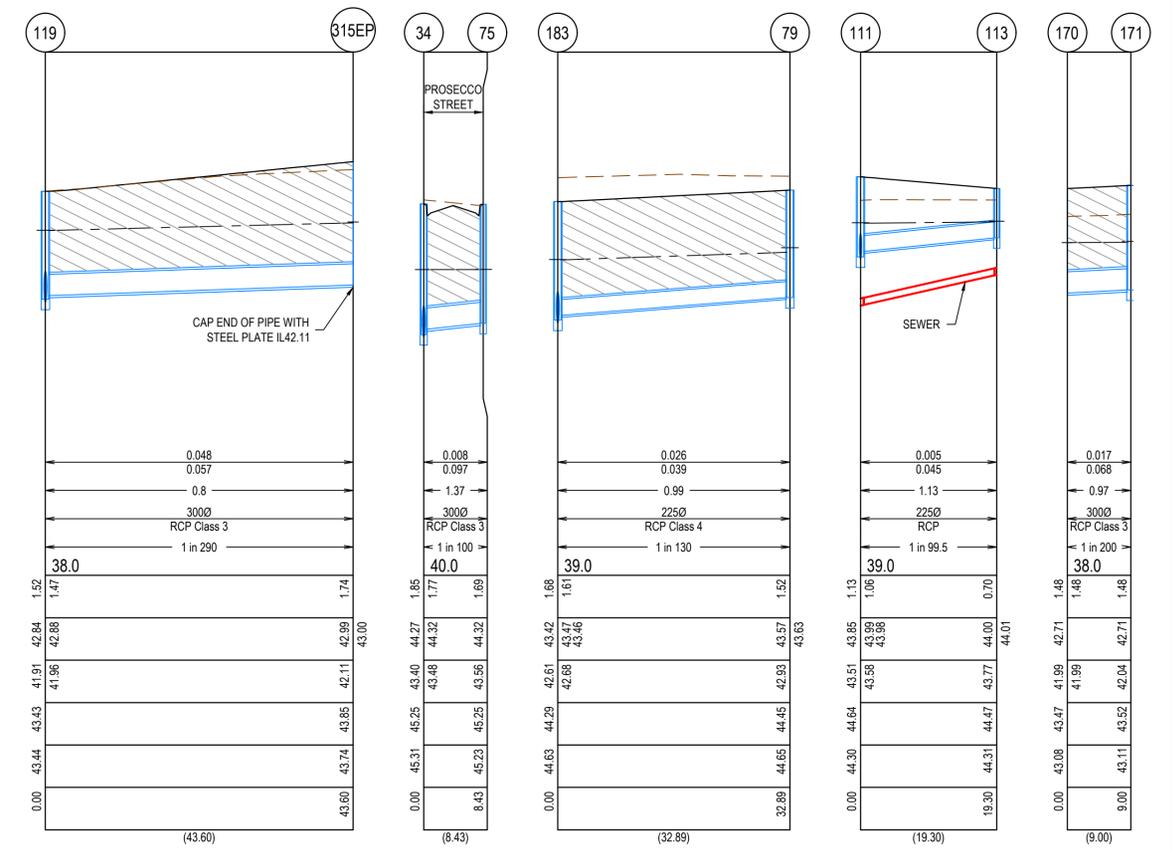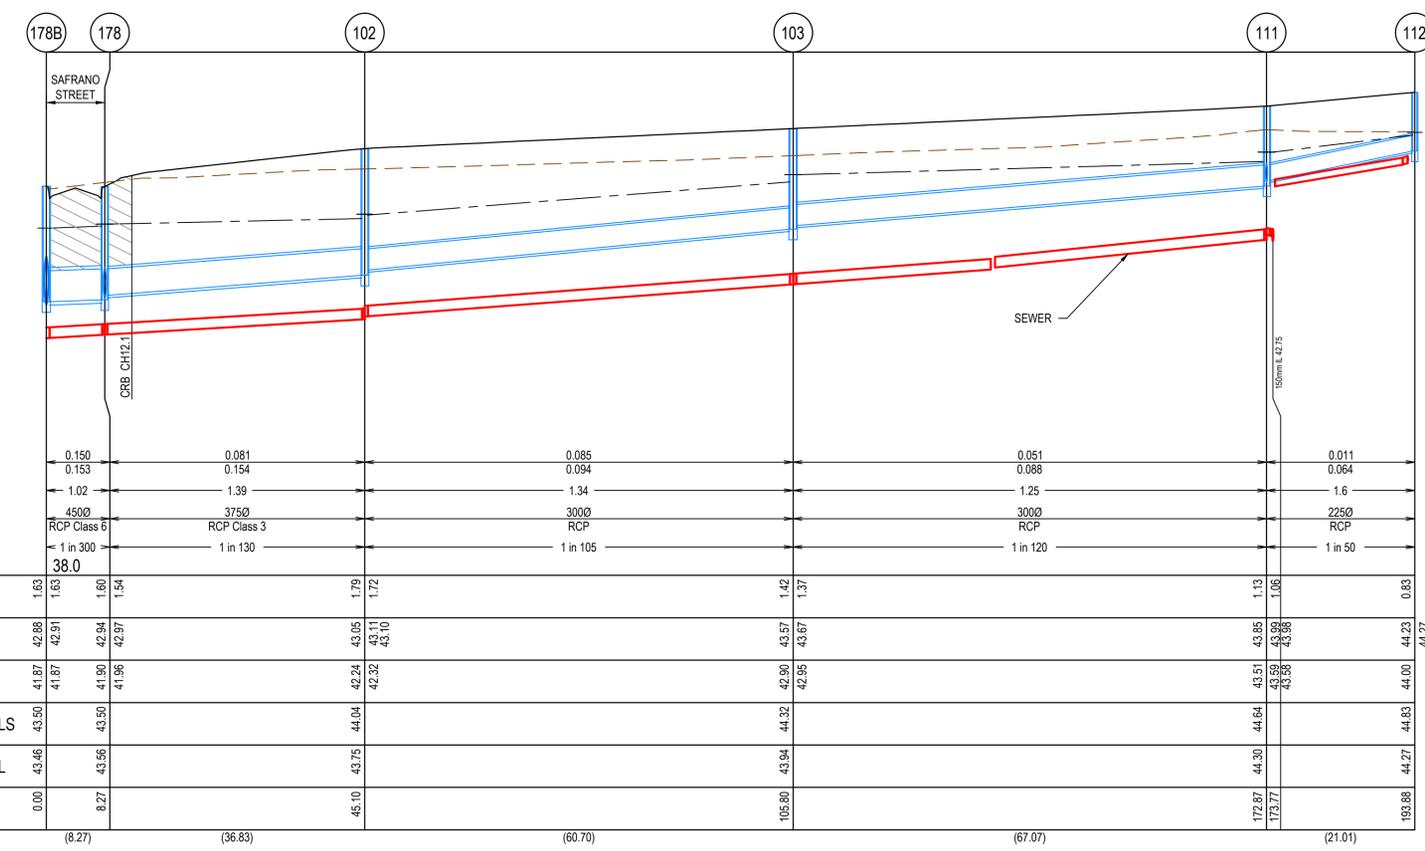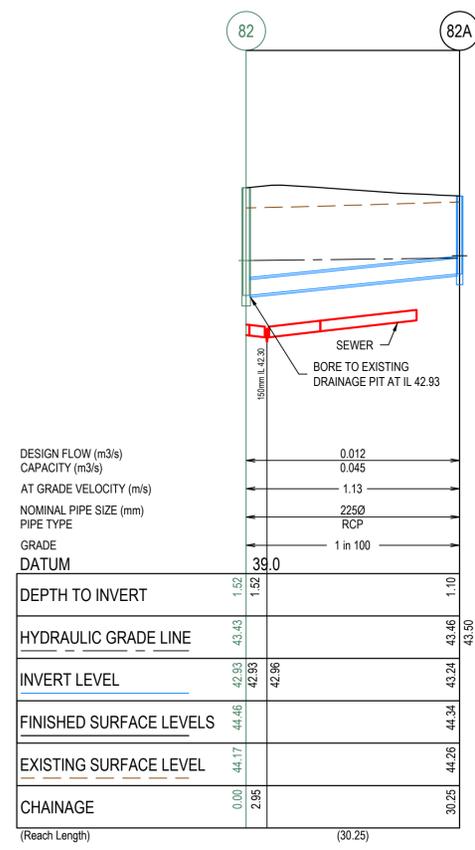


**AS CONSTRUCTED PLANS**

The purpose of these as-constructed plans is to update the design drawings to show significant changes which occurred during construction. Note that the levels shown on these plans are design levels, and have not been verified by survey. All information shown on these plans should be verified on site. SMEC Australia Pty Ltd accept no responsibility for loss or damages resulting from the inappropriate usage of these plans.



PLAN OF SUB. NO.  
PS841640V/S7  
 PERMIT REF. NO.  
WYP10107\_17.02

**AS CONSTRUCTED**

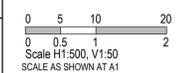

Alamora - Stage 9  
 Wyndham City Council  
 Road and Drainage  
 Drainage Longitudinal Sections - 2

MELWAYS REF <b>234 D5</b>	PROJECT / DRAWING No. <b>2070E-A09-302</b>	SHEET No. <b>12 of 16</b>	REVISION <b>1</b>
------------------------------	---	------------------------------	----------------------

PIT NUMBER	TYPE	PIT SCHEDULE								STANDARD DRAWING	REMARKS
		INTERNAL		INLET		OUTLET		F.S.L.	DEPTH		
		WIDTH (mm)	LENGTH (mm)	DIAMETER (mm)	INV R.L. (m)	DIAMETER (mm)	INV R.L. (m)				
386	ENDPIPE			375	43.22	Ex.375	43.22	45.068	1.848		REMOVE STEEL PLATE AND CONNECT TO END PIPE
34	SIDE ENTRY PIT GRATED	750	900	300	43.48	375	43.405	45.253	1.848	EDCM 601 & 607	PIT TO BE HAUNCHED TO 600x900 COVER TOWARDS PAVEMENT
34EP	ENDPIPE					300	43.716	45.469	1.753		CAP END OF PIPE WITH STEEL PLATE
387EP	ENDPIPE			300	43.093	Ex.300	43.093	44.856	1.763		REMOVE STEEL PLATE AND CONNECT TO END PIPE
21	JUNCTION PIT	600	900	300	43.352	300	43.302	44.908	1.606	EDCM 605	
28	JUNCTION PIT	600	900	225	43.719	300	43.644	45.097	1.453	EDCM 605	
312	ENDPIPE			750	41.71	Ex.750	41.71	43.44	1.729		REMOVE STEEL PLATE AND CONNECT TO END PIPE
313	JUNCTION PIT	1050	900	375	41.77	750	41.75	43.506	1.755	EDCM 605 & 607	PIT TO BE HAUNCHED TO 600x900 COVER TOWARDS PAVEMENT
313a	DOUBLE SIDE ENTRY PIT GRATED	750	900	355	41.884	375	41.834	43.401	1.567	EDCM 602 & 607	PIT TO BE HAUNCHED TO 600x900 COVER TOWARDS PAVEMENT
119	DOUBLE SIDE ENTRY PIT GRATED	600	900	300	41.962	355	41.907	43.431	1.524	EDCM 602	
178a	DOUBLE SIDE ENTRY PIT GRATED	600	900			300	42.003	43.288	1.285	EDCM 602	
178	JUNCTION PIT	750	900	375	41.947	450	41.897	43.5	1.603	EDCM 605 & 607	PIT TO BE HAUNCHED TO 600x900 COVER TOWARDS PAVEMENT
179	DOUBLE SIDE ENTRY PIT GRATED	750	900	300	42.166	375	42.116	43.747	1.631	EDCM 602 & 607	PIT TO BE HAUNCHED TO 600x900 COVER TOWARDS PAVEMENT
179a	JUNCTION PIT	600	900			300	42.476	44.047	1.571	EDCM 605	
173a	JUNCTION PIT	1300	900	600	41.784	600	41.784	43.515	1.731	EDCM 605 & 607	PIT TO BE HAUNCHED TO 600x900 COVER TOWARDS PAVEMENT
173	DOUBLE SIDE ENTRY PIT	1200	900	600	41.825	600	41.805	43.293	1.488	EDCM 602 & 607	PIT TO BE HAUNCHED TO 600x900 COVER TOWARDS PAVEMENT
178b	JUNCTION PIT	900	900	450	41.944	600	41.869	43.511	1.642	EDCM 605 & 607	PIT TO BE HAUNCHED TO 600x900 COVER TOWARDS PAVEMENT
174	DOUBLE GRATED ENTRY PIT	900	900	375	42.128	450	42.09	43.741	1.651	EDCM 602 & 607	PIT TO BE HAUNCHED TO 600x900 COVER TOWARDS PAVEMENT
175	GRATED ENTRY PIT	750	900	375	42.425	375	42.375	44.156	1.781	EDCM 601 & 607	PIT TO BE HAUNCHED TO 600x900 COVER TOWARDS PAVEMENT
181	GRATED ENTRY PIT	600	900	375	42.501	375	42.451	44.144	1.694	EDCM 601	
182	DOUBLE GRATED ENTRY PIT	600	900	375	42.586	375	42.536	44.288	1.752	EDCM 602	
183	DOUBLE GRATED ENTRY PIT	600	900	300	42.667	375	42.612	44.288	1.676	EDCM 602	
184EP	ENDPIPE					300	42.836	44.536	1.7		CAP END OF PIPE WITH STEEL PLATE
102	JUNCTION PIT	600	900	300	42.318	375	42.243	44.036	1.792	EDCM 605	
103	JUNCTION PIT	600	900	300	42.947	300	42.897	44.32	1.423	EDCM 605	
111	JUNCTION PIT	600	900	225	43.581	300	43.505	44.637	1.131	EDCM 605	
112	JUNCTION PIT	600	900	225	43.581	225	44.002	44.832	0.83	EDCM 605	
315EP	ENDPIPE					300	42.107	43.852	1.745		CAP END OF PIPE WITH STEEL PLATE
75	GRATED ENTRY PIT	600	900			300	43.564	45.257	1.693	EDCM 601	
79	JUNCTION PIT	600	900			225	42.93	44.448	1.519	EDCM 605	
113	JUNCTION PIT	600	900			225	43.774	44.473	0.698	EDCM 605	
170	ENDPIPE			300			43.471	44.473	1.479		REMOVE STEEL PLATE AND CONNECT TO END PIPE
171	JUNCTION PIT	600	900			300	42.043	43.516	1.479	EDCM 605	
Ex.82	JUNCTION PIT	600	900	225	42.93	Ex.225	42.88	44.457	1.577		CONNECT TO EXISTING PIT - BORE EASTE SIDE WALL
82a	JUNCTION PIT	600	900			225	43.236	44.34	1.103	EDCM 605	

**AS CONSTRUCTED PLANS**

The purpose of these as-constructed plans is to update the design drawings to show significant changes which occurred during construction. Note that the levels shown on these plans are design levels, and have not been verified by survey. All information shown on these plans should be verified on site. SMEC Australia Pty Ltd accept no responsibility for loss or damages resulting from the inappropriate usage of these plans.



**AS CONSTRUCTED**


PLAN OF SUB. NO.  
PS841640V/S7  
PERMIT REF. NO.  
WYP10107\_17.02

SCALE AS SHOWN AT A1



Alamora - Stage 9  
Wyndham City Council  
Road and Drainage  
Pit Schedule

MELWAYS REF <b>234 D5</b>	PROJECT / DRAWING No. <b>2070E-A09-351</b>	SHEET No. <b>13 of 16</b>	REVISION <b>1</b>
------------------------------	---	------------------------------	----------------------

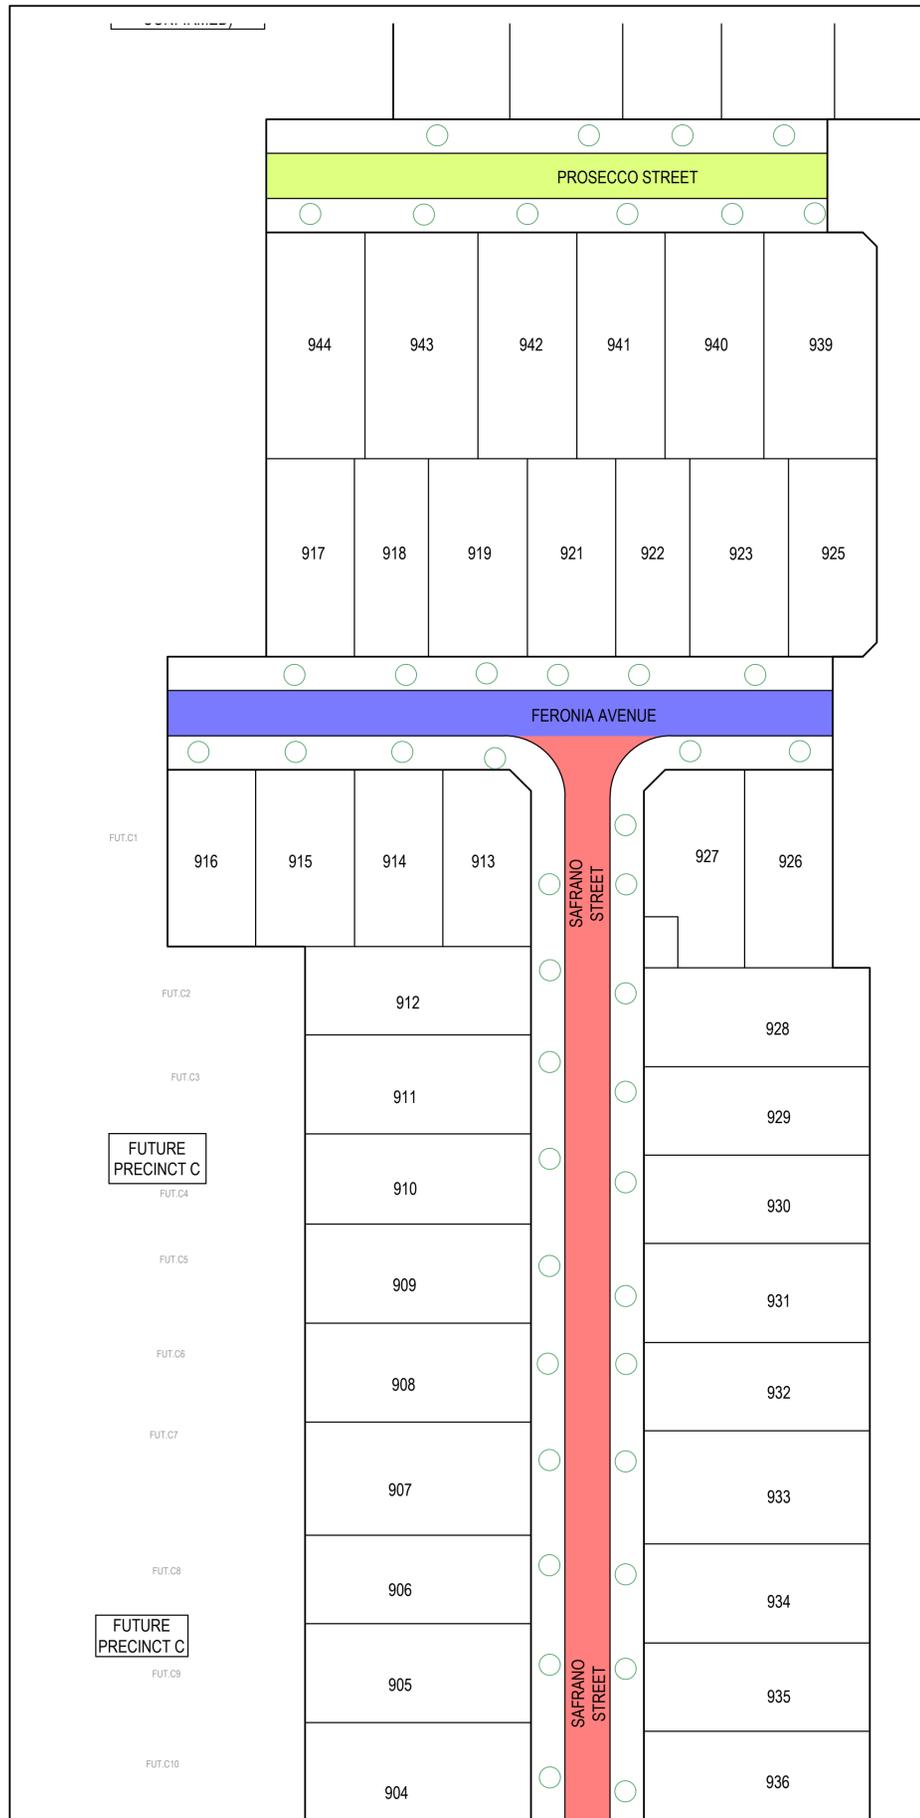

FUTURE  
PRECINCT C



ACCESS LANE- SAFRANO STREET, ARAGON ROAD PAVEMENT COMPOSITION			
520mm DEEP PAVEMENT (INCLUDING 200mm DEEP CAPPING) AND 200mm DEEP SUBGRADE			
PAVEMENT LAYER		DEPTH (mm)	MATERIAL
ASPHALT	WEARING COURSE	20	SIZE 7 TYPE L ASPHALT CLASS 320 BINDER
	INTERMEDIATE COURSE	30	SIZE 10 TYPE N ASPHALT CLASS 320 BINDER
	INTERLAYER	-	SIZE 10 SAMI SEAL S18RF
	BONDING LAYER	-	BITUMINOUS PRIME
BASE COURSE		140	SIZE 20 CLASS 2 CRUSHED ROCK, COMPACTED TO A MINIMUM DENSITY RATIO OF 96% (MODIFIED) AS1289, 5.2.1
SUBBASE COURSE		130	SIZE 20 CLASS 3 CRUSHED ROCK, COMPACTED TO A MINIMUM DENSITY RATIO OF 98% (MODIFIED) AS1289, 5.2.1
CAPPING		200	RIPPED ROCK OR STABILISED CLAY MEETING THE FOLLOWING PROPERTIES: CBR >=7%, PERMEABILITY k < 1x10 <sup>-9</sup> m/s AND SWELL < 1.5% MATERIAL, COMPACTED TO A MINIMUM DENSITY RATIO 98% (STANDARD) AS1289, 5.1.1
SUBGRADE/CONSTRUCTION LAYER		200	RIPPED ROCK OR STABILISED CLAY MEETING THE FOLLOWING PROPERTIES: CBR >=7%, PERMEABILITY k < 1x10 <sup>-9</sup> m/s AND SWELL < 1.5% MATERIAL, COMPACTED TO A MINIMUM DENSITY RATIO 98% (STANDARD) AS1289, 5.1.1

ACCESS STREET LEVEL 2 - FERONIA AVENUE PAVEMENT COMPOSITION			
730mm DEEP PAVEMENT (INCLUDING 250mm DEEP CAPPING) AND 150mm SUBGRADE			
PAVEMENT LAYER		DEPTH (mm)	MATERIAL
ASPHALT	WEARING COURSE	40	SIZE 14 TYPE N ASPHALT CLASS 320 BINDER
	INTERMEDIATE COURSE	40	SIZE 14 TYPE HP ASPHALT CLASS A10E BINDER
	SAMI SEAL	-	SIZE 10 SAMI SEAL S18RF
	BITUMINOUS PRIME	-	BITUMINOUS PRIME
BASE COURSE		110	SIZE 20 CLASS 2 CRUSHED ROCK, COMPACTED TO A MINIMUM DENSITY RATIO OF 98% (MODIFIED) AS1289, 5.2.1
SUBBASE COURSE		290	SIZE 20 CLASS 3 CRUSHED ROCK, COMPACTED TO A MINIMUM DENSITY RATIO OF 96% (MODIFIED) AS1289, 5.2.1
CAPPING		250	RIPPED ROCK (SELECT FILL) OR STABILISED CLAY MEETING THE FOLLOWING PROPERTIES: CBR >=7%, PERMEABILITY k < 1x10 <sup>-9</sup> m/s AND SWELL < 1.5% MATERIAL, COMPACTED TO A MINIMUM DENSITY RATIO 98% (STANDARD) AS1289, 5.1.1
SUBGRADE/CONSTRUCTION LAYER		150	RIPPED ROCK OR STABILISED CLAY MEETING THE FOLLOWING PROPERTIES: CBR >=7%, PERMEABILITY k < 1x10 <sup>-9</sup> m/s AND SWELL < 1.5% MATERIAL, COMPACTED TO A MINIMUM DENSITY RATIO 98% (STANDARD) AS1289, 5.1.1

ACCESS PLACE - PROSECCO STREET PAVEMENT COMPOSITION			
530mm DEEP PAVEMENT (INCLUDING 200mm DEEP CAPPING) AND 150mm SUBGRADE			
PAVEMENT LAYER		DEPTH (mm)	MATERIAL
ASPHALT	WEARING COURSE	30	SIZE 10 TYPE L ASPHALT CLASS 320 BINDER
	INTERMEDIATE COURSE	30	SIZE 10 TYPE N ASPHALT CLASS 320 BINDER
	SAMI SEAL	-	SIZE 10 SAMI SEAL S18RF
	BITUMINOUS PRIME	-	BITUMINOUS PRIME
BASE COURSE		130	SIZE 20 CLASS 2 CRUSHED ROCK, COMPACTED TO A MINIMUM DENSITY RATIO OF 98% (MODIFIED) AS1289, 5.2.1
SUBBASE COURSE		140	SIZE 20 CLASS 3 CRUSHED ROCK, COMPACTED TO A MINIMUM DENSITY RATIO OF 96% (MODIFIED) AS1289, 5.2.1
CAPPING		200	RIPPED ROCK (SELECT FILL) OR STABILISED CLAY MEETING THE FOLLOWING PROPERTIES: CBR >=7%, PERMEABILITY k < 1x10 <sup>-9</sup> m/s AND SWELL < 1.5% MATERIAL, COMPACTED TO A MINIMUM DENSITY RATIO 98% (STANDARD) AS1289, 5.1.1
SUBGRADE/CONSTRUCTION LAYER		150	RIPPED ROCK OR STABILISED CLAY MEETING THE FOLLOWING PROPERTIES: CBR >=7%, PERMEABILITY k < 1x10 <sup>-9</sup> m/s AND SWELL < 1.5% MATERIAL, COMPACTED TO A MINIMUM DENSITY RATIO 98% (STANDARD) AS1289, 5.1.1

**WARNING**  
**BWARE OF UNDERGROUND SERVICES**  
The locations of underground services are approximate only and their exact position should be proven on site.  
No guarantee is given that all existing services are shown.  
Locate all underground services before commencement of works  
**DIAL 1100 BEFORE YOU DIG**  
www.1100.com.au

**NOTE**  
ALL PAVEMENT DESIGNS HAVE BEEN PROVIDED BY TONKIN AND TAYLOR. SMEC IS NOT RESPONSIBLE FOR GEOTECHNICAL OR PAVEMENT RELATED DESIGNS AND IS NOT RESPONSIBLE FOR THE ACCURACY, ADEQUACY OR APPROPRIATENESS OF THESE DESIGNS. THE PAVEMENT COMPOSITIONS SHOWN ON THIS DRAWING HAVE BEEN REPRODUCED FROM THE PAVEMENT REPORT FOR THIS DEVELOPMENT STAGE. THIS DOCUMENT SHOULD BE REVIEWED BY THE CONTRACTOR TO ENSURE DESIGN HAS BEEN INTERPRETED CORRECTLY. A COPY OF THIS DOCUMENT WILL BE MADE AVAILABLE ON REQUEST. ANY DIFFERENCES FROM THIS REQUIREMENTS SHOWN ARE TO BE NOTIFIED TO THE SUPERINTENDENT BEFORE PROCEEDING.

**AS CONSTRUCTED PLANS**  
The purpose of these as-constructed plans is to update the design drawings to show significant changes which occurred during construction. Note that the levels shown on these plans are design levels, and have not been verified by survey. All information shown on these plans should be verified on site. SMEC Australia Pty Ltd accept no responsibility for loss or damages resulting from the inappropriate usage of these plans.

Quality Management ISO 9001  
Global-Mark.com.au®



OH&S Management AS/NZS 4801  
Global-Mark.com.au®

Environmental Management ISO 14001  
Global-Mark.com.au®

PLAN OF SUB. NO.  
PS841640V/S7

PERMIT REF. NO.  
WYP10107\_17.02

**AS CONSTRUCTED**

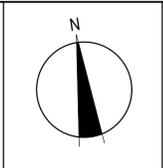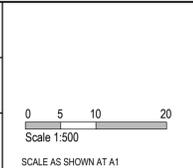


**SMEC**  
Member of the Surlana Jurong Group  
ABN 47 065 475 149  
Collins Square, Tower 4, Level 20, 727 Collins St  
Melbourne, VIC 3008  
Ph 03 9514 1500




Alamora - Stage 9  
Wyndham City Council  
Road and Drainage  
Pavement Details

MELWAYS REF: 234 D5  
PROJECT / DRAWING No: 2070E-A09-411

SHEET No: 14 of 16  
REVISION: 1

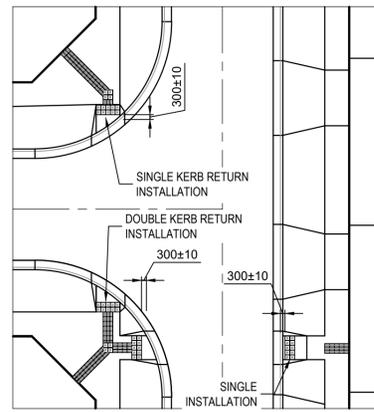


**TYPICAL TGS LAYOUT**  
N.T.S  
REFER TO NOTE 34

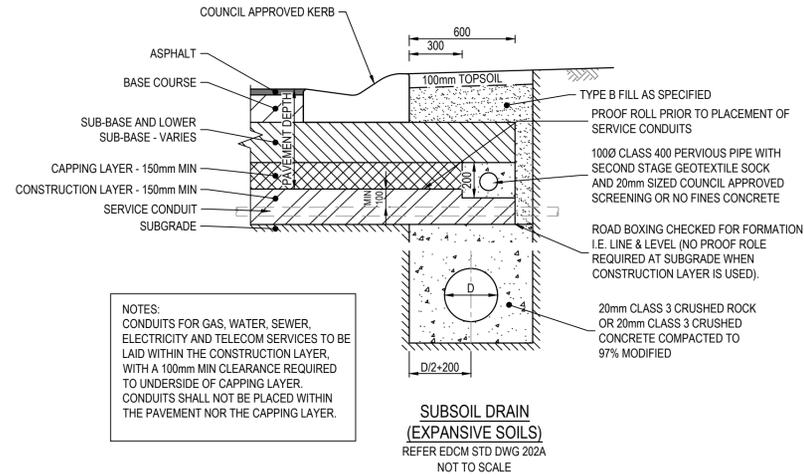


NOTES:  
CONDUITS FOR GAS, WATER, SEWER, ELECTRICITY AND TELECOM SERVICES TO BE LAID WITHIN THE CONSTRUCTION LAYER, WITH A 100mm MIN CLEARANCE REQUIRED TO UNDERSIDE OF CAPPING LAYER. CONDUITS SHALL NOT BE PLACED WITHIN THE PAVEMENT NOR THE CAPPING LAYER.


**SUBSOIL DRAIN (EXPANSIVE SOILS)**  
REFER EDM STD DWG 202A  
NOT TO SCALE

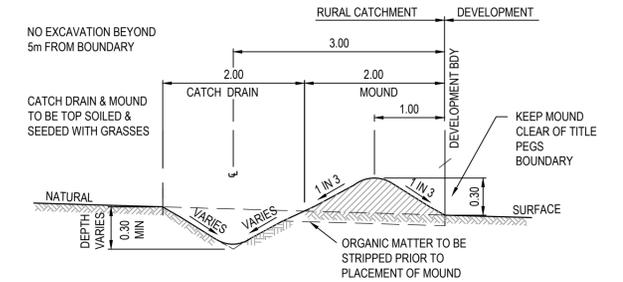


**TYPICAL SECTION THROUGH CATCH DRAIN**  
NOT TO SCALE

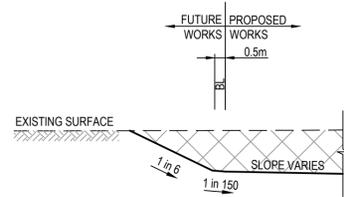


**CUT BATTER INTO FUTURE LOT**  
NOT TO SCALE

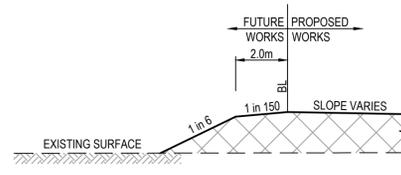


**FILL BATTER INTO FUTURE LOT**  
NOT TO SCALE

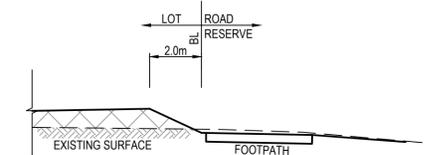


**TYPICAL RIDGE BATTER DETAIL**  
NOT TO SCALE

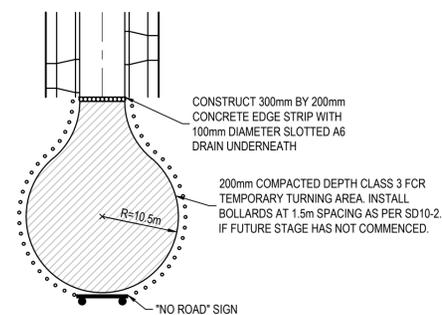

**TEMPORARY TURN AREA DETAIL**  
NOT TO SCALE

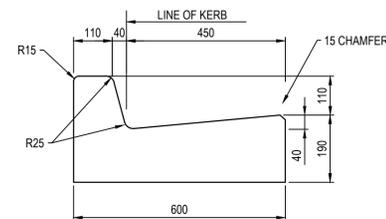

**600 B2 KERB DETAIL**  
SCALE 1:10  
EDCM

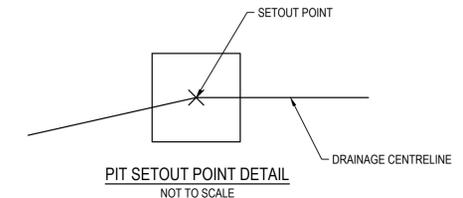

**PIT SETOUT POINT DETAIL**  
NOT TO SCALE

**WARNING**  
**BEWARE OF UNDERGROUND SERVICES**  
The locations of underground services are approximate only and their exact position should be proven on site. No guarantee is given that all existing services are shown. Locate all underground services before commencement of works. **DIAL 1100 BEFORE YOU DIG**  
www.1100.com.au

**AS CONSTRUCTED PLANS**

The purpose of these as-constructed plans is to update the design drawings to show significant changes which occurred during construction. Note that the levels shown on these plans are design levels, and have not been verified by survey. All information shown on these plans should be verified on site. SMEC Australia Pty Ltd accept no responsibility for loss or damages resulting from the inappropriate usage of these plans.



PLAN OF SUB. NO.  
PS841640V/S7  
PERMIT REF. NO.  
WYP10107\_17.02

**AS CONSTRUCTED**

SCALE AS SHOWN AT A1



Alamora - Stage 9  
Wyndham City Council  
Road and Drainage  
General Details

MELWAYS REF <b>234 D5</b>	PROJECT / DRAWING No. <b>2070E-A09-421</b>	SHEET No. <b>15 of 16</b>	REVISION <b>1</b>
------------------------------	---	------------------------------	----------------------

<b>Project Name:</b> Alamora Stage 9	<b>Design Package:</b> 2070E-A09
<b>Date:</b>	30/09/21

PHASE	DISCIPLINE CODE	RISK REGISTER - CONSTRUCTION / OPERATIONS / MAINTENANCE POTENTIAL RISK		RISK OWNER	POTENTIAL CONSEQUENCES	POTENTIAL ELIMINATION MEASURE, DESIGN INITIATIVE or CONTROL (Identify any Standard or Code of practice used)	HOW ISSUE ADDRESSED IN DESIGN AND/OR CONSTRUCTION OF THE WORKS	IS THE RISK ELIMINATED YES/NO	Score remaining residual risk		
									Residual Risk Likelihood (0-5)	Residual Risk Consequence (0-5)	Residual Risk Rating
<b>Road Furniture / Roadside features</b>											
Construction	RD	Roads	Construction close to live traffic	Contractor	Disruptions to live traffic, construction incident involving live traffic.	Provide safe temporary traffic control (TCP)	TCP provided within contract	N	5	3	15
Construction	RD	Roads	Culverts	Contractor	Potential risk from culverts under construction and height / fall hazards	Temporary barriers to be provided	Temporary barrier provided in contract	N	2	5	10
Construction	US	Utilities or Services	Utilities become a hazard within clear zones	Contractor	Vehicle conflict with utility / pit	Sequence works and protect with temp barrier or traffic control (TCP)	TCP provided within contract	N	1	5	5
Operational	RD	Roads	Sight Lines	Road Authority	Inadequate drivers response time.	Ensure design complies with relevant standard. Undertake thorough Safety Audit	Vis lines checked and discussed with approval authority as part of design approval process	N	1	4	4
Operational	LS	Lines and Signs	Signs and street lights	Road Authority	Potential for drivers / riders to strike signs and street lights	Ensure design complies with relevant standard. Undertake thorough Safety Audit	Refer to appropriate standard for sign and lighting offsets	N	1	4	4
Operational	RF	Road Furniture	Headwalls	Road Authority	Potential vehicle conflict within clear zone	Establish adequate clear zone provision	Adequate barrier provided as per appropriate standard where within clear zone. Culvert headwall selection in accordance with authority standard	N	2	4	8
Operational	RD	Roads	Culverts	Relevant Authority	Potential fall hazard during maintenance, by vehicles and pedestrians	Barriers to be provided in accordance with road standards	Barriers to be provided and safe batter slopes (>1:3)	N	2	5	10
<b>Retaining Walls</b>											
Construction	RW	Retaining Walls	Retaining Wall Alignment	Contractor	Falling from height during construction or commissioning of walls and adjacent structures eg. sewer manholes	Provide temporary and permanent fencing at top of wall.	Provide fencing (at heights) during design process	N	1	1	1
Operational	RW	Retaining Walls	Retaining Wall Alignment	Road/ Local Authority	Lack of safe access/setback from road	Establish adequate and accessible clear zone provision. Provide guardrail where required	Wall located in suitable position during design process and approved by authority	N	1	1	1
Operational	RW	Retaining Walls	Retaining Wall Height	Road/ Local Authority	Potential for falling from height	Provide temporary and permanent fencing at top of wall.	Provide fencing (at heights) during design process	N	1	5	5
Operational	RW	Retaining Walls	Retaining Wall Design	Road/ Local Authority	Potential for wall failure	Structural design in accordance with standards, geotechnical conditions, end use and good practise.	Refer to structural drawings and calculations	N	1	5	5
<b>Drainage</b>											
Operational	DR	Drainage	Grated Pits	Relevant Authority	Trip/fall hazard with large spaced grate	Provide pedestrian/bicycle friendly grates where applicable. Refer to pit schedule	Design in accordance with authority and manufacturers standards	N	3	2	6
Operational	DR	Drainage	Non Standard Large Pits	Relevant Authority	Potential for pit failure	Structural design in accordance with relevant design principles.	Refer to structural drawings and calculations	N	1	4	4
Operational	DR	Drainage	Culvert Endwalls/Headwalls	Relevant Authority	Potential for falling from height	Fencing to be provided where culverts/headwalls are at height in accordance with relevant authority standards	Allow for fencing in Design Process	N	1	4	4
Operational	DR	Drainage	Culvert Endwall/Headwall Outlets	Relevant Authority	Children playing in large pipes / watercourses and access for maintenance	Grate provided to authority standards	Design in accordance with authority and manufacturers standards	N	2	5	10
Maintenance	DR	Drainage	Access to Pits	Relevant Authority	Lack of safe access for maintenance	Provide safe working conditions for maintenance. Provide safe landing/ access arrangements as per relevant authority standards	Where possible design pit in location for easy access and outside of permanent water bodies	N	2	5	10
Maintenance	DR	Drainage	Deep Pits	Relevant Authority	Lack of safe entry for maintenance	Contractor to be certified for work in confined spaces, step irons to be provided to appropriate authority standards. Refer to pit schedule	Design in accordance with authority standards	N	1	5	5
Maintenance	DR	Drainage	Access to drains / culverts	Relevant Authority	Lack of safe access for maintenance	Provide safe working conditions for maintenance. Access as approved by authority	Design pit in location for easy access as agreed with authority	N	2	3	6
<b>Sewer</b>											
Construction	SE	Sewer	Sewer Manhole located adjacent to Retaining Wall Alignment	Contractor	Falling from height during construction or commissioning of adjacent sewer manholes	Provide temporary fencing until such time that permanent fencing is constructed	Provide fencing (at heights) during design process	N	1	1	1
Maintenance	SE	Sewer	Deep Manholes	Relevant Authority	Lack of safe entry for maintenance	Contractor to be certified for work in confined spaces, landings and step access provided as per authority standards and schedule	Design in accordance with authority standards. Refer pit schedule on drawings	N	1	5	5
Maintenance	SE	Sewer	Access to Manholes	Relevant Authority	Lack of safe access for maintenance	Provide safe working conditions for maintenance. Manholes located in compliance with authority standards	Where possible design manhole in location for easy access	N	1	5	5
Maintenance	SE	Sewer	Pump Station Access	Relevant Authority	Lack of safe access for maintenance	Provide safe working conditions for maintenance	Design pump station in location for easy access	N	2	4	8
<b>Electricity</b>											
Operational	ES	Electrical Services	Electrical Design	Relevant Authority	Location of assets within clear zones e.g.. pits/ substations	Electrical designed by sub consultant with appropriate accreditation and in accordance with authority standards	Pits designed below ground. Where above ground adequate offset from vehicle clear zones has been provided or barrier protection provided	N	2	3	6
<b>Telstra</b>											
Operational	TE	Telstra	Telstra Design	Relevant Authority	Location of assets within clear zones e.g.. pits	Telecommunications designed by authority consultant with appropriate accreditation and in accordance with authority standards	Pits designed below ground. Where above ground adequate offset from vehicle clear zones has been provided or barrier protection provided	N	2	3	6
<b>Water</b>											
Operational	WA	Water	Water Design	Relevant Authority	Location of assets within clear zones e.g.. pits/ substations	Water pits designed in accordance with authority standards	Pits designed below ground. Where above ground adequate offset from vehicle clear zones has been provided or barrier protection provided	N	2	3	6
<b>Gas</b>											
Operational	GA	Gas	Gas Design	Relevant Authority	Location of assets within clear zones e.g.. pits/ substations	Water pits designed in accordance with authority standards	Pits designed below ground. Where above ground adequate offset from vehicle clear zones has been provided or barrier protection provided	N	1	1	1

### AS CONSTRUCTED PLANS

The purpose of these as-constructed plans is to update the design drawings to show significant changes which occurred during construction. Note that the levels shown on these plans are design levels, and have not been verified by survey. All information shown on these plans should be verified on site. SMEC Australia Pty Ltd accept no responsibility for loss or damages resulting from the inappropriate usage of these plans.



PLAN OF SUB. NO.  
PS841640V/S7  
PERMIT REF. NO.  
WYP10107\_17.02

**AS CONSTRUCTED**

SCALE AS SHOWN AT A1



**ALAMORA**  
Tarnait

Alamora - Stage 9  
Wyndham City Council  
Road and Drainage  
Safety In Design

MELWAYS REF <b>234 D5</b>	PROJECT / DRAWING No. <b>2070E-A09-500</b>	SHEET No. <b>16 of 16</b>	REVISION <b>1</b>
------------------------------	---	------------------------------	----------------------