


file name: 305949CR900.dwg, layout name: CR900, created by: Theash Nguyen, file location: \\spire.com.au\media\00a\00a30\305949\00a\00a40, plot date: 17/04/2023 11:29 AM, Sheet: 17 of 18, Sheets

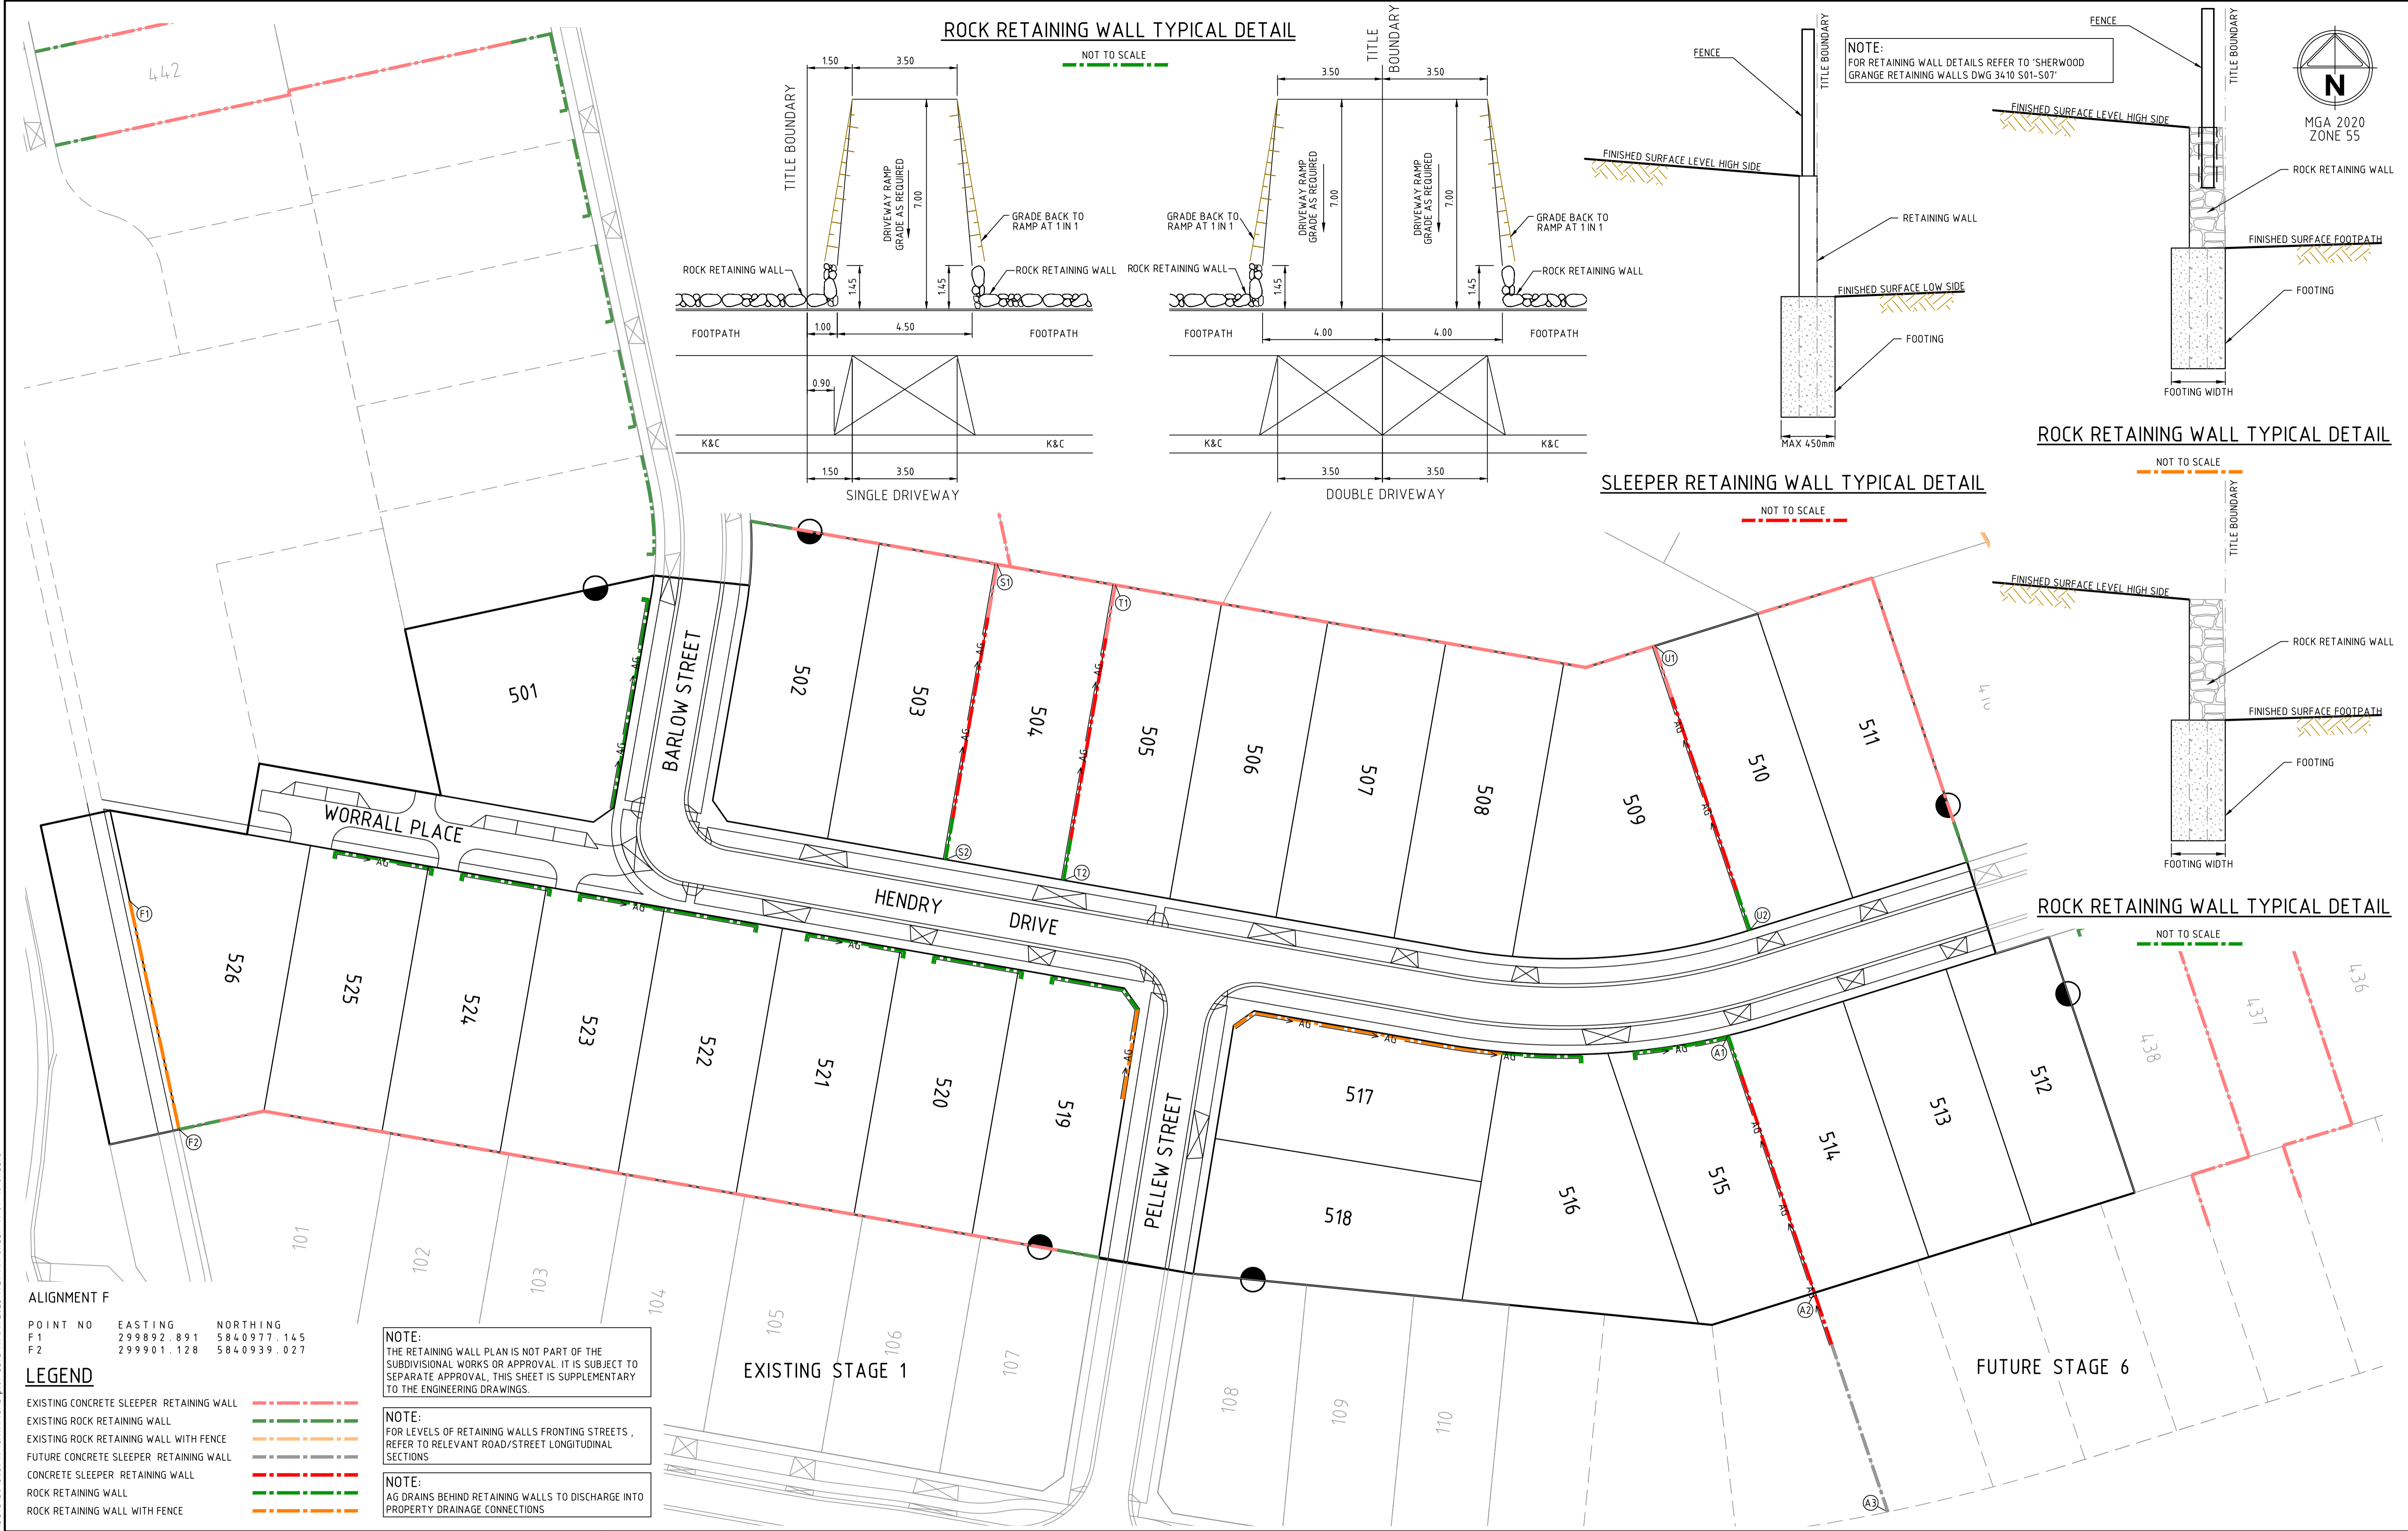

ALIGNMENT F

POINT NO	EASTING	NORTHING
F1	299892.891	5840977.145
F2	299901.128	5840939.027

LEGEND


EXISTING CONCRETE SLEEPER RETAINING WALL	---
EXISTING ROCK RETAINING WALL	---
EXISTING ROCK RETAINING WALL WITH FENCE	---
FUTURE CONCRETE SLEEPER RETAINING WALL	---
CONCRETE SLEEPER RETAINING WALL	---
ROCK RETAINING WALL	---
ROCK RETAINING WALL WITH FENCE	---

NOTE:
THE RETAINING WALL PLAN IS NOT PART OF THE SUBDIVISIONAL WORKS OR APPROVAL. IT IS SUBJECT TO SEPARATE APPROVAL. THIS SHEET IS SUPPLEMENTARY TO THE ENGINEERING DRAWINGS.

NOTE:
FOR LEVELS OF RETAINING WALLS FRONTING STREETS, REFER TO RELEVANT ROAD/STREET LONGITUDINAL SECTIONS

NOTE:
AG DRAINS BEHIND RETAINING WALLS TO DISCHARGE INTO PROPERTY DRAINAGE CONNECTIONS

2	AS CONSTRUCTED	M.T-S	17/04/23
1	LOT 526 RETAINING WALL TYPE AMENDED	M.T-S	23/12/22
0	ISSUED FOR CONSTRUCTION	M.R	09/08/22
B	RETAINING WALL TYPES AMENDED	M.R	11/07/22
A	ISSUED TO COUNCIL	M.T-S	15/11/21
Rev	Amendments	Approved	Date

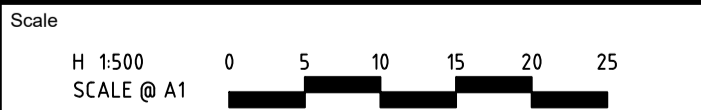

ISO 9001
ISO 45001
ISO 14001

System Certified

© Spiire Australia Pty Ltd All Rights Reserved
This document is produced by Spiire Australia Pty Ltd solely for the benefit of and use by the client in accordance with the terms of the retainer. Spiire Australia Pty Ltd does not and shall not assume any responsibility or liability whatsoever to any third party arising out of any use or reliance by third party on the content of this document.

spiire

L6 414 LA TROBE STREET PO BOX 16084 MELBOURNE
VICTORIA 8007 AUSTRALIA T 61 3 9993 7888
spiire.com.au ABN 55 050 029 635

Sherwood Grange


Designed L. TRAN	Checked J. KOEHLER
Authorised M. TOOMER-SMITH	Date 20/09/21

**SHERWOOD GRANGE
STAGE 5
ROAD AND DRAINAGE
RETAINING WALL - SHEET 1**
HUME CITY COUNCIL
RACECOURSE ROAD HOLDINGS PTY LTD


AS CONSTRUCTED 305949CR900

Rev 2


file name: 305949CR900.dwg, layout name: CR901, plotted by: Thinh Nguyen, file location: \\spira\media\data\305949, plot date: 17/04/2023 11:29 AM, Sheet: 18 of 18 Sheets

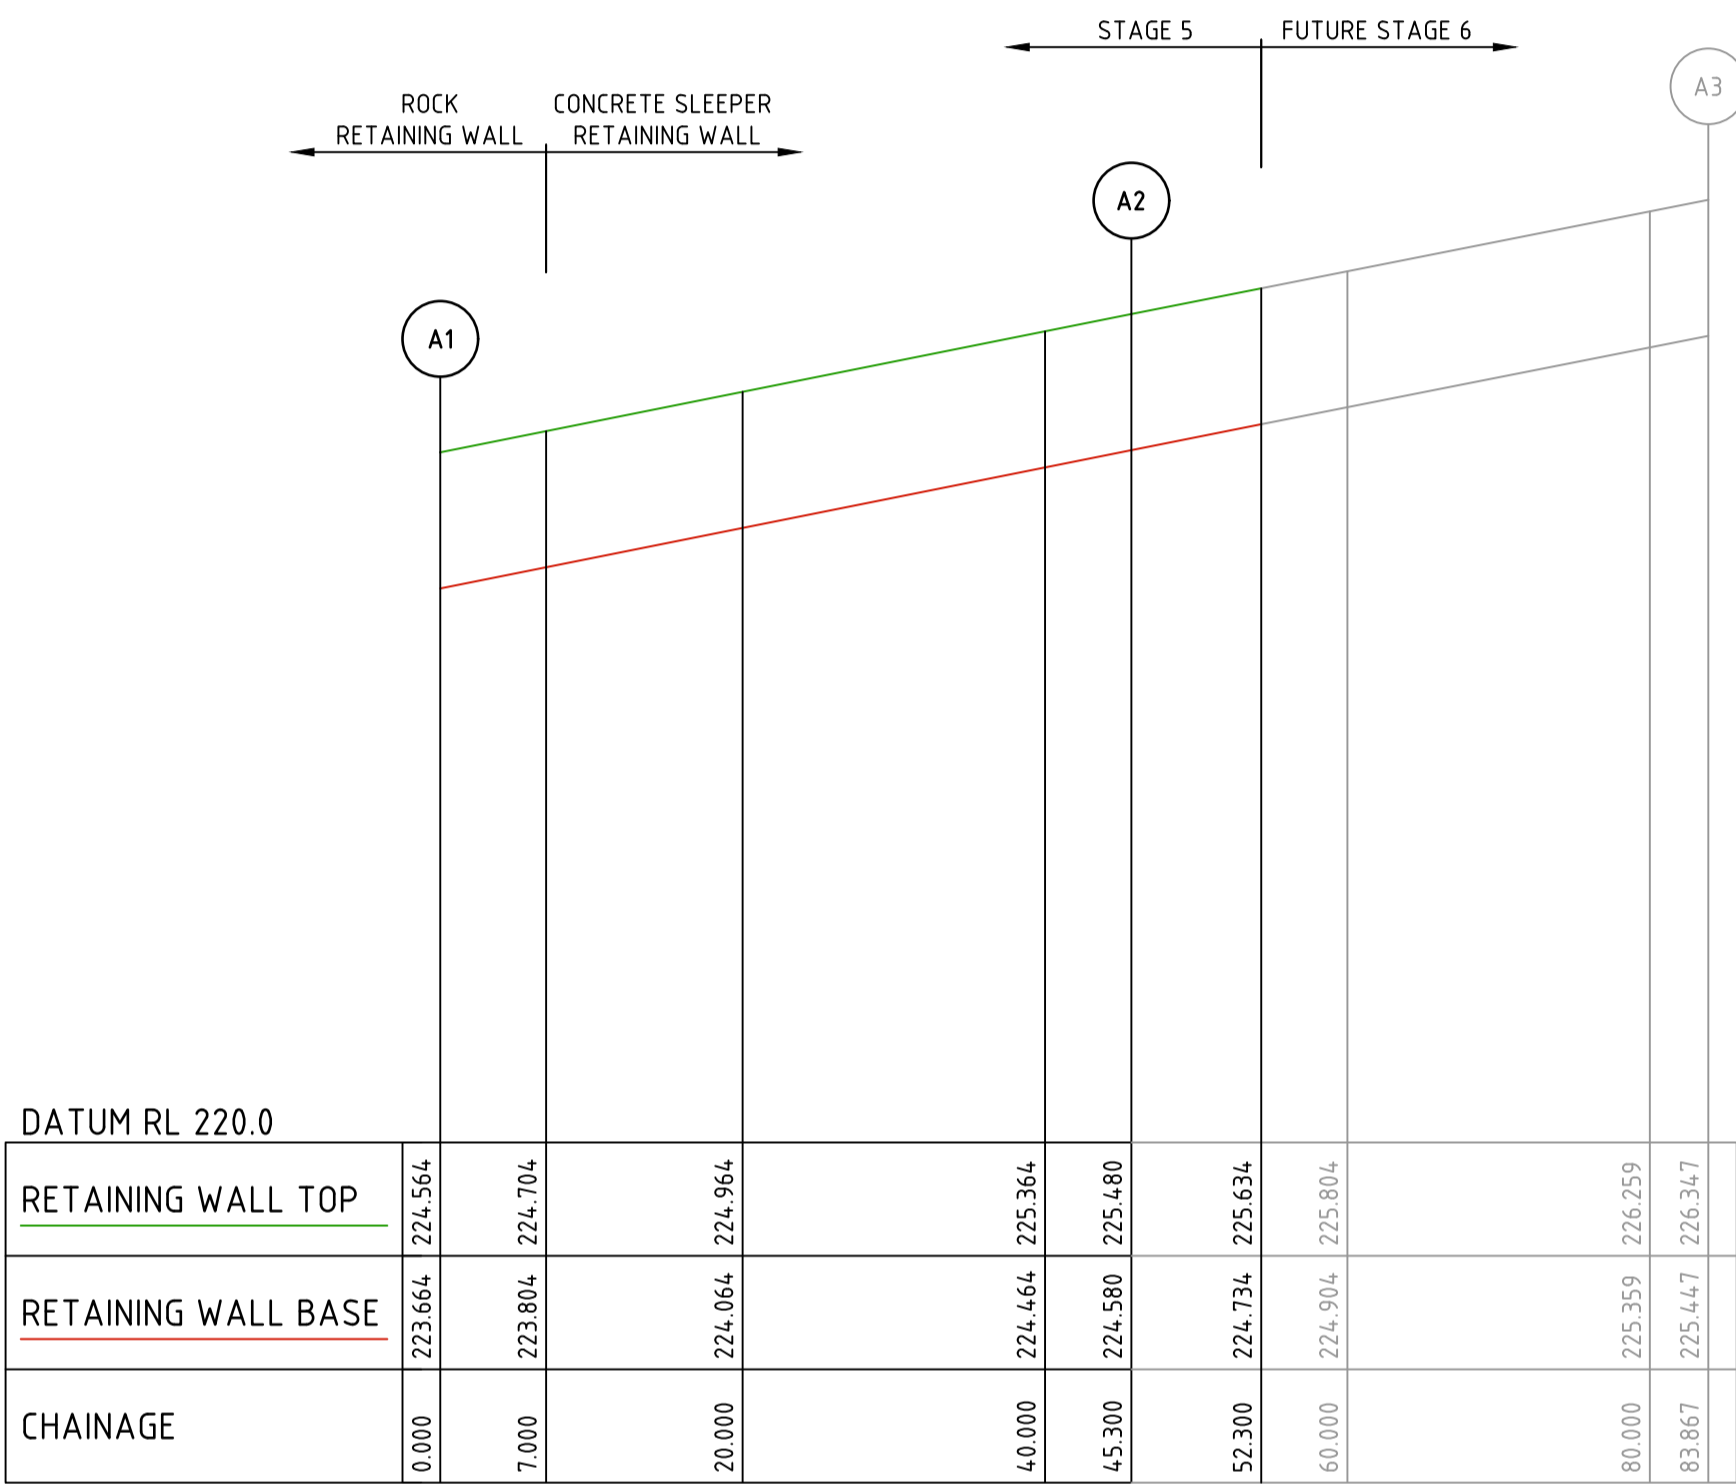


RETAINING WALL A

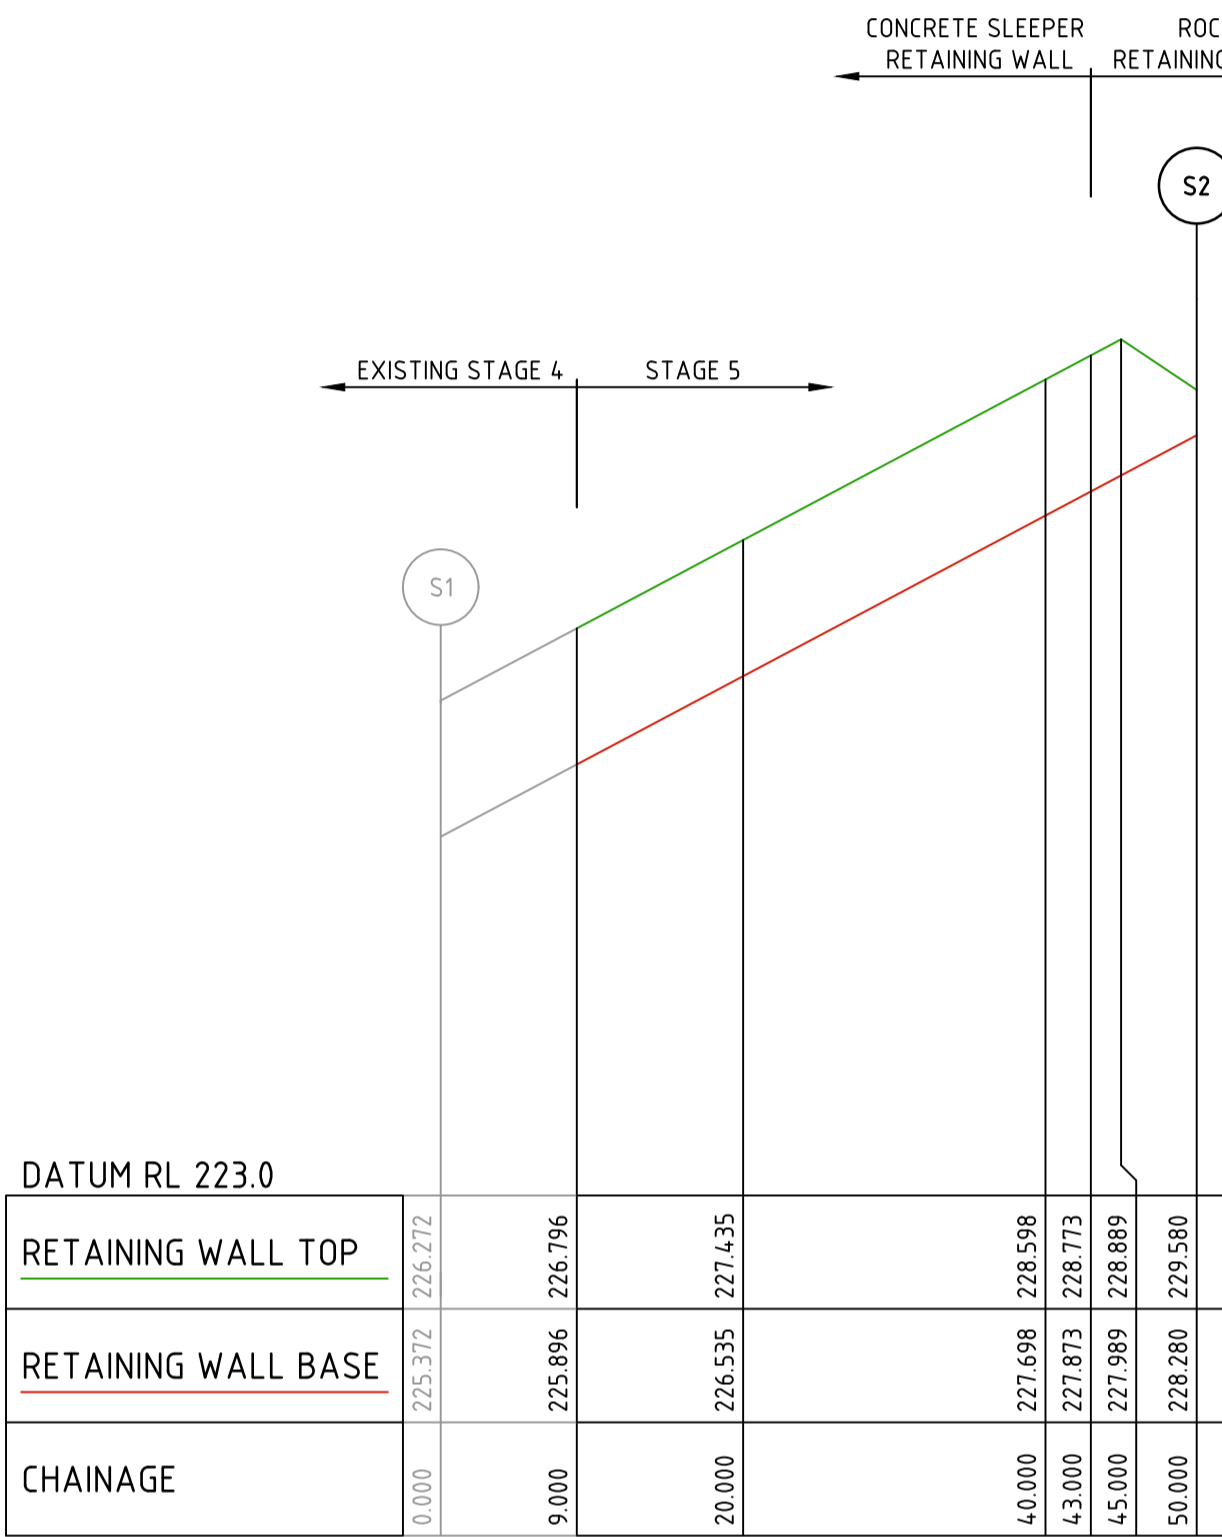

RETAINING WALL S

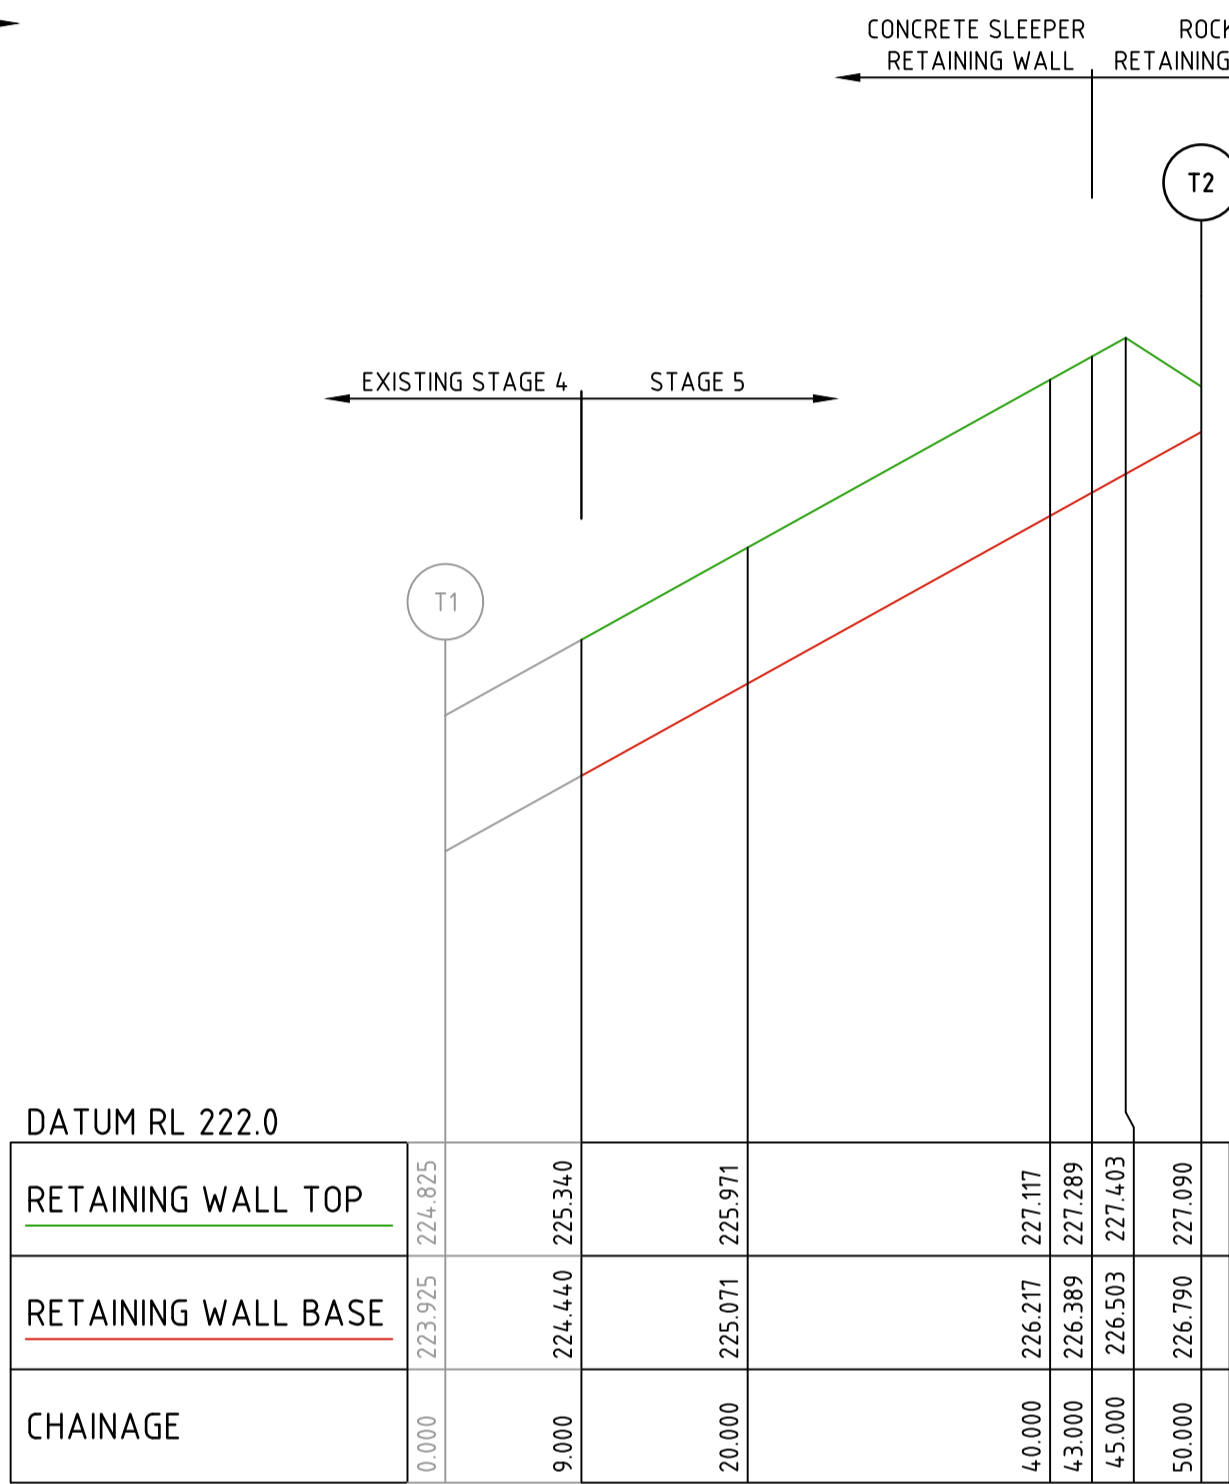


RETAINING WALL T

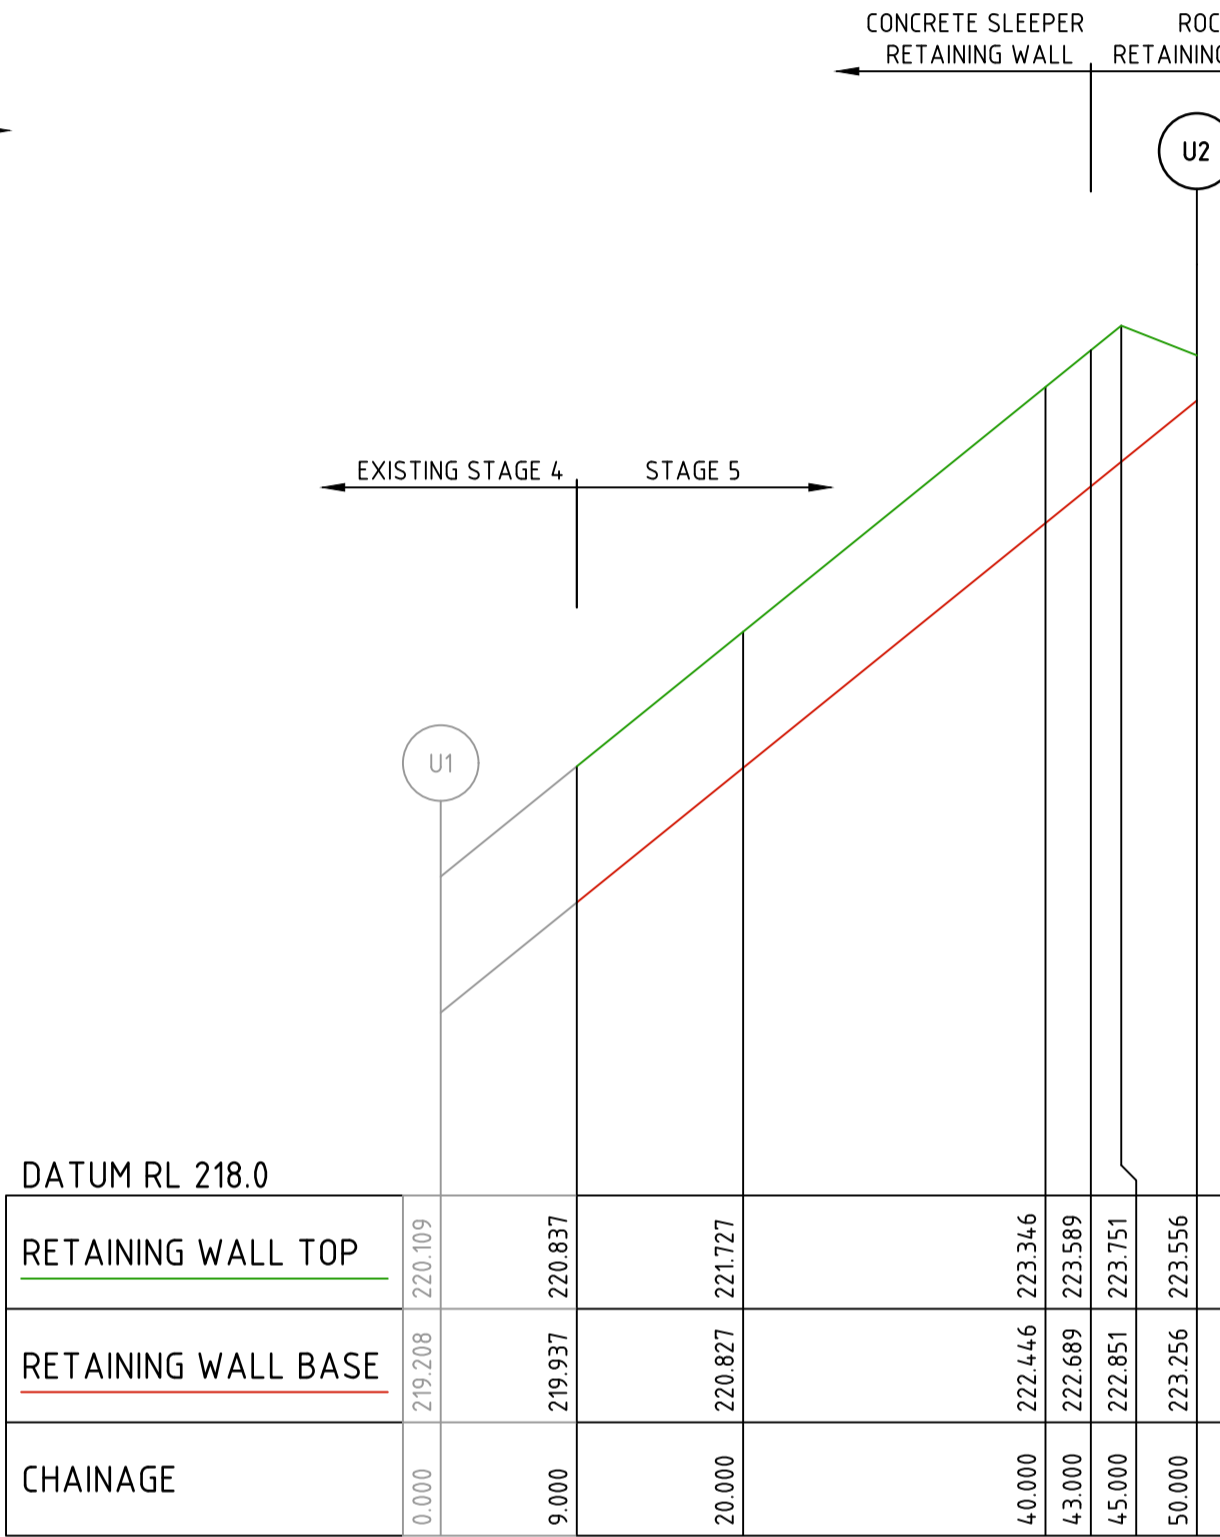

RETAINING WALL U

1	AS CONSTRUCTED	M.T-S	17/04/23
0	ISSUED FOR CONSTRUCTION	M.R	09/08/22
B	RETAINING WALLS REMOVED	M.R	11/07/22
A	ISSUED TO COUNCIL	M.T-S	15/11/21
Rev	Amendments	Approved	Date

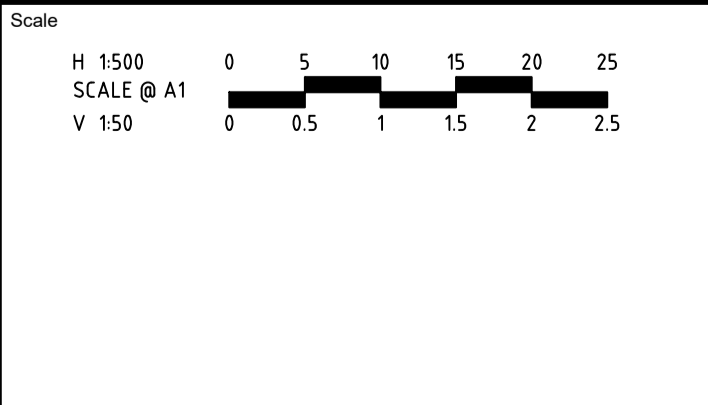

Designed L. TRAN	Checked J. KOEHLER
Authorised M. TOOMER-SMITH	Date 20/09/21

SHERWOOD GRANGE
STAGE 5
ROAD AND DRAINAGE
RETAINING WALL - SHEET 2
HUME CITY COUNCIL
RACECOURSE ROAD HOLDINGS PTY LTD

AS CONSTRUCTED

Drg No
305949CR901

Rev
1