

PM 56
E 299900.590
N 5840882.580
241.61

TBM STAR PICKET
E 300133.935
N 5840928.860
RL 226.605

PM
E 299837.190
N 5840876.715
RL 241.010

- NOTES:**
- REFER TO MRWA BACKFILL SPECIFICATION 04-03.2 FOR BACKFILLING & EMBEDMENT DETAILS FOR SEWERS CONSTRUCTED UNDER ROADS & FOOTPATHS.
 - EXPANSION JOINTS REQUIRED FOR DRAINAGE PITS LOCATED AT THE EDGE OF FOOTPATHS. REFER TO DETAIL ON CR604.


LEGEND

DESCRIPTION	PROPOSED
PASSIVE IRRIGATION TREE PIT TYPE 1 (1.5m PIT & 2.0m TRENCH)	

SEE CR702 & 703 FOR PASSIVE TREE IRRIGATION STANDARD DRAWINGS CIVIL CONTRACTOR TO EXTEND INLET PIPE BEYOND SHARED PATH

WARNING
BEWARE OF UNDERGROUND/OVERHEAD SERVICES
THE LOCATION OF SERVICES ARE APPROXIMATE ONLY AND THEIR EXACT POSITION SHOULD BE PROVEN ON SITE. NO GUARANTEE IS GIVEN THAT ALL EXISTING SERVICES ARE SHOWN. SPECIAL CONSIDERATION SHOULD BE GIVEN TO CONSTRUCTION PROCEDURES UNDER OVERHEAD ELECTRICITY TRANSMISSION LINES.

Rev	Description	Approved	Date
3	AS CONSTRUCTED	M.T-S	15/02/22
1	LOT 111 DRIVEWAY AMENDED	M.T-S	09/11/21
0	ISSUED FOR CONSTRUCTION	M.T-S	27/10/21
H	TURNING LANES ADDED	M.T-S	15/09/21
G	LOT LAYOUT AMENDMENTS AND ROUNDABOUT REMOVAL	M.T-S	21/05/21
F	PIT 36 & 37 ADDED, PIT 34 & 35 AMENDED, RESERVE ADDED	M.T-S	10/05/21
E	RAISED PAVEMENT, DRAINAGE AND HEAVY DUTY CROSS OVER AMENDED	M.T-S	01/04/21
D	LOT DIM, SHARED PATH, DRIVEWAY & DRAINAGE AMENDED WHERE CLOUDED	M.T-S	05/03/21
Rev	Amendments	Approved	Date

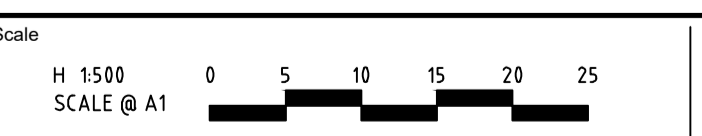

© Spiire Australia Pty Ltd All Rights Reserved
This document is produced by Spiire Australia Pty Ltd solely for the benefit of and use by the client in accordance with the terms of the retainer. Spiire Australia Pty Ltd does not and shall not assume any responsibility or liability whatsoever to any third party arising out of any use or reliance by third party on the content of this document.

414 LA TROBE STREET PO BOX 16084 MELBOURNE
VICTORIA 8007 AUSTRALIA T 61 3 9993 7888
spiire.com.au ABN 55 050 029 635

Sherwood Grange

Designed
A. SCOTT/L. TRAN

Checked
J. KOEHLER

Authorised
M. HOLMES

Date
28-10-20

**SHERWOOD GRANGE
STAGE 1
ROAD AND DRAINAGE
FACE PLAN
HUME CITY COUNCIL
RACECOURSE ROAD HOLDING PTY LTD**

AS CONSTRUCTED Drg No **305950CR201** Rev **3**

file name: 305950CR201.dwg; layout: 305950CR201_FACE PLAN; plotted by: Lillian Tran; plot date: 15/10/2022 09:33; sheet: 3 of 27 sheets