


file name: 305950CR900.dwg layout: title sheet 1 plotted by: Lillian Tran
file location: G:\305950\305950.dwg\A1.dwg plot date: 15/02/2022 8:36 AM Sheet 26 of 27 Sheets



LEGEND


CONCRETE SLEEPER RETAINING WALL
ROCK RETAINING WALL

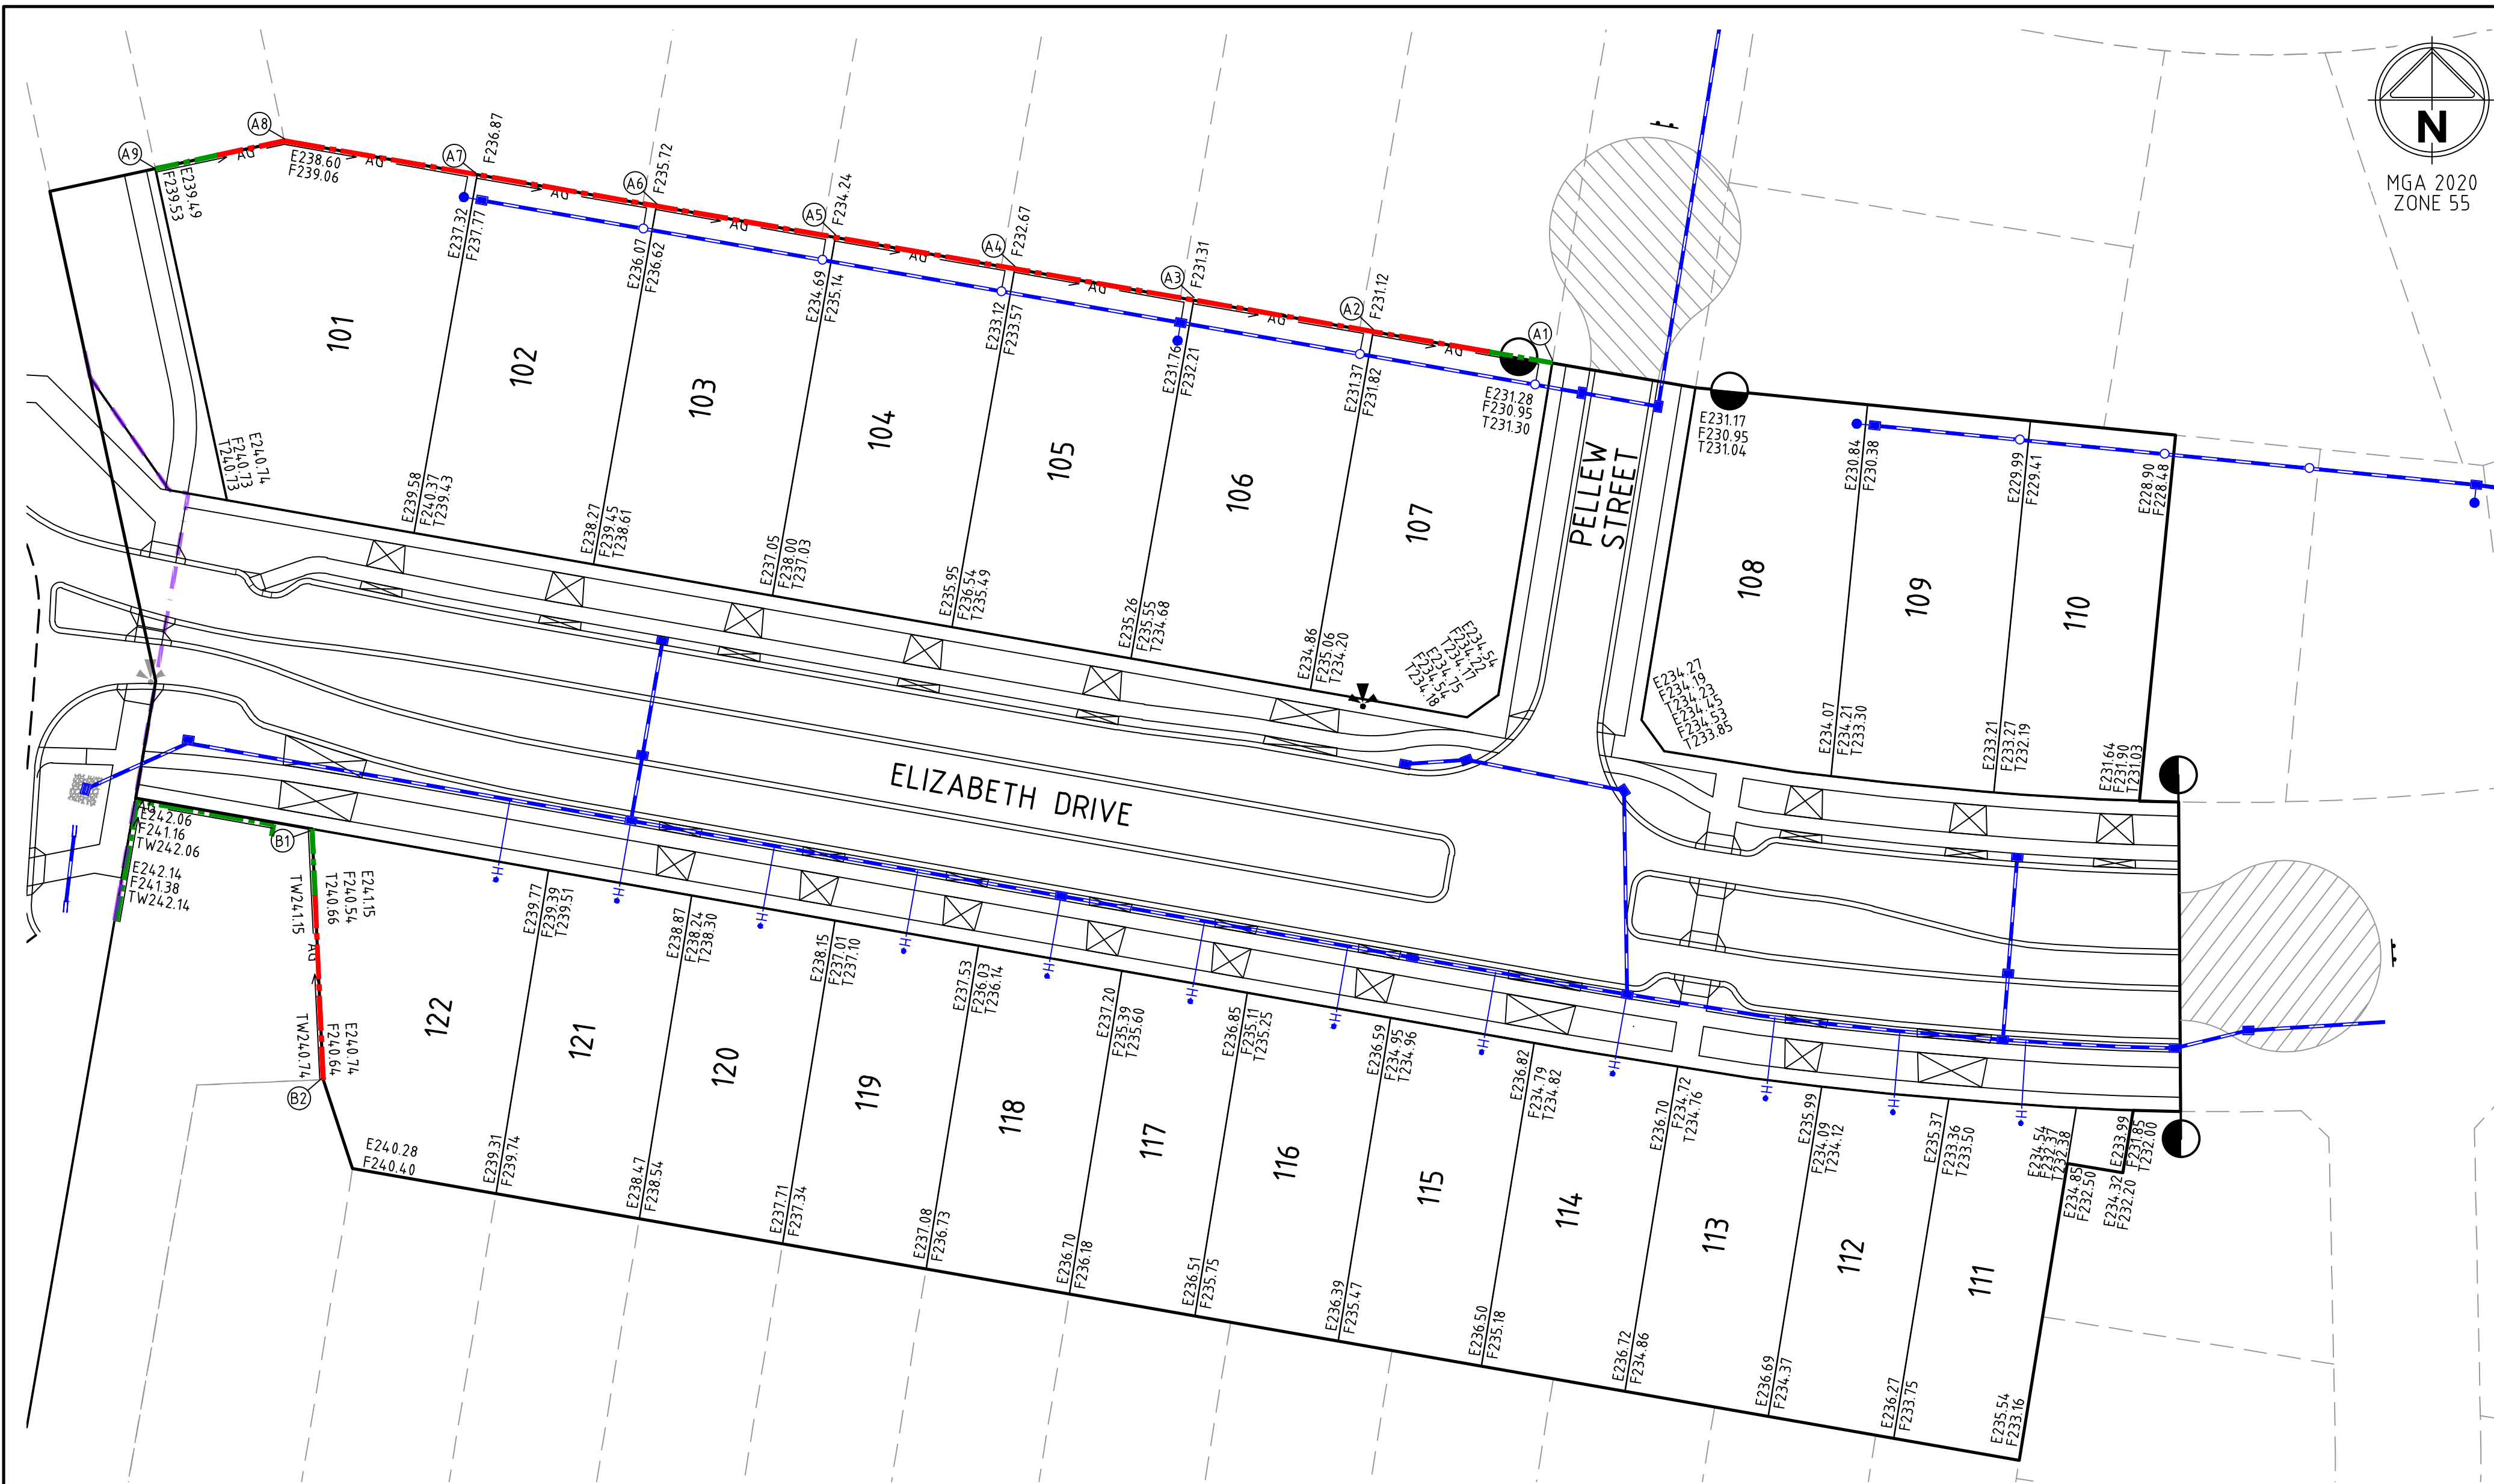

NOTE:
FOR LEVELS OF RETAINING WALLS FRONTING STREETS,
REFER TO RELEVANT ROAD/STREET LONGITUDINAL
SECTIONS


NOTE:
AG DRAINS BEHIND RETAINING WALLS TO DISCHARGE INTO
PROPERTY DRAINAGE CONNECTIONS

NOTE:
THE RETAINING WALL PLAN IS NOT PART OF THE
SUBDIVISIONAL WORKS OR APPROVAL. IT IS SUBJECT TO
SEPARATE APPROVAL. THIS SHEET IS SUPPLEMENTARY
TO THE ENGINEERING DRAWINGS.

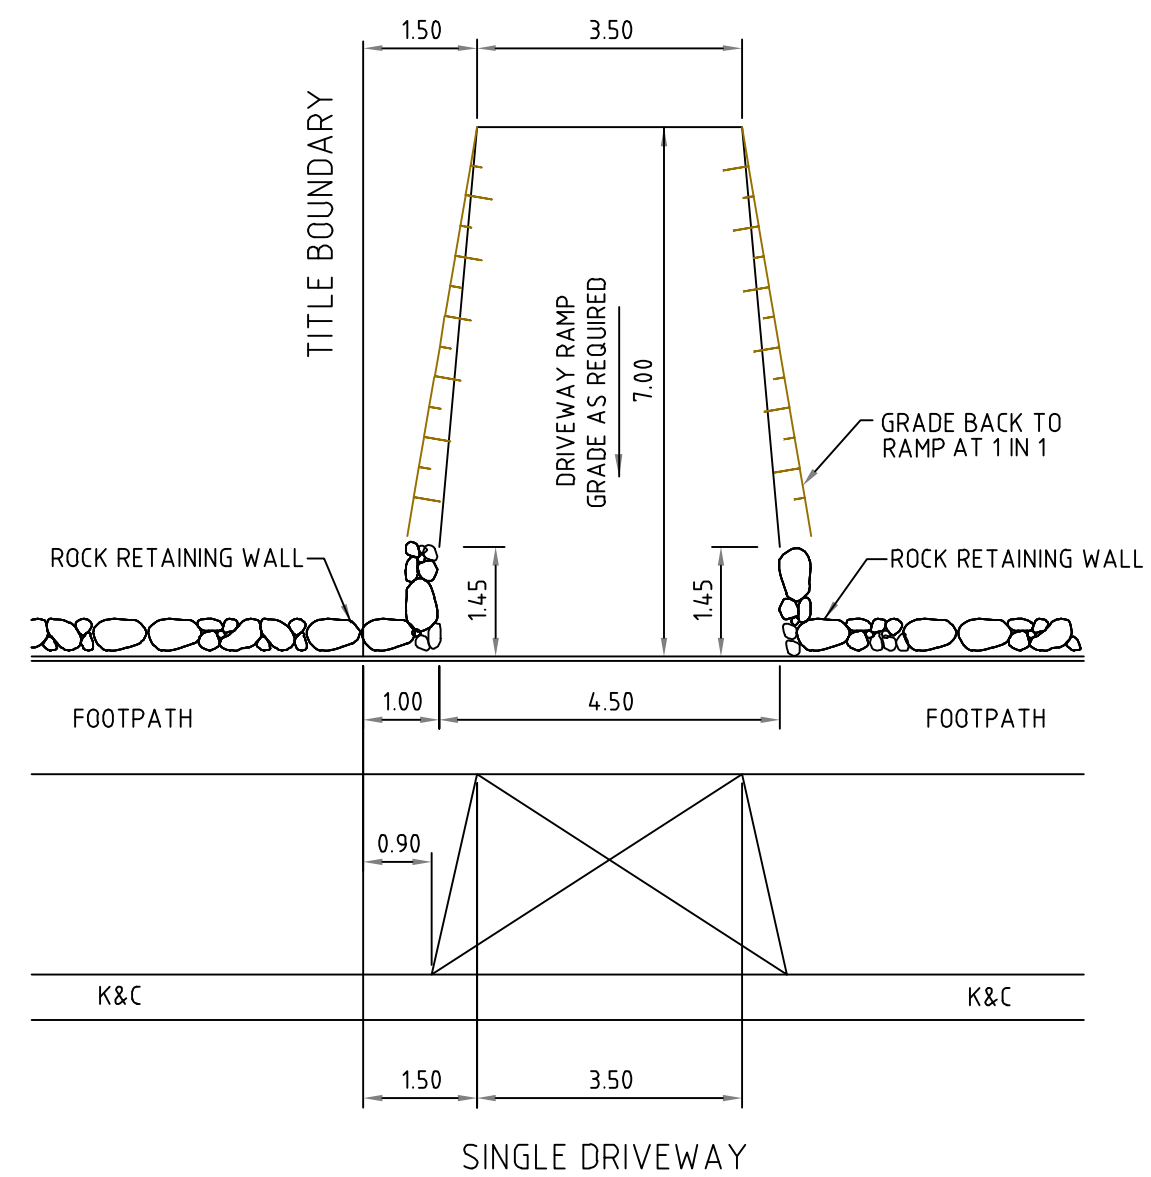


ROCK RETAINING WALL TYPICAL DETAIL

NOT TO SCALE

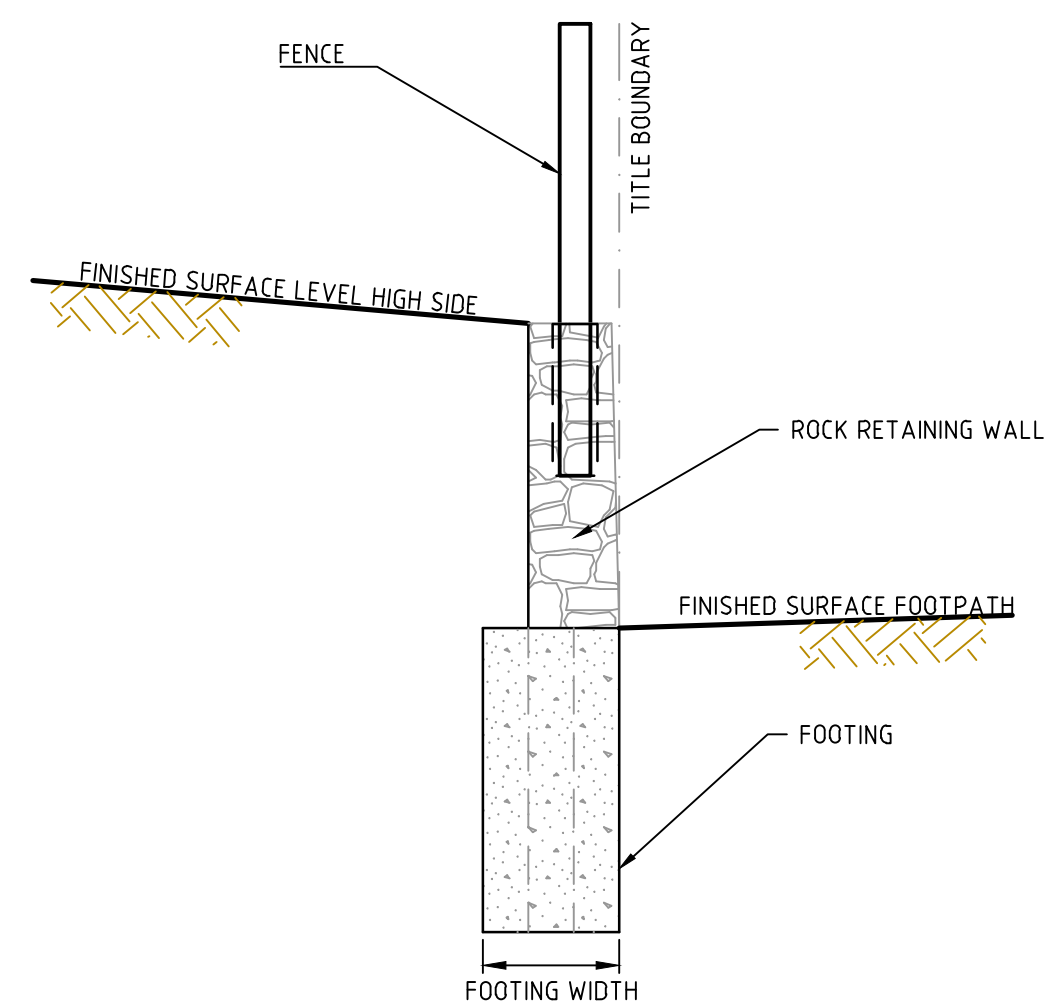

ROCK RETAINING WALL TYPICAL DETAIL


NOT TO SCALE

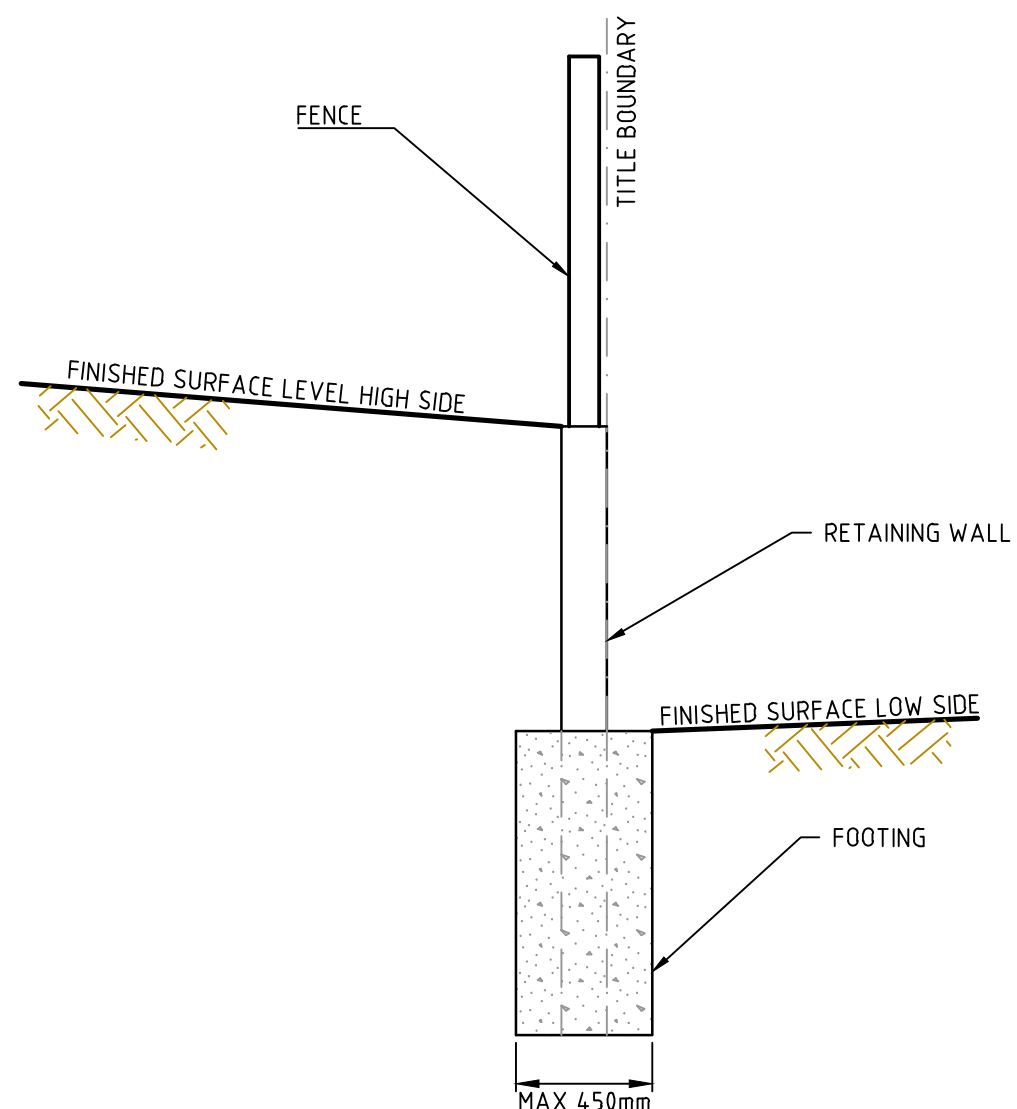

SLEEPER RETAINING WALL TYPICAL DETAIL

NOT TO SCALE

Rev	Amendments	Approved	Date
1	AS CONSTRUCTED	M.T-S	15/02/22
0	ISSUED FOR CONSTRUCTION	M.T-S	27/10/21
E	TURNING LANES ADDED	M.T-S	16/09/21
D	RETAINING WALL A AMENDED	M.T-S	21/05/21
C	SLEEPER RETAINING WALL AMENDED	M.T-S	05/03/21
B	ISSUED TO COUNCIL	M.H	28/10/20
A	ISSUED FOR TENDER	M.H	25/09/20

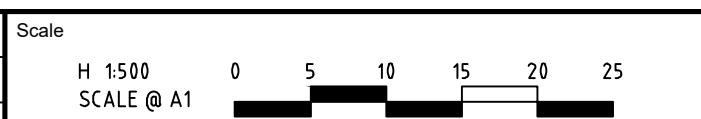

© Spiire Australia Pty Ltd All Rights Reserved
This document is produced by Spiire Australia Pty Ltd solely for the benefit of and use by the client in accordance with the terms of the retainer. Spiire Australia Pty Ltd does not and shall not assume any responsibility or liability whatsoever to any third party arising out of any use or reliance by third party on the content of this document.

spiire

414 LA TROBE STREET PO BOX 16084 MELBOURNE
VICTORIA 8007 AUSTRALIA T 61 3 9993 7888
spiire.com.au ABN 55 050 029 635

Sherwood Grange


Designed
A. SCOTT/L.TRAN
Authorised
M. HOLMES

Checked
J. KOEHLER
Date
28-10-20


**SHERWOOD GRANGE
STAGE 1
ROAD AND DRAINAGE
RETAINING WALL - SHEET 1**
HUME CITY COUNCIL
RACECOURSE ROAD HOLDING PTY LTD

AS CONSTRUCTED Drg No **305950CR900** Rev **1**

NOTE:
THE RETAINING WALL PLAN IS NOT PART OF THE
SUBDIVISIONAL WORKS OR APPROVAL. IT IS SUBJECT TO
SEPARATE APPROVAL, THIS SHEET IS SUPPLEMENTARY
TO THE ENGINEERING DRAWINGS.

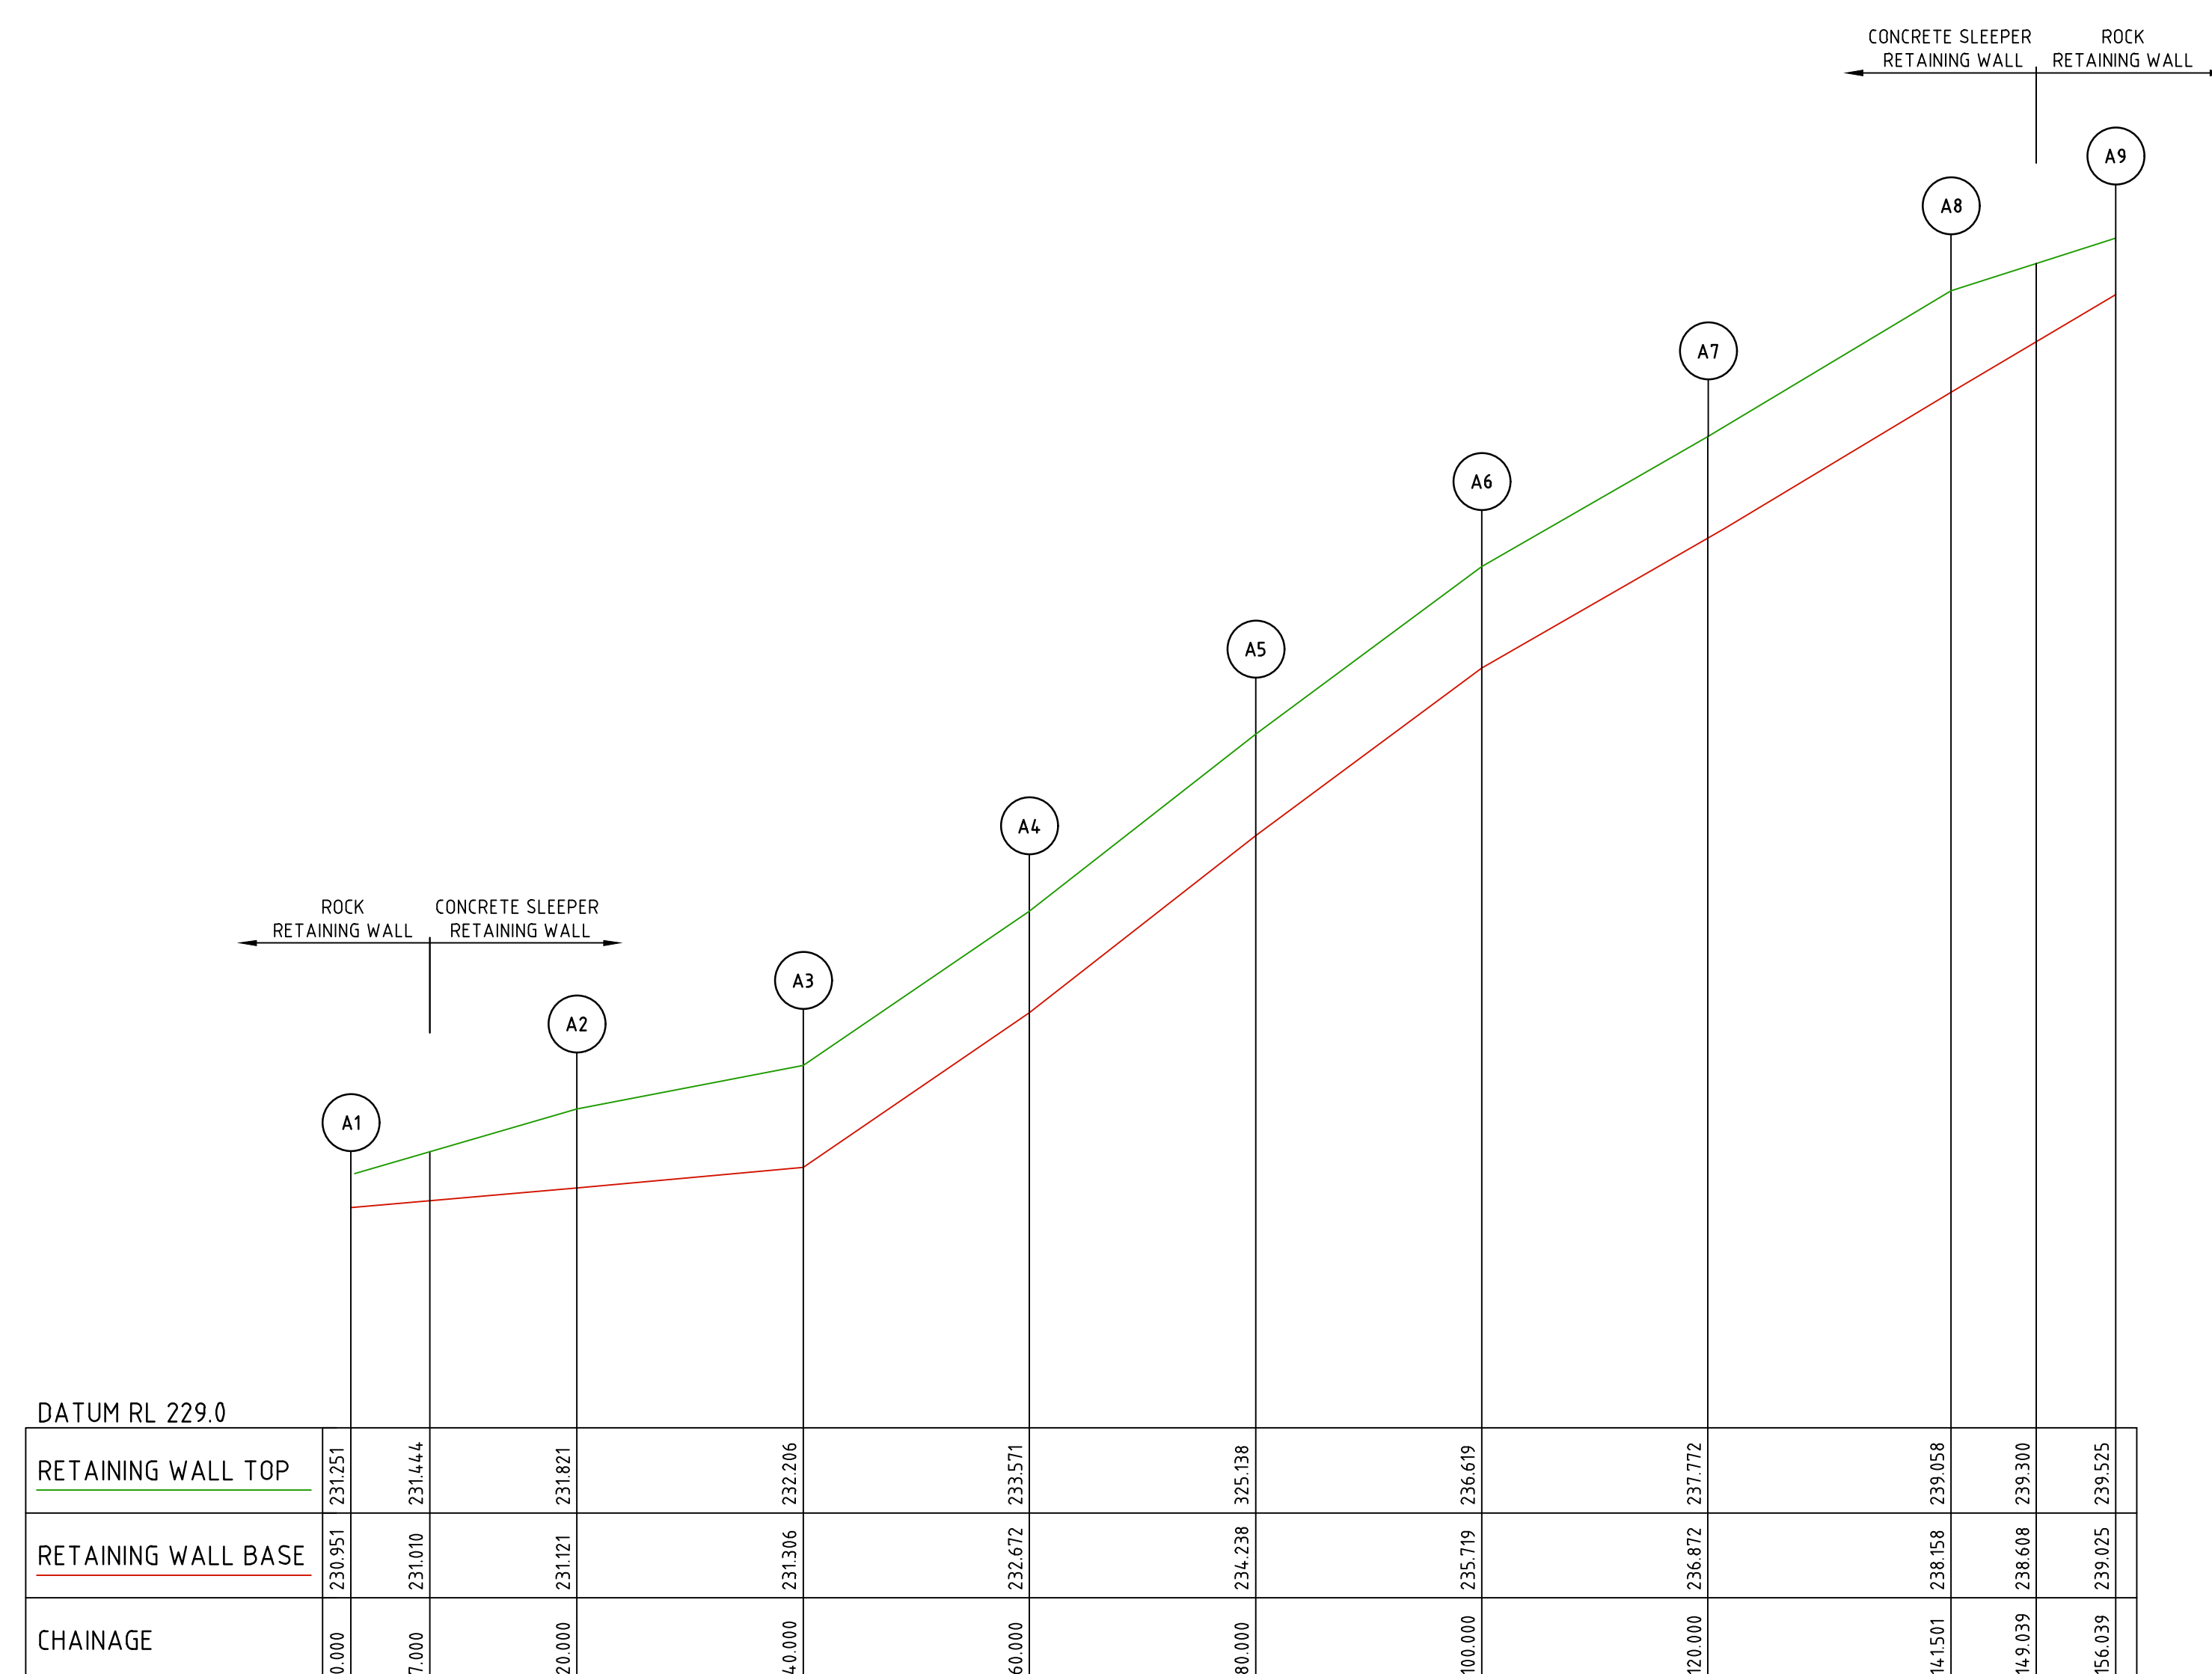


RETAINING WALL A

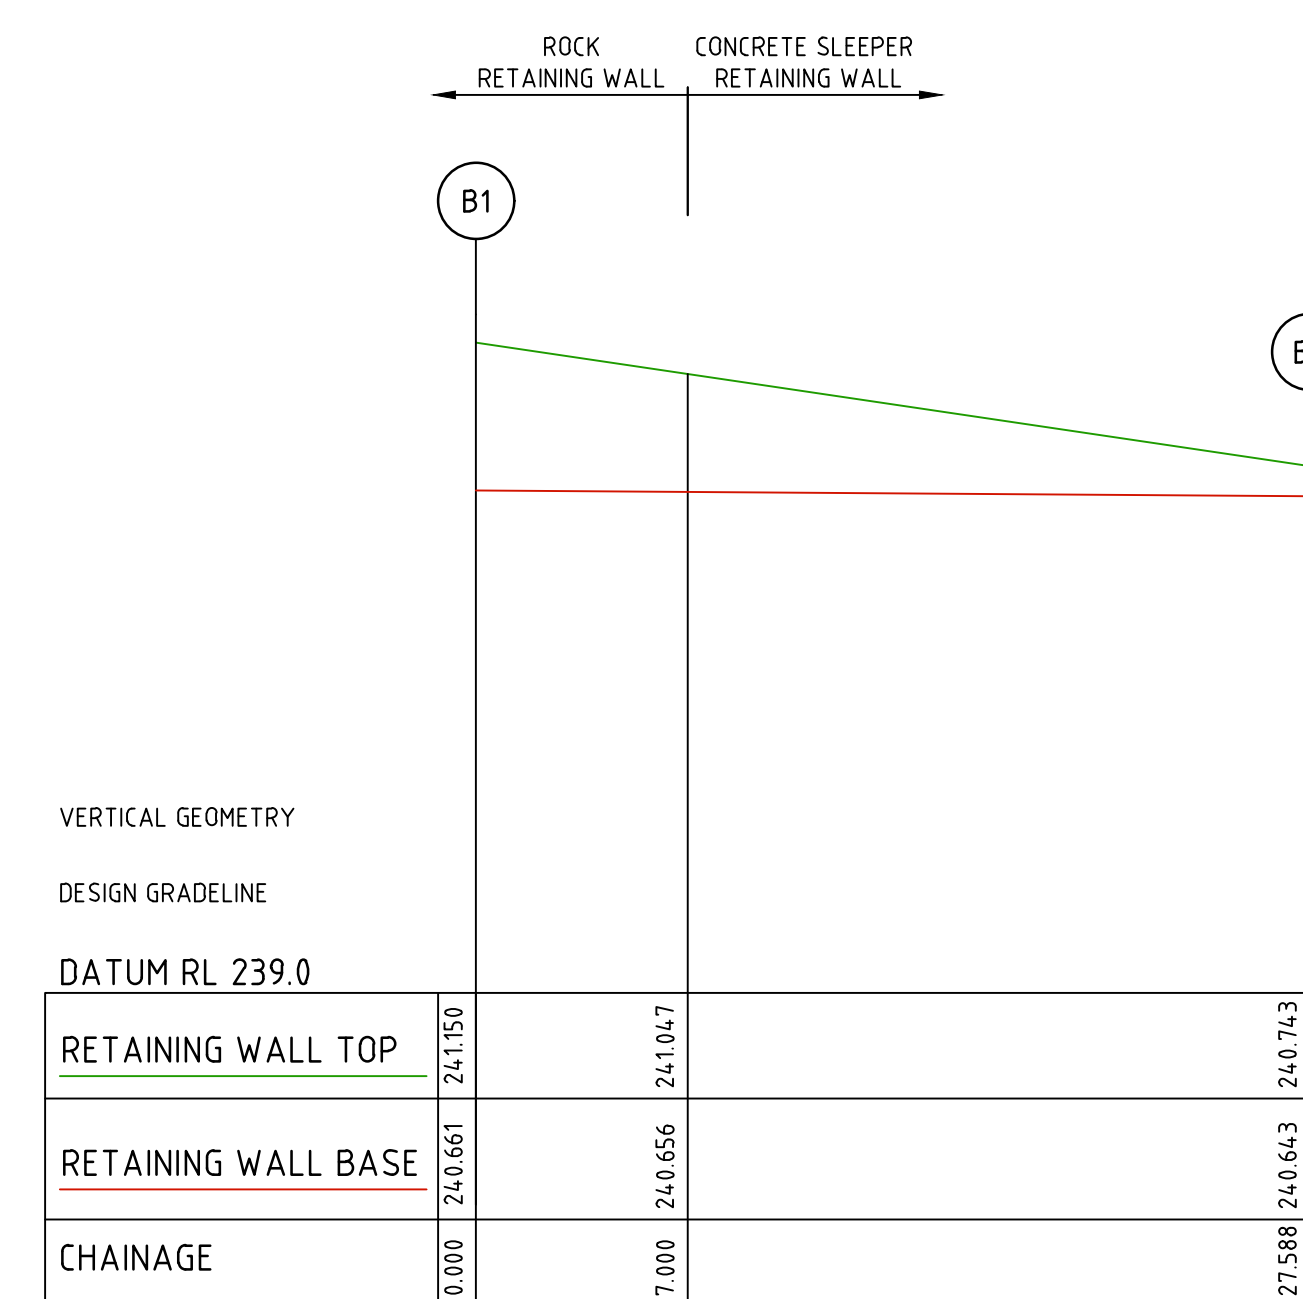

RETAINING WALL B

file location: G:\30-305950 (Civil)\ACAC				
	1	AS CONSTRUCTED	M.T-S	15/02/22
	0	ISSUED FOR CONSTRUCTION	M.T-S	27/10/21
	B	RETAINING WALL A AMENDED	M.T-S	21/05/21
A	ISSUED TO COUNCIL	M.T-S	05/03/21	
Rev	Amendments	Approved	Date	

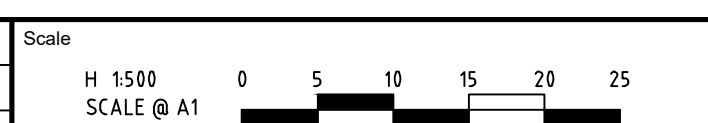

© Spiire Australia Pty Ltd All Rights Reserved
This document is produced by Spiire Australia Pty Ltd solely for the benefit of and use by the client in accordance with the terms of the retainer. Spiire Australia Pty Ltd does not and shall not assume any responsibility or liability whatsoever to any third party arising out of any use or reliance by third party on the content of this document.



414 LA TROBE STREET PO BOX 16084 MELBOURNE
VICTORIA 8007 AUSTRALIA T 61 3 9993 7888
spiire.com.au ABN 55 050 029 635



Designed
A. SCOTT/L.TRAN
Authorised
M. TOOMER-SMITH

Checked
J. KOEHLER
Date
28-10-20

**SHERWOOD GRANGE
STAGE 1
ROAD AND DRAINAGE
RETAINING WALL - SHEET 2
HUME CITY COUNCIL
RACECOURSE ROAD HOLDING PTY LTD**

AS CONSTRUCTED	Drg No 305950CR901	Rev 1
-----------------------	------------------------------	-----------------