



SLEEPER RETAINING WALL TYPICAL DETAIL

NOT TO SCALE

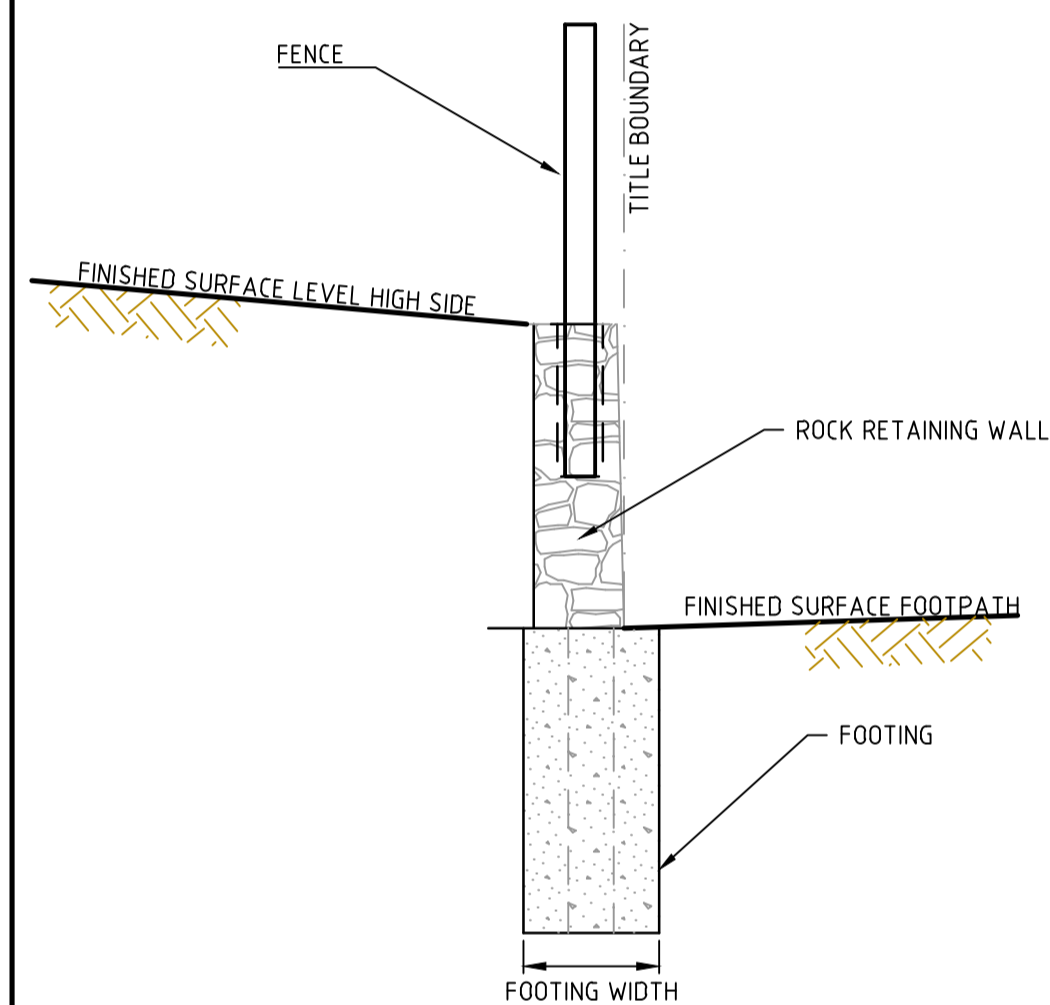


ROCK RETAINING WALL (WITH PROVISION FOR FENCING) TYPICAL DETAIL

NOT TO SCALE

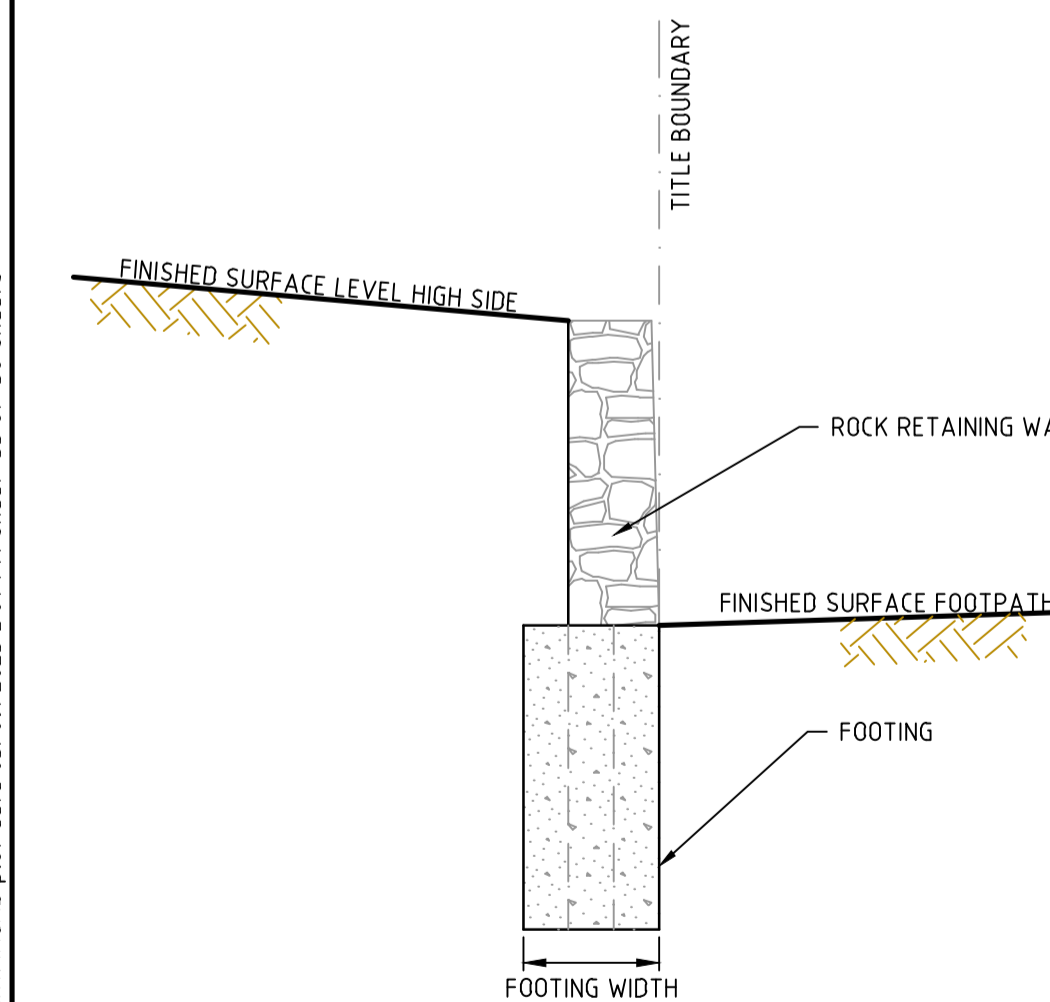



ROCK RETAINING WALL TYPICAL DETAIL

NOT TO SCALE

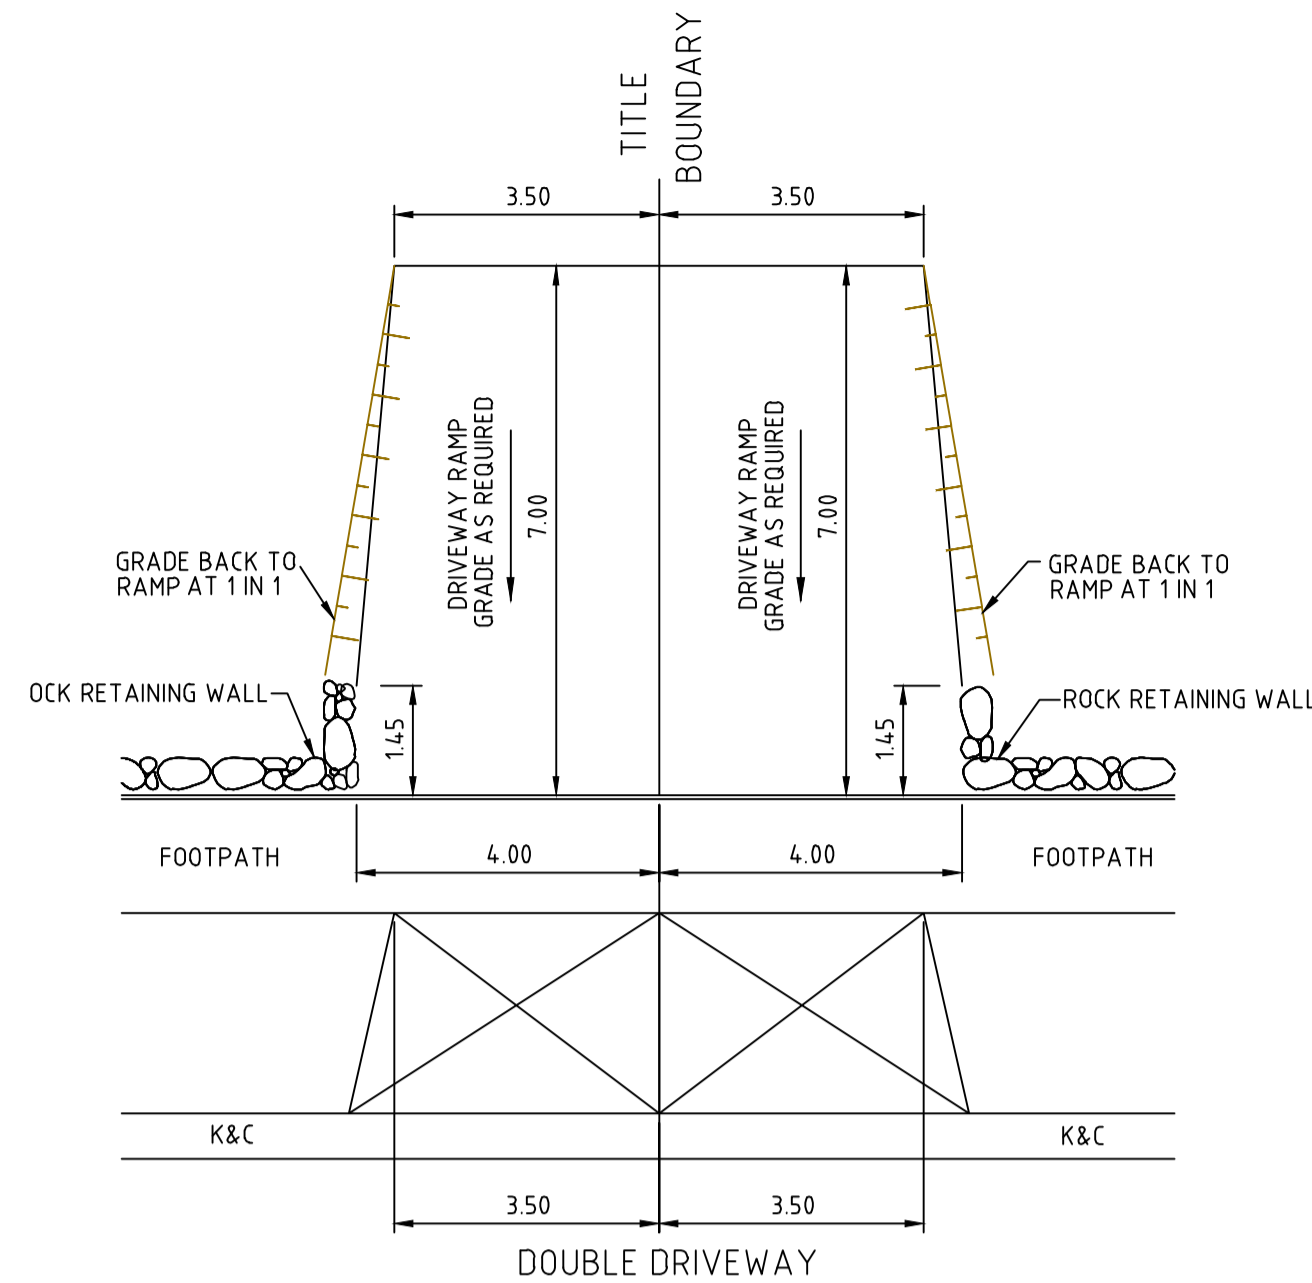

ROCK RETAINING WALL TYPICAL DETAIL

NOT TO SCALE

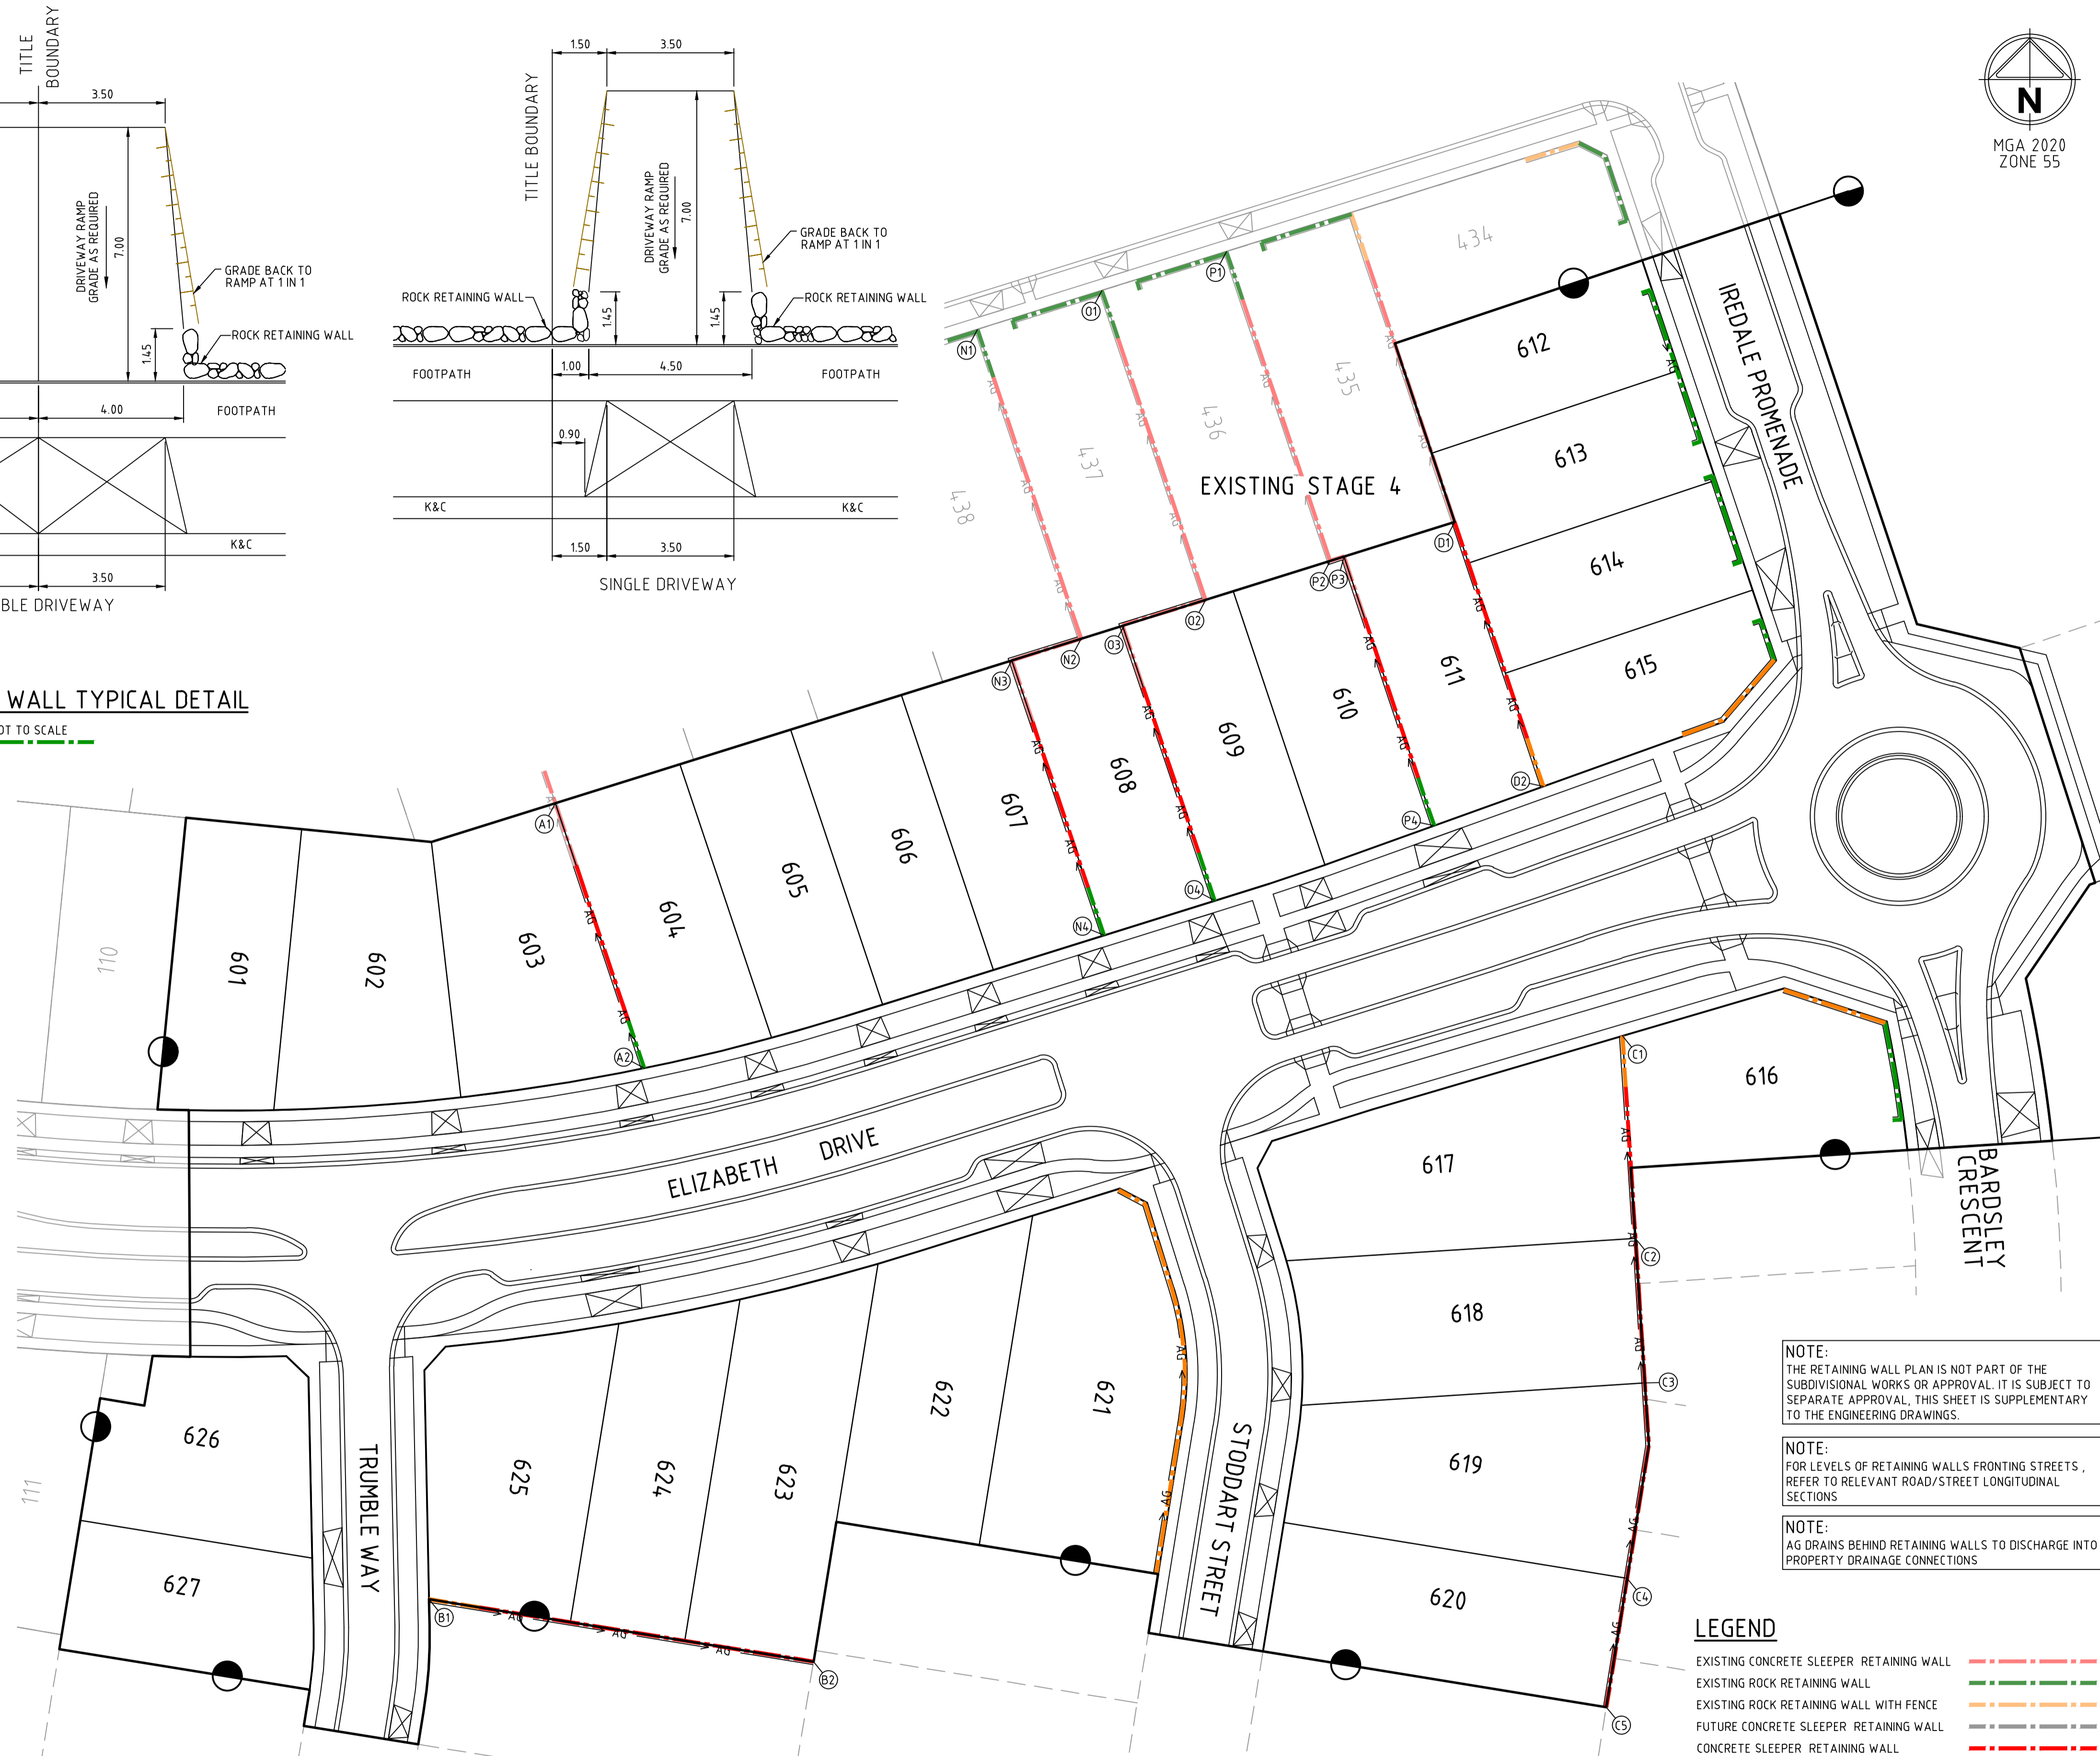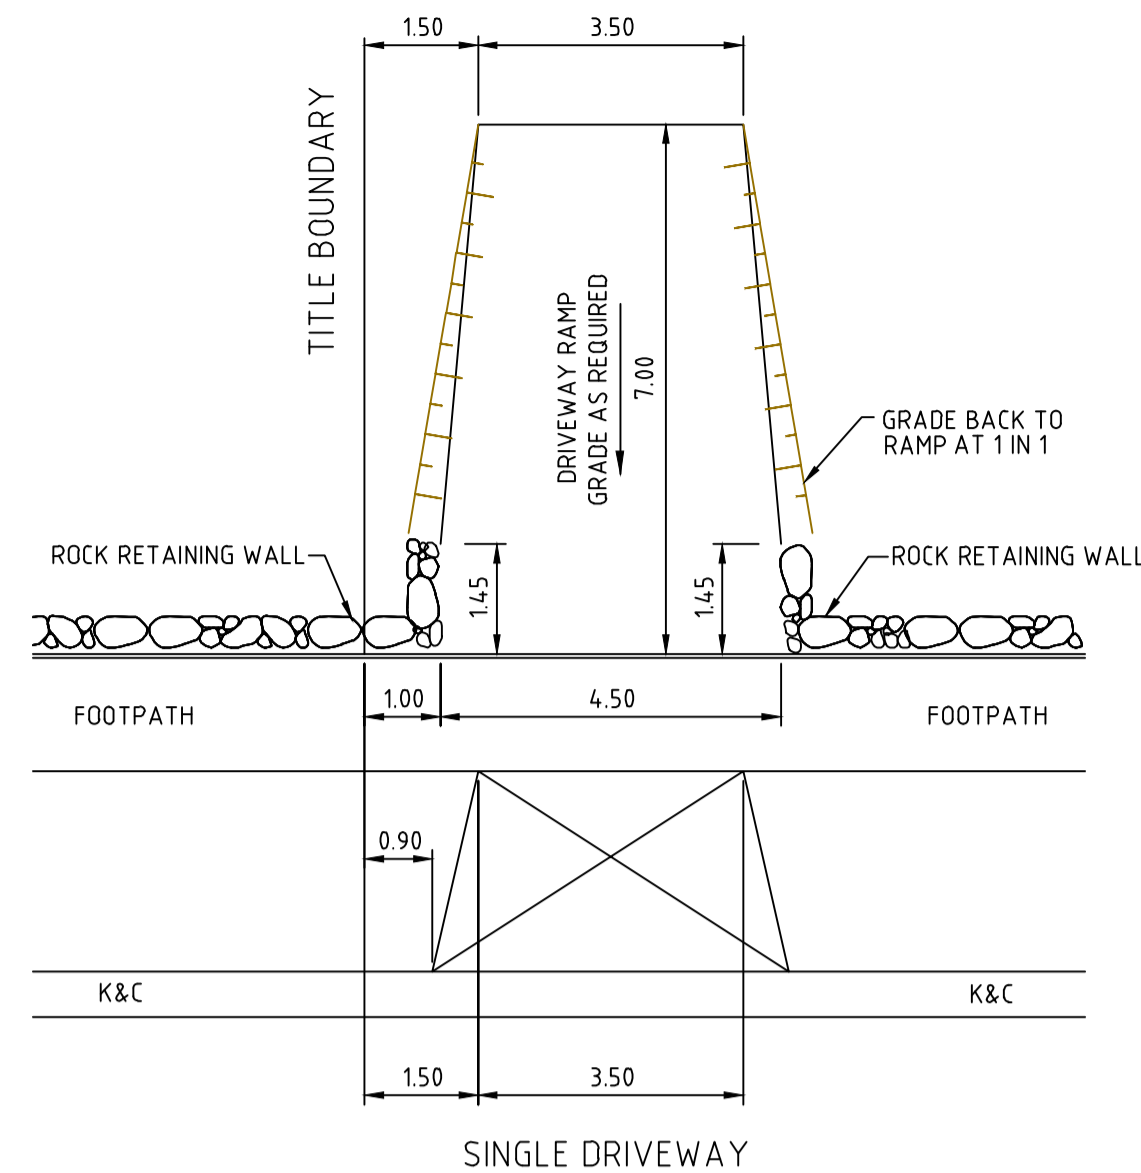

NOTE:
THE RETAINING WALL PLAN IS NOT PART OF THE
SUBDIVISIONAL WORKS OR APPROVAL. IT IS SUBJECT TO
SEPARATE APPROVAL. THIS SHEET IS SUPPLEMENTARY
TO THE ENGINEERING DRAWINGS.

NOTE:
FOR LEVELS OF RETAINING WALLS FRONTING STREETS,
REFER TO RELEVANT ROAD/STREET LONGITUDINAL
SECTIONS



NOTE:
AG DRAINS BEHIND RETAINING WALLS TO DISCHARGE INTO
PROPERTY DRAINAGE CONNECTIONS

LEGEND

- EXISTING CONCRETE SLEEPER RETAINING WALL
EXISTING ROCK RETAINING WALL
EXISTING ROCK RETAINING WALL WITH FENCE
FUTURE CONCRETE SLEEPER RETAINING WALL
CONCRETE SLEEPER RETAINING WALL
ROCK RETAINING WALL
ROCK RETAINING WALL WITH FENCE

NOTE:
FOR RETAINING WALL DETAILS REFER TO 'SHERWOOD
GRANGE RETAINING WALLS DWG 3410 S01-S07'

Rev	Amendments	Approved	Date
3	AS CONSTRUCTED	M.T-S	05/09/23
2	INDUSTRIAL DRIVEWAY AMENDED	M.T-S	12/01/23
1	ROAD NAME AMENDED	M.T-S	30/11/22
0	ISSUED FOR CONSTRUCTION	M.T-S	21/11/22
B	RETAINING WALL TYPES AMENDED	M.T-S	26/07/22
A	ISSUED TO COUNCIL	M.T-S	11/04/22

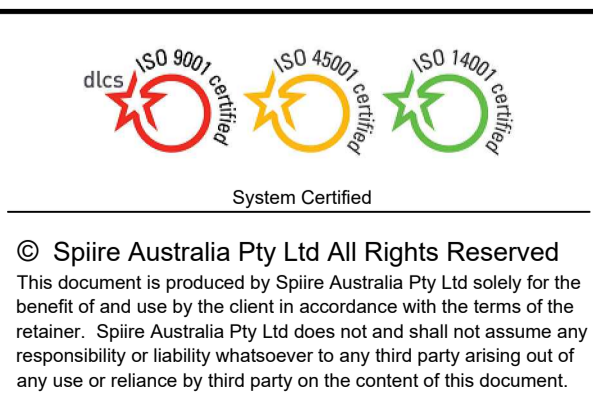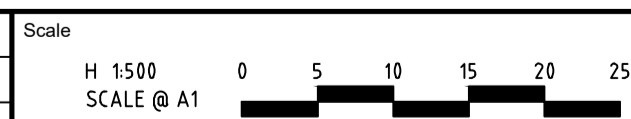

spiire

L6 414 LA TROBE STREET PO BOX 16084 MELBOURNE
VICTORIA 8007 AUSTRALIA T 61 3 9993 7888
spiire.com.au ABN 55 050 029 635

Sherwood
Grange

Designed
L. TRAN
Authorised
M. TOOMER-SMITH


Checked
J. KOEHLER
Date
10/11/22

SHERWOOD GRANGE
STAGE 6
ROAD AND DRAINAGE
RETAINING WALL - SHEET 1
HUME CITY COUNCIL
RACECOURSE ROAD HOLDING PTY LTD

AS CONSTRUCTED 305952CR900 3


file name: 305952CR900.dwg, layout name: CR901, plotted by: Thana Nguyen, file location: \\spiire.com.au\data\00a\305952\00a\ACAD, plot date: 05/09/2023 2:07 PM Sheet: 36 of 36 Sheets

NOTE:
THE RETAINING WALL PLAN IS NOT PART OF THE
SUBDIVISIONAL WORKS OR APPROVAL. IT IS SUBJECT TO
SEPARATE APPROVAL. THIS SHEET IS SUPPLEMENTARY
TO THE ENGINEERING DRAWINGS.

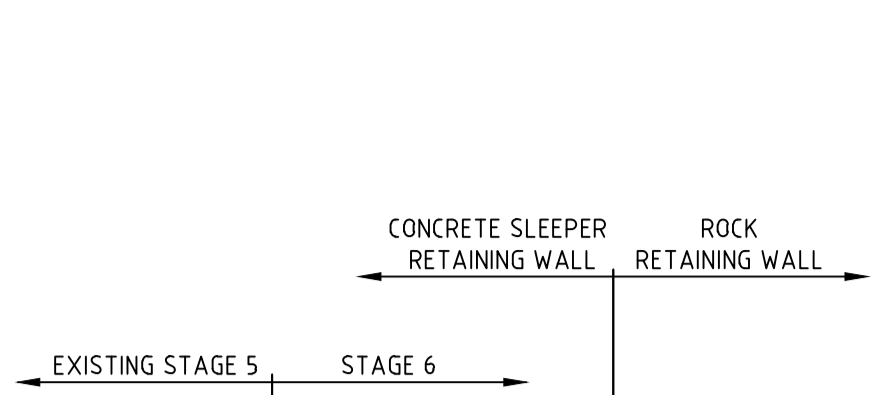


DATUM RL 220.0		
RETAINING WALL TOP	4.5300	225.480
RETAINING WALL BASE	52.300	224.734
CHAINAGE	60.000	224.904
	70.000	225.131
	76.867	225.288
	78.867	225.333
	83.867	225.447

RETAINING WALL A

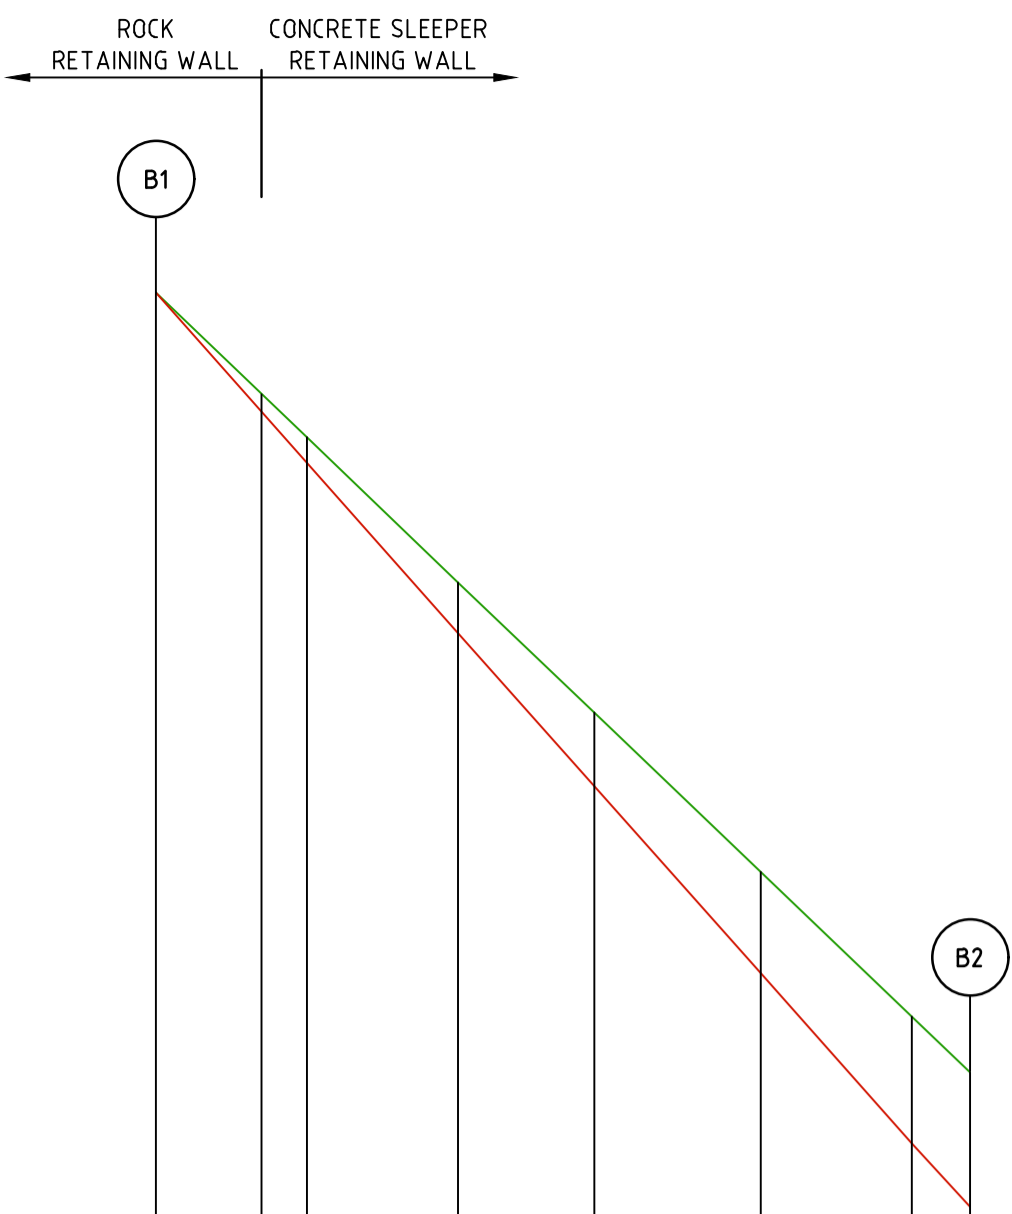


DATUM RL 223.0		
RETAINING WALL TOP	0.000	231.085
RETAINING WALL BASE	7.000	230.297
CHAINAGE	10.000	229.960
	20.000	228.834
	29.000	227.822
	40.000	226.584
	50.000	225.459
	53.743	225.939

RETAINING WALL B

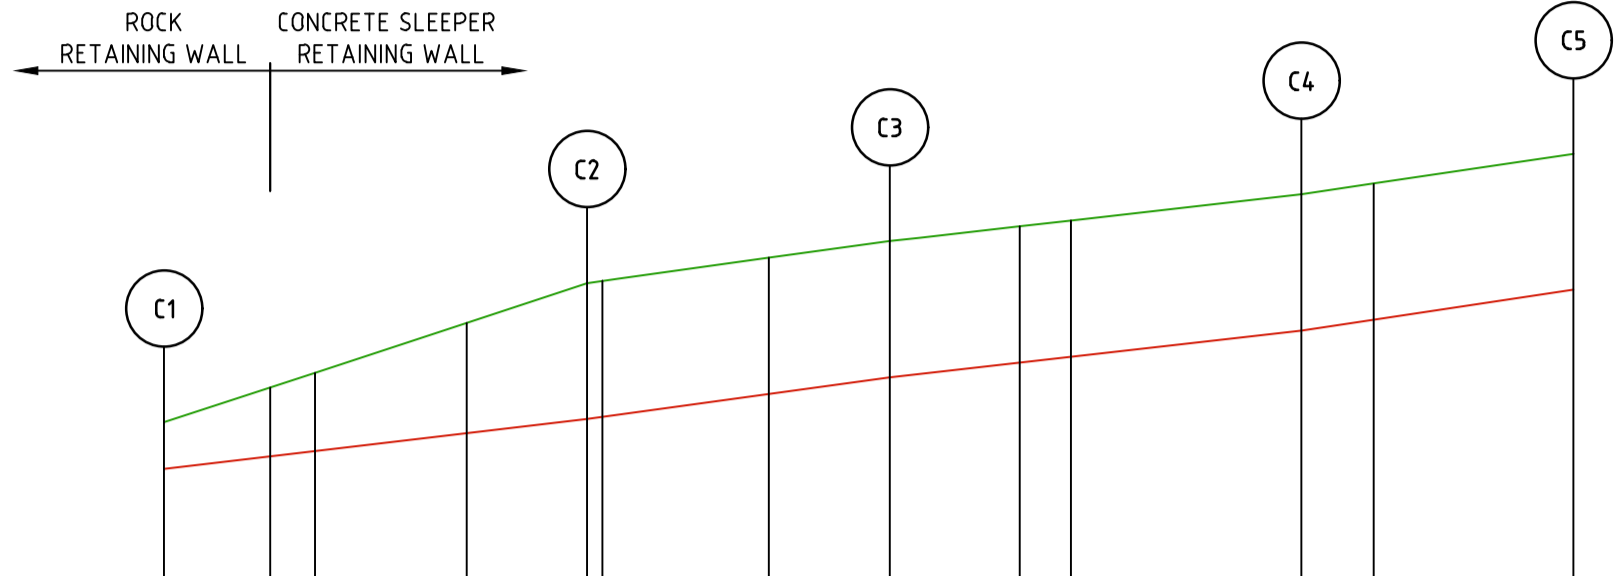


DATUM RL 211.0		
RETAINING WALL TOP	0.000	213.708
RETAINING WALL BASE	7.000	213.782
CHAINAGE	10.000	213.817
	20.000	213.935
	27.988	214.030
	29.000	214.044
	40.000	214.196
	47.988	214.307
	56.609	214.404
	60.000	214.443
	75.196	214.615
	80.000	214.686
	93.196	214.885

RETAINING WALL C

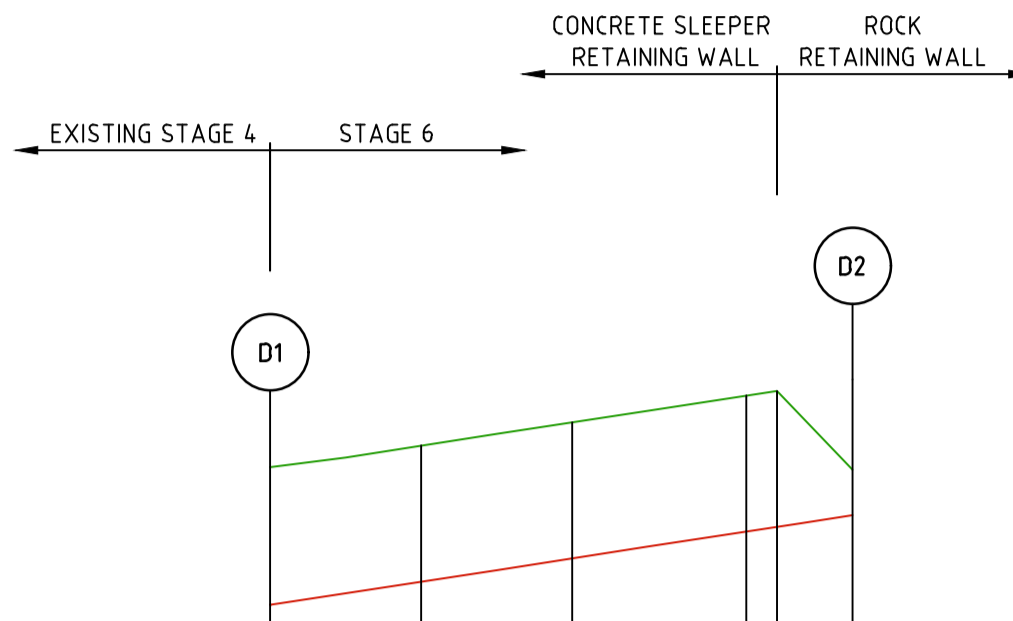


DATUM RL 211.0		
RETAINING WALL TOP	0.000	213.998
RETAINING WALL BASE	10.000	213.252
CHAINAGE	20.000	213.406
	31.512	213.584
	33.512	213.615
	38.512	213.690

RETAINING WALL D

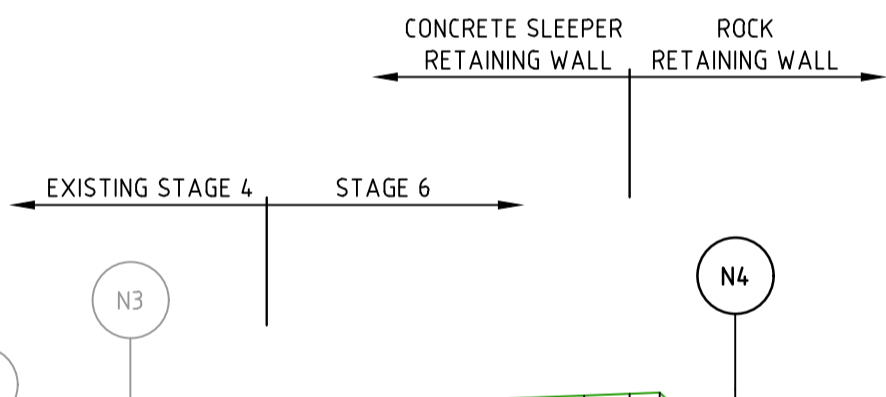


DATUM RL 215.0		
RETAINING WALL TOP	0.000	218.269
RETAINING WALL BASE	7.000	218.324
CHAINAGE	20.000	218.427
	40.000	218.585
	45.000	218.624
	55.000	219.079
	64.000	219.139
	75.000	219.145
	85.000	219.279
	88.000	219.232
	90.000	219.312
	95.000	219.346

RETAINING WALL N

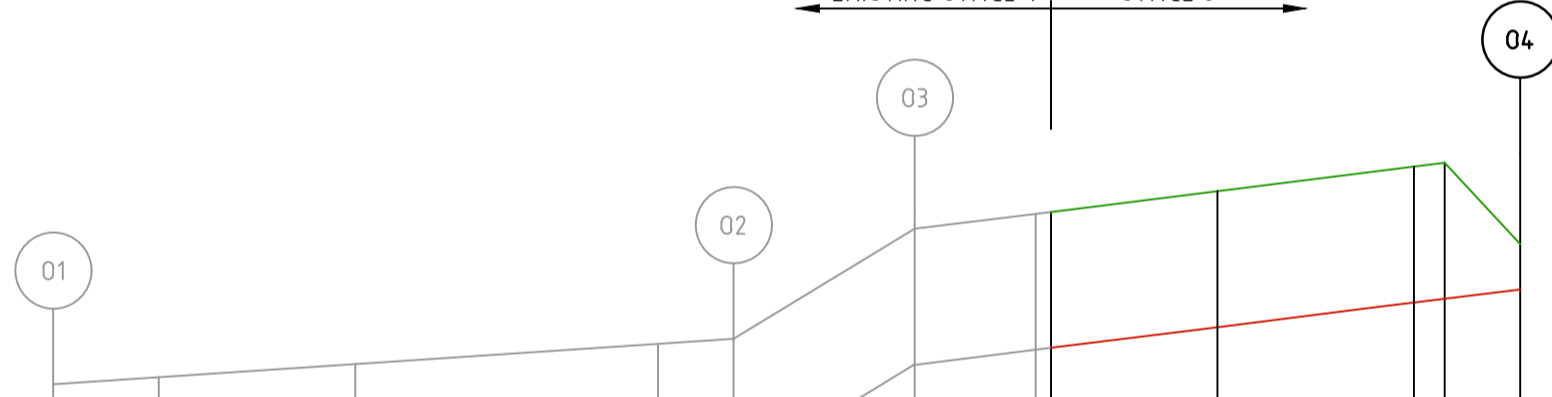

DATUM RL 212.0		
RETAINING WALL TOP	0.000	216.379
RETAINING WALL BASE	7.000	216.425
CHAINAGE	20.000	216.512
	40.000	216.645
	45.000	216.679
	57.000	217.405
	65.000	217.505
	66.000	217.512
	77.000	217.655
	90.000	217.818
	92.000	217.843
	97.000	217.905


RETAINING WALL O

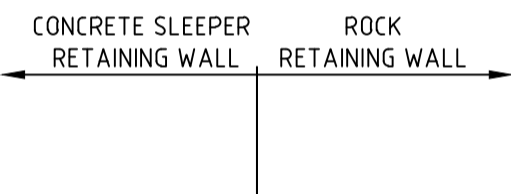

DATUM RL 211.0		
RETAINING WALL TOP	0.000	214.488
RETAINING WALL BASE	7.000	214.535
CHAINAGE	20.000	214.622
	40.000	214.755
	45.000	214.788
	47.000	214.698
	56.000	214.767
	65.000	214.840
	75.000	214.919
	79.178	214.952
	81.178	214.968
	86.178	215.007

RETAINING WALL P

3	AS CONSTRUCTED	M.T-S	05/09/23
2	RETAINING WALL A AMENDED	G.W	24/03/23
1	RETAINING WALL A AMENDED	G.W	16/03/23
0	ISSUED FOR CONSTRUCTION	M.T-S	21/11/22
A	ISSUED TO COUNCIL	M.T-S	11/04/22
Rev	Amendments	Approved	Date

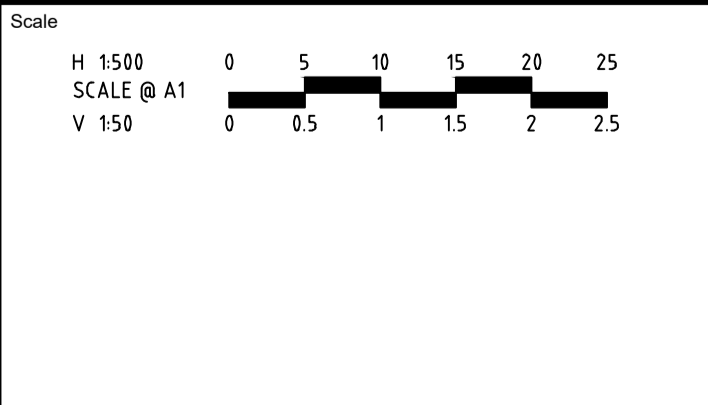

spiire

L6 414 LA TROBE STREET PO BOX 16084 MELBOURNE
VICTORIA 8007 AUSTRALIA T 61 3 9993 7888
spiire.com.au ABN 55 050 029 635

Sherwood Grange

Designed
L. TRAN

Authorised
M. TOOMER-SMITH

Checked
J. KOEHLER

Date
10/11/22

SHERWOOD GRANGE
STAGE 6
ROAD AND DRAINAGE
RETAINING WALL - SHEET 2
HUME CITY COUNCIL
RACECOURSE ROAD HOLDING PTY LTD

AS CONSTRUCTED

Drg No
305952CR901

Rev
3