

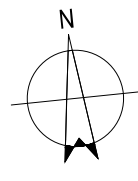


**LEGEND:**

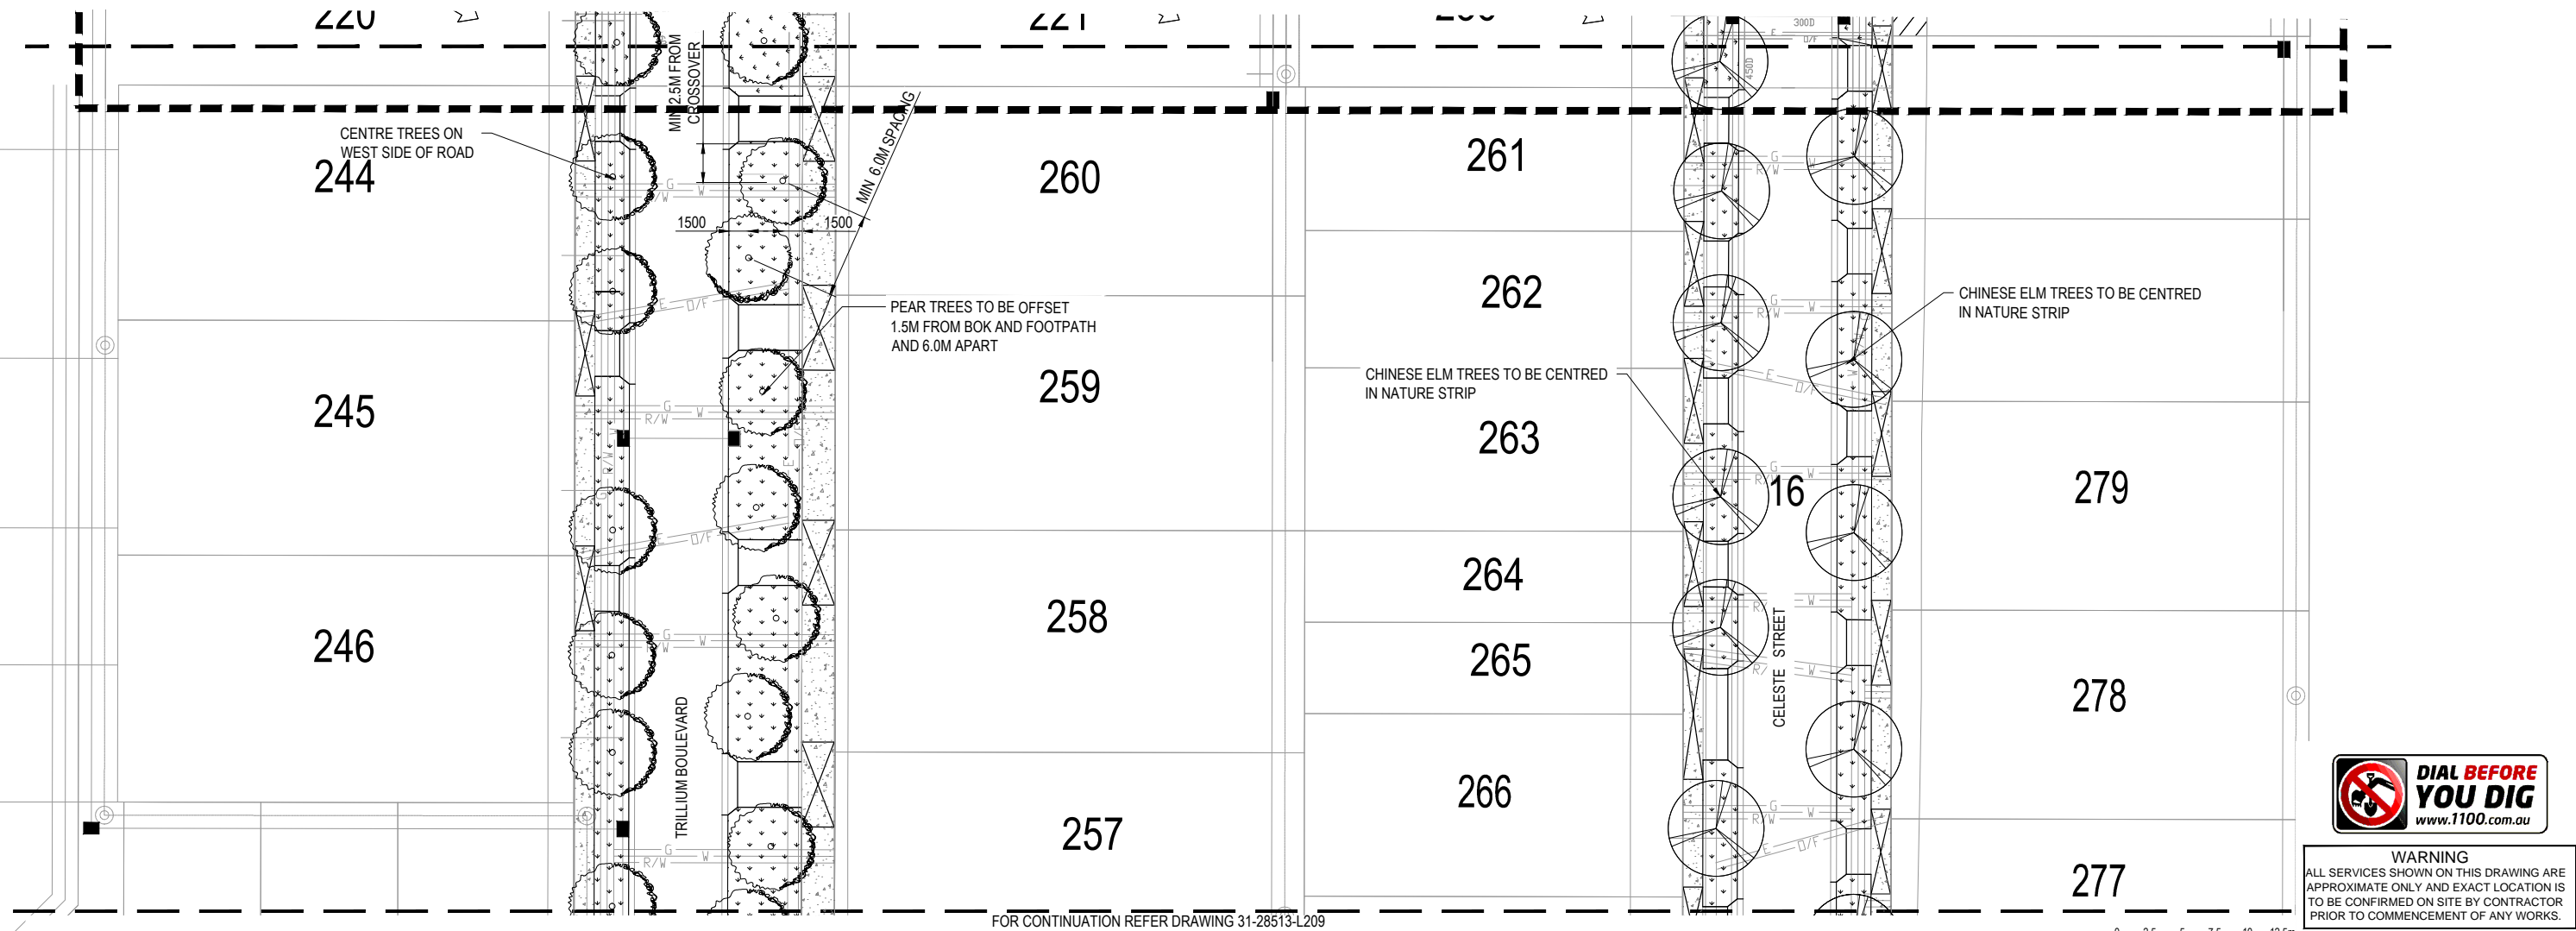


- COLOURED CONCRETE PAVEMENT
  - TUSCAN TOPPINGS FINISH
  - SOFT FALL MULCH
  - CONCRETE BY CIVIL CONTRACTOR
  - GRASS AREAS HYDROSEED
  - KIKUYU TURF
  - MULCHED PLANTED AREAS
  - 400x400x50 PAVERS
  - SEWER COVER
  - STREET SIGN LOCATION
  - CROSS OVER LOCATION
  - STREET TREE - *Acer truncatum* x *A. platanoides* 'Warrenred'
  - STREET TREE - *Pyrus calleryana* x *P. betulaefolia* 'Edgewood'
  - STREET TREE - *Acer negundo* 'Sensation' (150 Litre)
  - STREET TREE - *Ulmus parvifolia* 'Todd'
  - FEATURE TREE
  - EXISTING TREE TO BE RETAINED
  - STREET TREE - *Corymbia eximia nana*
  - SEAT ON CONCRETE BASE (FROM COMMERCIAL SYSTEMS (TYP1 - TM4035 - WITH ARM RESTS AND TYP2 - TM4050 WITHOUT
  - BOLLARDS
  - INTERPRETATION SIGN
  - FLAGPOLES BY OTHERS
  - SCULPTURAL ELEMENT BY OTHERS
  - STEEL EDGE
  - TIMBER EDGE
  - CONTRACTION JOINT AT 3m INTERVAL
  - EXPANSION JOINT AT 12m INTERVAL
  - STAGE BOUNDARY
- INDIGENOUS PLANTS ARE TO BE OBTAINED FROM APPROVED SUPPLIER AND BE OF LOCAL PROVENANCE

PLANT SCHEDULE STAGE 2B					
CODE	SPECIES	COMMON NAME	PLANT S/m2	COMP %	PLANT SIZE
<b>ADVANCE TREE PLANTING STREETSCAPES</b>					
PYR cal E	<i>Pyrus calleryana</i> x <i>P. betulaefolia</i> 'Edgewood'	EDGEWOOD PEAR	AS SHOWN		45 Litre 30mm CAL 2.5m HIGH
ULM par	<i>Ulmus parviflora</i> 'Todd'	CHINESE ELM	AS SHOWN		45 Litre 30mm CAL 2.5m HIGH
			<b>TOTAL PLANTS</b>		

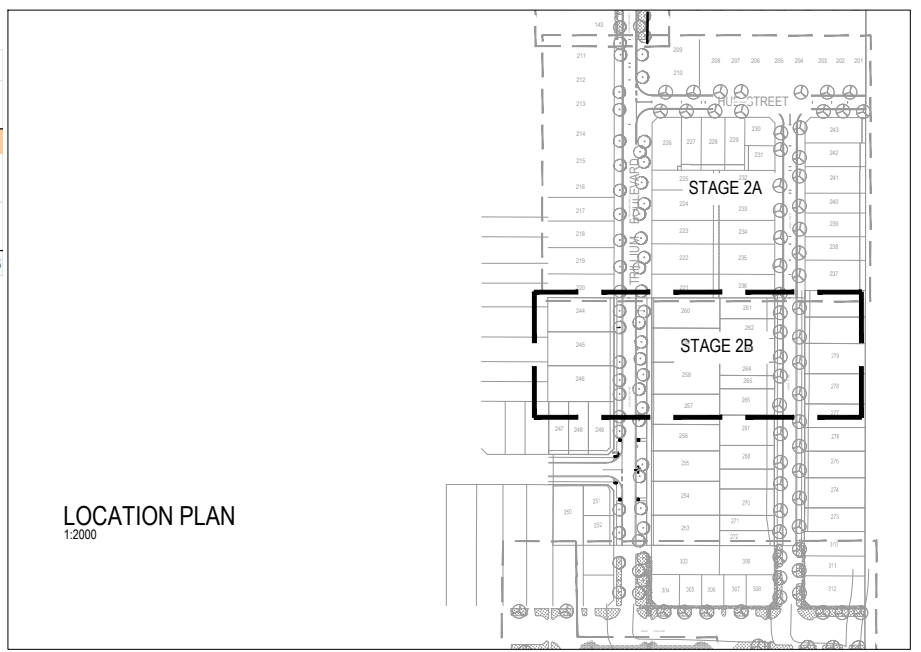

**WARNING**  
ALL SERVICES SHOWN ON THIS DRAWING ARE APPROXIMATE ONLY AND EXACT LOCATION IS TO BE CONFIRMED ON SITE BY CONTRACTOR PRIOR TO COMMENCEMENT OF ANY WORKS.

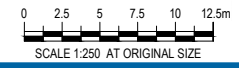

**AS BUILT**

No	Revision	Note: * indicates signatures on original issue of drawing or last revision of drawing	Drawn	Job Manager	Project Director	Date
A	FIRST ISSUE		GC	GC	SG	16.03.14



<b>DO NOT SCALE</b>	Drawn K.CELMENTE	Designer G. CATER
Conditions of Use. This document may only be used by GHD's client (and any other person who GHD has agreed can use this document) for the purpose for which it was prepared and must not be used by any other person or for any other purpose.	Drafting Check	Design Check
	Approved (Project Director)	Date
	Scale 1:250	This Drawing must not be used for Construction unless signed as Approved

Client	VILLAWOOD PROPERTIES
Project	TRILLIUM DEVELOPMENT
Title	STAGE 2B - STREETSCAPE GENERAL LANDSCAPE WORKS SHEET 1 OF 2
Original Size	A1
Drawing No:	31-28513-L208
Rev:	A