

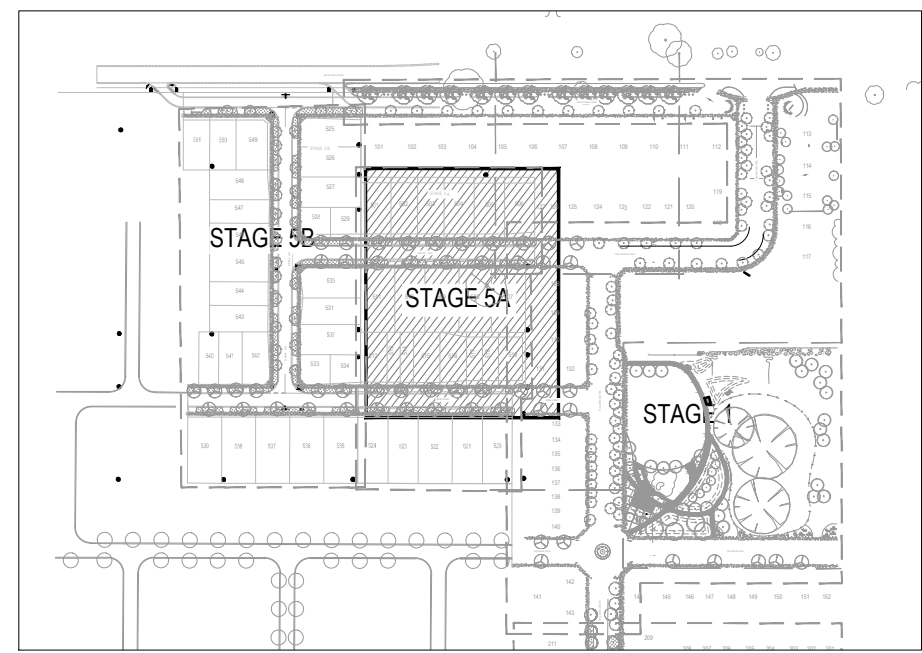


PLANT SCHEDULE STAGE 5A		
CODE	SPECIES	COMMON NAME
ADVANCE TREE PLANTING STREETSCAPES		
ULMpar	<i>Ulmus parvifolia 'Todd'</i>	CHINESE ELM

PLANT SCHEDULE STAGE 5B		
CODE	SPECIES	COMMON NAME
ADVANCE TREE PLANTING STREETSCAPES		
AGRtru W	<i>Acer truncatum x A. platanoides 'Warrenred'</i>	NORWAY MAPLE
ULMpar	<i>Ulmus parvifolia 'Todd'</i>	CHINESE ELM

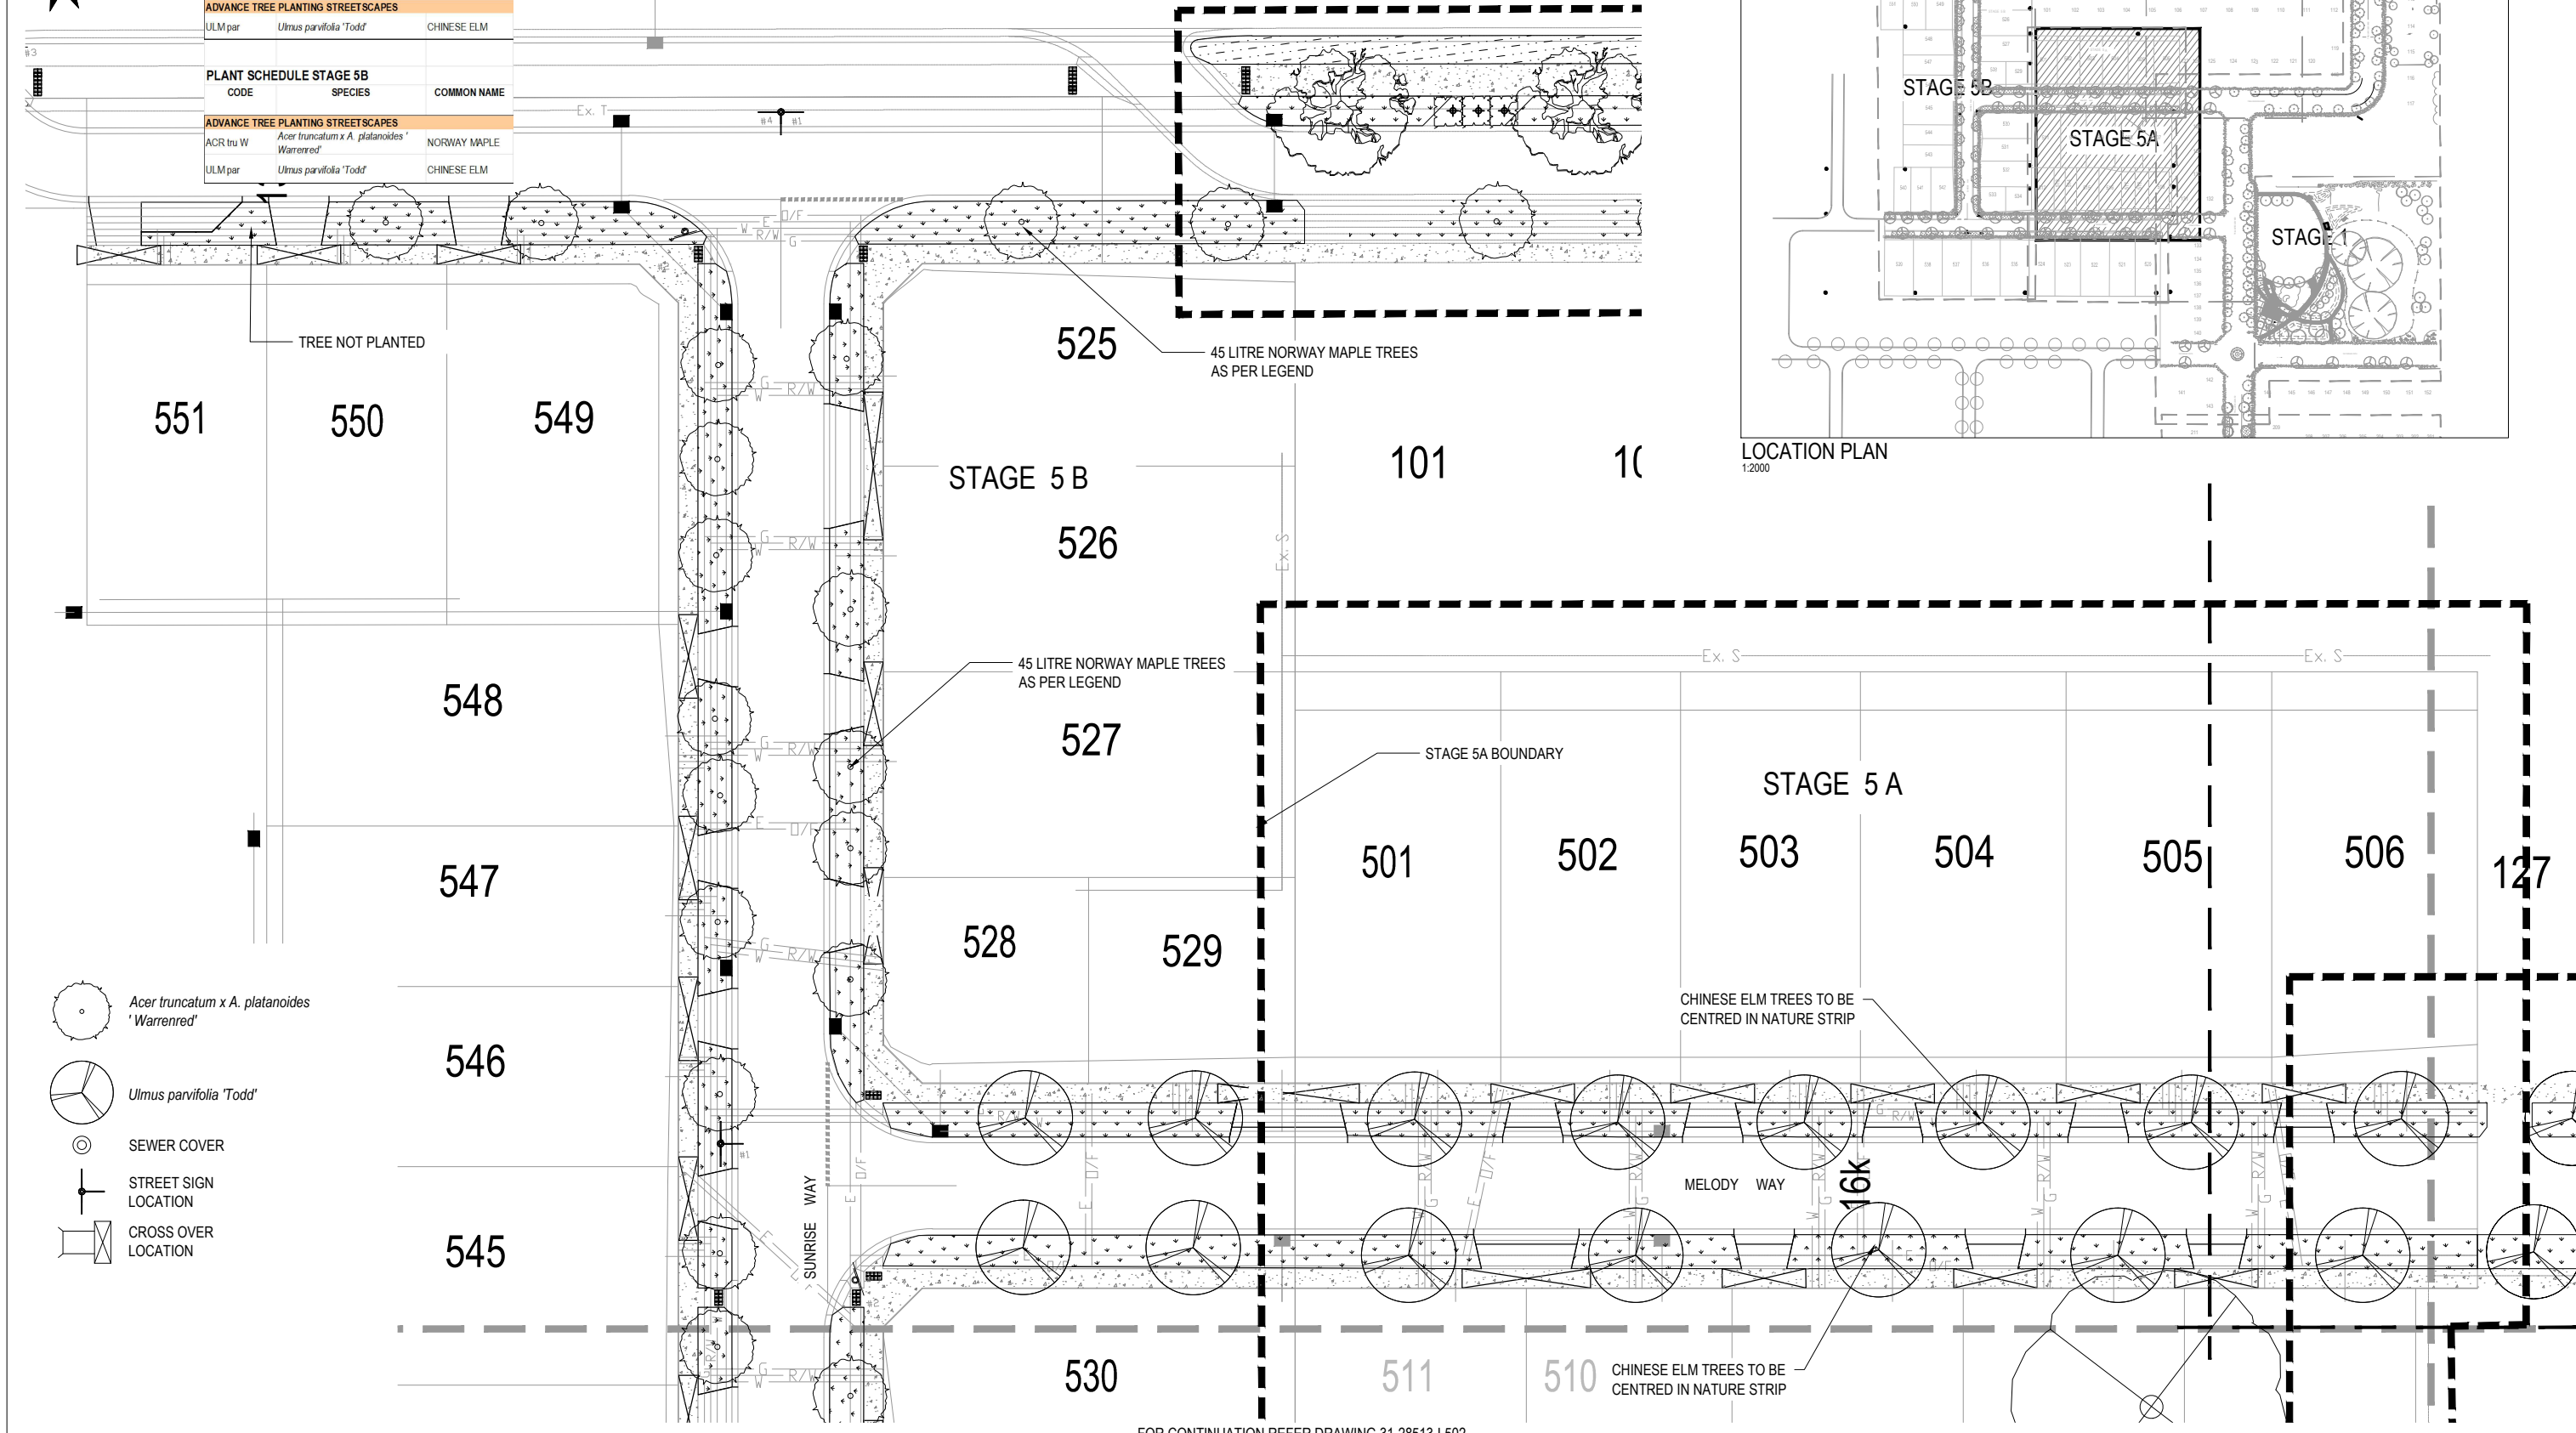


- Acer truncatum x A. platanoides 'Warrenred'*
- Ulmus parvifolia 'Todd'*
- SEWER COVER
- STREET SIGN LOCATION
- CROSS OVER LOCATION

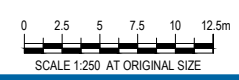

AS BUILT

No	Revision	Note: * indicates signatures on original issue of drawing or last revision of drawing	Drawn	Job Manager	Project Director	Date
1	ISSUE FOR AS BUILT		KC	GC	GC	19.06.14
0	ISSUED FOR CONSTRUCTION		KC	GC	GC	12.05.14

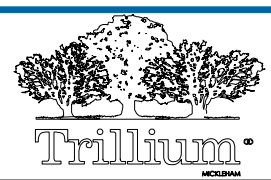

DO NOT SCALE	Drawn K. CLEMENTE	Designer G. CATER
Conditions of Use. This document may only be used by GHD's client (and any other person who GHD has agreed can use this document) for the purpose for which it was prepared and must not be used by any other person or for any other purpose.	Drafting Check	Design Check
	Approved (Project Director)	Date
	Scale 1:250	This Drawing must not be used for Construction unless signed as Approved

Client	VILLAWOOD PROPERTIES
Project	TRILLIUM DEVELOPMENT
Title	STAGE 5A AND 5B - STREETSCAPE
	GENERAL LANDSCAPE WORKS SHEET 1 OF 2
Original Size	A1
Drawing No:	31-28513-L501
Rev:	1