

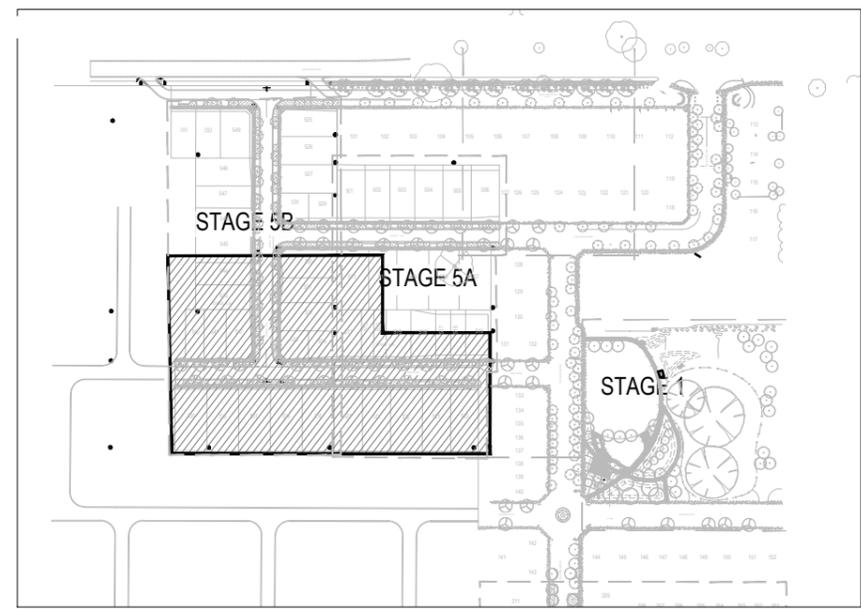


FOR CONTINUATION REFER DRAWING 31-28513-L501

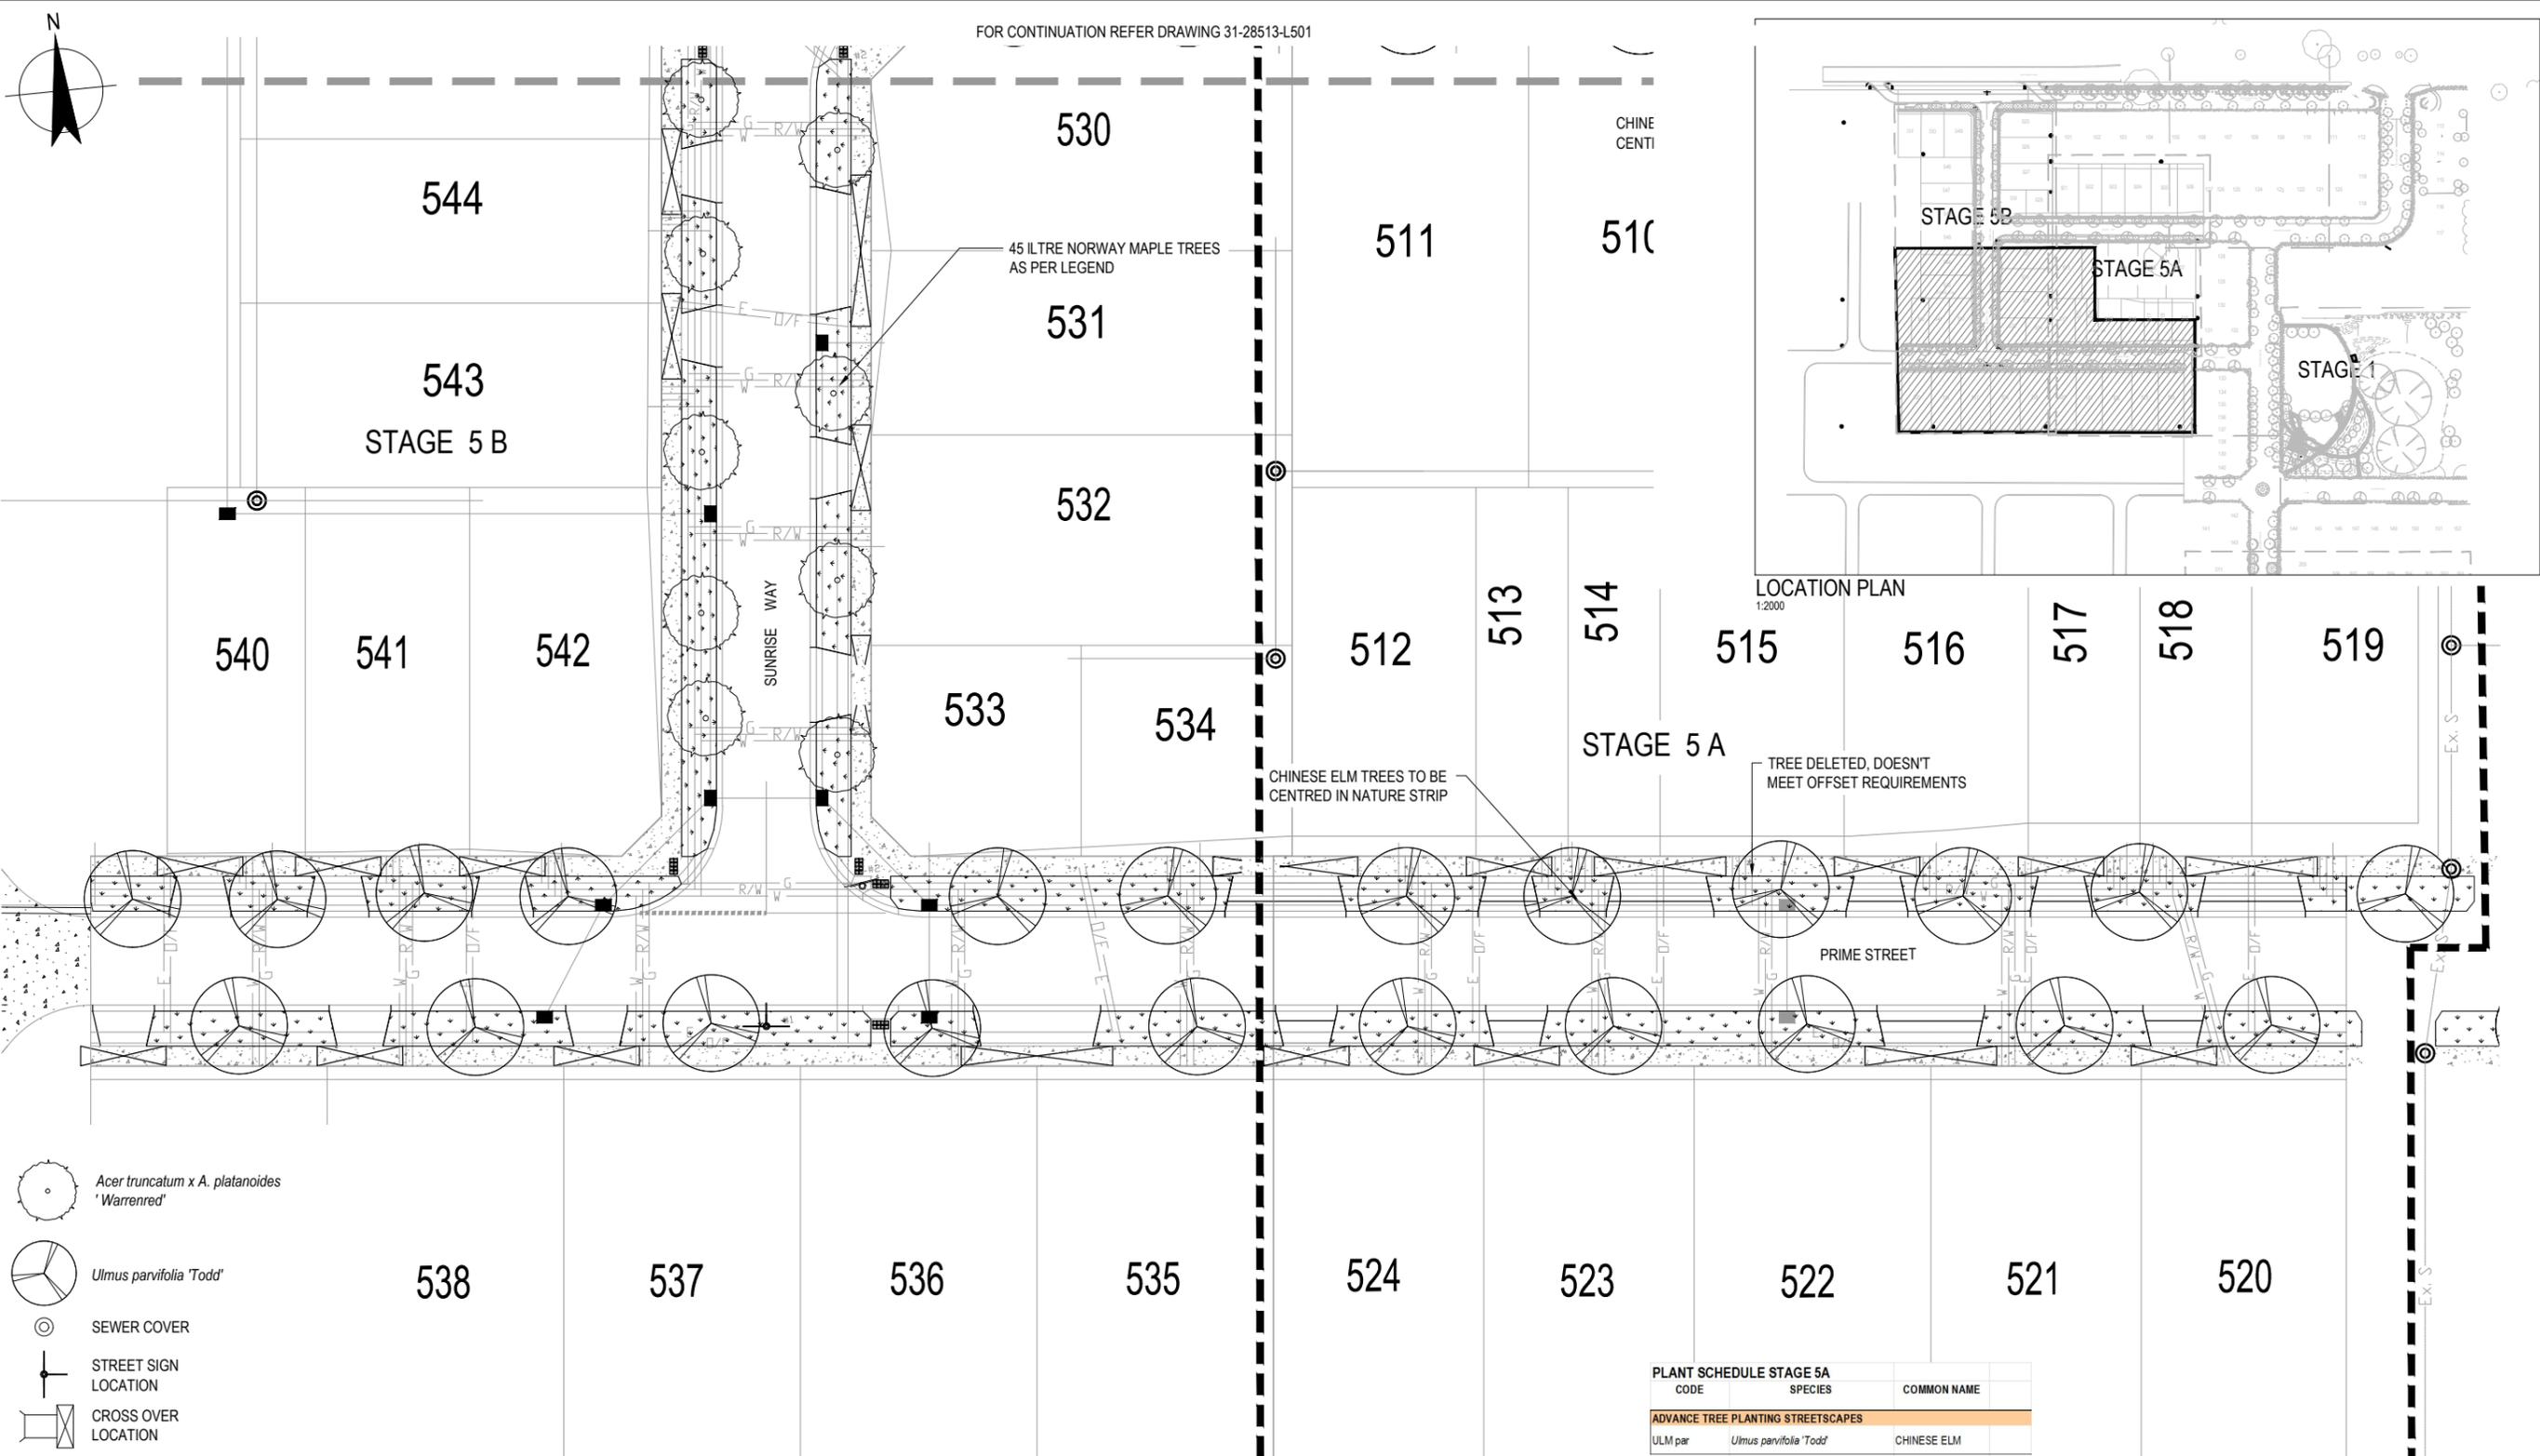

- Acer truncatum* x *A. platanoides* 'Warrenred'
- Ulmus parvifolia* 'Todd'
- SEWER COVER
- STREET SIGN LOCATION
- CROSS OVER LOCATION

PLANT SCHEDULE STAGE 5A		
CODE	SPECIES	COMMON NAME
ADVANCE TREE PLANTING STREETSAPES		
ULM par	<i>Ulmus parvifolia</i> 'Todd'	CHINESE ELM
PLANT SCHEDULE STAGE 5B		
CODE	SPECIES	COMMON NAME
ADVANCE TREE PLANTING STREETSAPES		
ACR tru W	<i>Acer truncatum</i> x <i>A. platanoides</i> 'Warrenred'	NORWAY MAPLE
ULM par	<i>Ulmus parvifolia</i> 'Todd'	CHINESE ELM

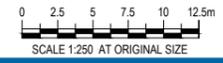

AS BUILT



WARNING
ALL SERVICES SHOWN ON THIS DRAWING ARE APPROXIMATE ONLY AND EXACT LOCATION IS TO BE CONFIRMED ON SITE BY CONTRACTOR PRIOR TO COMMENCEMENT OF ANY WORKS.

No	Revision	Note: * indicates signatures on original issue of drawing or last revision of drawing	Drawn	Job Manager	Project Director	Date
1	ISSUED FOR AS BUILT		KC	GC	GC	19.06.14
0	ISSUED FOR CONSTRUCTION		KC	GC	GC	12.05.14



DO NOT SCALE <small>Conditions of Use. This document may only be used by GHD's client (and any other person who GHD has agreed can use this document) for the purpose for which it was prepared and must not be used by any other person or for any other purpose.</small>	Drawn	K. CLEMENTE	Designer	G. CATER
	Drafting Check		Design Check	
	Approved (Project Director)		Date	
	Scale	1:250	<small>This Drawing must not be used for Construction unless signed as Approved</small>	

Client	VILLAWOOD PROPERTIES
Project	TRILLIUM DEVELOPMENT
Title	STAGE 5A AND 5B - STREETSCAPE GENERAL LANDSCAPE WORKS SHEET 2 OF 2
Original Size	A1
Drawing No:	31-28513-L502
Rev:	1