


FOR CONTINUATION REFER DRAWING 31-28513-L602

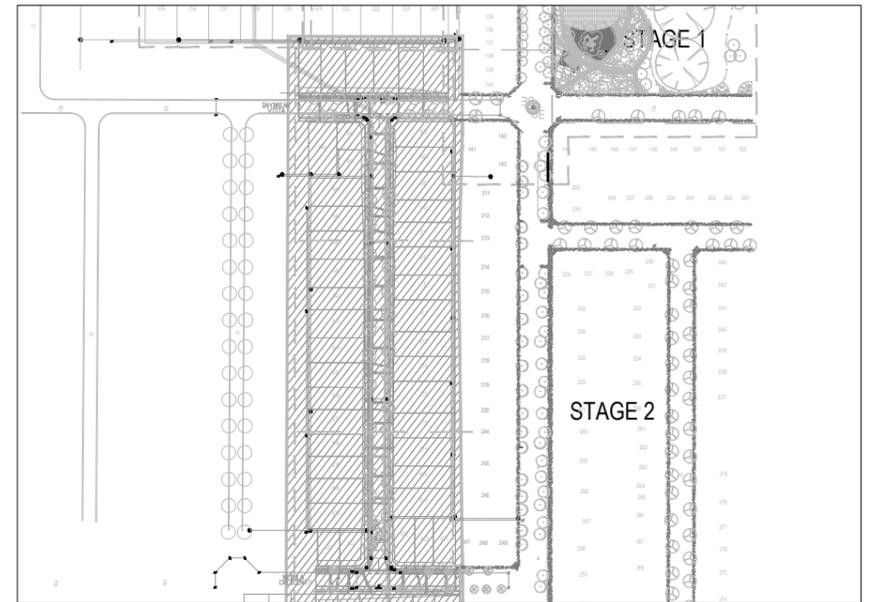

LOCATION PLAN  
1:2000

PLANT SCHEDULE STAGE 6		
CODE	SPECIES	COMMON NAME
<b>ADVANCE TREE PLANTING STREETSCAPES</b>		
ULM par	<i>Ulmus parvifolia</i> 'Todd'	CHINESE ELM

-  *Ulmus parvifolia* 'Todd'
-  SEWER COVER
-  STREET SIGN LOCATION
-  CROSS OVER LOCATION



**AS BUILT**

No	Revision	Note: * indicates signatures on original issue of drawing or last revision of drawing	Drawn	Job Manager	Project Director	Date
B	AS BUILT		KC	GC	GC	21.08.14
A	ISSUED FOR APPROVAL		KC	GC	SG	27.06.14



**DO NOT SCALE**  
Conditions of Use.  
This document may only be used by GHD's client (and any other person who GHD has agreed can use this document) for the purpose for which it was prepared and must not be used by any other person or for any other purpose.

Drawn	K. CLEMENTE	Designer	G. CATER
Drafting Check		Design Check	
Approved (Project Director)			
Date			
Scale	1:250		

Client	<b>VILLAWOOD PROPERTIES</b>
Project	<b>TRILLIUM DEVELOPMENT</b>
Title	<b>STAGE 6 - STREETSCAPE GENERAL LANDSCAPE WORKS</b>
Original Size	<b>A1</b>
Drawing No:	<b>31-28513-L601</b>

Rev: B