


FOR CONTINUATION REFER DRAWING 31-28513-L706

- Ulmus parviflora* 'Todd'
- Lagerstroemia indica* x *L. fauriei* 'Natchez'
- SEWER COVER
- STREET SIGN LOCATION
- CROSS OVER LOCATION
- STAGE BOUNDARY

PLANT SCHEDULE STAGE 7B STREET TREES		
CODE	SPECIES	COMMON NAME
ADVANCE TREE PLANTING STREETSAPES		
LAR NA	<i>Lagerstroemia indica</i> x <i>L. fauriei</i> 'Natchez'	CREPE MYRTLE
ULM par	<i>Ulmus parviflora</i> 'Todd'	CHINESE ELM




WARNING
ALL SERVICES SHOWN ON THIS DRAWING ARE APPROXIMATE ONLY AND EXACT LOCATION IS TO BE CONFIRMED ON SITE BY CONTRACTOR PRIOR TO COMMENCEMENT OF ANY WORKS.

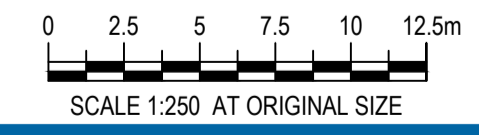

PRELIMINARY

No	Revision	Note: * indicates signatures on original issue of drawing or last revision of drawing	Drawn	Job Manager	Project Director	Date
A	ISSUED TO COUNCIL		LK	GC	MVDE	04.12.14

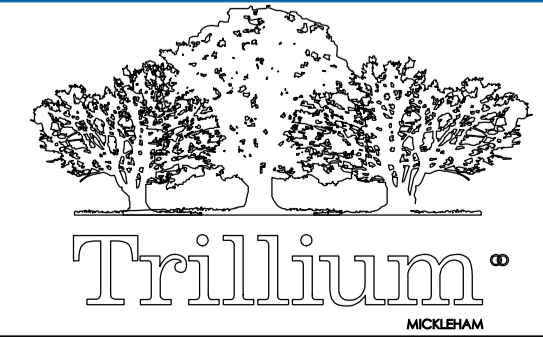

DO NOT SCALE
Conditions of Use.
This document may only be used by GHD's client (and any other person who GHD has agreed can use this document) for the purpose for which it was prepared and must not be used by any other person or for any other purpose.

Drawn	L.KRSTIC	Designer	G.CATER
Drafting Check		Design Check	
Approved (Project Director)		Date	
Scale	1:250	This Drawing must not be used for Construction unless signed as Approved	

Client	VILLAWOOD PROPERTIES
Project	TRILLIUM DEVELOPMENT
Title	STAGE 7B - STREETSAPES AS BUILT - GENERAL LANDSCAPE WORKS
Original Size	A1
Drawing No:	31-28513-L705
Rev:	A