



PLANT SCHEDULE STAGE 7A STREET TREES					
CODE	SPECIES	COMMON NAME	PLANT SIZE	COMP	PLANT SIZE
ADVANCE TREE PLANTING STREETSAPES					
EUC leu	<i>Eucalyptus leucoxylo</i> ssp. <i>Rosea</i>	RED FLOWERING YELLOW GUM	AS SHOWN		45 Litre 30mm CAL 2.5m HIGH
LAR NA	<i>Lagerstroemia indica</i> x <i>L. fauriei</i> 'Natchez'	CREPE MYRTLE	AS SHOWN		45 Litre 30mm CAL 2.5m HIGH

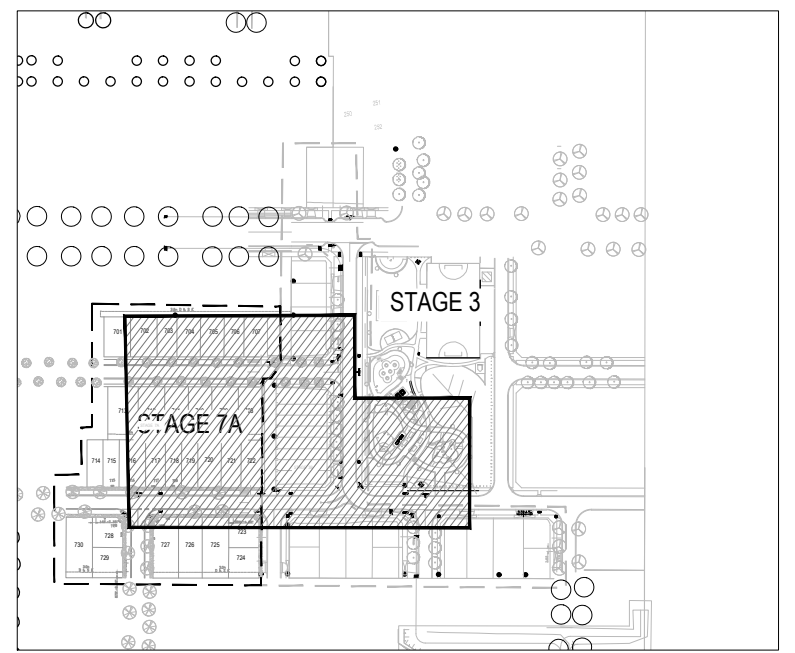


LOCATION PLAN
1:2000

- Pyrus calleryana* x *P. betulaeifolia* 'Edgewood'
- Ulmus parvifolia* 'Todd'
- Lagerstroemia indica* x *L. fauriei* 'Natchez'
- Eucalyptus leucoxylo* ssp. *Rosea*
- SEWER COVER
- STREET SIGN LOCATION
- CROSS OVER LOCATION

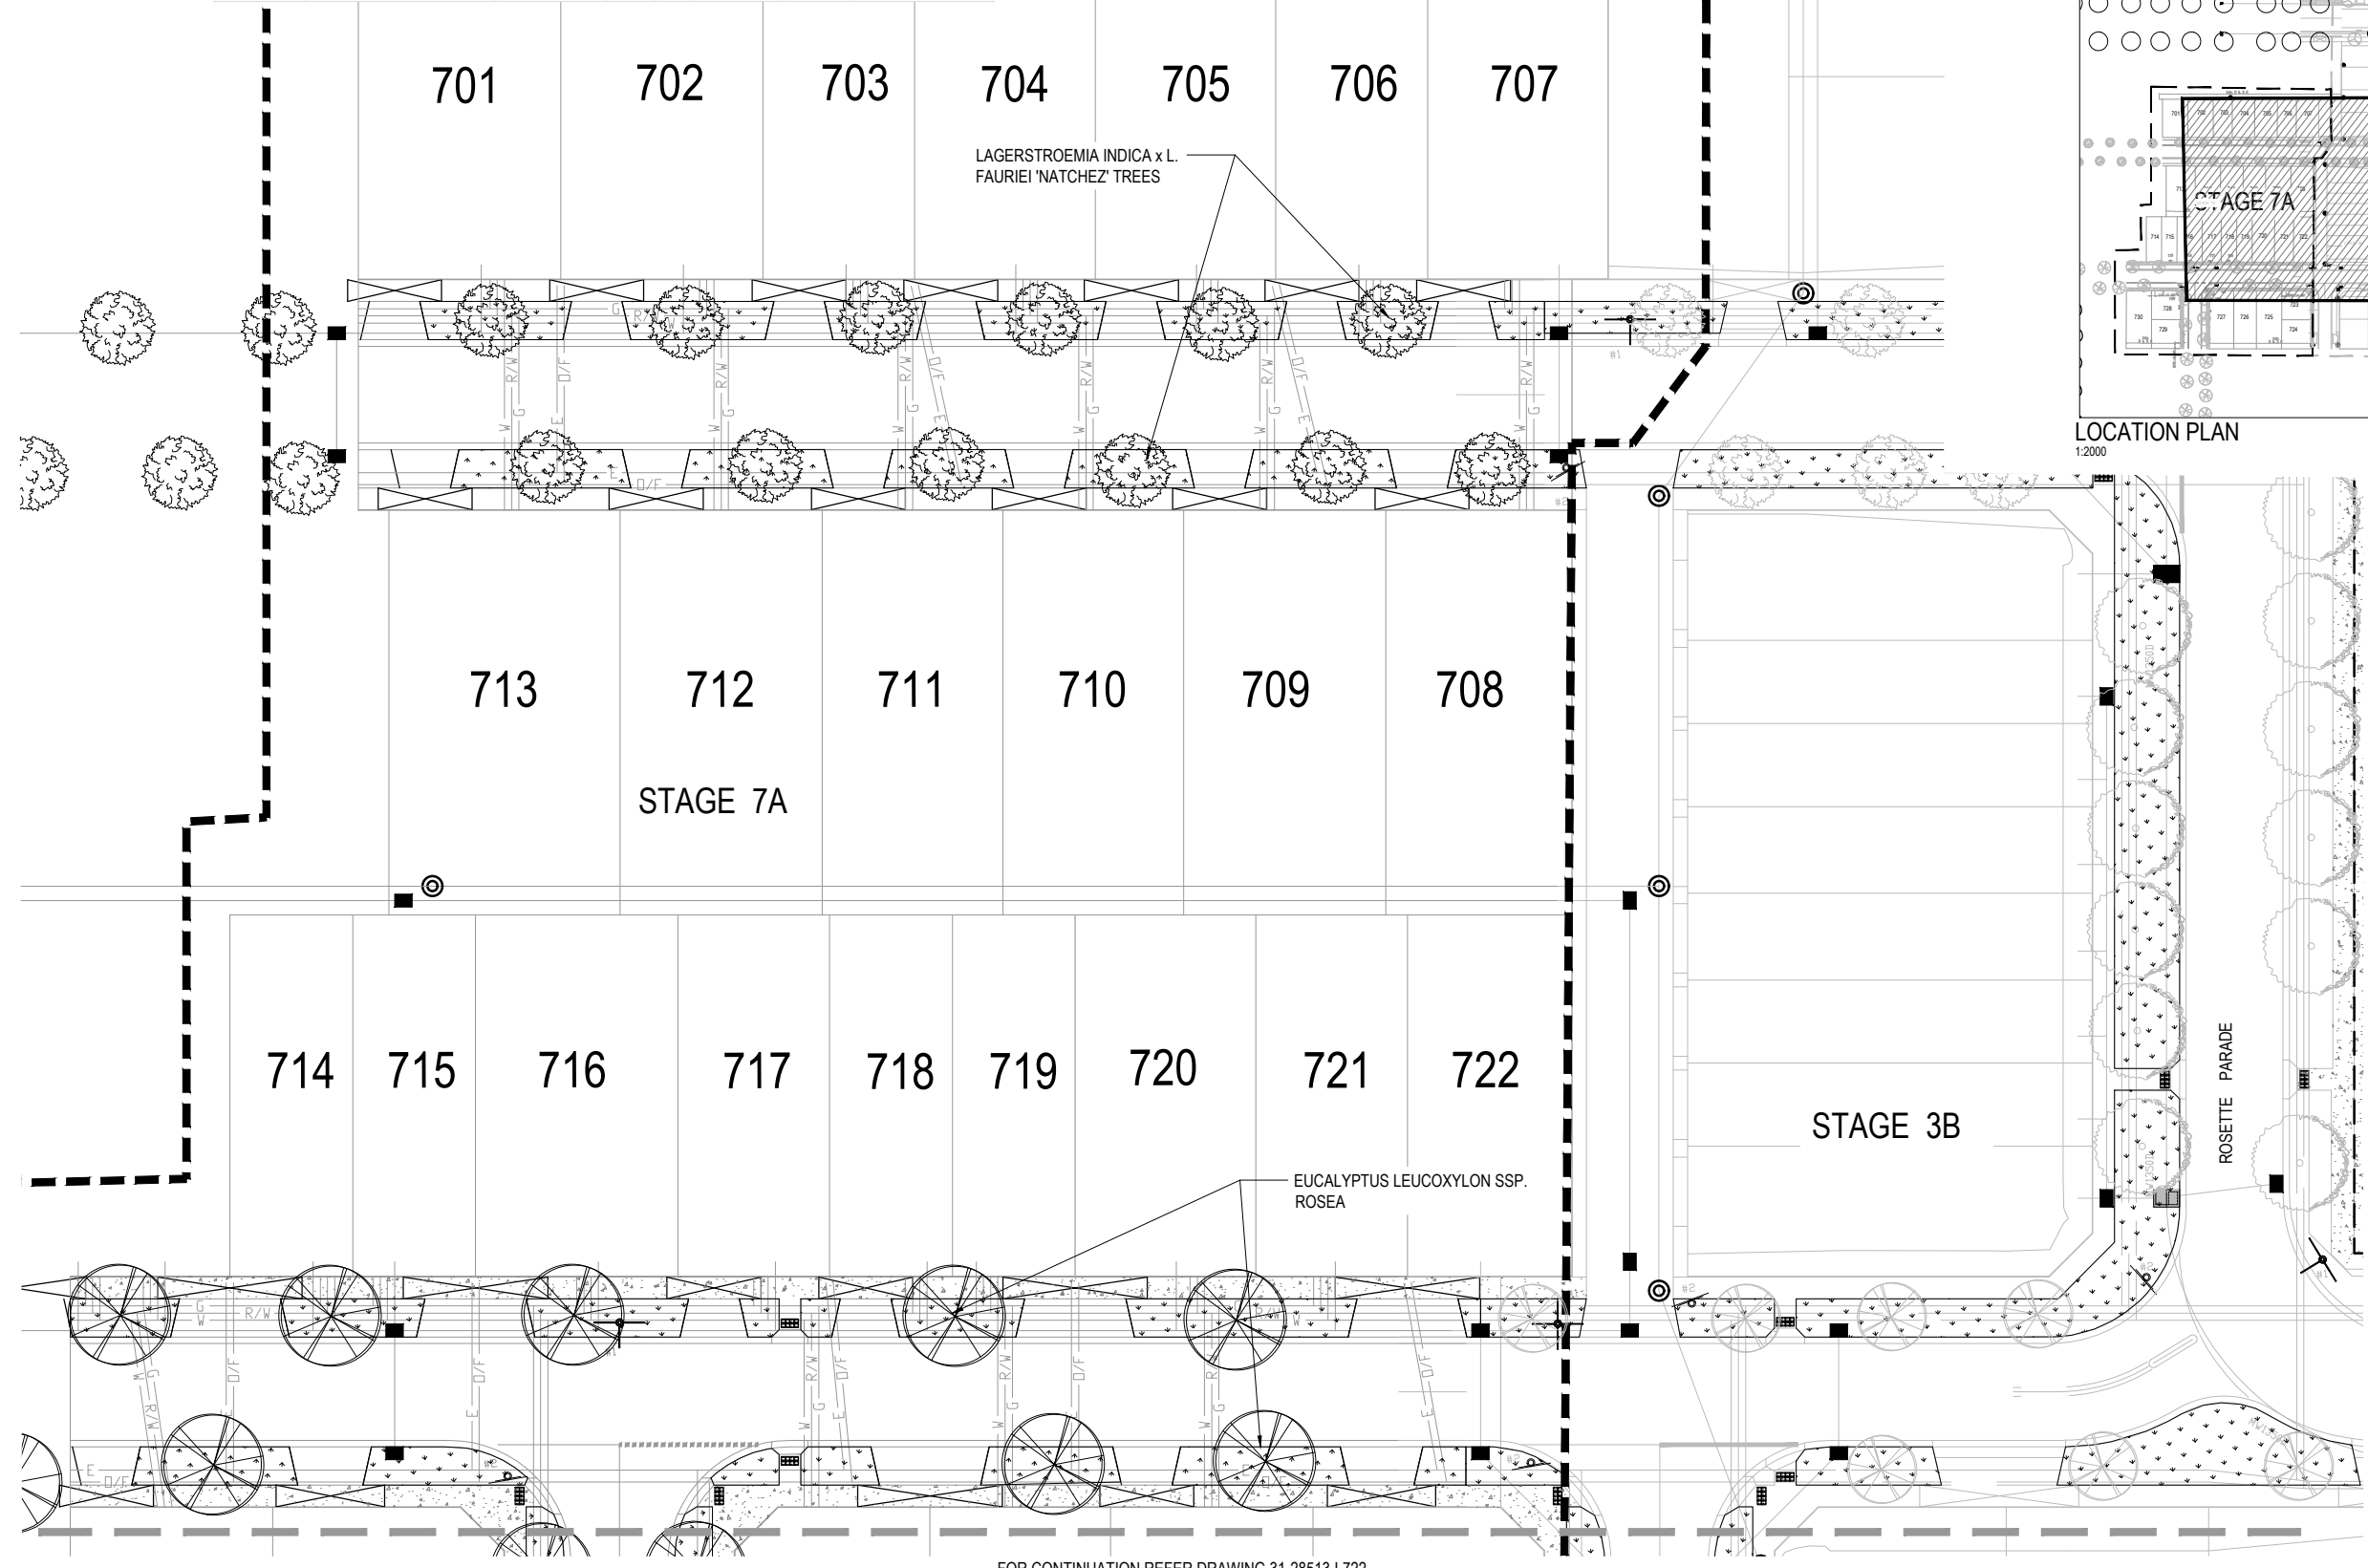

WARNING
ALL SERVICES SHOWN ON THIS DRAWING ARE APPROXIMATE ONLY AND EXACT LOCATION IS TO BE CONFIRMED ON SITE BY CONTRACTOR PRIOR TO COMMENCEMENT OF ANY WORKS.

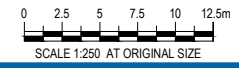

AS BUILT

FOR CONTINUATION REFER DRAWING 31-28513-L722

No	Revision	Note: * indicates signatures on original issue of drawing or last revision of drawing	Drawn	Job Manager	Project Director	Date
A	FIRST ISSUE		KC	GC	SG	09.04.14



DO NOT SCALE
Conditions of Use.
This document may only be used by GHD's client (and any other person who GHD has agreed can use this document) for the purpose for which it was prepared and must not be used by any other person or for any other purpose.

Drawn	Designer
Drafting Check	Design Check
Approved (Project Director)	Date
Scale 1:250	This Drawing must not be used for Construction unless signed as Approved

Client	VILLAWOOD PROPERTIES
Project	TRILLIUM DEVELOPMENT
Title	STAGE 7A - STREETSAPES GENERAL LANDSCAPE WORKS
Original Size	A1 Drawing No: 31-28513-L721
Rev:	A