



FOR CONTINUATION REFER DRAWING 31-28513-L721



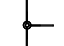
713 712 711 710 709 708

714 715 716 717 718 719 720 721 722

REFER SHEET
31-28513-L721

LOCATION PLAN
1:2000

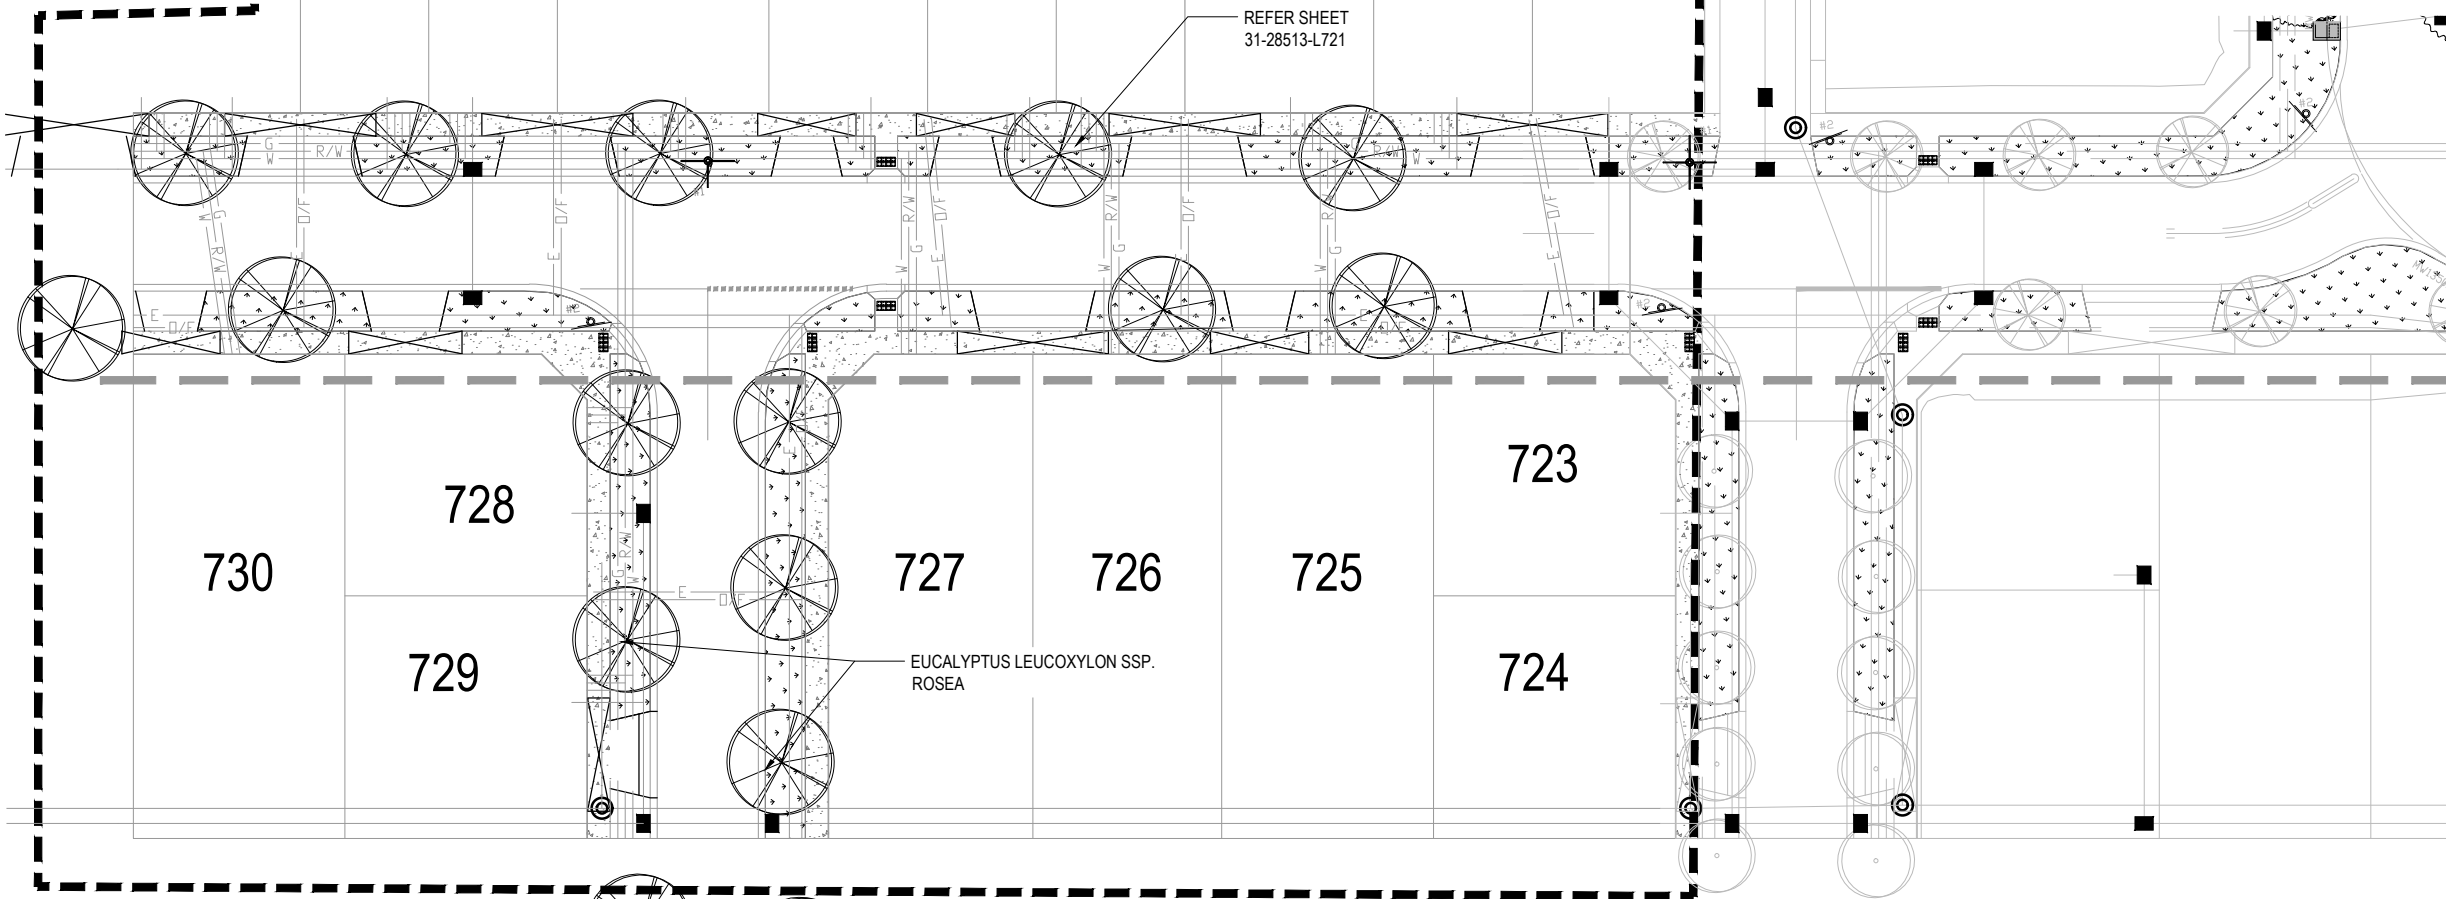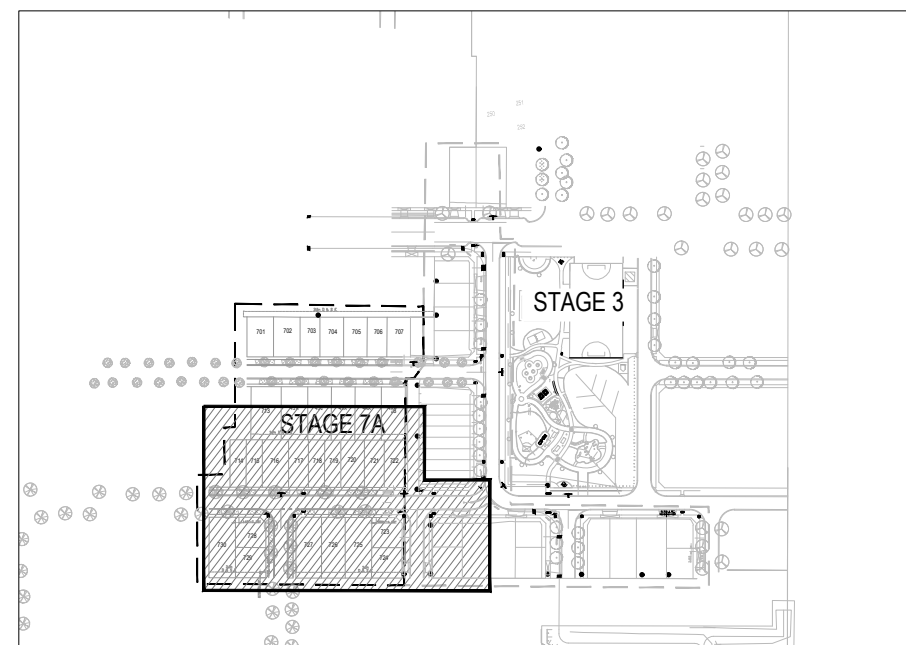

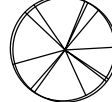-  *Eucalyptus leucoxylon ssp. Rosea*
-  SEWER COVER
-  STREET SIGN LOCATION

EUCALYPTUS LEUCOXYLON SSP.
ROSEA

PLANT SCHEDULE STAGE 7A STREET TREES					
CODE	SPECIES	COMMON NAME	PLANT S/m ²	COMP %	PLANT SIZE
ADVANCE TREE PLANTING STREETSAPES					
EUC leu	<i>Eucalyptus leucoxylon ssp. Rosea</i>	RED FLOWERING YELLOW GUM	AS SHOWN		45 Litre 30mm CAL 2.5m HIGH




WARNING
ALL SERVICES SHOWN ON THIS DRAWING ARE APPROXIMATE ONLY AND EXACT LOCATION IS TO BE CONFIRMED ON SITE BY CONTRACTOR PRIOR TO COMMENCEMENT OF ANY WORKS.



AS BUILT

No	Revision	Note: * indicates signatures on original issue of drawing or last revision of drawing	Drawn	Job Manager	Project Director	Date
A	FIRST ISSUE		KC	GC	SG	09.04.14

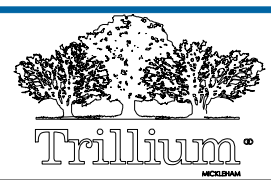

DO NOT SCALE Conditions of Use. This document may only be used by GHD's client (and any other person who GHD has agreed can use this document) for the purpose for which it was prepared and must not be used by any other person or for any other purpose.	Drawn	Designer
	Drafting Check	Design Check
	Approved (Project Director) Date	
	Scale 1:250	This Drawing must not be used for Construction unless signed as Approved

Client	VILLAWOOD PROPERTIES
Project	TRILLIUM DEVELOPMENT
Title	STAGE 7A - STREETScape GENERAL LANDSCAPE WORKS
Original Size	A1
Drawing No:	31-28513-L722
Rev:	A