


SHEET INDEX

- 1
- LOCALITY PLAN, SHEET INDEX, GENERAL NOTES & TYPICAL PAVEMENT CROSS SECTION
- 2
- SITE SPECIFIC NOTES & HUME CITY COUNCIL NOTES
- 3
- DETAIL PLAN & SERVICE OFFSET TABLE
- 4
- MELODY WAY LONGITUDINAL & CROSS SECTIONS
- 5
- MELODY WAY CROSS SECTIONS
- 6
- PRIME STREET LONGITUDINAL SECTION
- 7
- PRIME STREET CROSS SECTIONS
- 8
- PRIME STREET CROSS SECTIONS
- 9
- DRAINAGE LONGITUDINAL SECTIONS
- 10
- DRAINAGE LONGITUDINAL SECTIONS
- 11
- PIT SCHEDULE
- 12
- PARKING PLAN
- 13
- EARTHWORKS PLAN
- 14
- TEMPORARY CUTOFF DRAIN & TEMPORARY OUTFALL

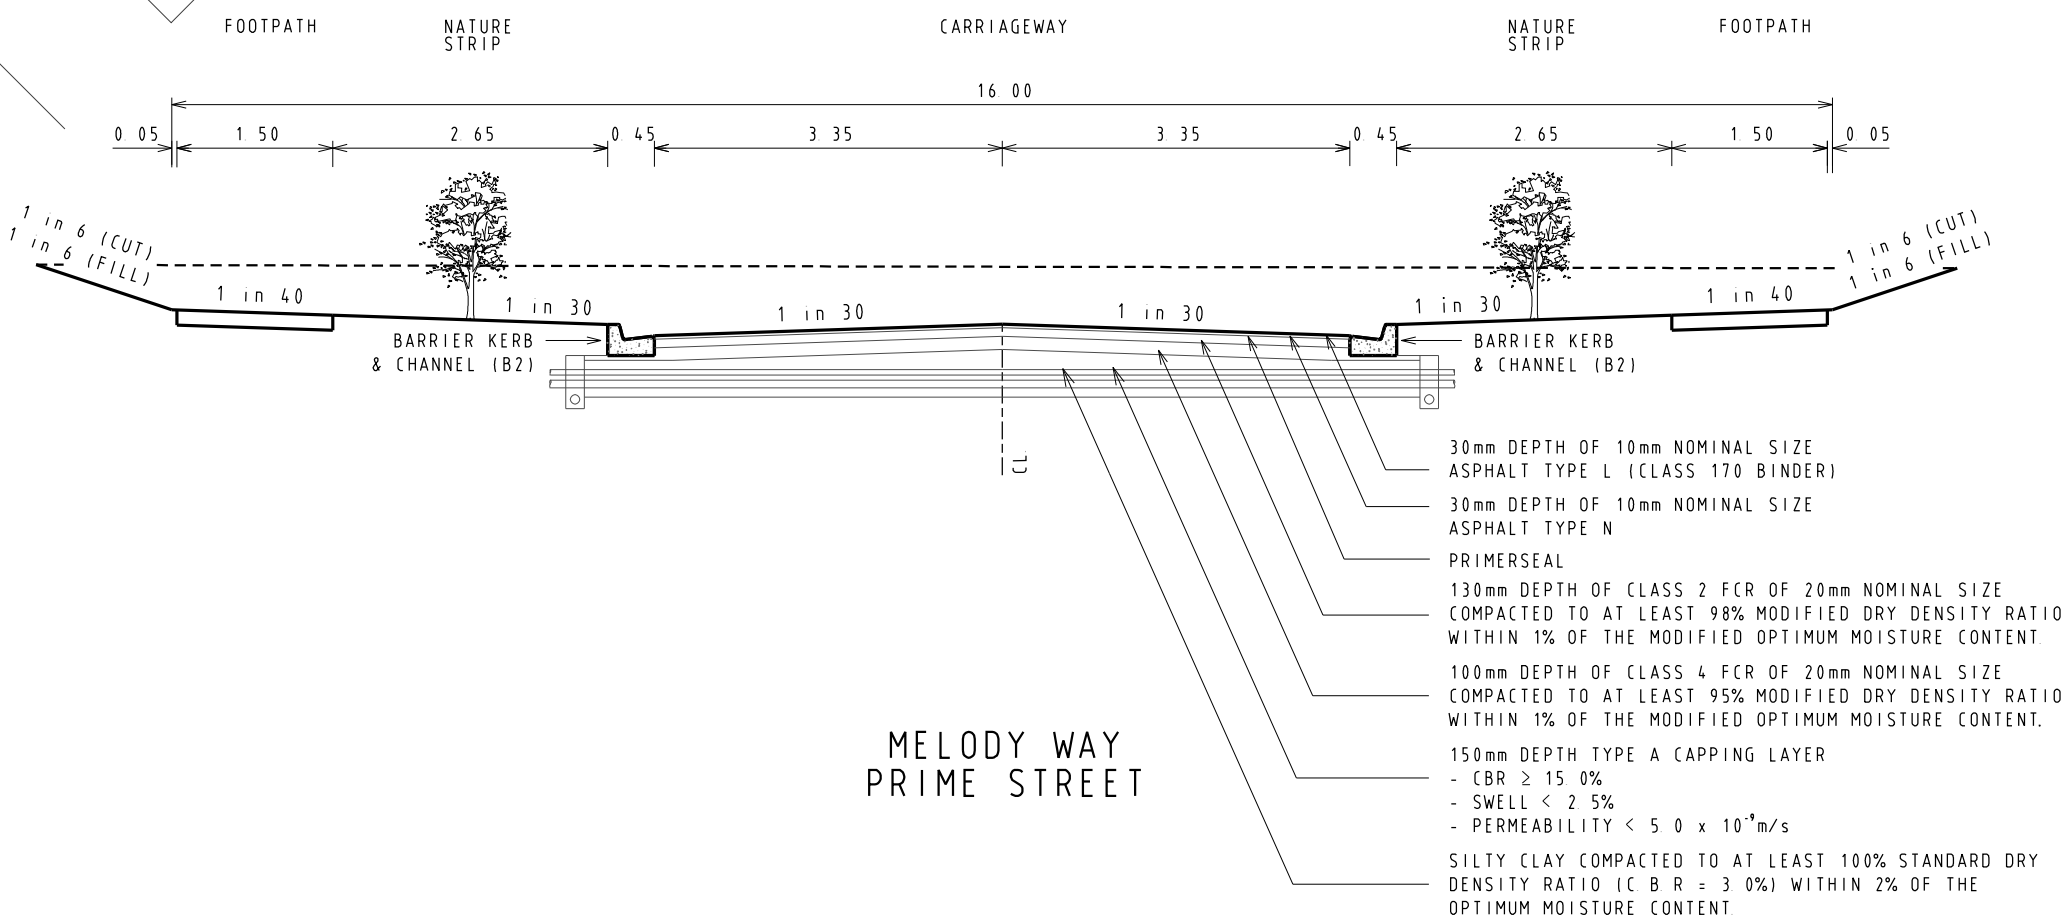

GENERAL NOTES

- UNLESS NOTED OTHERWISE :
- 1
- ALL LEVELS AND DIMENSIONS ARE IN METRES (UNO)
- 2
- ALL WORKS ARE TO BE CARRIED OUT IN ACCORDANCE WITH THE RELEVANT STANDARDS, DRAWINGS AND SPECIFICATIONS OF THE RELEVANT MUNICIPAL AND STATUTORY AUTHORITIES (CURRENT AT THE TIME OF CONSTRUCTION), AND THE AUSTRALIAN STANDARD GENERAL CONDITIONS OF CONTRACT AS 2124-1992
- 3
- THE CONTRACTOR SHALL CHECK LOCATION AND DEPTH OF ALL EXISTING SERVICES, INCLUDING THOSE WHICH MAY HAVE BEEN ABANDONED, PRIOR TO THE COMMENCEMENT OF ANY WORKS. ANY DISCREPANCIES ARE TO BE REPORTED TO THE ENGINEER.
- 4
- FINAL LOCATION OF SERVICE CONDUITS, HOUSE DRAINS AND VEHICLE CROSSINGS SHALL BE DETERMINED ON-SITE BY THE ENGINEER WHERE REQUIRED. CONDUITS FOR GAS AND WATER ARE TO BE A MINIMUM OF 4 METRES CLEAR OF SIDE BOUNDARIES WHERE PRACTICAL. WATER SERVICE LOCATIONS TO BE DETERMINED IN CONJUNCTION WITH WATERMAIN SUBCONTRACTOR.
- 5
- THE WORKS ARE TO INCLUDE THE COMPLETE GRADING AND REINSTATEMENT OF DISTURBED AREAS, INCLUDING RESURFACING WITH 150MM MINIMUM DEPTH OF APPROVED TOPSOIL, SOWN TO THE SATISFACTION OF THE ENGINEER.
- 6
- THE PLANS OF SUBDIVISION CERTIFIED BY COUNCIL ARE AN ANNEXURE TO THESE DRAWINGS.
- 7
- STANDARD DRAWINGS ISSUED BY COUNCIL ARE AN ANNEXURE TO THESE DRAWINGS.
- 8
- MELBOURNE WATER PLANS FOR THE ADJACENT WETLAND & OPEN WATER BODY ARE AN ANNEXURE TO THESE DRAWINGS.
- 9
- ALL DRAINAGE PIPES WITHIN EASEMENTS ARE AT 1 METRE CENTRELINE OFFSET UNLESS NOTED OTHERWISE.
- 10
- PERMISSION IS TO BE OBTAINED FROM THE WATER COMPANY FOR THE USE OF WATER SUPPLY FOR CONSTRUCTION PURPOSES.
- 11
- THE 'SCHEDULE OF QUANTITIES' ARE AN ANNEXURE TO THESE DRAWINGS. IT IS THE RESPONSIBILITY OF THE CONTRACTOR TO VERIFY THAT THE 'SCHEDULE OF QUANTITIES' ACCURATELY REFLECTS THE INFORMATION DETAILED IN THESE PLANS. ALL DISCREPANCIES SHOULD BE REPORTED BACK TO THE ENGINEER PRIOR TO SIGNING OF CONTRACTS. NO ALLOWANCES WILL BE MADE FOR DISCREPANCIES ONCE CONTRACTS HAVE BEEN SIGNED.
- 12
- THESE PLANS ARE FOR SUBDIVISION CONSTRUCTION PURPOSES ONLY.
- 13
- THESE PLANS MAY NOT BE REPRODUCED EXCEPT IN FULL.

REVISIONS			SCALE: AS SHOWN	
DATE	DETAILS	AUTHORISED	DATE PRINTED:	16/04/2014
16/04/14	M	AS CONSTRUCTED	ASC	LEVEL DATA: K:\36182\36182\LTPO
11/03/14	L	LOT 501 & 512 CROSSEVER AMENDED	ASC	DATUM: AHD
3/12/13	K	LOT 501, 511, 512 & 524 PROPERTY SERVICE & HOUSE DRAIN RELOCATION	ASC	PROJECT No.: 36182/5A
2/12/13	J	LOT 511 CROSSEVER RELOCATION	ASC	DRAWN: C.M.B. DATE: MAY 2013
29/10/13	I	CROSSEVER AMENDMENTS	ASC	DESIGNED: Z.W.L. DATE: MAY 2013
FILENAME K:\36182\36182 5\dgn\R01.dgn			AUTHORISED: A.S.C.	DATE: MAY 2013




MORNINGTON
5 Main Street,
P.O. Box 171, 3931
Phone: (03) 5975 4444
Fax: (03) 5975 3916
OX 9318 Mornington

MELBOURNE
The Melbourne Suite 2
250 St. Kilda Road,
Melbourne, 3004
Phone: (03) 9697 8000
Fax: (03) 9697 8099


HUME CITY COUNCIL
VILLAWOOD PROPERTIES P/L
TRILLIUM STAGE 5A
MICKLEHAM
ROAD AND DRAINAGE PLANS

LOCALITY PLAN, SHEET INDEX,
GENERAL NOTES & TYPICAL
PAVEMENT CROSS SECTION


PLAN NUMBER
36182/5A
R01
REVISION
M
SHEET 1 OF 14

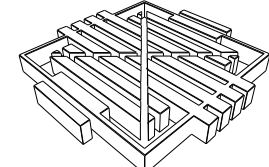HUME CITY COUNCIL NOTES				SITE SPECIFIC NOTES																																																							
1	ALL WORKS TO BE CARRIED OUT IN ACCORDANCE WITH HUME CITY COUNCIL STANDARD DRAWINGS, SPECIFICATIONS, APPROVED PLANS AND TO THE SATISFACTION OF THE CHIEF EXECUTIVE OFFICER AND/OR THEIR REPRESENTATIVE	23	ALL SERVICE CONDUITS TRENCHES UNDER ROAD PAVEMENTS ARE TO BE BACKFILLED WITH 20mm 3% CEMENT TREATED CLASS 3 CRUSHED ROCK COMPACTED TO A DENSITY NOT LESS THAN 95% OF THE MAXIMUM DRY DENSITY VALUE DETERMINED BY THE MODIFIED COMPACTION TEST IN ACCORDANCE WITH A S 1289 5 2 1-2003	1	ALL CONSTRUCTION TRAFFIC, STORAGE AND COMPOUNDS ARE TO BE LIMITED TO THE SITE OF WORKS THE FUTURE STAGE AREA IS TO BE KEPT UNDISTURBED, EXCEPT FOR SPECIFIC WORKS																																																						
2	COUNCIL TO BE NOTIFIED SEVEN (7) CLEAR WORKING DAYS PRIOR TO THE COMMENCEMENT OF WORKS WITH A PRECOMMENCEMENT MEETING BEING HELD BETWEEN HUME CITY COUNCIL, THE CONSULTANT AND THE CONTRACTOR BEFORE WORKS COMMENCE. A SITE MANAGEMENT PLAN IS TO BE SUBMITTED PRIOR TO COMMENCEMENT OF WORKS AND PRIOR TO AN ONSITE PRECOMMENCEMENT MEETING	24	ALL STORMWATER DRAINS ARE TO BE CLASS 2 R C OR RIGID F R C PIPES WITH ADCOL FLEXIBLE COLLARS UNLESS NOTED OTHERWISE. ALL PIPES UP TO AND INCLUDING 600mm DIA ARE TO BE RUBBER RING JOINTED. INTERLOCKING / FLUSH JOINTS WITH EXTERNAL BANDS CAN ONLY BE USED ON PIPE SIZES OVER 600mm DIA	2	THE CONTRACTOR SHALL BE RESPONSIBLE FOR APPROPRIATE SILTATION CONTROL DURING THE CONSTRUCTION AND MAINTENANCE PERIODS																																																						
3	PRIOR TO COMMENCEMENT OF THE WORKS, THE CONTRACTOR SHALL PROVIDE THE FOLLOWING INFORMATION a) SOURCE OF QUARRY MATERIAL b) N A T A APPROVED TESTS RESULTS FOR THE F C R THAT IS TO BE USED c) IF THE SOURCE OF THE QUARRY MATERIAL IS CHANGED DURING THE COURSE OF THE WORKS, THEN NEW TEST RESULTS SHALL BE PROVIDED	25	WHERE NEW ASPHALT, CONCRETE K & C, PATHS AND DRIVEWAYS MATCH INTO EXISTING, THE EXISTING SURFACE IS TO BE SAW CUT AND MATCHED NEATLY	3	FILLING IN ALL PROPERTIES AND ROAD RESERVES IS TO BE CARRIED OUT USING APPROVED CLAY FILL TOP SOIL AND ALL VEGETABLE MATTER TO BE STRIPPED FROM SITE PRIOR TO FILLING. ALL FILLING TO BE CARRIED OUT IN 150mm LAYERS AND COMPACTED TO 95% OF MAXIMUM DRY DENSITY. ALL FILLING TO COMPLY WITH AS3798 - 2007, SECTION 8.2, LEVEL 1.																																																						
4	PRIOR TO COMMENCEMENT OF WORKS ON SITE, THE CONTRACTOR MUST ENSURE THAT ALL MATTERS RELATING TO THE OCCUPATIONAL HEALTH AND SAFETY ACT 1985, HAVE BEEN AND WILL BE COMPLIED WITH	26	ALL REDUNDANT ASSETS ARE TO BE REMOVED AND DISPOSED OFF SITE	4	ALL SERVICES TRENCHES UNDER PAVEMENT WORKS ARE TO BE BACKFILLED WITH FCR AS SPECIFIED																																																						
5	ON COMMENCEMENT OF CONSTRUCTION WORKS, THE CONTRACTOR MUST COMPLY WITH THE RECOMMENDATIONS OF THE ENVIRONMENT PROTECTION AUTHORITY PUBLICATION "CONSTRUCTION TECHNIQUES FOR SEDIMENT POLLUTION CONTROL ". APPROPRIATE SILTATION CONTROL IS TO BE MAINTAINED THROUGHOUT THE CONSTRUCTION AND MAINTENANCE PERIOD OF THE WORKS	27	ALL TREES AND SHRUBS ARE TO BE RETAINED UNLESS OTHERWISE SHOWN OR DIRECTED BY THE CHIEF EXECUTIVE OFFICER AND/OR THEIR REPRESENTATIVE	5	ANY CYPRESS OR PINE TREES MUST BE REMOVED FROM THE SITE PRIOR TO THE COMMENCEMENT OF WORKS, AND COUNCIL'S LANDSCAPE OFFICER MUST BE CONSULTED PRIOR TO EITHER THE REMOVAL, OR RETENTION OF ANY OTHER TREES. NO TOPSOIL SHALL BE REMOVED FROM SITE																																																						
6	THE DISPOSAL SITE FOR SPOIL REMOVAL FROM SITE AND TRUCK ROUTE IS TO BE SUBMITTED TO AND APPROVED BY THE CHIEF EXECUTIVE OFFICER AND/OR THEIR REPRESENTATIVE IN WRITING PRIOR TO THE COMMENCEMENT OF ANY WORKS	28	AT THE COMPLETION OF ALL WORKS, ALL RUBBISH, DEBRIS AND SURPLUS SPOIL SHALL BE REMOVED AND THE SITE SHALL BE CLEARED TO THE SATISFACTION OF THE CHIEF EXECUTIVE OFFICER AND/OR THEIR REPRESENTATIVE	6	AG DRAIN TO BE CONSTRUCTED BEHIND ALL KERB AND CHANNEL																																																						
7	WHERE WORKS ARE IN THE VICINITY OF EXISTING SERVICES, THESE SERVICES ARE TO BE LOCATED AND EXPOSED/PROVED PRIOR TO COMMENCEMENT OF WORKS, AND THE RELEVANT AUTHORITIES NOTIFIED SEVEN (7) CLEAR DAYS PRIOR TO THE COMMENCEMENT OF THE WORKS	29	ALL DRAINS BEHIND KERB AND CHANNEL SHALL BE BACKFILLED TO MATCH PAVEMENT SUBGRADE LEVEL WITH 20mm CLASS 2 F C R COMPACTED TO 95% OF THE MAXIMUM DRY DENSITY VALUE DETERMINED BY THE MODIFIED COMPACTION TEST IN ACCORDANCE WITH A S 1289 5 2 1-2003	7	ALL DRAINAGE PIPES GREATER THAN 150mm TO BE R R J CLASS 2 (UNO)																																																						
8	ALL DIMENSIONS ARE IN METRES UNLESS NOTED OTHERWISE	30	PAVEMENT DEPTH SPECIFIED IS A MINIMUM DEPTH AND MAY BE VARIED BY THE CHIEF EXECUTIVE OFFICER AND/OR THEIR REPRESENTATIVE. SOFT SPOTS SHALL BE EXCAVATED TO A PROOF ROLLED BASE AND BACKFILLED WITH APPROVED MATERIAL COMPACTED IN 150mm LAYERS TO ACHIEVE TO A DENSITY NOT LESS THAN 95% OF THE MAXIMUM DRY DENSITY VALUE DETERMINED BY THE STANDARD COMPACTION TEST IN ACCORDANCE WITH A S 1289 5 1 1-2003	8	ACCESS TO EXISTING RESIDENCE TO BE MAINTAINED AT ALL TIMES DURING CONSTRUCTION																																																						
9	ALL LEVELS ARE TO AUSTRALIAN HEIGHT DATUM (AHD)	31	ALL EXISTING ASSETS AFFECTED BY THE WORKS; EG SIGNS, VEHICLE CROSSINGS, FOOTPATHS, KERB AND LINEMARKING SHALL BE REINSTATED BY THE CONTRACTOR PRIOR TO THE COMPLETION OF THE WORKS TO THE SATISFACTION OF THE CHIEF EXECUTIVE OFFICER AND/OR THEIR REPRESENTATIVE	9	ALL DRAINAGE LINES UNDER PAVEMENTS, PARKING BAYS, ETC AND WHERE TRENCH IS WITHIN 150mm OF BACK OF KERB ARE TO BE BACKFILLED WITH FCR AS SPECIFIED																																																						
10	THE CONTRACTOR MUST ARRANGE THE REQUISITE INSPECTIONS OF THE WORKS WITH THE CHIEF EXECUTIVE OFFICER AND/OR THEIR REPRESENTATIVE AS PER THE HOLD POINTS IN THE HUME CITY COUNCIL SPECIFICATIONS	32	ALL FIRE HYDRANTS ARE TO BE MARKED IN ACCORDANCE WITH "IDENTIFICATION OF STREET HYDRANTS FOR FIREFIGHTING PURPOSES" PUBLICATION (DEVELOPED BY C F A, M F E S B & N R E). MARKINGS TO BE VIA BLUE PAVEMENT MARKER AND A (RED TOPPED) WHITE POST	10	APPROPRIATE INSPECTIONS SHALL BE ORGANISED WITH HUME CITY COUNCIL'S COUNCIL WORKS SUPERVISOR																																																						
11	FILL AREAS TO BE STRIPPED OF TOPSOIL, FILLED AND TOPSOIL REPLACED TO OBTAIN FINAL FILL LEVELS AS SHOWN ON PLAN. FILLING IS TO BE CLEAN CLAY COMPACTED TO A DENSITY NOT LESS THAN 95% OF THE MAXIMUM DRY DENSITY VALUE DETERMINED BY THE STANDARD COMPACTION TEST IN ACCORDANCE WITH A S 1289 5 1 1-2003	33	AGRICULTURAL DRAINS ARE TO BE PLACED BEHIND ALL KERB AND CHANNEL, KERB ONLY AND EDGE STRIPS IN ACCORDANCE WITH COUNCIL STANDARD DRAWINGS	11	REFER SEPARATE PLAN FOR WORKS ASSOCIATED WITH SEWER, WATER SUPPLY, ELECTRICITY SUPPLY, TELSTRA AND GAS SUPPLY. THESE SERVICES ARE SHOWN ON THE DETAIL PLAN INDICATIVELY ONLY & MAY BE SUBJECT TO MINOR VARIATIONS																																																						
12	FILLING TO COMPLY WITH A S 3798-1996 APPENDIX B, LEVEL 1 (OR 2) AS SPECIFIED	34	ALL TABLE DRAINS AND VERGES ARE TO BE REINSTATED UPON COMPLETION OF WORKS TO THE SATISFACTION OF THE CHIEF EXECUTIVE OFFICER AND/OR THEIR REPRESENTATIVE	12	THE CONTRACTOR SHALL BE RESPONSIBLE FOR THE EXCAVATION AND BACKFILLING OF TRENCHING FOR RETICULATION ELECTRICITY AND COMMUNICATION CABLES, AND THE REMOVAL OF EXCESS SPOIL																																																						
13	THE CONTRACTOR IS RESPONSIBLE FOR ENSURING THAT ALL IMPORTED FILL MATERIAL, INCLUDING TOPSOIL, SATISFIES THE DESCRIPTION FOR CLEAN FILL MATERIAL IN EPA BULLETIN PUBLICATION NO 448 (SEPT '95) AND SUBSEQUENT REVISIONS. THE CONTRACTOR SHALL IF REQUIRED PROVIDE VERIFICATION INCLUDING TEST CERTIFICATES TO THE CHIEF EXECUTIVE OFFICER AND/OR THEIR REPRESENTATIVE	35	ALL TRAFFIC CONTROL MEASURES, SIGNS AND LINEMARKING SHALL BE IN ACCORDANCE WITH A S 1742 - 1, 2 & 3. STREET NAME SIGNS ARE TO BE IN ACCORDANCE WITH STANDARD DRAWING SD408	13	MINIMUM FALL ON ALL LOTS TO BE 1 IN 150 LONGITUDINALLY																																																						
14	WHERE, AS A CONDITION OF THE PLANNING PERMIT OR AS A RESULT OF THE PRECONSTRUCTION MEETING, FENCING OF AREAS CONTAINING TREES, NATIVE GRASSES AND SHRUBS IS REQUIRED, A THREE STRAND STAR PICKET AND WIRE FENCE SHALL BE CONSTRUCTED	36	ALL LINEMARKING PAINT SHALL BE LONG LIFE TYPE IN ACCORDANCE WITH SECTION 95C OF THE HUME CITY COUNCIL SPECIFICATIONS. LATERAL WORKS AND ARROWS BEING COLD APPLIED PLASTIC TROWELLED INTO PLACE (MATERIAL DEGADUR PLASTELINE) AND LONGITUDINAL LINES BEING EXTRUDED THERMOPLASTIC MATERIAL	14	PAVEMENT DEPTH TO BE MODIFIED AS DIRECTED BY HUME CITY COUNCIL																																																						
15	NO TREE OR NATIVE VEGETAION IS TO BE DISTURBED OR REMOVED WITHOUT PRIOR APPROVAL FROM COUNCILS SUSTAINABLE ENVIRONMENT DEPARTMENT. ANY TREES REMOVED, VEGETATION OR OTHER MATERIALS ARE NOT TO BE BURNT ON SITE	37	ALL SIGNS TO BE CLASS 1 HIGH INTENSITY TYPE AND TO COMPLY WITH THE REQUIREMENTS OF A S 1743 - 2001	15	USE OF ANY SOFT RIPPED ROCK IN ROAD PAVEMENT IS TO CONFORM TO SPECIFICATIONS FOR RIPPED ROCK																																																						
16	BEFORE COMMENCING WORK ON TRENCHES IN EXCESS OF 1.5m DEEP, NOTICE OF SUCH PROPOSAL IS TO BE FORWARDED BY THE CONTRACTOR TO WORKSAFE VICTORIA	38	HOUSE DRAIN CONNECTIONS TO 150mm DIAMETER PIPES TO BE VIA A MANUFACTURED JUNCTION PIECE. 150mm DIAMETER STORMWATER PIPES ARE TO BE HEAVY DUTY SEWER GRADE PVC PIPES SHALL BE BACKFILLED WITH 10mm MINUS F C R TO 150mm ABOVE TOP OF PIPE IN ALL LOCATIONS	16	ALL WORKS TO BE CARRIED OUT IN ACCORDANCE WITH CURRENT HUME CITY COUNCIL SPECIFICATIONS AND STANDARD DRAWINGS, AND TO THE SATISFACTION OF HUME CITY COUNCIL SUPERVISING ENGINEER																																																						
17	THE CONTRACTOR IS TO OBTAIN A BUILDING PERMIT FOR ANY STRUCTURES / FENCES AND FOR ANY RETAINING WALLS OVER 1.0m IN HEIGHT	39	100mm HOUSE DRAIN CONNECTIONS TO BE LAID AT AN OFFSET OF 5.0m FROM THE LOW SIDE TITLE BOUNDARY AND PROPERTY INLETS 1.0m FROM THE LOW CORNER OF THE LOT UNLESS OTHERWISE SHOWN	17	NO CUT OR FILL EXTENDS INTO BUILDING ENVELOPES, EXCEPT WHERE SHOWN																																																						
18	ANY INFRASTRUCTURE DAMAGE DURING THE DEFECTS LIABILITY PERIOD IS THE RESPONSIBILITY OF THE DEVELOPER OR HIS REPRESENTATIVE AND IS TO BE REINSTATED TO THE SATISFACTION OF THE CHIEF EXECUTIVE OFFICER OR HIS REPRESENTATIVE	40	BLASTING GENERALLY IS NOT ENCOURAGED, HOWEVER BLASTING MAY BE REQUIRED AS A LAST RESORT DEPENDING ON GROUND CONDITIONS. COUNCIL IS TO BE NOTIFIED IN WRITING IF ANY BLASTING IS NECESSARY. RESIDENTS LIKELY TO BE AFFECTED BY THE BLASTING AND ALL SERVICE AUTHORITIES SHALL BE NOTIFIED IN WRITING PRIOR TO WORKS COMMENCING. COPIES OF THESE NOTIFICATIONS ARE TO BE SUBMITTED TO COUNCIL. RESIDENT NOTIFICATION LETTER IS TO INCLUDE BLASTING GUIDELINES, FIRING AND MISFIRE PROCEDURES AND CONTRACTOR AND CONSULTANT CONTACT NAMES AND PHONE NUMBERS. ALL BLASTING IS TO BE WITHIN THE LIMITS FOR AIR AND GROUND VIBRATION LEVELS AS SET DOWN IN A S 2187 2-1993. ALL BLASTS SHALL BE MONITORED FOR AIR AND NOISE VIBRATION AT POTENTIALLY AFFECTED RESIDENCES. "FORM A" FROM AS 2187 2-1993, AND WAVE TRACE COPIES ARE TO BE SUBMITTED TO COUNCIL FOR EACH BLAST. BLASTING IS TO BE RESTRICTED TO BETWEEN 9:00am AND 3:30pm. BLASTING IS NOT TO OCCUR ON WEEKENDS OR PUBLIC HOLIDAYS. BLASTING AREA SIGNS ARE TO BE PLACED AT ALL ENTRANCES TO THE SITE	18	THE CONTRACTOR SHALL CONTACT JEMENA'S JOHN HEMSLEY (03) 93512214 FOR THE COORDINATION OF ELECTRICAL WORKS, AT LEAST 28 DAYS PRIOR TO THE COMMENCEMENT OF CONSTRUCTION OF ELECTRICAL WORKS																																																						
19	ALL DISTURBED AREAS, ie, NATURESTRIPS, BATTERS, ALLOTMENTS & RESERVES, ARE TO BE REINSTATED TO A CLEAN, TIDY CONDITION, TOP DRESSED (100mm LOAMY TOP SOIL FREE OF CLUMPS, SODS AND CLAY LUMPS) AND SOWN WITH GRASS SEED. SEED IS TO BE A DROUGHT TOLERANT COUCH/FESCUE MIX UNLESS OTHERWISE DETAILED. BLEND IS GENERALLY AS FOLLOWS: 40% Dwarf Tall Fescue - drought tolerant cultivars 40% Couch 20% Hard Fescue NOTE: GRASS IS TO BE ESTABLISHED PRIOR TO THE END OF THE MAINTENANCE PERIOD			19	THE CONTRACTOR SHALL CONTACT TELSTRA'S NOMINATED REPRESENTATIVE, PETER FEBO (03) 9632 6384 FOR THE COORDINATION OF TELSTRA WORKS IN LAYING CONDUITS, AT LEAST 28 DAYS PRIOR TO THE COMMENCEMENT OF CONSTRUCTION OF TELSTRA WORKS																																																						
20	FOOTPATHS ARE TO BE 50mm OFFSET FROM TITLE BOUNDARIES UNLESS NOTED OTHERWISE. VEHICLE CROSSING ALIGNMENTS ARE GENERALLY TO BE PARALLEL TO THE SIDE BOUNDARY			20	TELSTRA AND ELECTRICITY CABLES ARE TO BE PLACED IN A SHARED TRENCH																																																						
21	ALL NEW CONCRETE WORKS SHALL BE JOINED INTO ABUTTING EXISTING CONCRETE WITH 450mm LONG Y20 DOWEL BARS @ 600 CENTRES, UNLESS OTHERWISE SPECIFIED			21	ALL BATTERS SHALL BE BLENDED INTO THE NATURAL GROUND LEVEL TO THE SATISFACTION OF THE ENGINEER, 0.3M BERM REQUIRED AT TOE OF BATTERS HIGHER THAN 0.7M																																																						
22	ANY EXPOSED AGGREGATE CONCRETE WORKS TO BE ACHIEVED BY SANDBLASTING ONLY. WASHING AGGREGATE OFF WITH WATER IS NOT PERMITTED			22	DRIVEWAYS ARE TO BE CUT ONTO ALL ALLOTMENTS, AT MAXIMUM GRADE OF 1 IN 5 WHERE BATTERS HIGHER THAN 0.70M. CUT BATTERS ARE TO BE GRASSED AND MULCHED WITH A MIXTURE OF CHOPPED GRASS, HAY, STRAW AND BITUMINOUS EMULSION																																																						
				23	INVERT LEVEL OF PROPERTY INLETS TO BE MINIMUM OF 500mm BELOW FINISHED SURFACE LEVELS AS PER HUME CITY COUNCIL STANDARDS																																																						
				24	SIGNS, MARKINGS AND DELINEATORS TO BE INSTALLED ON ROADS AS APPLICABLE IN ACCORDANCE WITH AS1742.2. ALL LINE MARKING TO BE LONG LIFE ROAD MARKING, WITH LONGITUDINAL LINES IN THERMOPLASTIC AND TRANSVERSE MARKINGS IN COLD APPLIED																																																						
				25	STREET SIGNS ARE TO BE TO CURRENT HUME CITY COUNCIL STANDARD'S, INCLUDING PROVISION OF LOGO																																																						
				26	REFER TO SHEET 4, 5 & 6 FOR PSM LOCATIONS																																																						
				27	CONDUIT LOCATIONS AND HOUSE DRAIN LOCATIONS ARE TO BE MARKED BY STAMP ON ALL PERMANENT CONCRETE WORKS IN ACCORDANCE WITH HUME CITY COUNCIL STANDARDS																																																						
				28	ALL PIT LIDS ARE TO BE TO CURRENT HUME CITY COUNCIL STANDARDS																																																						
				29	ALL VEHICLE CROSSINGS SHOWN ARE INDICATIVE ONLY. VEHICLE CROSSING ARE TO BE CONSTRUCTED AS PER HUME CITY COUNCIL STANDARDS																																																						
				30	TACTILE INDICATORS TO BE PROVIDED AT ALL PRAM CROSSINGS TO HUME CITY COUNCIL STANDARD'S AND IN ACCORDANCE WITH AUSTRALIAN STANDARD AS1428.4																																																						
				31	PEDESTRIAN CROSSINGS THROUGH ALL SPLITTER ISLAND TO BE AT PAVEMENT LEVEL																																																						
				32	ALL PIT FLOORS WITH LESS THAN 30mm DROP TO BE SHAPED TO ACCOMODATE DROP THROUGH PITS. NO ALLOWANCE FOR TOLERANCE HAS BEEN MADE WITH THE IL'S PROVIDED. ALL PITS TO BE CONSTRUCTED TO HUME CITY COUNCIL STANDARDS																																																						
				33	WHERE ANY EXISTING DAMS, OPEN DRAINS OR CHANNELS ARE TO BE FILLED, INVERT LEVELS MUST BE TAKEN PRIOR TO COMMENCEMENT OF FILLING AND THE LEVELS SHOWN ON THE 'AS-CONSTRUCTED' PLANS																																																						
<table><tr><th colspan="3">REVISIONS</th><th>SCALE:</th><th>AS SHOWN</th></tr><tr><th>DATE</th><th></th><th>DETAILS</th><th>AUTHORISED</th><th>DATE PRINTED:</th></tr><tr><td>16/04/14</td><td>M</td><td>AS CONSTRUCTED</td><td>ASC</td><td>16/04/2014</td></tr><tr><td>11/03/14</td><td>L</td><td>LOT 501 & 512 CROSSOVER AMENDED</td><td>ASC</td><td>LEVEL DATA: K:\36182\36182\LTPO</td></tr><tr><td>3/12/13</td><td>K</td><td>LOT 501, 511, 512 & 524 PROPERTY SERVICE & HOUSE DRAIN RELOCATION</td><td>ASC</td><td>DATUM: AHD</td></tr><tr><td>2/12/13</td><td>J</td><td>LOT 511 CROSSOVER RELOCATION</td><td>ASC</td><td>PROJECT No.: 36182/5A</td></tr><tr><td>29/10/13</td><td>I</td><td>CROSSOVER AMENDMENTS</td><td>ASC</td><td>DRAWN: C.M.B. DATE: MAY 2013</td></tr><tr><td colspan="3">FILENAME: K:\36182\36182 5\dgn\r02. dgn</td><td>DESIGNED: Z.W.L. DATE: MAY 2013</td><td>AUTHORISED: A.S.C. DATE: MAY 2013</td></tr></table>				REVISIONS			SCALE:	AS SHOWN	DATE		DETAILS	AUTHORISED	DATE PRINTED:	16/04/14	M	AS CONSTRUCTED	ASC	16/04/2014	11/03/14	L	LOT 501 & 512 CROSSOVER AMENDED	ASC	LEVEL DATA: K:\36182\36182\LTPO	3/12/13	K	LOT 501, 511, 512 & 524 PROPERTY SERVICE & HOUSE DRAIN RELOCATION	ASC	DATUM: AHD	2/12/13	J	LOT 511 CROSSOVER RELOCATION	ASC	PROJECT No.: 36182/5A	29/10/13	I	CROSSOVER AMENDMENTS	ASC	DRAWN: C.M.B. DATE: MAY 2013	FILENAME: K:\36182\36182 5\dgn\r02. dgn			DESIGNED: Z.W.L. DATE: MAY 2013	AUTHORISED: A.S.C. DATE: MAY 2013	 MORNINGTON 5 Main Street, P.O. Box 171, 3911 Phone: (03) 5975 4444 Fax: (03) 5975 3906 OX 93118 Mornington MELBOURNE The Melbourne Suite 2 250 St. Kilda Road, Melbourne, 3004 Phone: (03) 9697 8000 Fax: (03) 9697 8099 WATSONS ANM AT 037 509 410			<table><tr><th colspan="2">HUME CITY COUNCIL</th><th>PLAN NUMBER</th></tr><tr><td colspan="2">VILLAWOOD PROPERTIES P/L TRILLIUM STAGE 5A MICKLEHAM ROAD AND DRAINAGE PLANS</td><td>36182/5A R02</td></tr><tr><td colspan="2" rowspan="2">HUME CITY COUNCIL & SITE SPECIFIC NOTES</td><td>REVISION M</td></tr><tr><td>SHEET 2 OF 14</td></tr></table>			HUME CITY COUNCIL		PLAN NUMBER	VILLAWOOD PROPERTIES P/L TRILLIUM STAGE 5A MICKLEHAM ROAD AND DRAINAGE PLANS		36182/5A R02	HUME CITY COUNCIL & SITE SPECIFIC NOTES		REVISION M	SHEET 2 OF 14
REVISIONS			SCALE:	AS SHOWN																																																							
DATE		DETAILS	AUTHORISED	DATE PRINTED:																																																							
16/04/14	M	AS CONSTRUCTED	ASC	16/04/2014																																																							
11/03/14	L	LOT 501 & 512 CROSSOVER AMENDED	ASC	LEVEL DATA: K:\36182\36182\LTPO																																																							
3/12/13	K	LOT 501, 511, 512 & 524 PROPERTY SERVICE & HOUSE DRAIN RELOCATION	ASC	DATUM: AHD																																																							
2/12/13	J	LOT 511 CROSSOVER RELOCATION	ASC	PROJECT No.: 36182/5A																																																							
29/10/13	I	CROSSOVER AMENDMENTS	ASC	DRAWN: C.M.B. DATE: MAY 2013																																																							
FILENAME: K:\36182\36182 5\dgn\r02. dgn			DESIGNED: Z.W.L. DATE: MAY 2013	AUTHORISED: A.S.C. DATE: MAY 2013																																																							
HUME CITY COUNCIL		PLAN NUMBER																																																									
VILLAWOOD PROPERTIES P/L TRILLIUM STAGE 5A MICKLEHAM ROAD AND DRAINAGE PLANS		36182/5A R02																																																									
HUME CITY COUNCIL & SITE SPECIFIC NOTES		REVISION M																																																									
		SHEET 2 OF 14																																																									


LEGEND

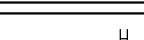

Kerb & Channel

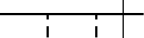

Footpath, Vehicular Crossing Layback & House Drain

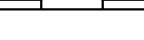

Proposed Underground Drainage, Pit & Property Inlet



Existing Underground Drainage, Pit & Property Inlet



Drainage Pit Number



Design Surface Level - Allotments



Existing Surface Level - Allotments




Top of Batter Level - Allotments (Front)




Kerb Level




Pavement Level

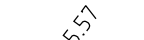

Proposed Cut Areas - Allotments

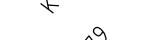

Proposed Fill Areas - Allotments

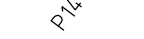

Service Conduits

Gas

Water

Recycled Water

Electricity

Telstra

Optic Fibre



G — Gas Main



W — Water Main



OF — Optic Fibre Underground Cable



E — Electrical Underground Cable & Pit



T — Telstra Underground Cable



S — Sewer Main, Access Chamber & Inspection Shaft



Existing Pole (with stay)



Street Name Sign



Existing Tree or Plantation



P.S.M. or Survey Mark



Lot Slope Direction




T.B.M. with Description


NOTE:

1. Symbols are proposed construction (UNO)


2. Existing construction shown with broken lines

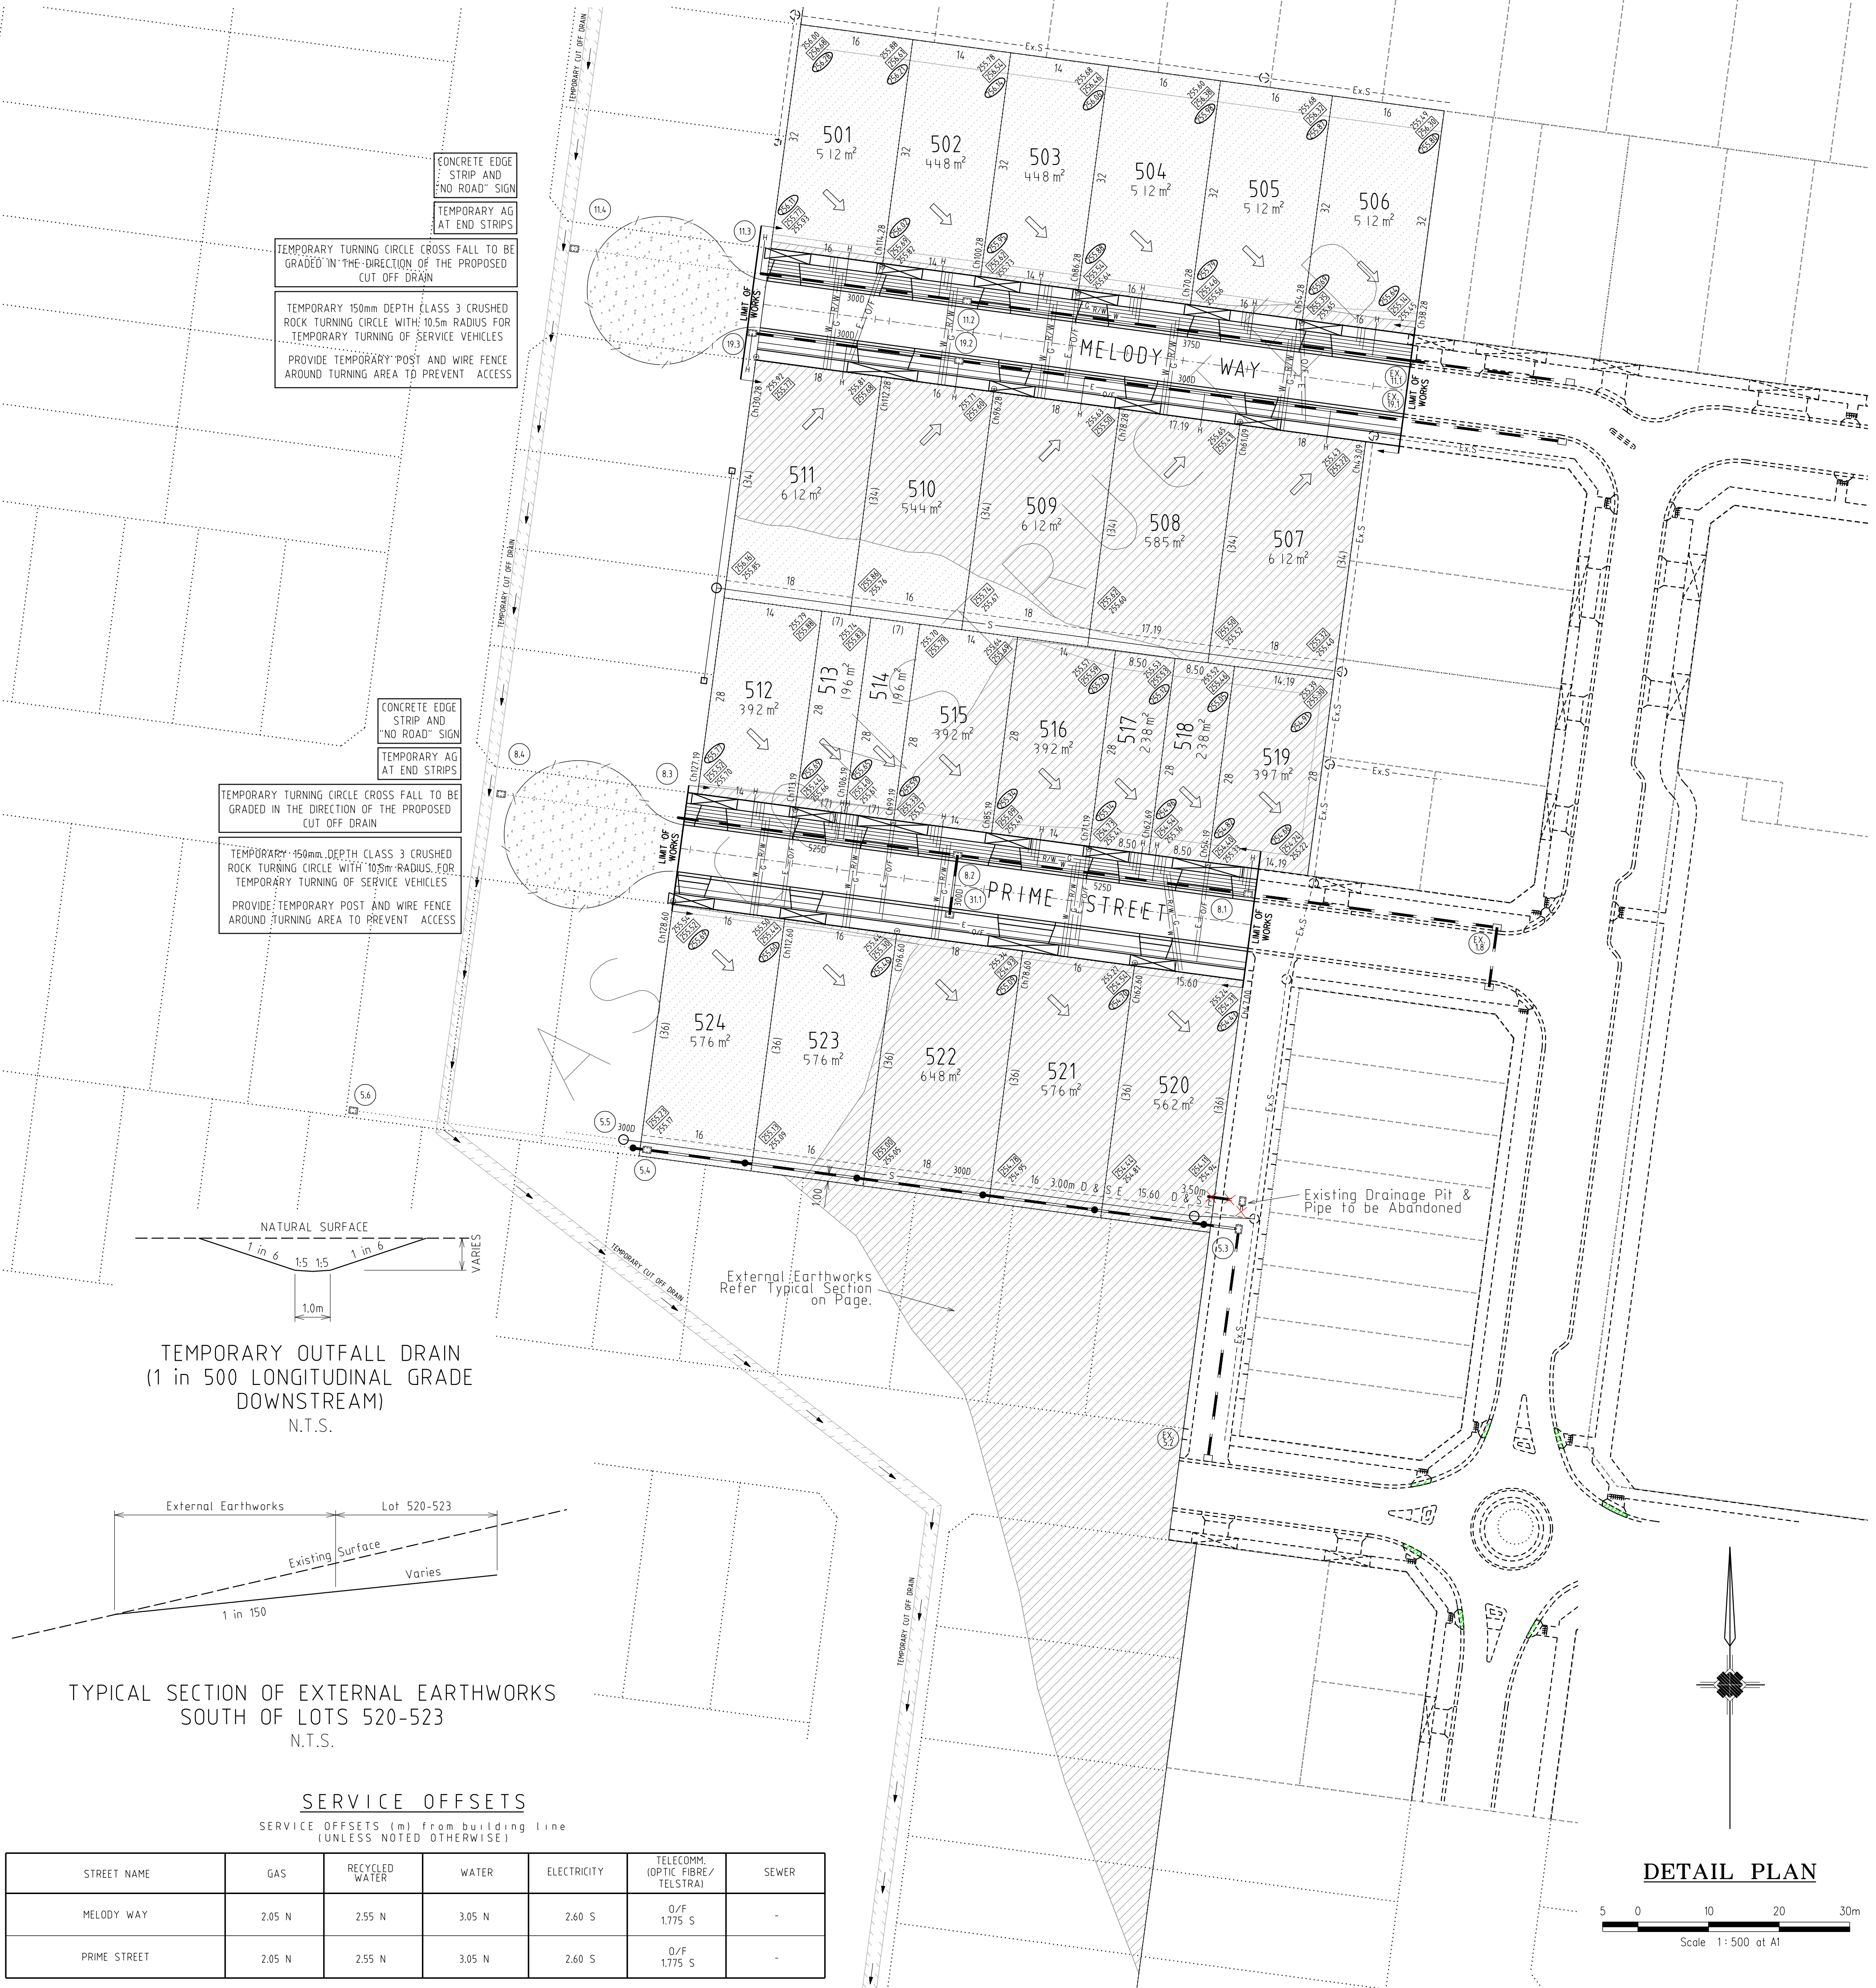

DETAIL PLAN

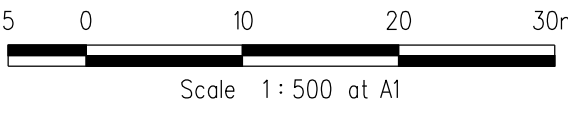










REVISIONS			SCALE: AS SHOWN	
DATE	DETAILS	AUTHORISED	DATE PRINTED:	17/04/2014
16/04/14	M	AS CONSTRUCTED	LEVEL DATA:	K\N36182\36182\N1\TOPO
11/03/14	L	LOT 501 & 512 CROSSOVER AMENDED	DATUM:	AHD
3/12/13	K	LOT 501, 511, 512 & 524 PROPERTY SERVICE & HOUSE DRAIN RELOCATION	PROJECT No.:	36182/5A
2/12/13	J	LOT 511 CROSSOVER RELOCATION	DRAWN:	C.M.B. DATE: MAY 2013
29/10/13	I	CROSSOVER AMENDMENTS	DESIGNED:	Z.W.L. DATE: MAY 2013
FILENAME K:\36182\36182 5\dgn\N03.dgn			AUTHORISED:	A.S.C. DATE: MAY 2013

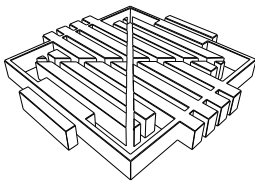

MORNINGTON
5 Main Street
P.O. Box 171 3931
Phone: (03) 5975 4444
Fax: (03) 5975 3916
DX 93188 Mornington

MELBOURNE
The Melbourne Suite 2
250 St. Kilda Road
Melbourne, 3004
Phone: (03) 9697 8000
Fax: (03) 9697 8099

HUME CITY COUNCIL		PLAN NUMBER
VILLAWOOD PROPERTIES P/L TRILLIUM STAGE 5A MICKLEHAM ROAD AND DRAINAGE PLANS		36182/5A R03
DETAIL PLAN & SERVICE OFFSET TABLE		REVISION M
		SHEET 3 OF 14

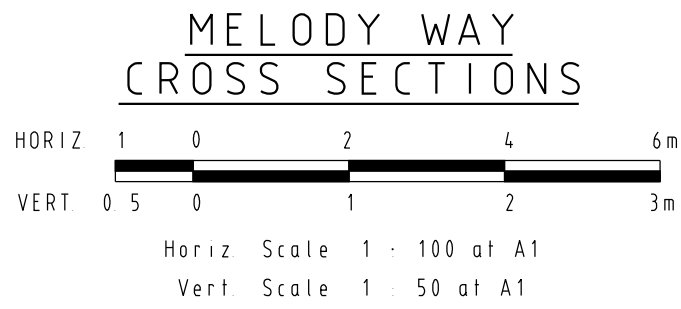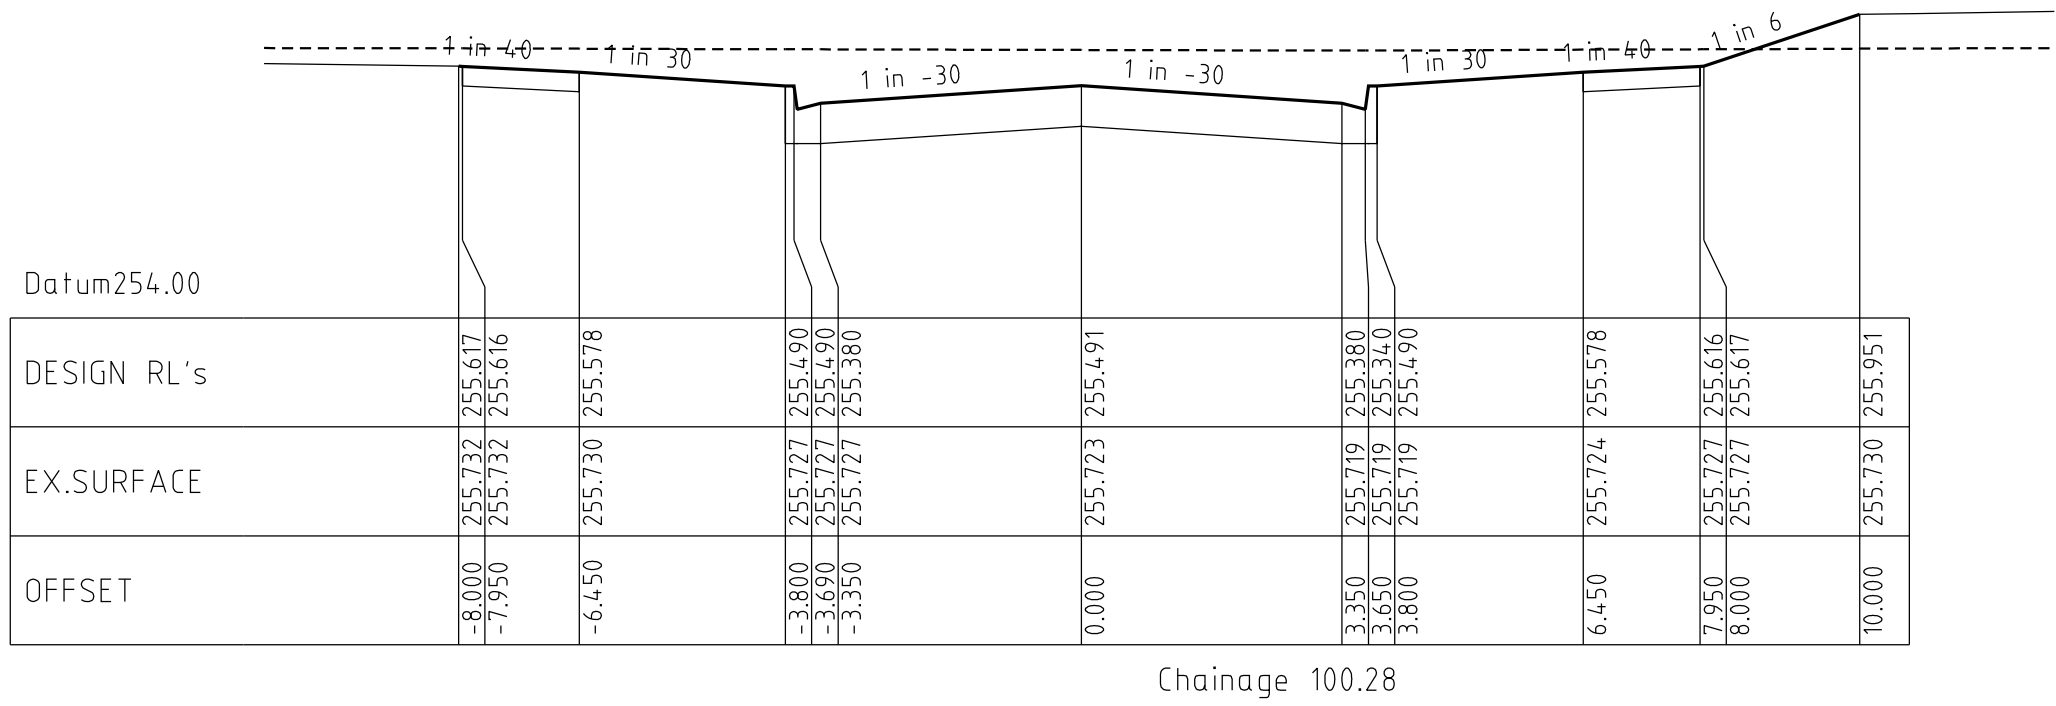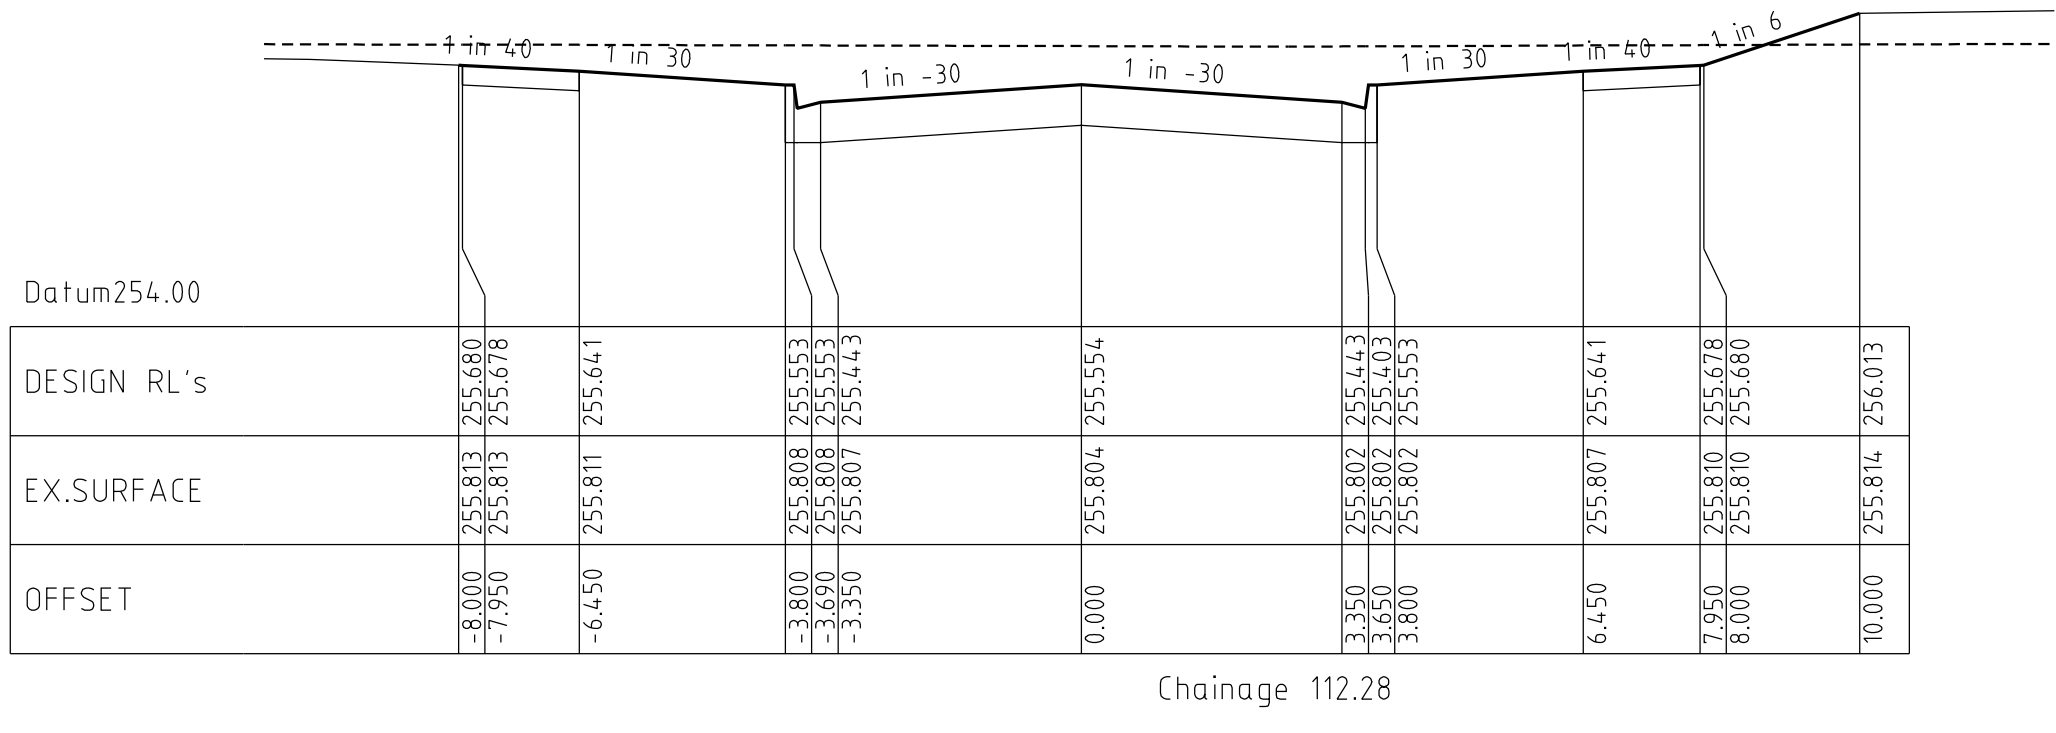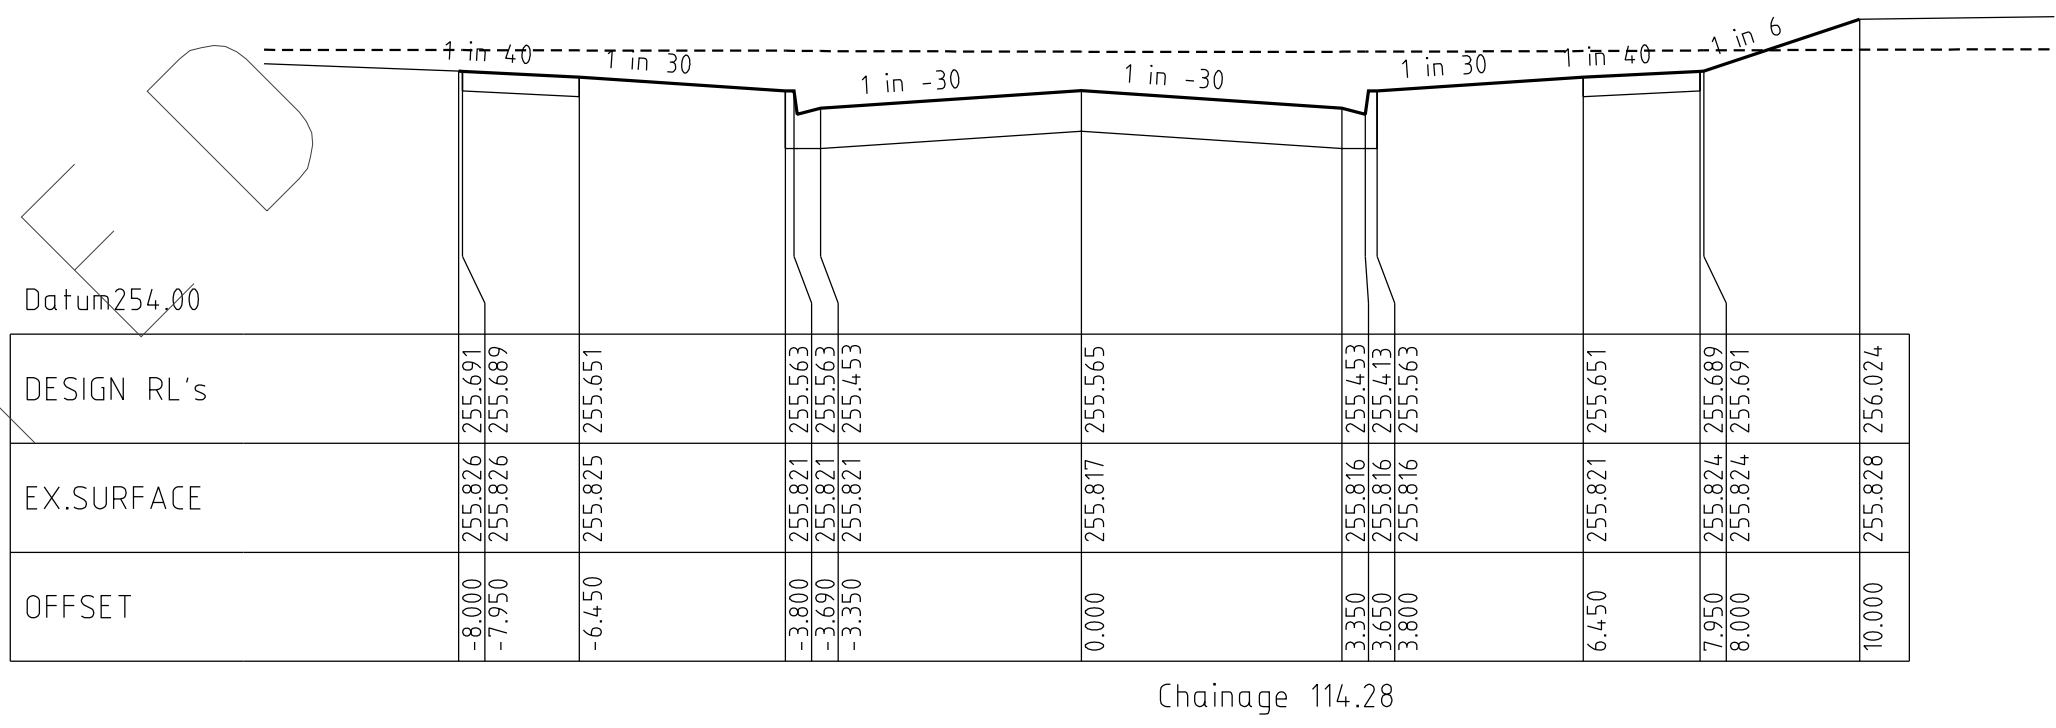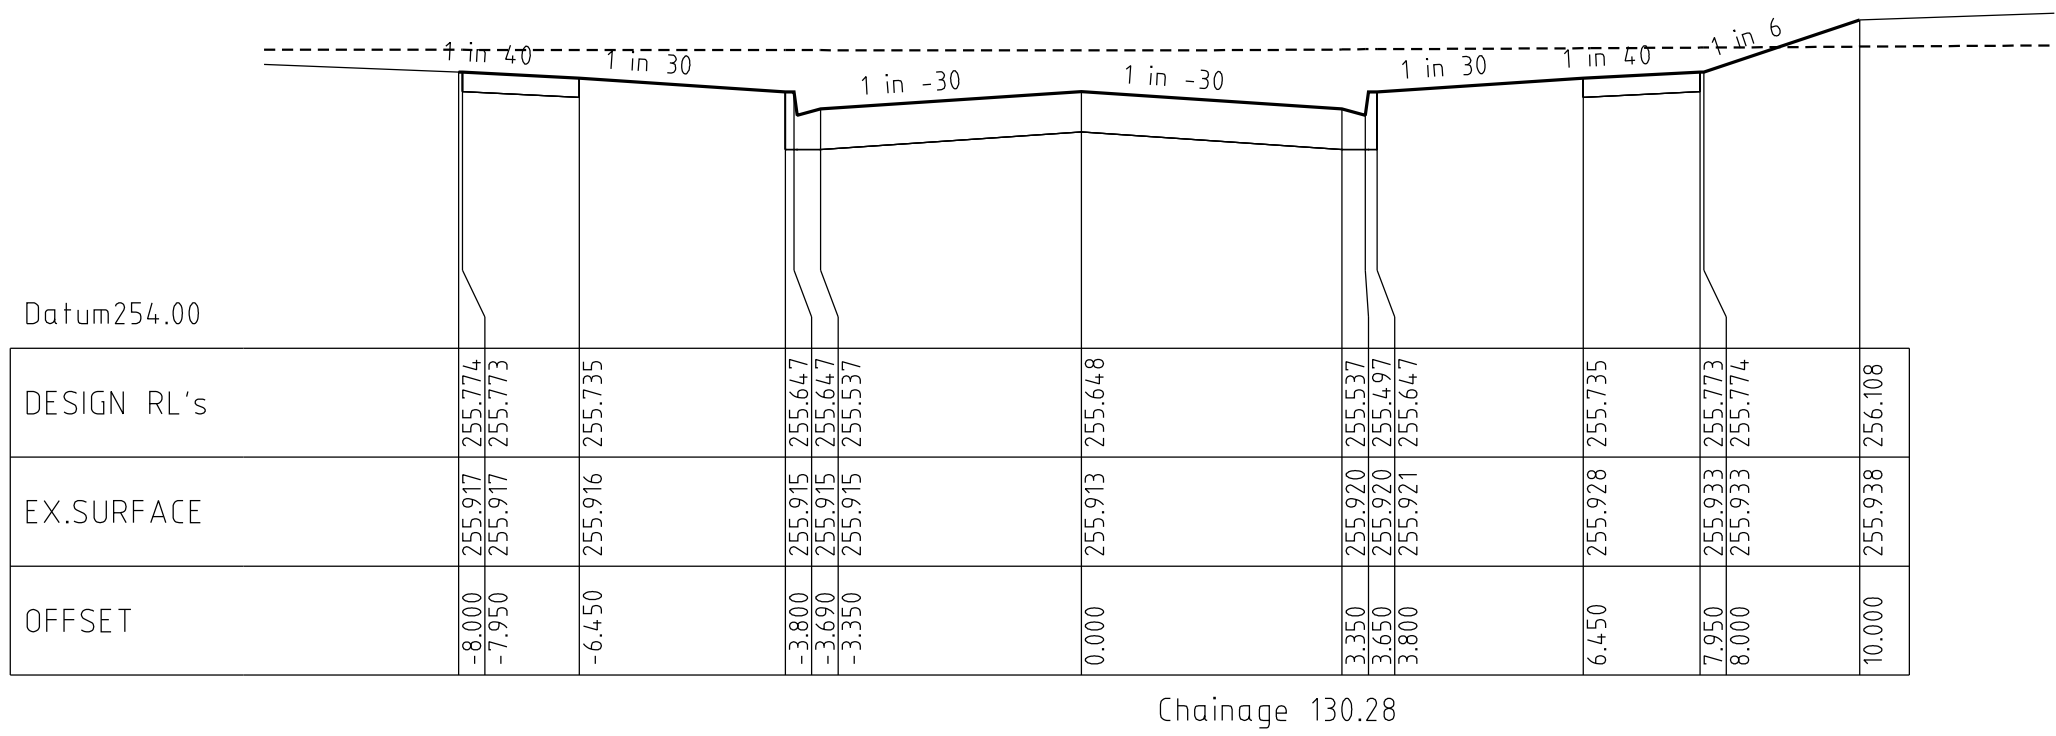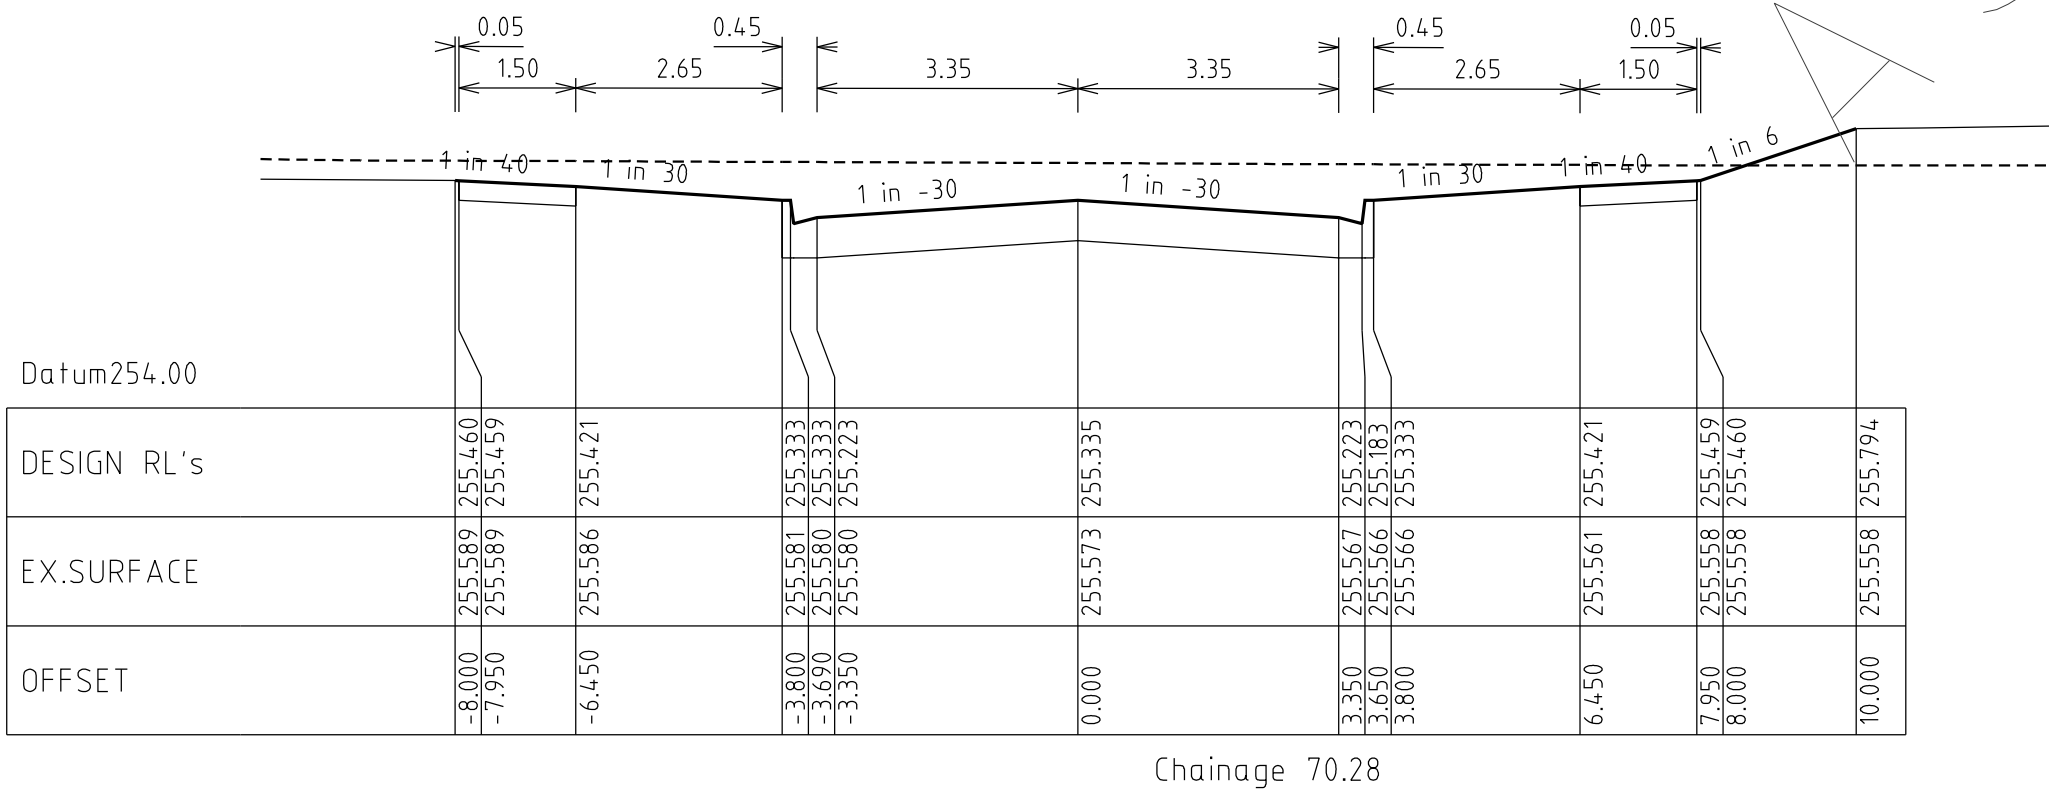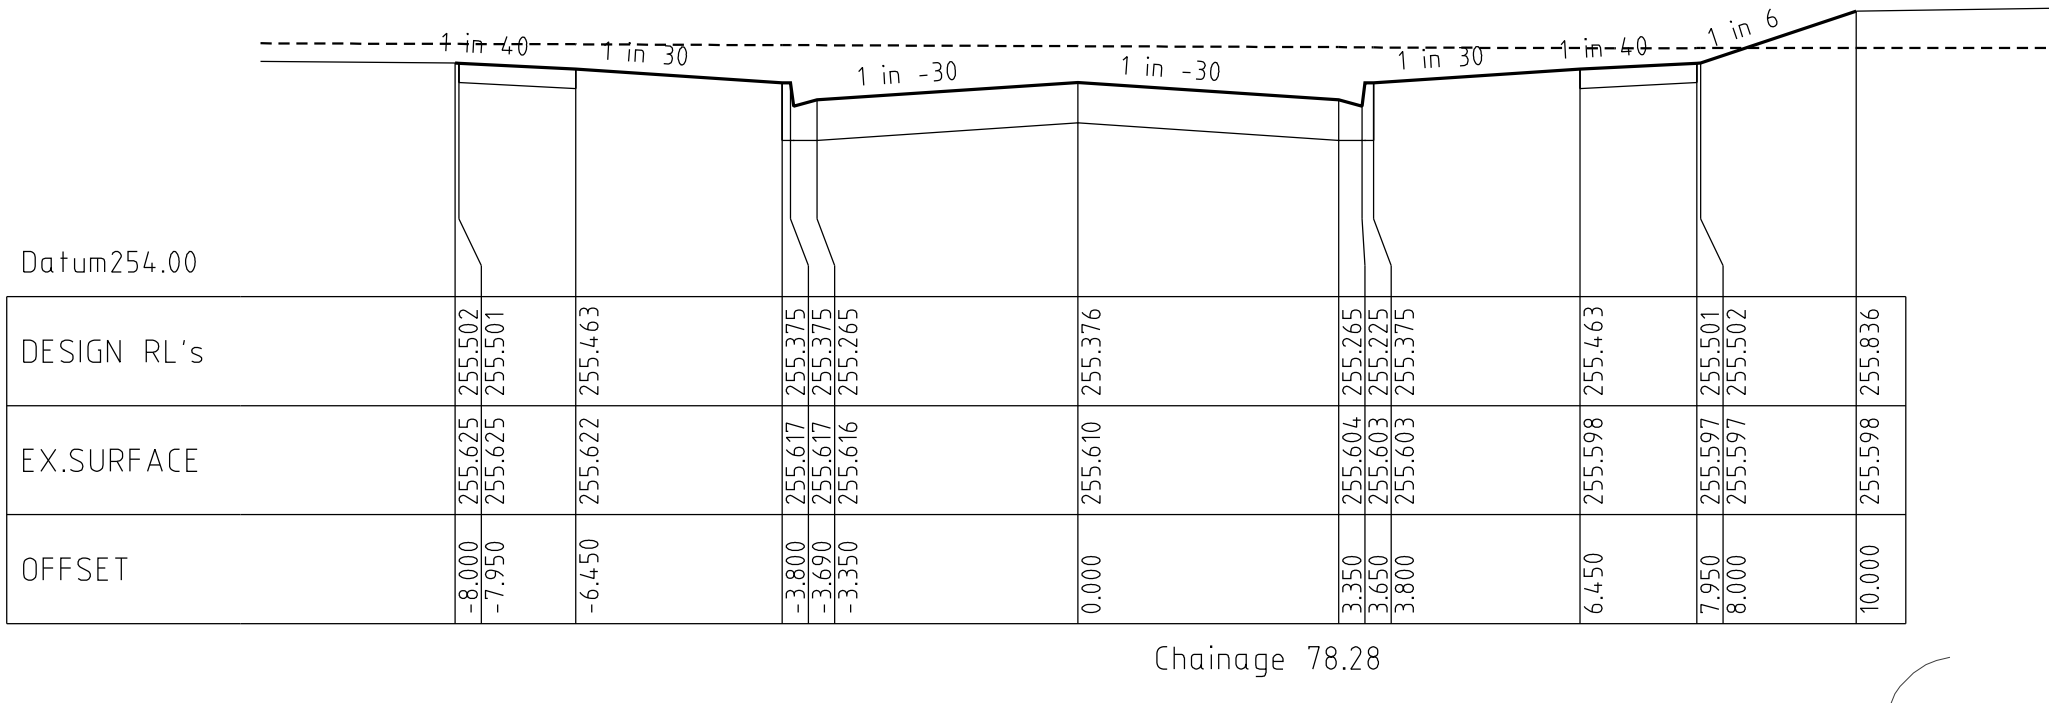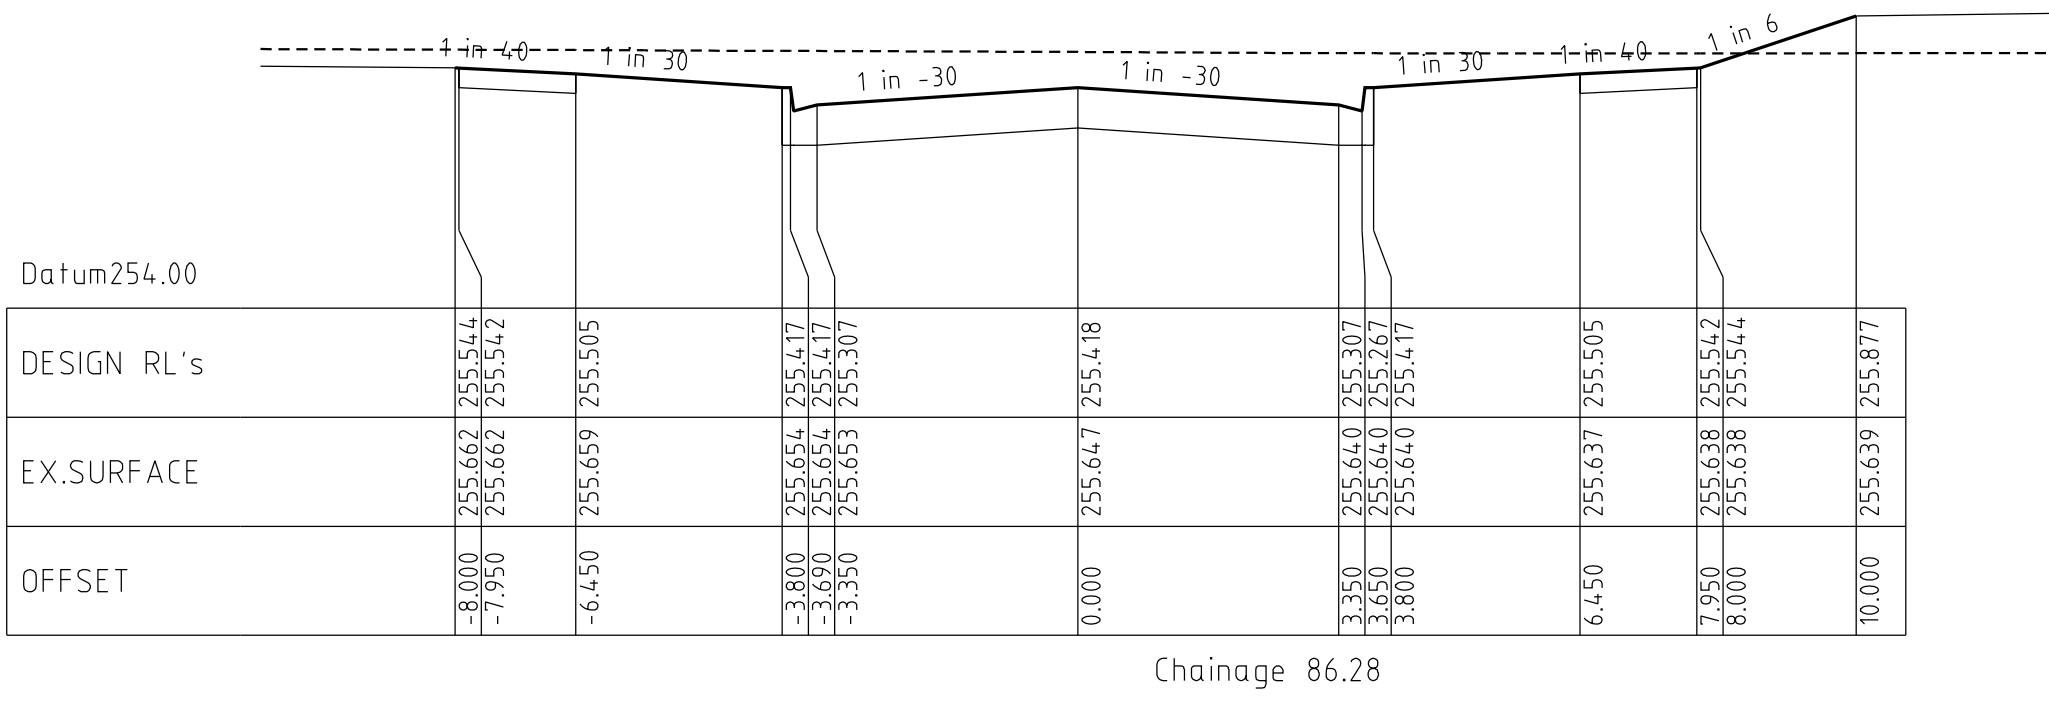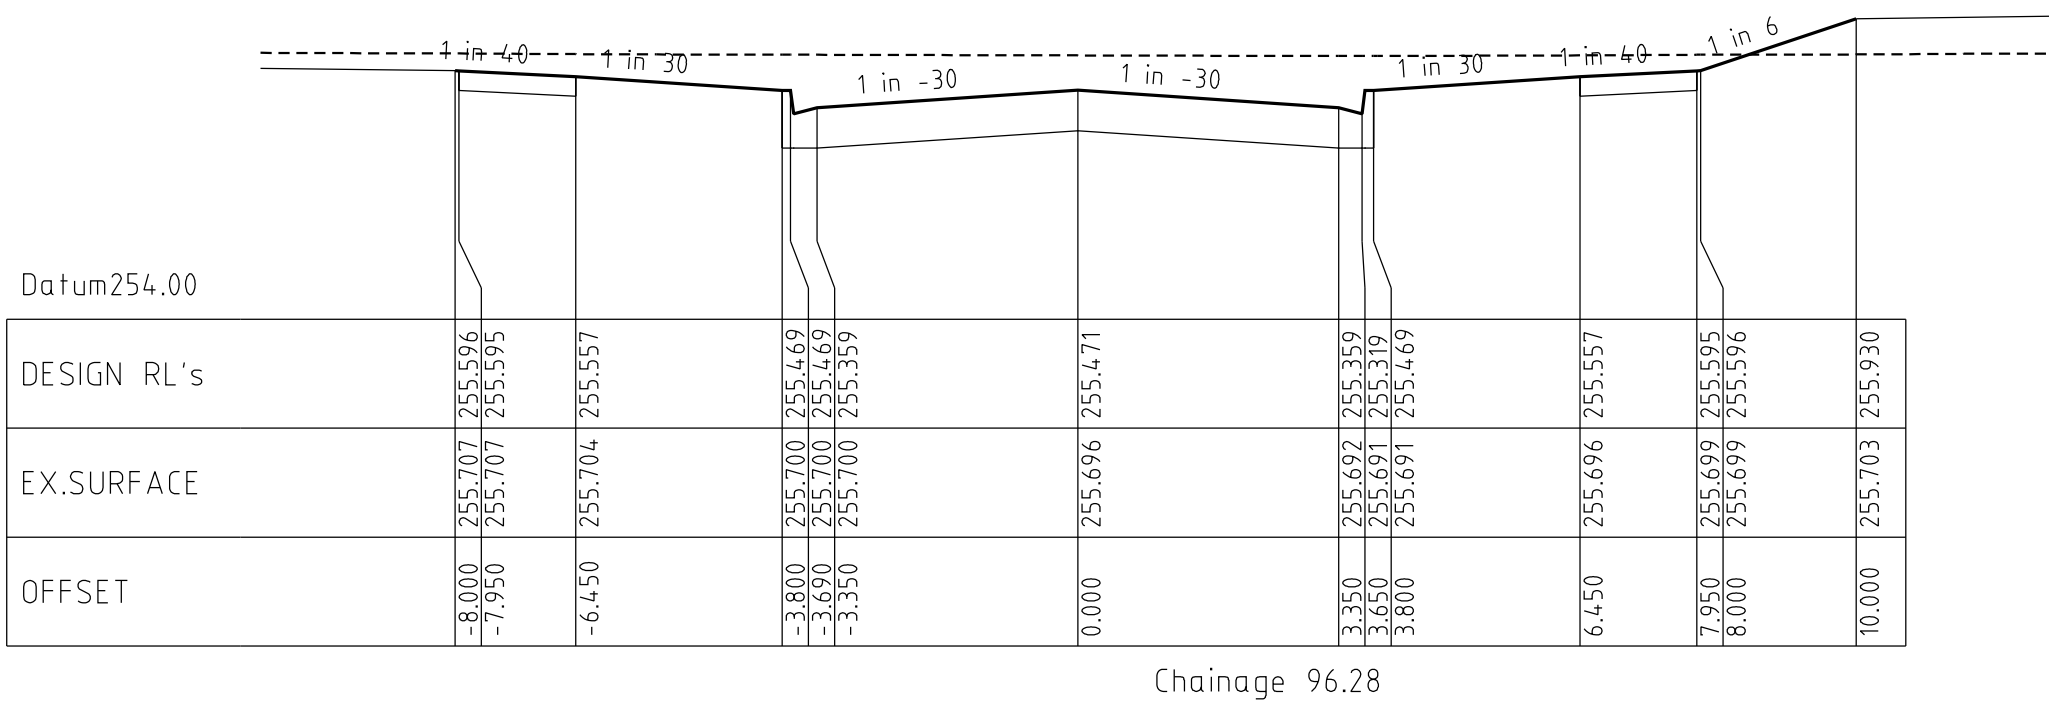










REVISIONS			SCALE: AS SHOWN	
DATE	DETAILS	AUTHORISED	DATE PRINTED:	16/04/2014
16/04/14	M AS CONSTRUCTED	ASC	LEVEL DATA:	K:\36182\36182\LTPOD
11/03/14	L LOT 501 & 512 CROSSOVER AMENDED	ASC	DATUM:	AHD
3/12/13	K LOT 501, 511, 512 & 524 PROPERTY SERVICE & HOUSE DRAIN RELOCATION	ASC	PROJECT No.:	36182/5A
2/12/13	J LOT 511 CROSSOVER RELOCATION	ASC	DRAWN:	C.M.B. DATE: MAY 2013
29/10/13	I CROSSOVER AMENDMENTS	ASC	DESIGNED:	Z.W.L. DATE: MAY 2013
FILENAME K:\36182\36182\5\dgn\r05.dgn			AUTHORISED:	A.S.C. DATE: MAY 2013



MORNINGTON
P.O. Box 171 3931
Phone: (03) 5975 4444
Fax: (03) 5975 3916
OX 93118 Mornington

MELBOURNE
The Melbourne Suite 2
250 St. Kilda Road
Melbourne, 3004
Phone: (03) 9497 8000
Fax: (03) 9497 8099

HUME CITY COUNCIL		PLAN NUMBER
VILLAWOOD PROPERTIES P/L TRILLIUM STAGE 5A MICKLEHAM ROAD AND DRAINAGE PLANS		36182/5A R05
MELODY WAY CROSS SECTIONS		REVISION M
		SHEET 5 OF 14

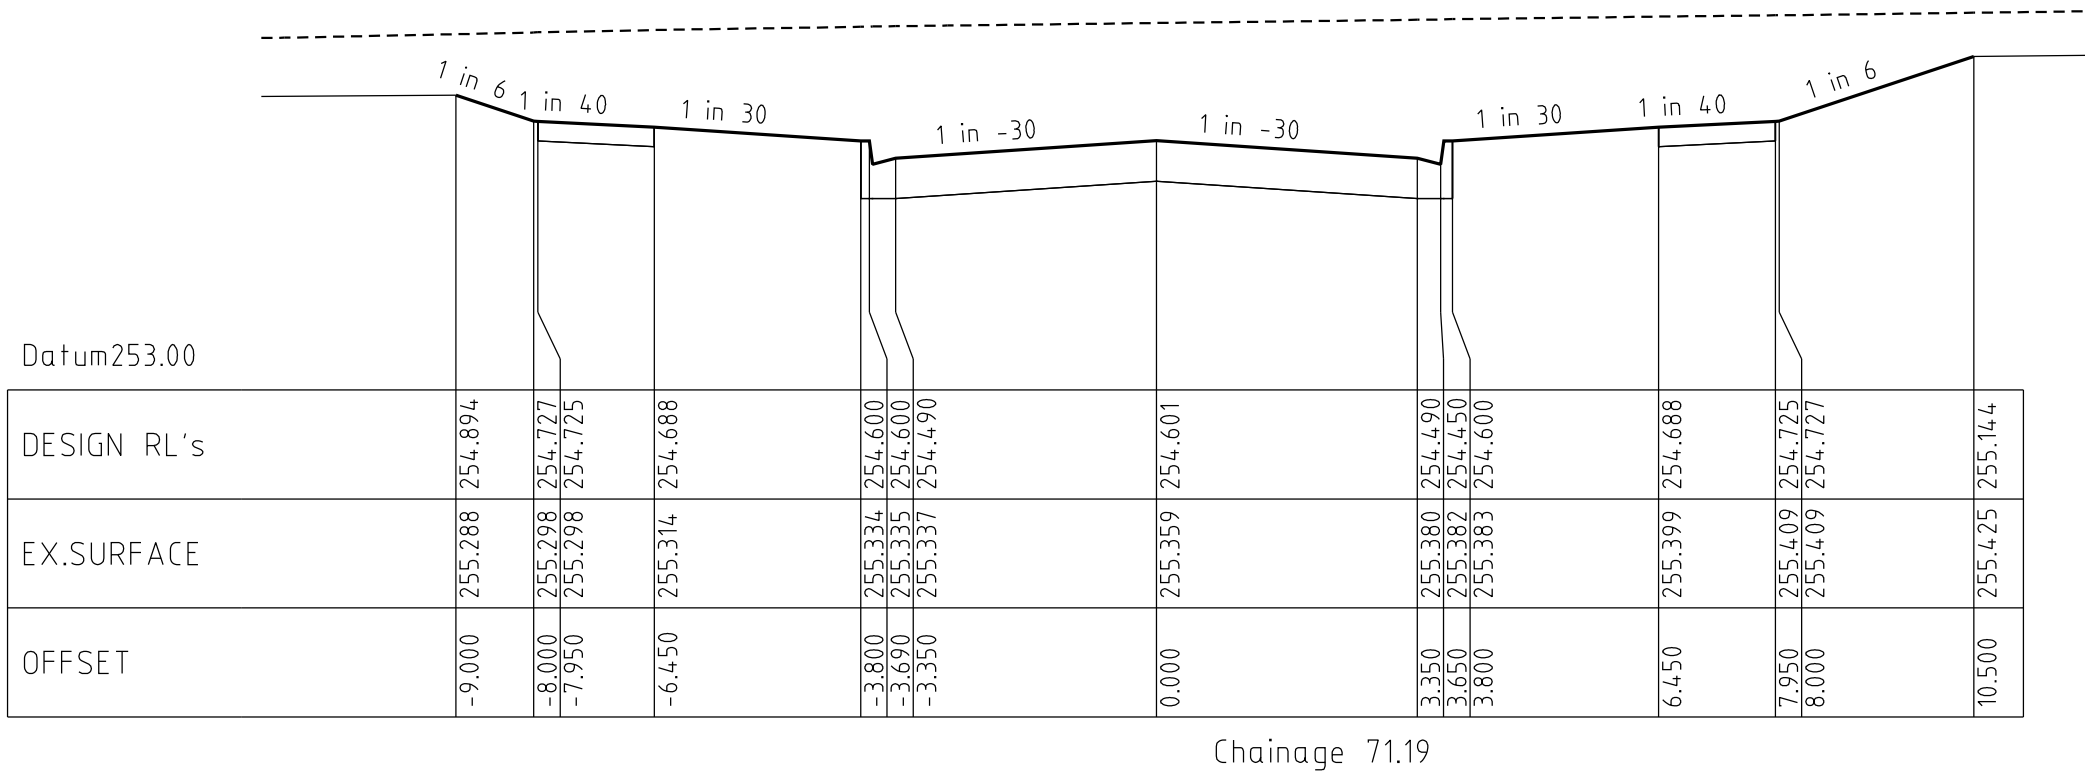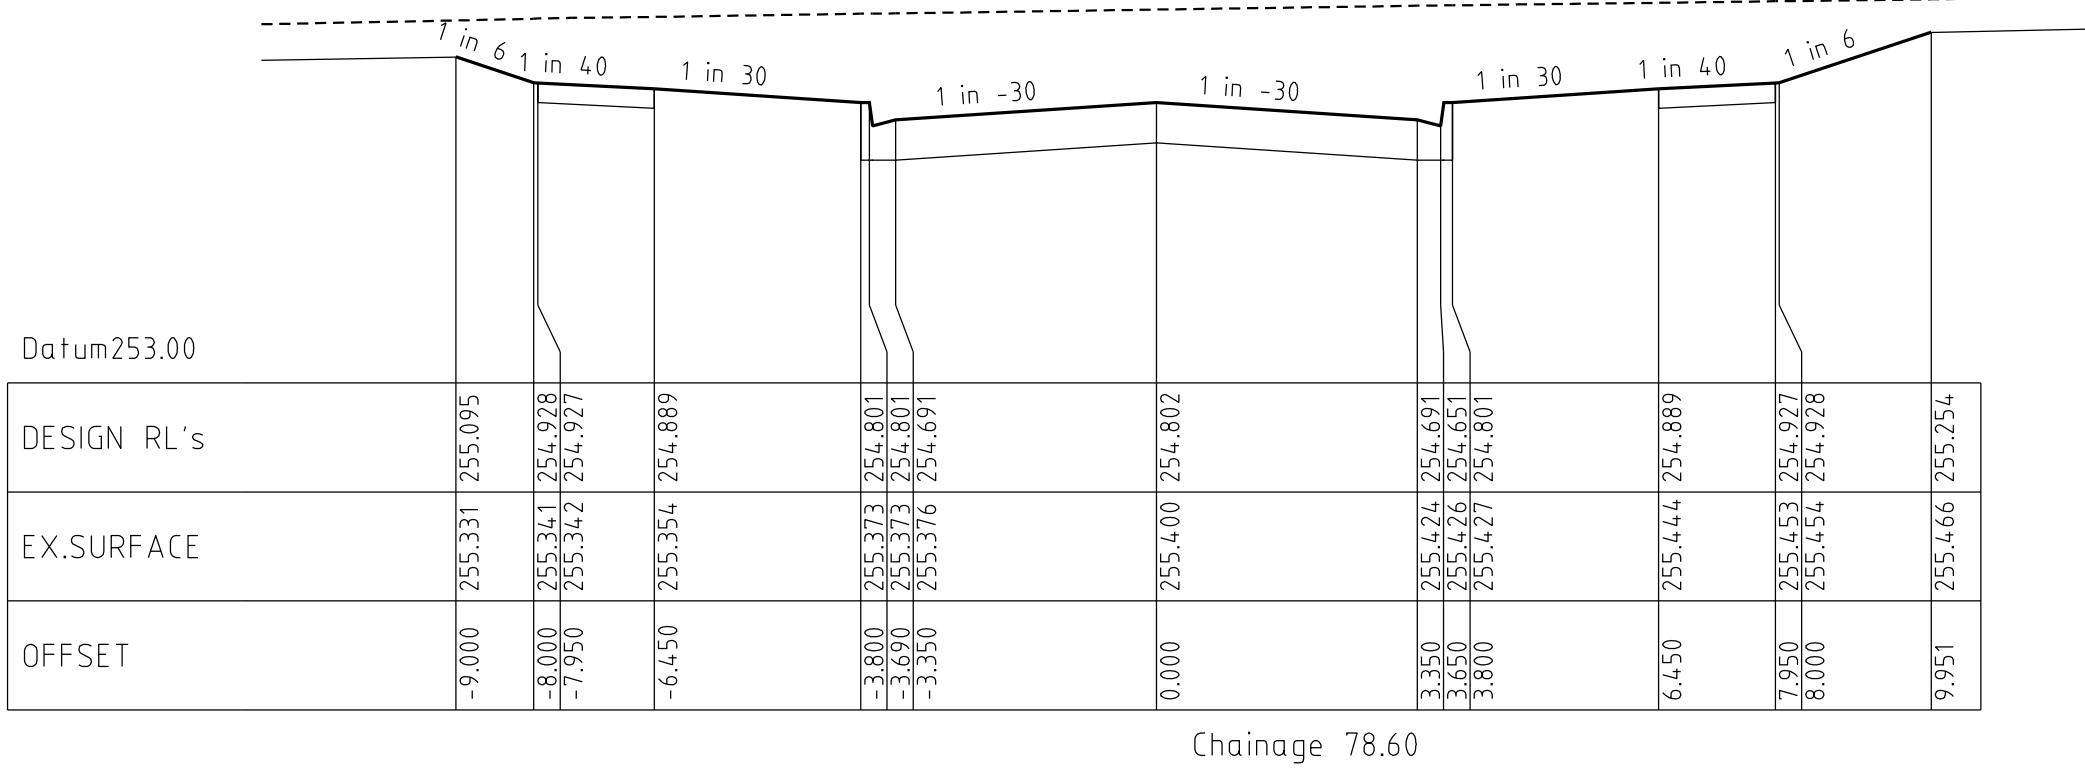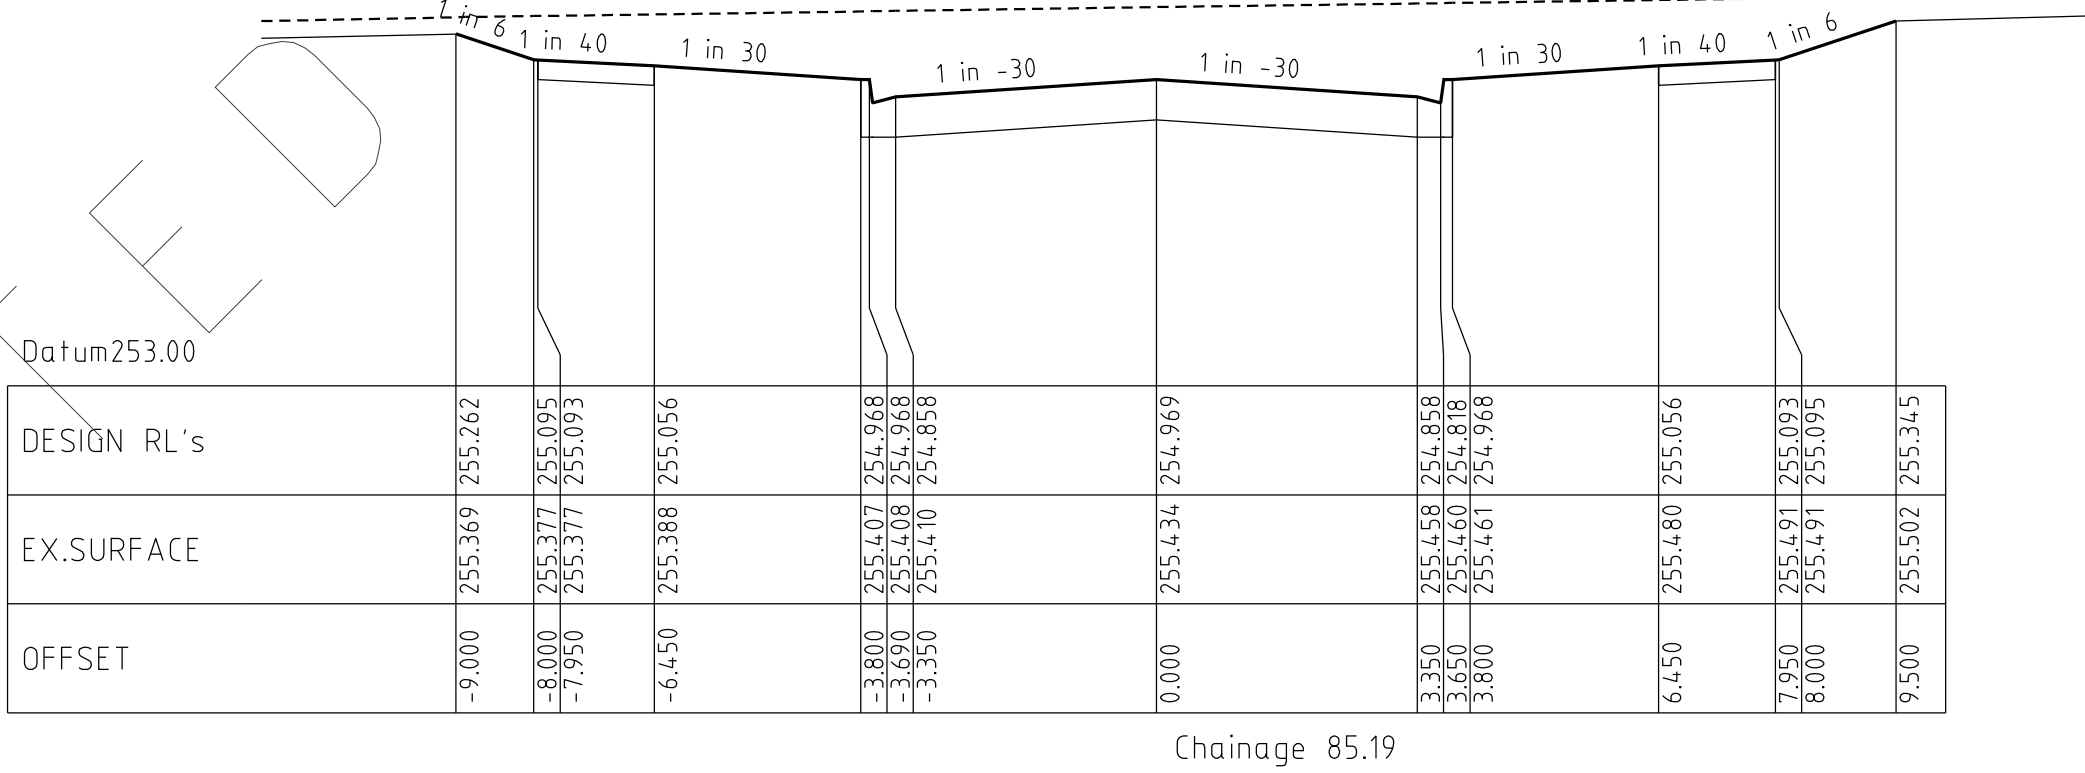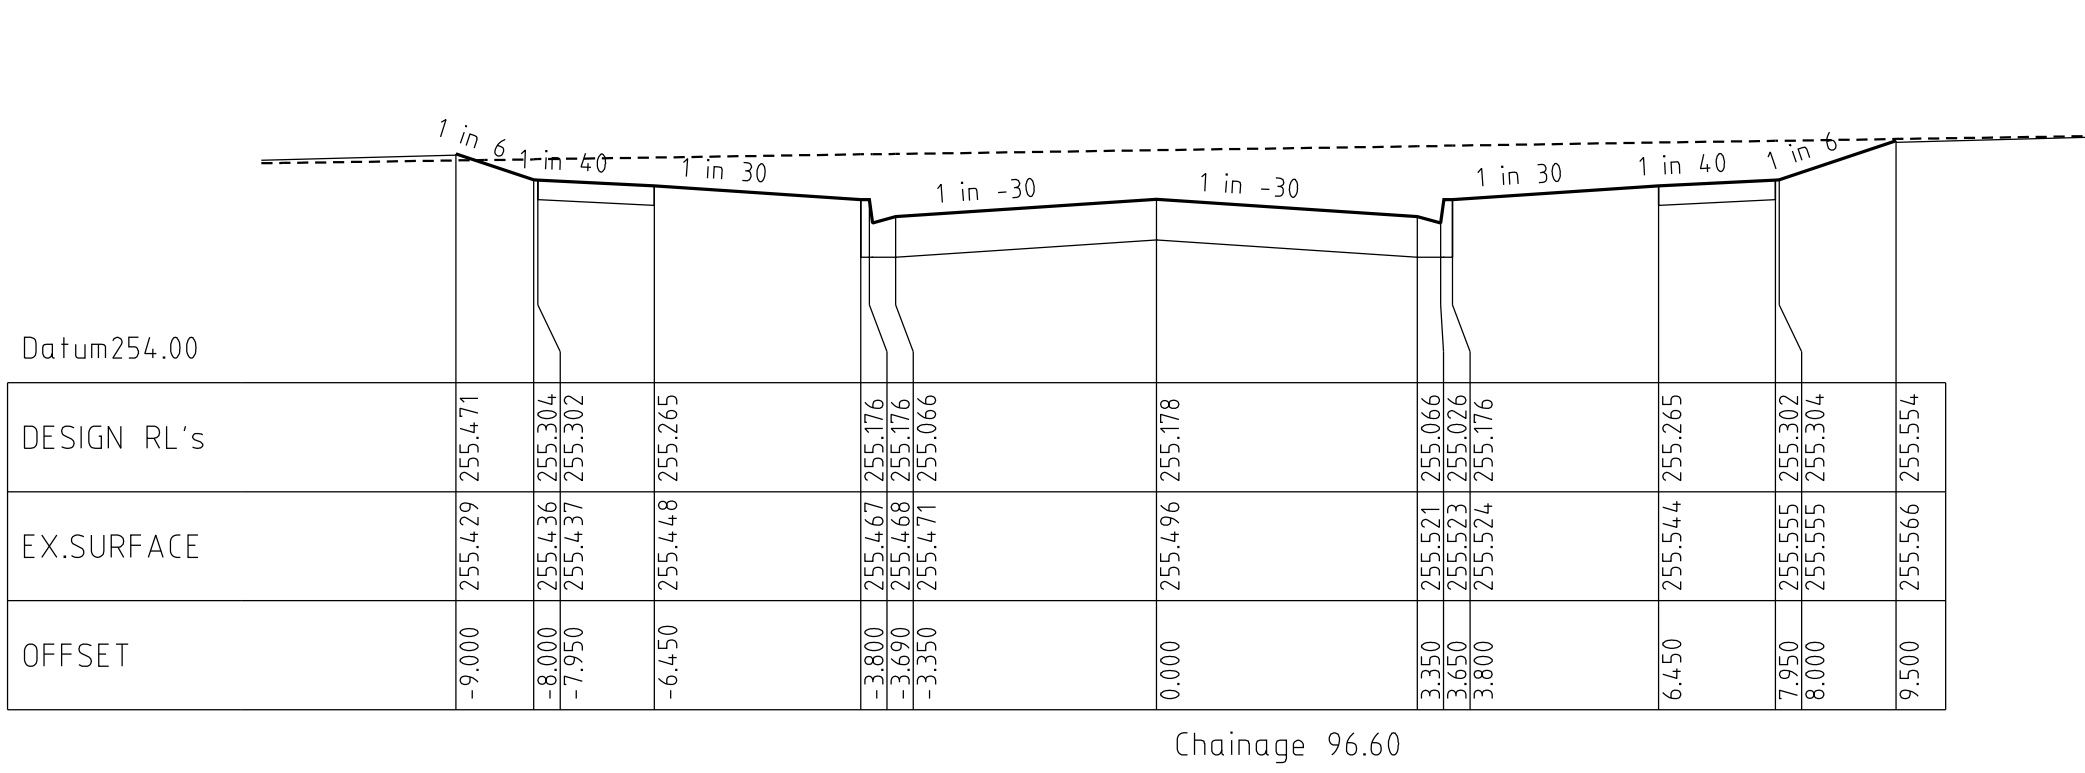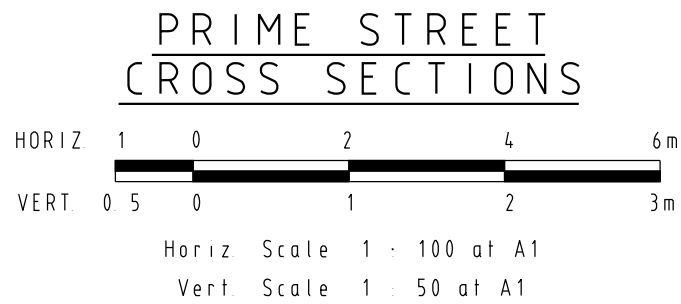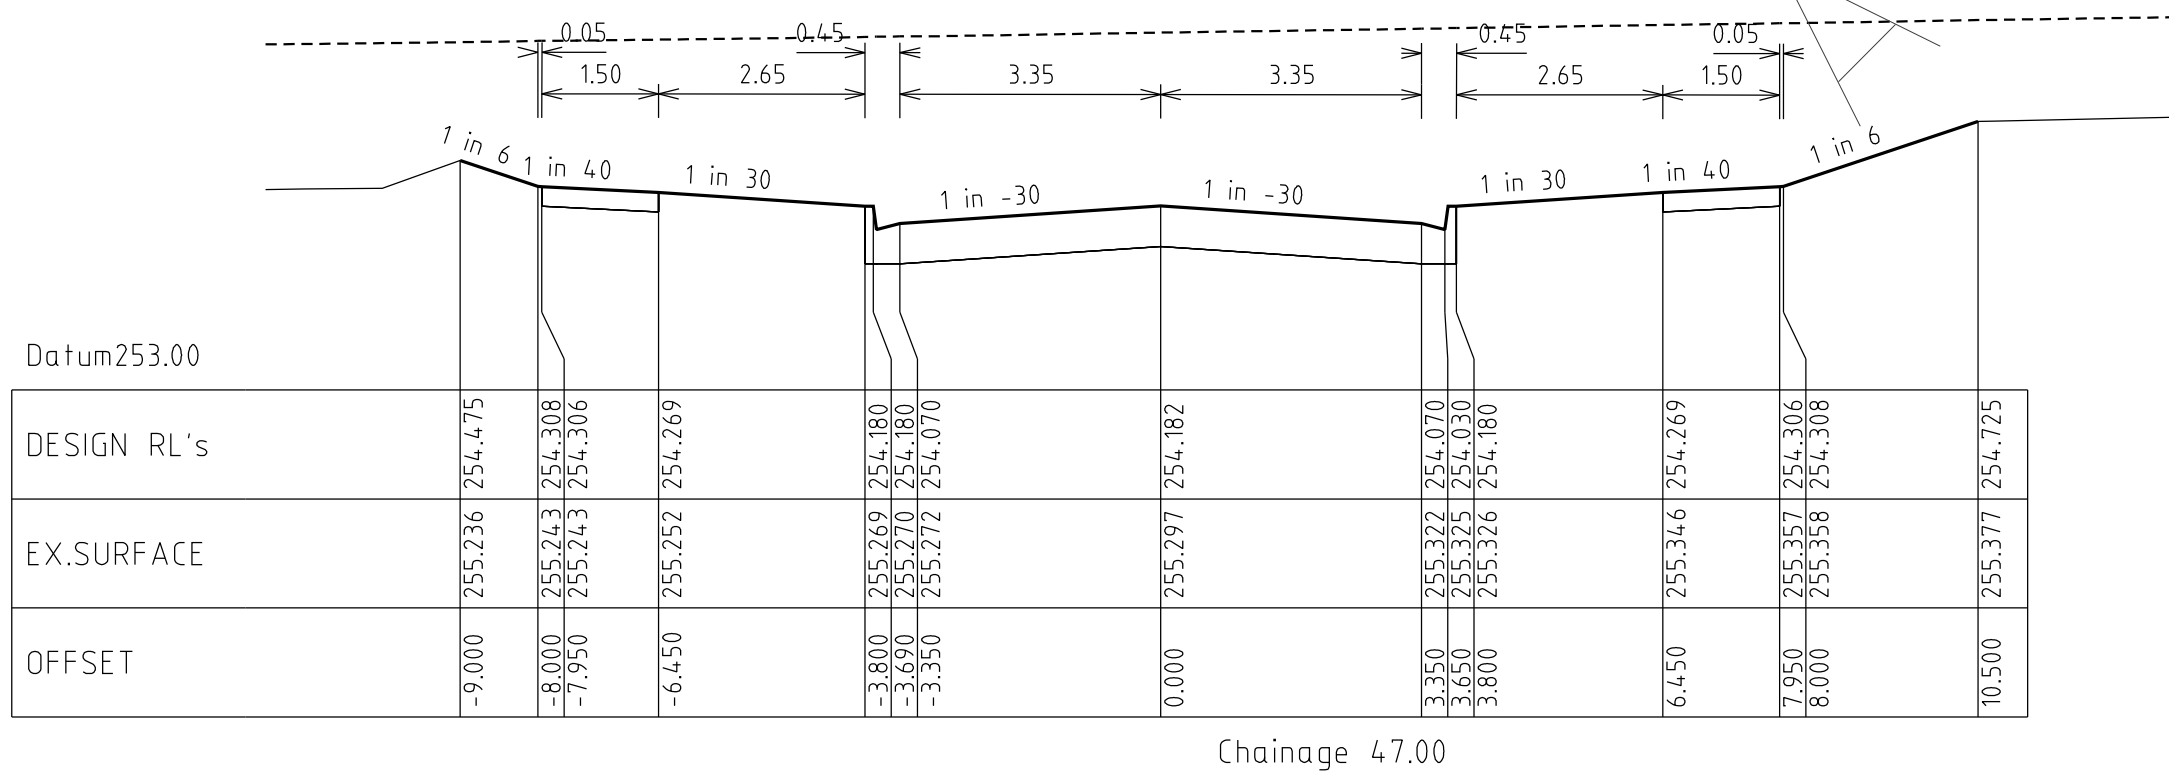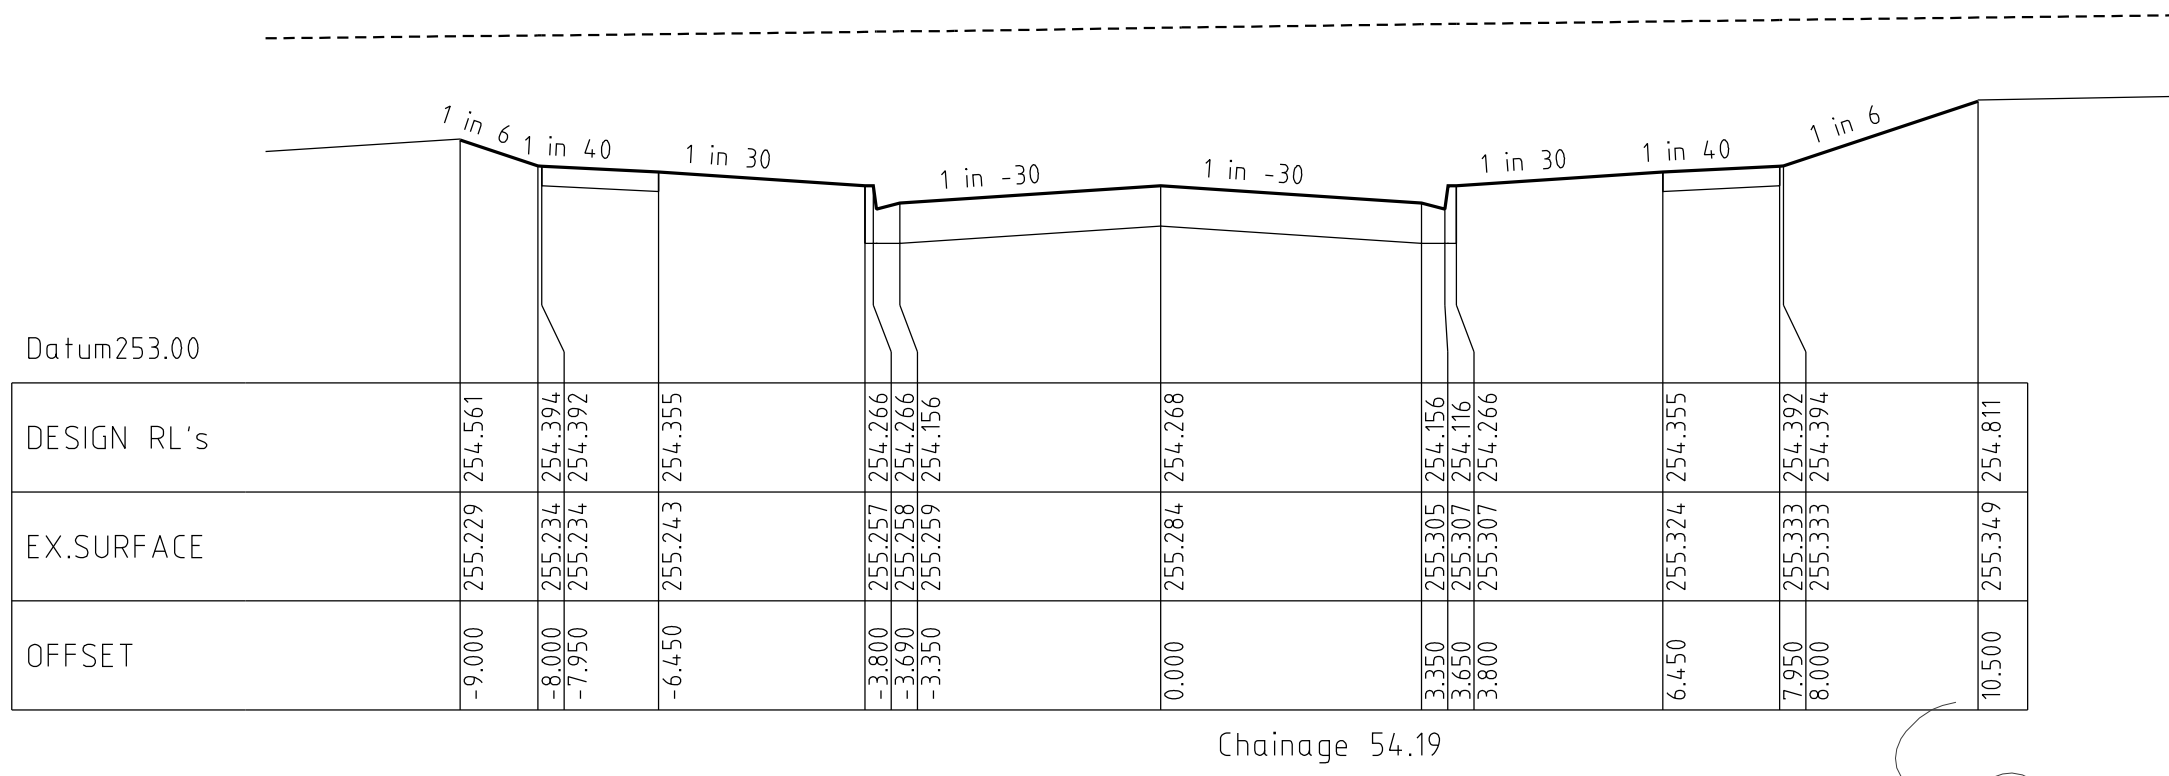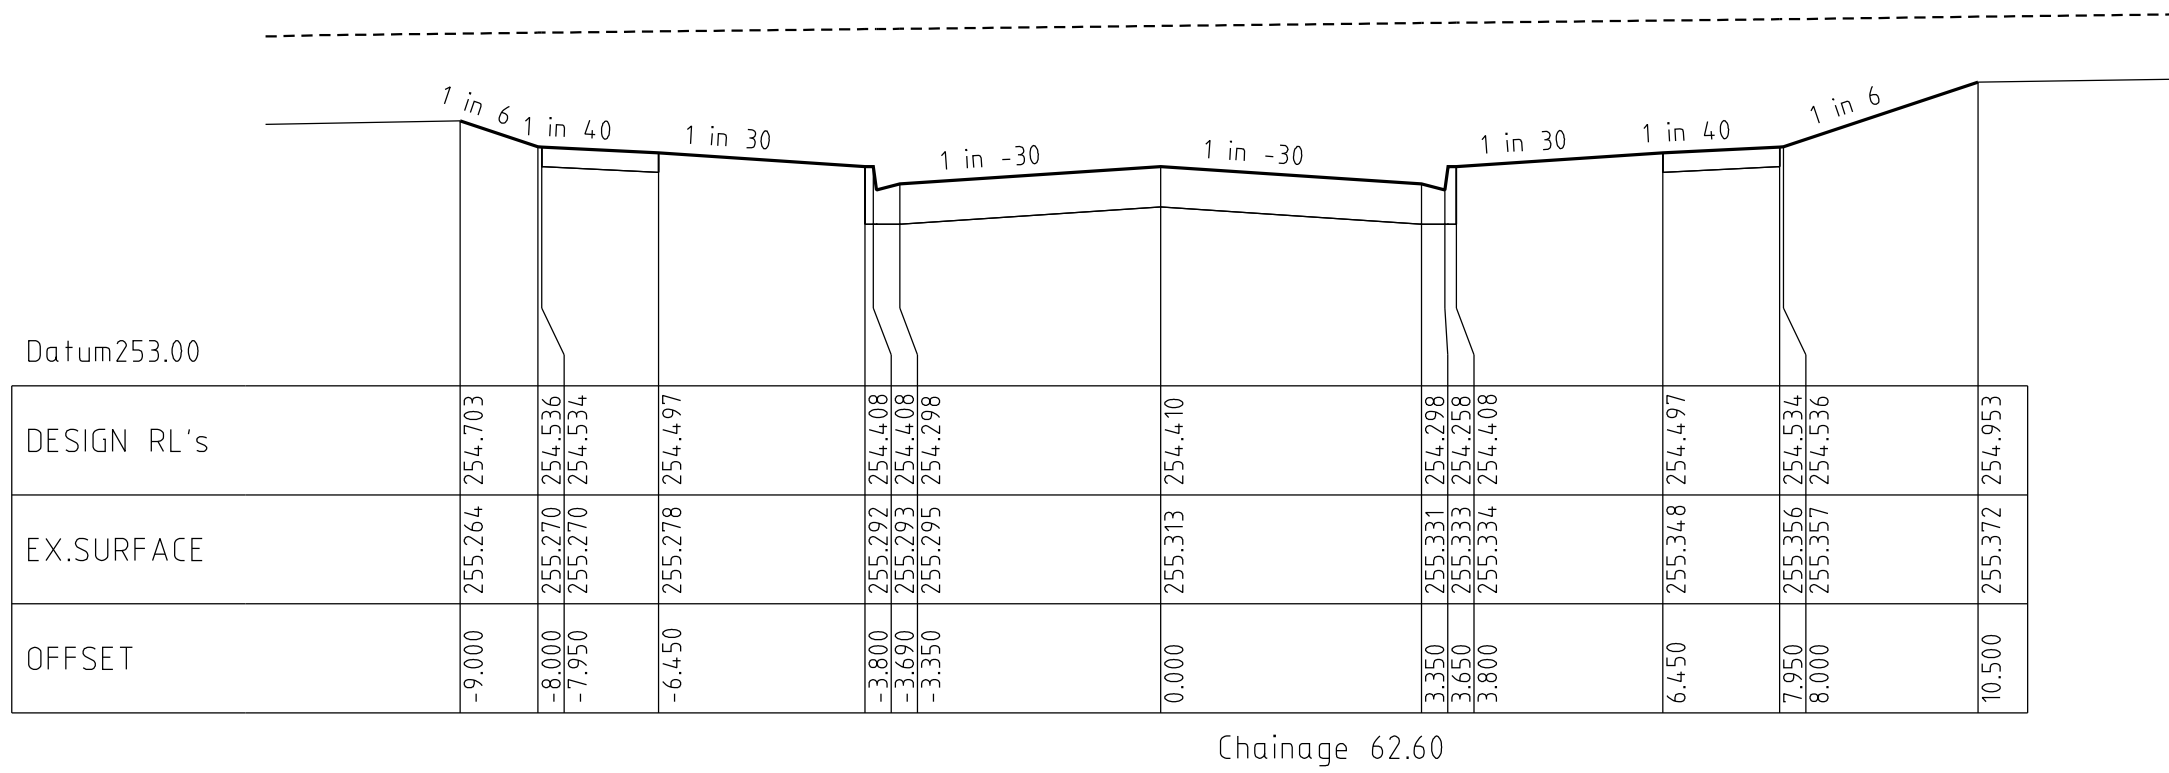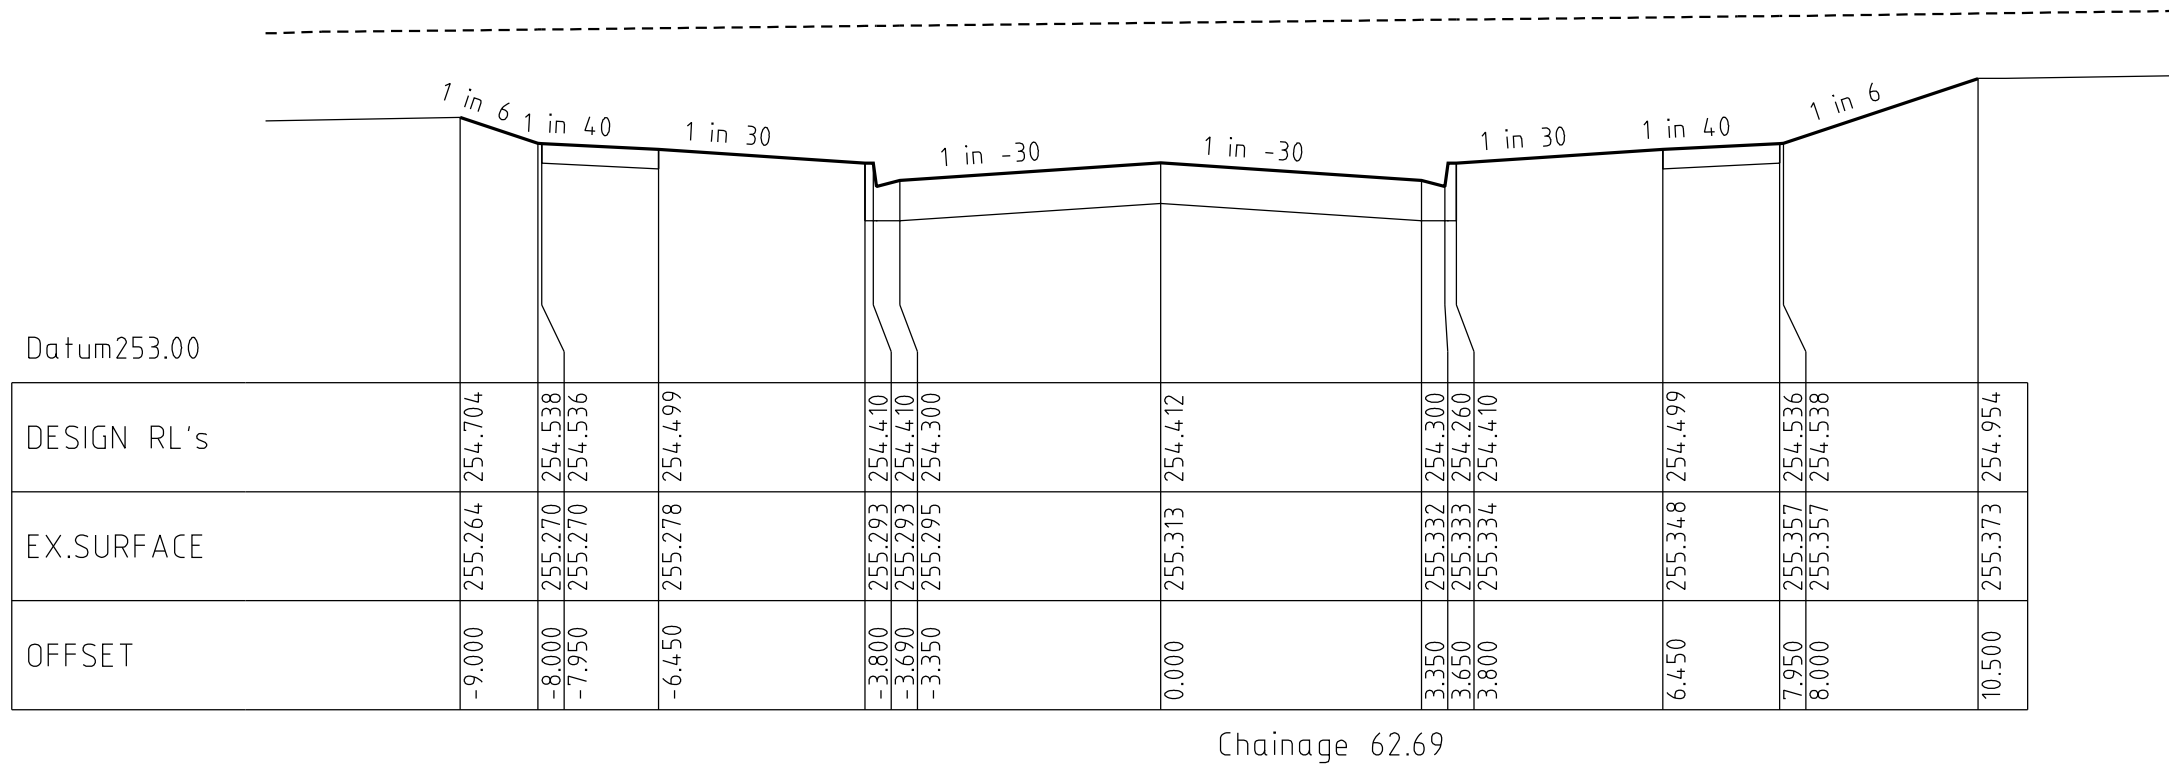

REVISIONS			SCALE: AS SHOWN	
DATE	DETAILS	AUTHORISED	DATE PRINTED:	16/04/2014
16/04/14	M	AS CONSTRUCTED	ASC	LEVEL DATA: K:\36182\36182\LTPOD
11/03/14	L	LOT 501 & 512 CROSSOVER AMENDED	ASC	DATUM: AHD
3/12/13	K	LOT 501, 511, 512 & 524 PROPERTY SERVICE & HOUSE DRAIN RELOCATION	ASC	PROJECT No.: 36182/5A
2/12/13	J	LOT 511 CROSSOVER RELOCATION	ASC	DRAWN: C.M.B. DATE: MAY 2013
29/10/13	I	CROSSOVER AMENDMENTS	ASC	DESIGNED: Z.W.L. DATE: MAY 2013
FILENAME K:\36182\36182 5\dgn\r07.dgn			AUTHORISED: A.S.C.	DATE: MAY 2013







WATSONS
ENR AT 07 599 410

MORNINGTON
4 Main Street,
P.O. Box 171 3931
Phone: (03) 5975 4444
Fax: (03) 5975 3916
OX 93118 Mornington

MELBOURNE
The Melbourne Suite 2
250 St. Kilda Road,
Melbourne, 3004
Phone: (03) 9497 8800
Fax: (03) 9497 8099

HUME CITY COUNCIL		PLAN NUMBER
VILLAWOOD PROPERTIES P/L		36182/5A R07
TRILLIUM STAGE 5A		
MICKLEHAM		
ROAD AND DRAINAGE PLANS		REVISION
PRIME STREET		M
CROSS SECTIONS		SHEET 7 OF 14

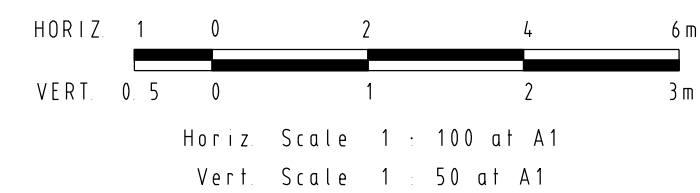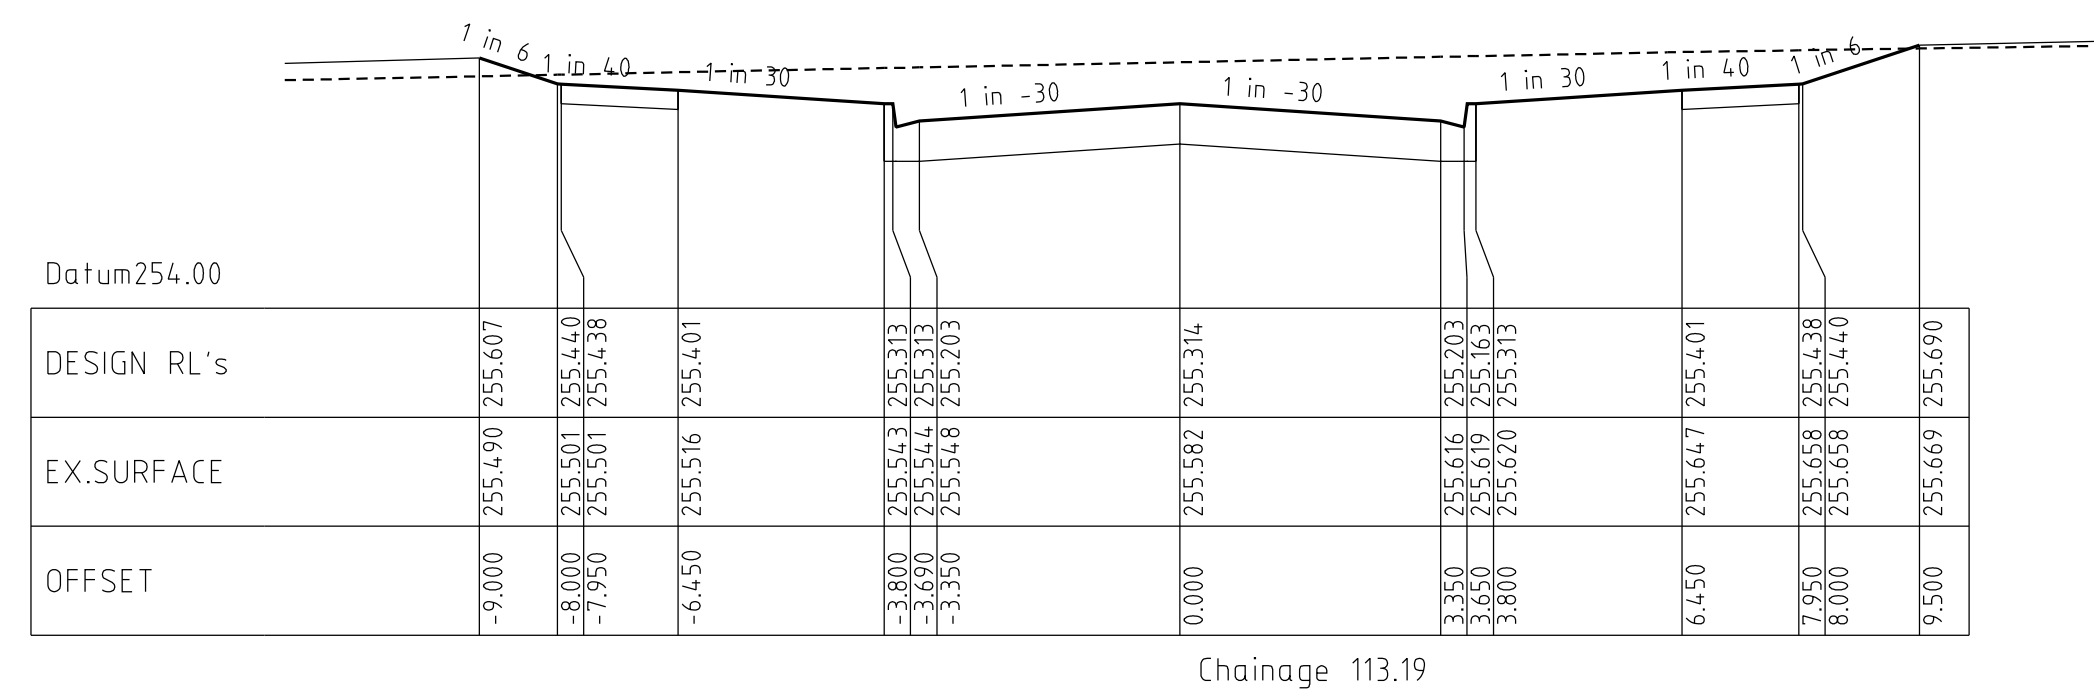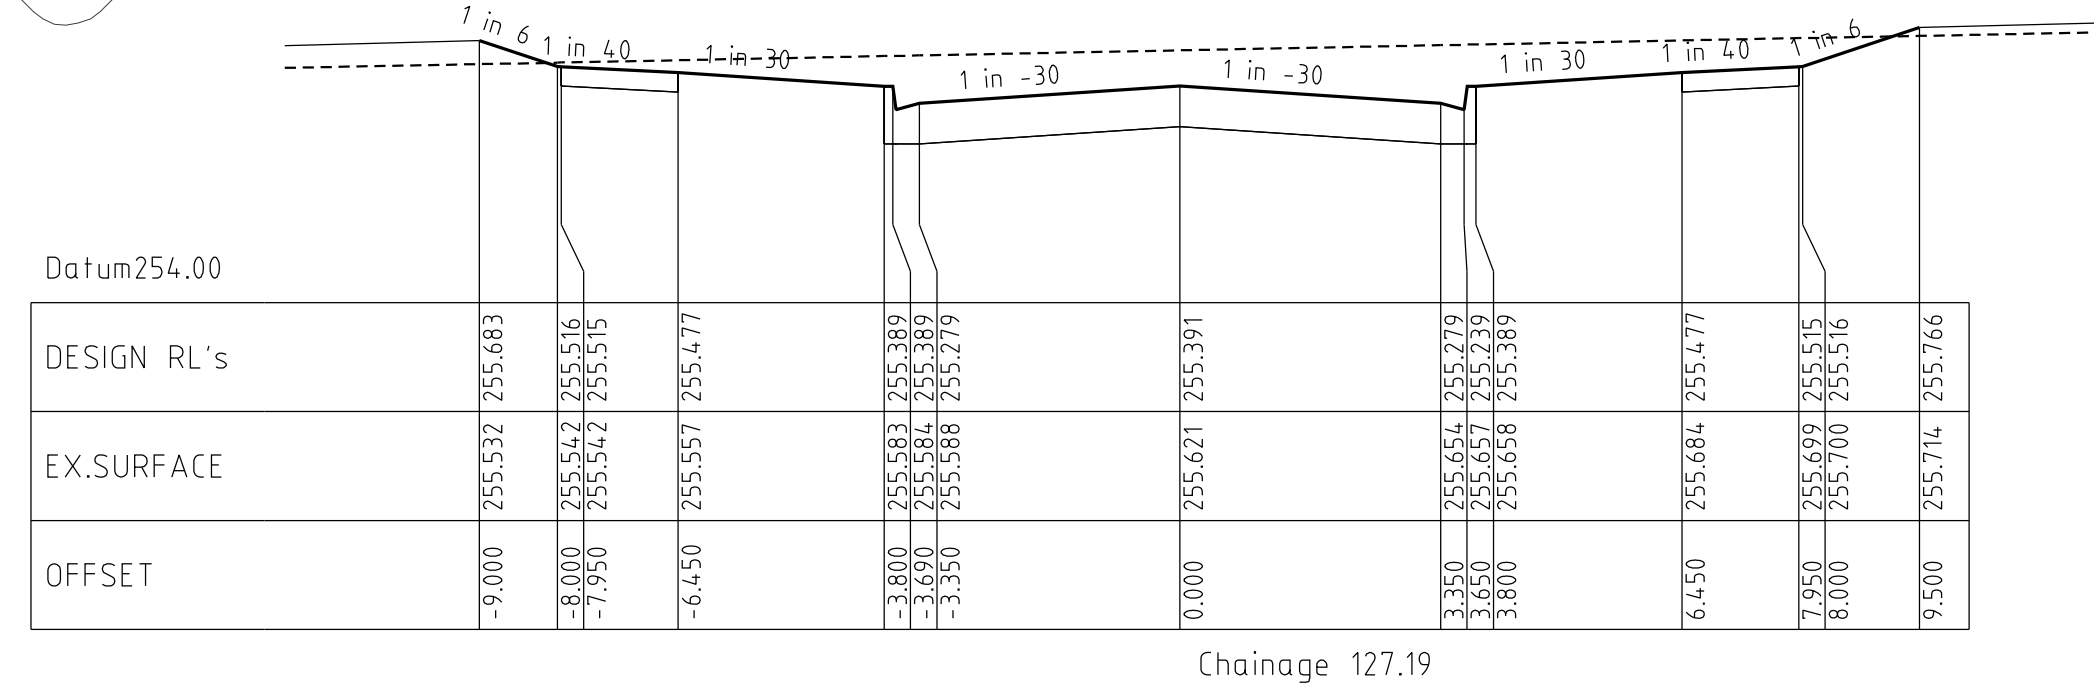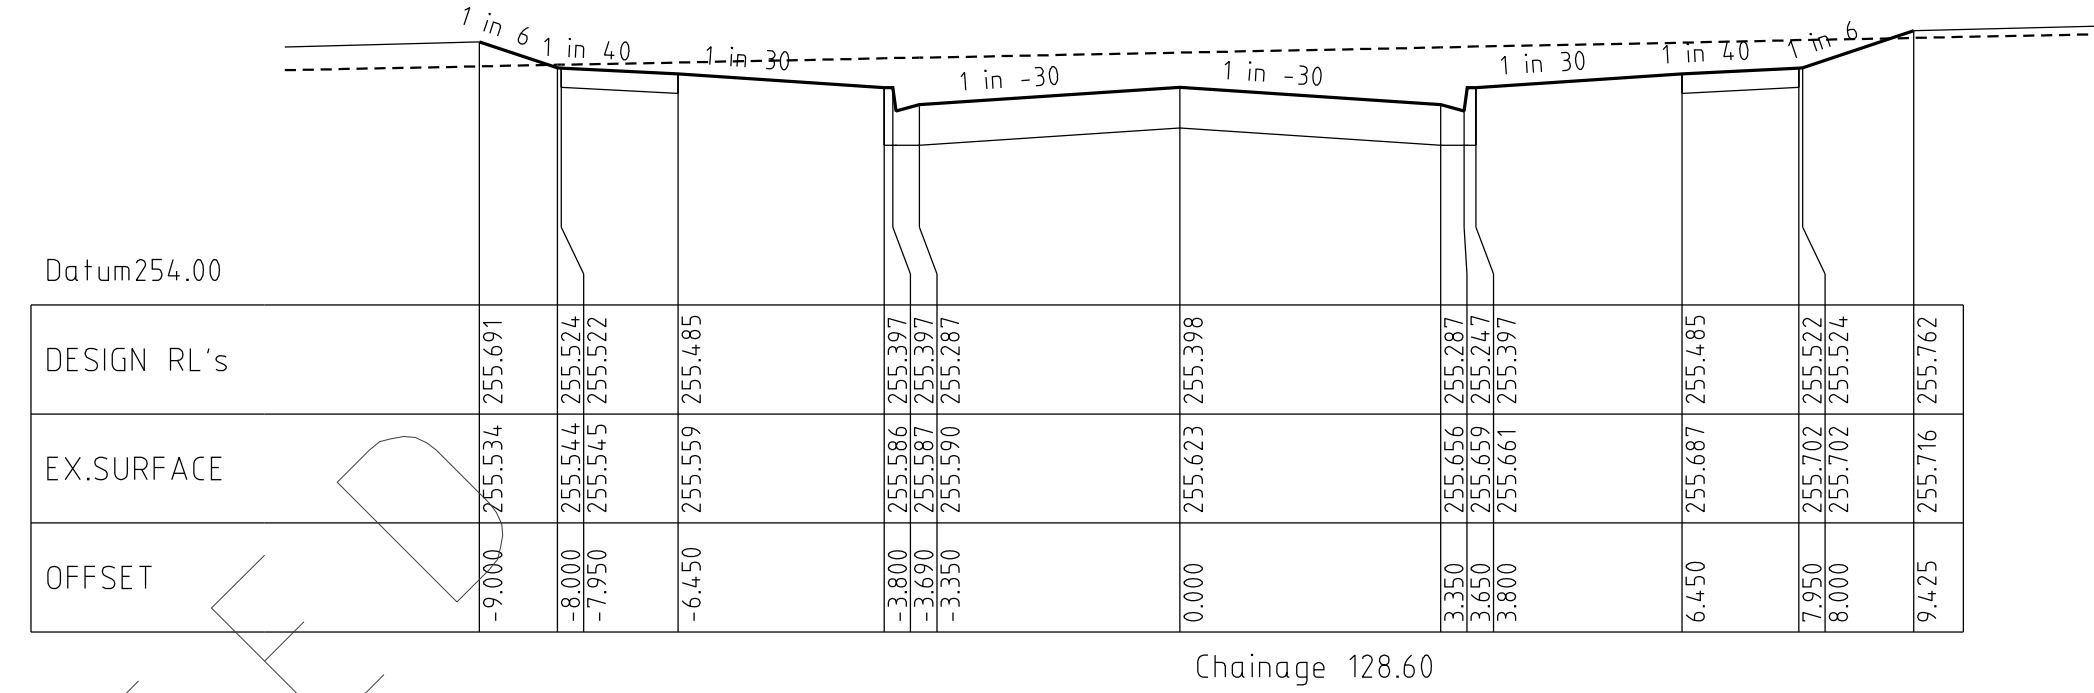

WATSONS

ABN 47 637 597 413



MORNINGTON

5 Main Street,
P.O. Box 171 3931
Phone: (03) 5975 4644
Fax: (03) 5975 5916
DX: 93118 Mornington

MELBOURNE


The Melbourne, Suite 2
250 St. Kilda Road
Melbourne, 3004
Phone: (03) 9697 8000
Fax: (03) 9697 8099

HUME CITY COUNCIL	PLAN NUMBER
VILLAWOOD PROPERTIES P/L TRILLIUM STAGE 5A MICKLEHAM ROAD AND DRAINAGE PLANS	36182/5A R08
PRIME STREET CROSS SECTIONS	REVISION M
	SHEET 8 OF 14

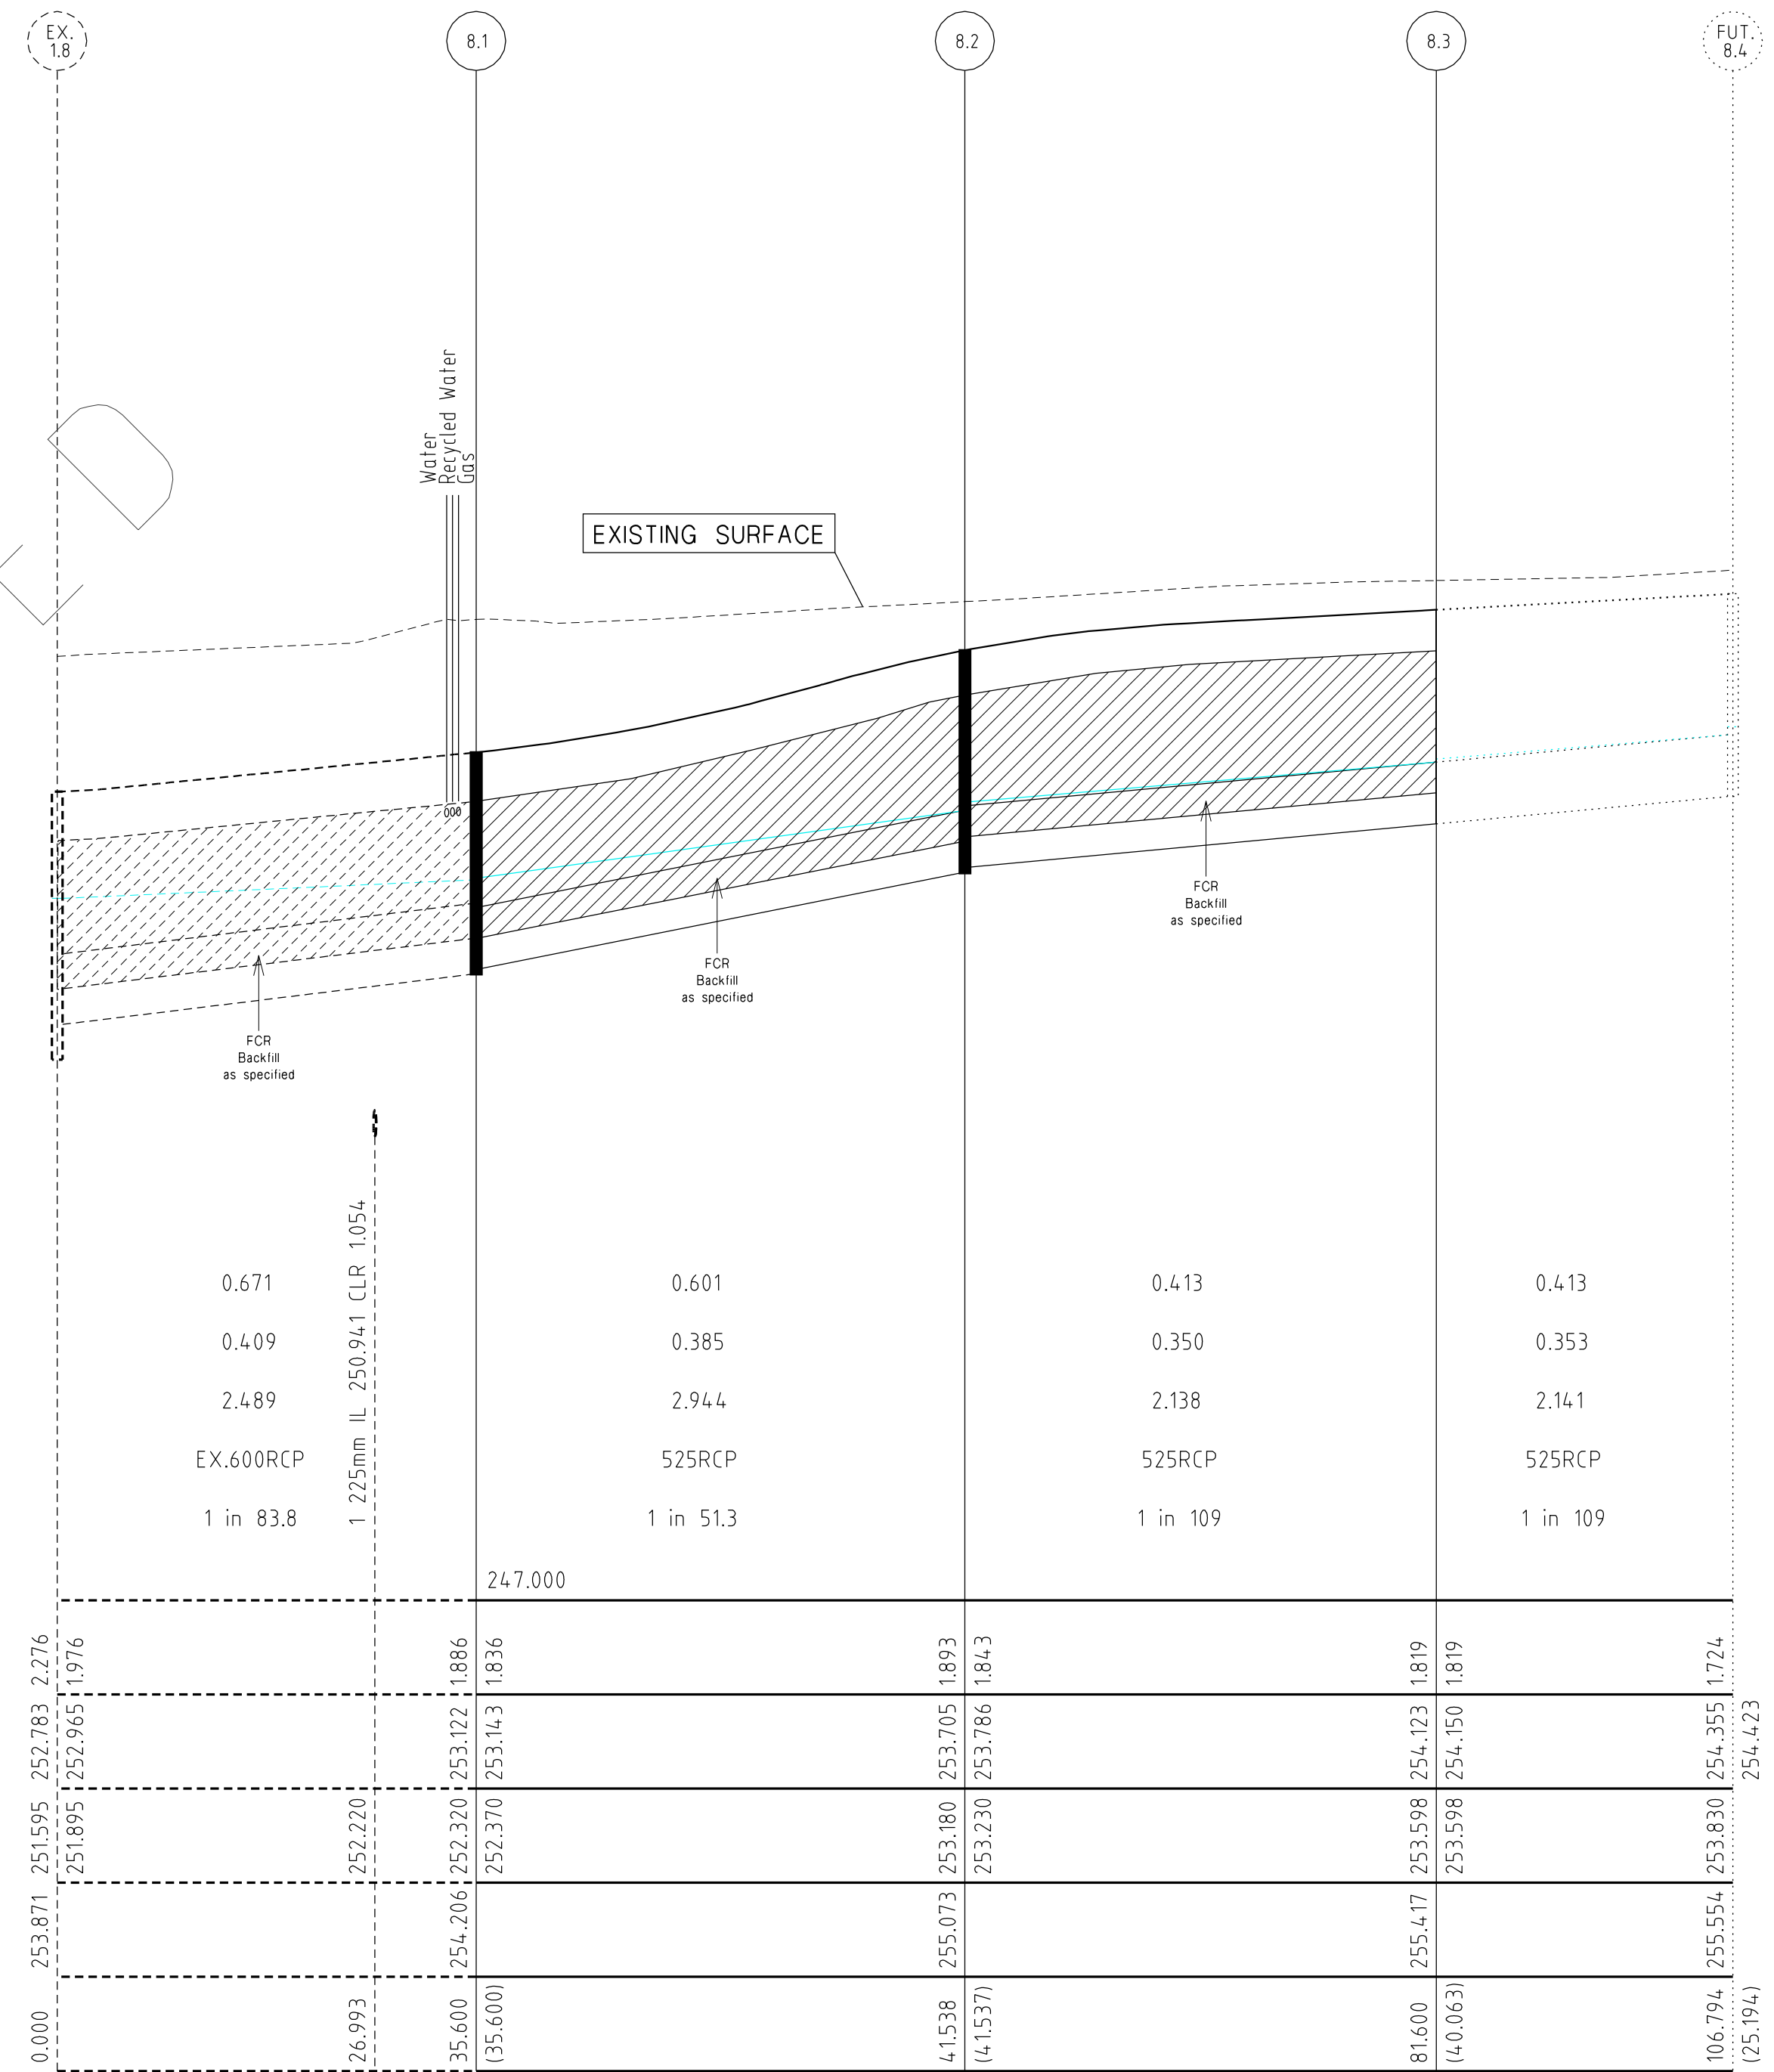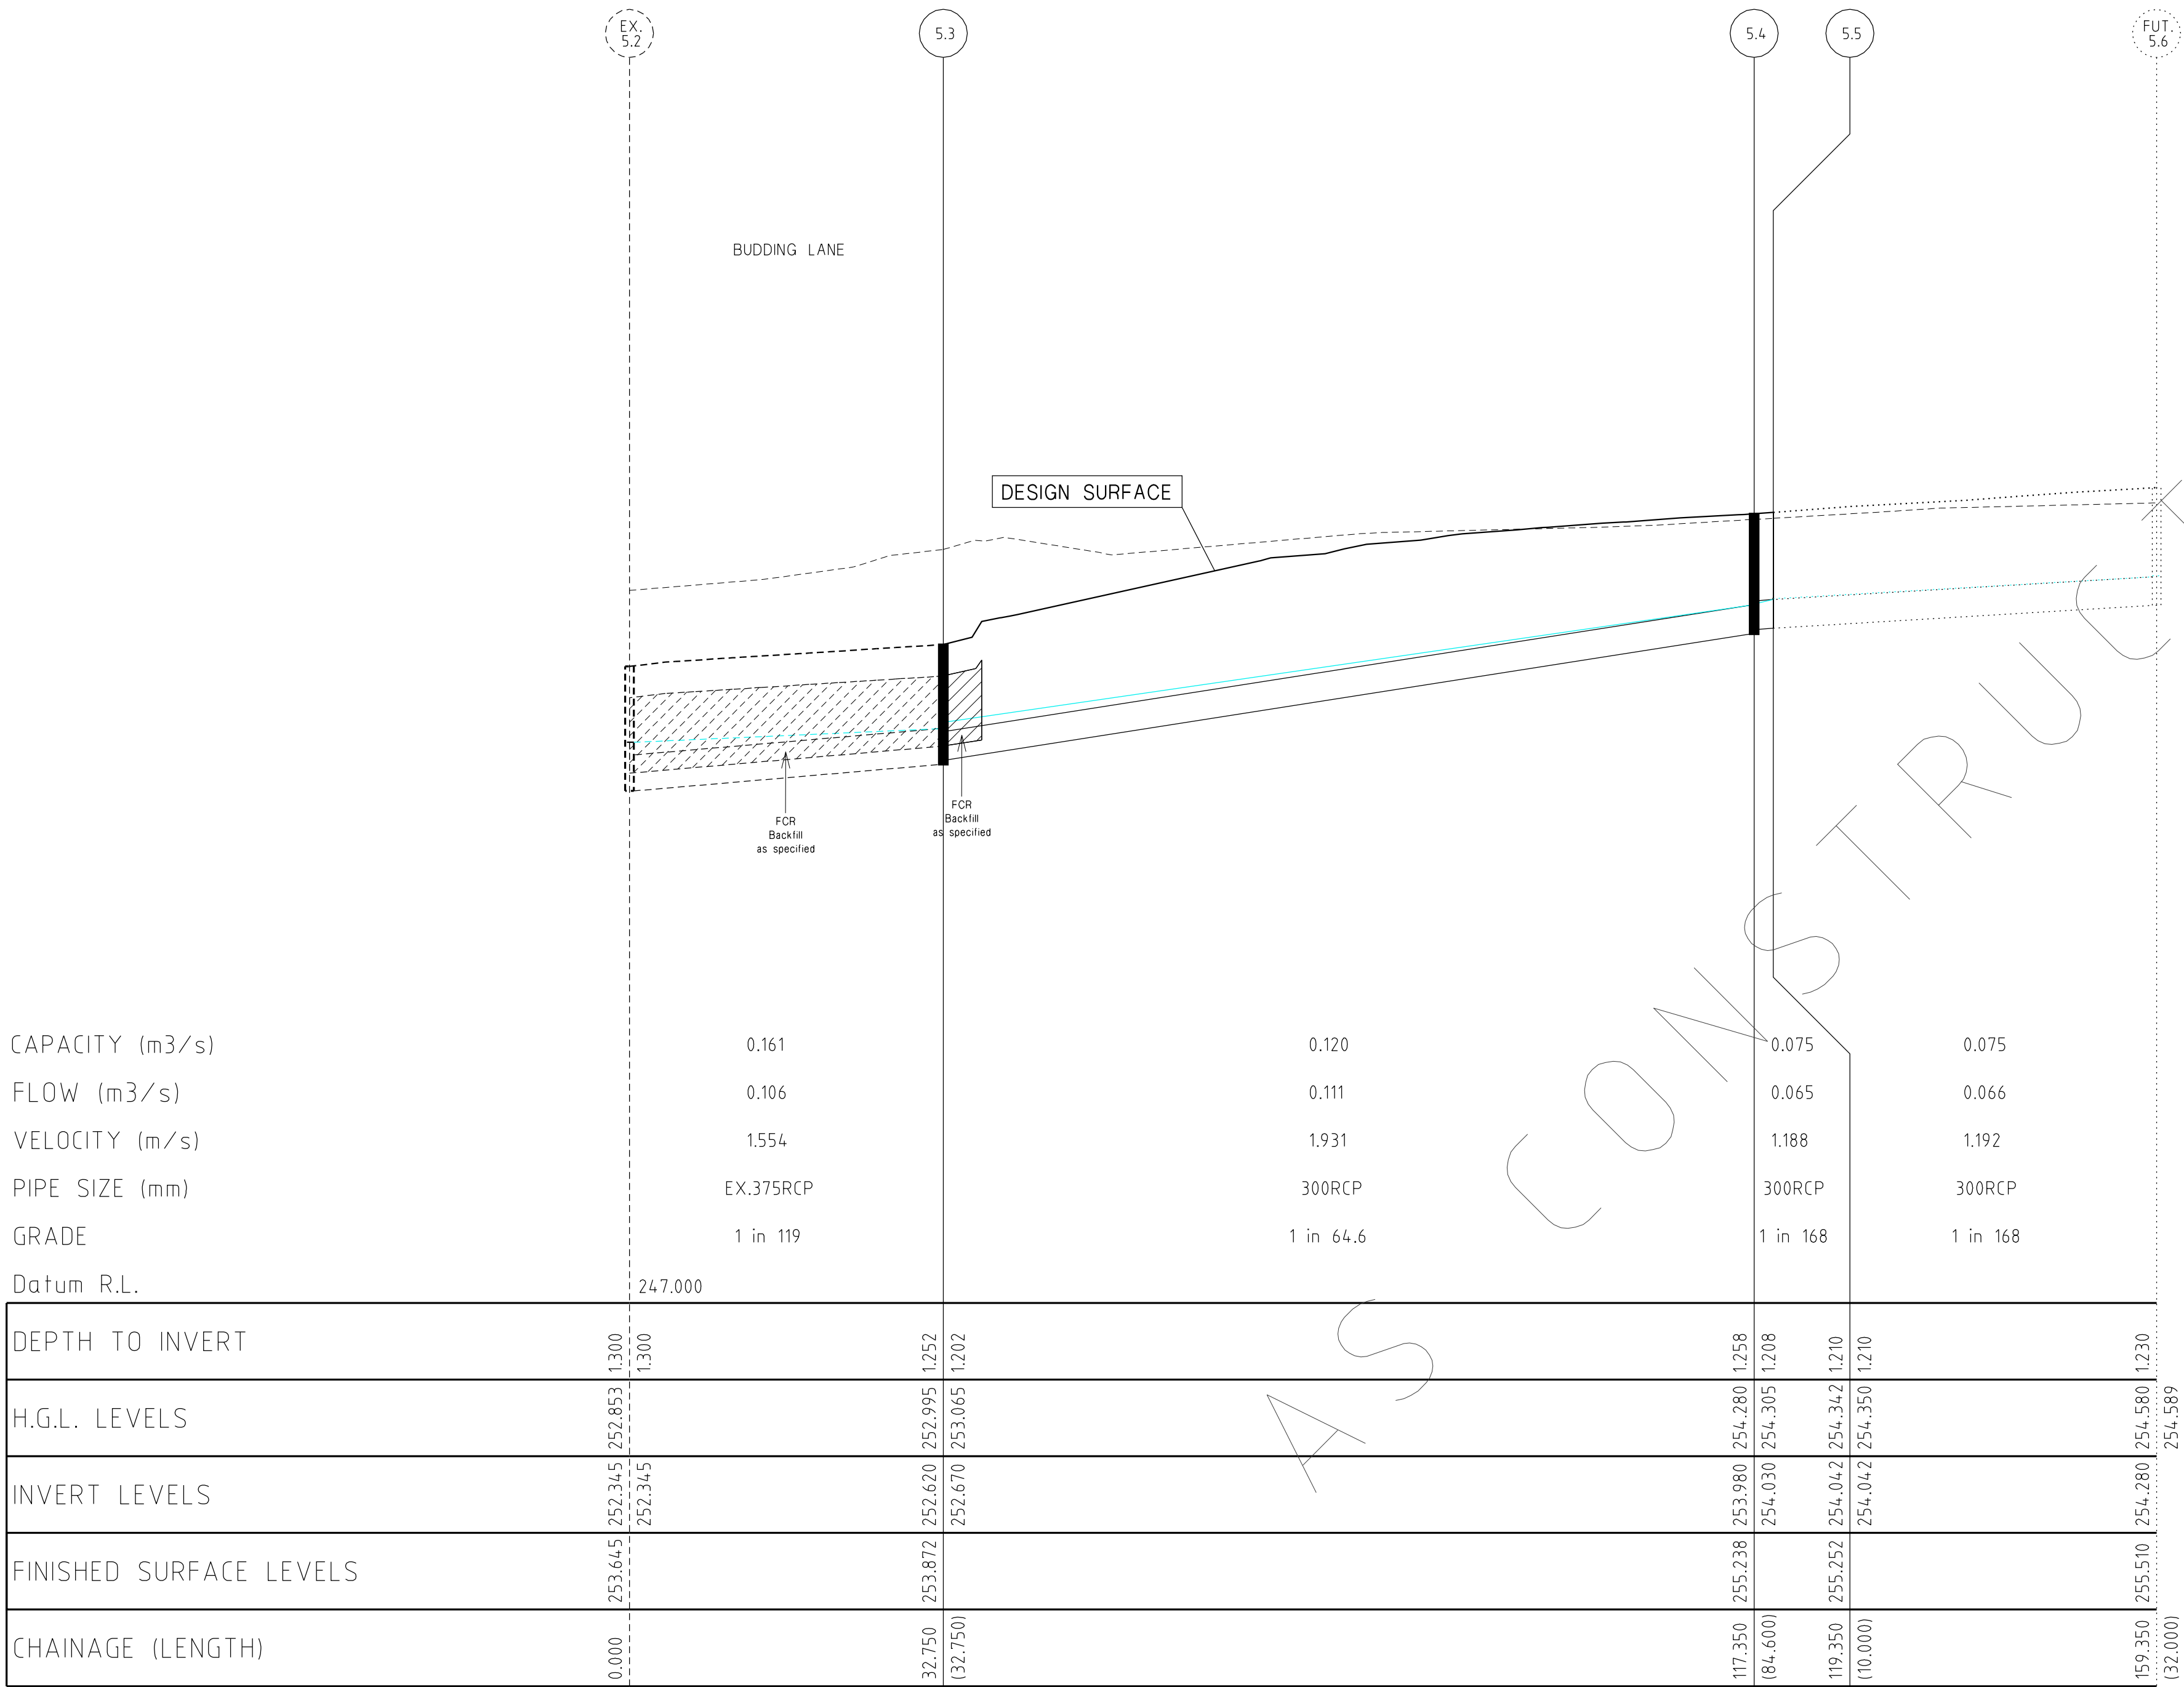


NOTE:
LOCATION OF GAS, WATER,
TELSTRA & ELECTRICITY
SERVICES INDICATIVE ONLY

DRAINAGE LONGITUDINAL SECTIONS

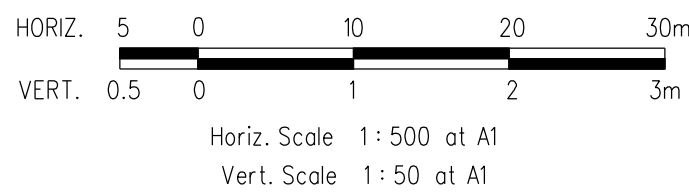


REVISIONS			SCALE: AS SHOWN	
DATE	DETAILS	AUTHORISED	DATE PRINTED:	17/04/2014
16/04/14	M	AS CONSTRUCTED	LEVEL DATA:	K:\36182\36182\LTPO
11/03/14	L	LOT 501 & 512 CROSSOVER AMENDED	DATUM:	AHD
3/12/13	K	LOT 501, 511, 512 & 524 PROPERTY SERVICE & HOUSE DRAIN RELOCATION	PROJECT No.:	36182/5A
2/12/13	J	LOT 511 CROSSOVER RELOCATION	DRAWN:	C.M.B. DATE: MAY 2013
29/10/13	I	CROSSOVER AMENDMENTS	DESIGNED:	Z.W.L. DATE: MAY 2013
FILENAME K:\36182\36182 5\dgn\R09.dgn			AUTHORISED:	A.S.C. DATE: MAY 2013

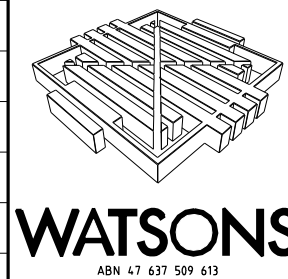


MORNINGTON
5 Main Street,
P.O. Box 171, 3931
Phone: (03) 5975 4444
Fax: (03) 5975 3936
OX 93118 Mornington
ABN 41 437 599 410

MELBOURNE
The Melbourne, Suite 2
250 St. Kilda Road,
Melbourne, 3004
Phone: (03) 9493 8000
Fax: (03) 9493 8099

HUME CITY COUNCIL		PLAN NUMBER
VILLAWOOD PROPERTIES P/L TRILLIUM STAGE 5A MICKLEHAM ROAD AND DRAINAGE PLANS		36182/5A R09
DRAINAGE LONGITUDINAL SECTION		REVISION M
		SHEET 9 OF 14

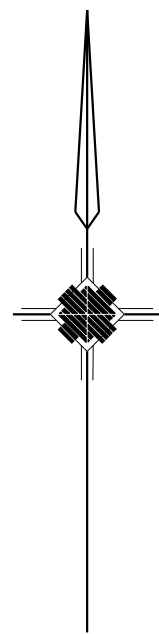

PARKING PLAN

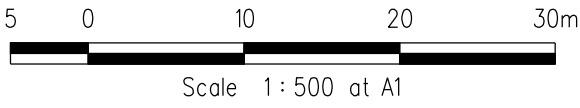

REVISIONS			SCALE: AS SHOWN	
DATE	DETAILS	AUTHORISED	DATE PRINTED:	16/04/2014
16/04/14	M	AS CONSTRUCTED	ASC	LEVEL DATA: K:\36182\36182\LT.OPO
11/03/14	L	LOT 501 & 512 CROSSOVER AMENDED	ASC	DATUM: AHD
3/12/13	K	LOT 501, 511, 512 & 524 PROPERTY SERVICE & HOUSE DRAIN RELOCATION	ASC	PROJECT No.: 36182/5A
2/12/13	J	LOT 511 CROSSOVER RELOCATION	ASC	DRAWN: C.M.B. DATE: MAY 2013
29/10/13	I	CROSSOVER AMENDMENTS	ASC	DESIGNED: Z.W.L. DATE: MAY 2013
FILENAME K:\36182\36182 5\dgn\r12.dgn			AUTHORISED: A.S.C.	DATE: MAY 2013



MORNINGTON
5 Main Street,
P.O. Box 171 3911
Phone: (03) 5975 4444
Fax: (03) 5975 3916
OX 93118 Mornington

MELBOURNE
The Melbourne, Suite 2
250 St. Kilda Road,
Melbourne, 3004
Phone: (03) 9697 8000
Fax: (03) 9697 8099


HUME CITY COUNCIL		PLAN NUMBER
VILLAWOOD PROPERTIES P/L TRILLIUM STAGE 5A MICKLEHAM ROAD AND DRAINAGE PLANS		36182/5A R12
PARKING PLAN		REVISION M
		SHEET 12 OF 14


PIT SCHEDULE

PIT NO. & TYPE	INTERNAL DIMENSIONS	EASTING	NORTHING	INLET DIA.	INLET I.L.	OUTLET DIA.	OUTLET I.L.	COVER LEVEL	DEPTH TO INVERT	REMARKS
FUT. 5.6 JP	Future	3770.253	10270.613			300	254.28	255.51	1.23	Future Pit
5.5 PC	-	3809.898	10265.297	300	254.042	300	254.042	255.252	1.21	End Capped (Future Pipe to Pipe Connection)
5.4 JP	900 x 600	3811.88	10265.031	300	254.03	300	253.98	255.238	1.258	GAA014: SD275(CIRCULAR PIT LID)
5.3 GP	900 x 600	3895.73	10253.789	300	252.67	375	252.62	253.872	1.252	GAA014: GRATED PIT LID (CLASS D)
EX. 5.2	Existing	3891.378	10221.33	375	252.345			253.645	1.3	Existing Pit
FUT. 8.4 JP	Future	3791.207	10315.476			525	253.83	255.554	1.724	Future Pit
8.3 PC	-	3816.177	10312.128	525	253.598	525	253.598	255.417	1.819	End Capped (Future Pipe to Pipe Connection)
8.2 SEP	900 x 750	3855.884	10306.804	525	253.23	525	253.18	255.073	1.893	GAA012 (HAUNCHED); SD275(CIRCULAR PIT LID)
				300	253.53			255.073	1.893	Line 31 Enters
8.1 JP	900 x 750	3897.053	10301.285	525	252.37	600	252.32	254.206	1.836	GAA014 (HAUNCHED); SD275(CIRCULAR PIT LID)
FUT. 11.4 JP	Future	3801.572	10392.784	300	254.51	300	254.46	255.806	1.346	Future Pit
11.3 PC	-	3827.936	10389.25	300	254.261	300	254.261	255.667	1.406	End Capped (Future Pipe to Pipe Connection)
11.2 SEP	900 x 600	3857.231	10385.322	300	254.04	375	253.99	255.512	1.522	GAA012: SD275(CIRCULAR PIT LID)
EX. 11.1 PC	-	3919.12	10377.024	375	253.11			255.048	1.938	Pipe to Pipe Connection
19.3 JP	900 x 600	3826.806	10380.825			300	254.46	255.667	1.207	GAA014: SD275(CIRCULAR PIT LID)
19.2 SEP	900 x 600	3856.102	10376.897	300	254.08	300	254.03	255.512	1.482	GAA012: SD275(CIRCULAR PIT LID)
EX. 19.1 PC	-	3917.99	10368.6	300	253.15			255.048	1.898	Pipe to Pipe Connection
31.1 SEP	900 x 600	3854.755	10298.38			300	253.709	255.073	1.365	GAA012: SD275(CIRCULAR PIT LID)


NOTE:

1. xy setout to pit centre
2. setout level to pit cover level

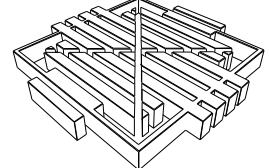REVISIONS				SCALE: AS SHOWN		 MORNINGTON 5 Main Street, P.O. Box 171 3931 Phone: (03) 5975 4444 Fax: (03) 5975 3916 OX 93118 Mornington ABN 47 627 509 410 MELBOURNE The Melbourne, Suite 2 250 St. Kilda Road, Melbourne, 3004 Phone: (03) 9697 8000 Fax: (03) 9697 8099	HUME CITY COUNCIL	PLAN NUMBER
DATE		DETAILS	AUTHORISED	DATE PRINTED:	17/04/2014		VILLAWOOD PROPERTIES P/L TRILLIUM STAGE 5A MICKLEHAM ROAD AND DRAINAGE PLANS	36182/5A R 11
16/04/14	M	AS CONSTRUCTED	ASC	LEVEL DATA:	K:\36182\36182\LTPOD		DRAINAGE PIT SCHEDULE	REVISION M
11/03/14	L	LOT 501 & 512 CROSSOVER AMENDED	ASC	DATUM:	AHD			SHEET 11 OF 14
3/12/13	K	LOT 501, 511, 512 & 524 PROPERTY SERVICE & HOUSE DRAIN RELOCATION	ASC	PROJECT No.:	36182/5A			
2/12/13	J	LOT 511 CROSSOVER RELOCATION	ASC	DRAWN:	C.M.B DATE: MAY 2013			
29/10/13	I	CROSSOVER AMENDMENTS	ASC	DESIGNED:	Z.W.L DATE: MAY 2013			
FILENAME K:\36182\36182 5\dgn\R11.dgn				AUTHORISED:	A.S.C DATE: MAY 2013			

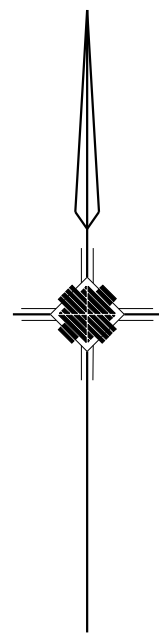

PARKING PLAN

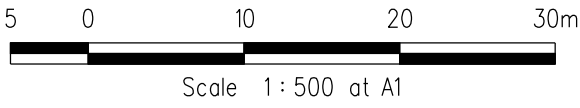

REVISIONS			SCALE: AS SHOWN	
DATE	DETAILS	AUTHORISED	DATE PRINTED:	17/04/2014
16/04/14	M AS CONSTRUCTED	ASC	LEVEL DATA:	K:\36182\36182\LT.OPO
11/03/14	L LOT 501 & 512 CROSSOVER AMENDED	ASC	DATUM:	AHD
3/12/13	K LOT 501, 511, 512 & 524 PROPERTY SERVICE & HOUSE DRAIN RELOCATION	ASC	PROJECT No.:	36182/5A
2/12/13	J LOT 511 CROSSOVER RELOCATION	ASC	DRAWN:	C.M.B. DATE: MAY 2013
29/10/13	I CROSSOVER AMENDMENTS	ASC	DESIGNED:	Z.W.L. DATE: MAY 2013
FILENAME K:\36182\36182 5\dgn\R12.dgn			AUTHORISED:	A.S.C. DATE: MAY 2013



MORNINGTON
5 Main Street,
P.O. Box 171 3911
Phone: (03) 5975 4444
Fax: (03) 5975 3916
OX 93118 Mornington

MELBOURNE
The Melbourne, Suite 2
250 St. Kilda Road,
Melbourne, 3004
Phone: (03) 9697 8000
Fax: (03) 9697 8099


HUME CITY COUNCIL		PLAN NUMBER
VILLAWOOD PROPERTIES P/L TRILLIUM STAGE 5A MICKLEHAM ROAD AND DRAINAGE PLANS		36182/5A R12
PARKING PLAN		REVISION M
		SHEET 12 OF 14

LEGEND



Area in Cut

Area in Fill (<200mm)

Area in Fill (>200mm)

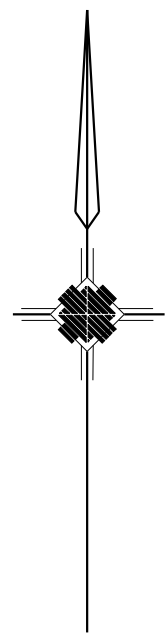

EARTHWORKS PLAN

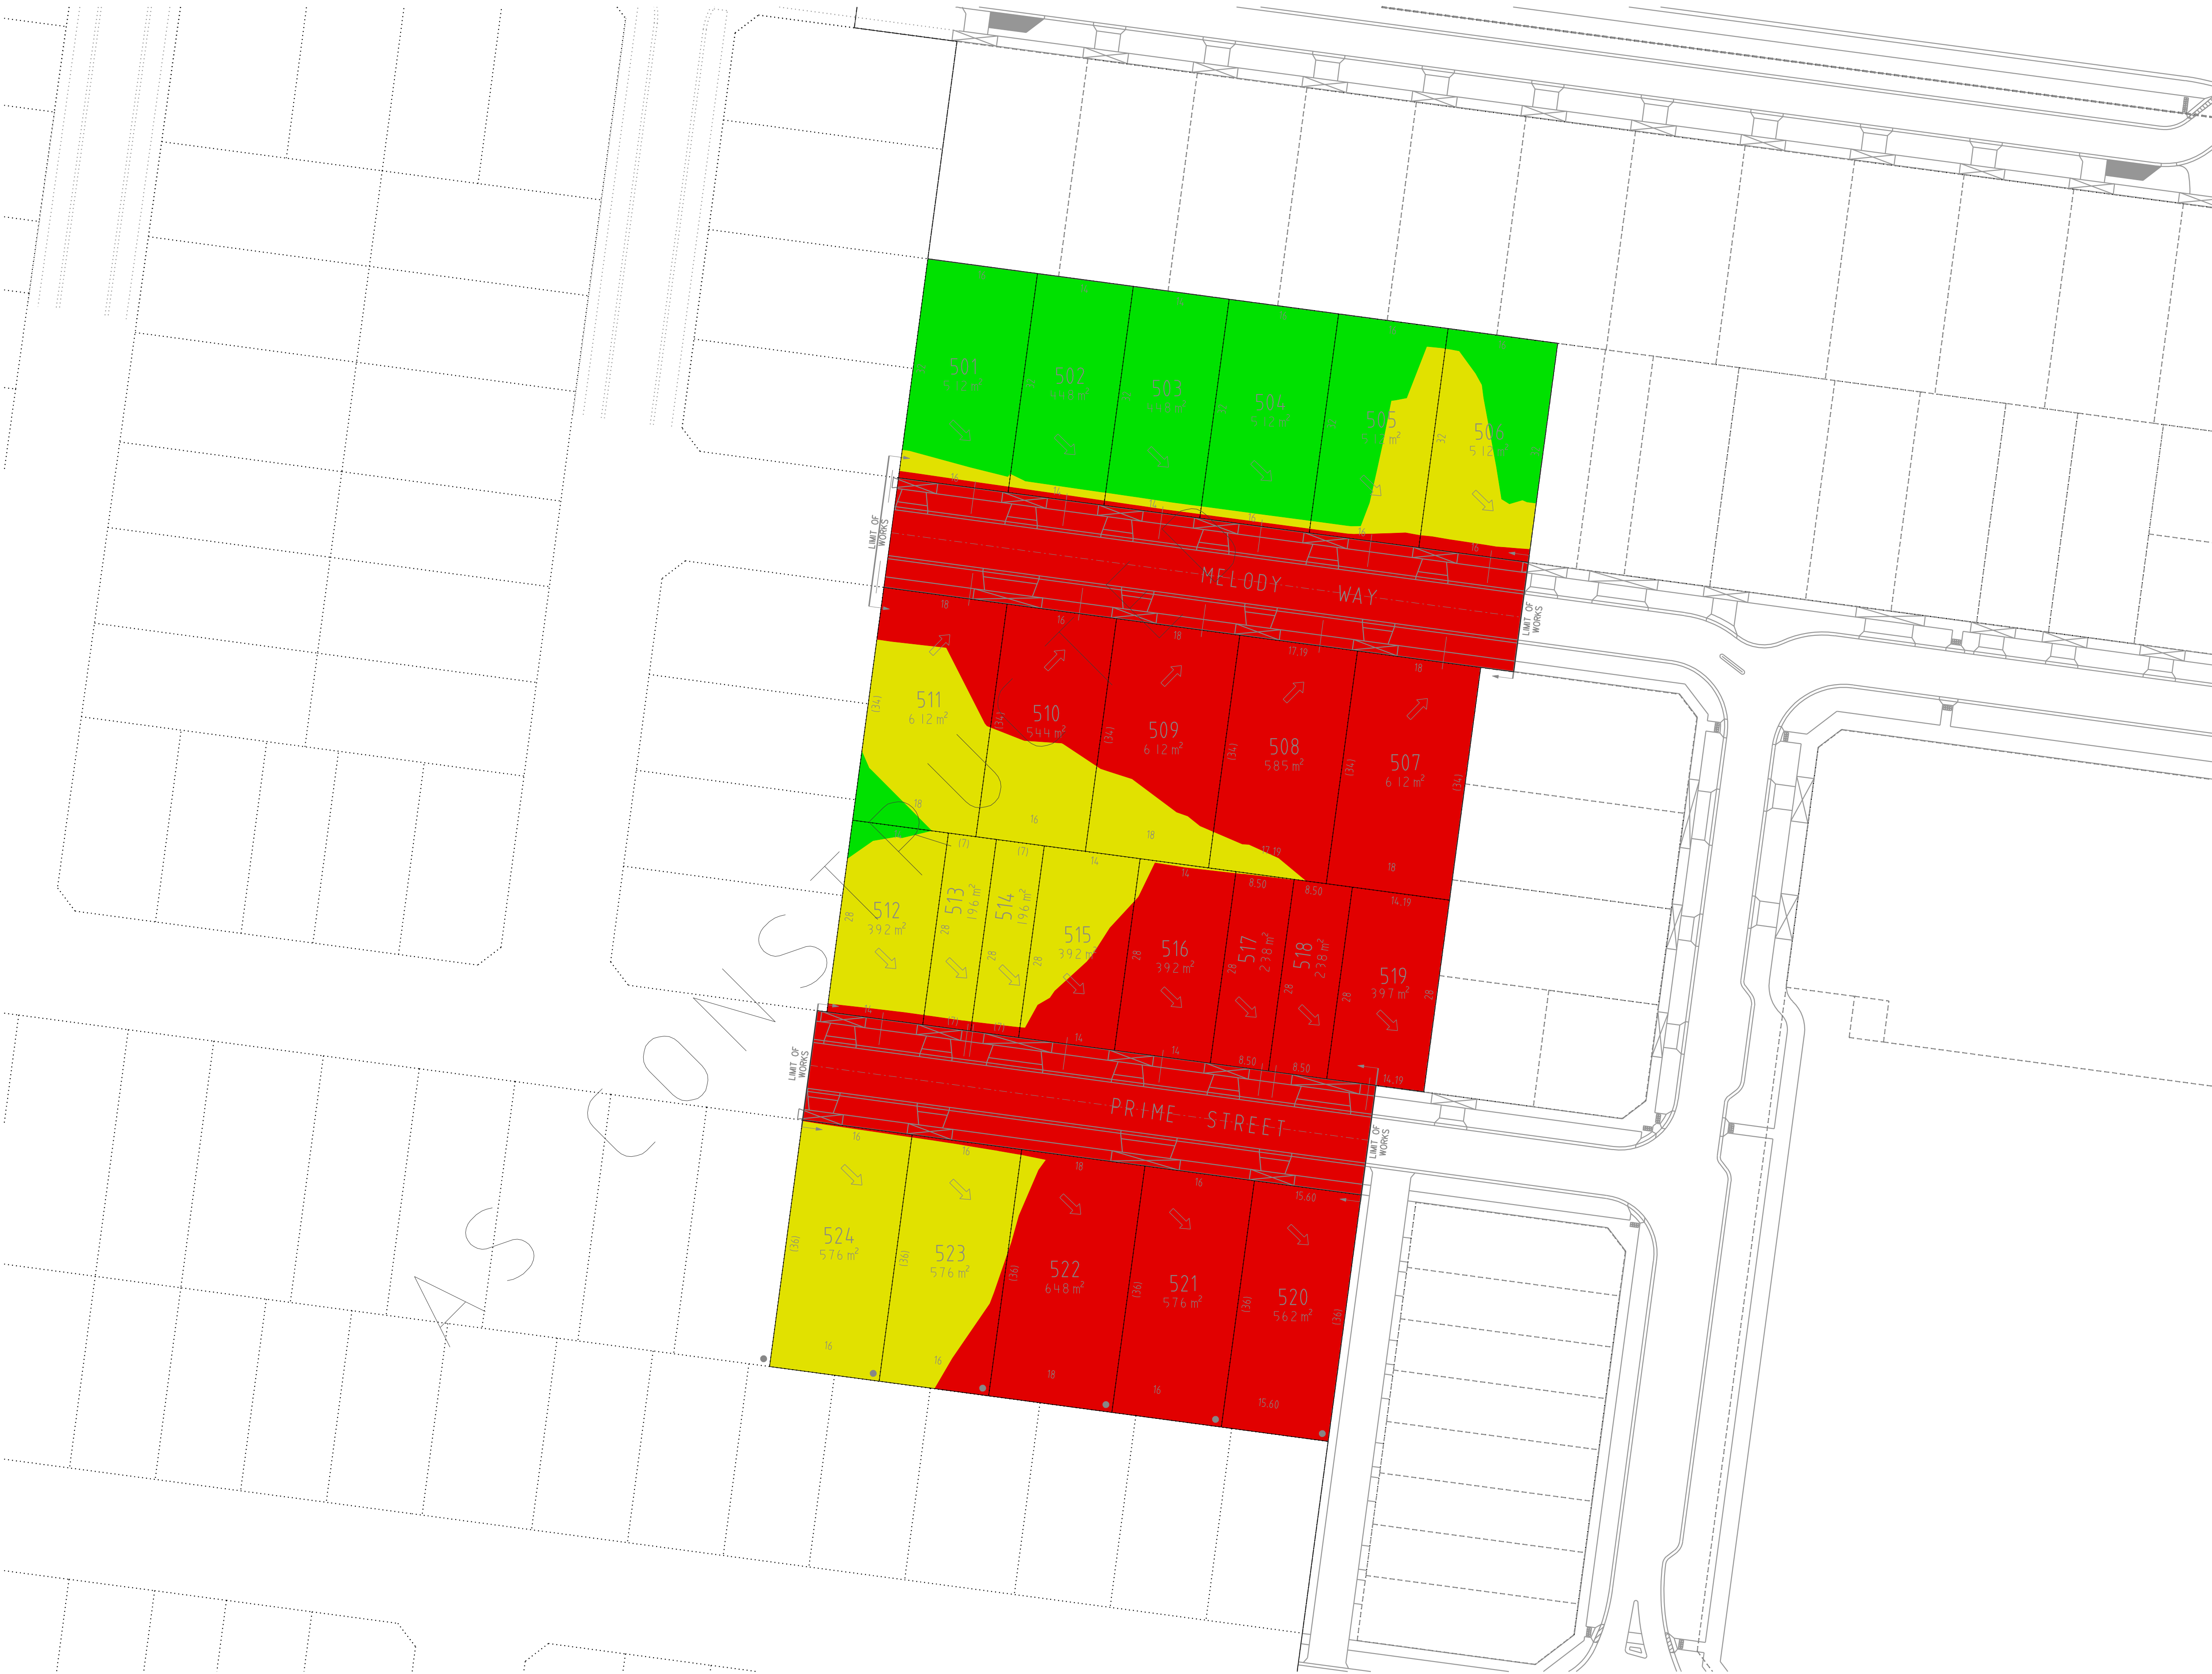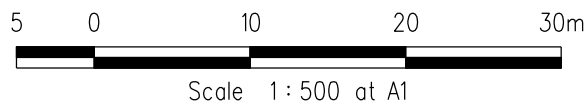



REVISIONS				SCALE: AS SHOWN	
DATE		DETAILS	AUTHORISED	DATE PRINTED:	17/04/2014
16/04/14	M	AS CONSTRUCTED	ASC	LEVEL DATA:	K:\36182\36182\LTPO
11/03/14	L	LOT 501 & 512 CROSSOVER AMENDED	ASC	DATUM:	AHD
3/12/13	K	LOT 501, 511, 512 & 524 PROPERTY SERVICE & HOUSE DRAIN RELOCATION	ASC	PROJECT No.:	36182/5A
2/12/13	J	LOT 511 CROSSOVER RELOCATION	ASC	DRAWN:	C.M.B. DATE: MAY 2013
29/10/13	I	CROSSOVER AMENDMENTS	ASC	DESIGNED:	Z.W.L. DATE: MAY 2013
FILENAME K:\36182\36182 5\dgn\R13.dgn				AUTHORISED:	A.S.C. DATE: MAY 2013



MORNINGTON
5 Main Street,
P.O. Box 171 3931
Phone: (03) 5975 4444
Fax: (03) 5975 3936
OX 93118 Mornington

MELBOURNE
The Melbourne, Suite 2
250 St. Kilda Road,
Melbourne, 3004
Phone: (03) 9697 8000
Fax: (03) 9697 8099

HUME CITY COUNCIL	PLAN NUMBER
VILLAWOOD PROPERTIES P/L TRILLIUM STAGE 5A MICKLEHAM ROAD AND DRAINAGE PLANS	36182/5A R13
EARTHWORKS PLAN	REVISION M
	SHEET 13 OF 14

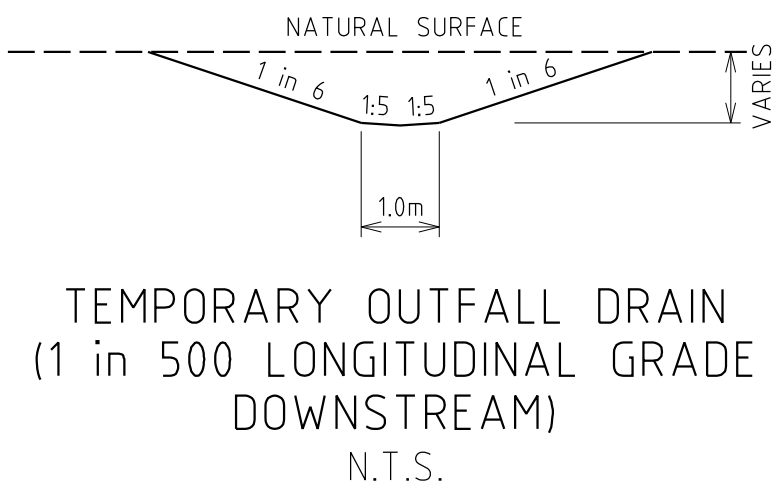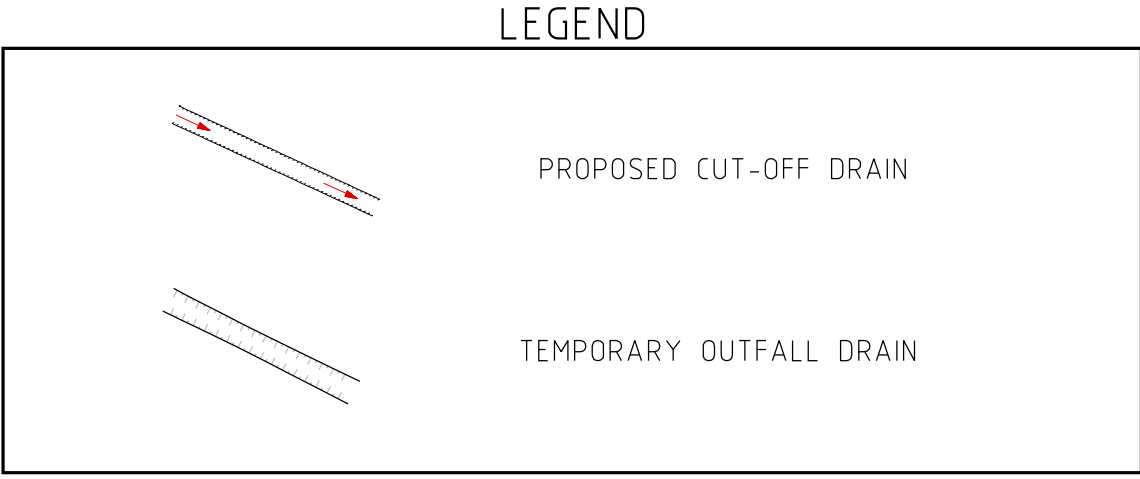

REVISIONS				SCALE: AS SHOWN	
DATE		DETAILS	AUTHORISED	DATE PRINTED:	17/04/2014
16/04/14	M	AS CONSTRUCTED	ASC	LEVEL DATA:	K:\36182\36182\LTPO
11/03/14	L	LOT 501 & 512 CROSSOVER AMENDED	ASC	DATUM:	AHD
3/12/13	K	LOT 501, 511, 512 & 524 PROPERTY SERVICE & HOUSE DRAIN RELOCATION	ASC	PROJECT No.:	36182/5A
2/12/13	J	LOT 511 CROSSOVER RELOCATION	ASC	DRAWN:	C.M.B. DATE: MAY 2013
29/10/13	I	CROSSOVER AMENDMENTS	ASC	DESIGNED:	Z.W.L. DATE: MAY 2013
FILENAME K:\36182\36182 5\dgn\R14.dgn				AUTHORISED:	A.S.C. DATE: MAY 2013



MORNINGTON
5 Main Street
P.O. Box 171 3931
Phone: (03) 5975 4444
Fax: (03) 5975 3916
DX 9318 Mornington

MELBOURNE
The Melbourne Suite 2
250 St. Kilda Road
Melbourne, 3004
Phone: (03) 9697 8000
Fax: (03) 9697 8099

HUME CITY COUNCIL		PLAN NUMBER
VILLAWOOD PROPERTIES P/L TRILLIUM STAGE 5A MICKLEHAM ROAD AND DRAINAGE PLANS		36182/5A R14
TEMPORARY CUTOFF DRAIN & TEMPORARY OUTFALL		REVISION M
		SHEET 14 OF 14