


AS CONSTRUCTED

DRAINAGE LONGITUDINAL SECTIONS - 6

SCALE: H 1:500, V 1:50

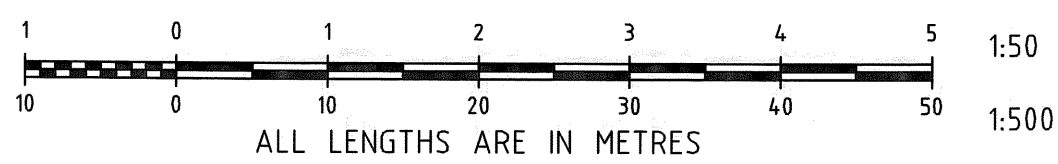

NOTE:
 DENOTES CRUSHED ROCK BACKFILL

AMENDMENTS		MELWAY REF. 354 D11		breese pitt dixon pty. ltd. land surveyors civil engineers		1/19 Cato Street Hawthorn East, 3123 Telephone 8823 2300 Fax no. 8823 2310	
SURVEY BJ		ASPIRE ESTATE STAGE 1		MUNICIPALITY MELTON		REFERENCE 8226 E/1	
DESIGN GP		DRAWN GP		SCALE AS SHOWN		DATE FEB 11	
VER. DATE		REMARKS		CHECKED		SHEET 36 OF 39	