

AS CONSTRUCTED

SHT. No.	VER	DRAWING INDEX	
		DESCRIPTION	
1	C	LAYOUT PLAN AND DETAILS	
2	C	NOTES AND TYPICAL CROSS SECTIONS	
3	B	INTERSECTION DETAILS - SHEET 1	
4	B	INTERSECTION DETAILS - SHEET 2	
5	B	WATERGARDENS CIRCUIT - LONGITUDINAL SECTION	
6	B	WATERGARDENS CIRCUIT - CROSS SECTIONS	
7	B	SPRAY CIRCUIT - LONGITUDINAL SECTION	
8	B	SPRAY CIRCUIT - CROSS SECTIONS	
9	B	DRAINAGE LONGITUDINAL SECTIONS - SHEET 1	
10	B	DRAINAGE LONGITUDINAL SECTIONS - SHEET 2	
11	B	SIGNAGE AND LINEMARKING PLAN	

SERVICES OFFSETS AND LOCATIONS

STREET NAME	Rd RESERVE	WATER		SEWER RISING MAIN	GAS	ELECTRICITY		FIBRE TO THE HOME		Bk. of KERB	JOINT TRENCHING
		DW	NDW			CABLES	POLES	FTTH CABLES	FTTH PITS		
WATERGARDEN CIRCUIT (LOTS 608-610)	16.00	2.95 W	2.50 W	1.55 W	2.10 W	2.10 E	1.00 BOK	0.80 E	1.80 W	4.20 W 3.90 E	G/DW/NDW & FTTH/E
WATERGARDEN CIRCUIT (LOTS 626-660)	16.00	2.95 S	2.50 S	1.55 S	2.10 S	2.40 N	1.00 BOK	1.80 N	1.80 S	4.20 S 3.90 N	G/DW/NDW & FTTH/E
WATERGARDEN CIRCUIT (LOTS 660-661)	13.50	2.90 N&W	2.45 N&W	1.55 N&W	2.00 N&W	4.30 N&W	1.00 BOK	3.50 N&W	3.50 N&W	1.20 S&E 6.35 N&W	G/DW/NDW & FTTH/E
SPRAY CIRCUIT (LOTS 611-615)	13.50	2.90 E	2.45 E	1.55 E	2.00 E	4.30 E	1.00 BOK	3.50 E	3.50 E	1.20 W 6.35 E	G/DW/NDW & FTTH/E
SPRAY CIRCUIT (LOTS 615-619)	13.50	2.90 S	2.45 S	1.55 S	2.00 S	4.30 S	1.00 BOK	3.50 S	3.50 S	1.20 N 6.35 S	G/DW/NDW & FTTH/E
SPRAY CIRCUIT (LOTS 619-622)	13.50	2.90 W	2.45 W	1.55 W	2.00 W	4.30 W	1.00 BOK	3.50 W	3.50 W	1.20 E 6.35 W	G/DW/NDW & FTTH/E


LEGEND

- PROP DRAINAGE
- EXIST DRAINAGE
- DRAINAGE PIT/DIA./FLOW
- PROPERTY INLET
- HOUSE DRAIN
- RETAINING WALL DRAIN
- PROP/EX/FUT SEWER
- PROP/EX/FUT WATER
- PROP/EX/FUT 100mm CONDUIT
- PROP RETAINING WALL
- EXIST RETAINING WALL
- EXIST HP OIL
- EXIST TELECOMS
- 100Ø IRRIGATION CONDUIT
- FILL - PROP / EXIST
- CUT - PROP / EXIST
- LOT FALL
- LOT LEVEL - F.S. / EXIST
- F.S. AT BUILDING LINE
- TOP / TOE OF BATTER
- KERBING TYPE
- LOT Bdy CHAINAGE
- LOTS EASEMENT
- STREET SIGN
- LINEMARKING
- DRIVEWAY
- PSM
- REMOVE EXIST TREE



WARNING
BEWARE OF UNDERGROUND SERVICES
THE LOCATIONS OF UNDERGROUND SERVICES ARE APPROXIMATE ONLY AND THEIR EXACT POSITION SHOULD BE PROVEN ON SITE. NO GUARANTEE IS GIVEN THAT ALL EXISTING SERVICES ARE SHOWN.

- ATTENTION TO CONTRACTOR**
- IT IS THE CONTRACTORS RESPONSIBILITY TO ENSURE THAT THE DIGITAL PLAN, PROVIDED FOR SETOUT PURPOSES, MATCHES THE TBM COORDINATES SHOWN.
 - CONTRACTOR TO ENSURE THAT THE SITE IS PEGGED AND OR SET OUT CHECKED BY THE LICENCED SURVEYOR RESPONSIBLE FOR CERTIFYING THE PLAN OF SUBDIVISION PRIOR TO UNDERGROUND INFRASTRUCTURE BEING INSTALLED.
 - WHERE CONCRETE WORKS ABOUT A SEWER ACCESS CHAMBER SURROUND OR SIMILAR STRUCTURE, AN EXPANSION JOINT OF APPROVED MATERIAL SHALL BE PROVIDED BETWEEN THE TWO FACES.

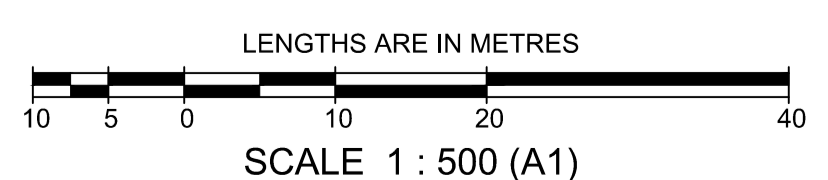

breese pitt dixon pty. ltd.
land surveyors civil engineers

1/19 cafo street hawthorn east, 3123 telephone 8823 2300 fax no. 8823 2310

AQUAREVO ESTATE STAGE 6B
LAYOUT PLAN AND DETAILS

MUNICIPALITY: CASEY
REFERENCE: 8766 E/06B

SCALE: As Shown DATUM: AHD DATE: Jun'19 SHEET: 1 OF 11

VER	DATE	REMARKS	CHECKED
C	29/04/20	SERVICE OFFSETS WATERGARDEN CIRCUIT (LOTS 608-610)	
B	09/03/20	POS REVISED (LOTS 611-630, 658-661)	
A	15/08/19	ISSUED FOR CONSTRUCTION	