



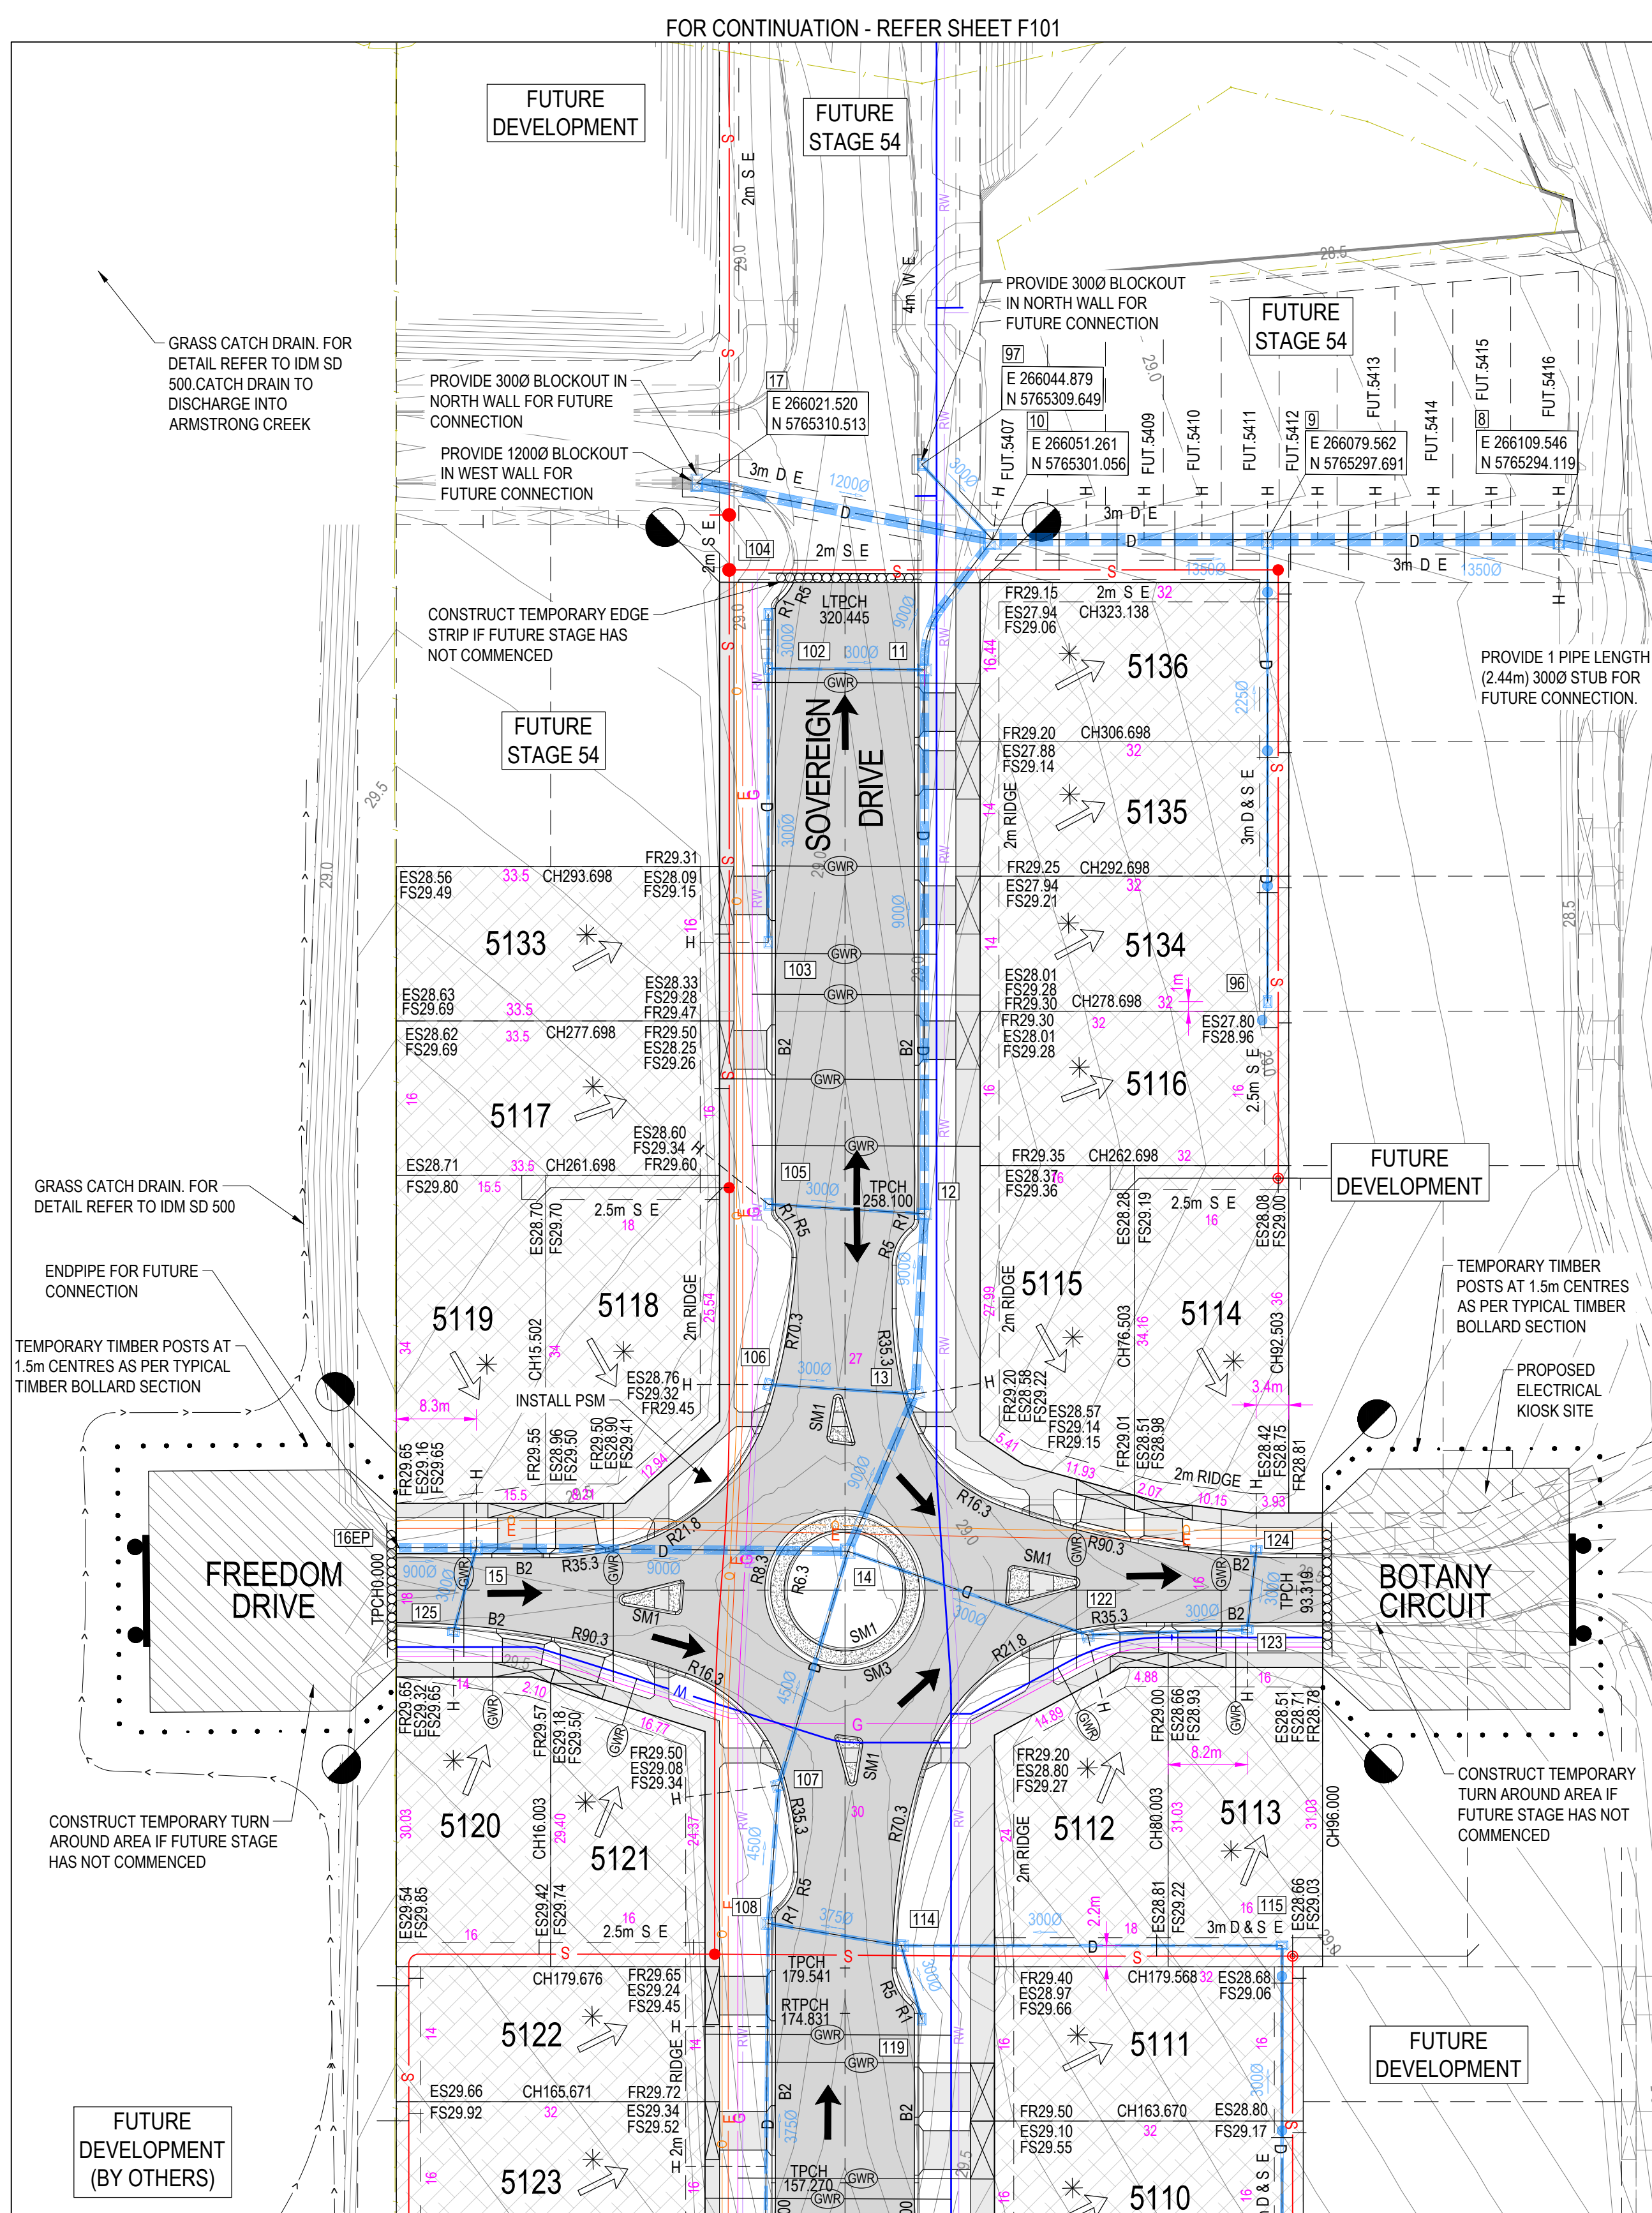


ROAD NAME	GAS		RECYCLED WATER		POTABLE WATER		OPTIC FIBRE		ELECTRICITY		RW TRUNK MAIN	
	SIDE	OFFSET	SIDE	OFFSET	SIDE	OFFSET	SIDE	OFFSET	SIDE	OFFSET	SIDE	OFFSET
SOVEREIGN DRIVE	W	3.60	W	4.10	E	4.50	W	1.80	W	2.40	E	3.7
BOTANY CIRCUIT	S	2.10	S	2.60	S	3.10	N	1.80	N	2.60	-	-
FREEDOM DRIVE	S	2.10	S	2.60	S	3.10	N	1.80	N	2.60	-	-


SCALE AT A1	DRAWN	DESIGNED
1:500 @ A1	M.TROUNCE	M.TROUNCE
PROJECT ENGINEER	PROJECT MANAGER	DATE FIRST ISSUE
T.PALIOS	T.PALIOS	FEB 2019
PROJECT No.	DRAWING No.	REVISION
180016.51	R200	AC1

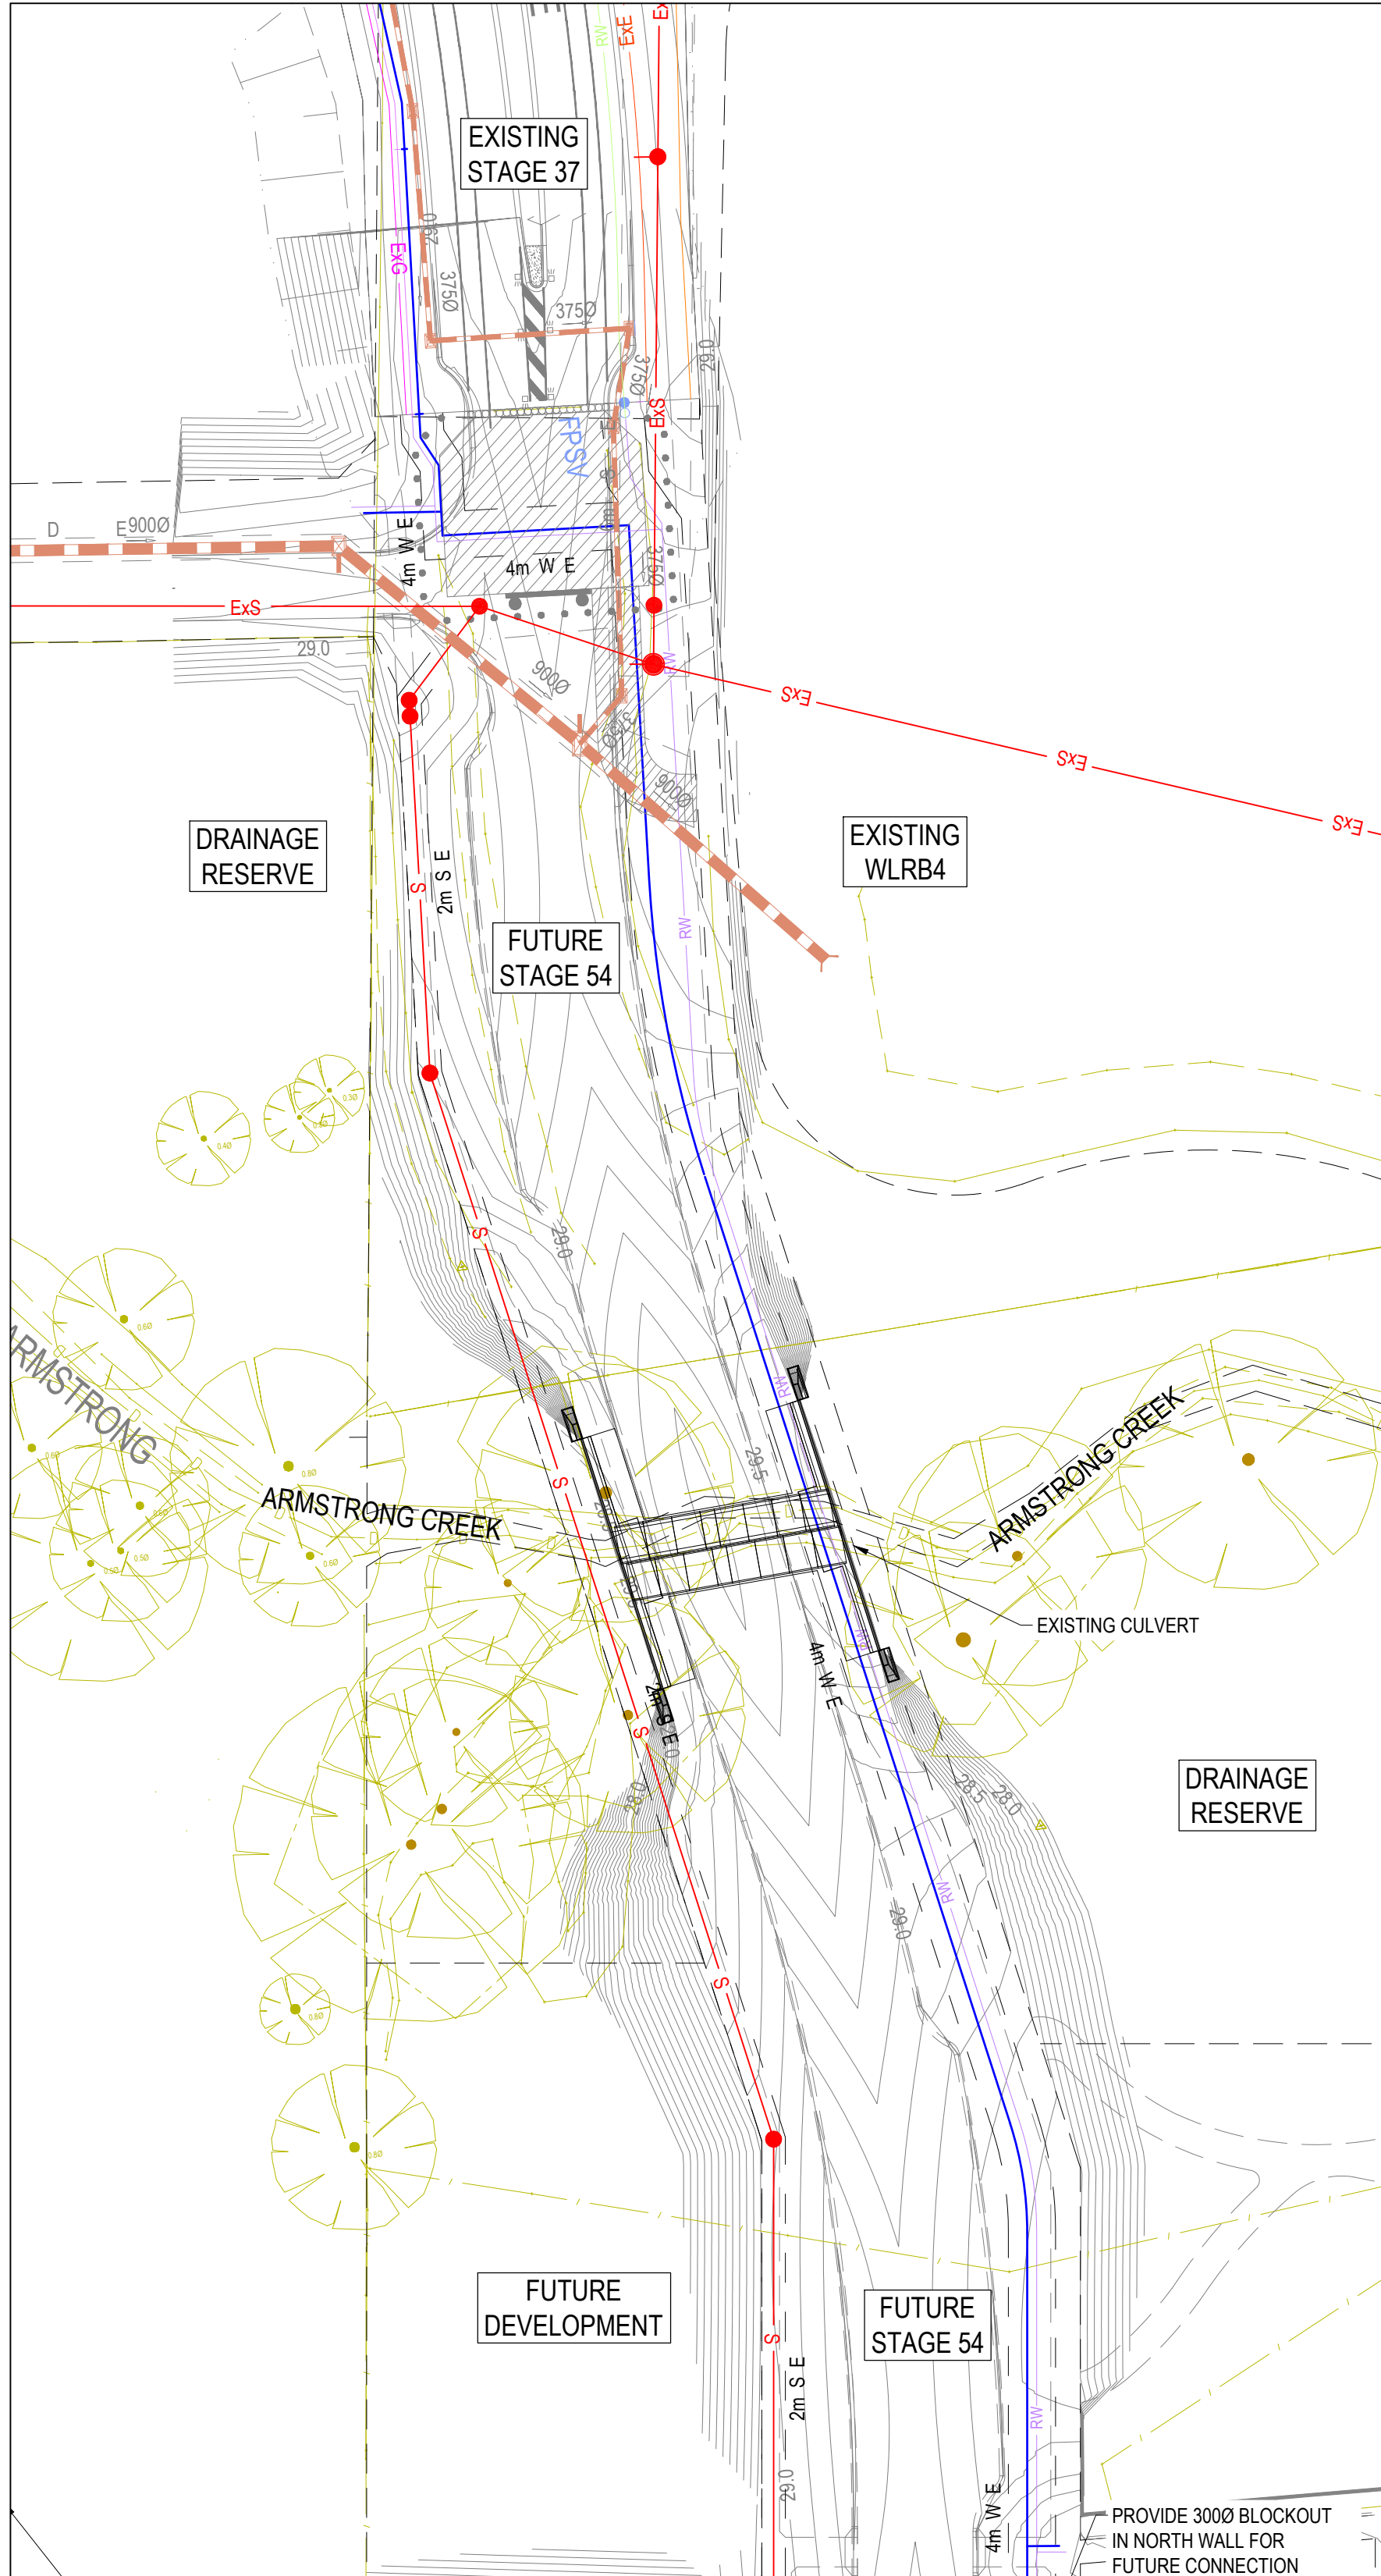

FOR CONTINUATION - REFER SHEET F100

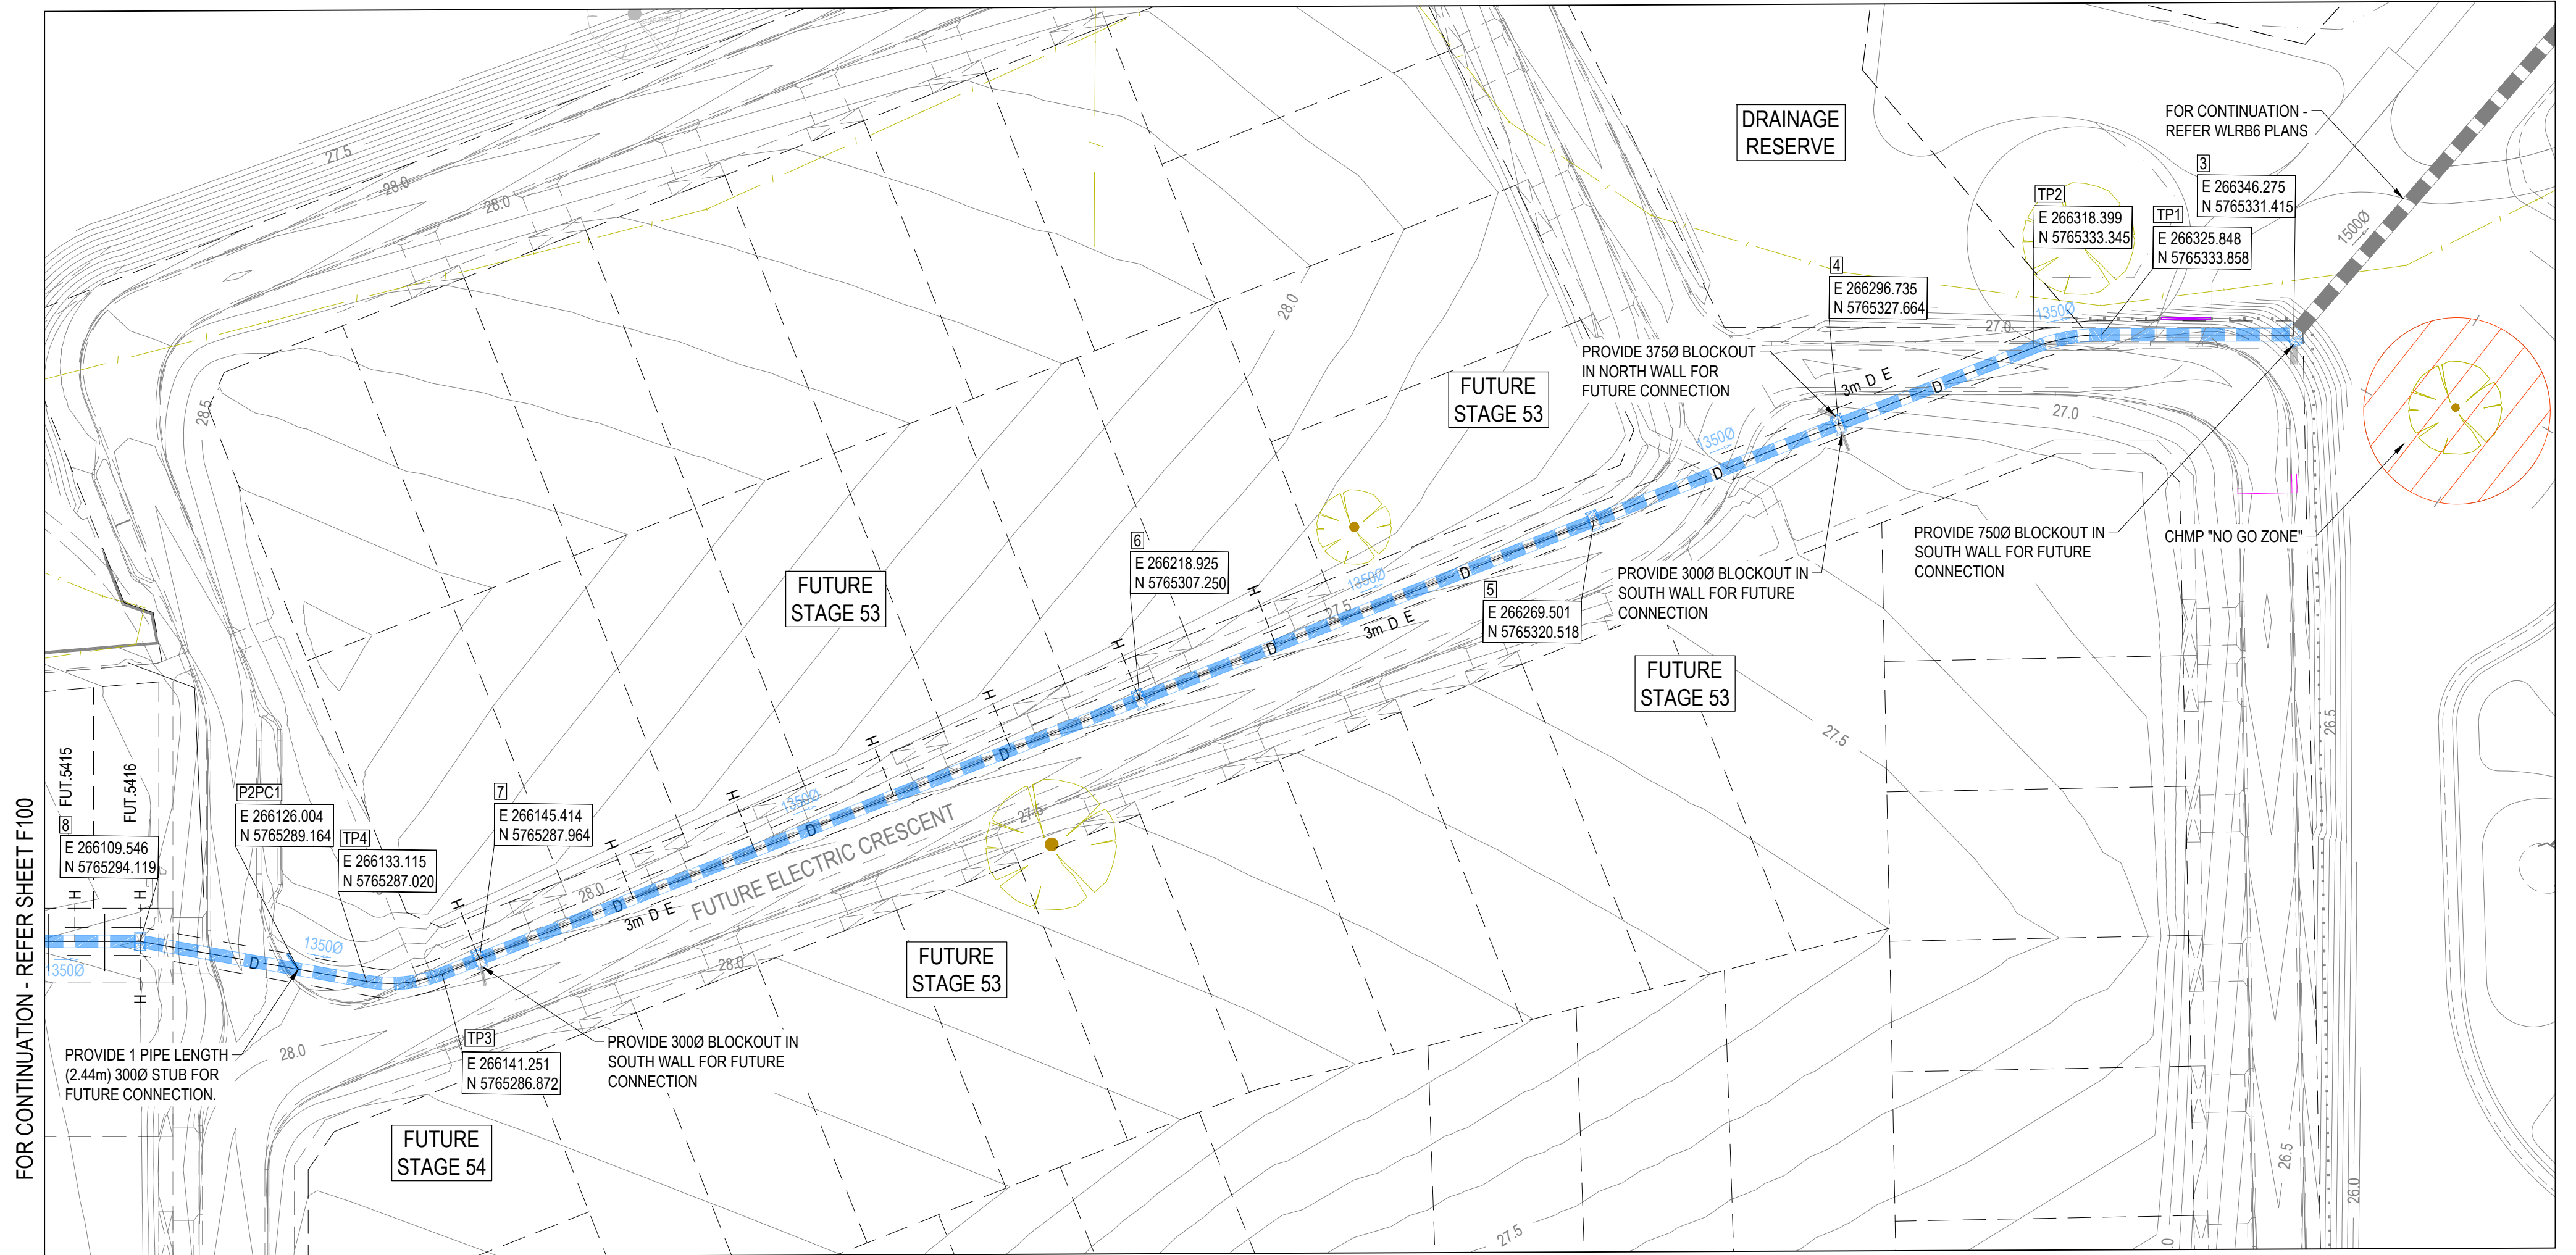

FOR CONTINUATION - REFER SHEET F100

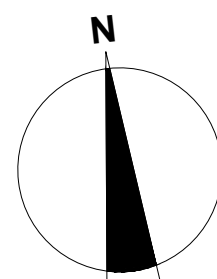


1:500
1:1000
10 5 0 10 20 A1
A3

WARNING
BEWARE OF UNDERGROUND & OVERHEAD SERVICES
The locations of underground & overhead services are approximate only & their exact position should be proven on site. No guarantee is given that all existing services are shown. Locate all underground services before commencement of works
DIAL 1100 BEFORE YOU DIG
www.1100.com.au

- LEGEND - LAYOUT PLAN**
- STORMWATER DRAIN, PIT & PROPERTY INLET
 - SWALE DRAIN
 - SEWER & MAINTENANCE STRUCTURES
 - HOUSE DRAIN
 - SERVICE CONDUITS
 - TACTILE PAVERS
 - EXISTING ELECTRICITY (UNDERGROUND)
 - EXISTING ELECTRICITY (OVERHEAD)
 - EXISTING GAS
 - EXISTING OPTIC FIBRE
 - EXISTING TELSTRA
 - EXISTING WATER
 - EXISTING RECYCLED WATER
 - EXISTING STORMWATER DRAIN
 - EXISTING SEWER
 - EXISTING HOUSE DRAIN
 - EXISTING SWALE DRAIN
 - EXISTING SURFACE LEVEL
 - FINISHED BUILDING LINE LEVEL
 - FINISHED RIDGE LINE LEVEL
 - TOP OF RETAINING WALL
 - BOTTOM OF RETAINING WALL
 - RETAINING WALL
 - PAVEMENT TREATMENT
 - STRUCTURAL FILL > 200mm DEEP
 - EX. STRUCTURAL FILL > 200mm DEEP

- DIRECTION OF FALL
- OVERLAND FLOW
- ALLOTMENT TO BE GRADED EVENLY IN
- DIRECTION OF FALL TO LEVELS INDICATED
- CONCRETE EDGE STRIP WITH SUBSOIL DRAIN
- "NO ROAD" SIGN & BARRIER
- LIMIT OF WORKS
- EXISTING TREE TO BE REMOVED
- PERMANENT SURVEY MARK
- TEMPORARY BENCH MARK
- PROPOSED DRIVEWAY
- BUILDING ENVELOPES

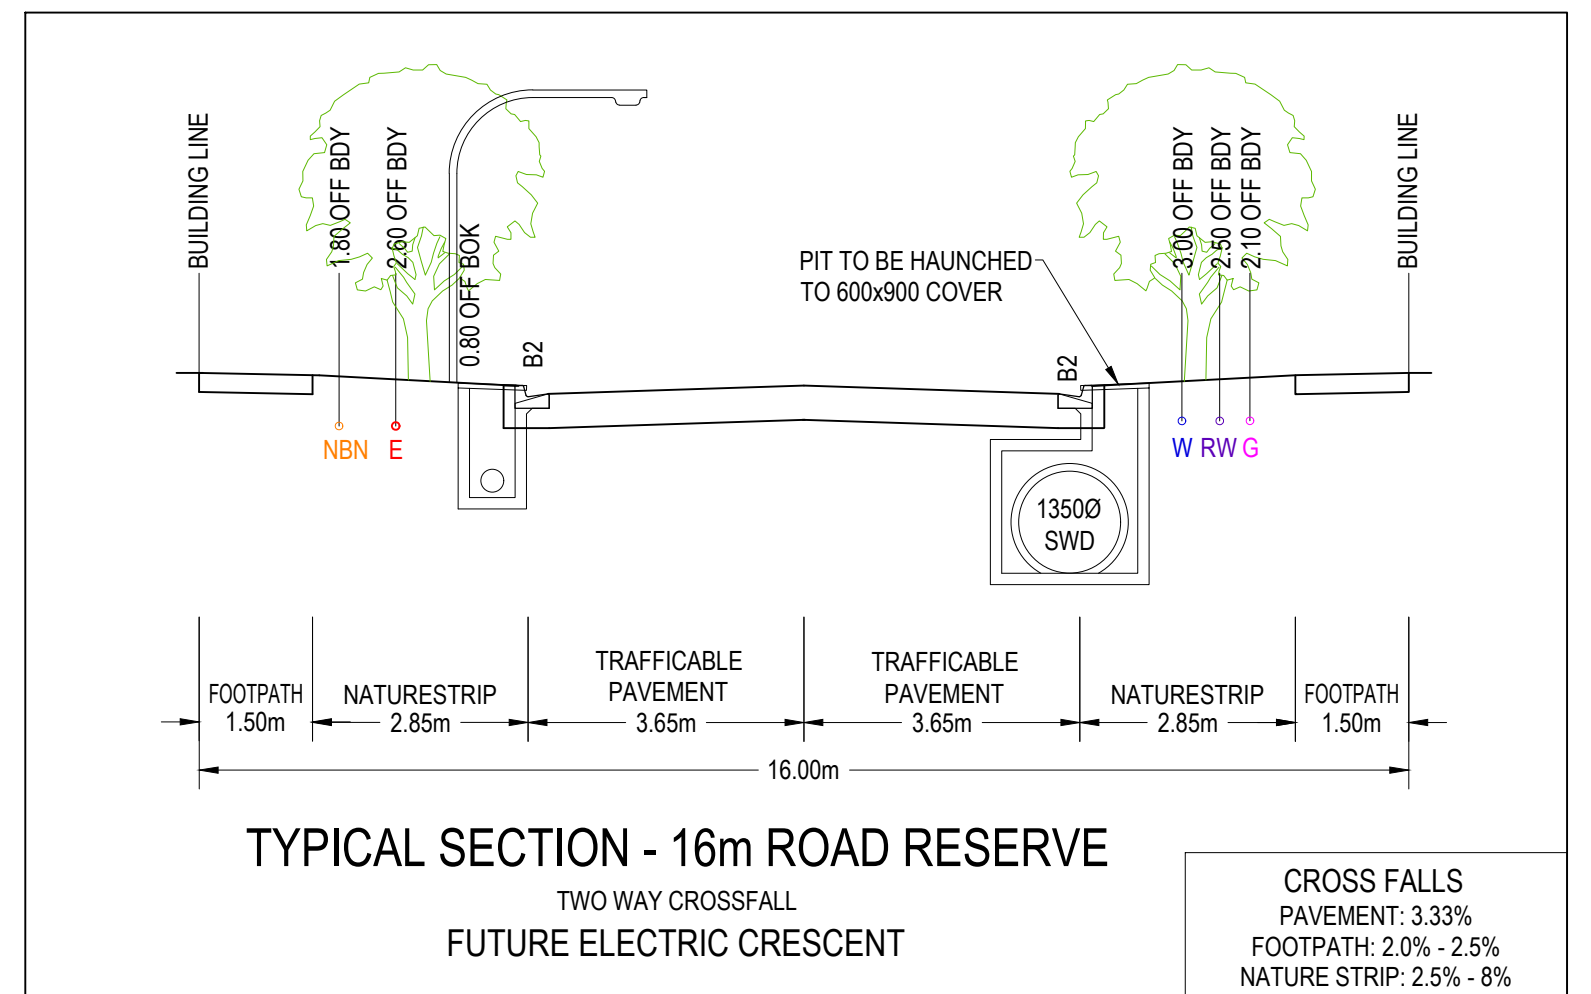

REVISION	DATE	ISSUE DESCRIPTION	DRAWN	DESIGNED	APPROVED
AC1	13/07/20	ODYSSEY DRIVE AMENDED TO SOVEREIGN DRIVE	M.T.	M.T.	T.P.
AC	04/05/20	AS CONSTRUCTED	K.N.	M.T.	T.P.
2	05/12/19	STAGE BOUNDARY AMENDED	K.N.	M.T.	T.P.
1	05/08/19	STUBS REPLACED WITH BLOCKOUTS & P2PC1 ADDED	M.T.	M.T.	T.P.
0	09/05/19	CONSTRUCTION ISSUE	M.T.	M.T.	T.P.
D	30/04/19	COUNCIL COMMENTS DATED 18/04/19	M.T.	M.T.	T.P.
C	15/03/19	ISSUED FOR TENDER	M.T.	M.T.	T.P.
B	7/03/19	ISSUED TO COUNCIL FOR APPROVAL	M.T.	M.T.	T.P.
A	28/02/19	PRELIMINARY ISSUE TO CLIENT	M.T.	M.T.	T.P.



ARMSTRONG - STAGE 51
LAYOUT PLAN - 2

AS CONSTRUCTED

SCALE AT A1	DRAWN	DESIGNED
1:500 @ A1	M.TROUNCE	M.TROUNCE
PROJECT ENGINEER	PROJECT MANAGER	DATE FIRST ISSUE
T.PALIOS	T.PALIOS	FEB 2019
PROJECT No.	DRAWING No.	REVISION
180016.51	R201	AC1