


Height Difference Table			
No.	Min. Level	Max. Level	Colour
1	0.0	0.20	
2	0.20	0.40	
3	0.40	0.60	
4	0.60	0.80	
5	0.80	1.00	
6	1.00	1.20	
7	1.20	1.40	
8	1.40	1.60	
9	1.60	1.80	
NOTES: LEVELS ARE A COMPARISON BETWEEN EXISTING SURFACE AND AS CONSTRUCTED FINISHED SURFACE			

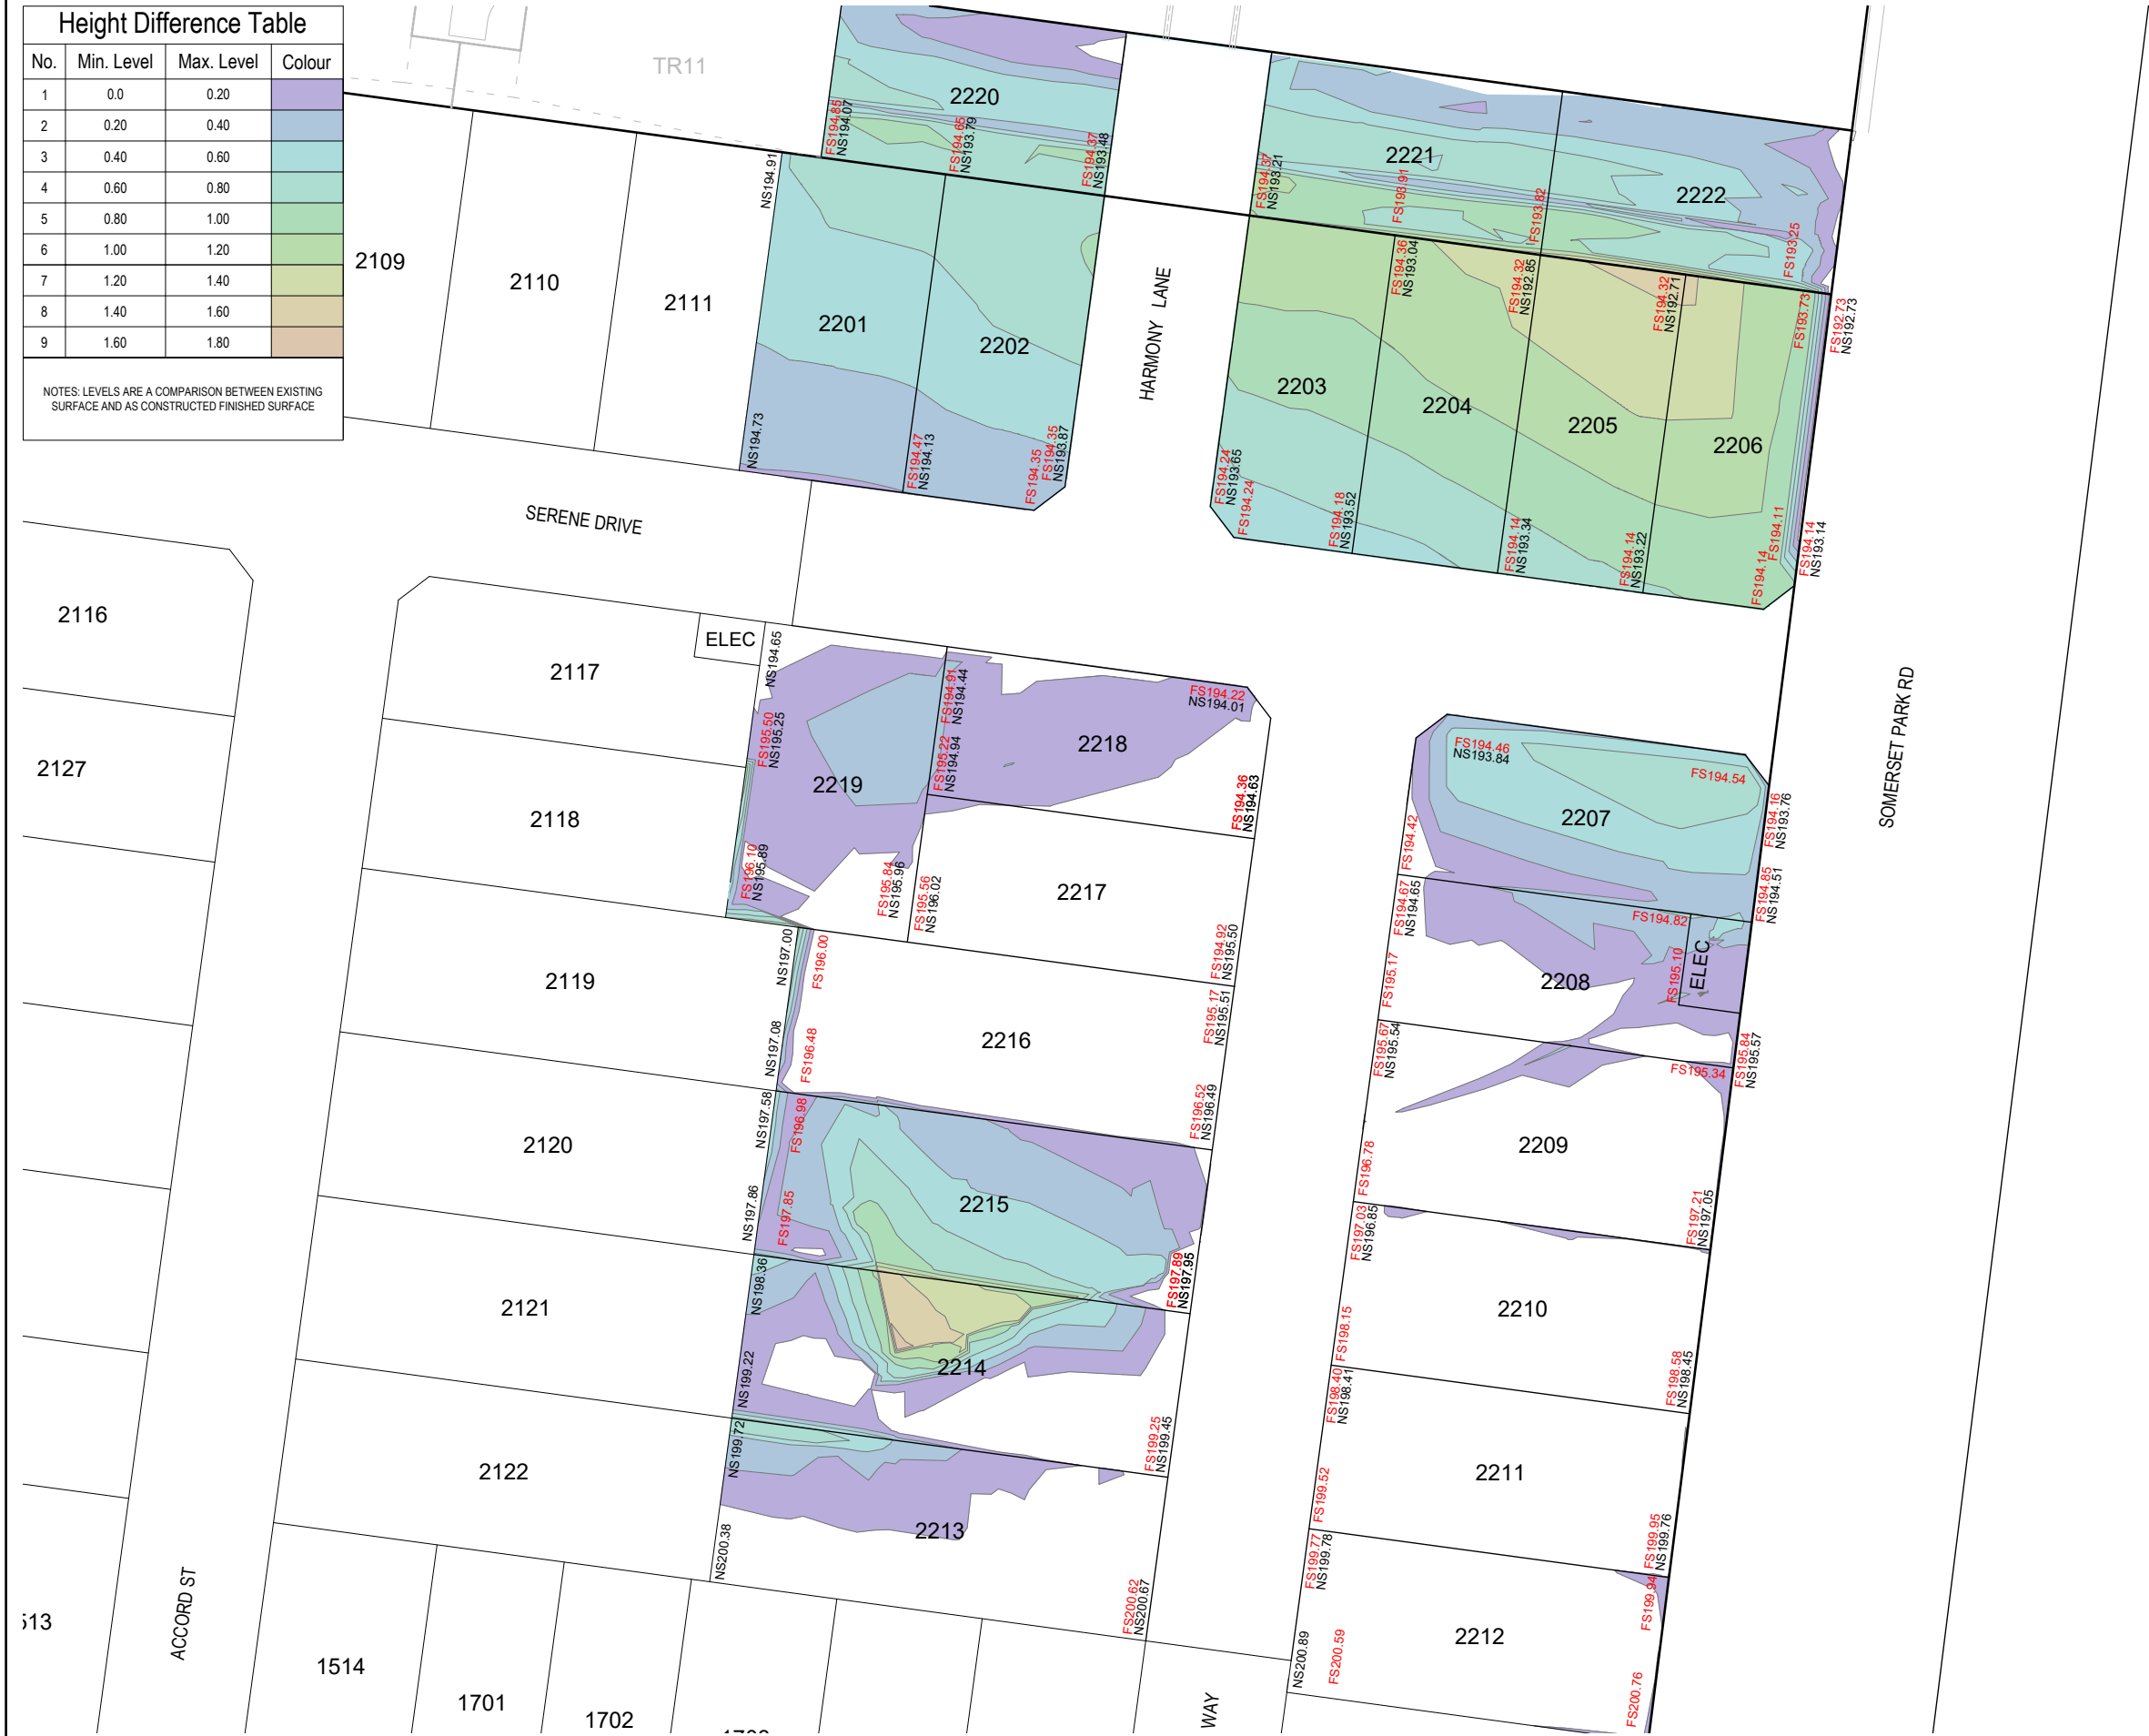


A AS SUBMITTED TO CLIENT		EM	HB	08/07/26
REV	REVISION	DES	DWG	CHK AUTH DATE



**Tomkinson**
SURVEY • ENGINEERING • PLANNING • PROJECT MANAGEMENT
HEAD OFFICE: 41B BREEN STREET QUARRY HILL PH 03 5445 8700
ABN 11 103 336 358 WWW.TOMKINSON.COM



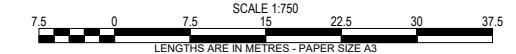

© COPYRIGHT
THE INFORMATION CONTAINED
ON THIS DRAWING IS THE
INTELLECTUAL PROPERTY OF
TOMKINSON. COPYING OR USING
THIS DRAWING IN WHOLE OR IN
PART WITHOUT THE EXPRESS
WRITTEN PERMISSION OF
TOMKINSON INFRINGES
COPYRIGHT

IMAGINE ESTATE STAGE 22
SERENE DRIVE STRATHFIELDSAYE
FILL DEPTH RANGE & LEVELS
CITY OF GREATER BENDIGO - AM/459/2020/C, AM/188/2016/B & DS/819/2022
STARTHIELDSAYE HOLDINGS PTY LTD
DWG STATUS:
CONCEPT
PROJECT & DWG No:
503150 M01 / 01
REV:
A

NOTE: THIS IS AN UNCONTROLLED DOCUMENT AND WILL NOT BE UPDATED. IT IS THE RESPONSIBILITY OF THE USER TO CONFIRM THAT THIS IS A CURRENT COPY AND SUITABLE FOR THE PROPOSED USE - THIS SHEET MUST BE READ IN CONJUNCTION WITH ALL SHEETS OF THIS SET AND ANY ACCOMPANYING DOCUMENTS
PLOT DATE: 16/07/2026 FILE: C:\12\DATA\TOMKINGCO-12\501503150 - STRATHFIELDSAYE - 308\ENGINEERING\CAD\OTHER\503150 STAGE 22 FILL PLAN REV.DWG