


AS-BUILT

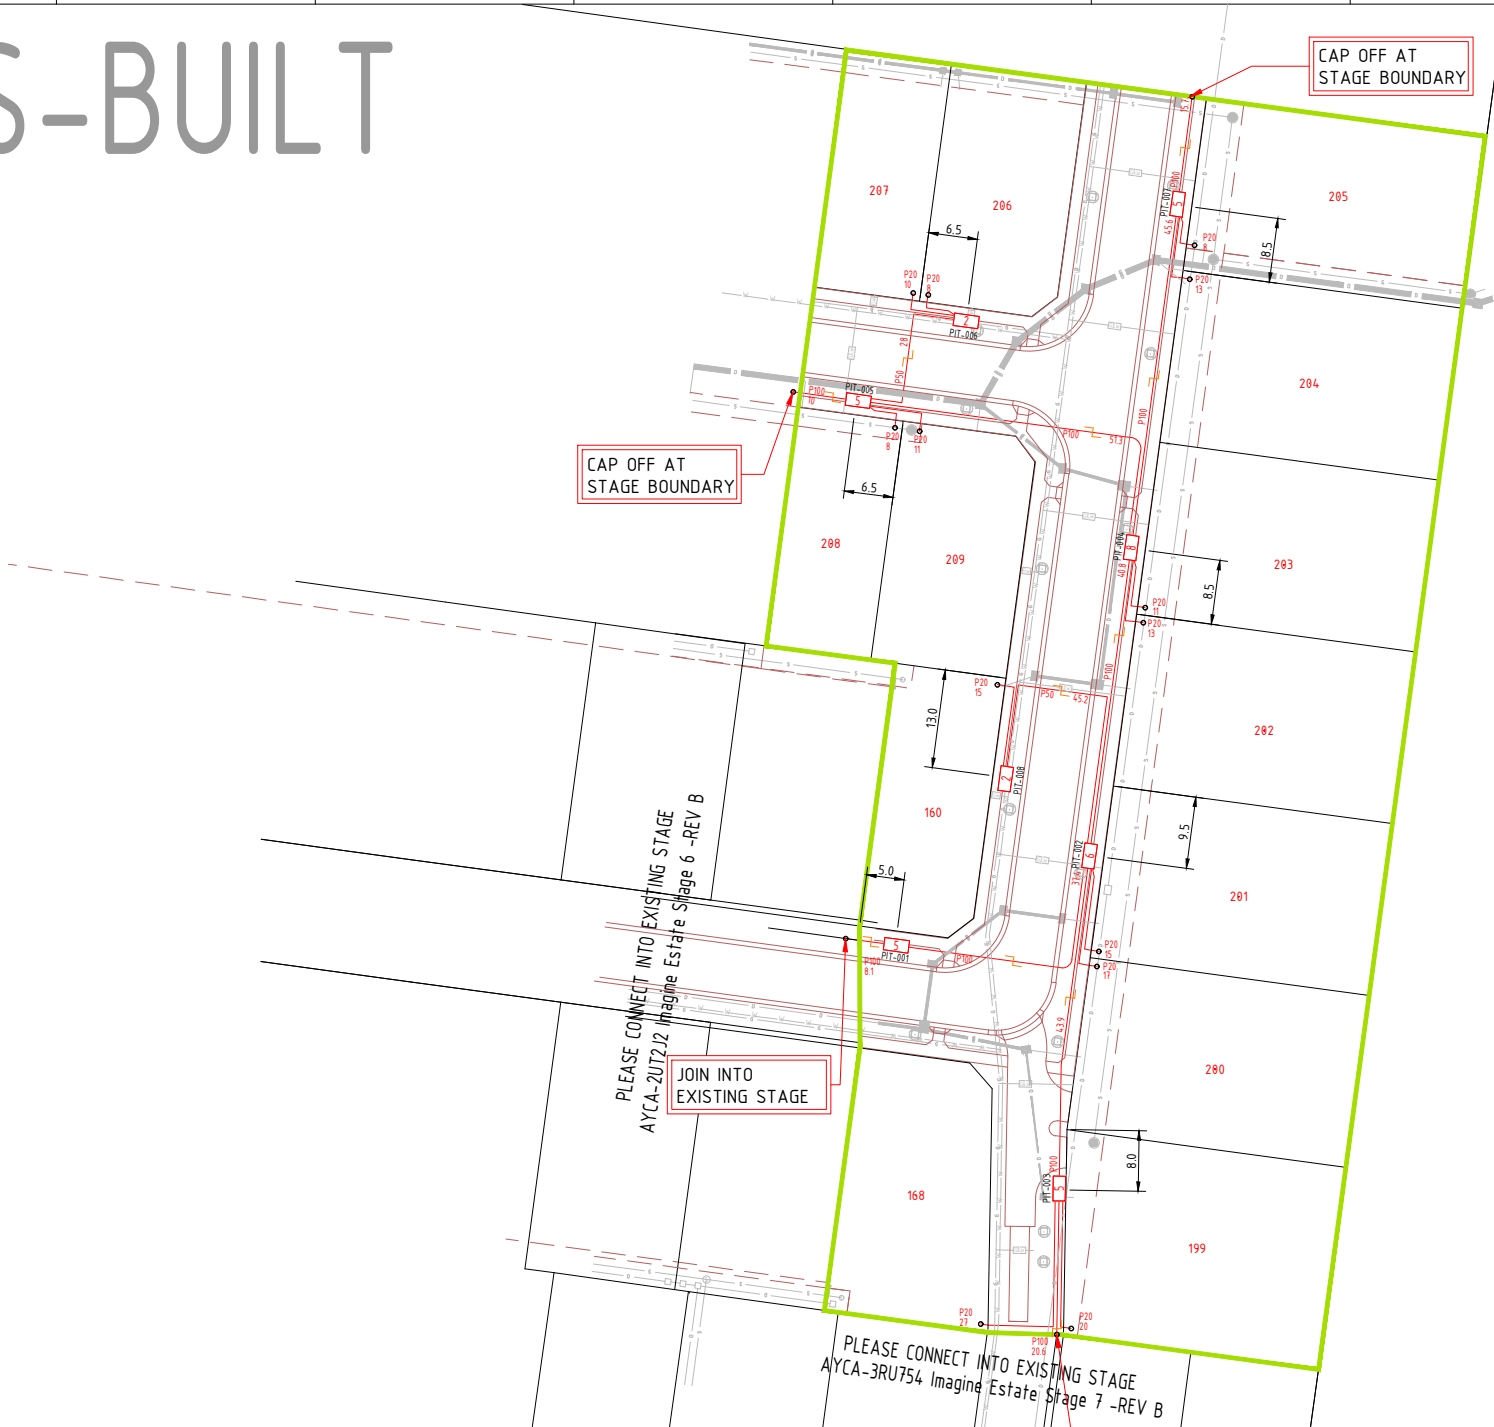

Development Information

Development Name:
IMAGINE ESTATE

Developer Company:
STRATHFIELDSAYE HOLDINGS P/L

Development Address:
SWANSON BOULEVARD, STRATHFIELDSAYE, VIC

Authorised Rep:
FIXED COMMUNICATIONS
Phone: 0402 578 393
E-Mail: ferry@fixedcommunications.com.au

CRM ID: AYCA-4WRNM0 Stage Number: 8

BILL OF MATERIAL

NO OF LOTS:13

PITS		DUCTS		
SIZE	QTY	SIZE	QTY	MTRS
2	2	P100	9	273.4
5	4	P50	2	73.2
6	1	P23	13	176
8	1			
9	0			

TOTAL NUMBER OF PITS: 8
TOTAL NUMBER OF MANHOLES: 0
TOTAL NUMBER OF CONDUITS: 24
TOTAL LENGTH OF CONDUITS: 522.6

SERVICE LOCATIONS

STREET NAME	GAS		WATER		NBN		ELECTRICITY	
	OFFSET	SIDE	OFFSET	SIDE	OFFSET	SIDE	OFFSET	SIDE
TERRAPEE ST (N/S)	1.9	W	2.4	W	1.9	E	2.4	E
TERRAPEE ST (E/W)	1.9	S	2.4	S	1.9	N	2.4	N
TARRNOOK DR	1.9	N	2.4	N	1.9	S	2.4	S

PIT-ID

2

Service Drop Access Pit
(650mmX280mmX565mm)

PIT-ID

5

Network Boundary/Local Network Pit (Single Lid)
(700mmX450mmX650mm)

PIT-ID

8

Distribution/Local Network Connection Pit
(1360mmX555mmX860mm)

PIT-ID

9

Fibre Distribution Hub (FDH) Pit
(2000mmX555mmX900mm)

FDH-ID

FIBRE DISTRIBUTION HUB-FDH CABINET

Existing Telstra manhole

5

Existing Telstra Pit (2,3,4,5,6,7,8,9)

Transformer / Kiosk / Pad Mount Sub-station / Pole Mount Transformer

THE CONTRACTOR SHALL BE TOTALLY RESPONSIBLE FOR AND AT ALL TIMES PROVIDE A SAFE WORKING ENVIRONMENT IN THE VICINITY OF THE SITE OF WORKS IN FULL COMPLIANCE WITH THE OCCUPATIONAL HEALTH AND SAFETY REGULATIONS.

ATTENTION

CONSTRUCTION PLAN ONLY
DO NOT USE FOR CABLE LOCATION

FOR UNDERGROUND CABLE LOCATIONS CONTACT:
METROPOLITAN AREA: MELBOURNE ONE CALL SERVICE - PHONE 1100
OUTSIDE METROPOLITAN AREA: YOUR NEAREST EE OFFICE


NOTES

- THIS PLAN IS TO BE READ IN CONJUNCTION WITH NBN CO NEW DEVELOPMENTS: DEPLOYMENT OF THE NBN CO CONDUIT AND PIT NETWORK - GUIDELINES FOR DEVELOPERS VERSION 6.
- REFER TO NBN GUIDELINES.

WARNING

BEWARE OF UNDERGROUND SERVICES

THE LOCATION OF UNDERGROUND SERVICES ARE APPROXIMATE ONLY AND THEIR EXACT LOCATION SHOULD BE PROVEN ON SITE. NO GUARANTEE IS GIVEN THAT ALL EXISTING SERVICES ARE SHOWN.

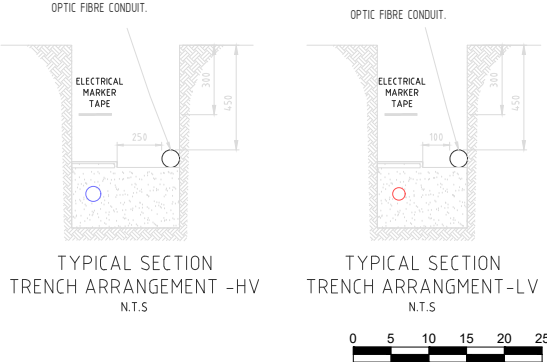

REV	DATE	DRAFTER	DESCRIPTION	APPROVED
-				
-				
STRICTLY CONFIDENTIAL

NBNCO APPROVAL RECORD:

	SIGNATURE	DATE
☐ DD		
☐ WD		
☐ AB		

QUALITY RECORD :

NBNCO DISCLAIMER
THIS DOCUMENT HAS BEEN PREPARED SOLELY FOR THE USE OF NBNCO LIMITED (ABN 86 136 533 741) FOR USE IN MAINTAINING NBNCO FACILITIES. IT HAS NOT BEEN CREATED FOR ANY OTHER USE. IT SHOULD NOT BE SCALED TO LOCATE NBNCO ASSETS. NO WARRANTY IS GIVEN THAT THE INFORMATION IS ACCURATE OR COMPLETE.

Australia's broadband network

KEY PLAN

DRAWING TITLE:
OPTIC FIBRE PIT & PIPE DESIGN
IMAGINE ESTATE
STAGE 8
GREATER CITY OF BENDIGO

STATE: VIC	REGION: STRATHFIELDSAYE
FSA:	SAM: ADA:
PROJECT No: AYCA-4WRNM0	
CADREF No:	
SCALE: 1:500	SHEET No. 1 OF 1 REV. -