


NOTES:
 REFER TO MRWA BACKFILL SPECIFICATION 04-03.2 FOR BACKFILLING & EMBEDMENT DETAILS FOR SEWERS CONSTRUCTED UNDER ROADS & FOOTPATHS.

DESCRIPTION	PROPOSED
PASSIVE IRRIGATION TREE PIT TYPE 1 (1.5m PIT & 2.0m TRENCH)	

WARNING
 BEWARE OF UNDERGROUND/OVERHEAD SERVICES
 THE LOCATION OF SERVICES ARE APPROXIMATE ONLY AND THEIR EXACT POSITION SHOULD BE PROVEN ON SITE. NO GUARANTEE IS GIVEN THAT ALL EXISTING SERVICES ARE SHOWN. SPECIAL CONSIDERATION SHOULD BE GIVEN TO CONSTRUCTION PROCEDURES UNDER OVERHEAD ELECTRICITY TRANSMISSION LINES.

Rev	Description	M.T-S	Date
8	AS CONSTRUCTED	M.T-S	05/09/23
7	LEVELS AMENDED	G.W	15/05/23
6	LEVELS AMENDED	G.W	11/05/23
5	SHARED PATH AMENDED	M.T-S	17/04/23
4	HEAVY DUTY FOOTPATH AMENDED & SHARED PATH ADDED	G.W	04/04/23
3	DRIVEWAY AND SERVICE CONDUIT ADDED	G.W	24/03/23
2	INDUSTRIAL CROSSOVER AMENDED	M.T-S	12/01/23
1	ROAD NAME AMENDED	M.T-S	30/11/22
Rev	Amendments	Approved	Date

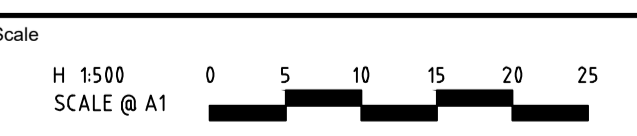

ISO 9001
 ISO 14001
 ISO 45001
 System Certified

© Spiire Australia Pty Ltd All Rights Reserved
 This document is produced by Spiire Australia Pty Ltd solely for the benefit of and use by the client in accordance with the terms of the retainer. Spiire Australia Pty Ltd does not and shall not assume any responsibility or liability whatsoever to any third party arising out of any use or reliance by third party on the content of this document.



L6 414 LA TROBE STREET PO BOX 16084 MELBOURNE
 VICTORIA 3007 AUSTRALIA T 61 3 9993 7888
 spiire.com.au ABN 55 050 029 635



Designed
 L. TRAN

Checked
 J. KOEHLER

Authorised
 M. TOOMER-SMITH

Date
 10/11/22

**SHERWOOD GRANGE
 STAGE 6
 ROAD AND DRAINAGE
 FACE PLAN**
 HUME CITY COUNCIL
 RACECOURSE ROAD HOLDING PTY LTD

AS CONSTRUCTED Dwg No **305952CR200** Rev **8**