


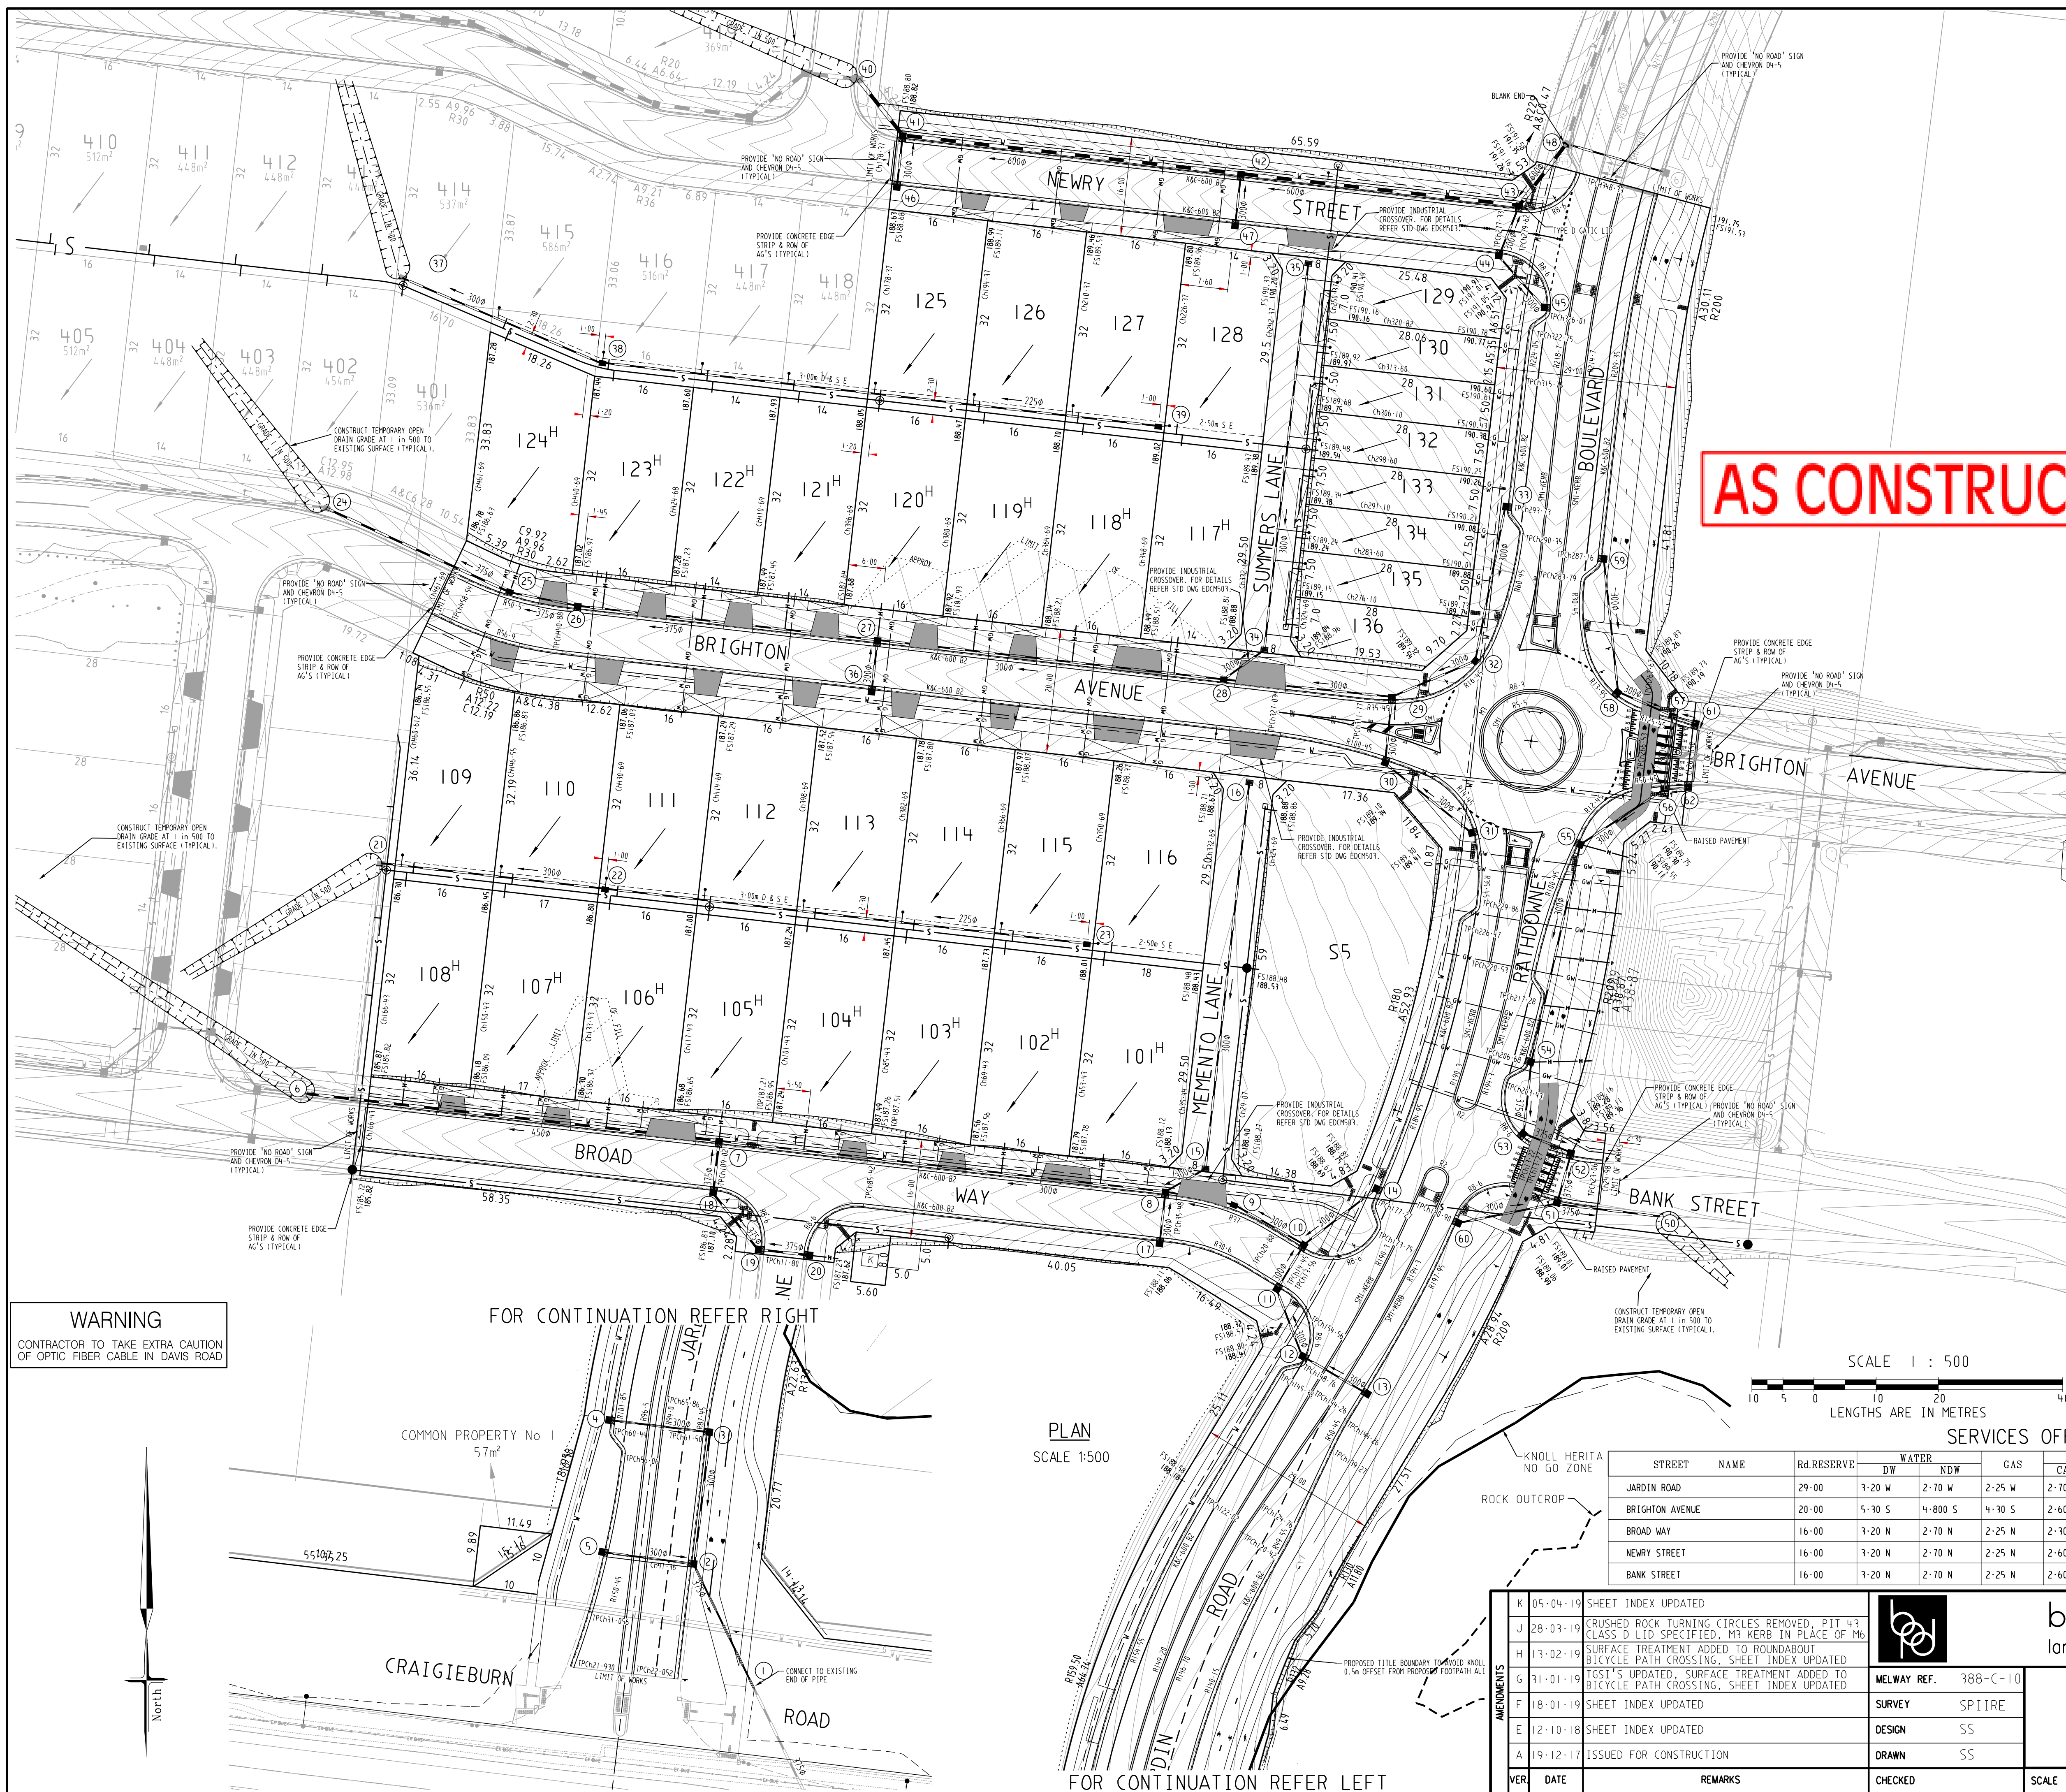

AS CONSTRUCTED

WARNING
BEWARE OF UNDERGROUND SERVICES
THE LOCATIONS OF UNDERGROUND SERVICES ARE
APPROXIMATE ONLY AND THEIR EXACT POSITION
SHOULD BE PROVEN ON SITE. NO GUARANTEE IS
GIVEN THAT ALL EXISTING SERVICES ARE SHOWN.

SHEET INDEX		
SHT No.	VER	DESCRIPTION
1	K	DETAIL PLAN & SERVICES SCHEDULE
2	H	NOTES AND TYPICAL SECTIONS SHEET 1 OF 2
3	A	NOTES AND TYPICAL SECTIONS SHEET 2 OF 2
4	D	INTERSECTION DETAILS SHEET 1 OF 3
5	B	INTERSECTION DETAILS SHEET 2 OF 3
6	A	INTERSECTION DETAILS SHEET 3 OF 3
7	E	JARDIN ROAD - LONGITUDINAL SECTION
8	E	JARDIN ROAD - CROSS SECTIONS
9	A	JARDIN ROAD - CROSS SECTIONS
10	A	BROAD WAY - LONGITUDINAL AND CROSS SECTIONS
11	A	BRIGHTON AVENUE - LONGITUDINAL AND CROSS SECTIONS
12	A	BRIGHTON AVENUE - CROSS SECTIONS
13	A	MEWRY STREET - LONGITUDINAL AND CROSS SECTIONS
14	A	MEMENTO LANE & SUMMERS LANE - LONGITUDINAL AND CROSS SECTIONS
15	A	TIERRA CIRCUIT, BANK STREET & ROAD A - LONGITUDINAL AND CROSS SECTIONS
16	D	DRAINAGE LONGITUDINAL SECTIONS SHEET 1 OF 3
17	C	DRAINAGE LONGITUDINAL SECTIONS SHEET 2 OF 3
18	D	DRAINAGE LONGITUDINAL SECTIONS & PIT SCHEDULE SHEET 3 OF 3
19	D	PAVEMENT, SIGNAGE AND LINE MARKING PLAN

ATTENTION TO CONTRACTOR	
1.	IT IS THE CONTRACTORS RESPONSIBILITY TO ENSURE THAT THE DIGITAL PLAN PROVIDED FOR SETOUT PURPOSES, MATCHES THE TBM COORDINATES SHOWN.
2.	Contractor to ensure that the site is pegged and or set out checked by the licenced surveyor responsible for certifying the Plan of Subdivision prior to underground infrastructure being installed.
3.	Where concrete works about a sewer access chamber surround or similar structure an expansion joint of approved material shall be provided between the two faces.

SYMBOL LEGEND

Drains	Prop	Exist	Ex/Natural/FS Level	28.17	28.97
Sewer <300	S	S	FS @ Building Line	28.25	28.97
Sewer >300	S	S	Top/Toe of Batter	28.25	28.97
Water	W	W	Top Ret. Wall Level	28.51	
House Drain	H	H	100ry Flood Level	28.51	
Property Inlet	P	P	Fill Prop/Ex		
Street Sign			Cut Prop/Ex		
PSM					
Retaining Wall					
Conduits 50mm	GW	GW			
Conduits 100mm	W100	W100			
Ex Gas/Elect/Tel	G	E	T		

SERVICES OFFSETS AND LOCATIONS												
STREET	NAME	Rd.RESERVE	WATER		GAS	ELECTRICITY		FIBRE TO THE HOME		Bk. of KERB	JOINT TRENCHING	STREET CLASSIFICATION
			DW	NDW		CABLES	POLES	FTTH CABLES	FTTH PITS			
JARDIN ROAD		29.00	3.20 W	2.70 W	2.25 W	2.70 E	0.90 BOK	1.85 E	1.78 E/W	4.35 W 8.75 E	G & W, FTTH & E	CONNECTOR ROAD
BRIGHTON AVENUE		20.00	5.30 S	4.800 S	4.30 S	2.60 N	0.90 BOK	1.85 N	1.78 N/S	4.95 N 7.45 S	G & W, FTTH & E	STREET - LEVEL
BROAD WAY		16.00	3.20 N	2.70 N	2.25 N	2.30 S	0.90 BOK	1.85 S	1.78 N/S	4.35 N 4.05 S	G & W, FTTH & E	STREET - LEVEL
NEWRY STREET		16.00	3.20 N	2.70 N	2.25 N	2.60 S	0.90 BOK	1.85 S	1.78 N/S	4.35 N 4.05 S	G & W, FTTH & E	STREET - LEVEL
BANK STREET		16.00	3.20 N	2.70 N	2.25 N	2.60 S	0.90 BOK	1.85 S	1.78 N/S	4.35 N 4.05 S	G & W, FTTH & E	STREET - LEVEL

AMENDMENTS	DATE	REMARKS
K	05-04-19	SHEET INDEX UPDATED
J	28-03-19	CRUSHED ROCK TURNING, CIRCLES REMOVED, PIT 43 CLASS D LID SPECIFIED, M3 KERB IN PLACE OF M6
H	13-02-19	SURFACE TREATMENT ADDED TO ROUNDABOUT BICYCLE PATH CROSSING, SHEET INDEX UPDATED
G	31-01-19	TGS1'S UPDATED, SURFACE TREATMENT ADDED TO BICYCLE PATH CROSSING, SHEET INDEX UPDATED
F	18-01-19	SHEET INDEX UPDATED
E	12-10-18	SHEET INDEX UPDATED
A	19-12-17	ISSUED FOR CONSTRUCTION

 breese pitt dixon Pty. Ltd.
land surveyors civil engineers

1/19 cato street
hawthorn east, 3122
telephone 8823 2311
fax no. 8823 2311

MELWAY REF.	388-C-10	RATHDOWNE ESTATE STAGE 1 DETAIL PLAN					MUNICIPALITY		WHITTLESEA	
SURVEY	SPIIRE						REFERENCE		9365 E/1	
DESIGN	SS									
DRAWN	SS									
CHECKED		SCALE	AS SHOWN	DATUM	AHD	DATE	JAN'17	SHEET	1	OF 19

NOTES

1. ALL WORKS TO BE CARRIED OUT IN ACCORDANCE WITH PLANS AND CURRENT CITY OF WHITTLESEA SPECIFICATIONS AND STANDARD DRAWINGS APPROVED BY COUNCIL AND TO THE SATISFACTION OF THE ENGINEER. PRIOR TO COMMENCEMENT OF WORKS, THE CONTRACTOR SHALL PROVIDE THE FOLLOWING INFORMATION:
a) SOURCES OF QUARRY MATERIAL
b) N.A.T.A. APPROVED TEST RESULTS FOR THE F.C.R. THAT IS TO BE USED.
c) IF THE SOURCE THE QUARRY MATERIAL IS CHANGED DURING THE COURSE OF THE WORKS, THEN NEW TEST RESULTS SHALL BE PROVIDED.
2. COUNCIL TO BE NOTIFIED 2 CLEAR DAYS PRIOR TO COMMENCEMENT OF WORKS.
3. ALL DIMENSIONS ARE IN METERS UNLESS NOTED OTHERWISE
4. ALL LEVELS ARE TO BE AUSTRALIAN HEIGHT DATUM (AHD)
5. DRAINAGE AND PITS TO BE SETOUT FROM OFFSETS SHOWN RATHER THAN FROM CENTRELINE PIPE CHAINAGES.
6. ALL PIPES TO BE CLASS 2 UNLESS OTHERWISE SPECIFIED AND SHALL BE RRJ UP TO AND INCLUDING 750mm DIAMETER. ALL DRAINS THAT CROSS UNDER ROAD PAVEMENTS ARE TO BE RRJ CLASS 4 R.C.P.
7. JOINTING FOR CURVED PIPE ALIGNMENT SHALL CONFORM TO MANUFACTURER'S SPECIFICATIONS (RRJ'S FOR MINOR DEFLECTIONS OR COMPLETE R.C. BANDAGES)
8. PROPERTY INLETS ARE TO BE PLACED 1.0m FROM THE LOW CORNER OF LOT UNLESS OTHERWISE SHOWN.
9. LOTS DENOTED THUS 416H ARE TO BE PROVIDED WITH A 100mm HOUSE DRAIN PLACED 7.00m FROM THE LOW CORNER OF THE LOT UNLESS OTHERWISE SHOWN. HOUSE DRAINS TO BE CONNECTED TO STREET DRAINAGE WITH 27A & CAP, CLEAR OF ANY PAVING. IF CONNECTION IS WITHIN PAVING A PIT MUST BE USED.
10. APPROVED GRANULAR BACKFILL TO BE PROVIDED WHERE PIPE TRENCHES ENCR OACH UNDER ROADWAY DUE TO DEEP EXCAVATIONS IN ROCK.
11. SHALLOW CUT OFF DRAINS ARE TO BE PROVIDED ON SUBDIVISION BOUNDARY WHERE NECESSARY.
12. WHERE CONCRETE PAVING CROSSES SERVICE TRENCHES, SEWERAGE AND DRAINAGE, TRENCHES SHALL BE BACKFILL WITH COMPACTED FINE CRUSH ROCK.
13. ALL CROSSEOVERS MUST BE 0.75m FROM THE DRAINAGE PITS AND PRAM CROSSINGS. IN ADDITION, THE PRAM CROSSING MUST BE 2m FROM THE DRAINAGE PITS.
14. PRIOR TO COMMENCEMENT OF WORKS ON SITE, THE CONTRACTOR MUST ENSURE THAT ALL MATTERS RELATING TO THE OCCUPATIONAL HEALTH AND SAFETY ACT 2004, INCLUDING ALL RELEVANT REGULATIONS, HAVE BEEN ADDRESSED. IN PARTICULAR, THE REQUIRED NOTIFICATIONS MUST BE CONVEYED TO THE VICTORIAN WORKCOVER AUTHORITY - HEALTH & SAFETY DIVISION WITH RESPECT TO TRENCHING OPERATIONS. DETAILS OF THE CONTRACTORS OCCUPATIONAL HEALTH & SAFETY PROCEDURES MUST BE LODGED WITH THE SUPERINTENDENT PRIOR TO COMMENCEMENT OF WORKS.
15. AGRICULTURAL PIPE DRAINS 100mm PVC CLASS 4 TO BE PLACED BEHIND ALL KERB AND CHANNEL AND BUFFER PITCHERS AND WHERE DIRECTED BY THE ENGINEER (REFER TO COUNCIL STANDARD DRAWINGS). WHERE KERB AND CHANNEL IS LOCATED ON TITLE BOUNDARY AG's ARE TO BE PLACED BENEATH KERB AND 750mm BELOW TOP OF KERB.
16. ALL DRAINS BEHIND KERB AND CHANNEL SHALL BE BACKFILLED TO MATCH PAVEMENT SUBGRADE LEVEL WITH 20mm CLASS 2 F.C.R. COMPACTED TO 95% OF THE MAXIMUM DRY DENSITY VALUE DETERMINED BY THE MODIFIED COMPACTION TEST IN ACCORDANCE WITH A.S. 1289.5.2.1-2003. EXCEPT WHERE DRAINS UP TO AND INCLUDING 450mm DIA. PIPES ARE LOCATED BEHIND KERB, THESE TRENCHES ARE TO BE BACKFILLED WITH SCREENINGS IN LIEU OF AG'S.
17. AGRICULTURAL DRAINS ARE TO BE 760mm BELOW TOP OF KERB.
18. BATTERS SHALL BE 1 IN 6 FOR CUT & FILL UNLESS OTHERWISE SHOWN.
19. ALL NATIVE TREES AND SHRUBS TO BE RETAINED UNLESS ROAD CONSTRUCTION NECESSITATES THEIR REMOVAL OR REMOVAL IS DIRECTED BY THE ENGINEER.
20. LOTS TO BE GRADED AND LEFT CLEAN TO THE SATISFACTION OF THE ENGINEER.
21. ON COMPLETION THE CONTRACTOR IS RESPONSIBLE FOR THE REMOVAL OF RUBBISH AND SPOIL FROM SITE.
22. WHERE WORKS ARE IN THE VICINITY OF EXISTING SERVICES, THESE SERVICES ARE TO BE LOCATED AND THE VARIOUS AUTHORITIES NOTIFIED PRIOR TO COMMENCEMENT OF WORKS.
23. ALL MATERIAL SURROUNDING SERVICE AUTHORITY PITS LOCATED IN FOOTPATHS MUST BE ADEQUATELY COMPACTED IN 150mm LAYERS AND TESTED TO THE SATISFACTION OF THE CITY OF WHITTLESEA, PRIOR TO THE CONSTRUCTION OF FOOTPATH BAYS ADJACENT TO THESE PITS.
24. THE WATER CONDUIT OFFSET FROM THE LOT BOUNDARY IS GIVEN ON THE WATER RETICULATION PLAN. THE CONTRACTOR MUST CONSTRUCT CONDUITS TO ACCORD WITH THE GIVEN OFFSET AND ENSURE THAT THE CONCRETE R MARKS THE KERB AND FOOTPATH EXACTLY ABOVE THE CONDUIT.
25. ALL GAS AND WATER CONDUIT TYPES ARE PVC CLASS 12 WITH A 50mm DIAMETER FOR RESIDENTIAL LOTS.
26. TELSTRA/BNB Co TO BE NOTIFIED 7 DAYS PRIOR TO CONCRETE BEING PLACED.
27. CONDUITS ARE TO BE EXTENDED 450mm BEHIND FACE OF KERB AND TO BE REFERENCED ON FACE OF KERB.
28. ALL STREET SIGNS TO BE CONSTRUCTED AND ERECTED TO CURRENT CITY OF WHITTLESEA STANDARDS. STREET NAME PLATES TO BE IN ACCORDANCE WITH STANDARD DRAWING SD812, INCLUDING "NO THROUGH ROAD" NOMINATION WHERE APPLICABLE.
29. TRAFFIC CONTROL SIGNS, MARKINGS & DELINEATORS TO BE INSTALLED IN ACCORDANCE WITH AS1742.2. ALL LINE MARKING IS TO BE LONG LIFE ROAD MARKING, WITH LONGITUDINAL LINES IN THERMOPLASTIC & TRANSVERSE MARKINGS IN COLD APPLIED.
30. ALL DRIVEWAYS TO BE OFFSET 0.75m FROM SIDE BOUNDARY OR EASEMENT (REFER EDM501) UNLESS OTHERWISE SHOWN.
31. ALL DRIVEWAY RAMPS INTO PROPERTIES ARE TO BE CUT IN AT A MAXIMUM GRADE OF 1 IN 6.
32. FILL AREAS ARE TO BE STRIPPED OF TOPSOIL, FILLED AND TOPSOIL REPLACED TO OBTAIN FINAL FILL LEVELS AS SHOWN ON PLANS. FILLING TO BE CLEAN CLAY COMPACTED TO A DRY DENSITY NOT LESS THAN 95% OF THE MAXIMUM DRY DENSITY VALUE DETERMINED BY THE STANDARD COMPACTION TEST IN ACCORDANCE WITH AUSTRALIAN STANDARD AS1289.5.2.1-1993. TESTING TO COMPLY WITH AS3798-1996 APPENDIX B, LEVEL 1.
33. THE CONTRACTOR IS RESPONSIBLE FOR ENSURING THAT ALL IMPORTED FILL MATERIAL, INCLUDING TOPSOIL, SATISFIES THE DESCRIPTION FOR CLEAN FILL MATERIAL IN EPA BULLETIN PUBLICATION No. 448 (SEPT '95) AND SUBSEQUENT REVISIONS. THE CONTRACTOR SHALL PROVIDE VERIFICATION INCLUDING TEST CERTIFICATES TO THE SUPERVISING ENGINEER.
34. FILL REQUIRED UNDER ROADWAY KERB AND CHANNEL AND FOOTPATH TO BE APPROVED GRANULAR MATERIAL COMPACTED TO 95% AASHO IN 150mm LAYERS.

35. PAVEMENT TO CONSIST OF: JARDIN ROAD (540mm DEPTH)
a) 40mm COMPACTED DEPTH SIZE 14 TYPE H ASPHALT WITH A C320 BINDER (ASPHALT TO BE 5mm PROUD OF LIP OF KERB)
b) 75mm COMPACTED DEPTH SIZE 20 TYPE S1 ASPHALT WITH A C320 BINDER
c) 75mm COMPACTED DEPTH SIZE 20 TYPE SF ASPHALT WITH A C320 BINDER
d) BITUMINOUS PRIME
e) 100mm COMPACTED DEPTH OF 20mm NOMINAL SIZE CLASS 2 CR, COMPACTED TO AT LEAST 98% MODIFIED DRY DENSITY RATIO WITHIN 1% OF THE MODIFIED OPTIMUM MOISTURE CONTENT.
f) 250mm COMPACTED DEPTH OF SELECT GRANULAR MATERIAL "TYPE A" WITH A MINIMUM SOAKED CBR OF 10% COMPACTED TO 98% STANDARD DRY DENSITY RATIO WITHIN 1% OF THE STANDARD OPTIMUM MOISTURE CONTENT AND A PERCENTAGE SWELL OF LESS THAN 1.5%
g) SUBGRADE TO CONSIST OF SILTY CLAY COMPACTED TO AT LEAST 100% STANDARD DRY DENSITY RATIO (SOAKED CBR>2.0%) WITHIN 2% OF THE OPTIMUM MOISTURE CONTENT. SUBGRADE IMPROVEMENT FOR SOFT OR ROCK AREAS, TO BE 150mm MINIMUM DEPTH OF COMPACTED CLASS 3 FCR* OR APPROVED EQUIVALENT MATERIAL. Refer to "Technical Specification for Roads and Drainage Works" Section 20.3.5 & Table 20.3.5 for requirements
SAMI TREATMENT (STRAIN ALLEVIATING MEMBRANE INTERLAYER) CONSISTING SIZE 10 SPRAYED SEAL USING CLASS S18RF BITUMEN CRUMB RUBBER BINDER PLACED AT AN APPLICATION RATE > 1.8 l/m2 AND COVERED WITH A LIGHT APPLICATION OF PRE-COATED SIZE 10 AGGREGATE.


- PAVEMENT TO CONSIST OF: ROUNDABOUT (570mm DEPTH)
a) 40mm COMPACTED DEPTH SIZE 14 TYPE V ASPHALT WITH A C320 BINDER (ASPHALT TO BE 5mm PROUD OF LIP OF KERB)
b) 75mm COMPACTED DEPTH SIZE 20 TYPE S1 ASPHALT WITH A C320 BINDER
c) 75mm COMPACTED DEPTH SIZE 20 TYPE SF ASPHALT WITH A C320 BINDER
d) BITUMINOUS PRIME
e) 100mm COMPACTED DEPTH OF 20mm NOMINAL SIZE CLASS 2 CR, COMPACTED TO AT LEAST 98% MODIFIED DRY DENSITY RATIO WITHIN 1% OF THE MODIFIED OPTIMUM MOISTURE CONTENT.
f) 280mm COMPACTED DEPTH OF SELECT GRANULAR MATERIAL "TYPE A" WITH A MINIMUM SOAKED CBR OF 10% COMPACTED TO 98% STANDARD DRY DENSITY RATIO WITHIN 1% OF THE STANDARD OPTIMUM MOISTURE CONTENT AND A PERCENTAGE SWELL OF LESS THAN 1.5%
g) SUBGRADE TO CONSIST OF SILTY CLAY COMPACTED TO AT LEAST 100% STANDARD DRY DENSITY RATIO (SOAKED CBR>2.0%) WITHIN 2% OF THE OPTIMUM MOISTURE CONTENT. SUBGRADE IMPROVEMENT FOR SOFT OR ROCK AREAS, TO BE 150mm MINIMUM DEPTH OF COMPACTED CLASS 3 FCR* OR APPROVED EQUIVALENT MATERIAL.

- PAVEMENT TO CONSIST OF: INTERSECTIONS JARDIN ROAD/ CRAIGIEBURN ROAD (80m TOWARDS JARDIN ROAD FROM LEFT TURN LANE OF CRAIGIEBURN RD). (860mm DEPTH)
a) 40mm COMPACTED DEPTH SIZE 14 TYPE V ASPHALT WITH A C320 BINDER (ASPHALT TO BE 5mm PROUD OF LIP OF KERB)
b) 75mm COMPACTED DEPTH SIZE 20 TYPE S1 ASPHALT WITH A C320 BINDER
c) 75mm COMPACTED DEPTH SIZE 20 TYPE SF ASPHALT WITH A C320 BINDER
d) BITUMINOUS PRIME
f) 180mm COMPACTED DEPTH OF 20mm NOMINAL SIZE CLASS 3 CEMENT MODIFIED CR, MAX 1% CEMENT COMPACTED TO AT LEAST 98% MODIFIED DRY DENSITY RATIO WITHIN 2% OF THE MODIFIED OPTIMUM MOISTURE CONTENT WITH A MINIMUM YOUNG'S MODULUS OF 500MPa AND A MAXIMUM YOUNG'S MODULUS OF 1500MPa.
f) 140mm COMPACTED DEPTH OF 20mm NOMINAL SIZE CLASS 4 CR, COMPACTED TO AT LEAST 95% MODIFIED DRY DENSITY RATIO WITHIN 1% OF THE MODIFIED OPTIMUM MOISTURE CONTENT
g) 350mm COMPACTED DEPTH OF SELECT GRANULAR MATERIAL "TYPE A" WITH A MINIMUM SOAKED CBR OF 10% COMPACTED TO 98% STANDARD DRY DENSITY RATIO WITHIN 1% OF THE STANDARD OPTIMUM MOISTURE CONTENT AND A PERCENTAGE SWELL OF LESS THAN 1.5%
h) SUBGRADE TO CONSIST OF SILTY CLAY COMPACTED TO AT LEAST 100% STANDARD DRY DENSITY RATIO (SOAKED CBR>2.0%) WITHIN 2% OF THE OPTIMUM MOISTURE CONTENT. SUBGRADE IMPROVEMENT FOR SOFT OR ROCK AREAS, TO BE 150mm MINIMUM DEPTH OF COMPACTED CLASS 3 FCR* OR APPROVED EQUIVALENT MATERIAL.


- PAVEMENT TO CONSIST OF: BRIGHTON AVENUE, BROAD WAY, BANK STREET AND HALO LANE (580mm DEPTH)
a) 40mm COMPACTED DEPTH SIZE 14 TYPE N ASPHALT WITH A C170 BINDER
b) GLASGRID GG8511TF PLACED AS PER MANUFACTURERS SPECIFICATIONS
c) 30mm COMPACTED DEPTH SIZE 7 TYPE N ASPHALT WITH A C170 BINDER
d) SAMI SEAL WITH CLASS S18RF BINDER AND BITUMINUS PRIME
e) 130mm COMPACTED DEPTH OF 20mm NOMINAL SIZE CLASS 2 FCR, COMPACTED TO AT LEAST 98% MODIFIED DRY DENSITY RATIO WITHIN 1% OF THE MODIFIED OPTIMUM MOISTURE CONTENT.
f) 100mm COMPACTED DEPTH OF 20mm NOMINAL SIZE CLASS 3 CEMENT MODIFIED CR, COMPACTED TO AT LEAST 98% MODIFIED DRY DENSITY RATIO WITHIN 2% OF THE MODIFIED OPTIMUM MOISTURE CONTENT WITH A MINIMUM YOUNG'S MODULUS OF 500MPa AND A MAXIMUM YOUNG'S MODULUS OF 1500MPa.
g) 140mm COMPACTED DEPTH OF 20mm NOMINAL SIZE CLASS 3 RECYCLED CRUSHED CONCRETE, COMPACTED TO AT LEAST 95% MODIFIED DRY DENSITY RATIO WITHIN 1% OF THE MODIFIED OPTIMUM MOISTURE CONTENT.
h) 150mm COMPACTED DEPTH OF SELECT GRANULAR MATERIAL "TYPE A" WITH A MINIMUM CBR OF 10% COMPACTED TO 98% STANDARD DRY DENSITY RATIO WITHIN 1% OF THE STANDARD OPTIMUM MOISTURE CONTENT AND A PERCENTAGE SWELL OF LESS THAN 1.5%
i) SUBGRADE TO CONSIST OF SILTY CLAY COMPACTED TO AT LEAST 100% STANDARD DRY DENSITY RATIO (SOAKED CBR>2.5%) WITHIN 2% OF THE OPTIMUM MOISTURE CONTENT. SUBGRADE IMPROVEMENT FOR SOFT OR ROCK AREAS, TO BE 150mm MINIMUM DEPTH OF COMPACTED CLASS 3 FCR* OR APPROVED EQUIVALENT MATERIAL.

- PAVEMENT TO CONSIST OF: NEWRY STREET (540mm DEPTH)
a) 40mm COMPACTED DEPTH SIZE 14 TYPE N ASPHALT WITH A C170 BINDER
b) GLASGRID GG8511TF PLACED AS PER MANUFACTURERS SPECIFICATIONS
c) 30mm COMPACTED DEPTH SIZE 7 TYPE N ASPHALT WITH A C170 BINDER
d) SAMI SEAL WITH CLASS S18RF BINDER AND BITUMINUS PRIME
e) 130mm COMPACTED DEPTH OF 20mm NOMINAL SIZE CLASS 2 FCR, COMPACTED TO AT LEAST 98% MODIFIED DRY DENSITY RATIO WITHIN 1% OF THE MODIFIED OPTIMUM MOISTURE CONTENT.
f) 100mm COMPACTED DEPTH OF 20mm NOMINAL SIZE CLASS 3 CEMENT MODIFIED CR, COMPACTED TO AT LEAST 98% MODIFIED DRY DENSITY RATIO WITHIN 2% OF THE MODIFIED OPTIMUM MOISTURE CONTENT WITH A MINIMUM YOUNG'S MODULUS OF 500MPa AND A MAXIMUM YOUNG'S MODULUS OF 1500MPa.
g) 140mm COMPACTED DEPTH OF 20mm NOMINAL SIZE CLASS 3 RECYCLED CRUSHED CONCRETE, COMPACTED TO AT LEAST 95% MODIFIED DRY DENSITY RATIO WITHIN 1% OF THE MODIFIED OPTIMUM MOISTURE CONTENT.
h) 150mm COMPACTED DEPTH OF SELECT GRANULAR MATERIAL "TYPE A" WITH A MINIMUM CBR OF 10% COMPACTED TO 98% STANDARD DRY DENSITY RATIO WITHIN 1% OF THE STANDARD OPTIMUM MOISTURE CONTENT AND A PERCENTAGE SWELL OF LESS THAN 1.5%
i) SUBGRADE TO CONSIST OF SILTY CLAY COMPACTED TO AT LEAST 100% STANDARD DRY DENSITY RATIO (SOAKED CBR>2.5%) WITHIN 2% OF THE OPTIMUM MOISTURE CONTENT. SUBGRADE IMPROVEMENT FOR SOFT OR ROCK AREAS, TO BE 150mm MINIMUM DEPTH OF COMPACTED CLASS 3 FCR* OR APPROVED EQUIVALENT MATERIAL.


- PAVEMENT TO CONSIST OF: MEMENTO LANE AND SUMMERS LANE
a) 200mm CONCRETE PAVEMENT REINFORCED SL82 32MPa
b) 150mm SUBBASE CLASS 3 CRUSHED ROCK
TOTAL PAVEMENT DEPTH 350mm.
36. PAVEMENT DEPTH MAY BE MODIFIED AS DIRECTED BY THE ENGINEER.
37. ALL 125mm THICK FOOTPATH CONCRETE PAVING TO BE REINFORCED WITH SL72 MESH AND MUST BE CONSTRUCTED WITH A 50mm UNDERLAYER OF 20mm COMPACTED CLASS 3 FCR IN ACCORDANCE WITH EDM STANDARD DRAWING 401.
38. THE CONTRACTOR IS TO ORGANISE AND PAY FOR TESTING OF PAVEMENT BASE COURSE MATERIAL AND FINAL LAYER OF CRUSHED ROCK. A COPY OF RESULTS IS TO BE FORWARDED TO THE DIRECTOR OF ENGINEERING OR HIS REPRESENTATIVE. THE RESULTS MUST MEET THE REQUIREMENTS OF THE CITY OF WHITTLESEA SPECIFICATION BEFORE ANY FURTHER WORKS ARE REQUIRED.
39. THE CONTRACTOR MUST COMPLETE A LEVEL CHECK BETWEEN ALL TBM'S TO VERIFY LEVEL VALUES BEFORE COMMENCEMENT OF WORKS. ALL TBM's AND CONTROL POINTS ARE TO BE MAINTAINED AND PROTECTED AT ALL TIMES DURING CONSTRUCTION. SHOULD ANY MARKS BE DISTURBED, THE CONTRACTOR WILL IMMEDIATELY NOTIFY THE DEVELOPER'S CONSULTANT TO ARRANGE RE-INSTATEMENT AT THE CONTRACTORS EXPENSE.

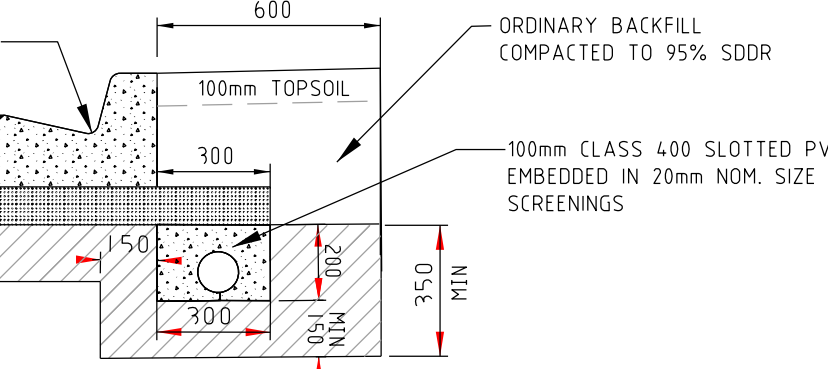


PAVEMENT DETAILS
JARDIN ROAD

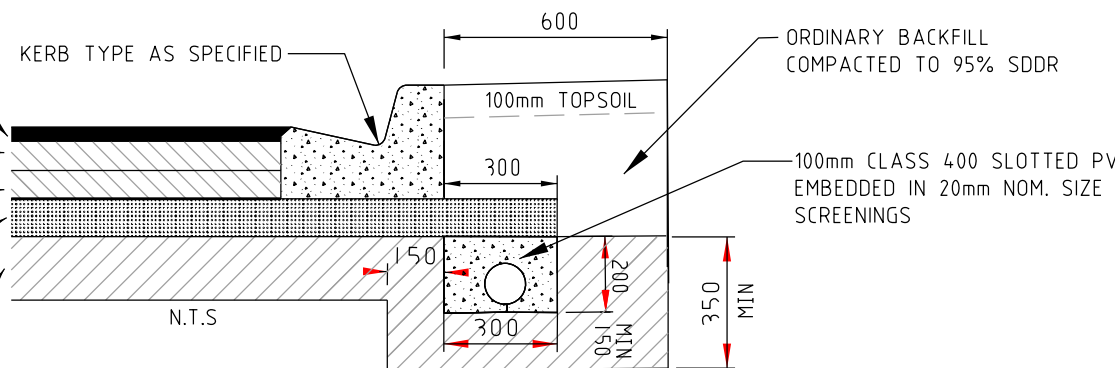


PAVEMENT DETAILS
ROUNDABOUT

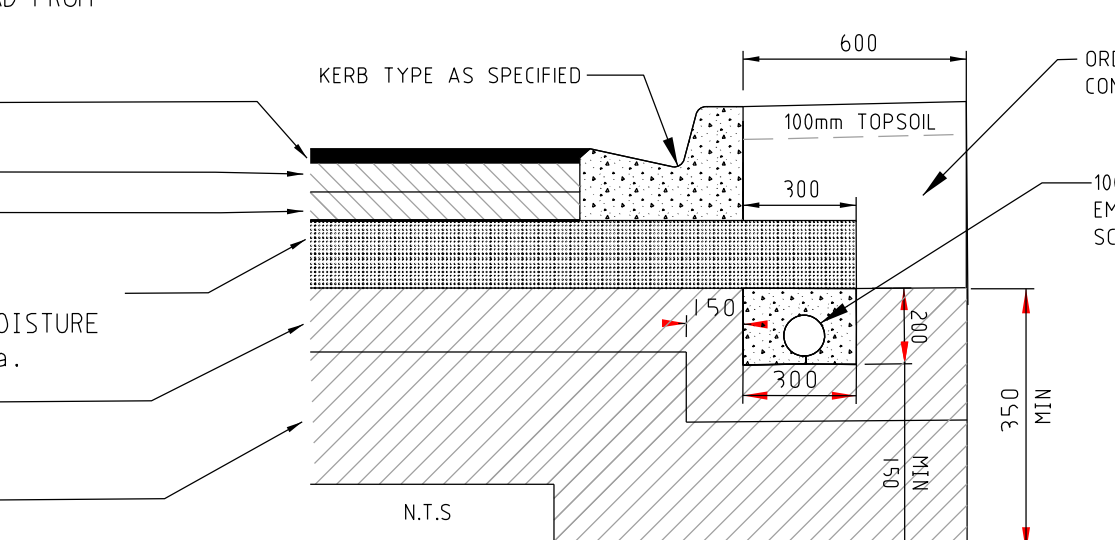


PAVEMENT DETAILS
INTERSECTION

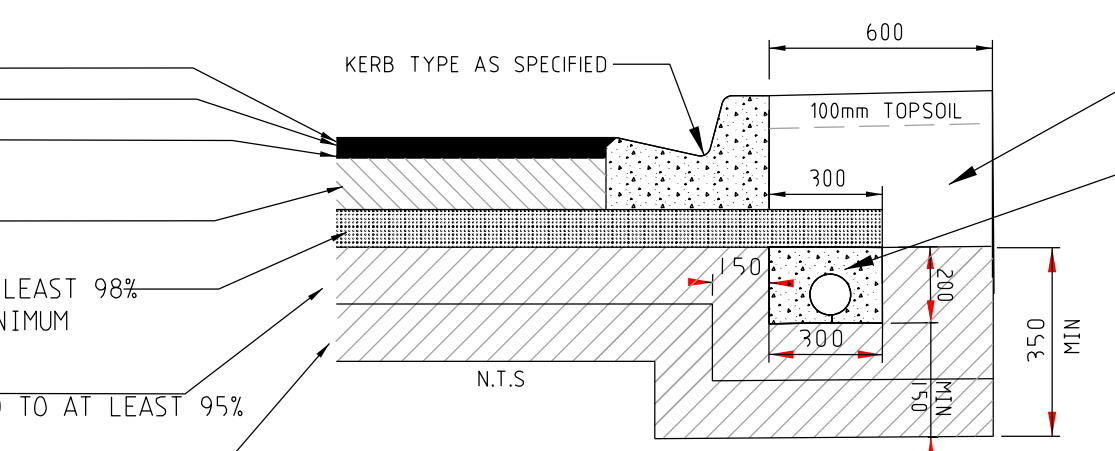

PAVEMENT DETAILS
BRIGHTON AVENUE, BROAD WAY,
BANK STREET AND HALO LANE

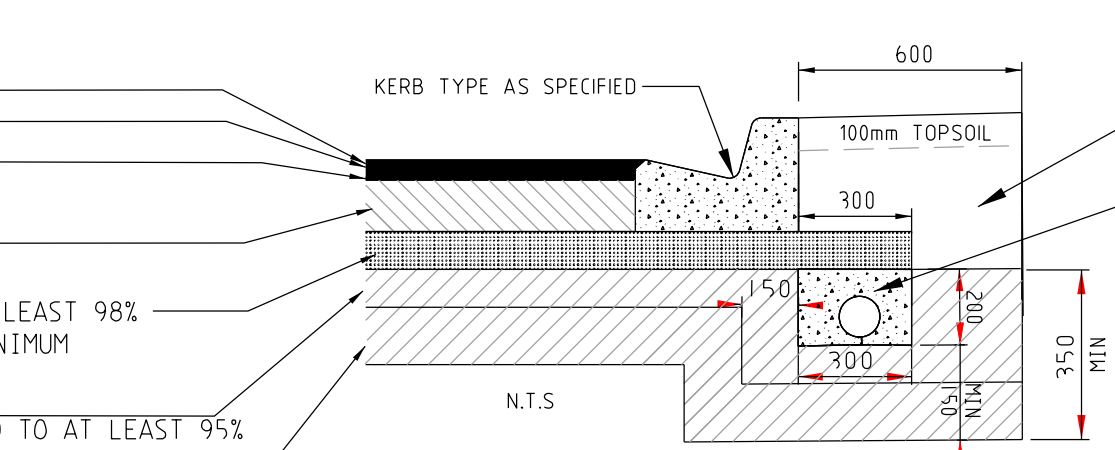


PAVEMENT DETAILS
NEWRY STREET

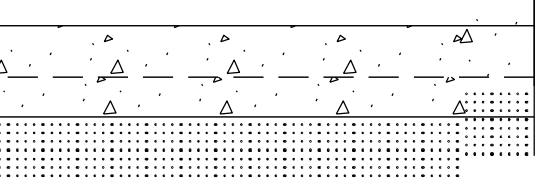

PAVEMENT DETAILS
MEMENTO LANE AND
SUMMERS LANE

40. PRIOR TO COMMENCEMENT OF WORKS, THE CONTRACTOR MUST SUBMIT A SMP TO THE DEVELOPER'S CONSULTANT FOR APPROVAL. THE CONTRACTOR MUST COMPLY WITH THE RECOMMENDATIONS OF THE ENVIRONMENT PROTECTION AUTHORITY PUBLICATION No.275 "CONSTRUCTION TECHNIQUES FOR SEDIMENT POLLUTION CONTROL" AND MW SITE ENVIRONMENTAL MANAGEMENT POLICY 3.8.2. APPROPRIATE SILTATION CONTROL IS TO BE MAINTAINED THROUGHOUT THE CONSTRUCTION AND MAINTENANCE PERIOD OF THE WORKS.
41. ALL FOOTPATHS IN ROADS TO BE OFFSET 50mm FROM PROPERTY BOUNDARY. FOOTPATHS CONSTRUCTED ABOVE EXISTING LEVEL TO BE CONSTRUCTED ON APPROVED FILL (TO AS-3798) OF F.C.R. INTO NATURAL GROUND.
42. REFER TO LANDSCAPE ARCHITECT PLANS FOR DETAILS OF VEHICLE EXCLUSION FENCING AROUND PERIMETER OF WORKS.
43. PRIOR TO COMMENCEMENT OF WORKS A RINGLOCK WIRE MESH FENCE, APPROX 1.8m HIGH, SHALL BE ERECTED AROUND TREES NOTED "TO BE RETAINED". CORNER POSTS TO BE TREATED PINE WITH TREATED PINE STAYS. INTERMEDIATE POSTS TO BE STAR PICKETS AT 3m INTERVALS, EVERY THIRD POST TO BE TREATED PINE, NO CONCRETE IS TO BE USED TO SECURE POSTS. NO EXCAVATION SHALL BE CARRIED OUT WITHIN 5.0m OF ANY TREE UNTIL APPROVAL IS GIVEN BY THE ENGINEER.
44. ALL FENCES ADJOINING ALL RESERVES (OTHER THAN ROAD RESERVES) ARE TO BE ERECTED BY THE DEVELOPER (OR OWNER) AT NO COST TO COUNCIL AND SHALL BE CONSTRUCTED PRIOR TO STATEMENT OF COMPLIANCE IN ACCORDANCE WITH CONDITION 43 OF THE PERMIT.
45. EXISTING DAM OR WATERCOURSES TO BE EXCAVATED TO A FIRM BASE AND BACKFILLED AS SPECIFIED. DEVELOPER'S CONSULTANT TO BE NOTIFIED WHEN THE DAM OR WATERCOURSES ARE EXCAVATED TO A FIRM BASE. NO FILLING IS TO BE PLACED PRIOR TO DAMS BEING INSPECTED AND LEVELS TAKEN. BACKFILLING IS TO BE CARRIED OUT TO THE SATISFACTION OF THE COUNCIL SUPERVISING ENGINEER.
46. TACTILE GROUND SURFACE INDICATORS (TGS1) ARE TO BE INSTALLED WHERE SHOWN IN ACCORDANCE WITH AS1428 AND SD320.
47. THE CONTRACTOR MUST ARRANGE THE REQUISITE INSPECTIONS OF THE WORKS WITH THE CHIEF EXECUTIVE OFFICER/OR THEIR REPRESENTATIVE AS PER THE HOLD POINTS IN THE WHITTLESEA CITY COUNCIL SPECIFICATIONS.
48. THE CONTRACTOR IS TO OBTAIN A BUILDING PERMIT FOR ANY STRUCTURE / FENCES AND OR ANY RETAINING WALLS 600mm IN HEIGHT.
49. ANY INFRASTRUCTURE DAMAGE DURING THE DEFECTS LIABILITY PERIOD IS THE RESPONSIBILITY OF THE DEVELOPER OR HIS REPRESENTATIVE AND IS TO BE REINSTATED TO THE SATISFACTION OF THE CHIEF EXECUTIVE OFFICER / OR THEIR REPRESENTATIVE.
50. AT THE COMPLETION OF ALL WORKS, ALL RUBBISH, DEBRIS AND SURPLUS SPOIL SHALL BE REMOVED AND THE SITE SHALL BE CLEARED TO THE SATISFACTION OF THE CHIEF EXECUTIVE OFFICER / OR THEIR REPRESENTATIVE.
51. ALL FIRE HYDRANTS ARE TO BE MARKED IN ACCORDANCE WITH "IDENTIFICATION OF STREET HYDRANTS FOR FIRE-FIGHTING PURPOSES" PUBLICATION (DEVELOPED BY C.F.A., M.F.E.S.B. & N.R.E.). MARKINGS TO BE VIA BLUE PAVEMENT MARKER AND A (RED TOPPED) WHITE POST.



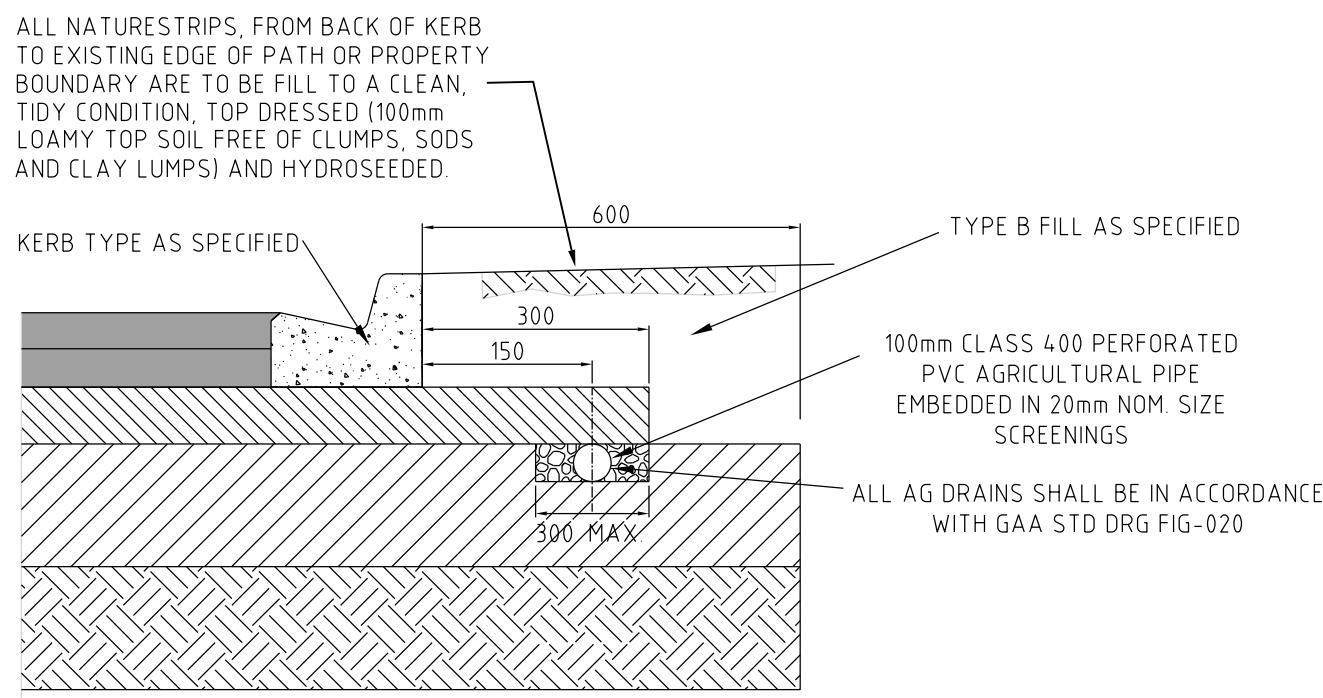


PAVEMENT COMPOSITION
NOT TO SCALE

AS CONSTRUCTED


AMENDMENTS				breese pitt dixon Pty. Ltd. land surveyors civil engineers				1/19 coto street hawthorn east, 3123 telephone 8823 2300 fax no. 8823 2310							
	H	05-04-19										NOTE 35 AMENDED			
	G	21-03-19										NOTE 4 35 AMENDED			
	F	18-01-19										NOTE 35 AMENDED			
	E	12-10-18										NOTE 35 AMENDED			
	B	11-5-18										NOTE. 6 AMENDED			
	A	19-12-17	ISSUED FOR CONSTRUCTION	DRAWN	SS	RATHDOWNE ESTATE STAGE 1 NOTES AND LOCALITY PLAN				MUNICIPALITY WHITTLESEA					
					REFERENCE 9365 E/1										
VER	DATE	REMARKS		CHECKED		SCALE	AS SHOWN	DATUM	AHD	DATE	JAN'17	SHEET	2	OF 19	H

AS CONSTRUCTED

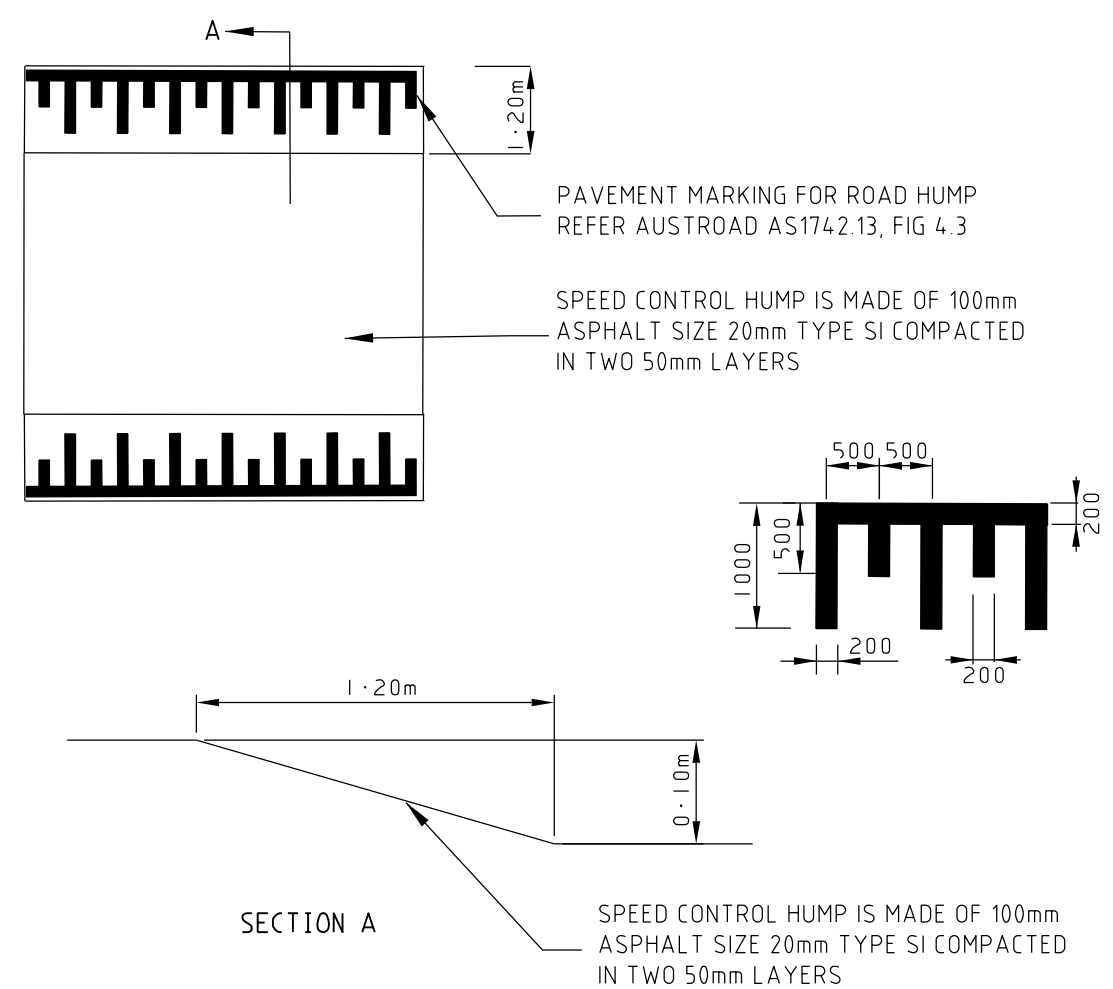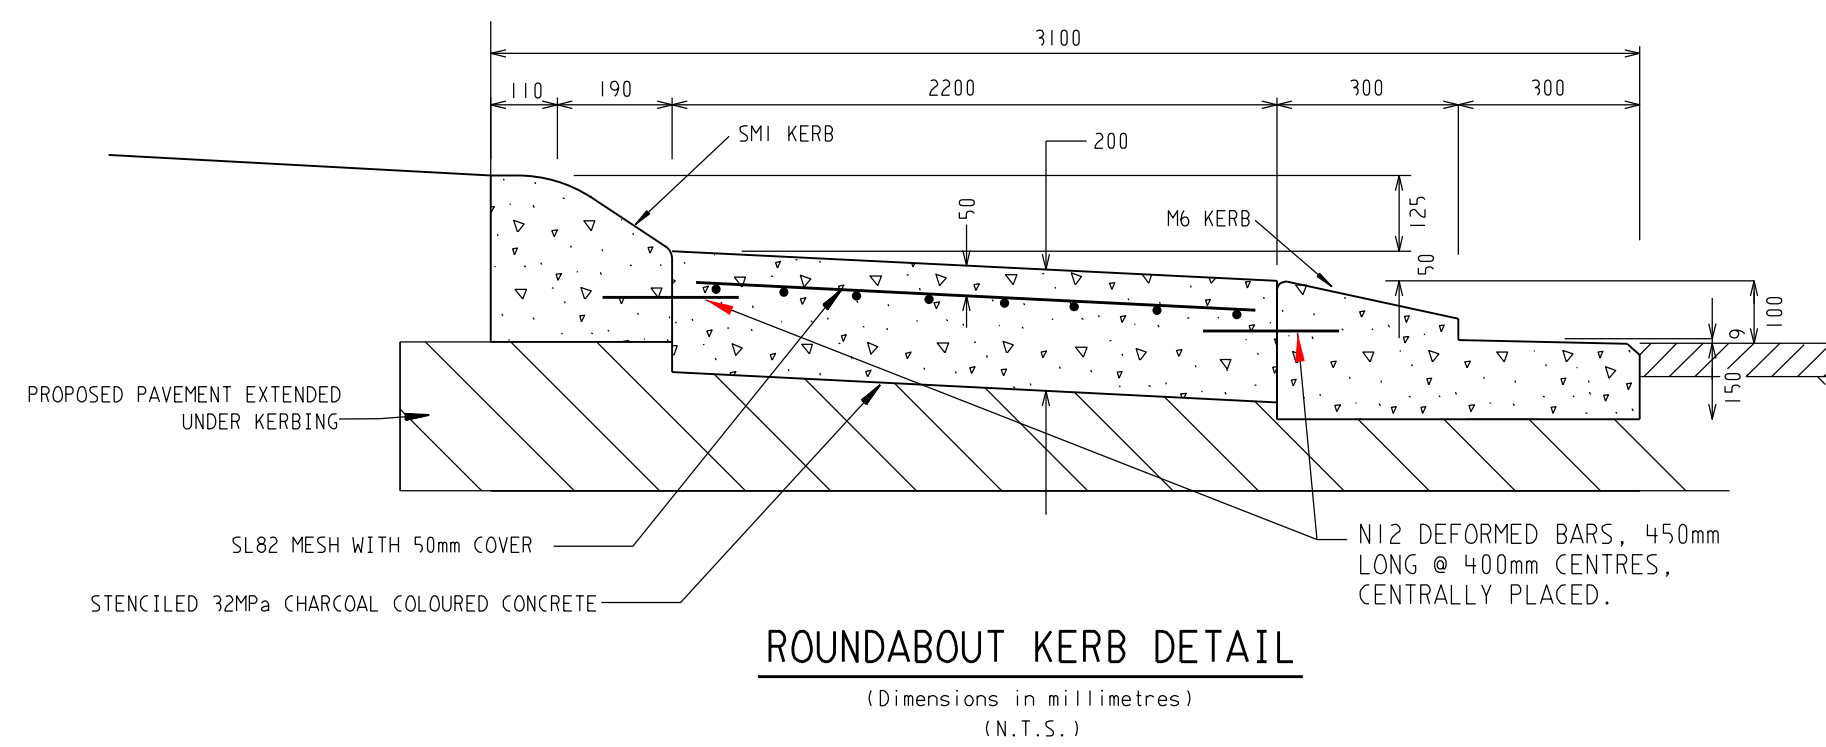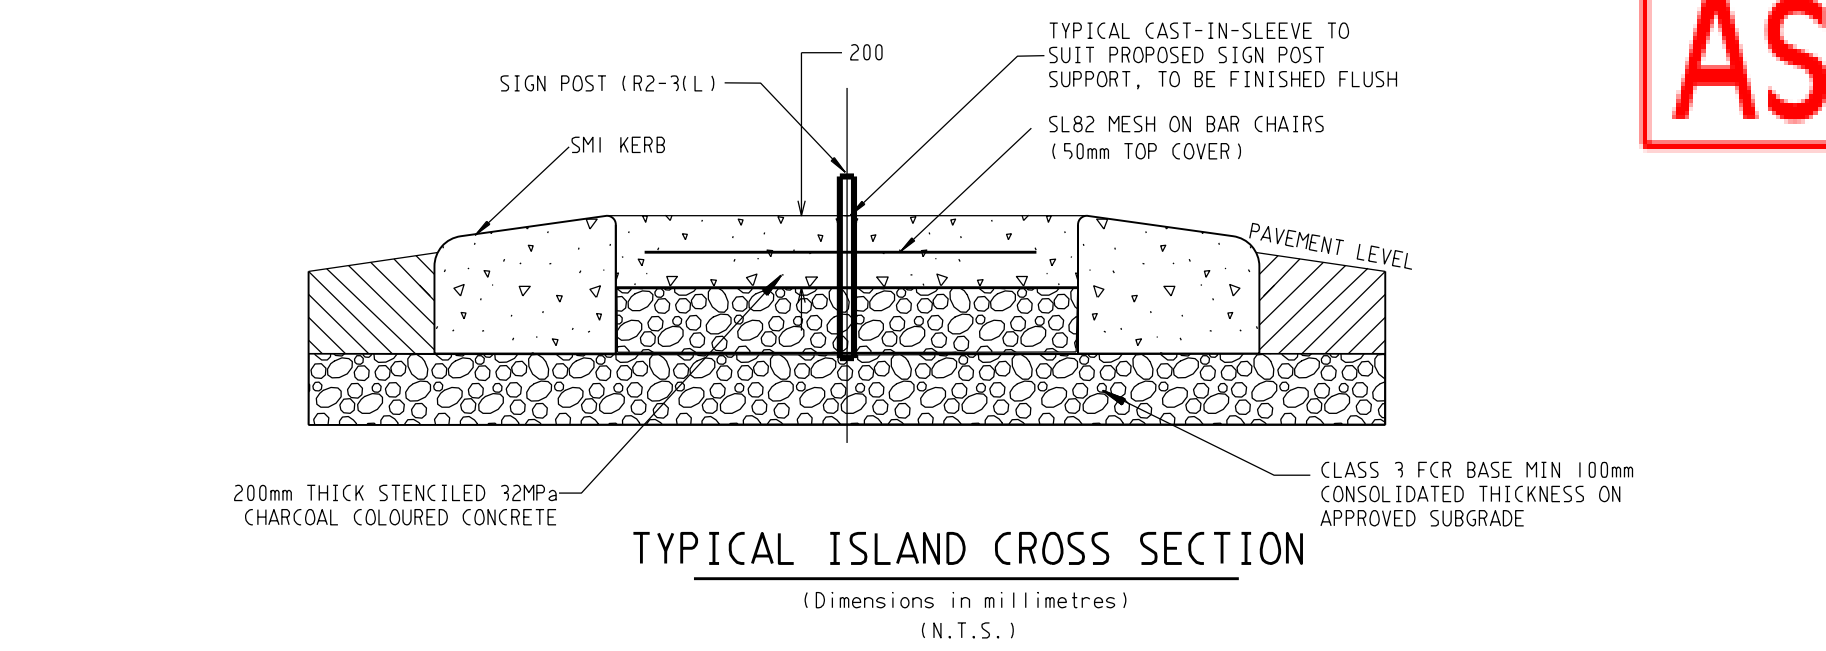


SETOUT DETAIL FOR RAISED PAVEMENT


NOTE: ASPHALT TO BE COMPACTED IN LAYERS NOT MORE THAN 50mm.

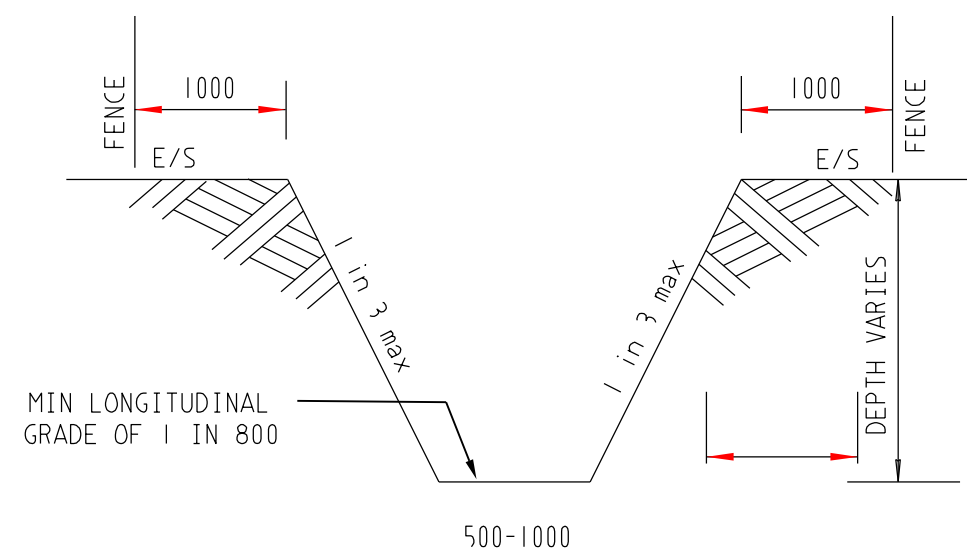

TEMPORARY OUTFALL CHANNEL DETAIL
(Dimensions in millimetres)
(N.T.S.)

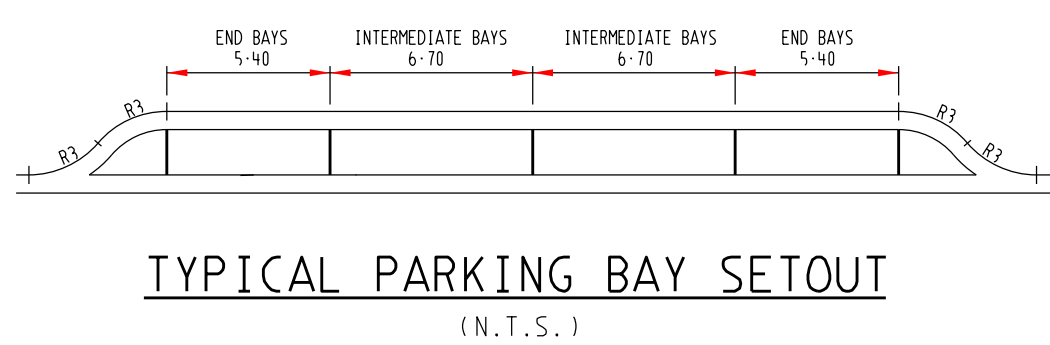

TYPICAL PARKING BAY SETOUT
(N.T.S.)

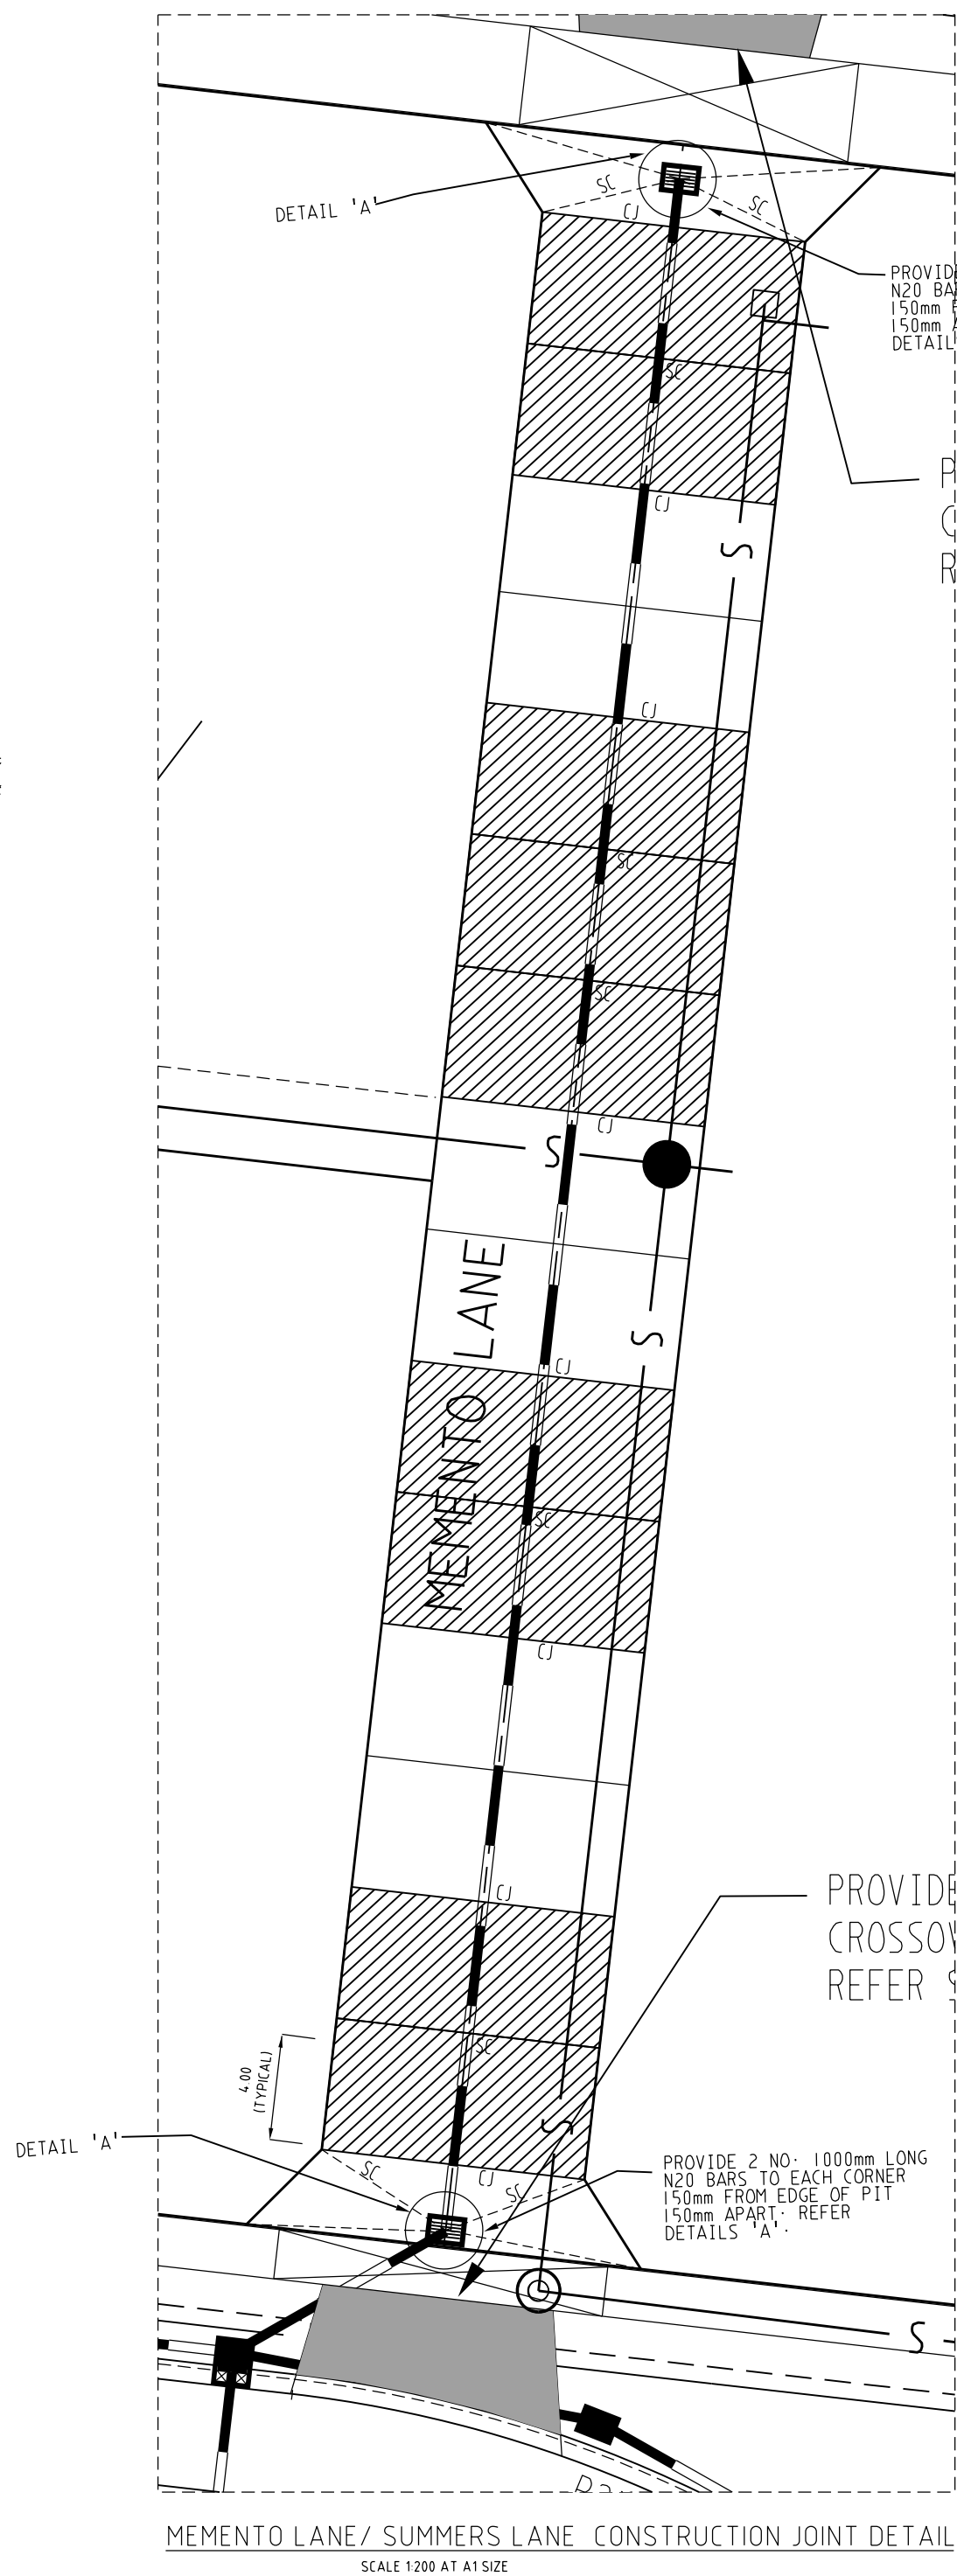

THE CONCRETE IS TO BE POURED IN ALTERNATIVE BAYS.
BAYS THAT ARE SHOWN HATCHED ARE TO BE POURED FIRST.
SECOND POUR IS TO TAKE PLACE AFTER THE INITIAL
PLASTIC SHRINKAGE HAS OCCURED.

ALL DOWELS IN EXISTING CONCRETE ARE TO BE GREASED TO THE FACE OF THE EXISTING CONCRETE BEFORE THE NEXT POUR.

GENERAL NOTES

ALL WORKS TO BE COMPLETED IN ACCORDANCE WITH RELEVANT AUSTRALIAN STANDARDS AND CCAA LITERATURE OR VIC ROADS STANDARDS FOR NON RESIDENTIAL STREETS.

ALL CONCRETE TO BE MINIMUM 32MPa COMPRESSIVE STRENGTH
CONCRETE TO BE THOROUGHLY COMPACTED USING EITHER
SURFACE AND/OR IMMERSSION VIBRATORS, PARTICULARLY
AROUND REINFORCEMENT AND IN CORNERS OF FORMS.

PRIOR TO CASTING, THE UNBOUND GRANULAR SUBBASE MUST BE DAMP TO ENSURE NO EARLY "DRYING OUT" OF THE CONCRETE.

CURING OF CONCRETE IS ESSENTIAL - IDEALLY BY
MAINTAINING WET HESSIAN OR SEALING WITH PLASTIC
SHEETING.


SAW CUTTING OF CONCRETE SHOULD BE COMMENCE AS SOON AS
CONCRETE PERMITS BY EXPERIENCED CONTRACTORS, BUT NO
LATER THEN 12 HOURS
AFTER POUR.

ALL DOWELS TO BE GRADE 250R STEEL BARS, 450mm LONG AND PLACED AT 300mm CENTRES. REFER CCA4- CONCRETE PAVEMENT DESIGN FOR RESIDENTIAL STREETS. FOR DOWEL DIAMETERS, DOWELS MUST BE ACCURATELY PLACED TO ENSURE THE JOINT DOES NOT LOCK. INSERTION OF DOWELS DURING THE PLACING OF CONCRETE IS NOT ACCEPTABLE. DOWELS MUST BE SAWN AND NOT BROKEN.


ALL JOINTS TO BE APPROPRIATELY SEALED TO RESIST THE INTRUSION OF SAND AND GRAVEL AND TO MINIMISE THE INGRESS OF WATER.

VARIATION TO JOINT LAYOUT BY CONTRACTOR WILL NOT BE
 ACCEPTED WITHOUT
 SPECIFIC WRITTEN APPROVAL OF SUPERINTENDENT &
 COUNCIL.


WEAKENED-PLANE JOINT AS SHOWN ON PLAN - MAX SPACING
1.2m

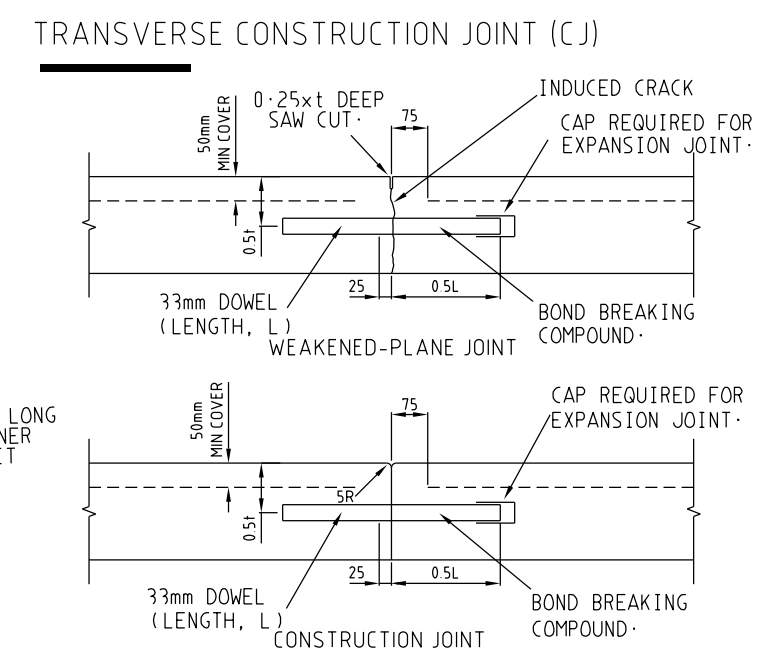


ISOLATION JOINT (ISJ)

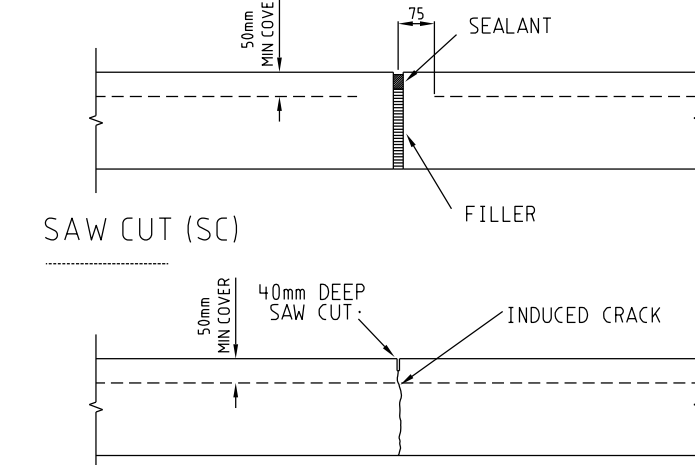

TIED CONSTRUCTION JOINT

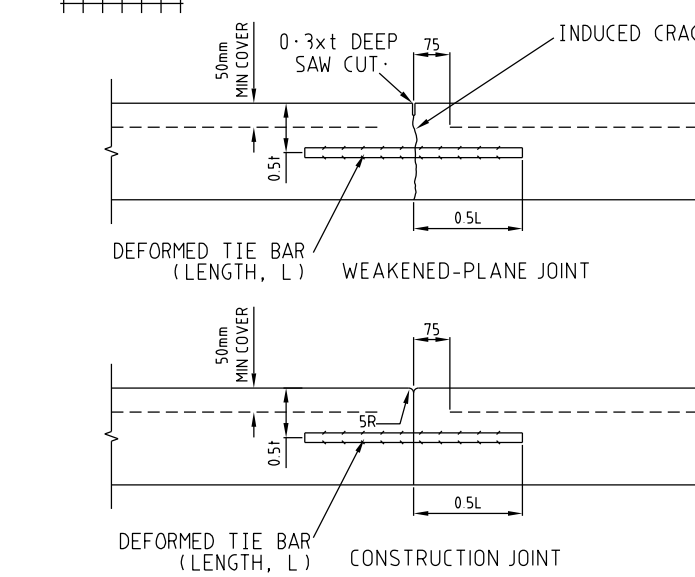


TYPICAL CONSTRUCTION JOINT DETAILS
NOT TO SCALE

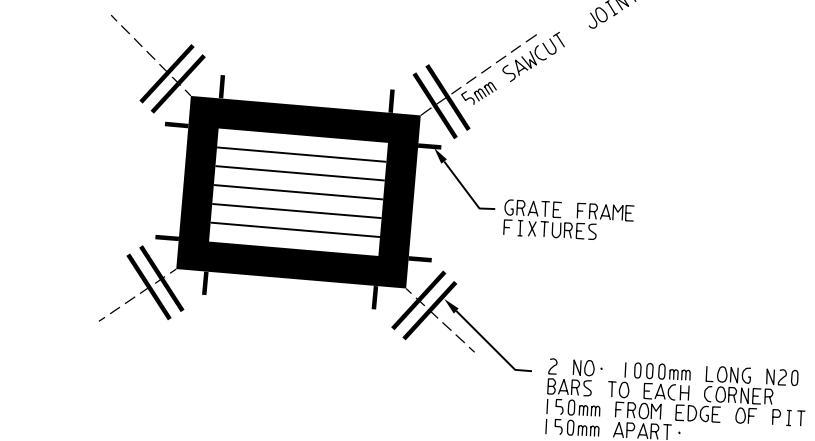

DETAIL 'A'

NOT TO SCALE

CONCRETE JOINT DETAILS AROUND GRATED PIT

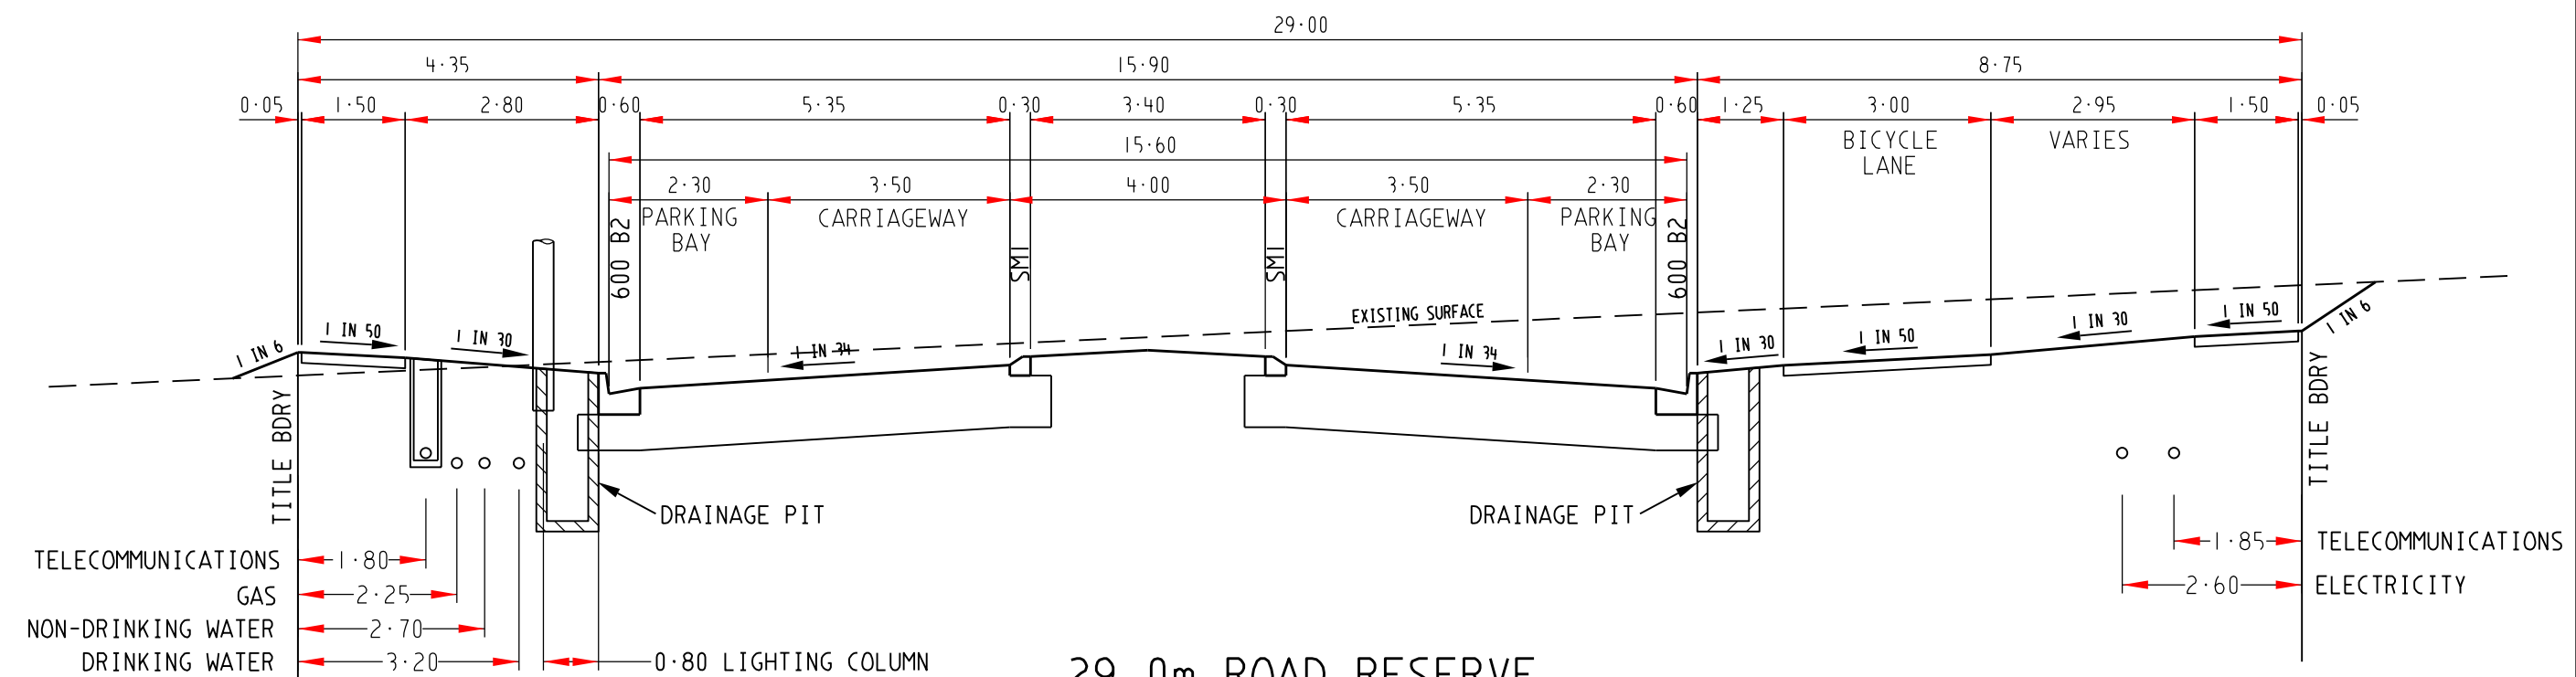


29.0m ROAD RESERVE
JARDIN ROAD
CONNECTOR ROAD










TYPICAL ROAD CROSS SECTIONS

SCALE HORIZONTAL 1:100
 VERTICAL 1:50


AMENDMENTS					breese pitt dixon pty. ltd. land surveyors civil engineers				1/19 cato street hawthorn east, 3123 telephone 8823 2300 fax no. 8823 2310							
				MELWAY REF.	388-C-10			RATHDOWNE ESTATE STAGE I NOTES AND LOCALITY PLAN				MUNICIPALITY				
			SURVEY	SPIIRE			WHITTLESEA									
			DESIGN	SS			REFERENCE									
			DRAWN	SS			9365 E/1									
	A 19-12-17	ISSUED FOR CONSTRUCTION														
VER.	DATE	REMARKS		CHECKED				SCALE	AS SHOWN	DATUM	AHD	DATE	JAN'17	SHEET	3 OF 19	A

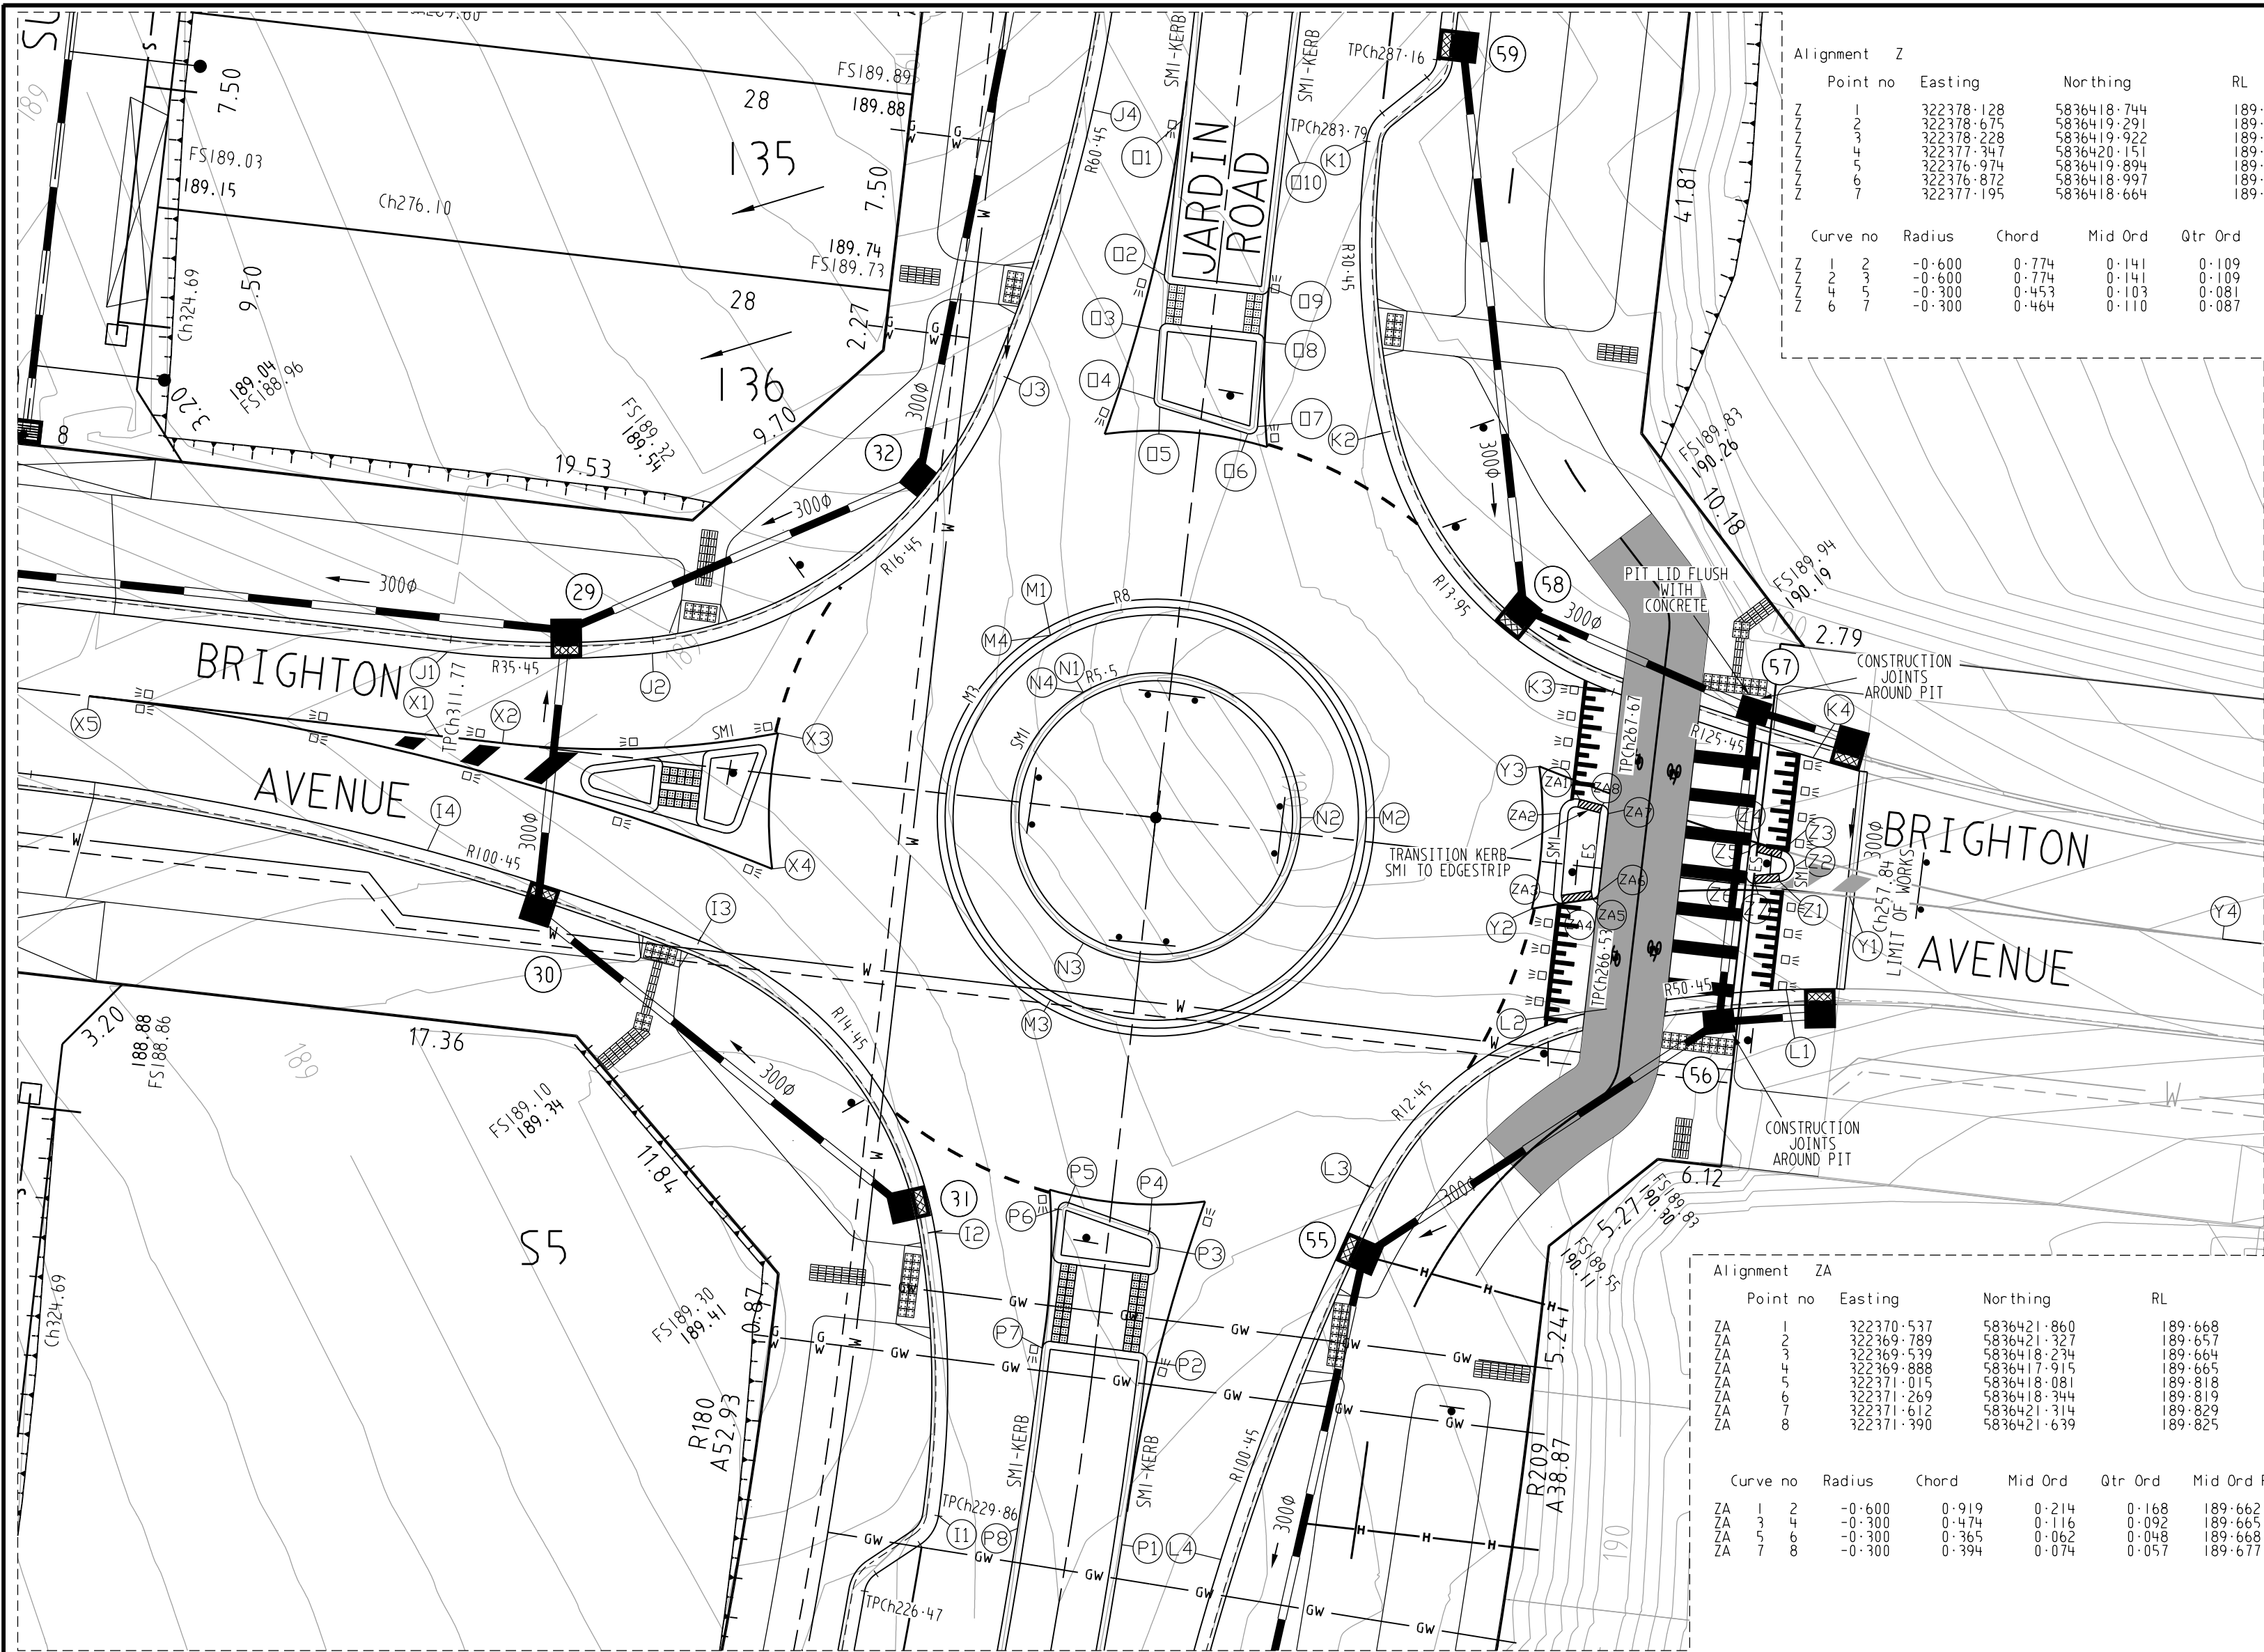

ROUNDAABOUT JARDIN ROAD/ BRIGHTON AVENUE

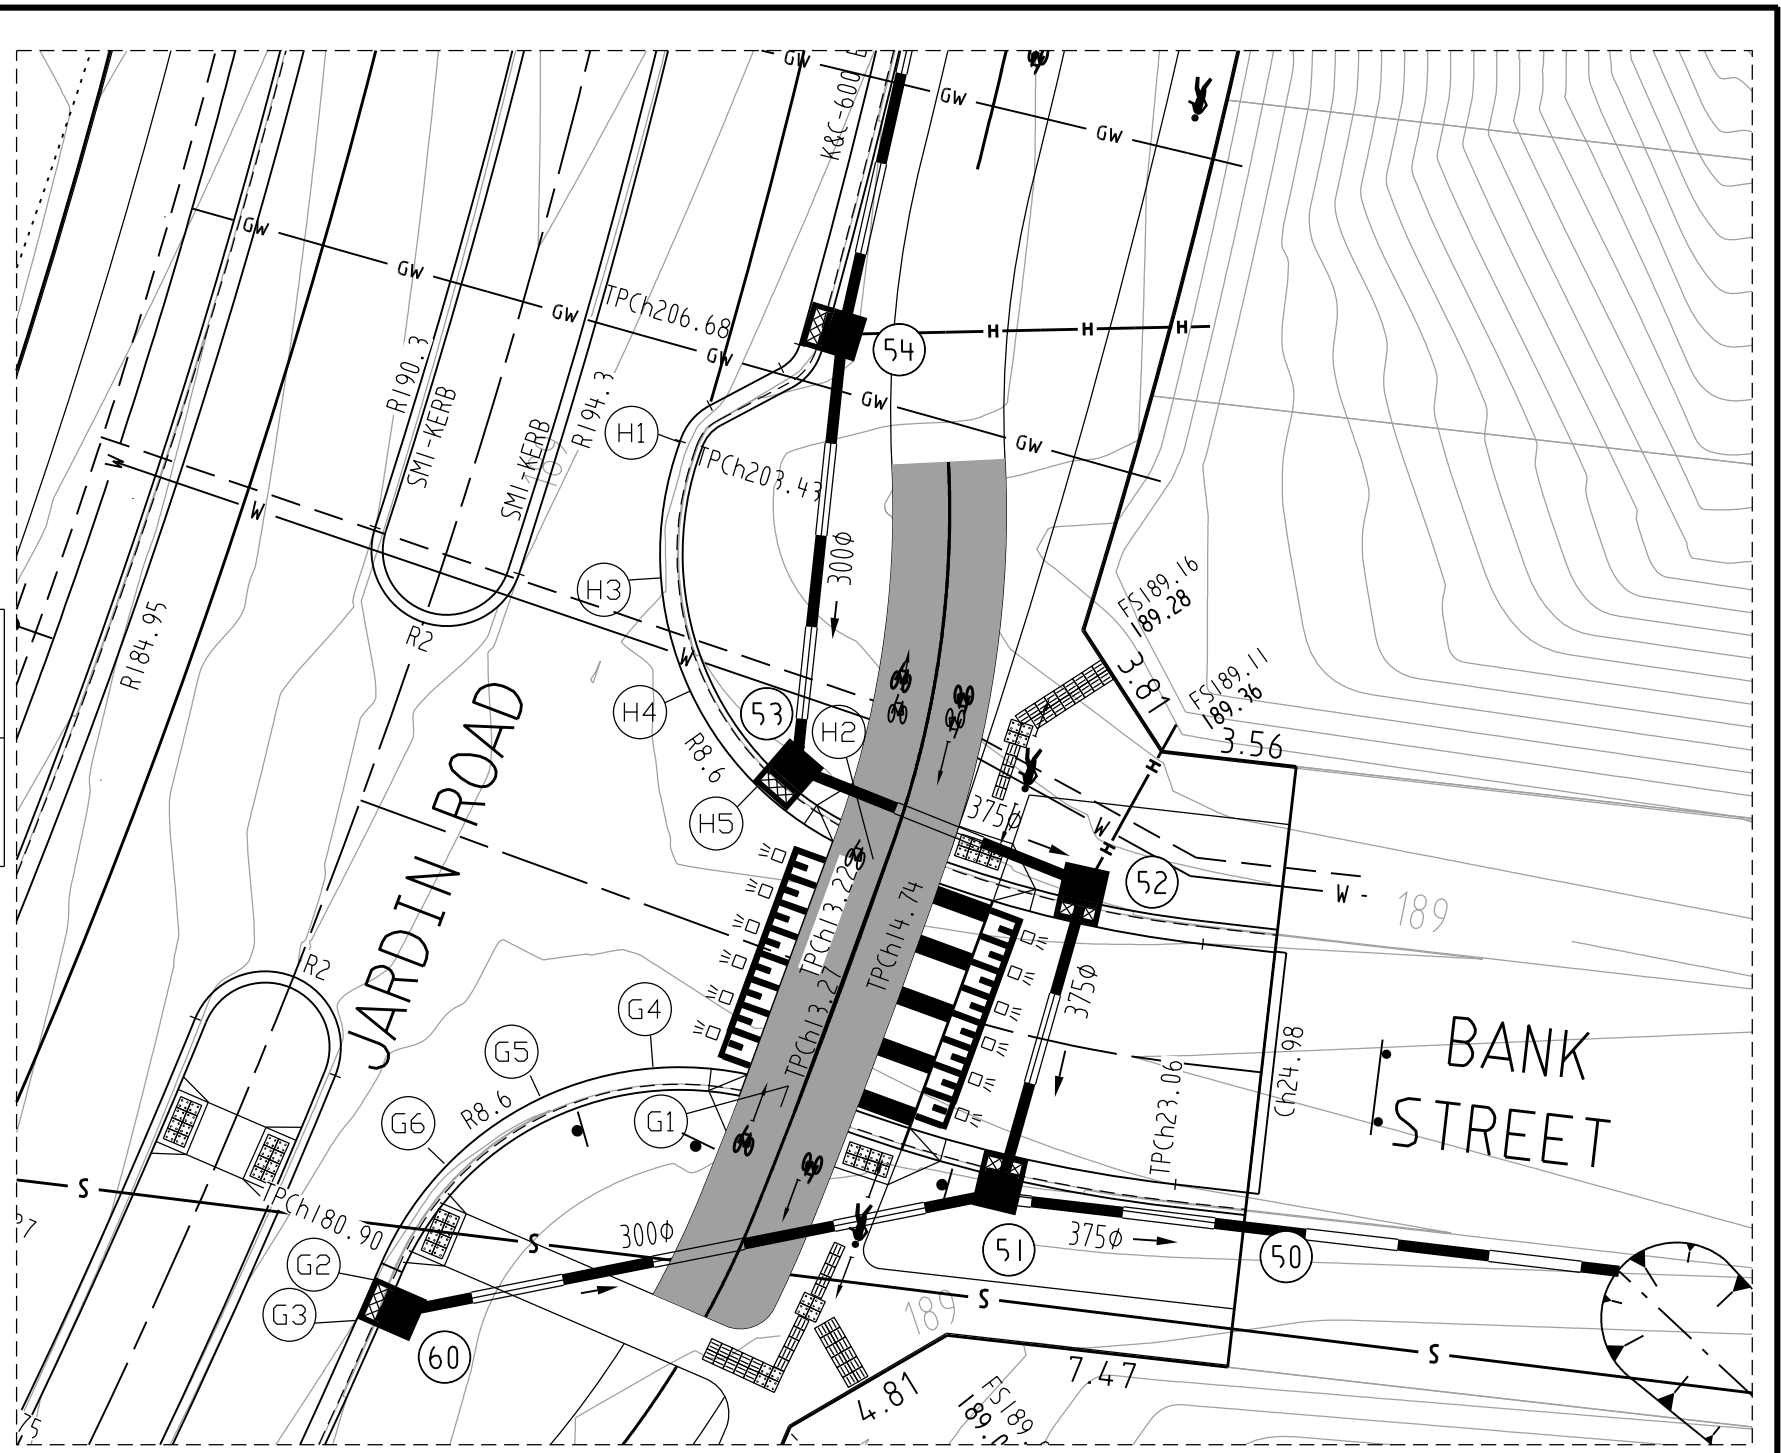
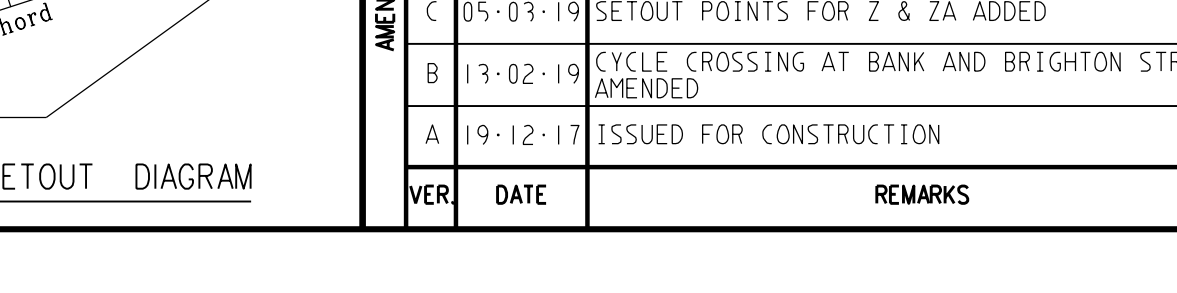
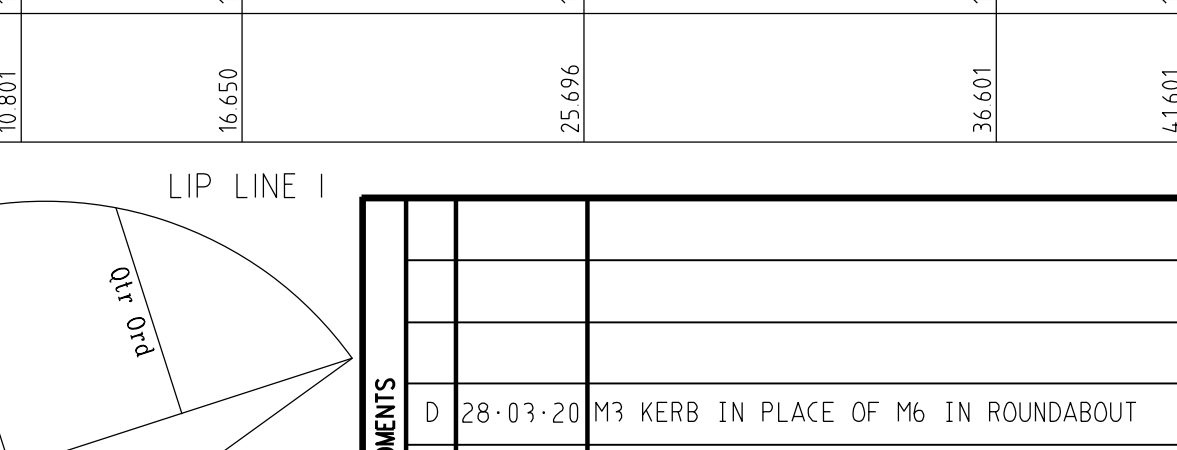
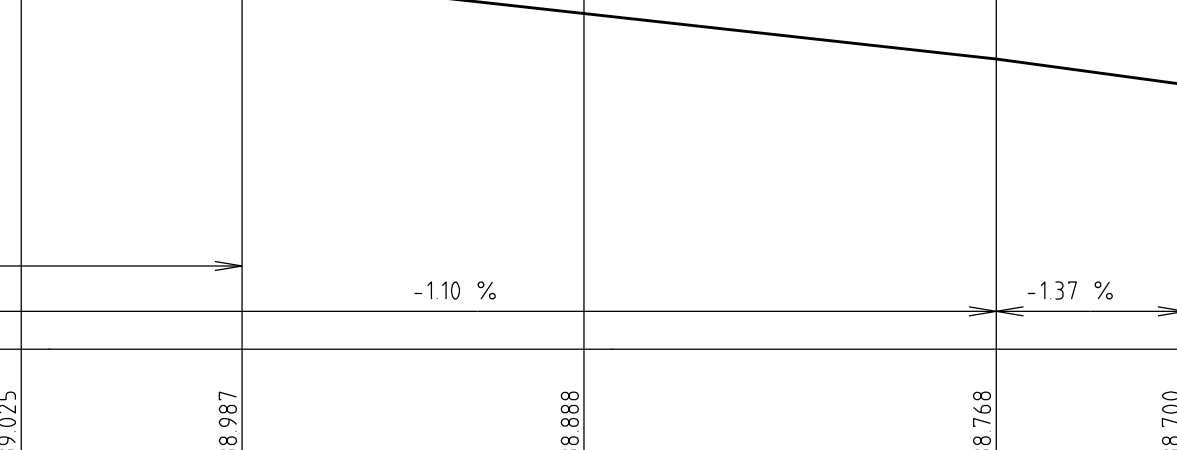
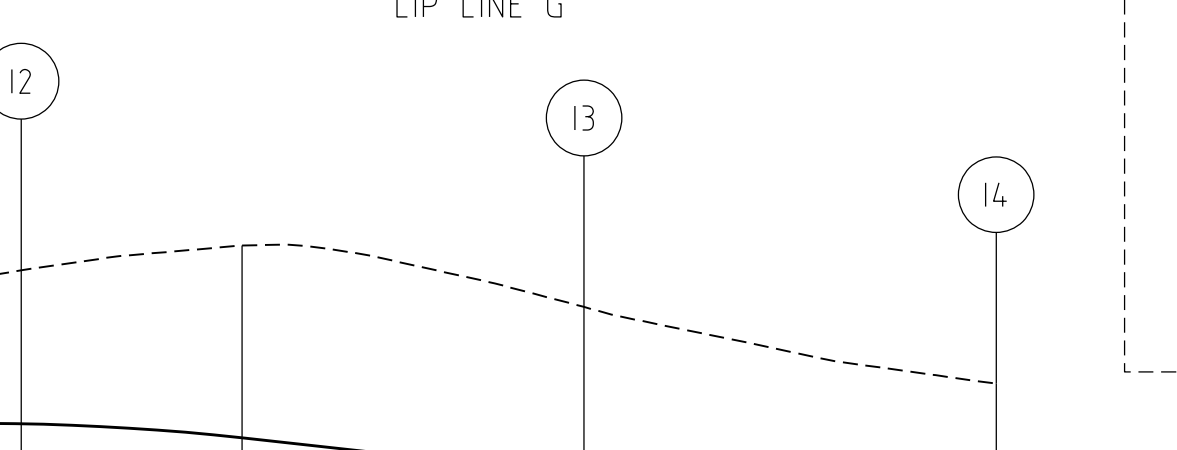
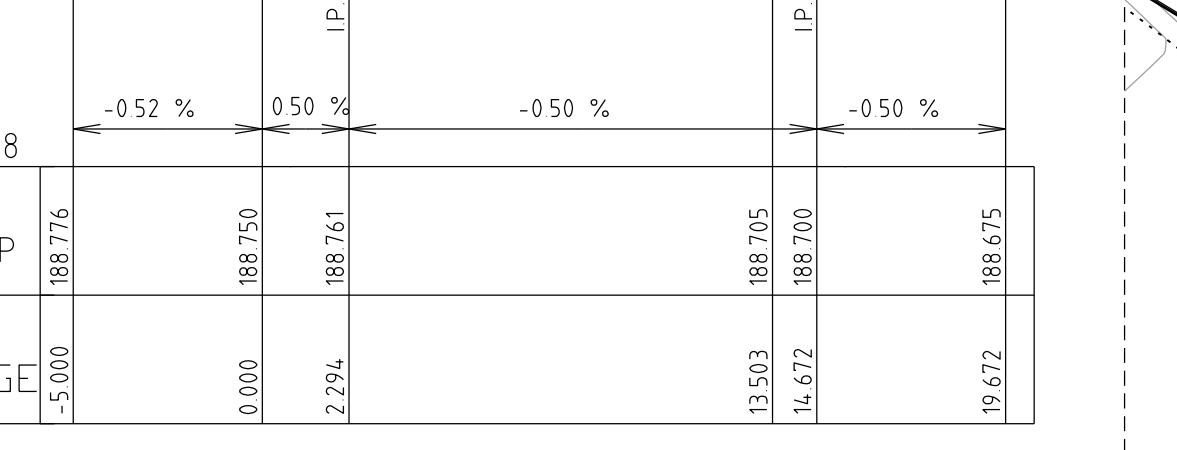
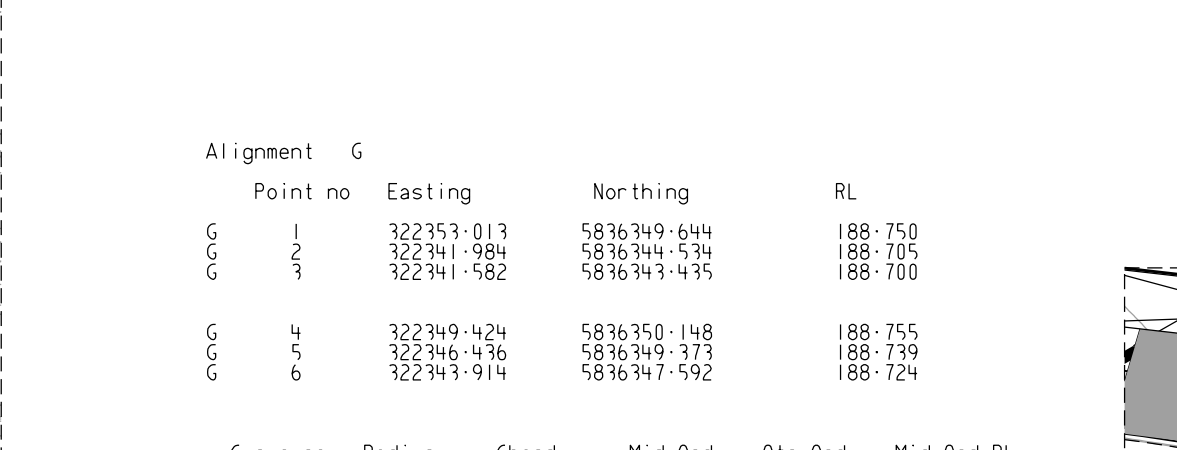
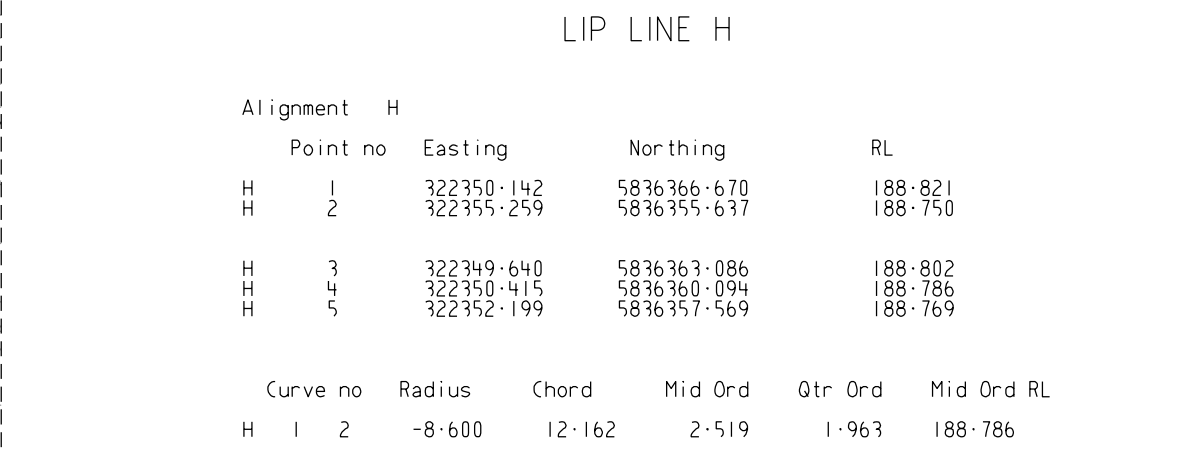
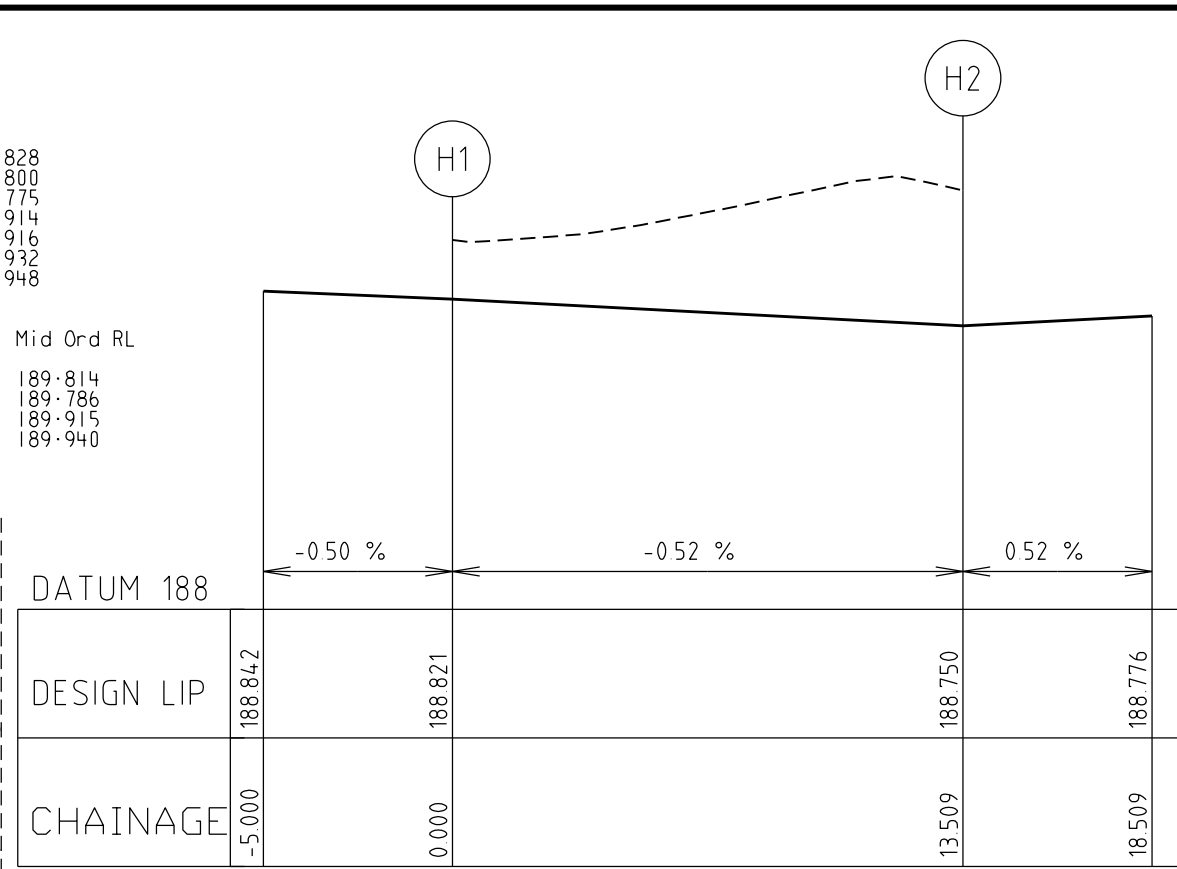



INTERSECTION JARDIN ROAD AND BANK STREET

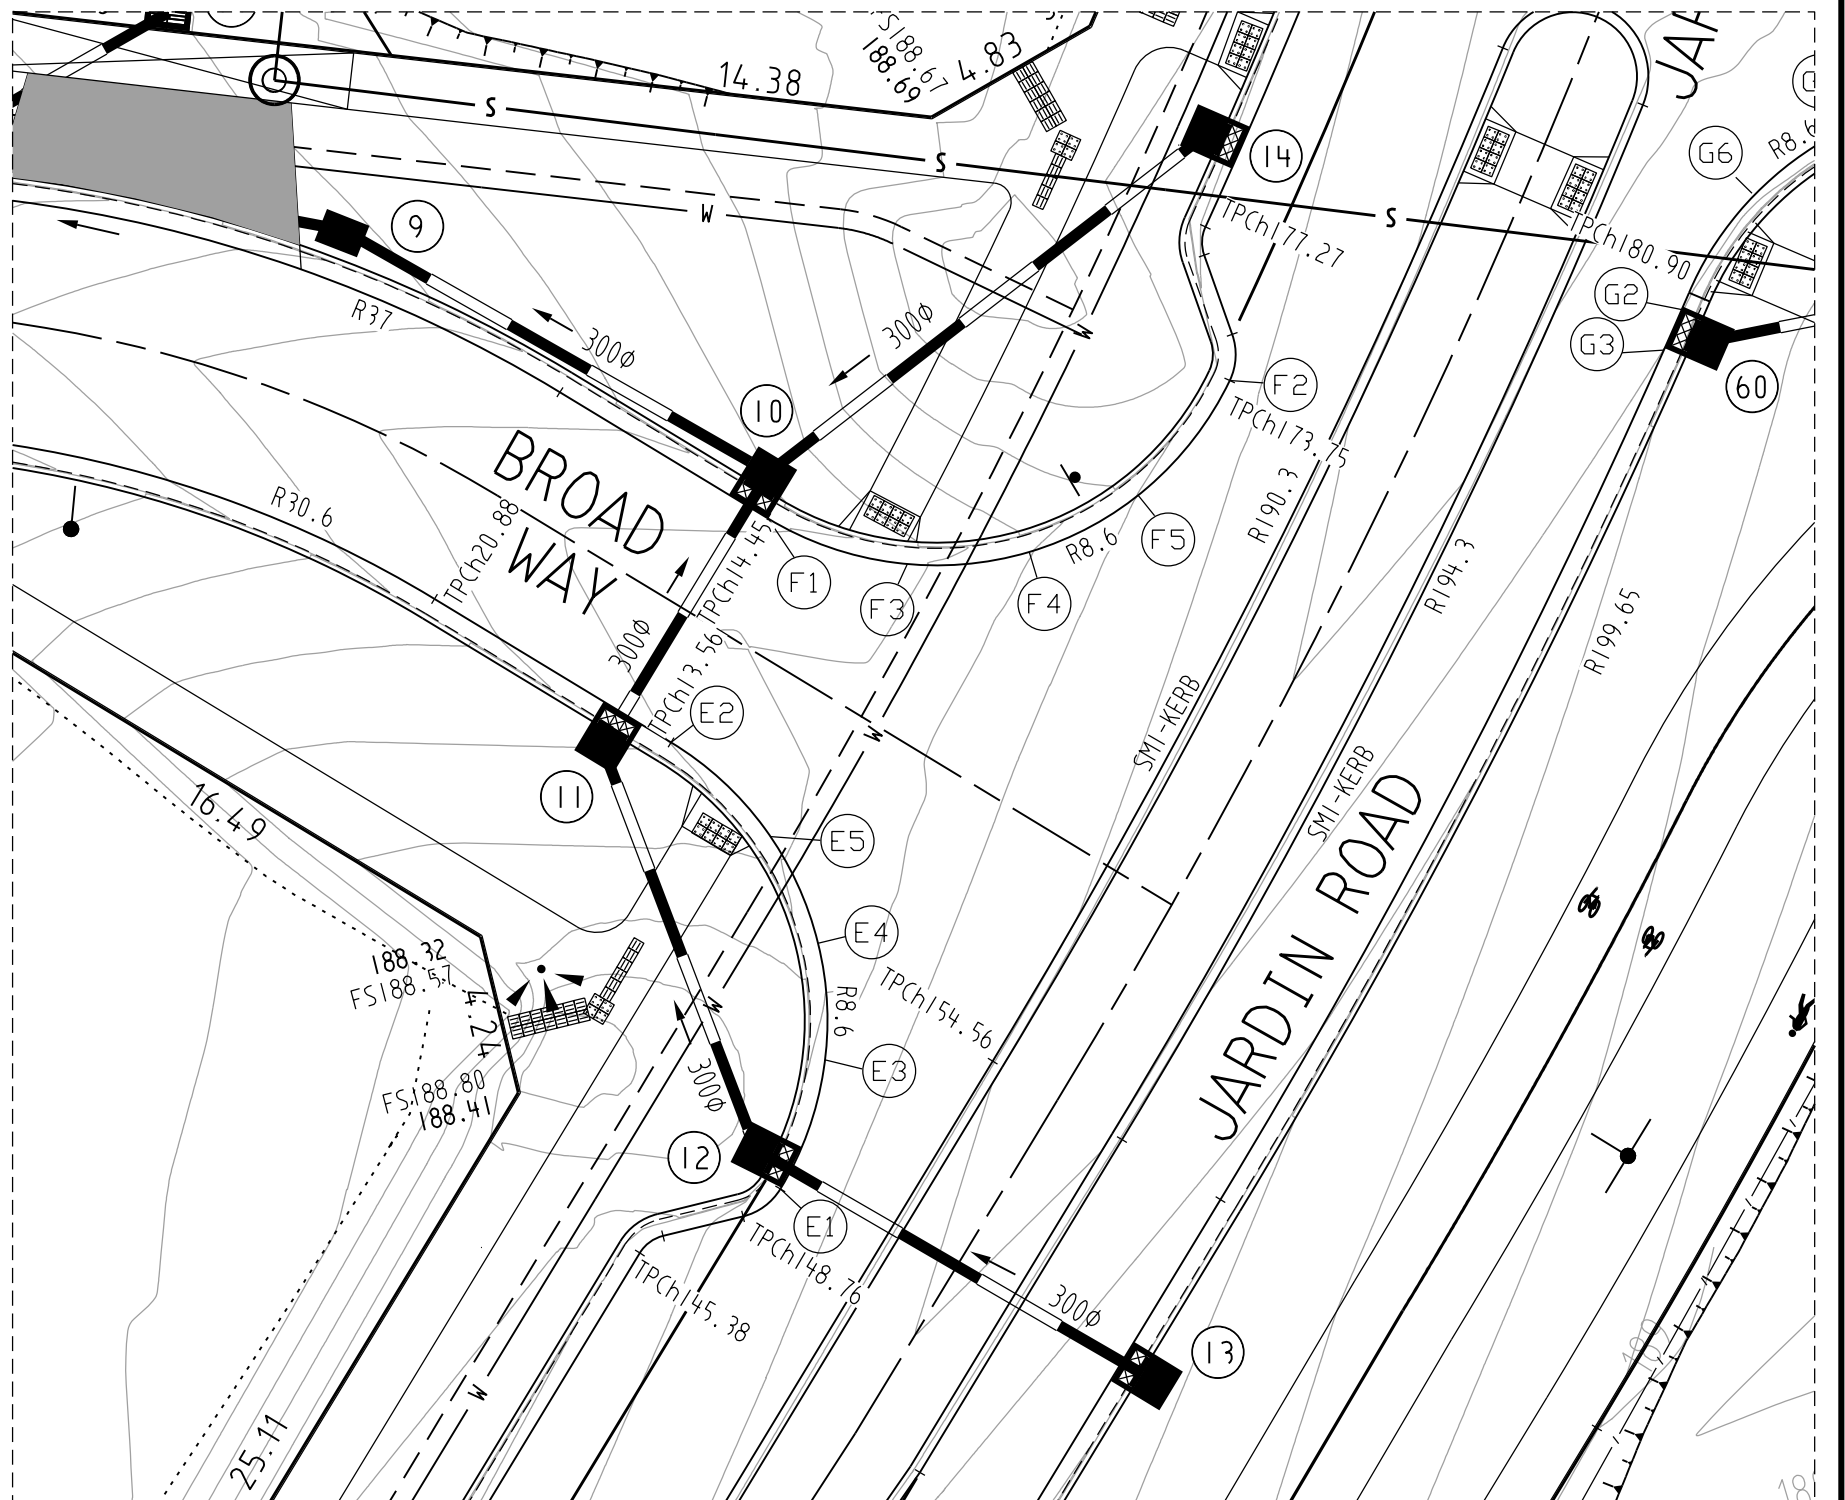


INTERSECTION JARDIN ROAD AND BROAD WAY

AS CONSTRUCTED

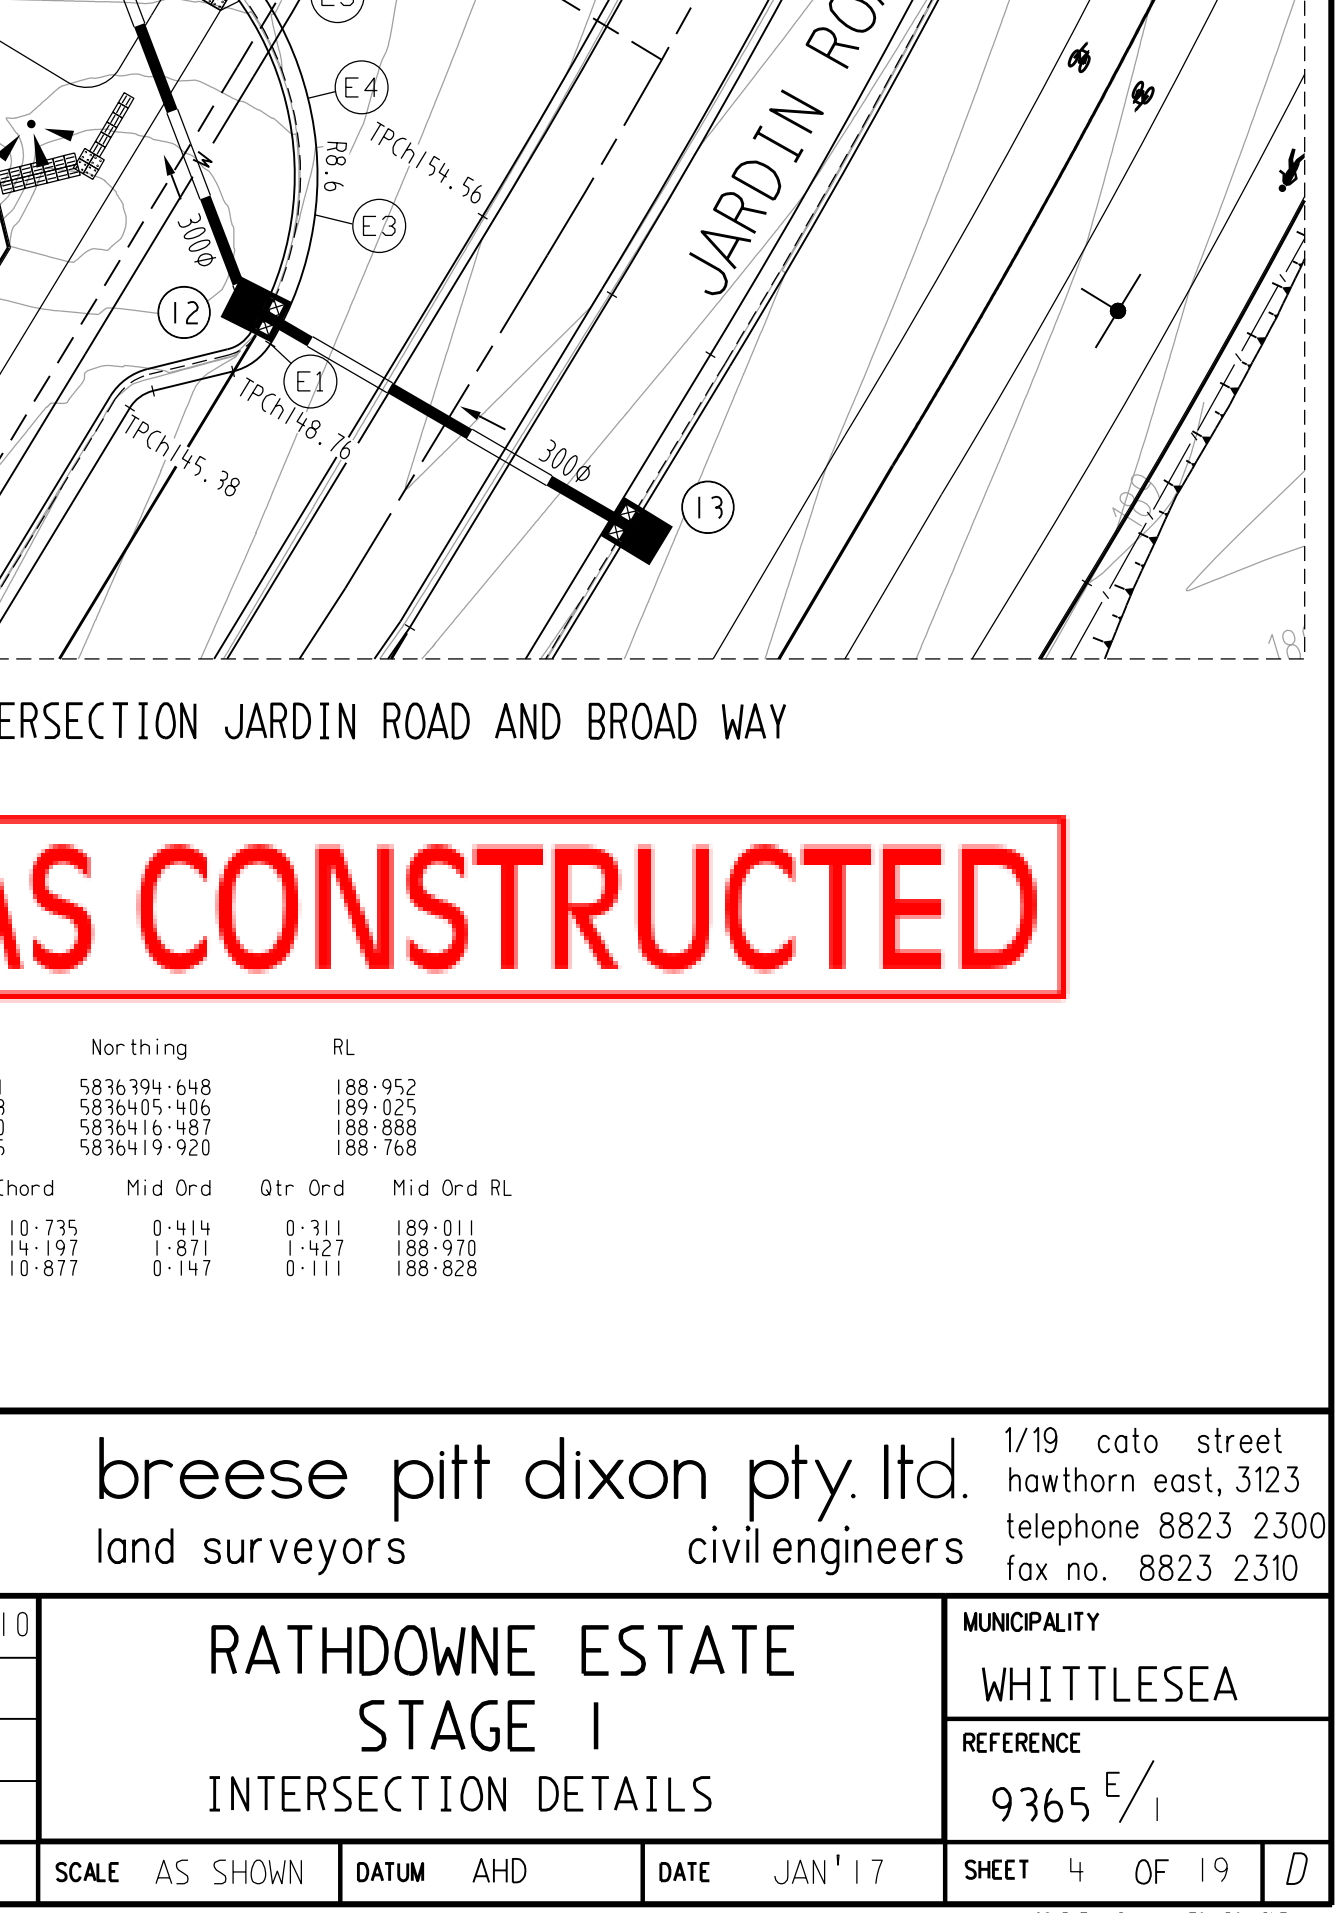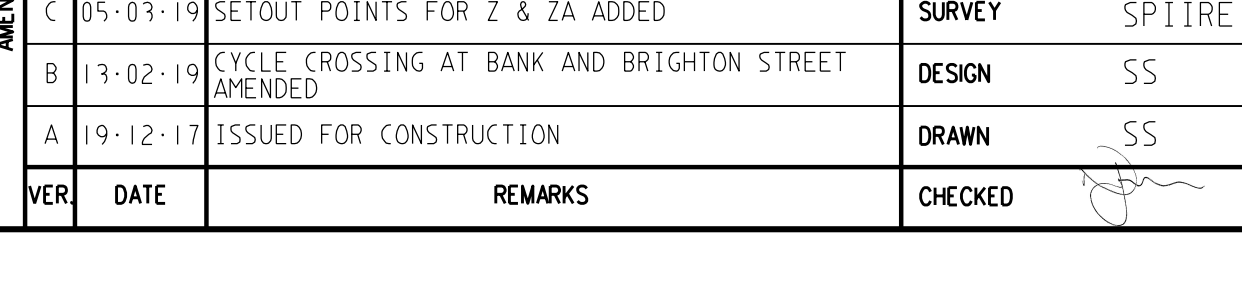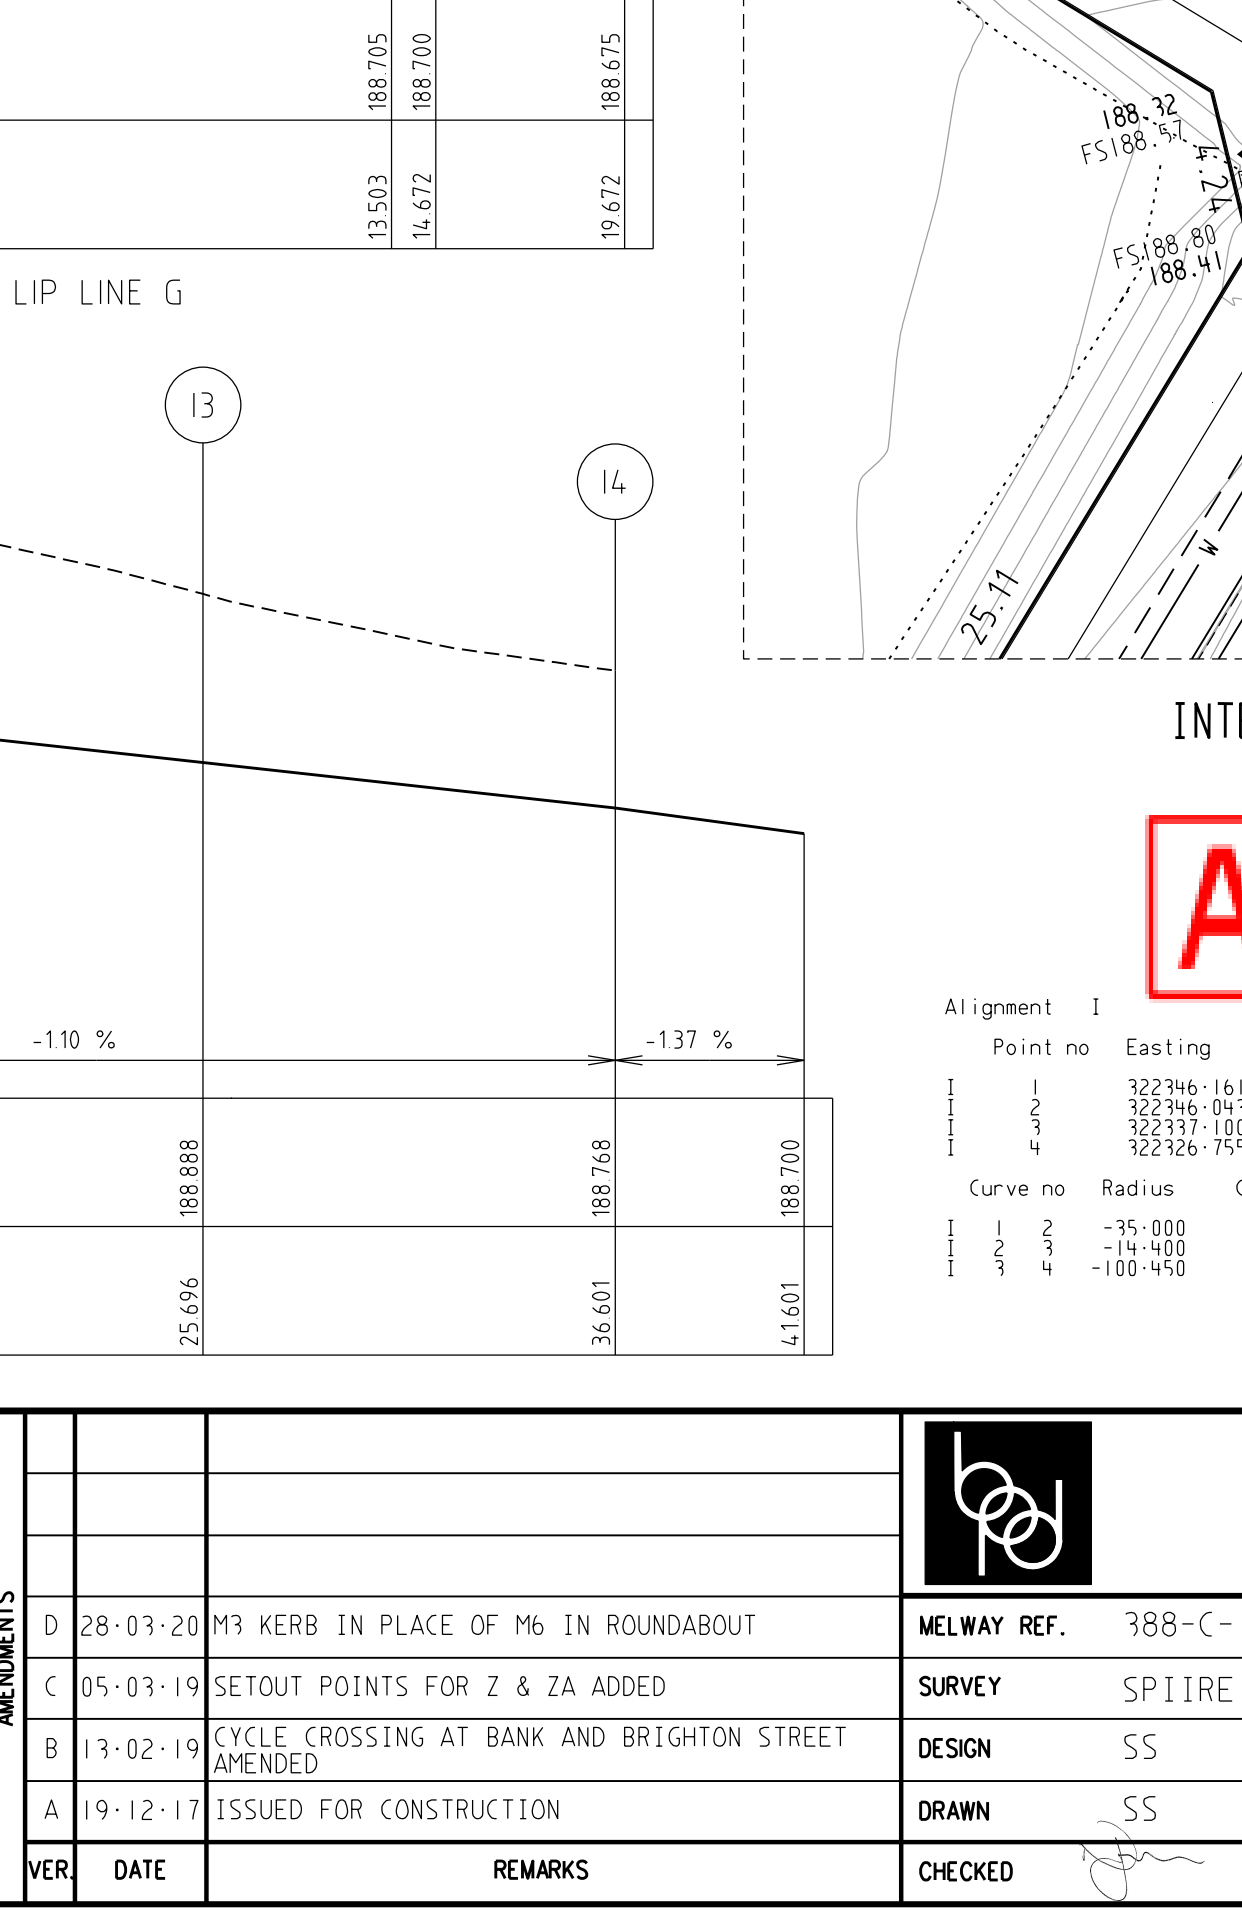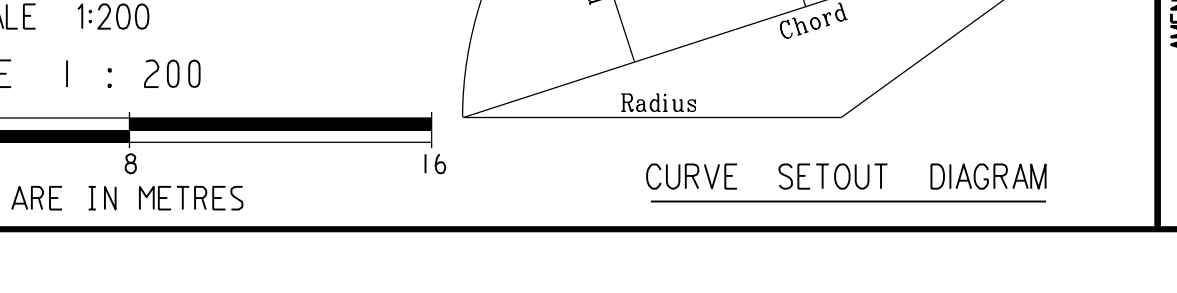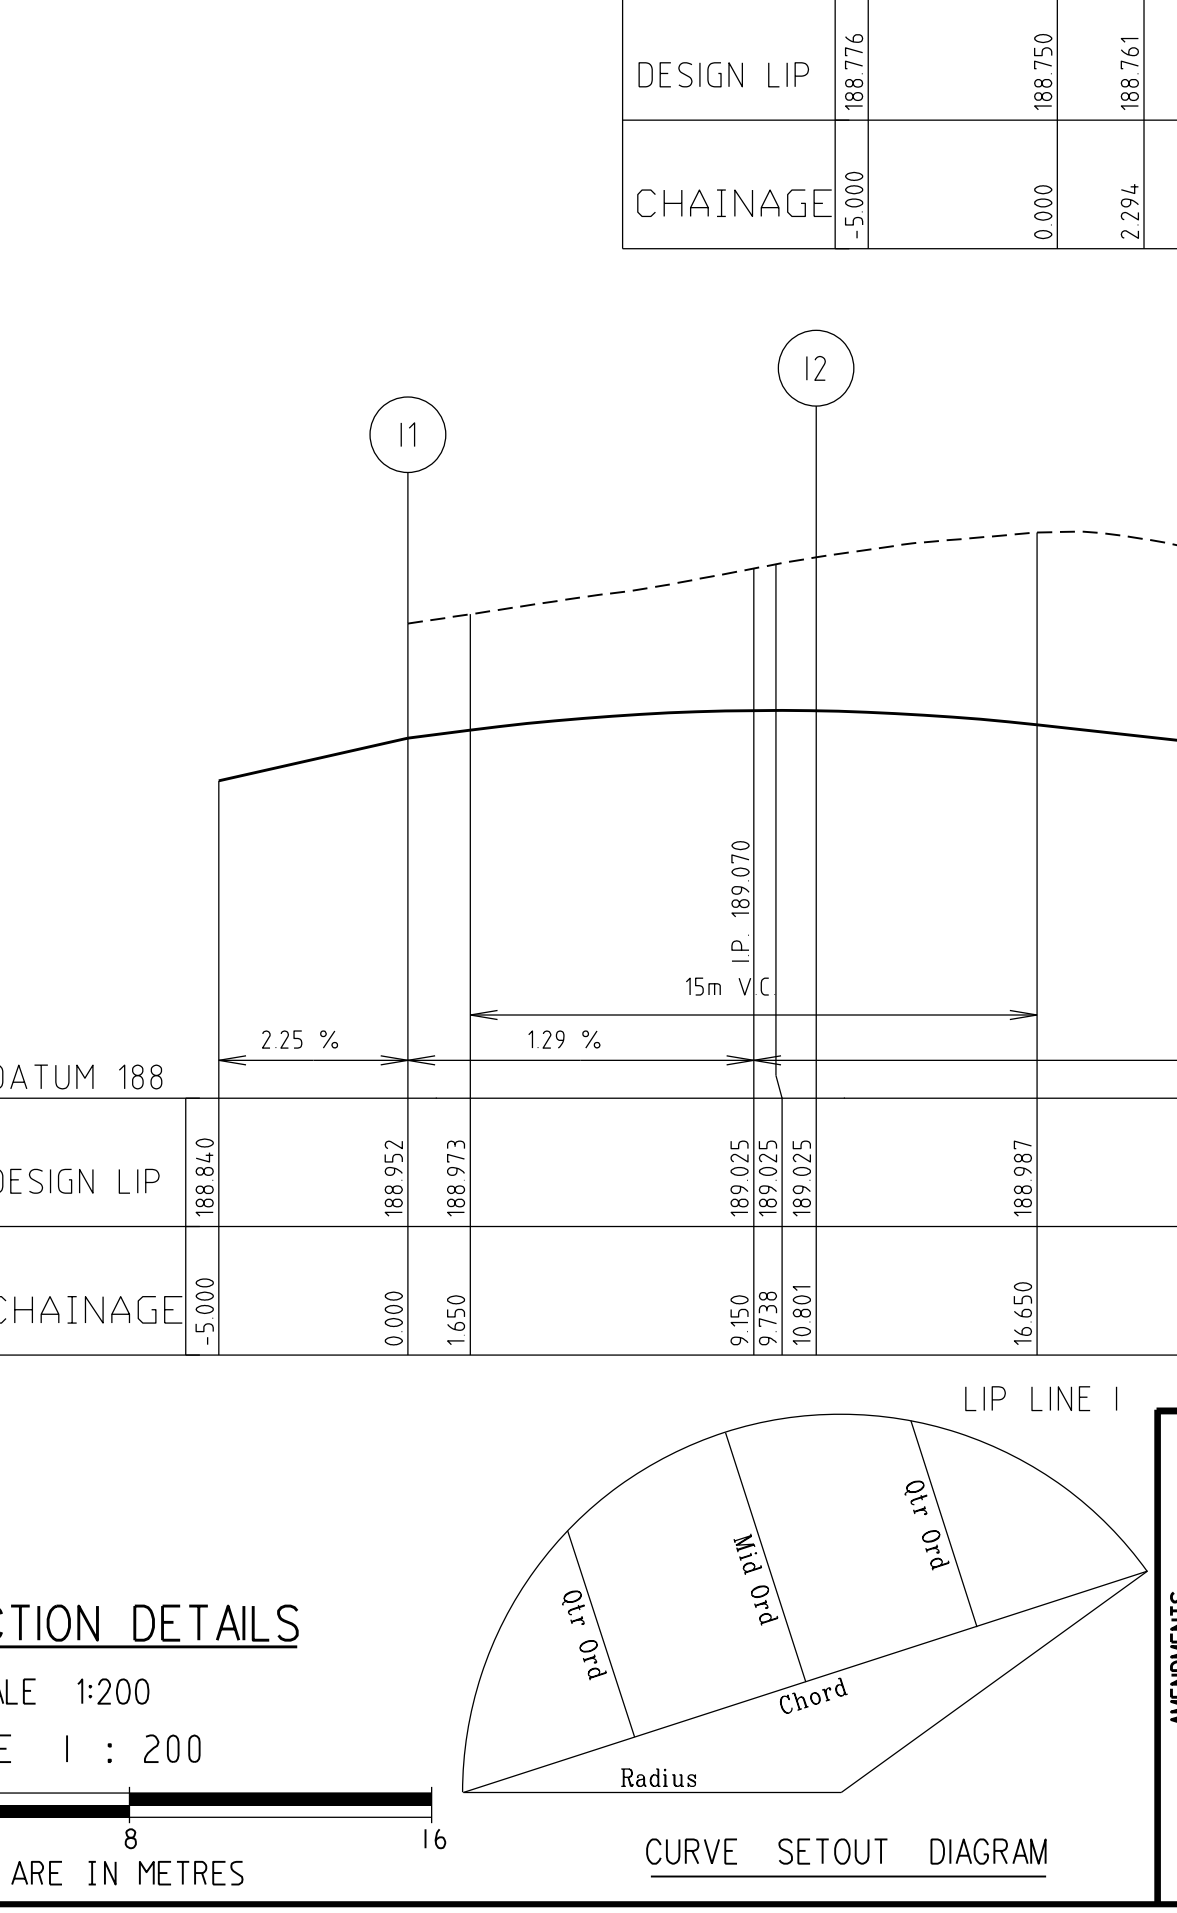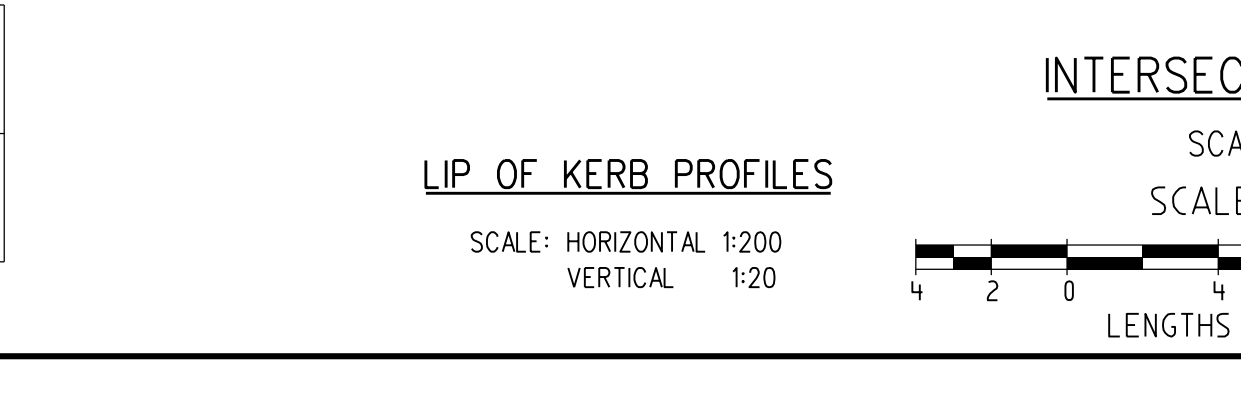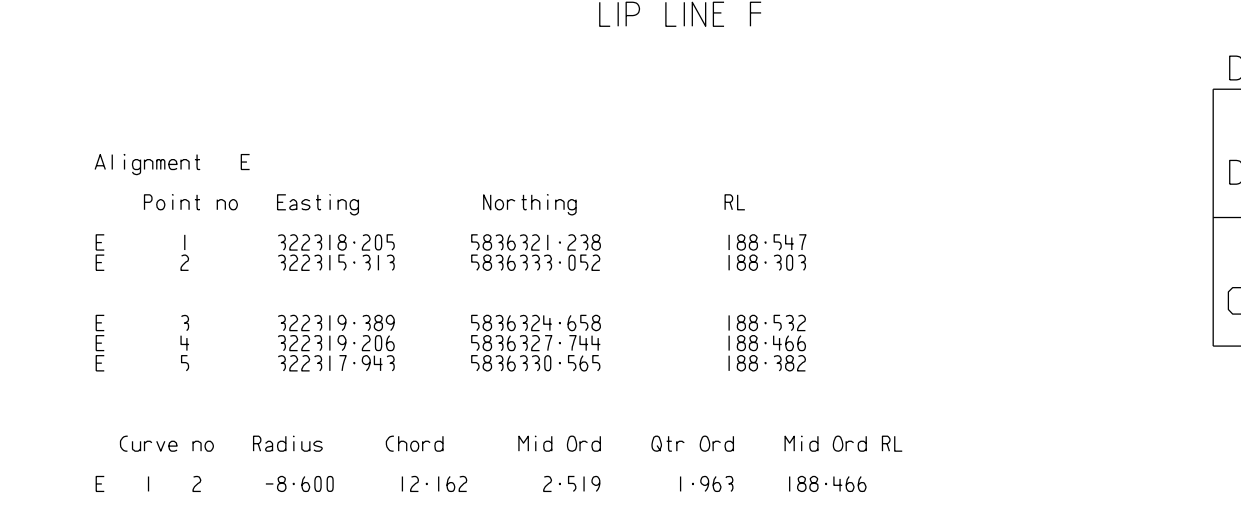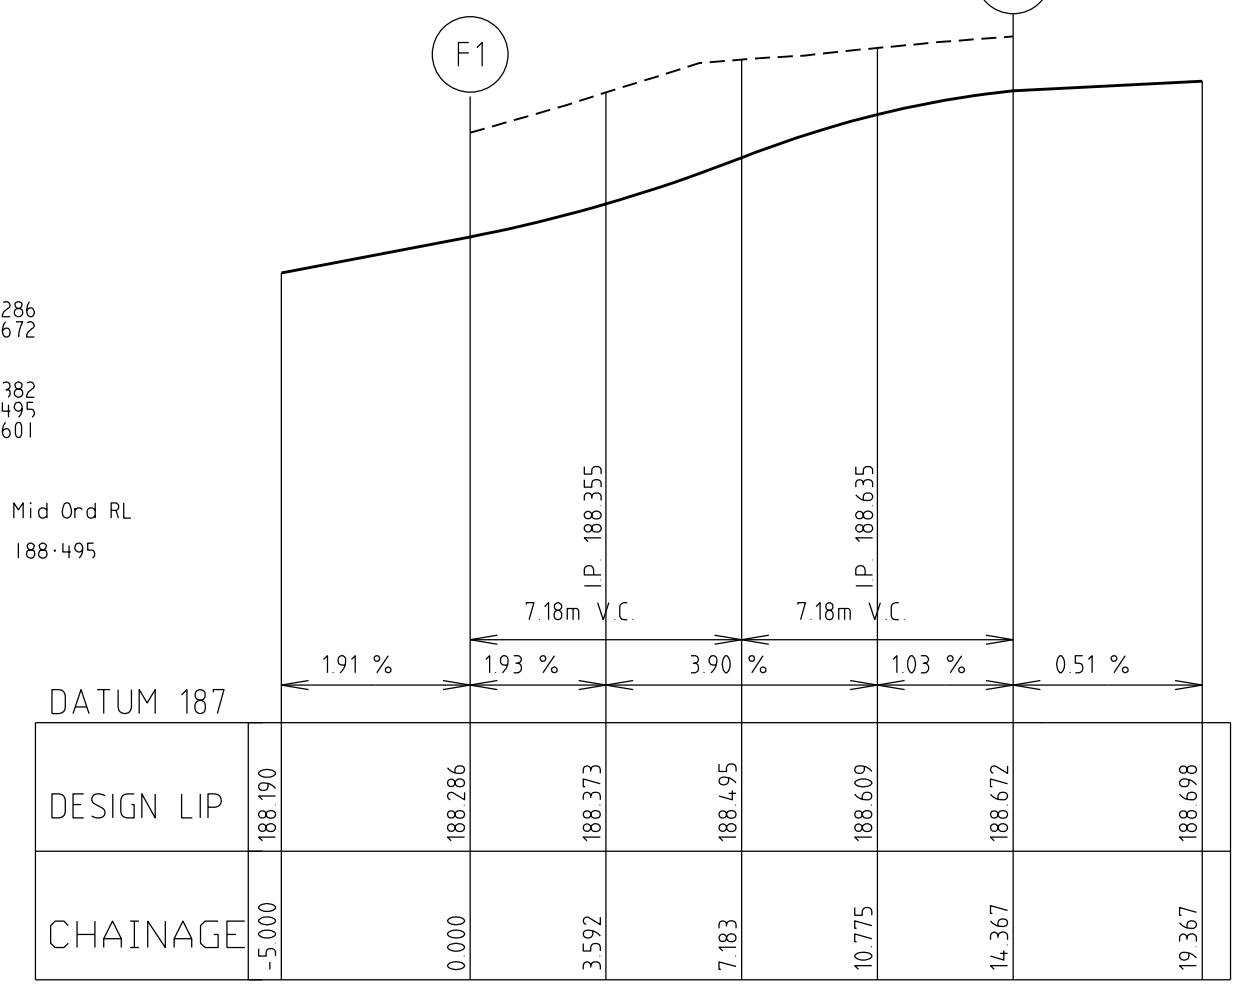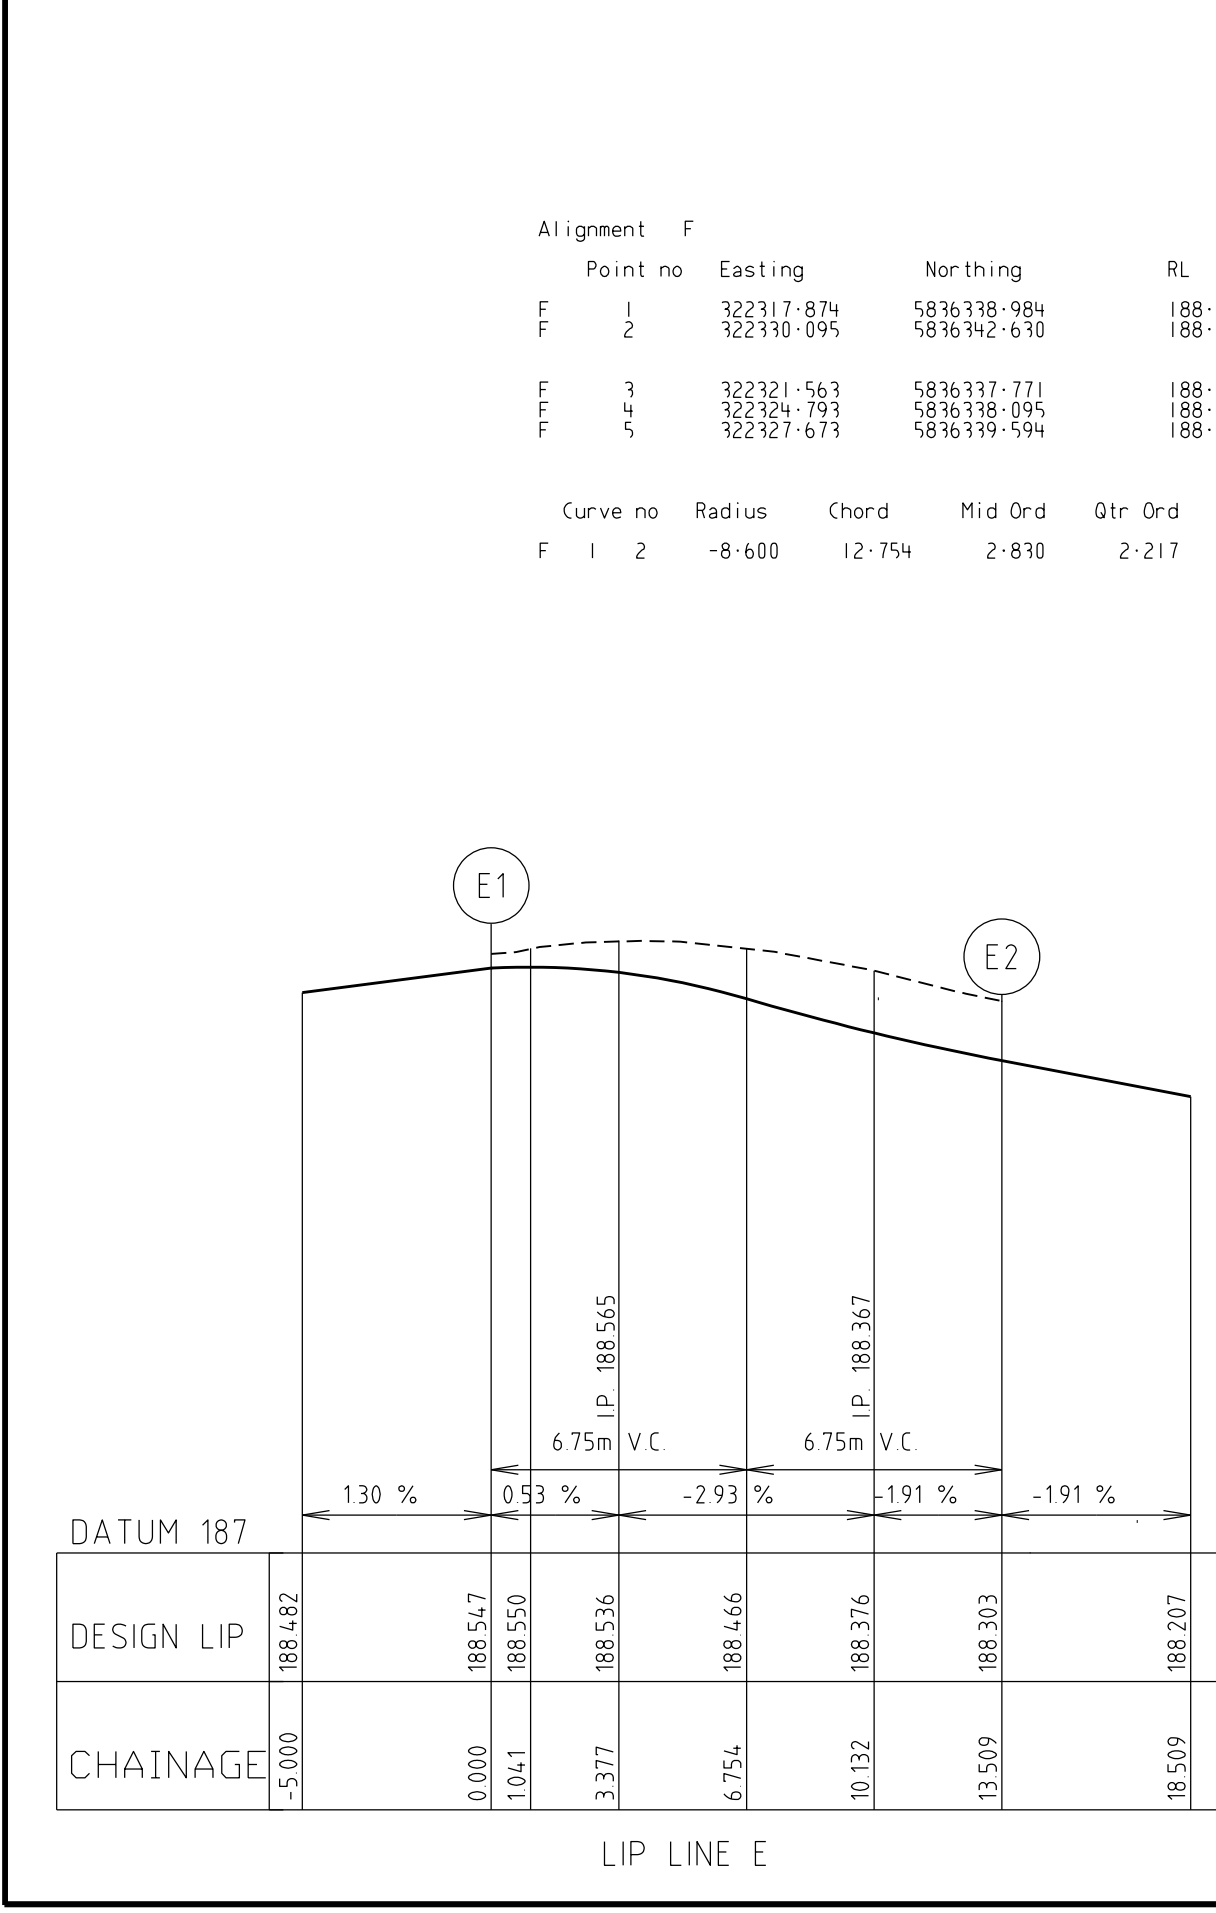


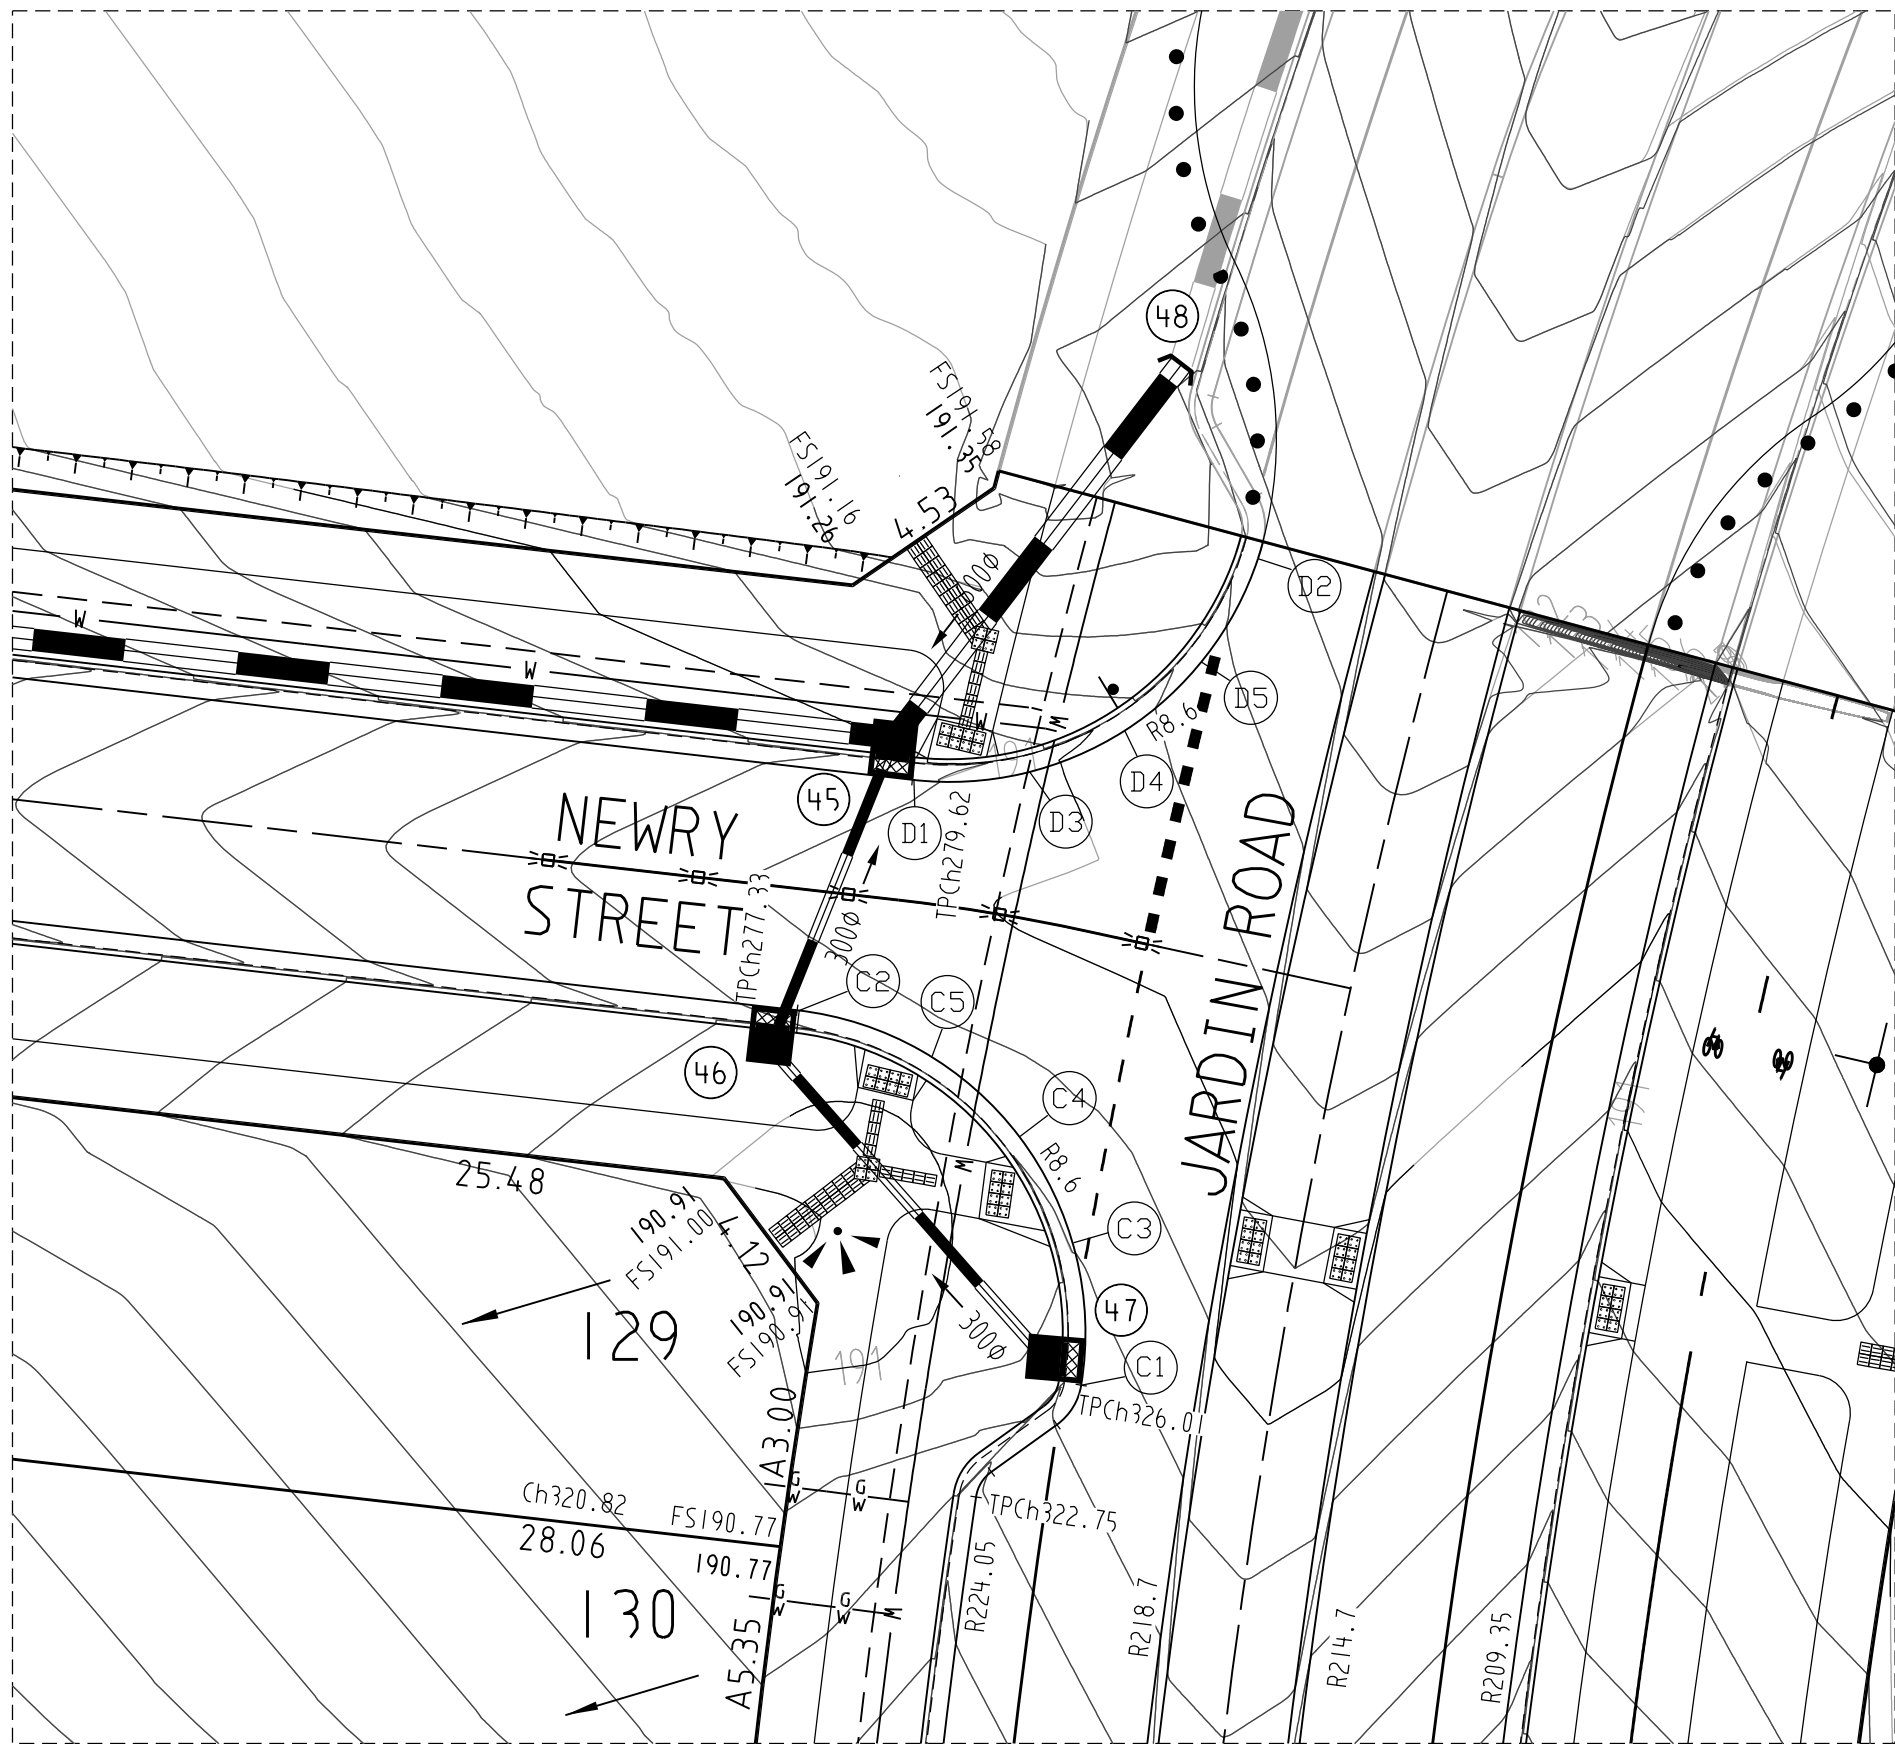

INTERSECTION JARDIN ROAD AND NEWRY STREET

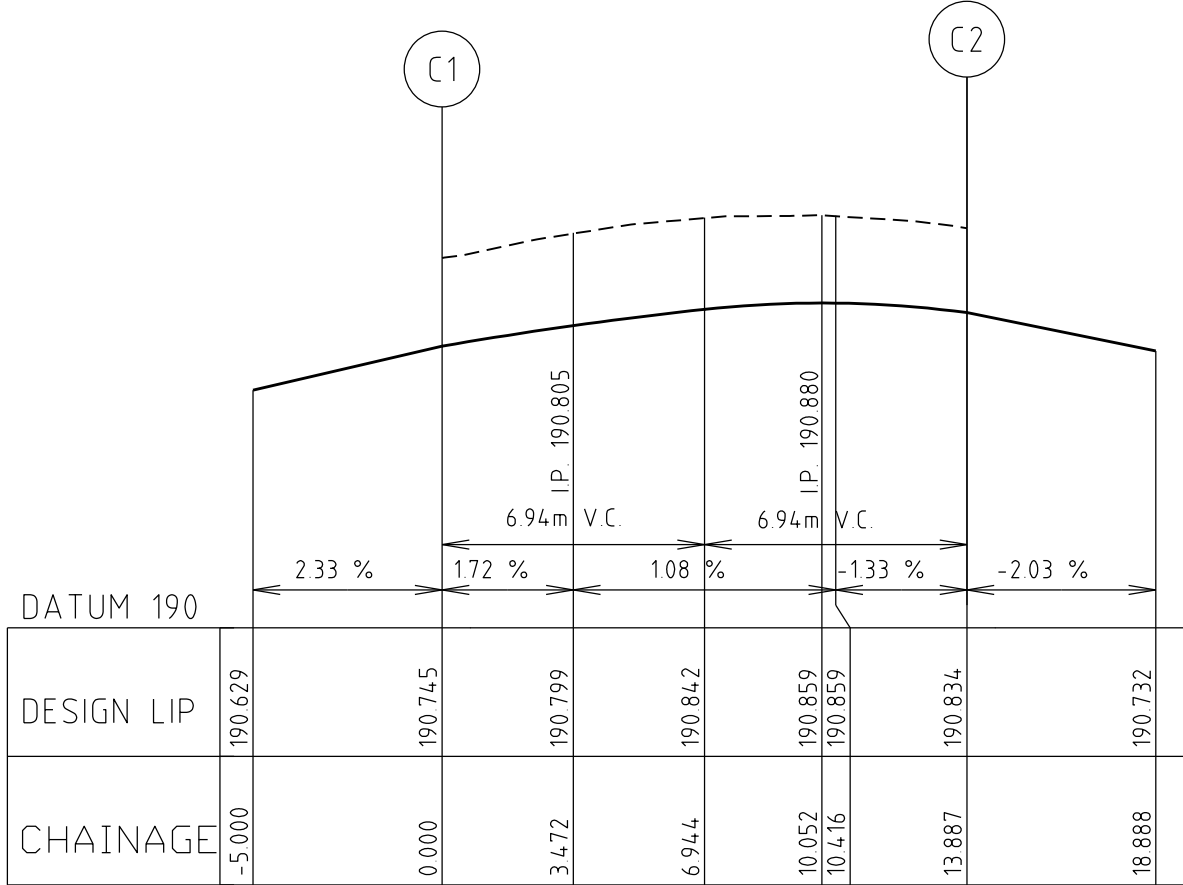

Alignment C							
	Point no	Easting	Northing	RL			
C	1	322357.449	5836490.163			190.745	
C	3	322349.985	5836500.078			190.834	
C	3	322357.239	5836493.930			190.804	
C	4	322355.832	5836496.746			190.843	
C	5	322353.503	5836498.862			190.859	
	Curve no	Radius	Chord	Mid Ord	Qtr Ord	Mid Ord RL	
C	1	2	-8.550	12.374	2.649	2.070	190.843

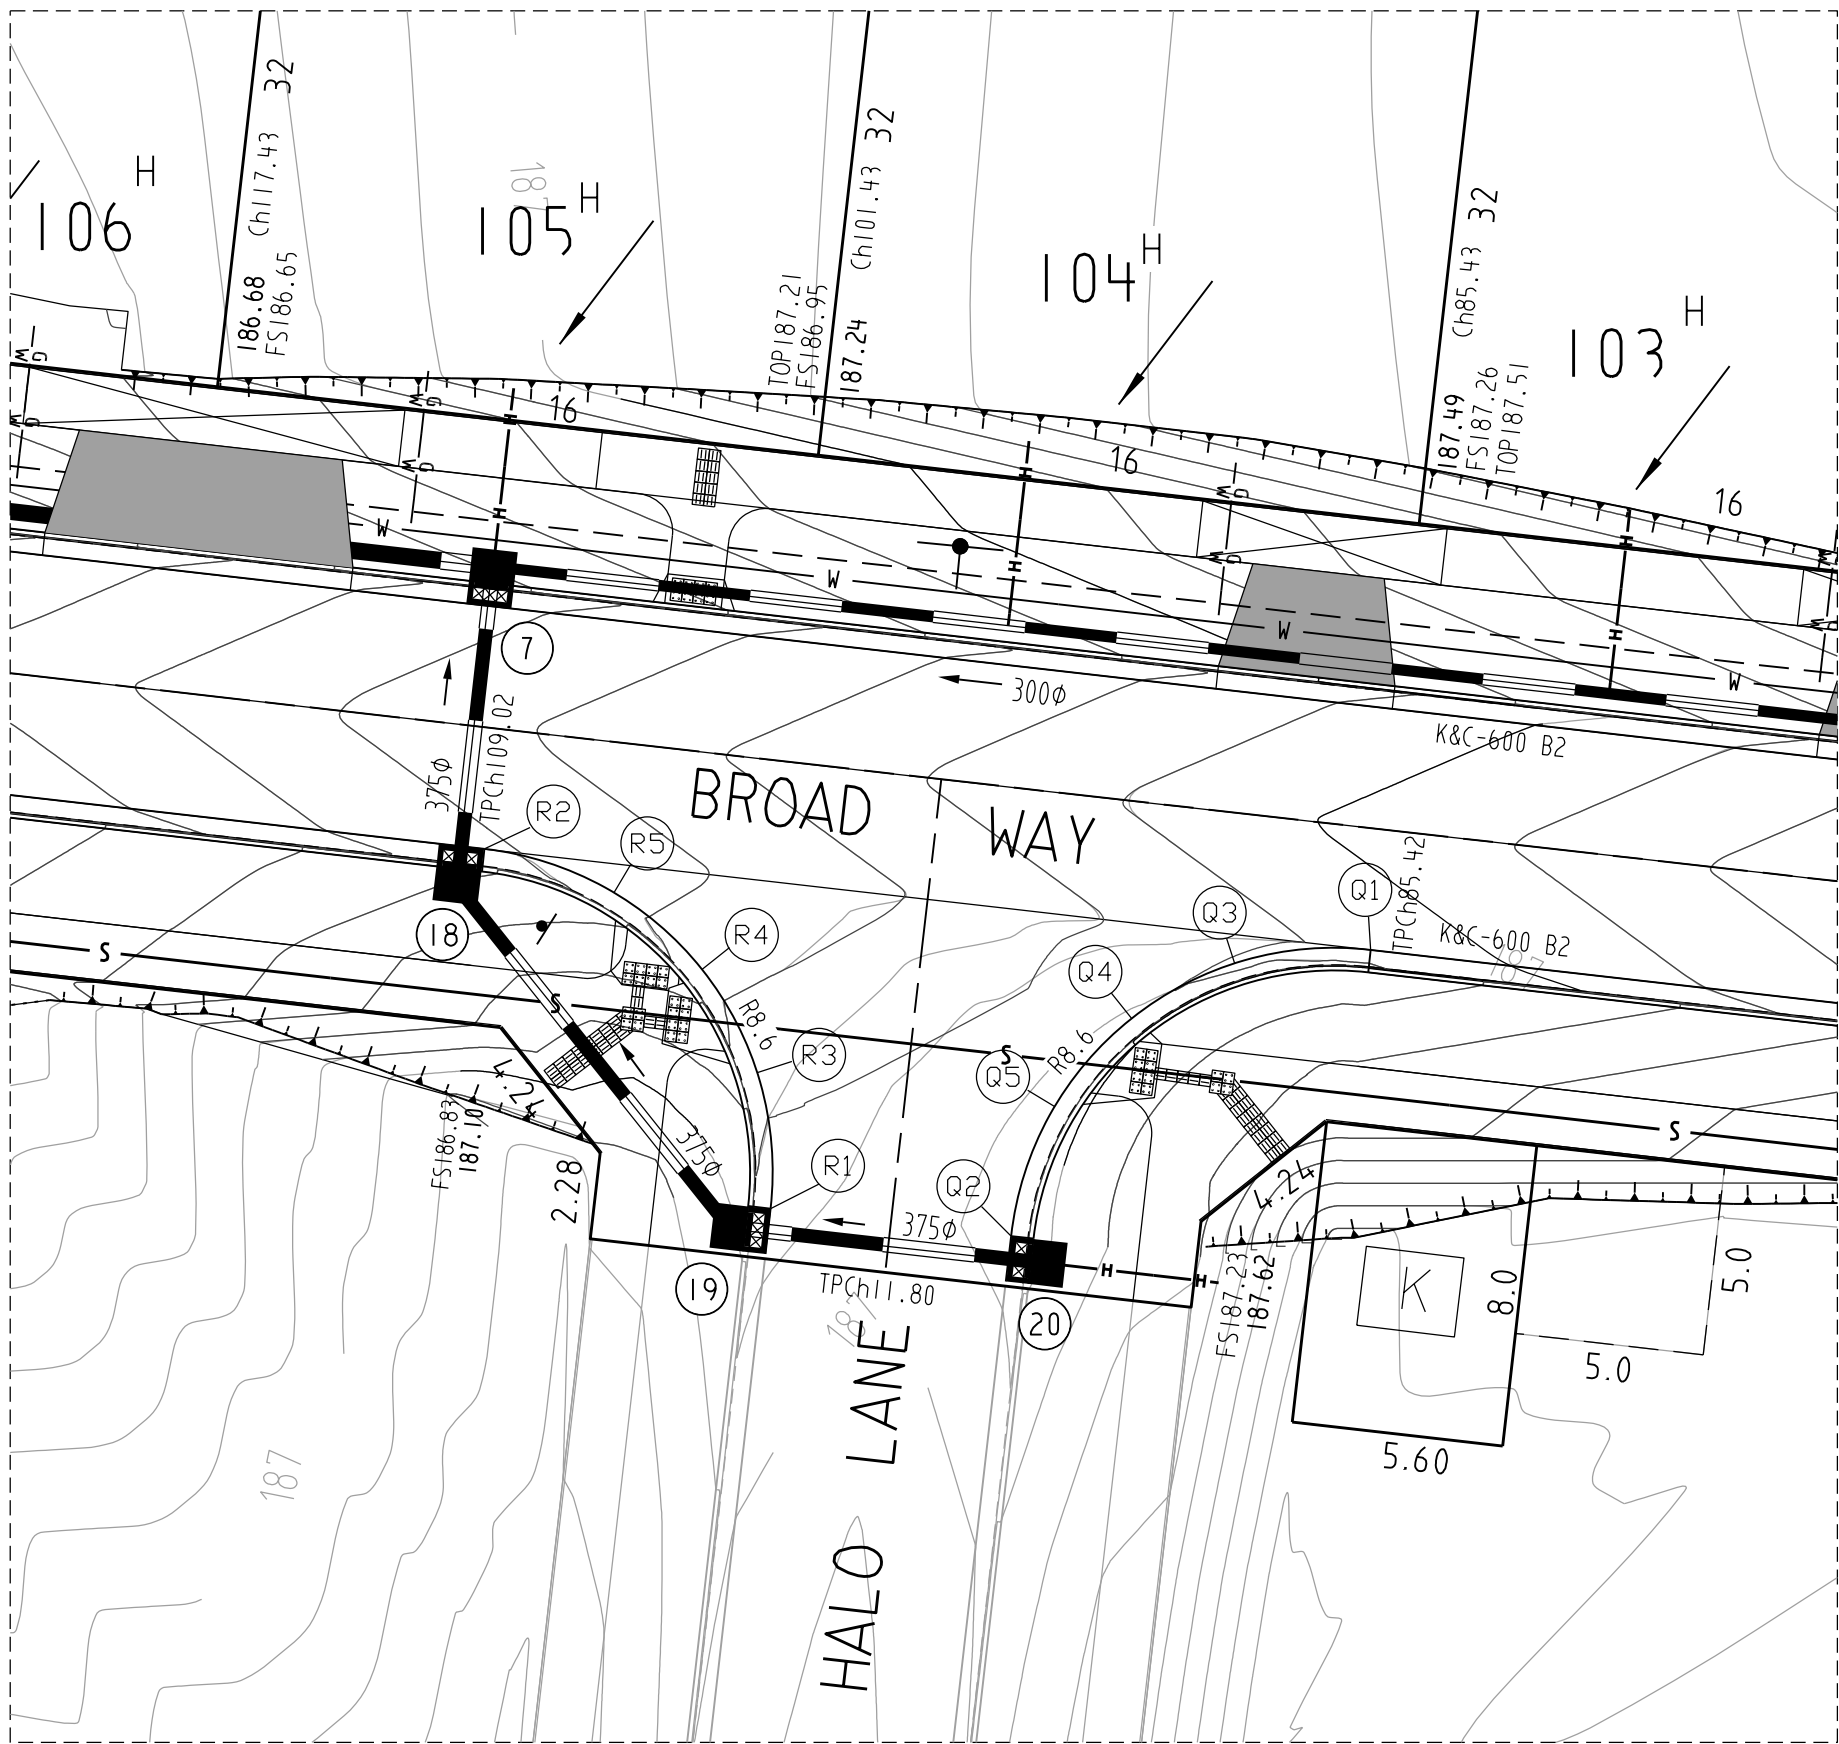


INTERSECTION BROAD WAY AND HALO LANE

Alignment D						
	Point no	Easting	Northing		RL	
D	1	322352.984	5836506.178		190.880	
D	2	322362.110	5836511.994		191.264	
D	3	322356.093	5836506.188		190.972	
D	4	322358.601	5836507.469		191.065	
D	5	322360.637	5836509.292		191.161	
	Curve no	Radius	Chord	Mid Ord	Qtr Ord	Mid Ord RL
D	1	2	-8.550	10.792	1.918	1.481
						191.065


AS CONSTRUCTED

Alignment Q							
	Point no	Easting	Northing	RL			
Q	1	322247.019	5836346.742	186.932			
Q	2	322217.501	5836319.170	186.858			
Q	3	322243.417	5836346.386	186.910			
Q	4	322240.692	5836344.927	186.892			
Q	5	322238.659	5836342.600	186.876			
	Curve no	Radius	Chord	Mid Ord	Qtr Ord	Mid Ord RL	
Q	1	2	-8.600	12.162	2.519	1.963	186.892


Alignment R							
	Point no	Easting	Northing	RL			
R	1	322231.143	5836339.894	186.858			
R	2	322223.571	5836344.412	186.461			
R	3	322230.786	5836343.496	186.766			
R	4	322229.328	5836346.221	186.665			
R	5	322227.000	5836348.255	186.567			
	Curve no	Radius	Chord	Mid Ord	Qtr Ord	Mid Ord RL	
R	1	2	-8.600	12.162	2.519	1.963	186.665

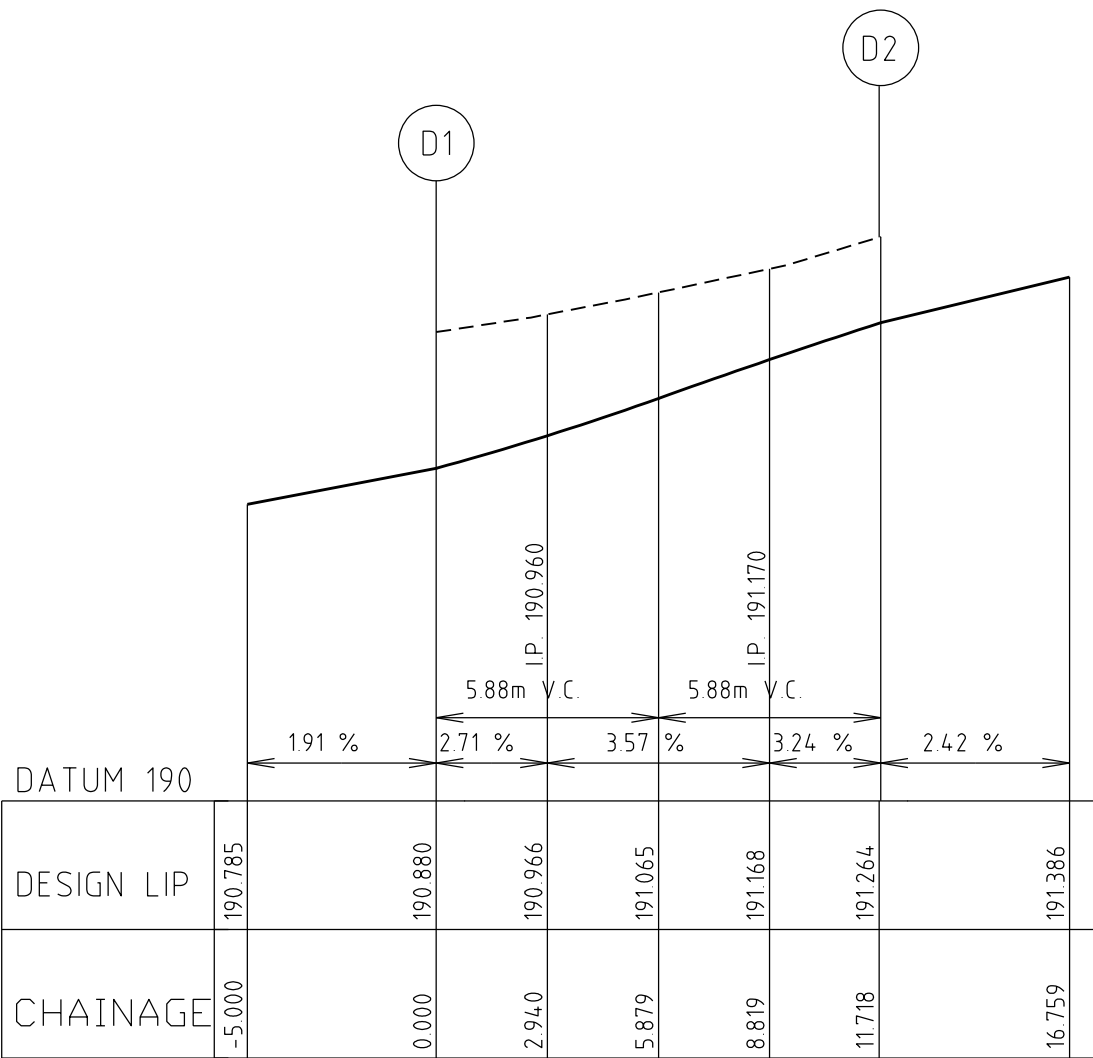

LIP LINE D

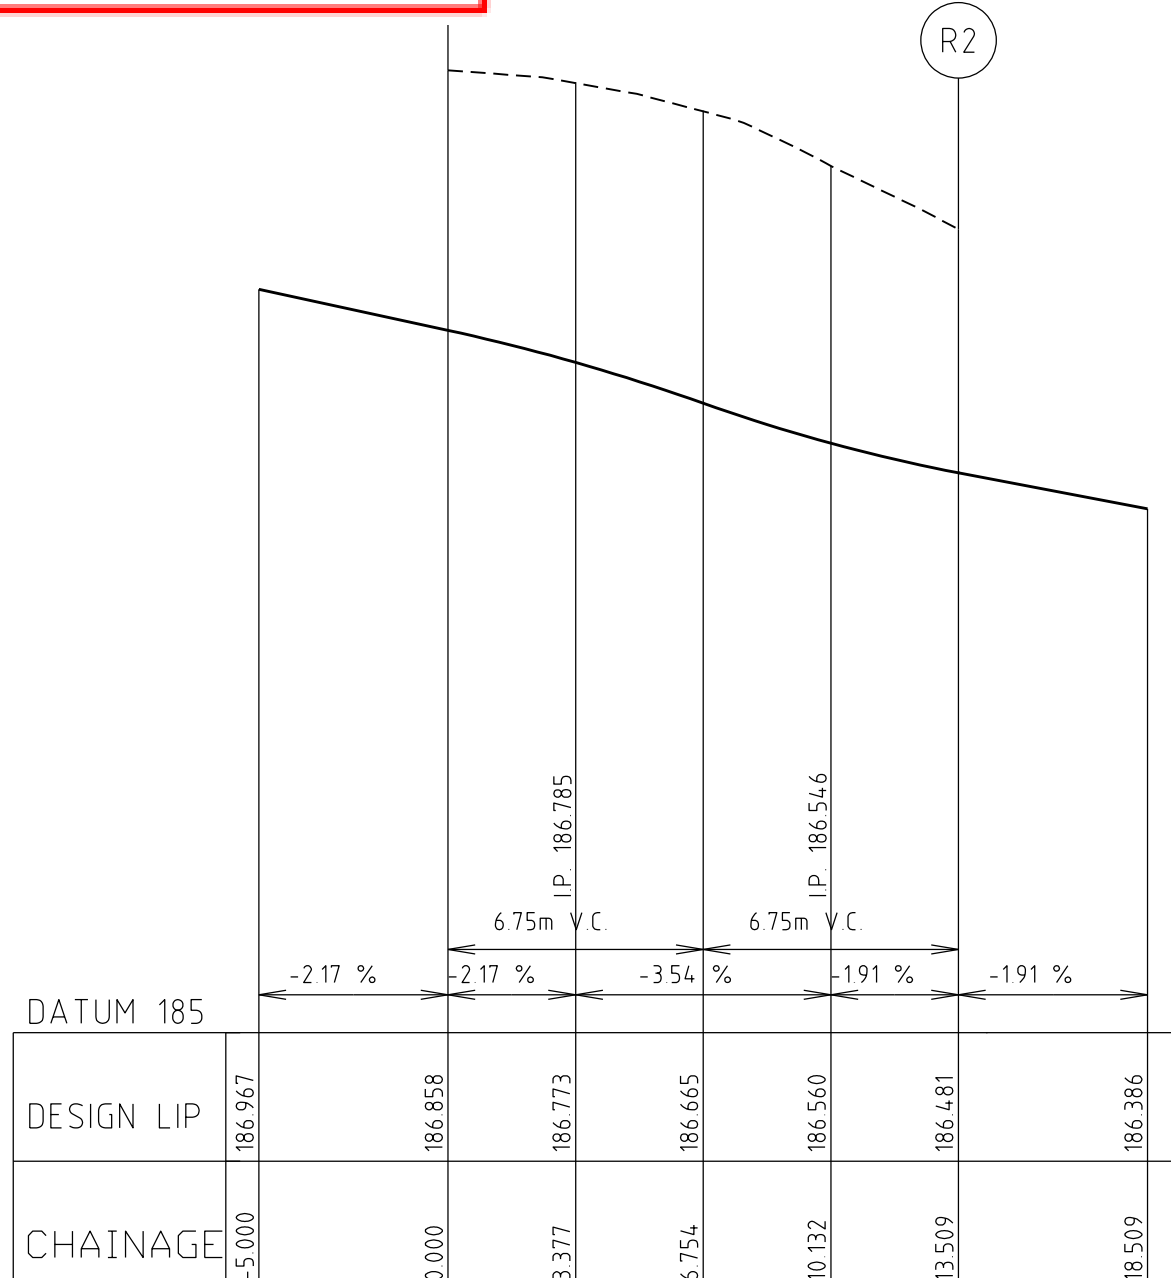

LIP LINE R

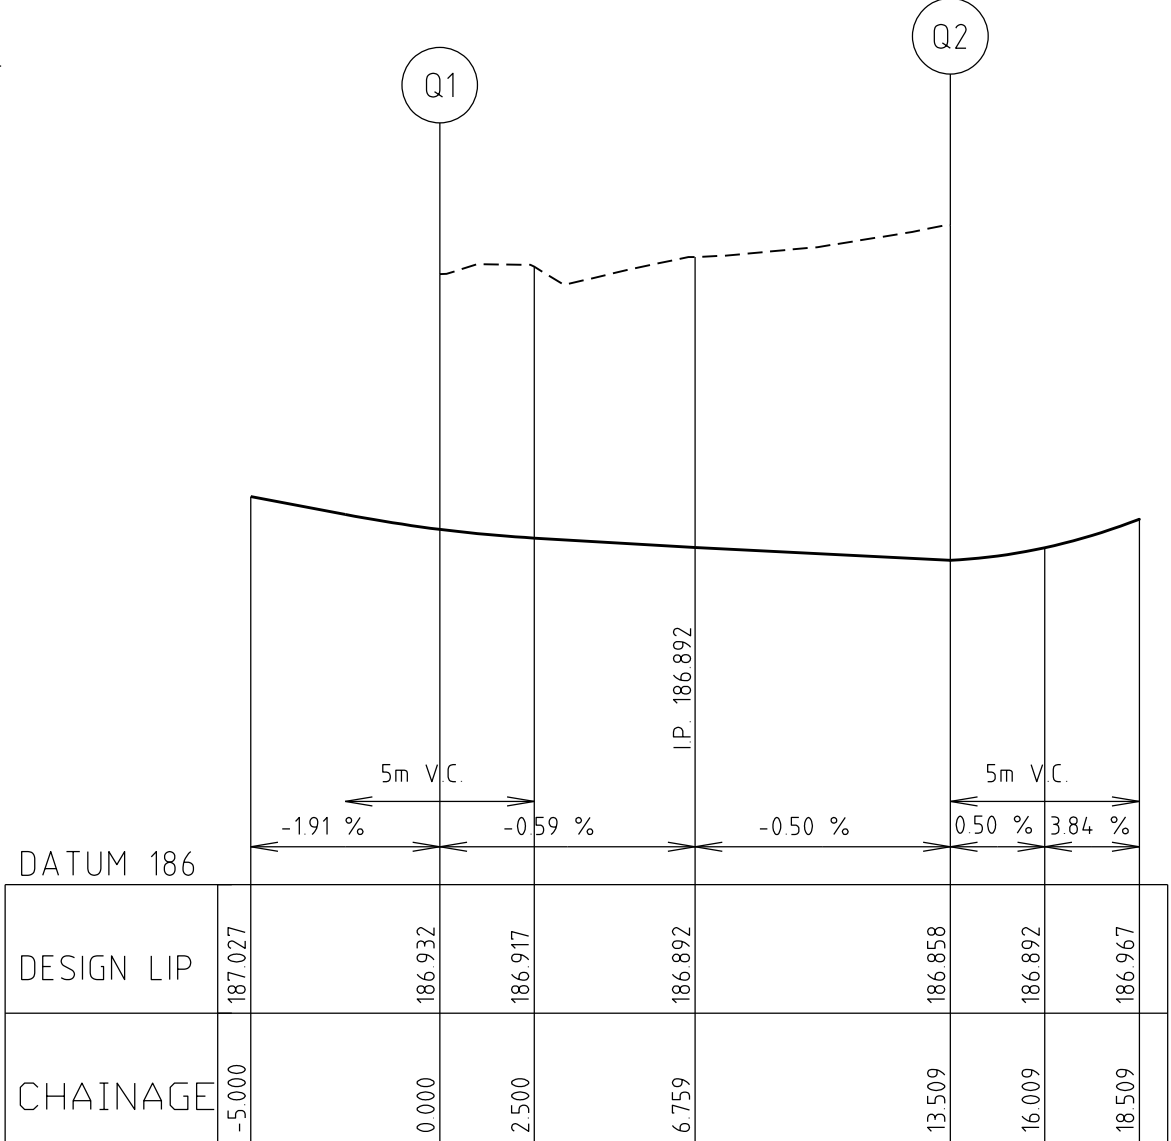

LIP LINE Q


LIP OF KERB PROFILES

SCALE: HORIZONTAL 1:200
VERTICAL 1:20

INTERSECTION DETAILS











SCALE 1:200

SCALE 1 : 200

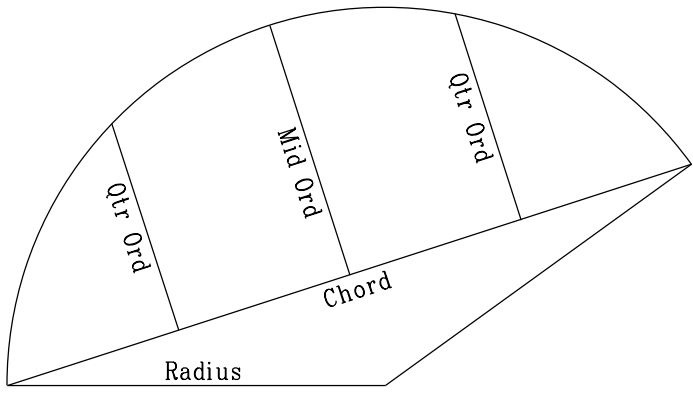


CURVE SETOUT DIAGRAM

AMENDMENTS		bpd		breese pitt dixon pty. ltd. land surveyors civil engineers		1/19 coto street hawthorn east, 3123 telephone 8823 2300 fax no. 8823 2310			
B 13.02.19		TGS1's UPDATED		MELWAY REF. 388-C-10		RATHDOWNE ESTATE STAGE 1 INTERSECTION DETAILS		MUNICIPALITY WHITTLESEA	
A 19.12.17		ISSUED FOR CONSTRUCTION		SURVEY SPIRE		DESIGN SS		REFERENCE 9365 E/I	
VER		DATE		REMARKS		DRAWN SS		SHEET 5 OF 19	
CHECKED		DATE		REMARKS		SCALE AS SHOWN		DATUM AHD	
DATE		DATE		DATE		DATE		DATE	
DATE		DATE		DATE		DATE		DATE	

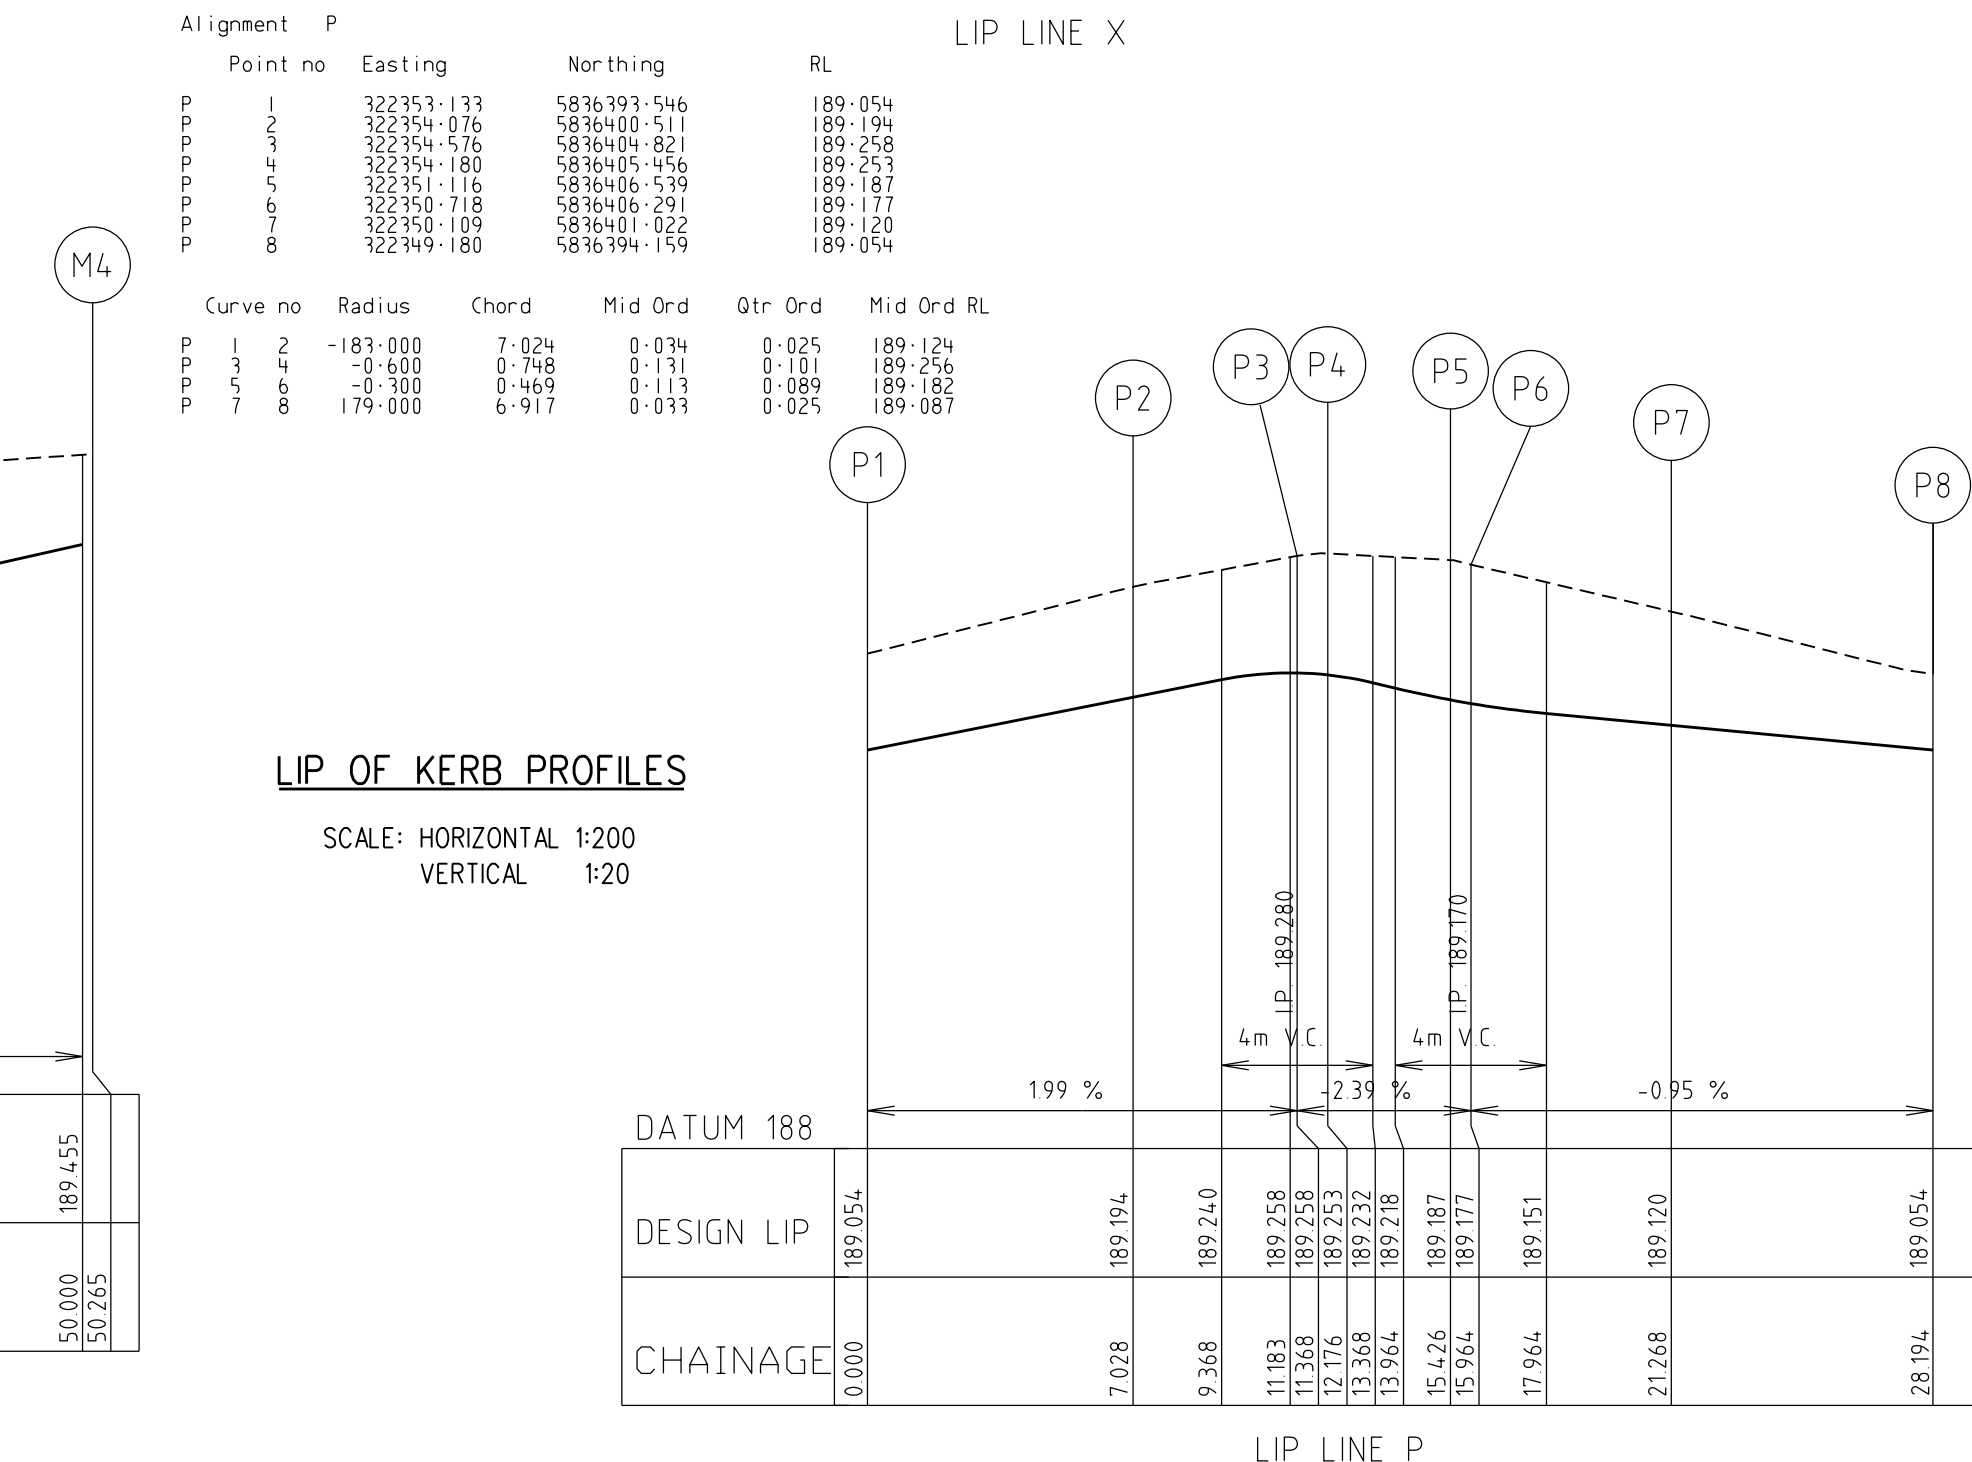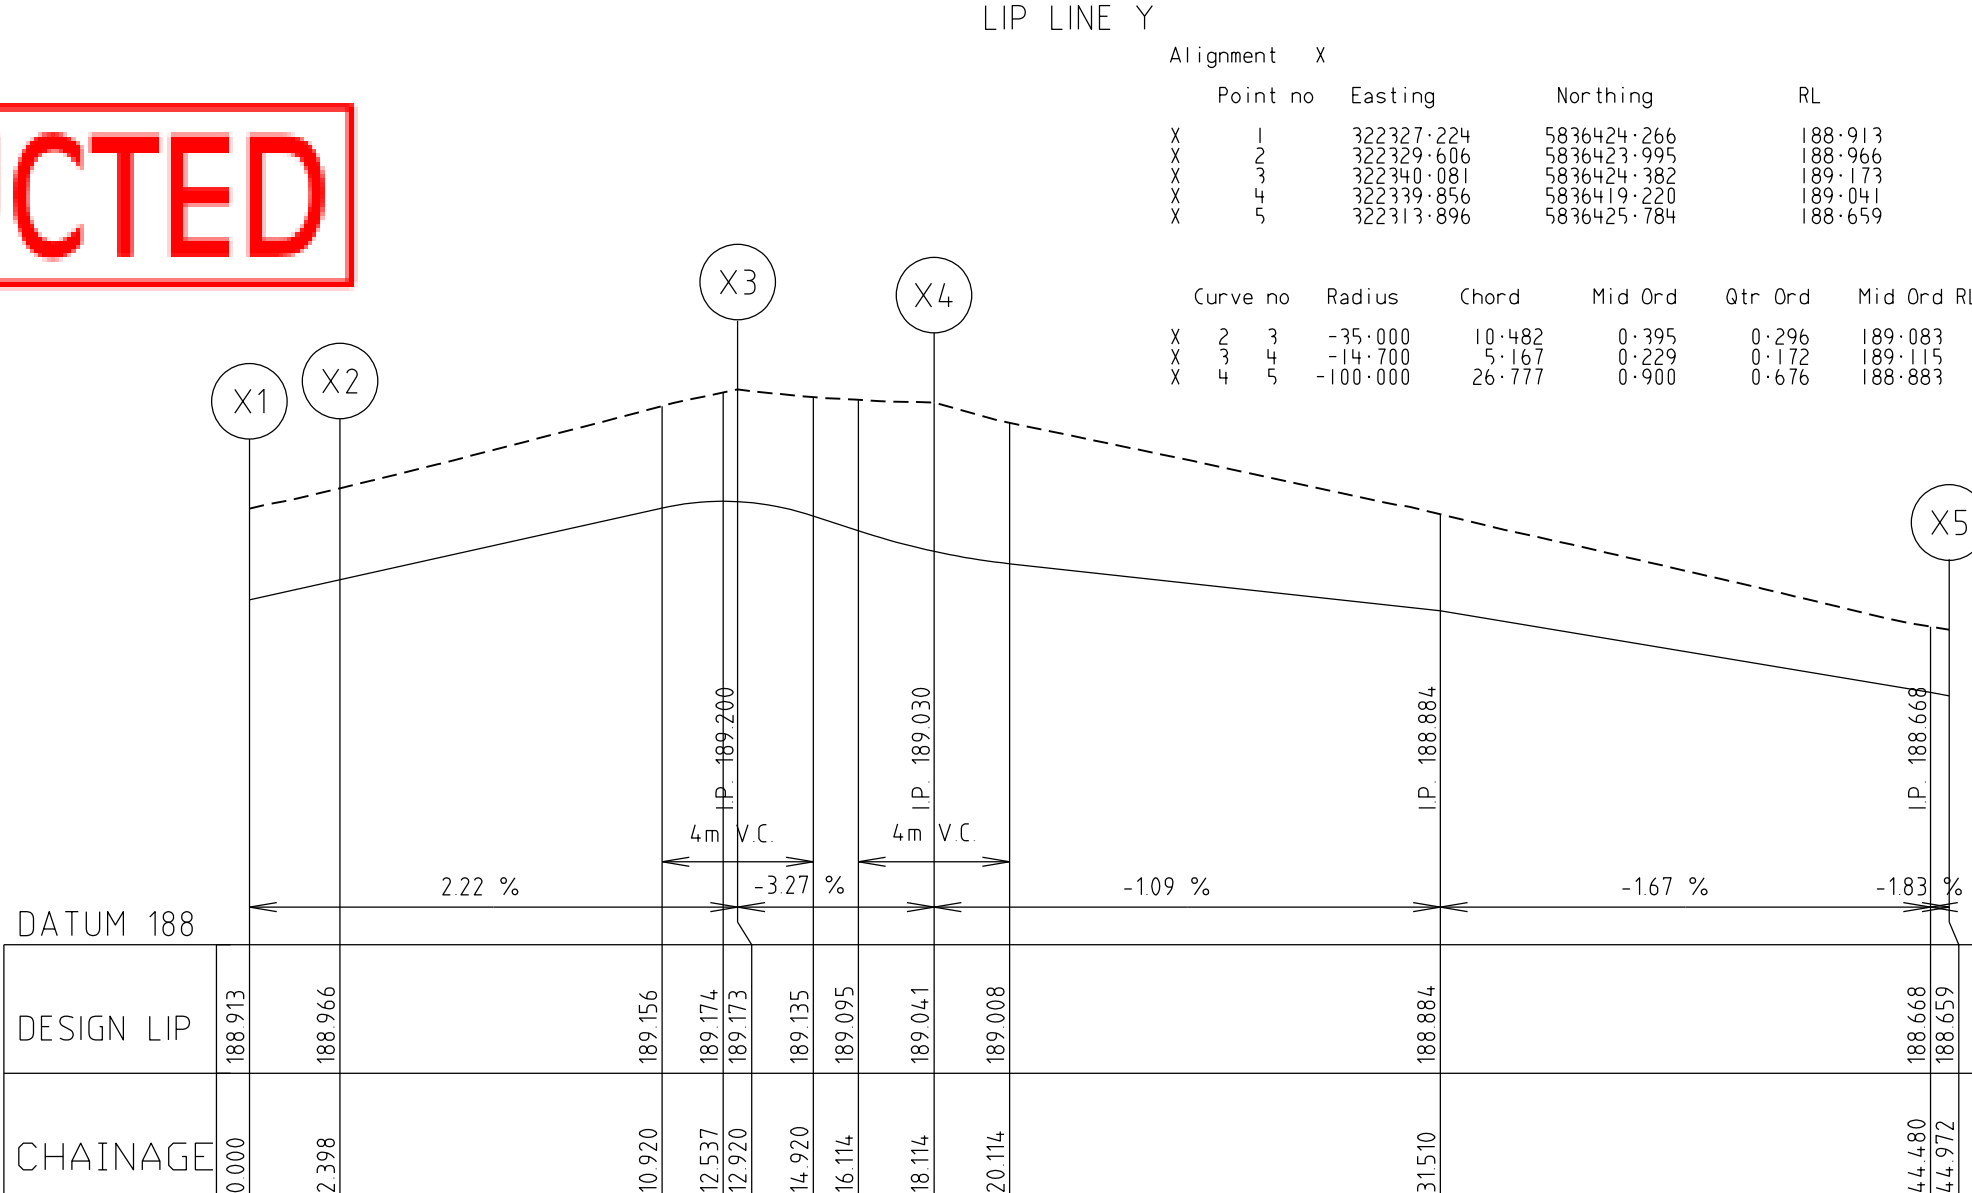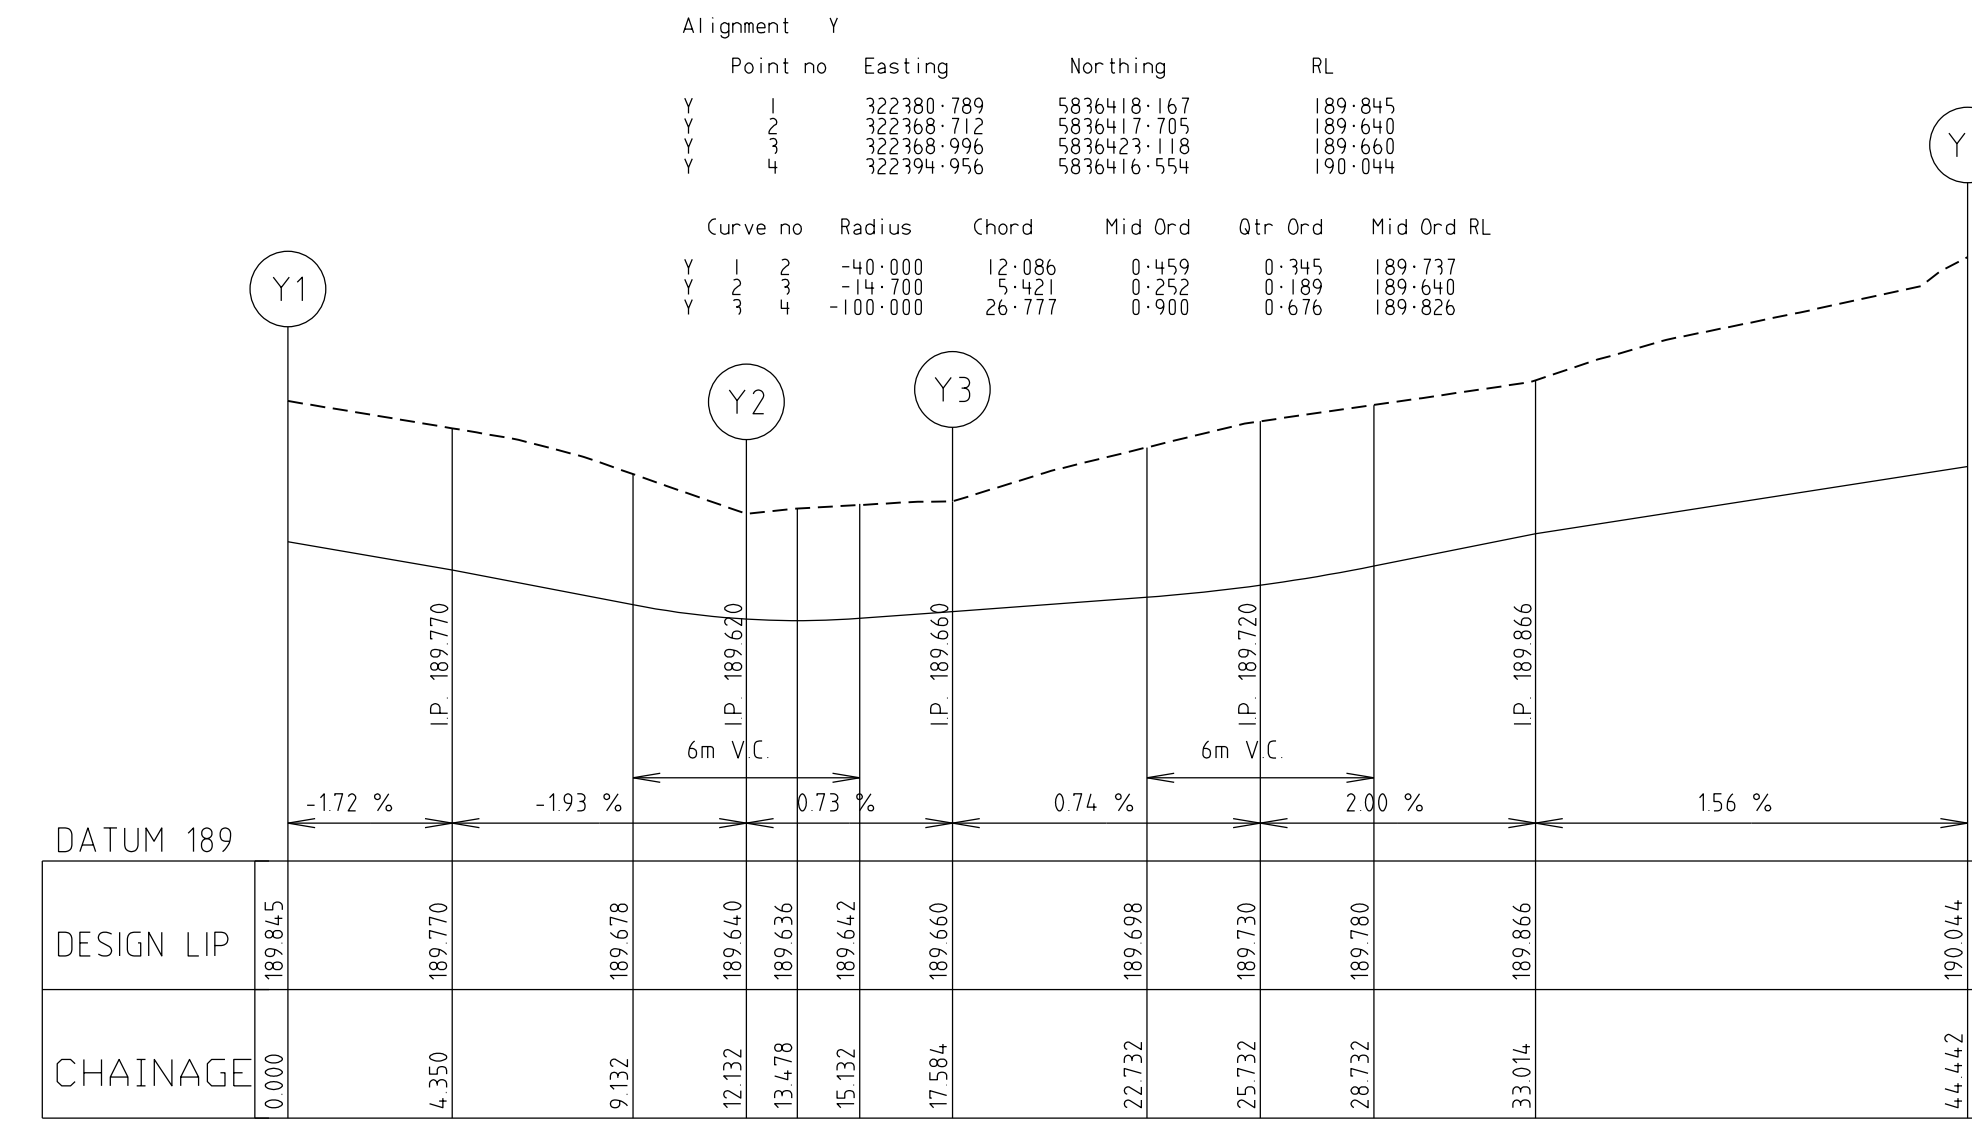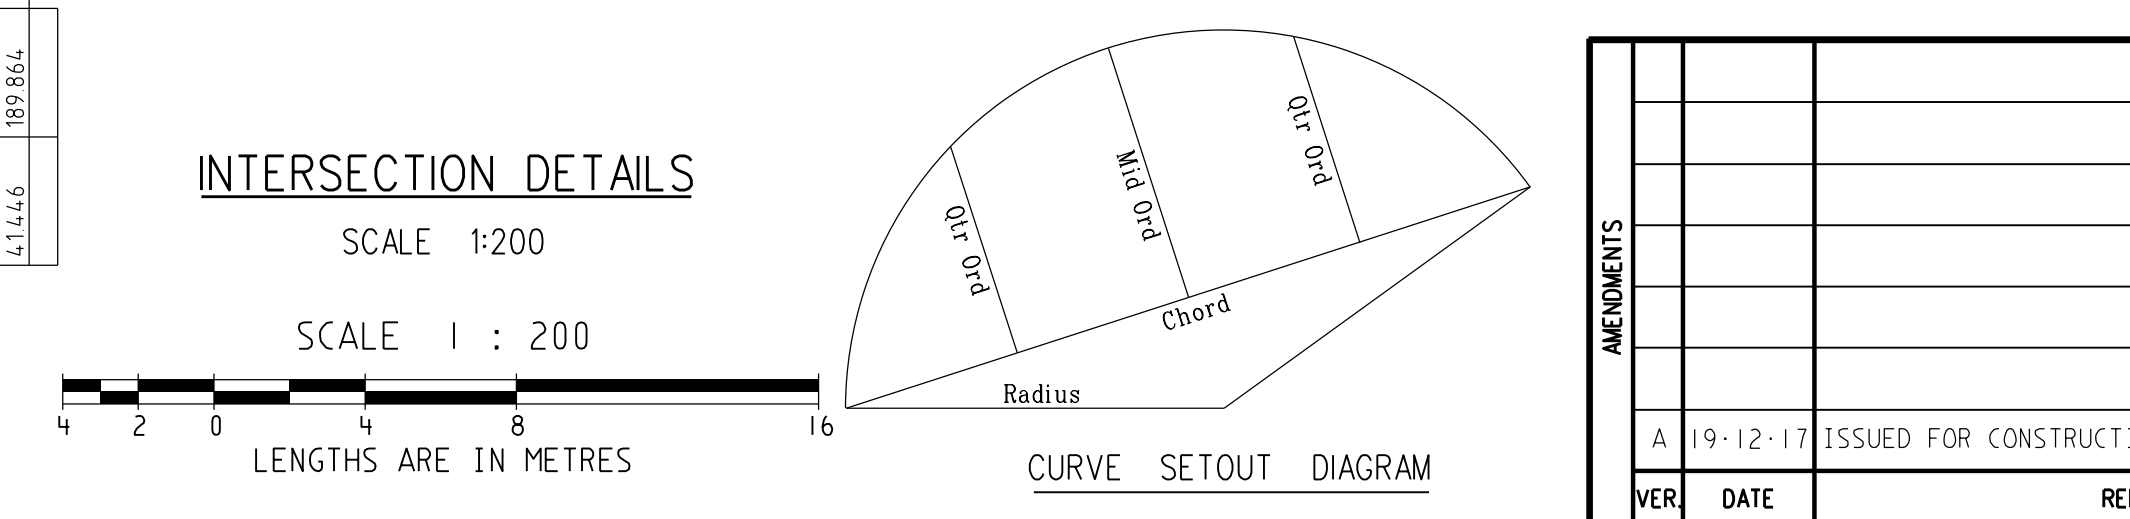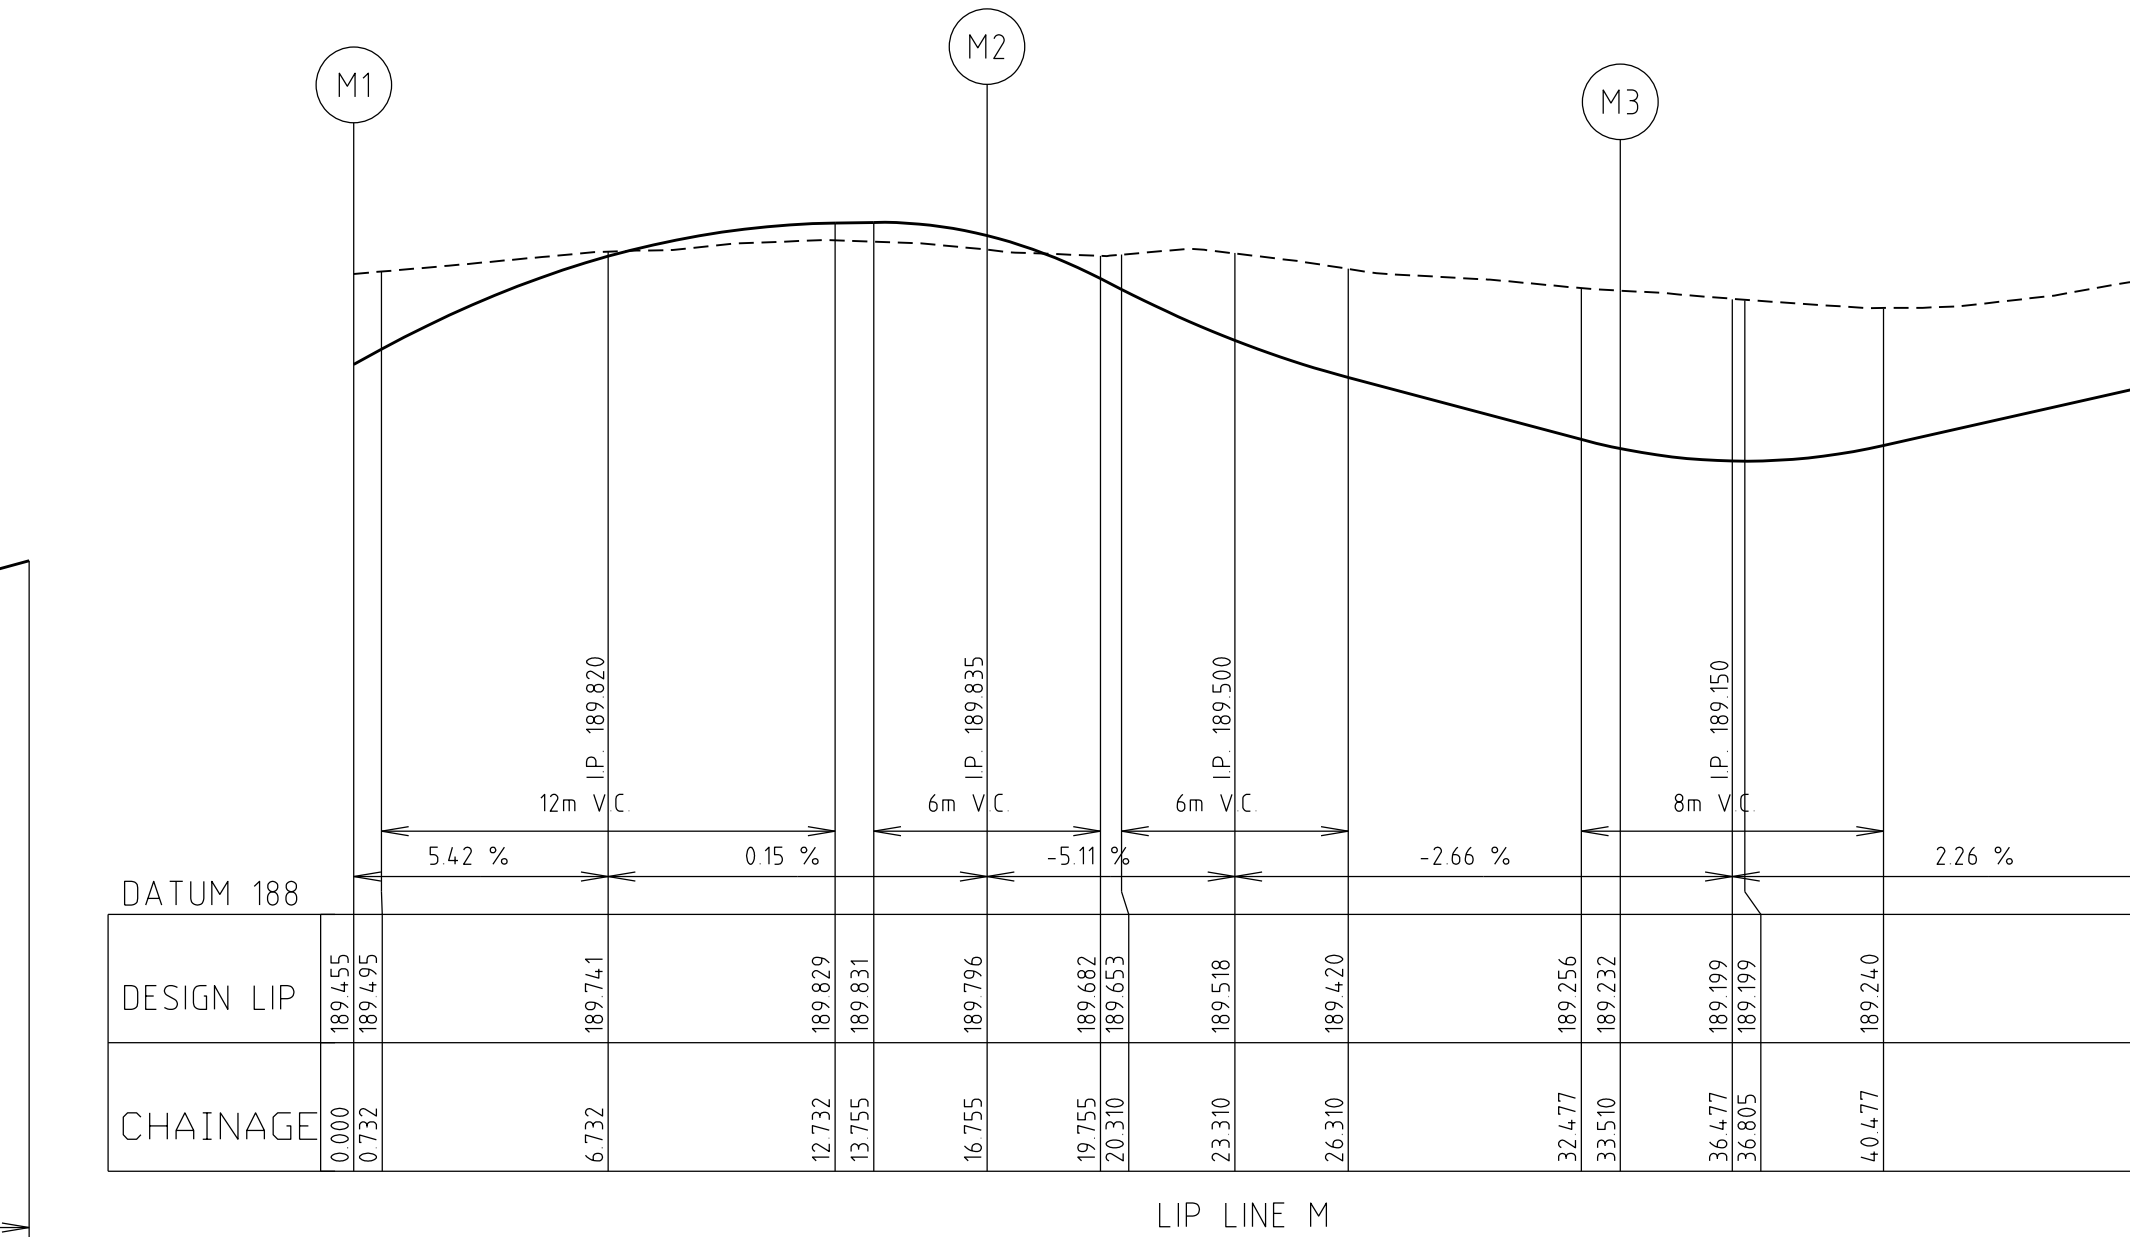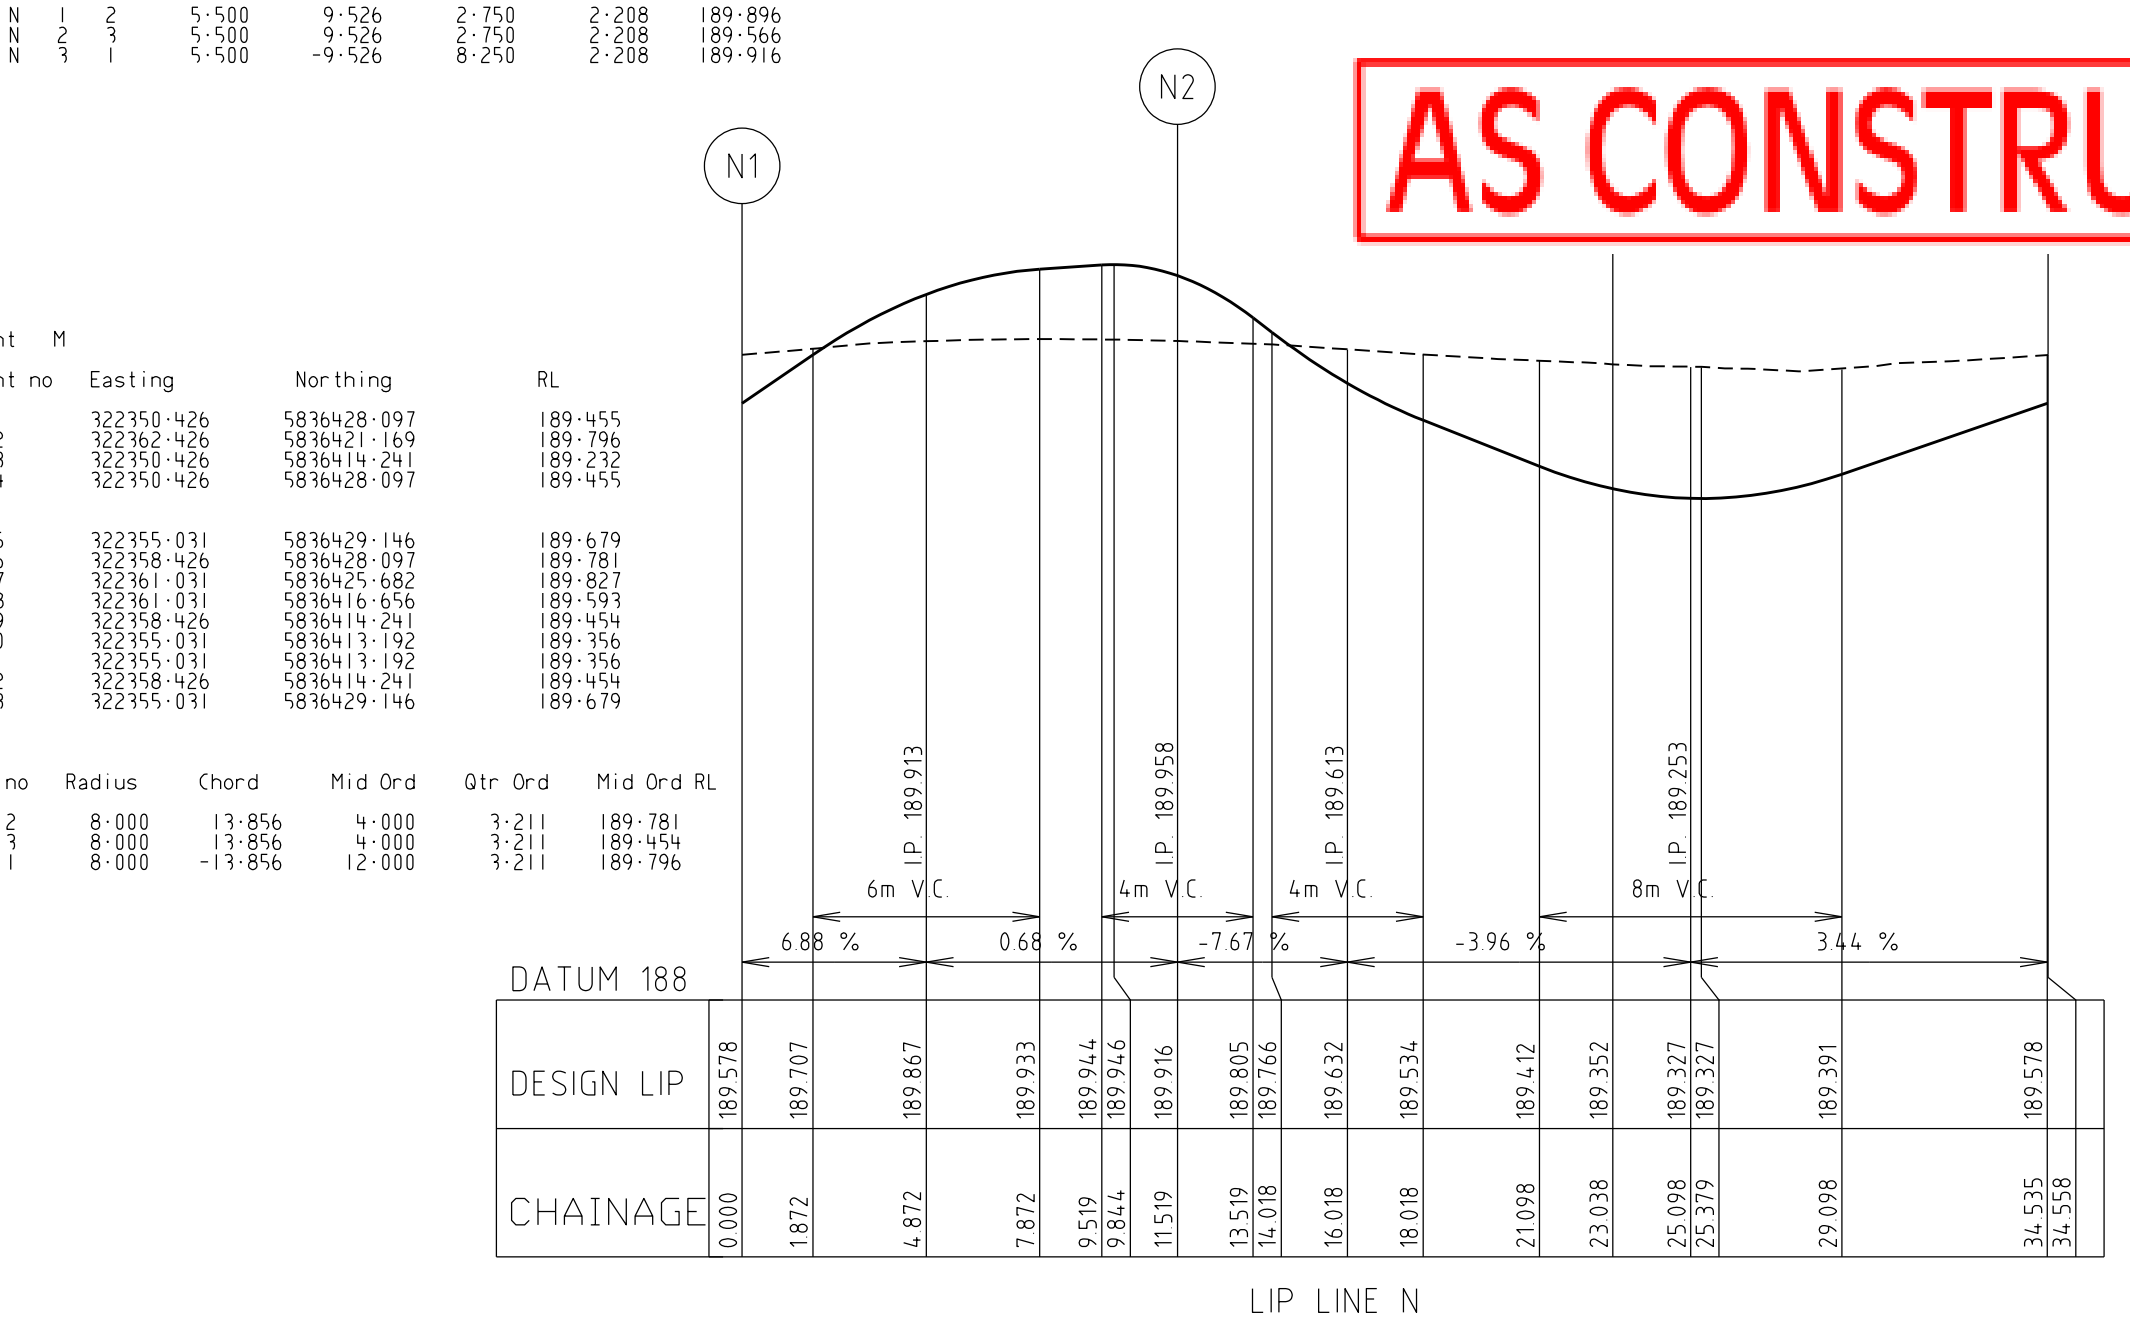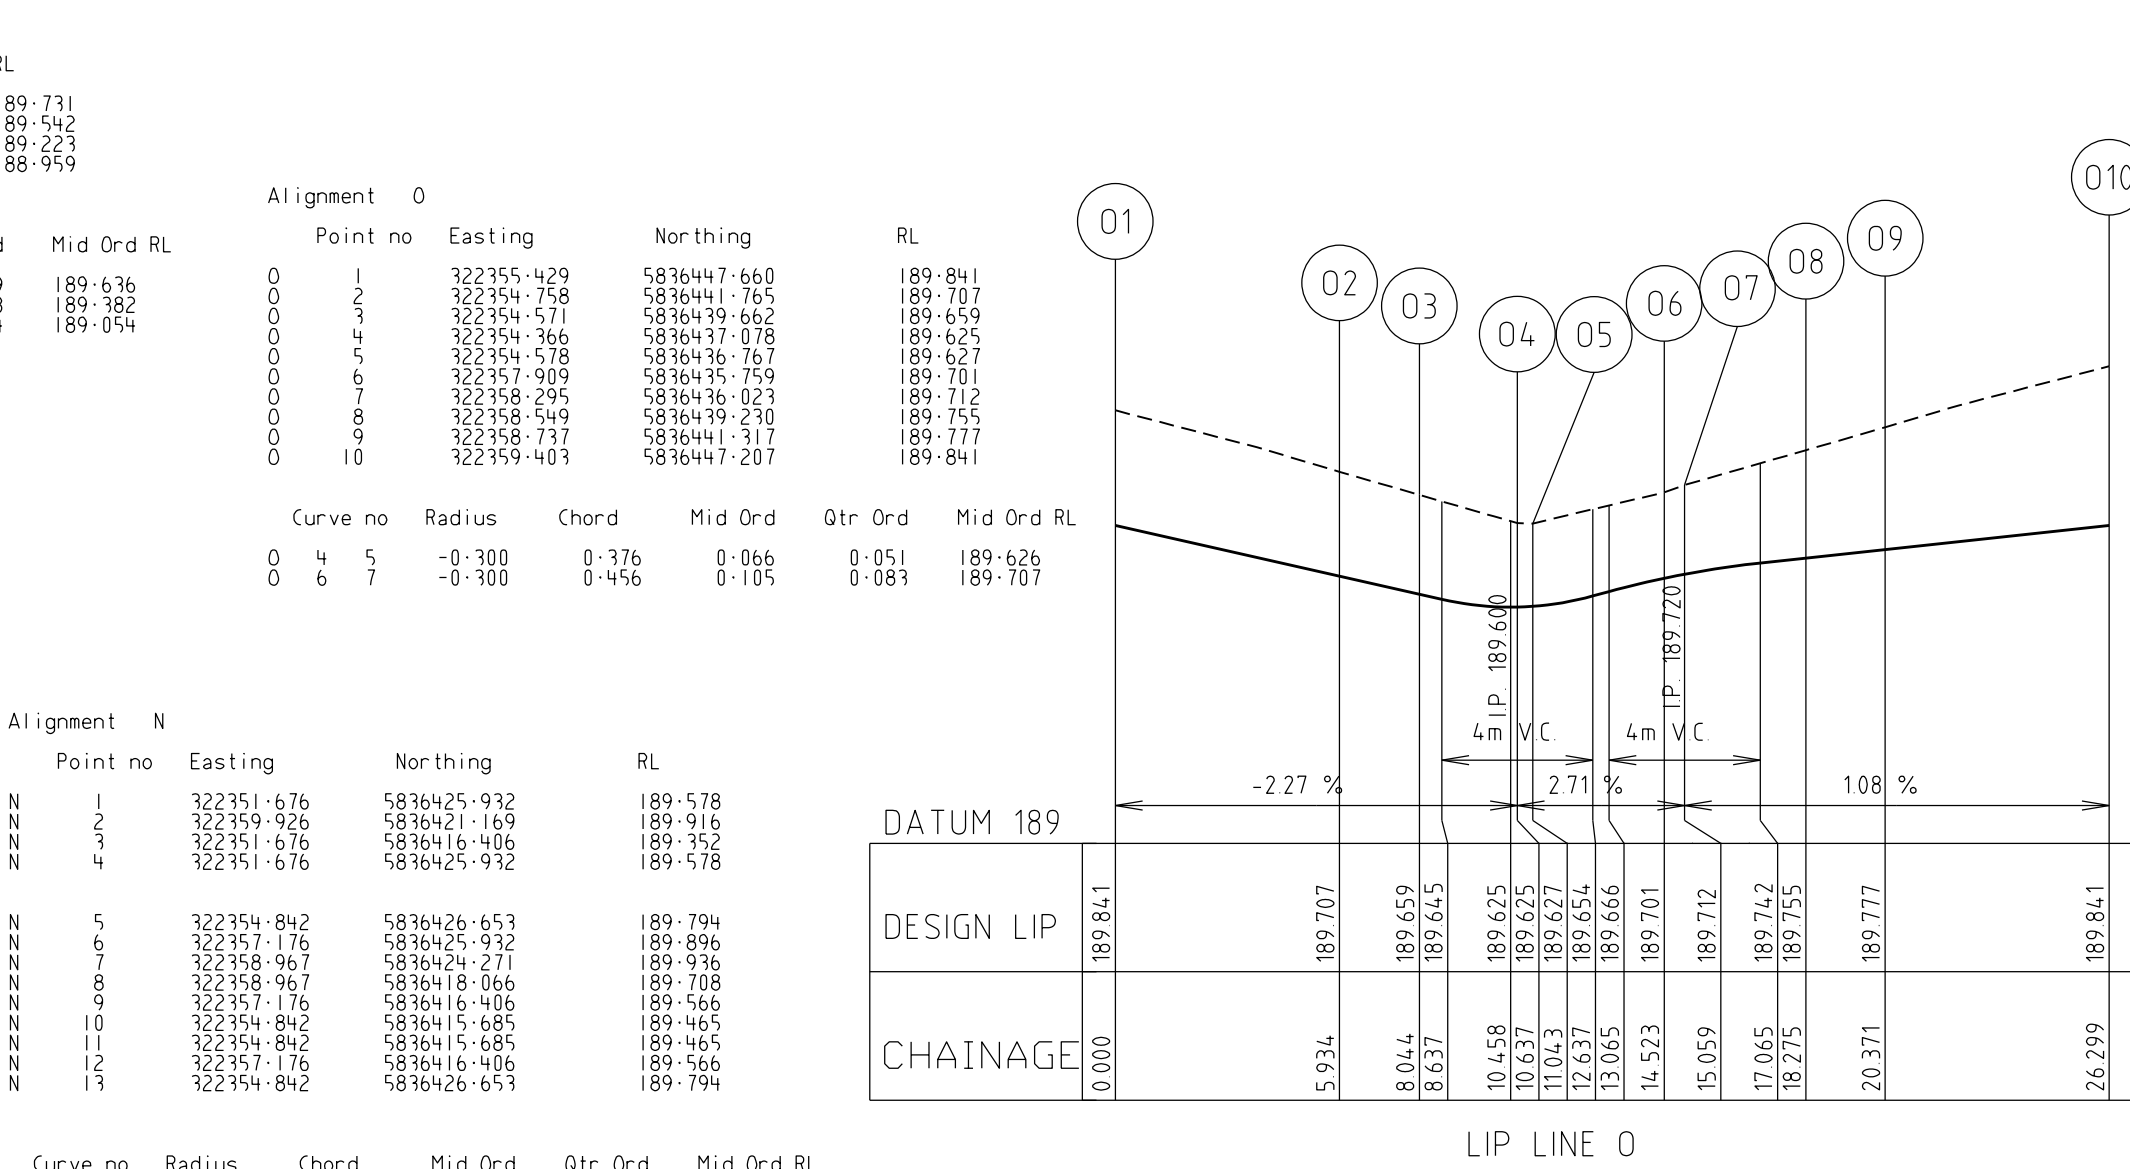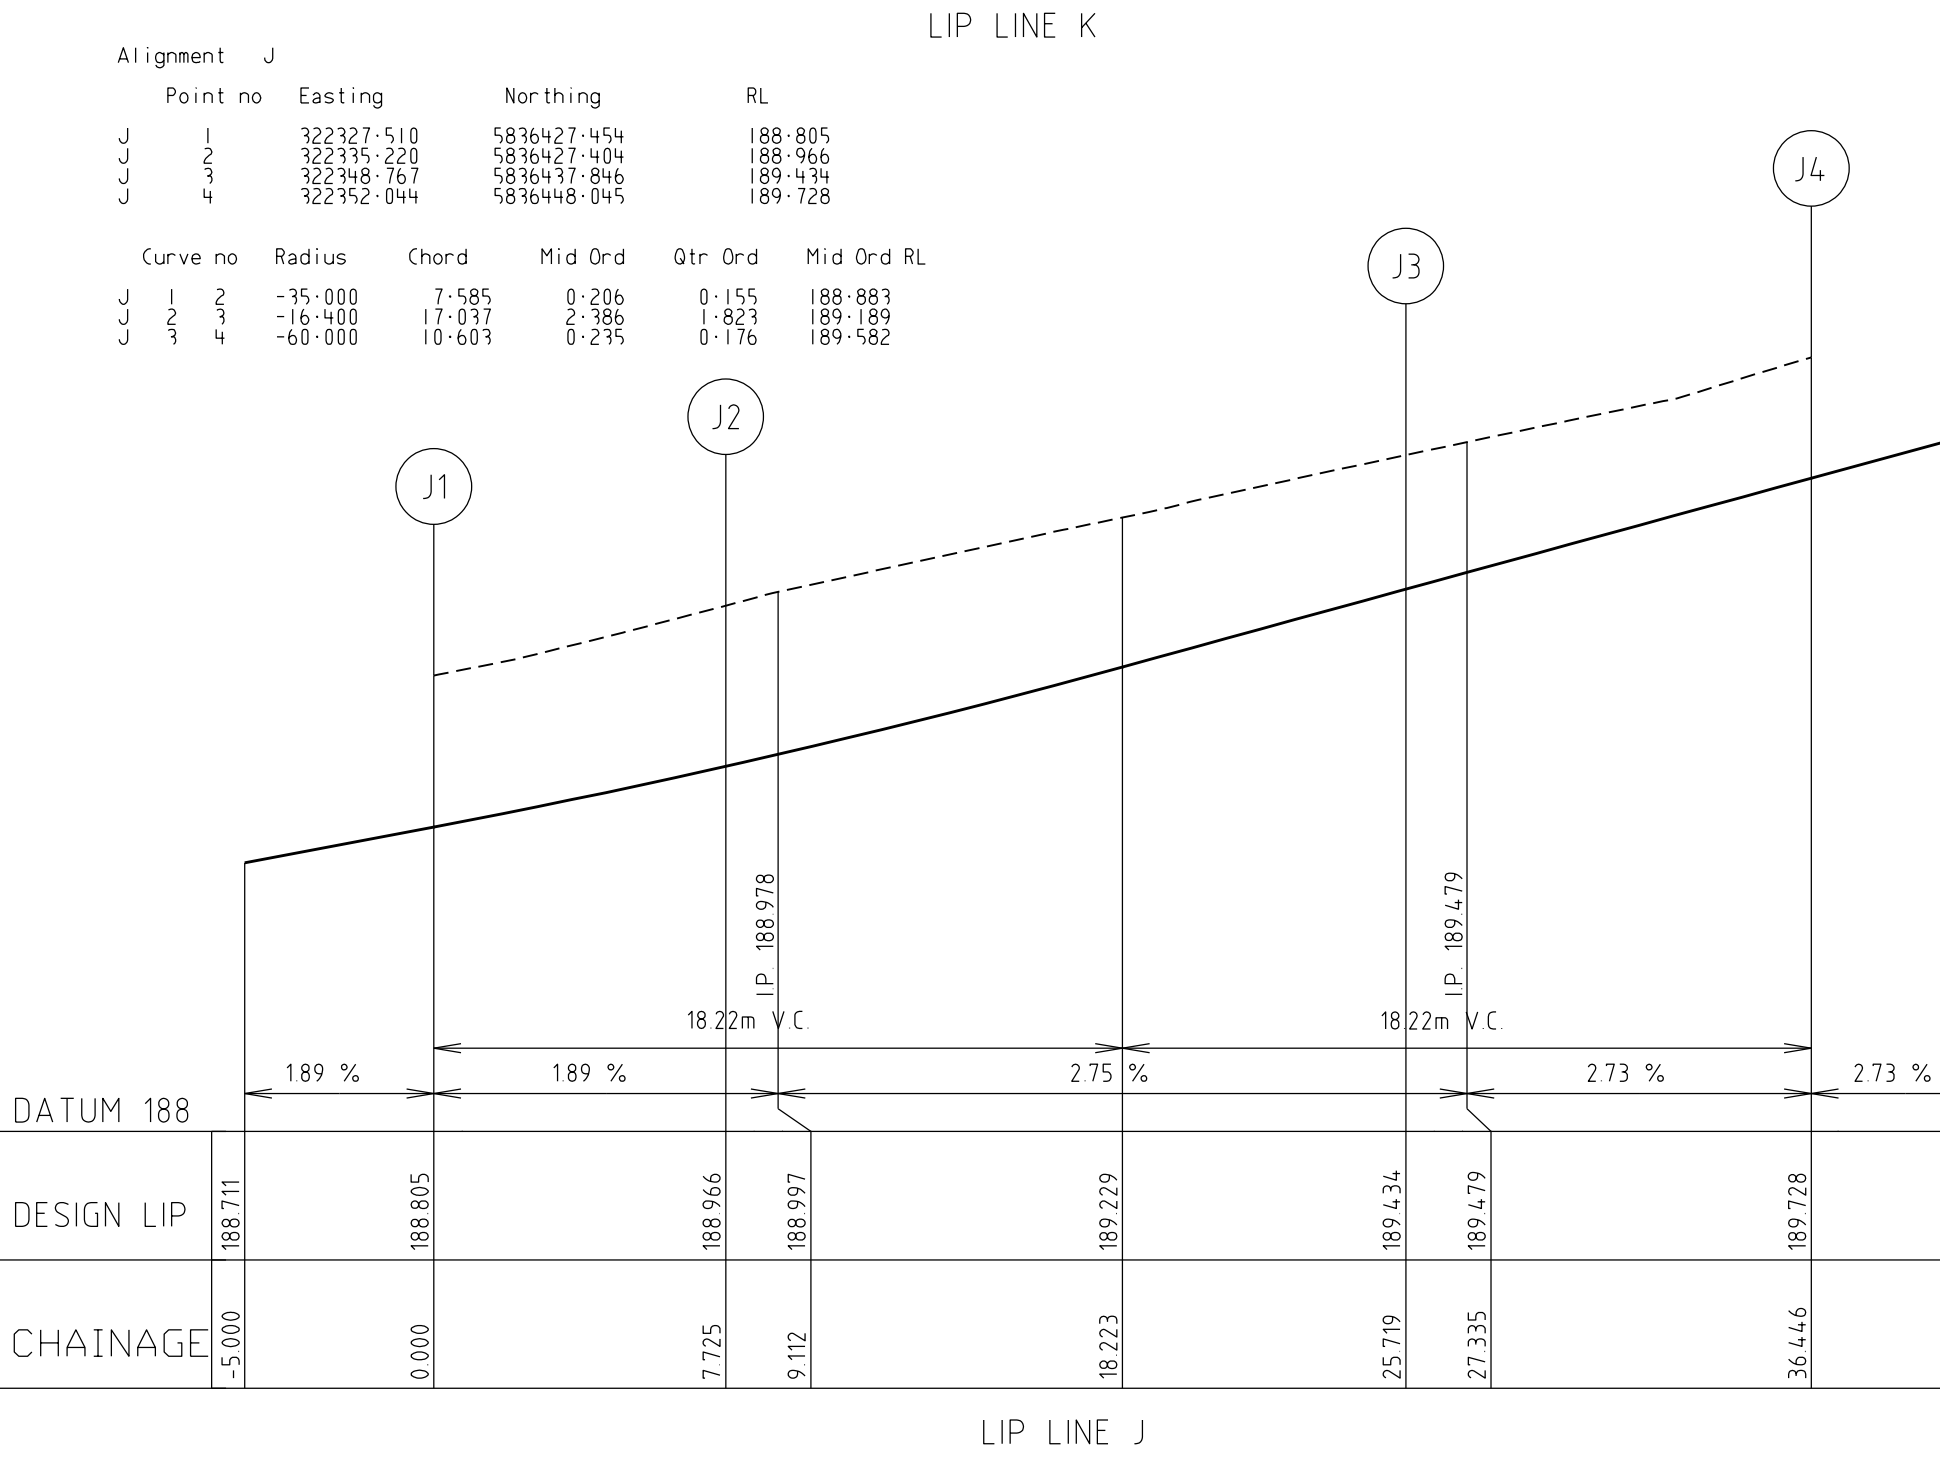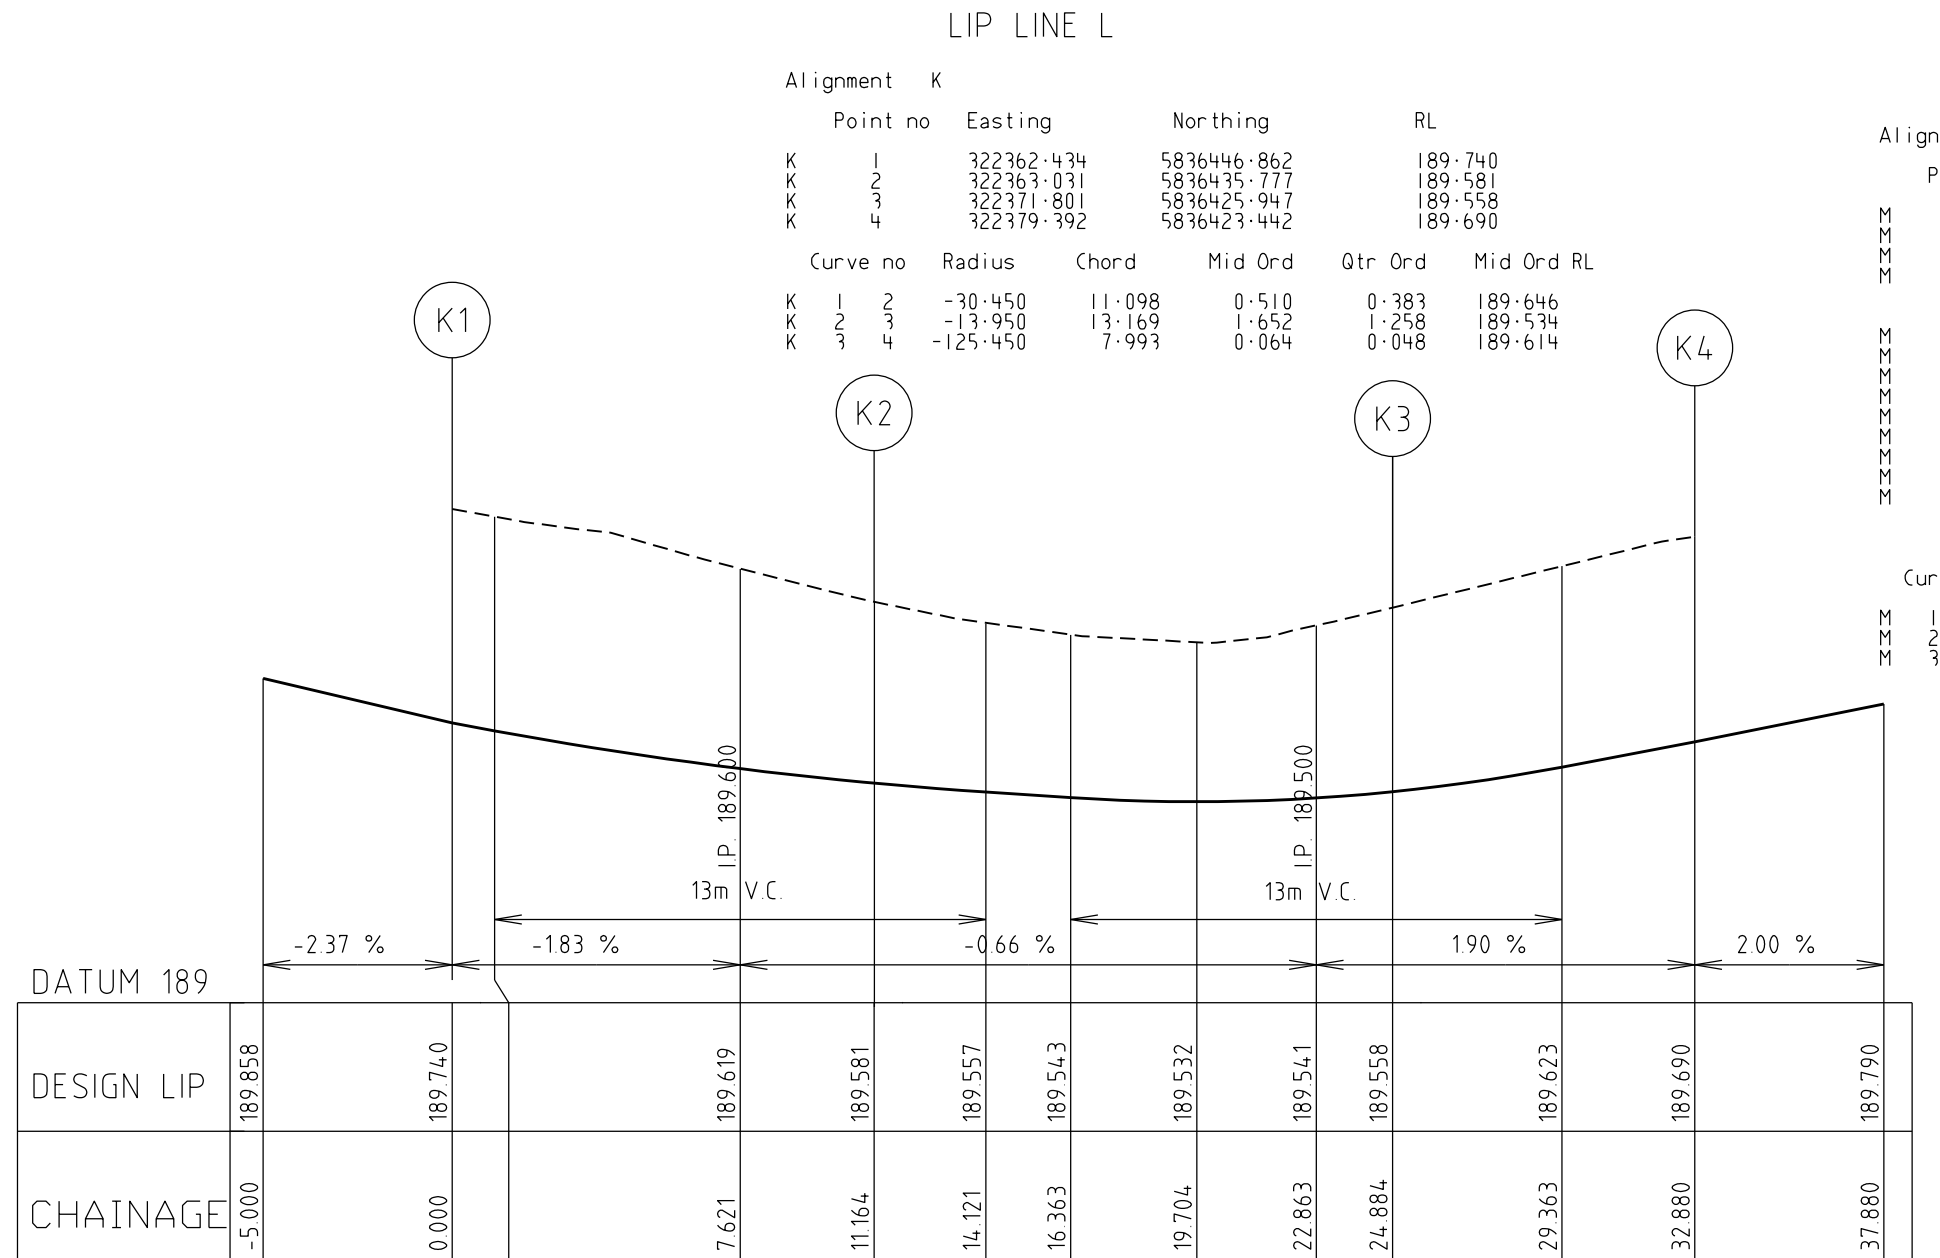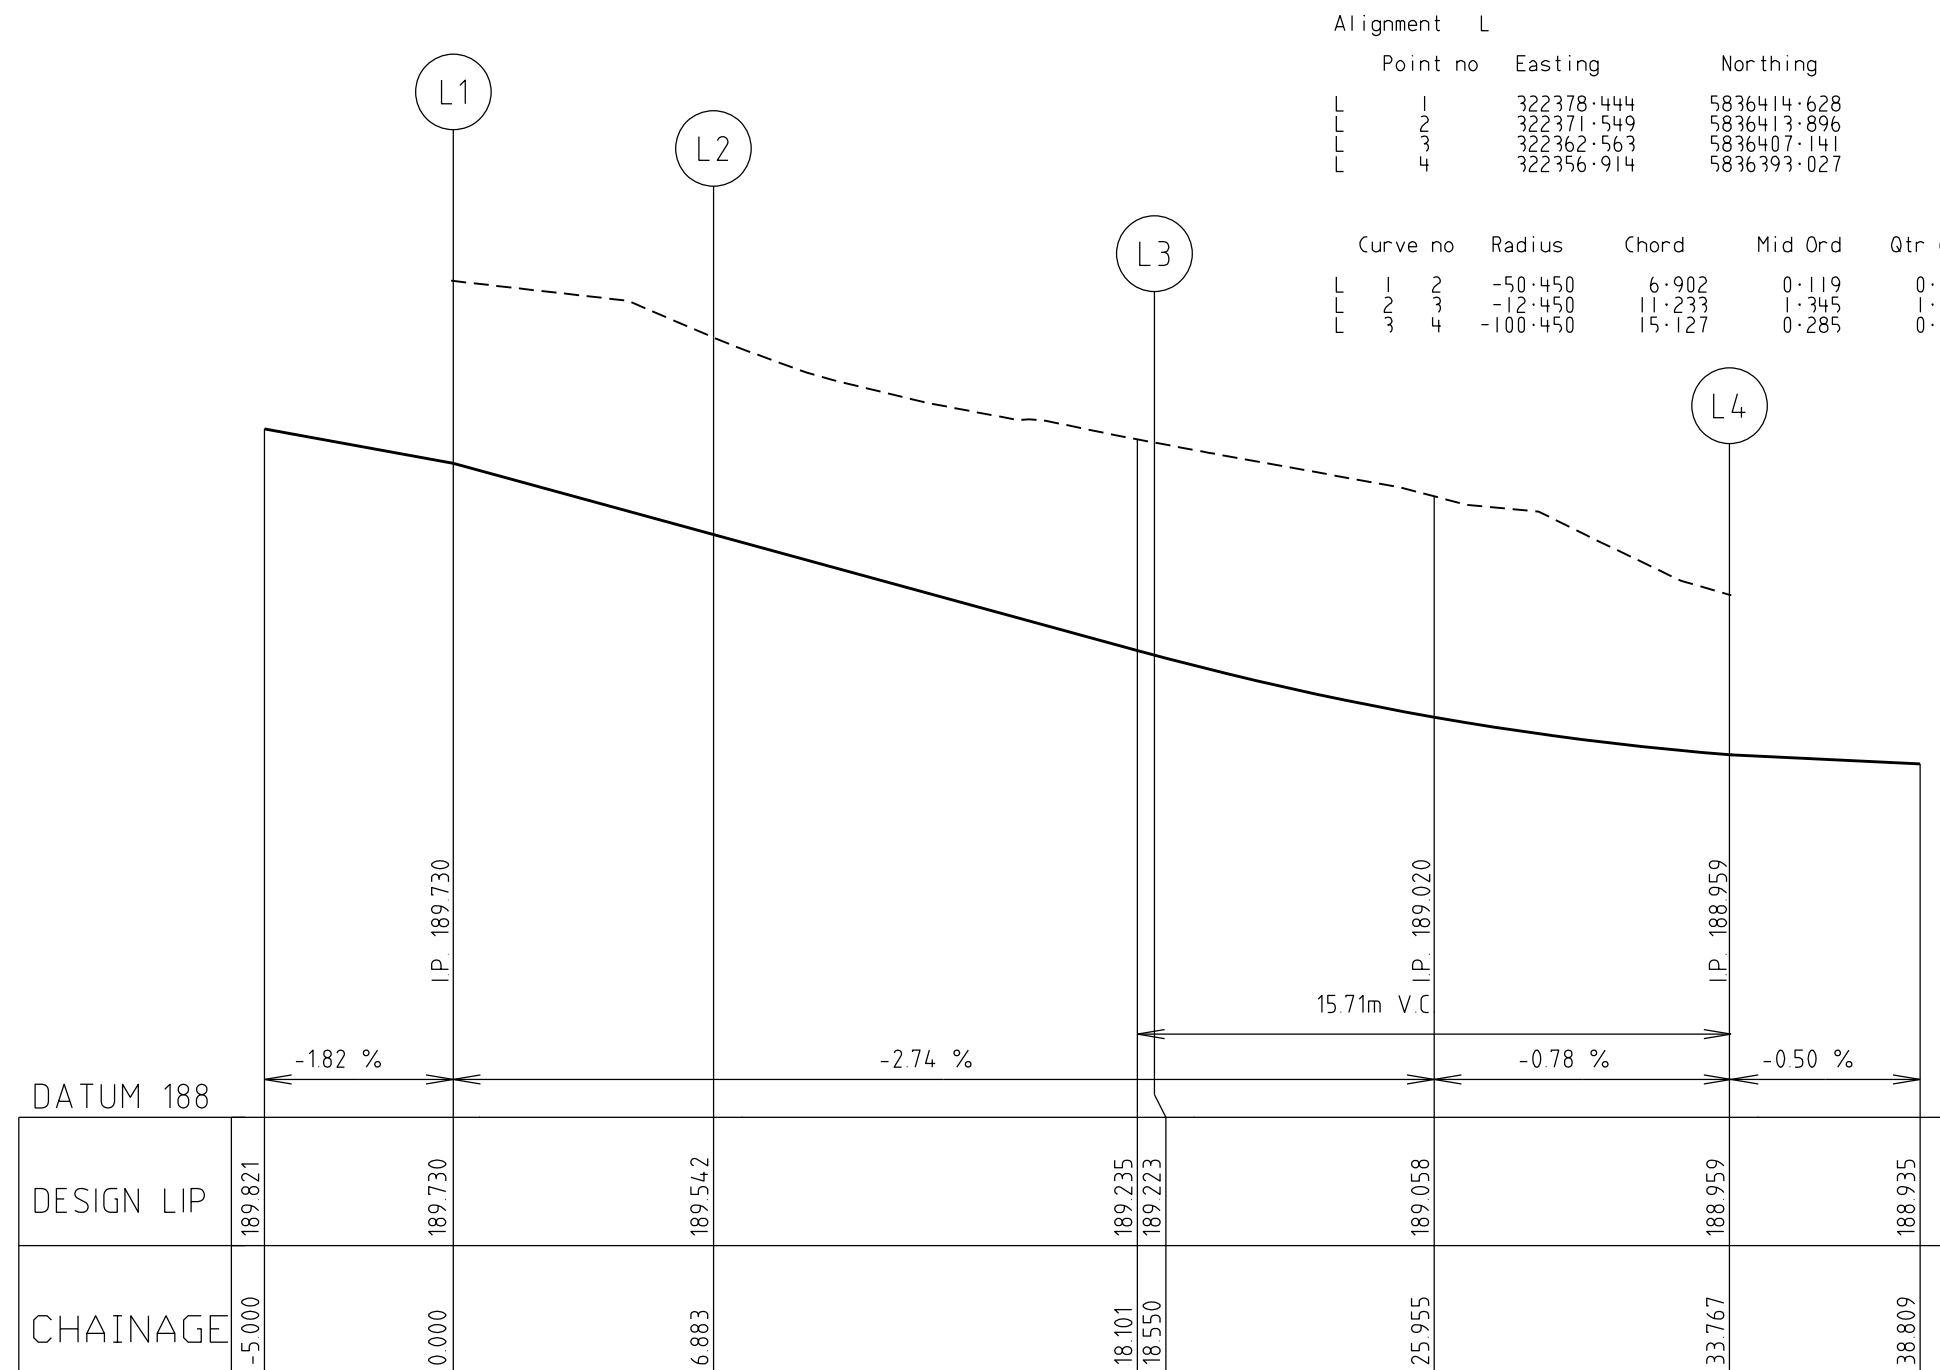

LONGITUDINAL SECTION

SCALE HORIZONTAL 1:500
VERTICAL 1:50

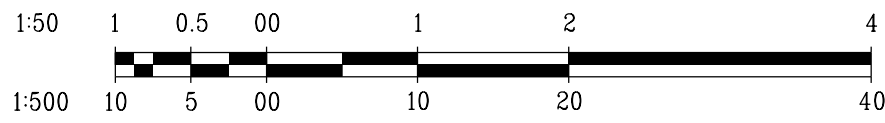

AS CONSTRUCTED

JARDIN ROAD

REFER TO INTERSECTION
DETAILS BELOW

STAGE I

LIMIT OF
WORKS

RIGHT TITLE BOUNDARY
EXISTING SURFACE

LEFT TITLE BOUNDARY
EXISTING SURFACE

CENTRELINE
EXISTING SURFACE

LIP OF KERB
DESIGN CL

FOR KERB RETURN GRADES AT
ROUNDABOUT REFER SHEET 3

STAGE I
PROPOSED STAGE 2

LIMIT OF
WORKS

TRUE LEFT & RIGHT ARE IN
THE DIRECTION OF THE
INCREASING CHAINAGE

VC LENGTH

DESIGN GRADELINE

DATUM 186

ES LEFT TITLE BDY

FS LEFT TITLE BDY

LEFT LIP OF KERB


DESIGN CL

RIGHT LIP OF KERB

FS RIGHT TITLE BDY

ES RIGHT TITLE BDY

CHAINAGE CENTRE LINE

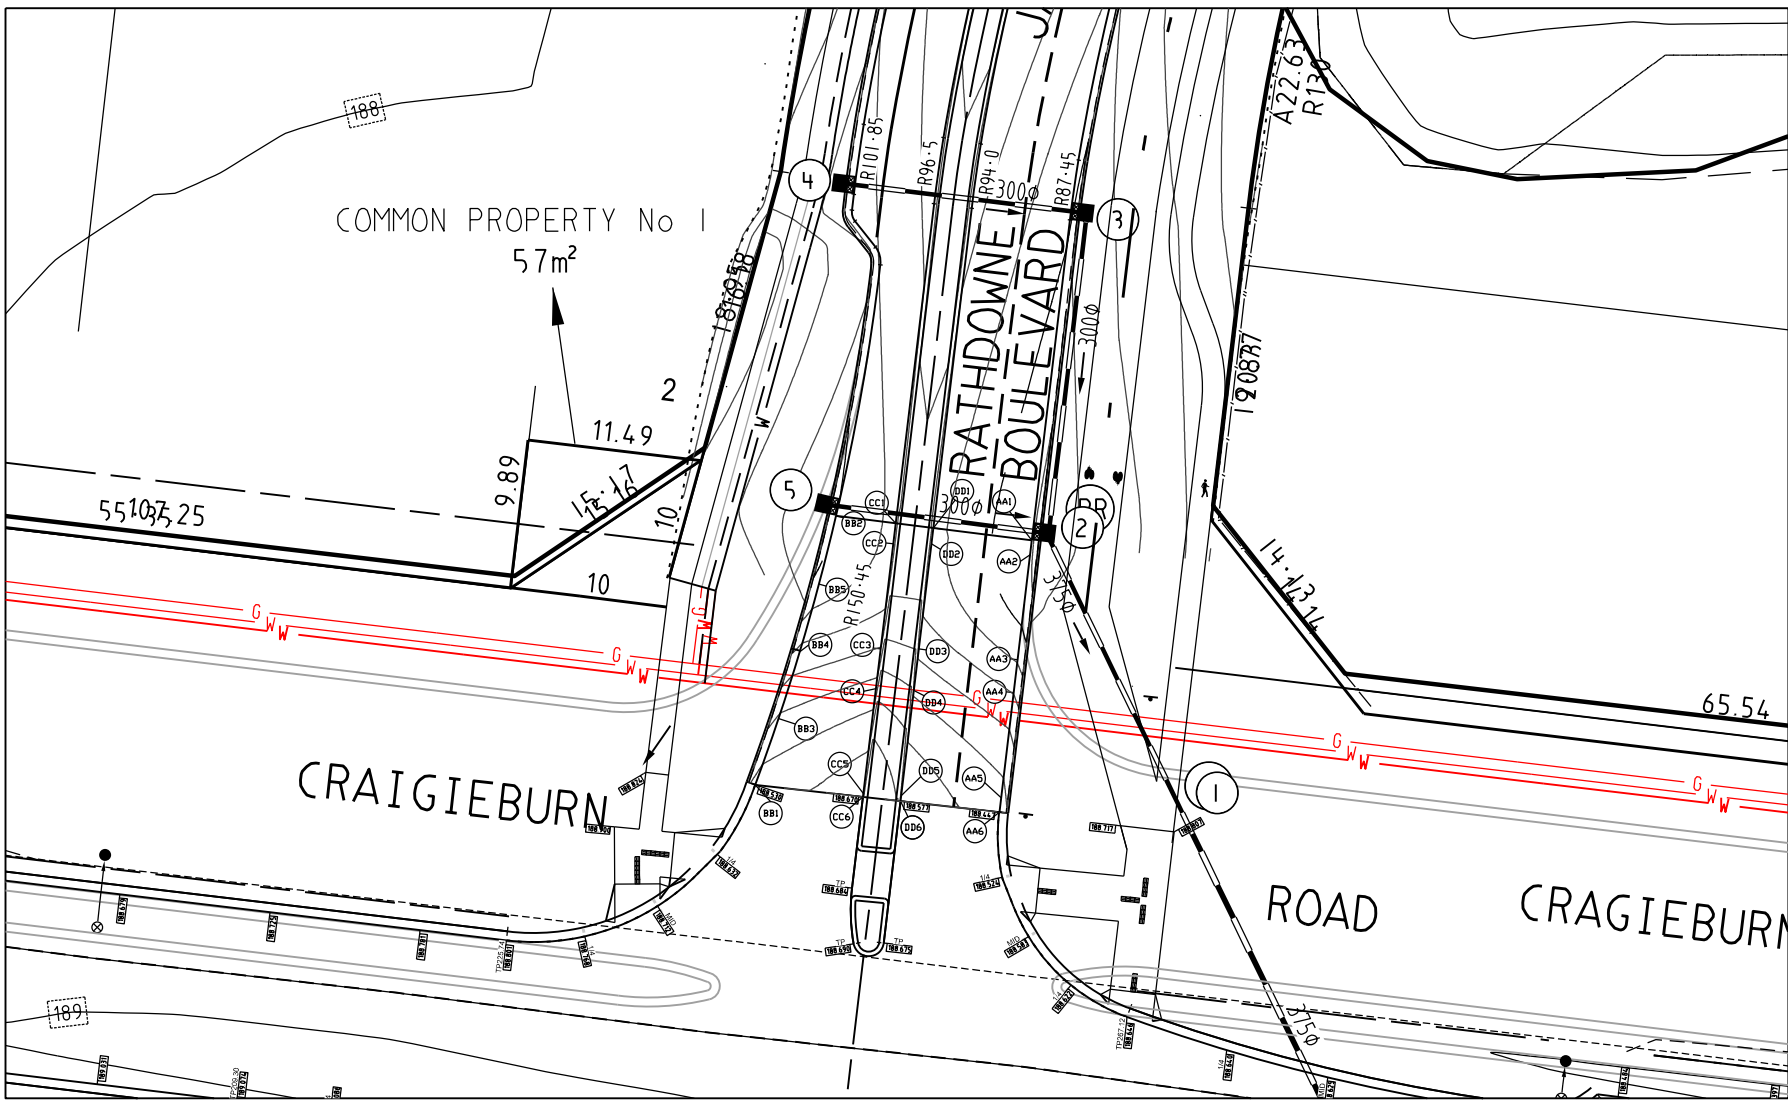

Alignment BB

Point no	Easting	Northing	RL
BB 1	322274.956	5836201.194	188.530
BB 2	322280.314	5836218.984	187.997
BB 3	322276.501	5836205.579	188.413
BB 4	322277.910	5836210.006	188.227
BB 5	322279.180	5836214.475	188.048

Curve no	Radius	Chord	Mid Ord	Qtr Ord	Mid Ord RL
BB 1 2	-150.450	18.580	0.287	0.215	188.227

Alignment AA



Point no	Easting	Northing	RL
AA 1	322293.259	5836217.377	187.911
AA 2	322293.146	5836219.422	187.914
AA 3	322292.317	5836209.471	188.091
AA 4	322292.058	5836207.296	188.196
AA 5	322291.230	5836200.345	188.458
AA 6	322291.116	5836199.391	188.447

Alignment DD


Point no	Easting	Northing	RL
DD 1	322286.743	5836218.187	188.136
DD 2	322286.617	5836217.134	188.136
DD 3	322286.784	5836220.184	188.274
DD 4	322285.455	5836207.447	188.385
DD 5	322284.622	5836200.497	188.572
DD 6	322284.577	5836200.126	188.577

Alignment CC


Point no	Easting	Northing	RL
CC 1	322284.262	5836218.495	188.129
CC 2	322284.099	5836217.134	188.131
CC 3	322283.266	5836220.184	188.306
CC 4	322282.951	5836207.141	188.458
CC 5	322282.118	5836200.611	188.667
CC 6	322282.093	5836200.406	188.670

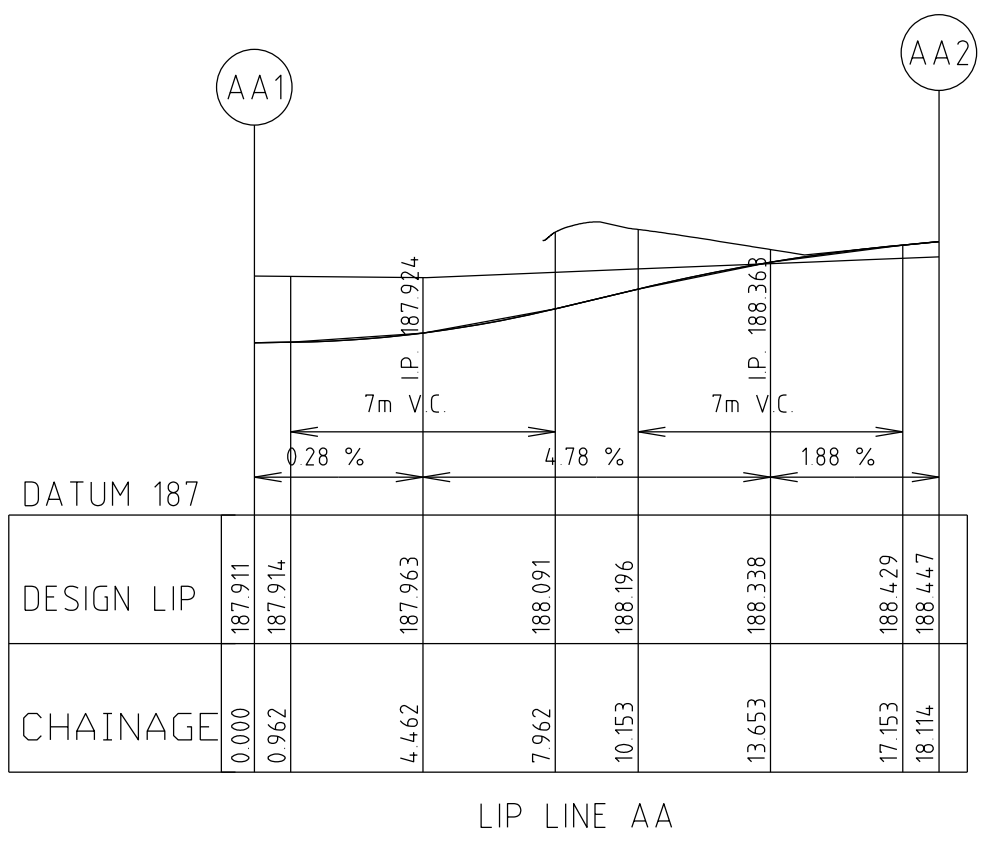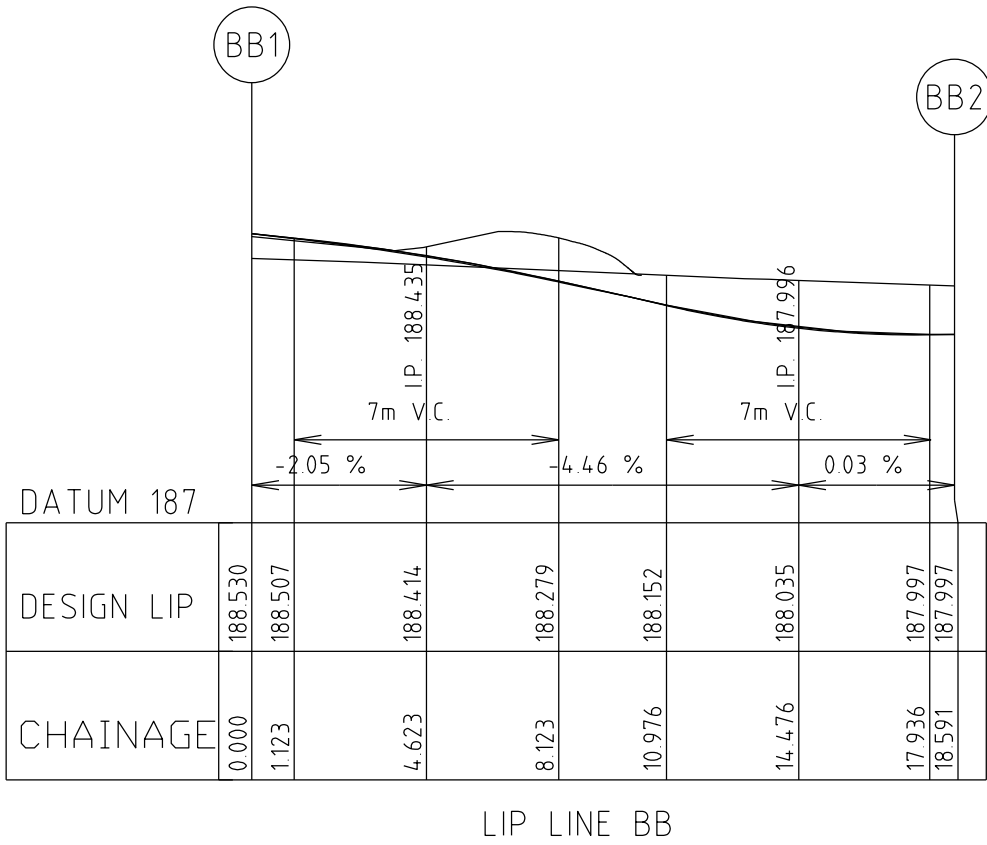


AMENDMENTS		bpd		breese pitt dixon pty. ltd. land surveyors		1/19 coto street hawthorn east, 3123 telephone 8823 2300 fax no. 8823 2310	
E 10.10.18		LIP LINES AMENDED AT INTERSECTION INTERFACE RATHDOWNE BLVD & CRAIGIEBURN EAST RD		MELWAY REF. 388-C-10		MUNICIPALITY WHITTLESEA	
A 19.12.17		ISSUED FOR CONSTRUCTION		SURVEY SPIRE		REFERENCE 9365 E/1	
VER DATE		REMARKS		DESIGN SS		SHEET 7 OF 19	
CHECKED		SCALE AS SHOWN		DRAWN SS		DATE JAN '17	
DATE		DATE		DATE		DATE	

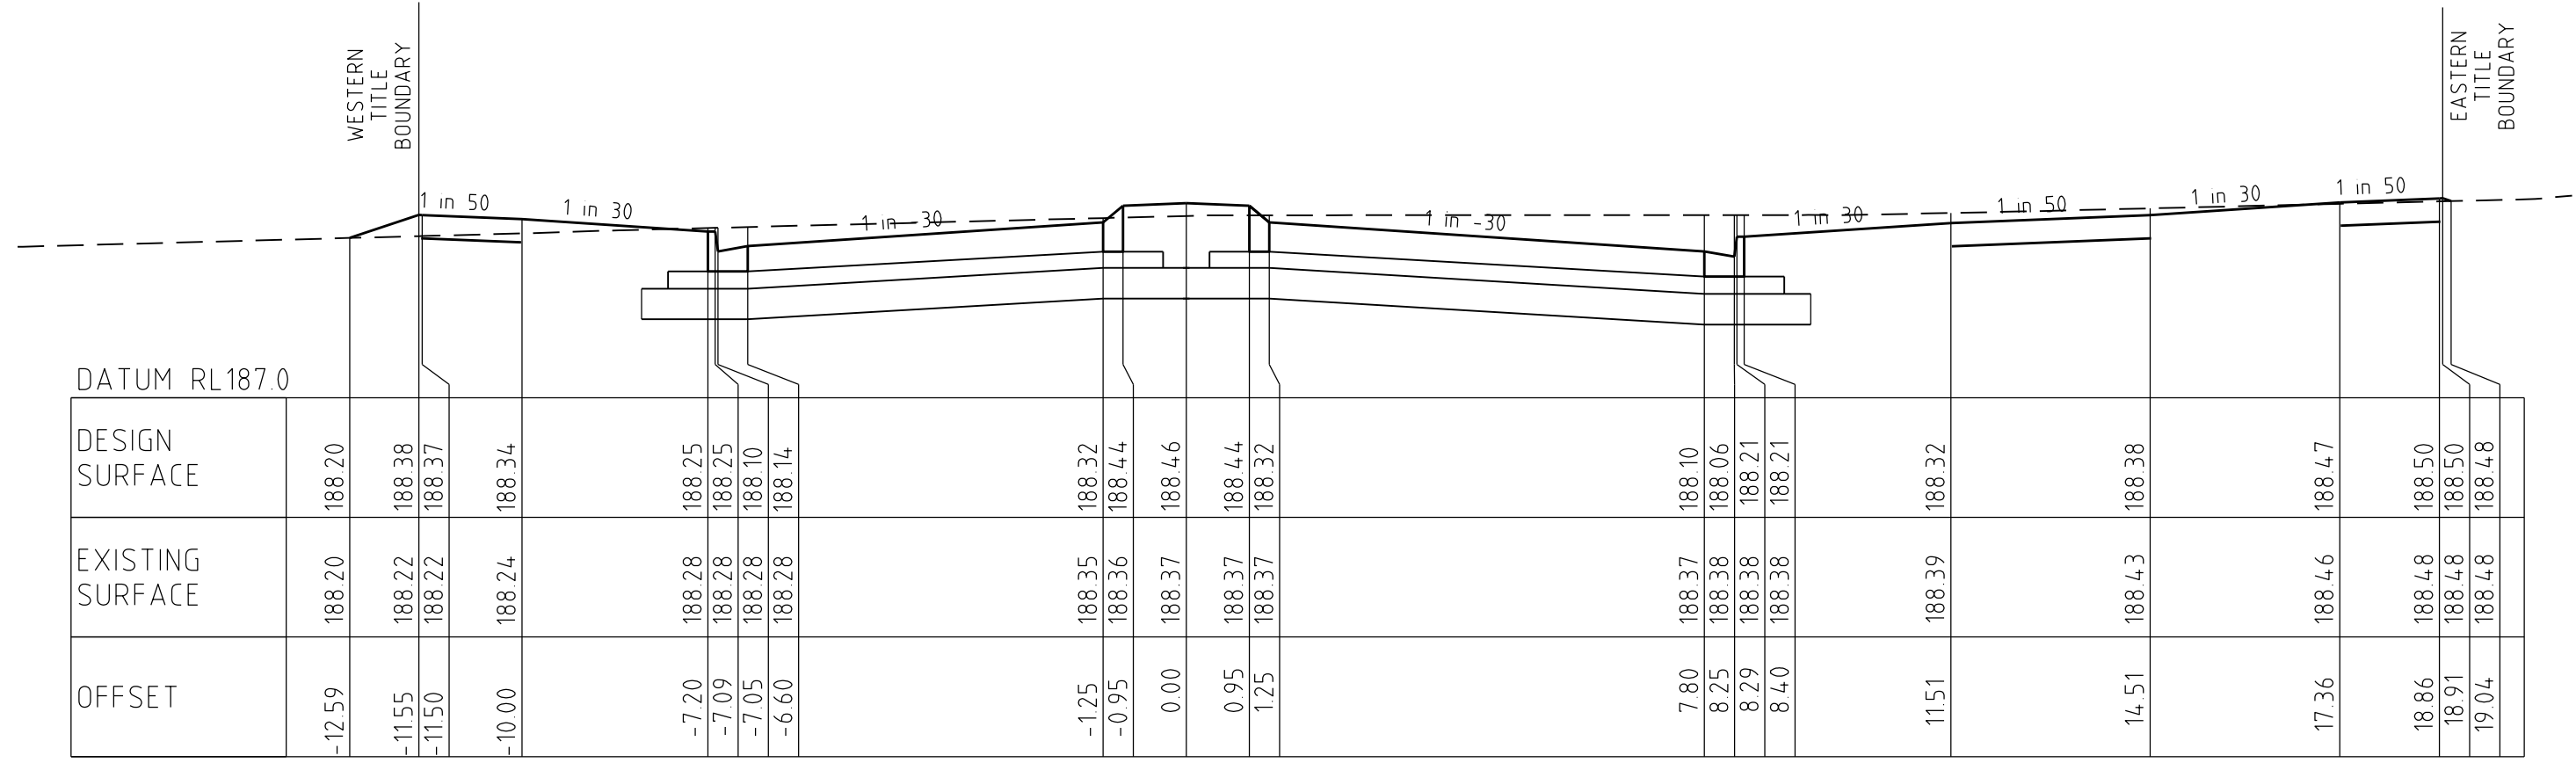


80.00

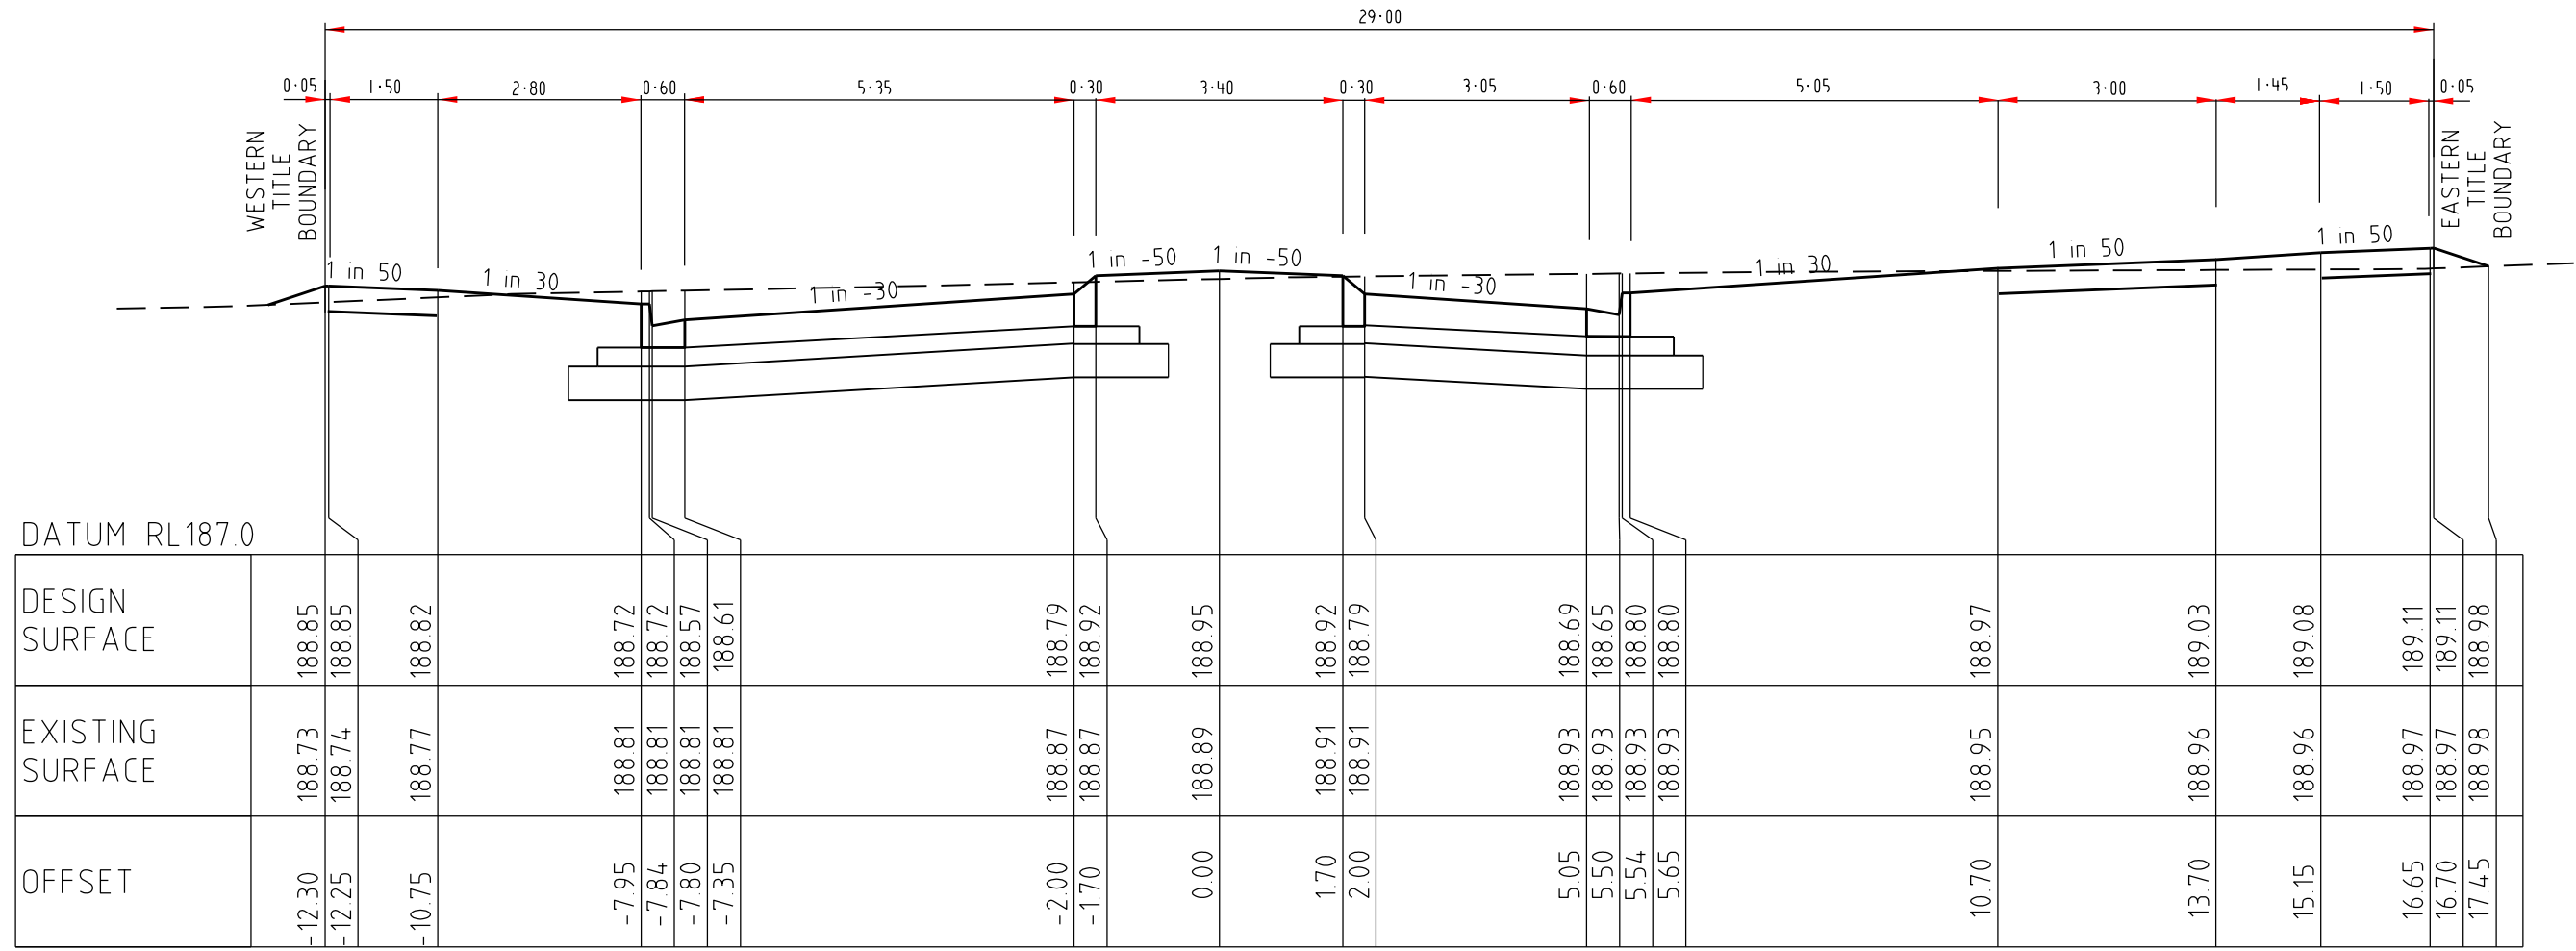

177.27

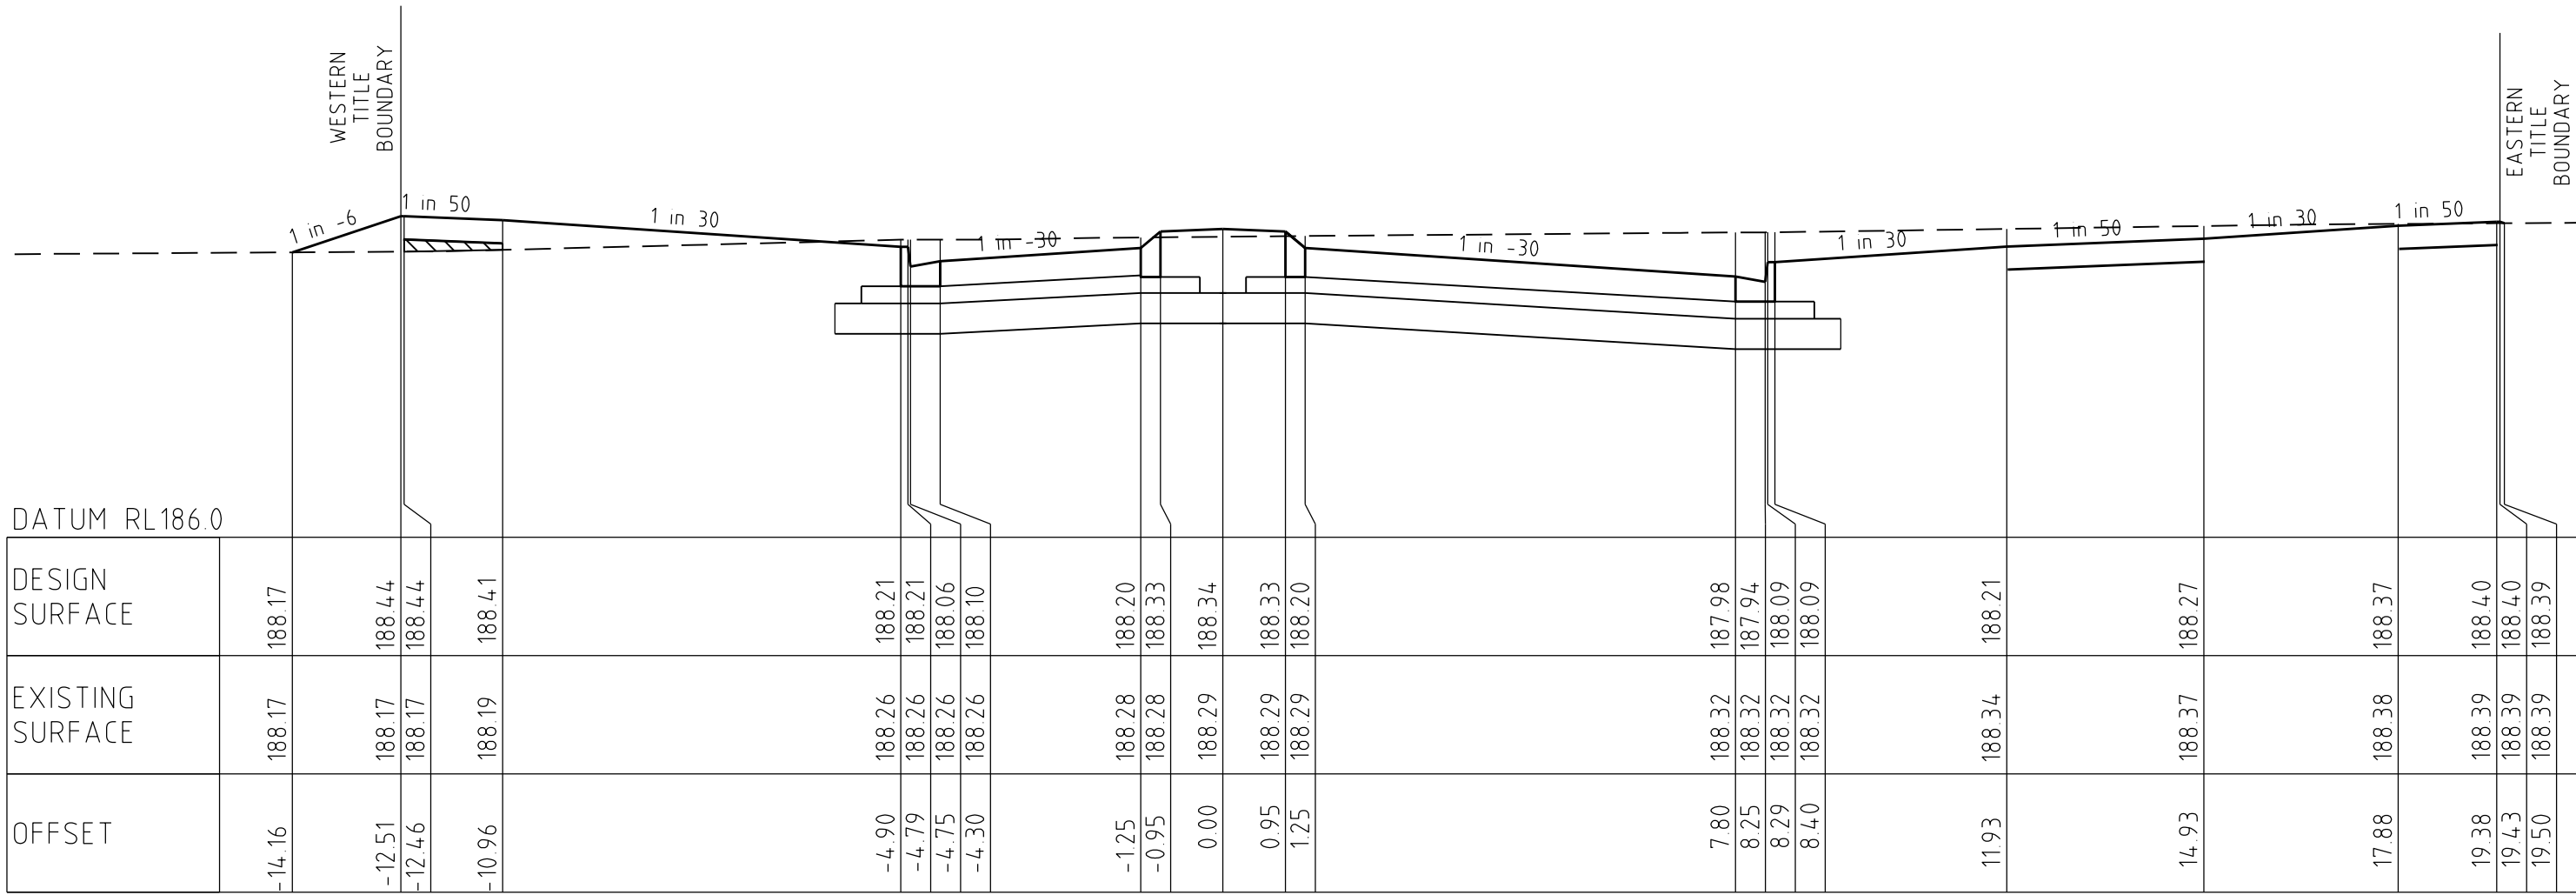


56.06

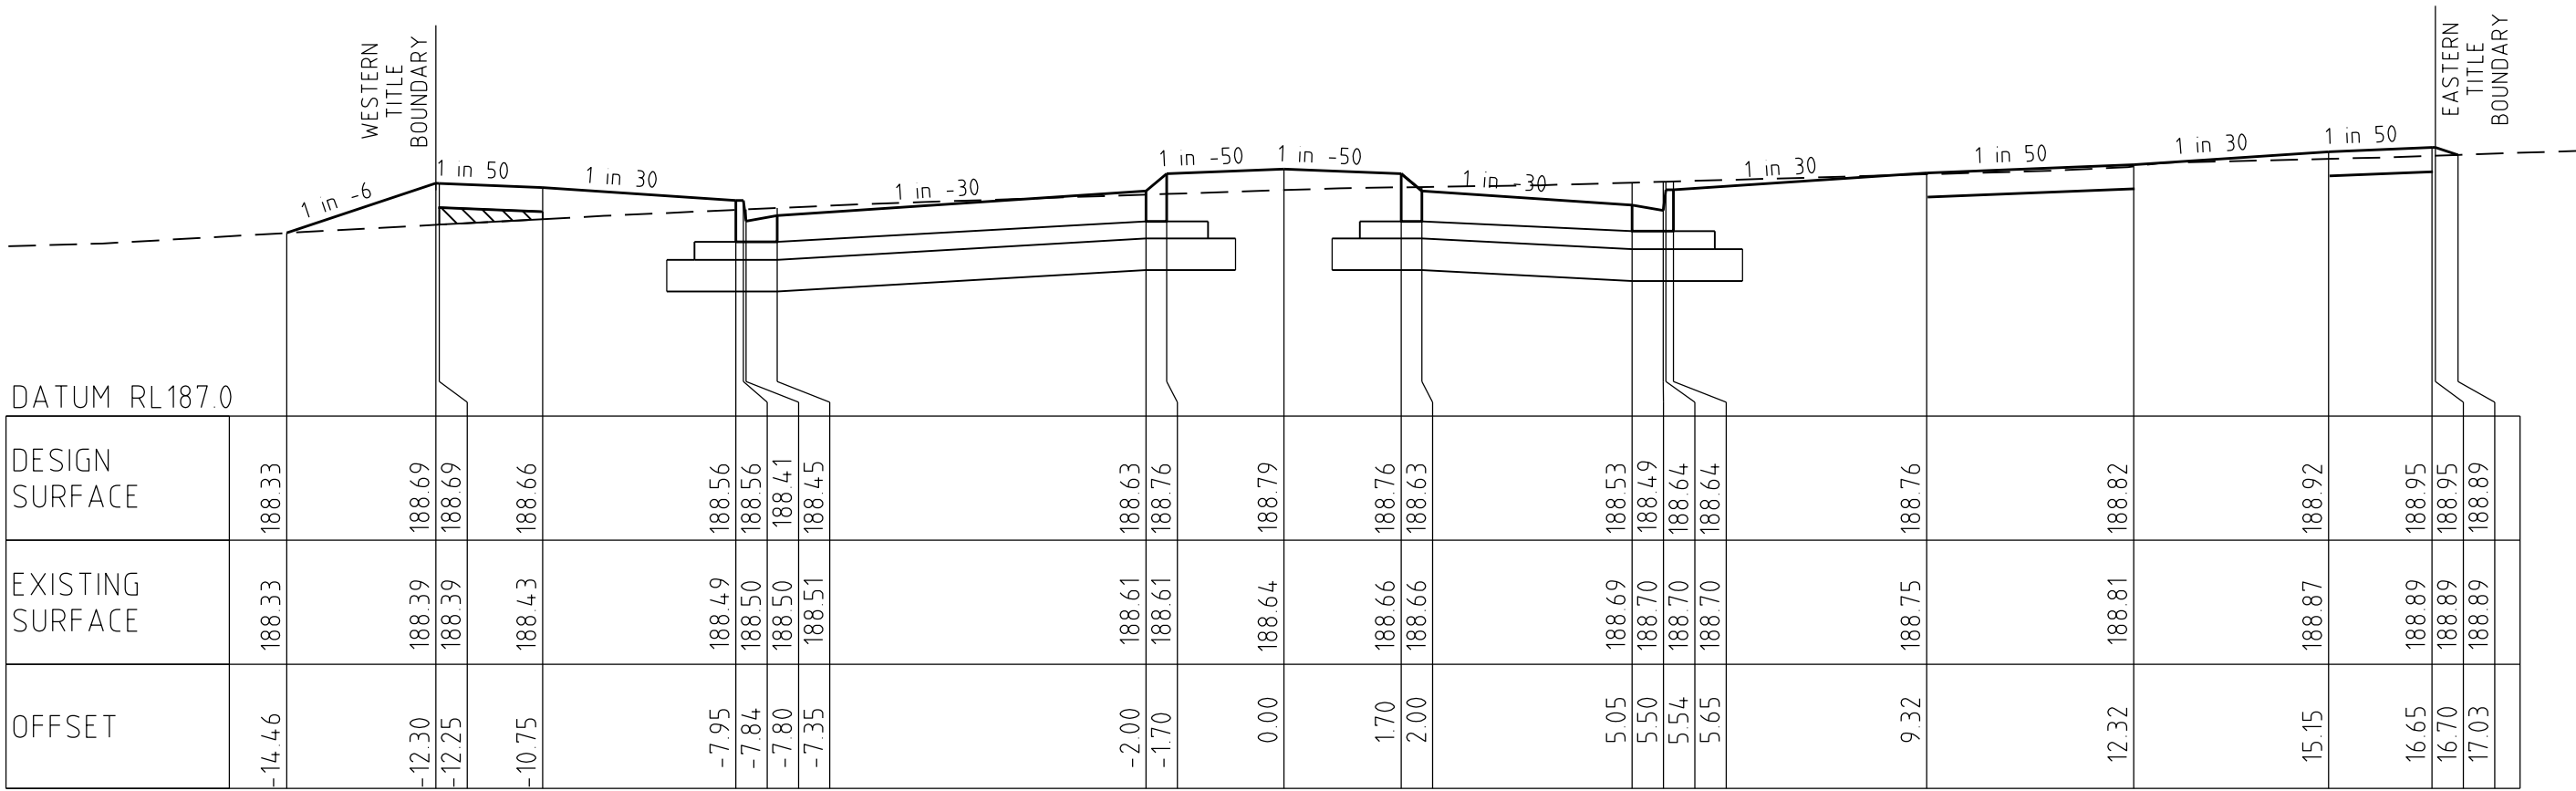

145.38

AS CONSTRUCTED

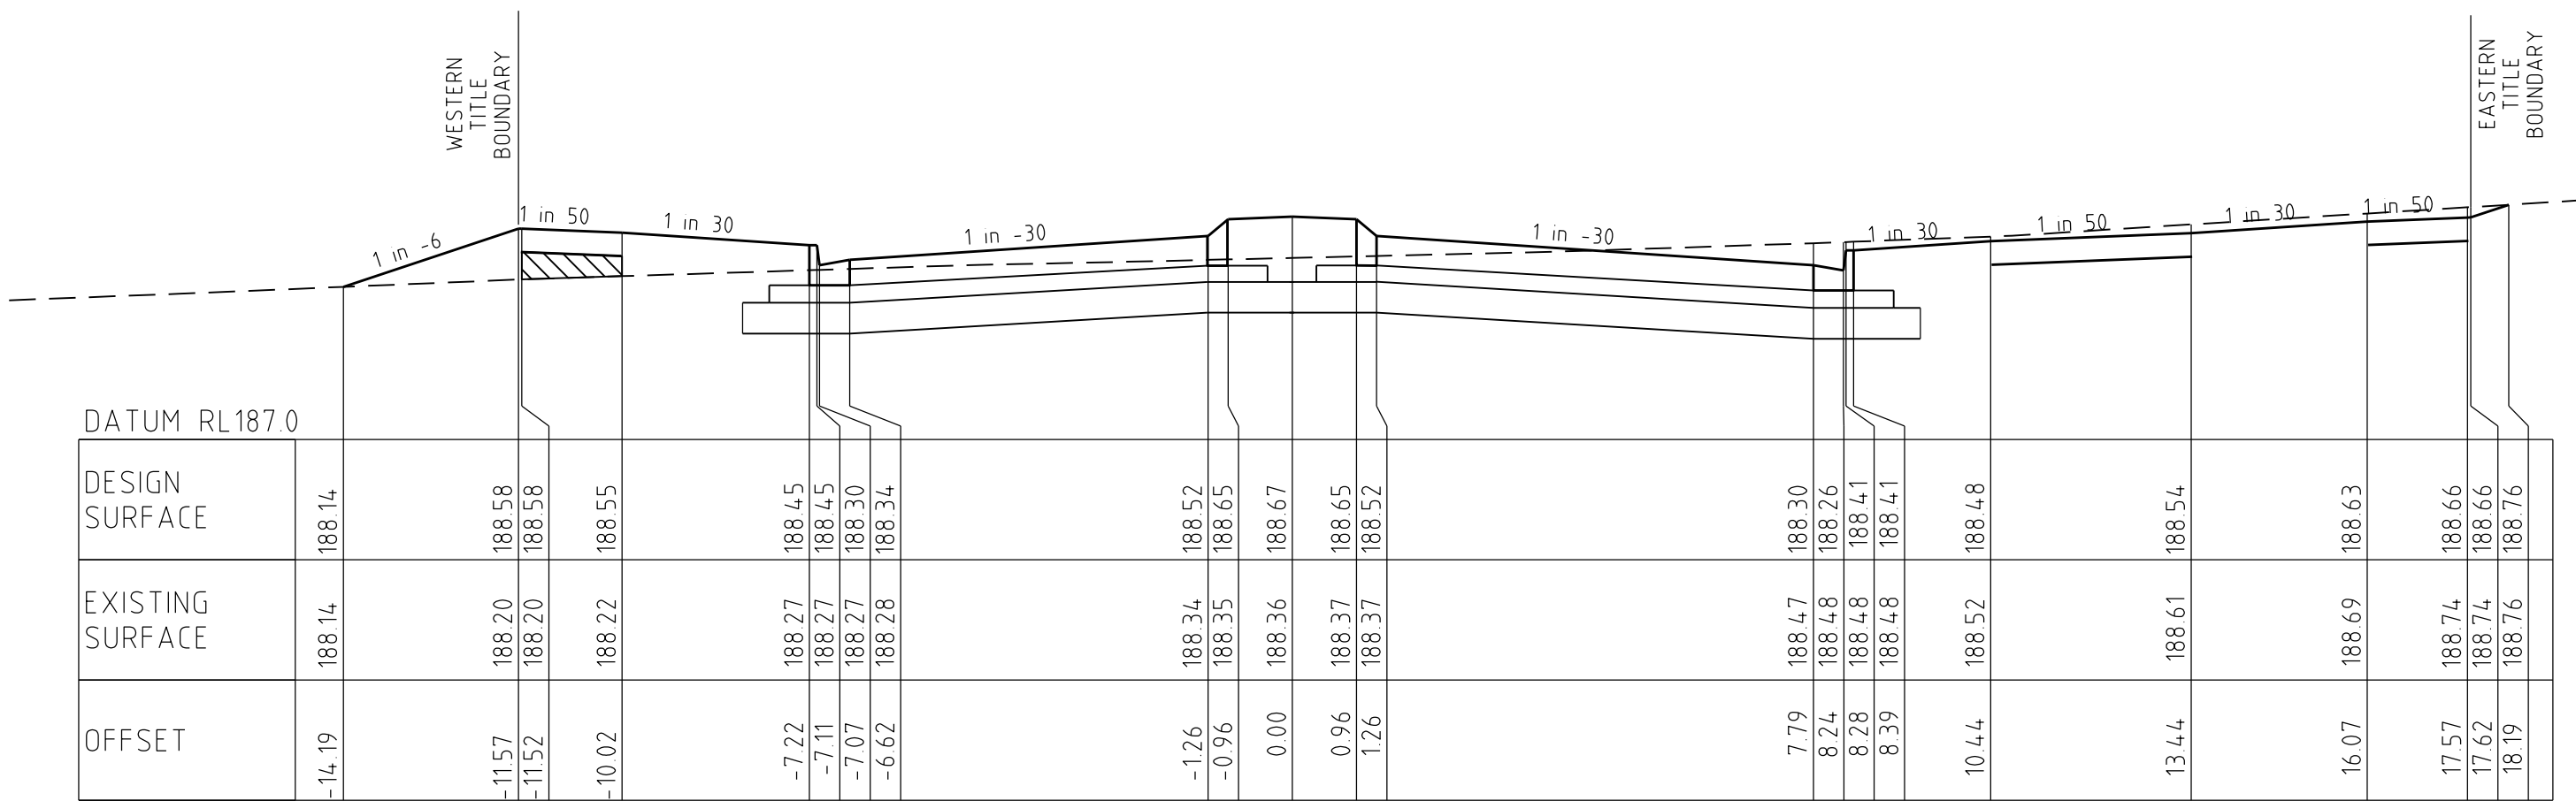


120.42



CRUSHED ROCK BACKFILL


CROSS SECTIONS

SCALE HORIZONTAL 1:100
VERTICAL 1:50

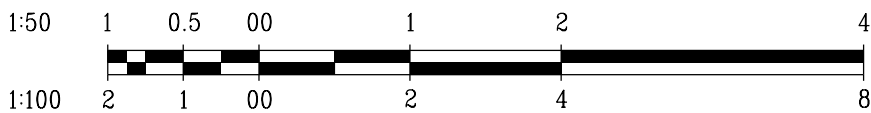


JARDIN ROAD

AMENDMENTS					breese pitt dixon pty. ltd. land surveyors civil engineers			1/19 coto street hawthorn east, 3123 telephone 8823 2300 fax no. 8823 2310								
				MELWAY REF.	388-C-10	RATHDOWNE ESTATE STAGE I JARDIN ROAD			MUNICIPALITY							
				SURVEY	SPIIRE				WHITTLESEA							
E	12-10-18	Ch 22.05 REMOVED		DESIGN	SS				REFERENCE							
A	19-12-17	ISSUED FOR CONSTRUCTION		DRAWN	SS				9365 E/1							
VER	DATE	REMARKS		CHECKED		SCALE	AS SHOWN	DATUM	AHD	DATE	JAN '17	SHEET	8	OF	19	E

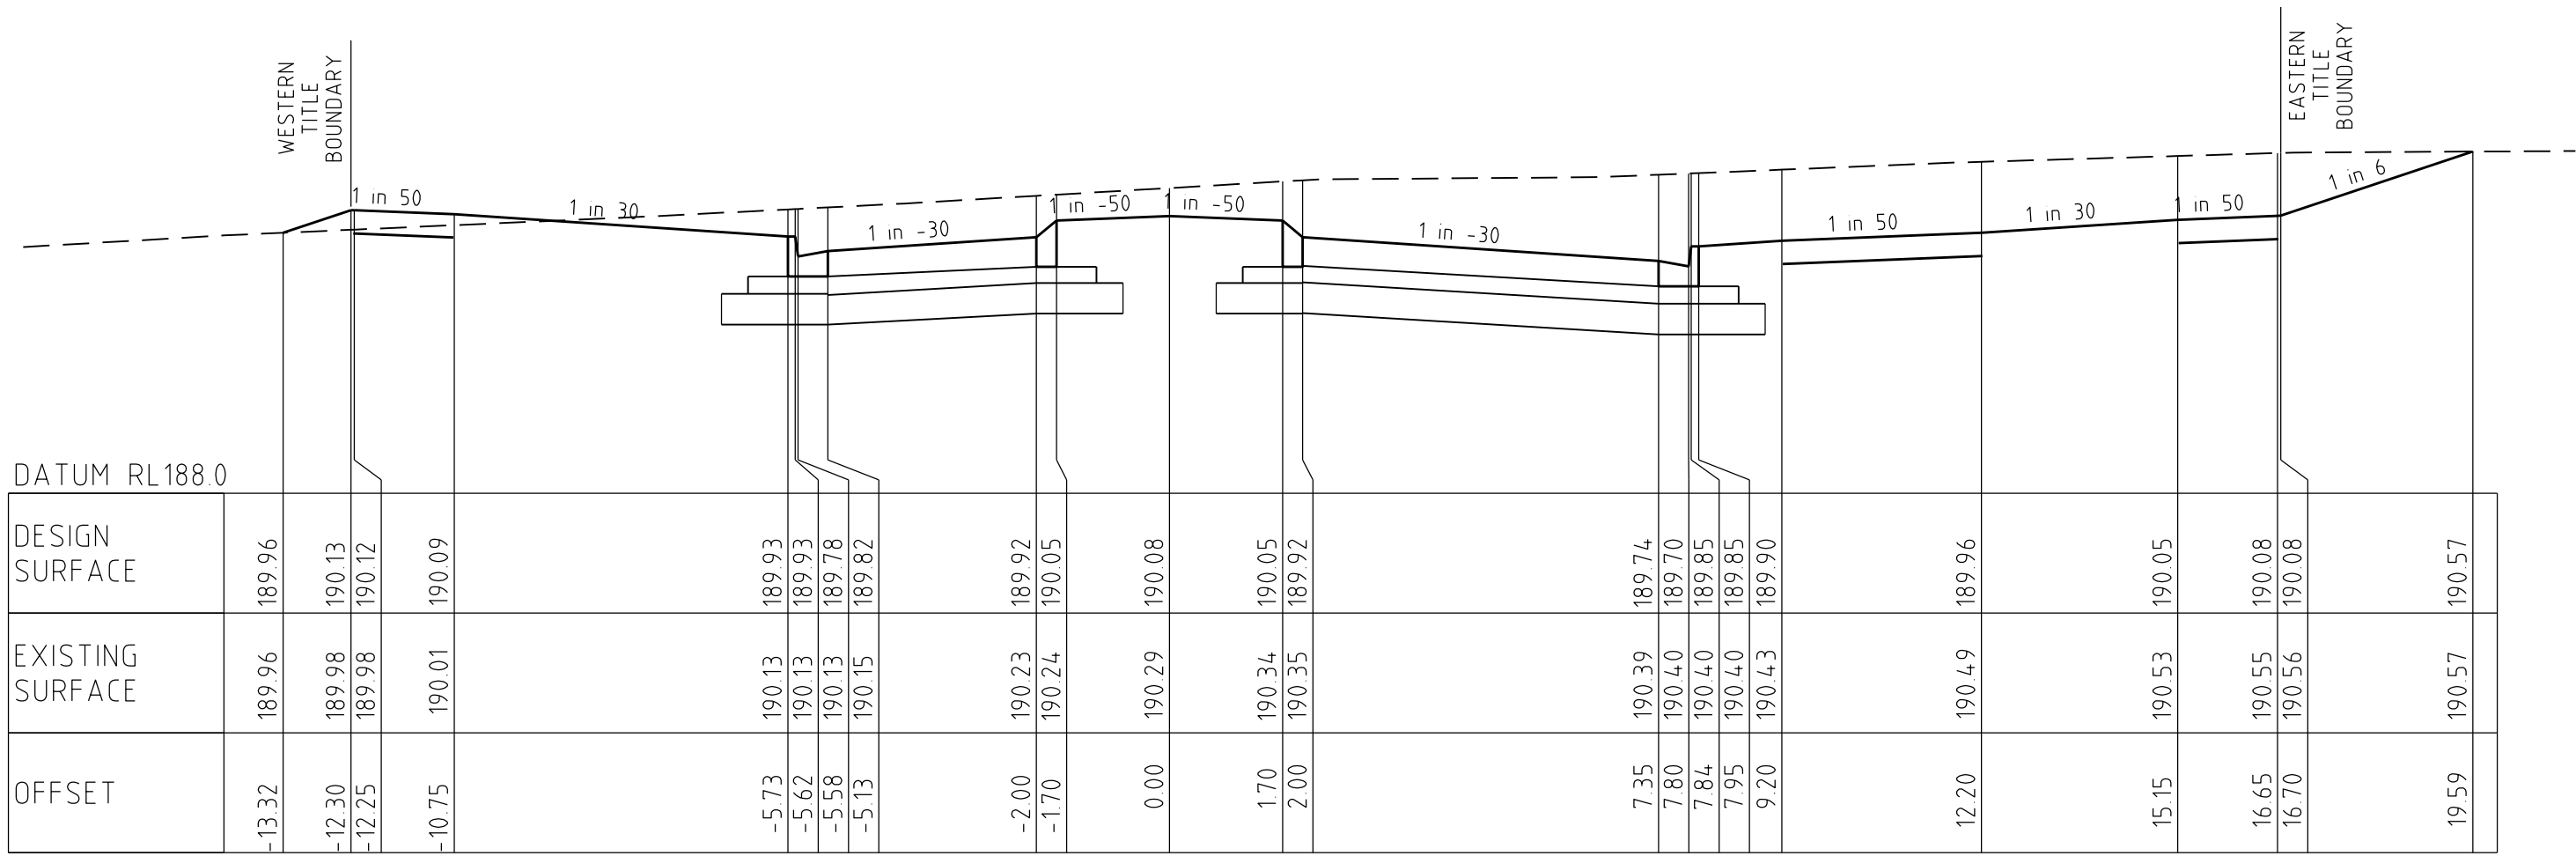


287.16

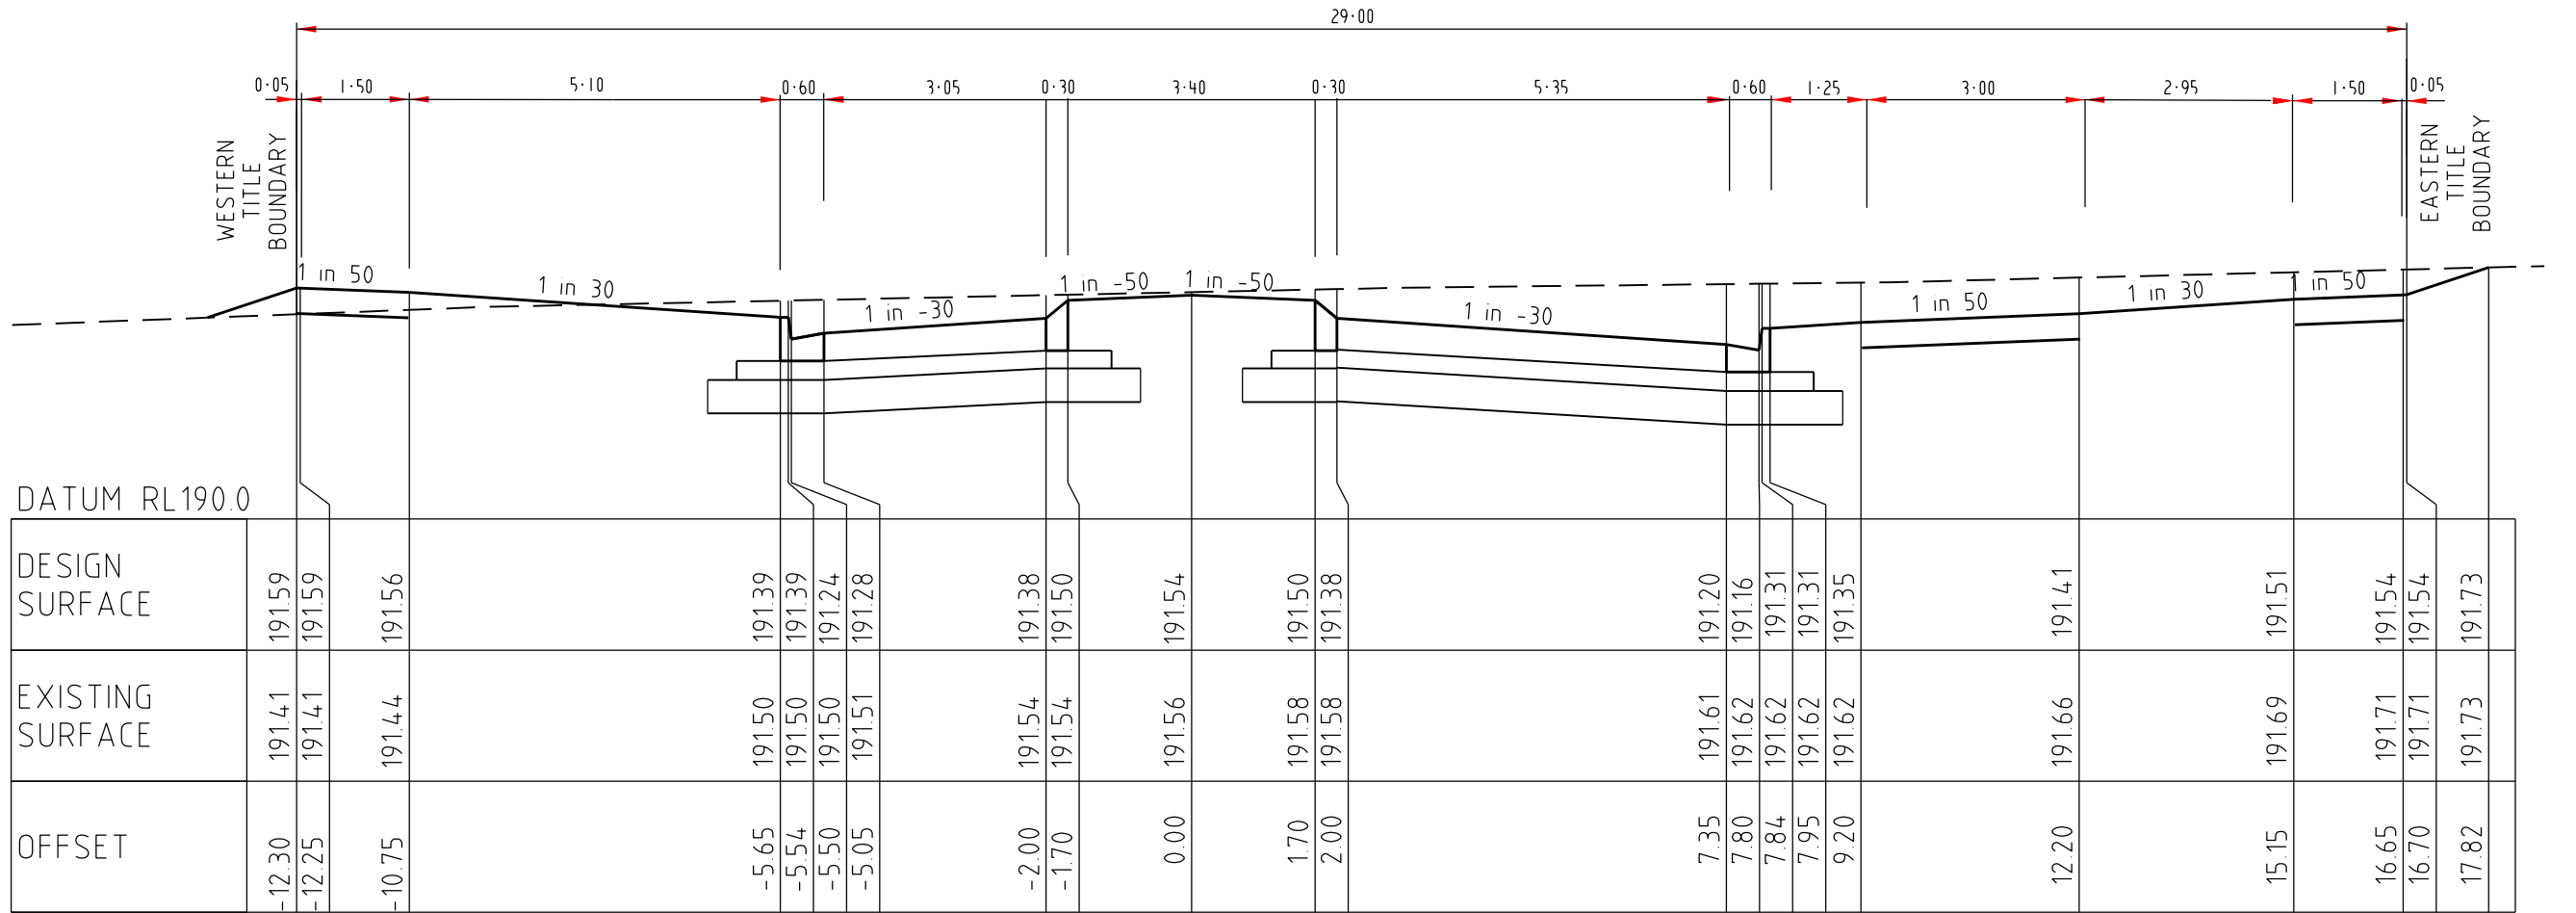


348.33


AS CONSTRUCTED

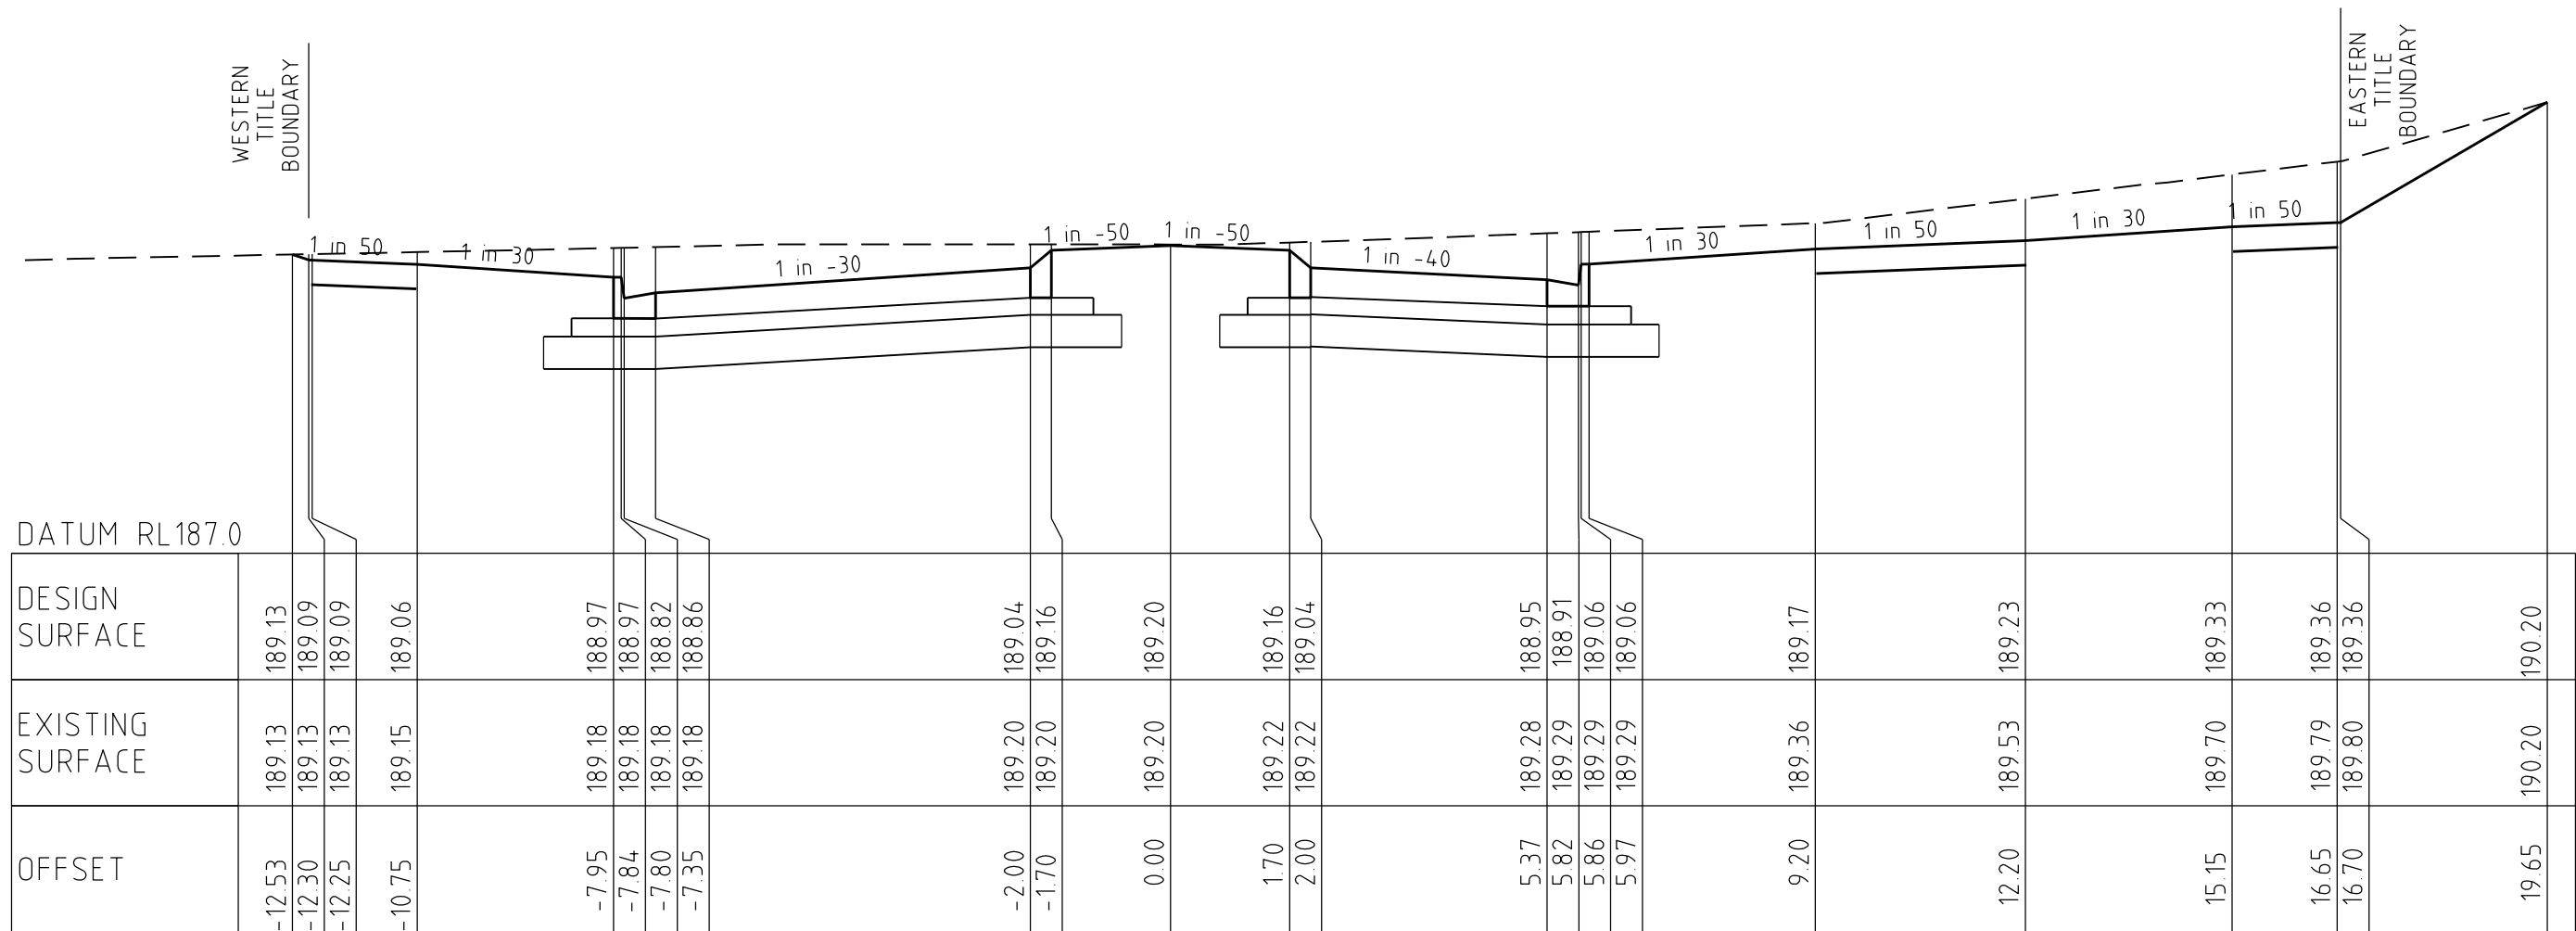


226.47

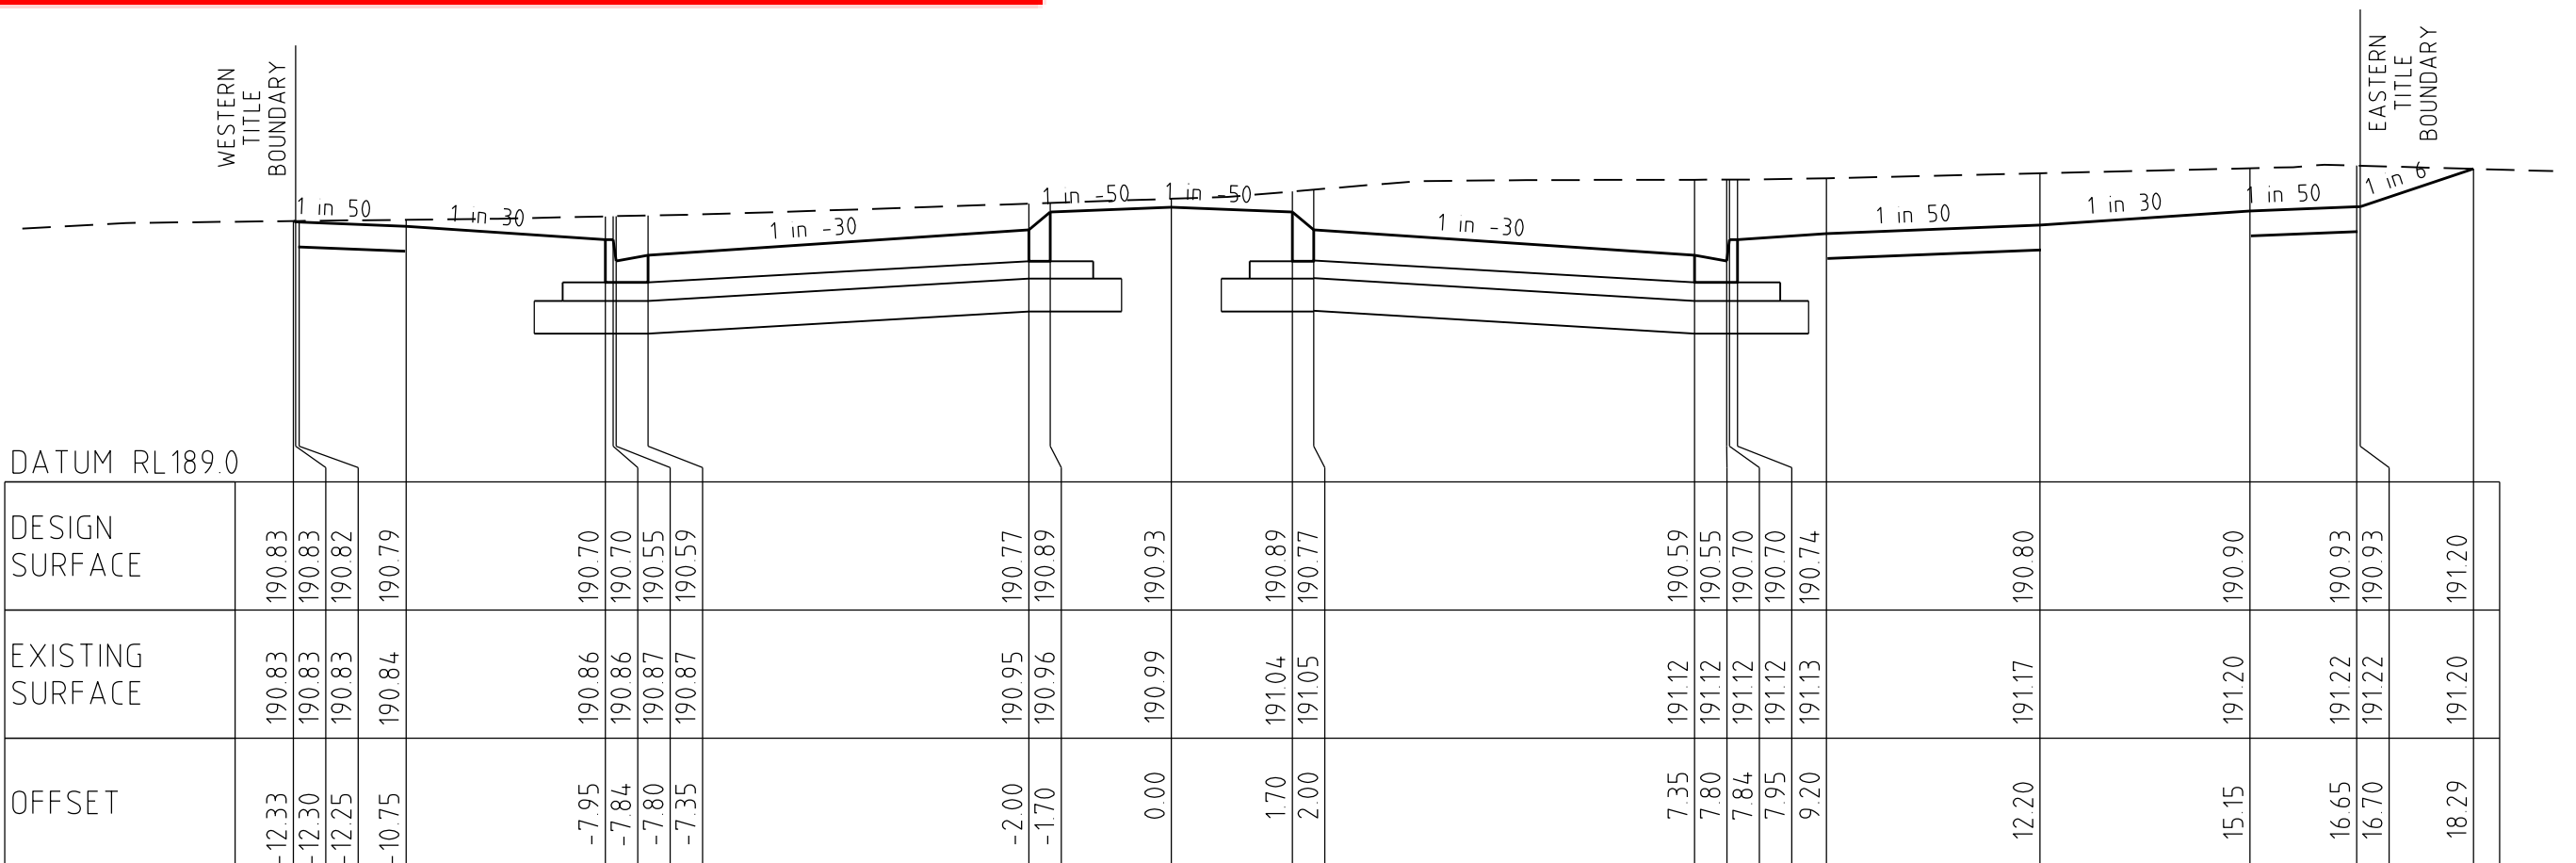


322.75

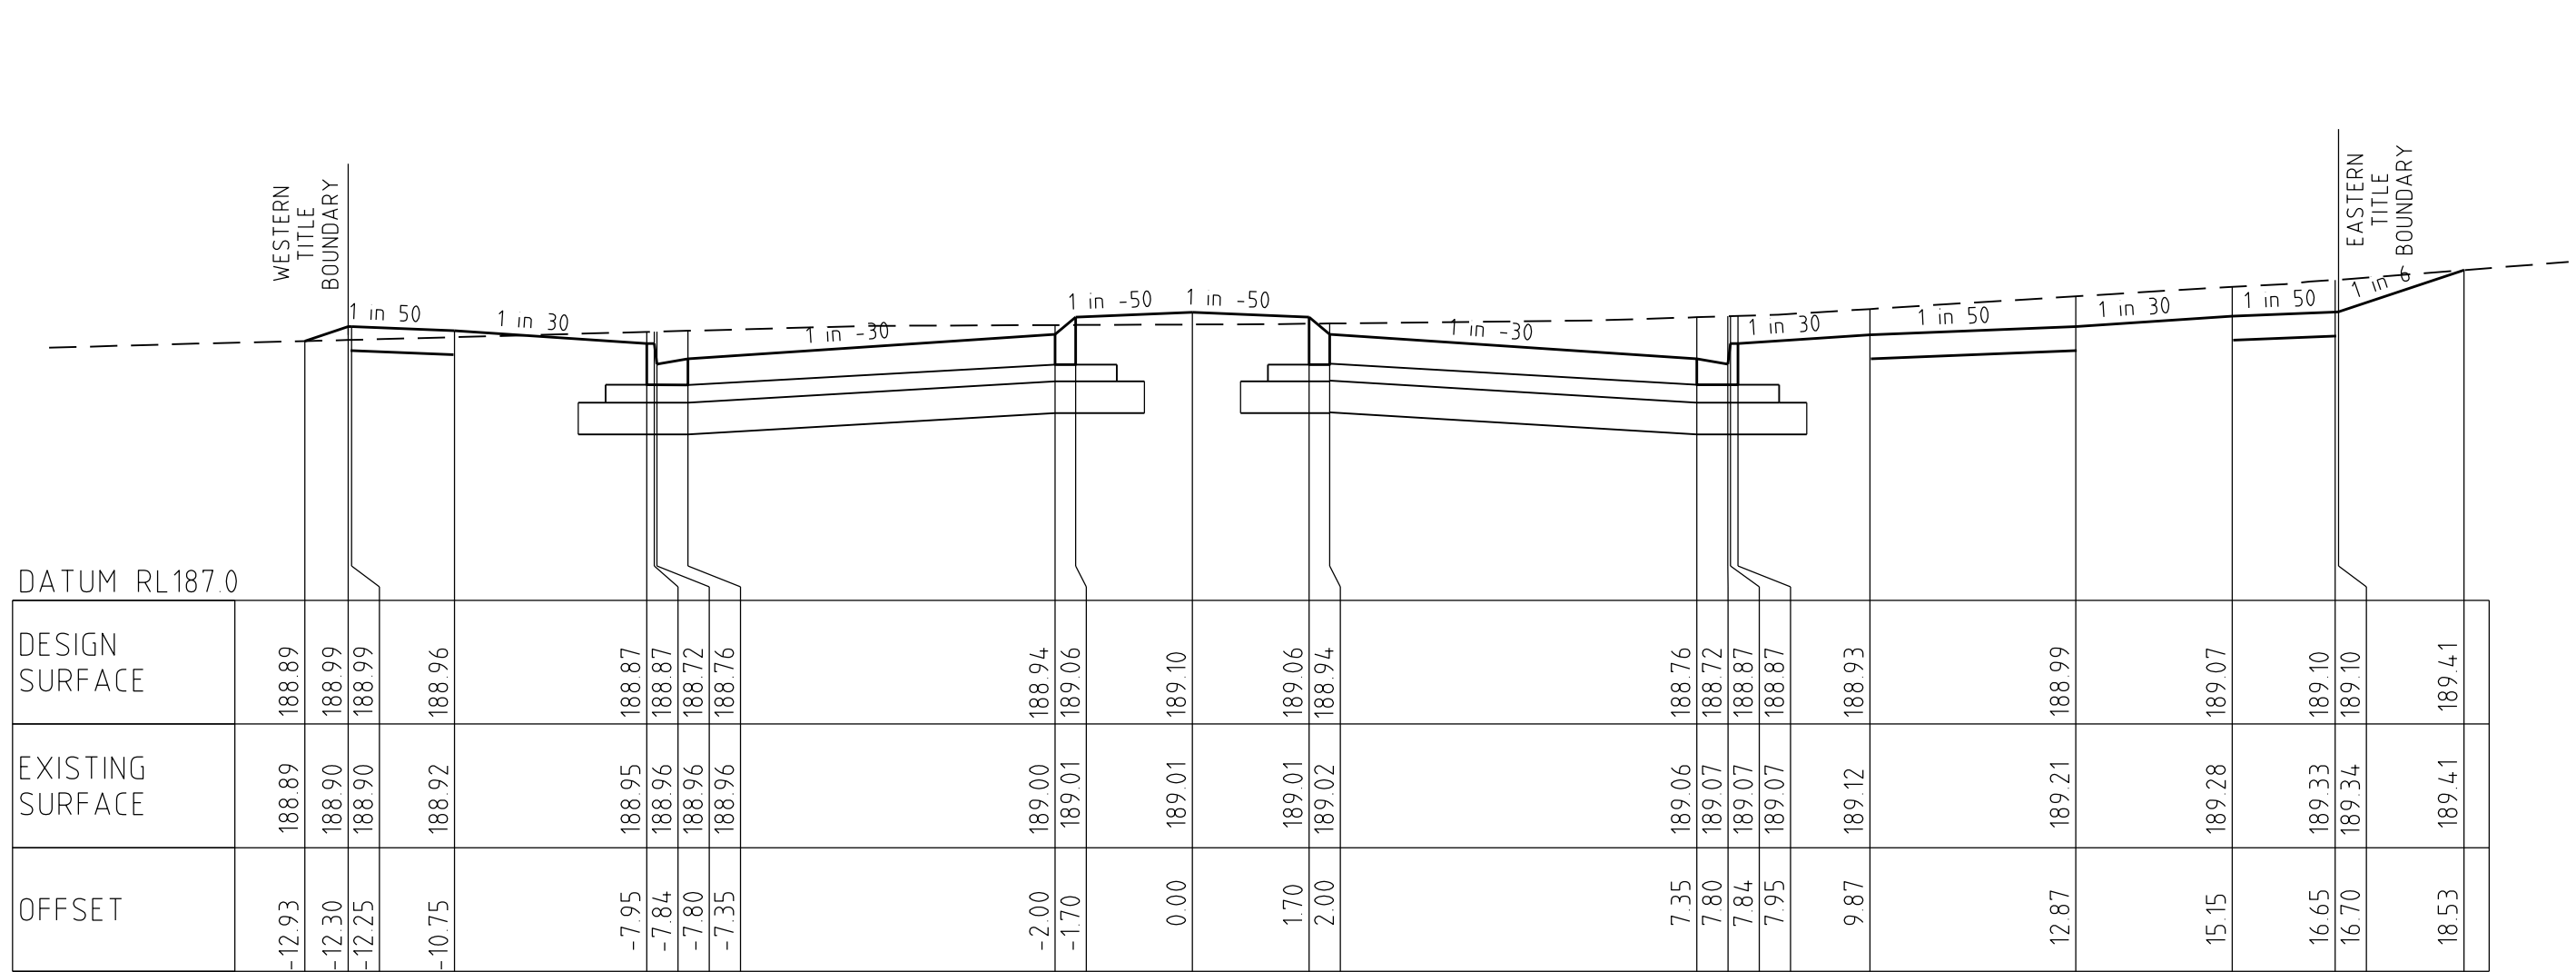






206.68

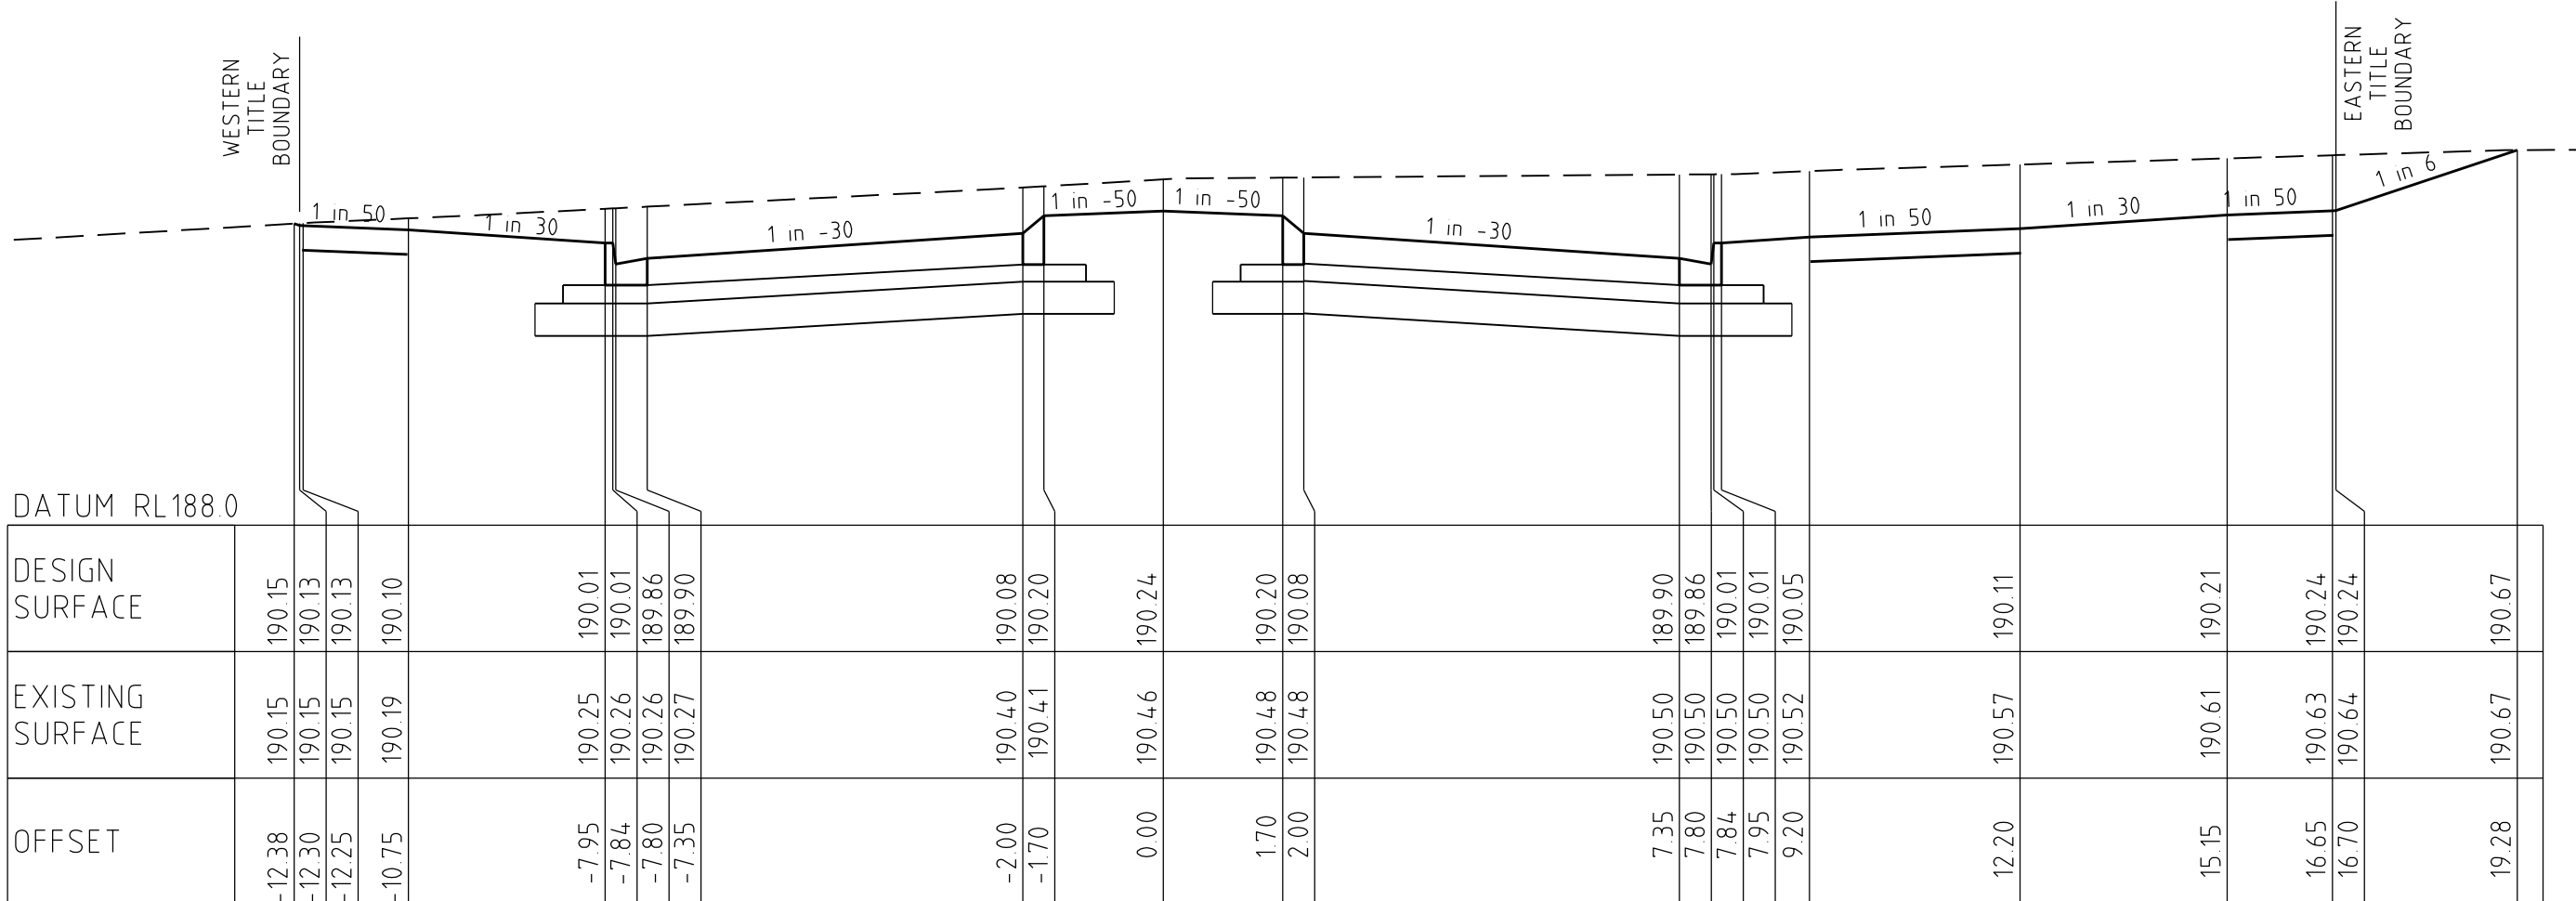


293.73

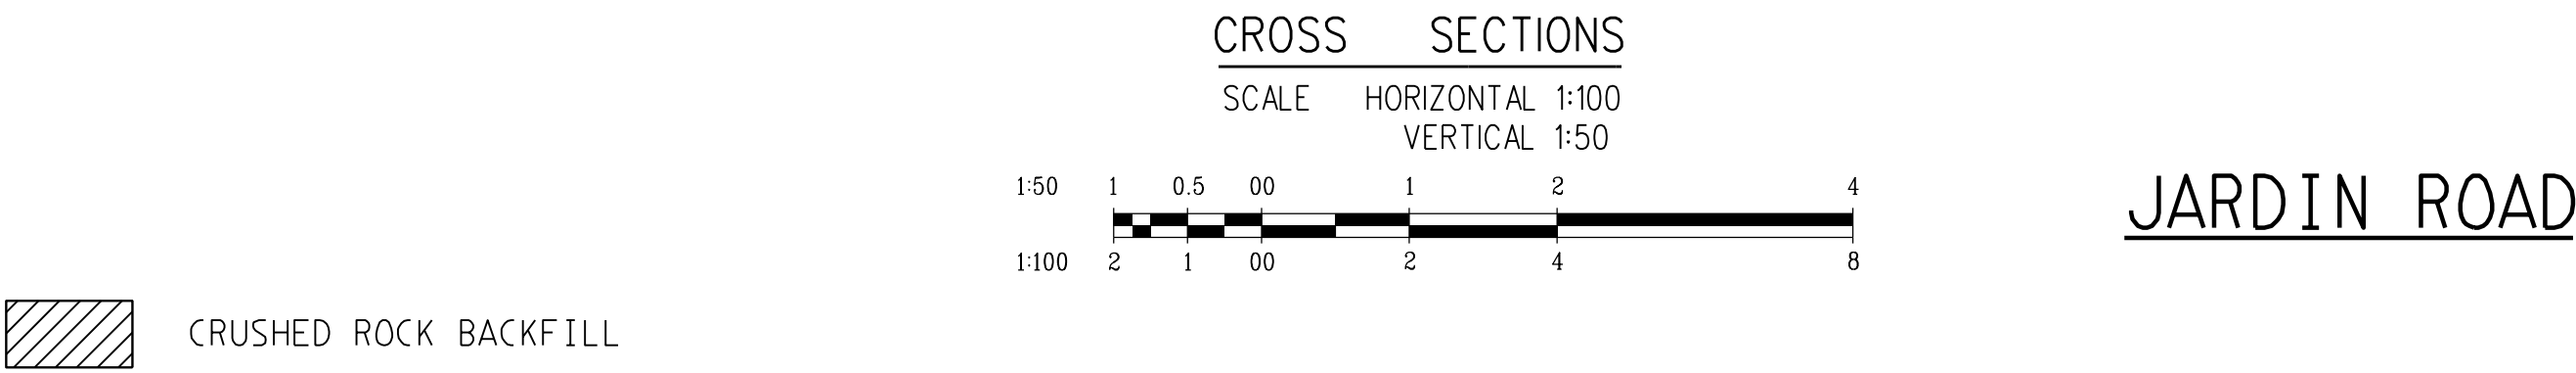


AMENDMENTS		bpd breese pitt dixon Pty. Ltd. land surveyors civil engineers		1/19 cato street hawthorn east, 3123 telephone 8823 2300 fax no. 8823 2310	
		MELWAY REF.	388-C-10	RATHDOWNE ESTATE STAGE 1 JARDIN ROAD	
		SURVEY	SPIIRE	MUNICIPALITY WHITTLESEA	
		DESIGN	SS	REFERENCE 9365 E/1	
		DRAWN	SS	SHEET 9 OF 19	
VER	DATE	REMARKS	CHECKED	SCALE	AS SHOWN
				DATUM	AHD
				DATE	JAN '17

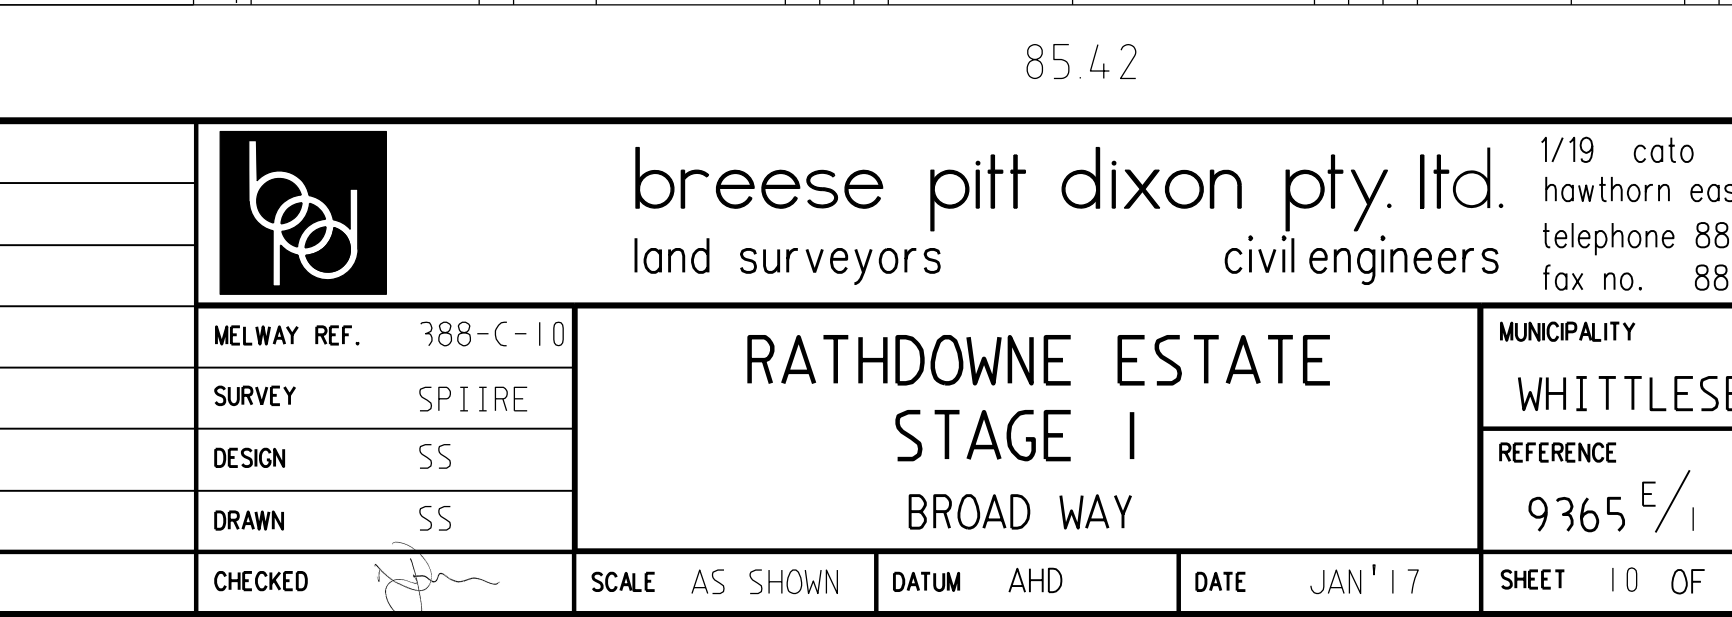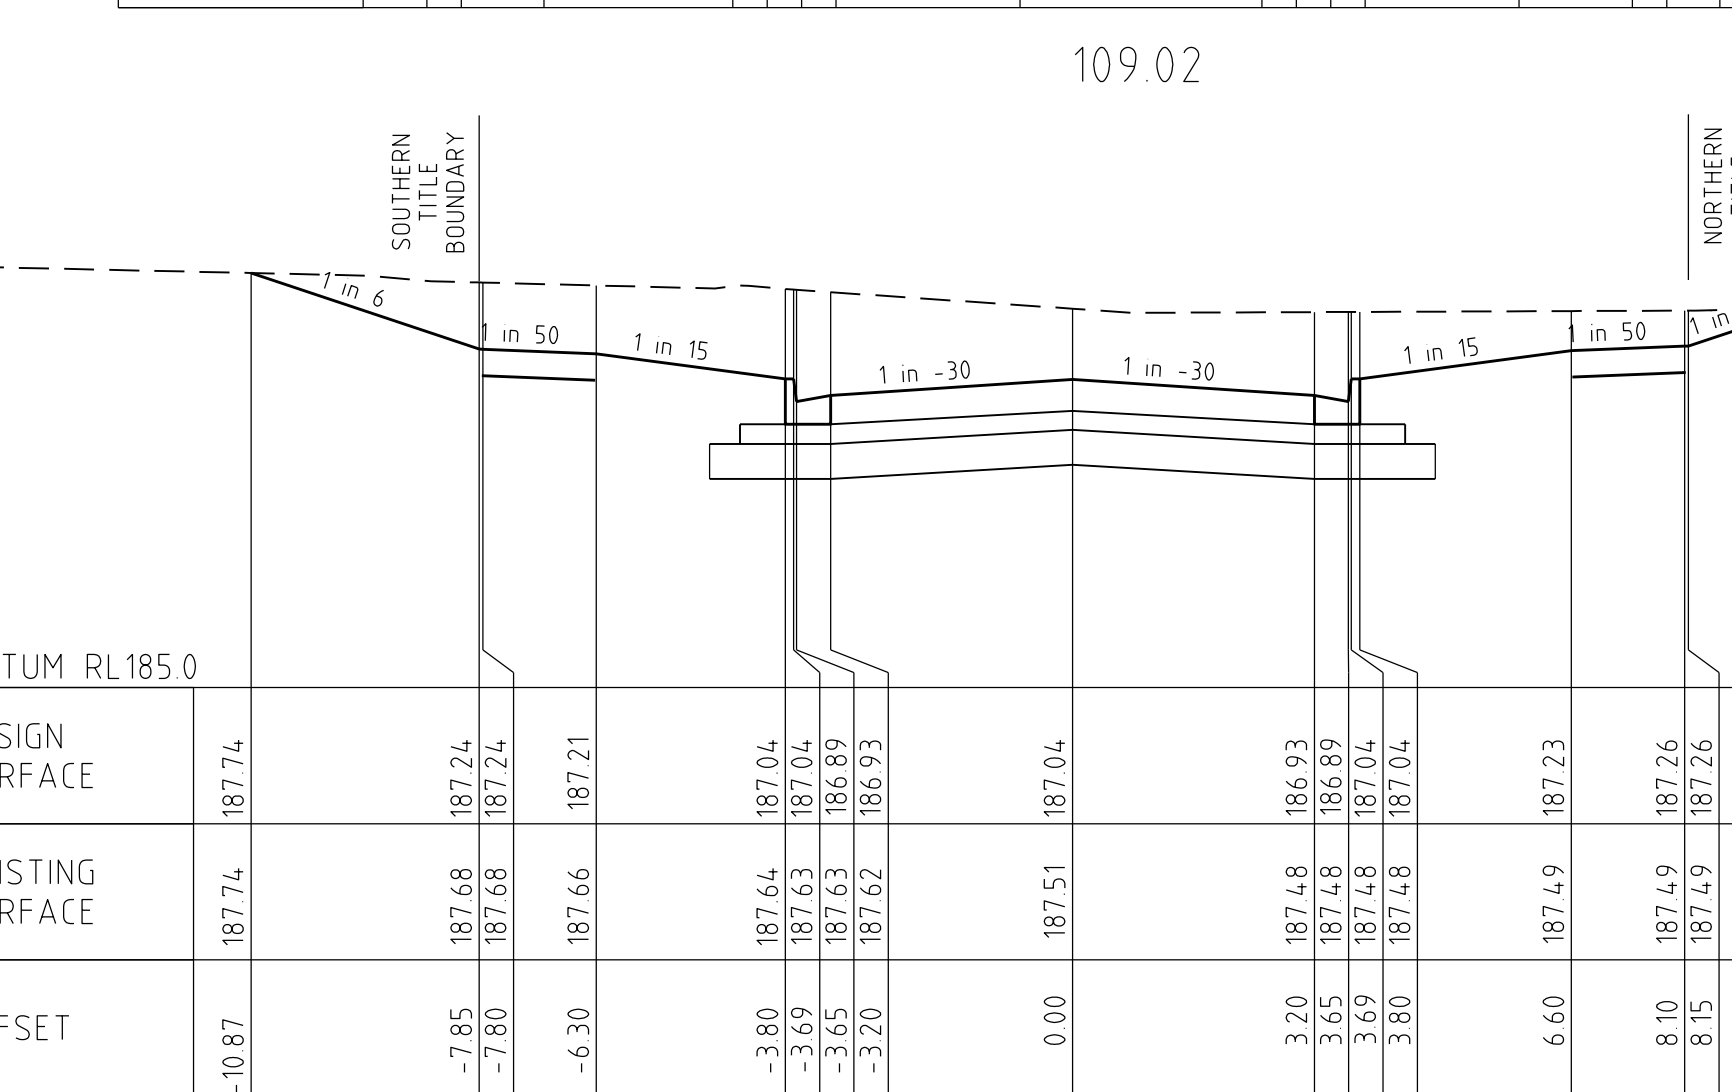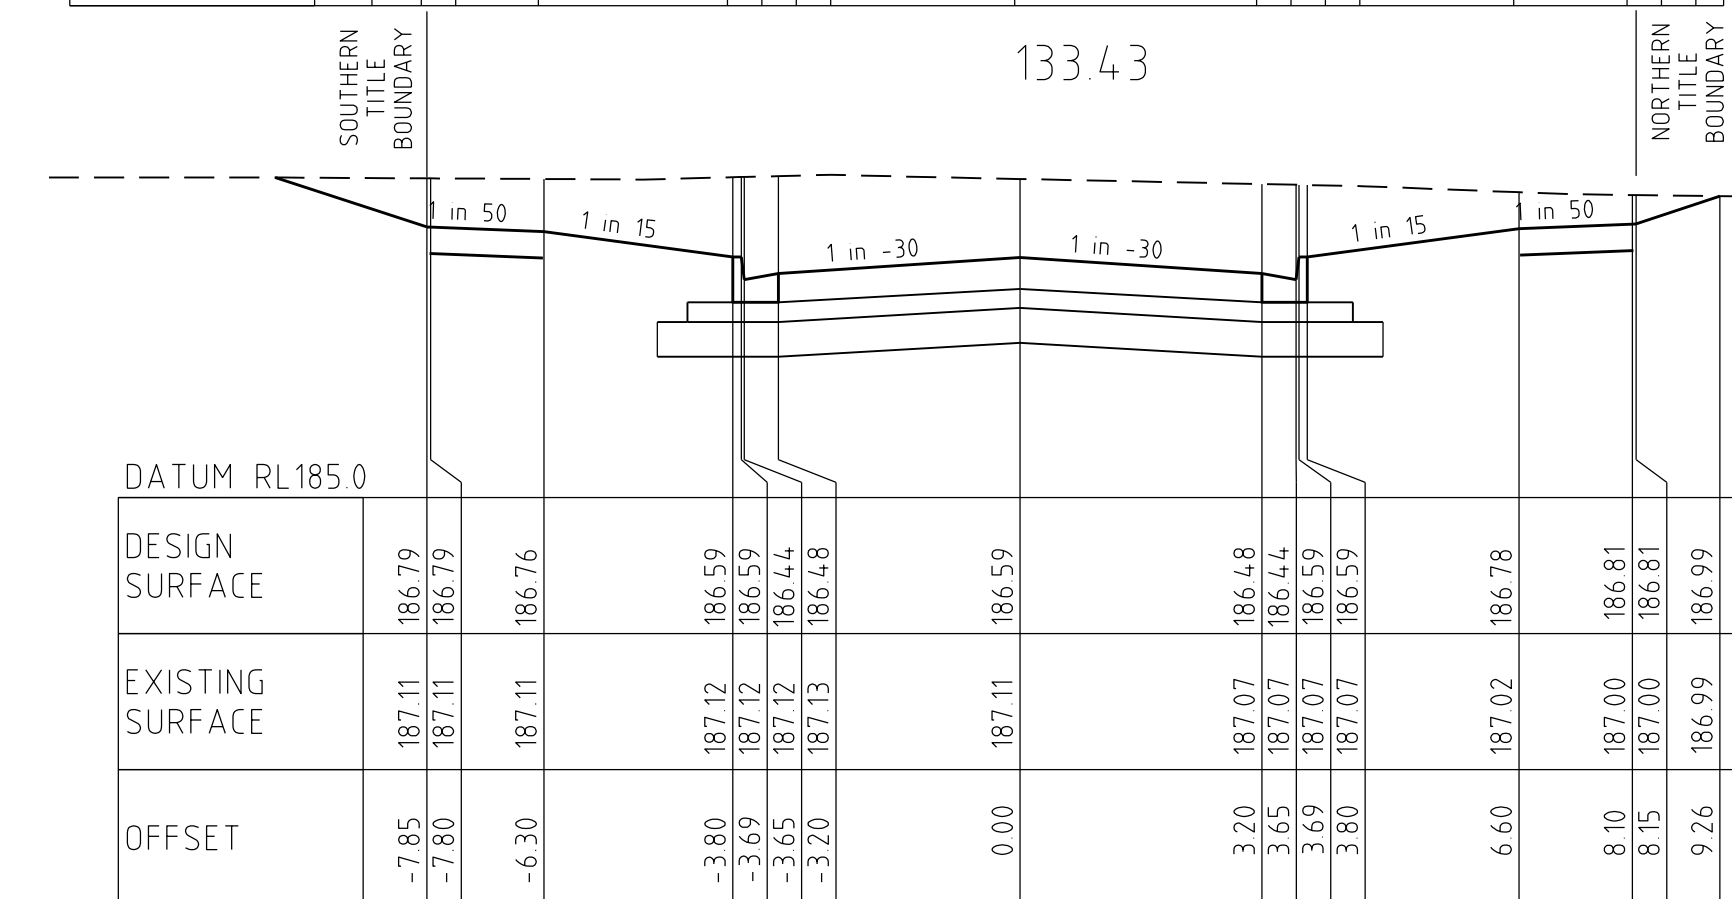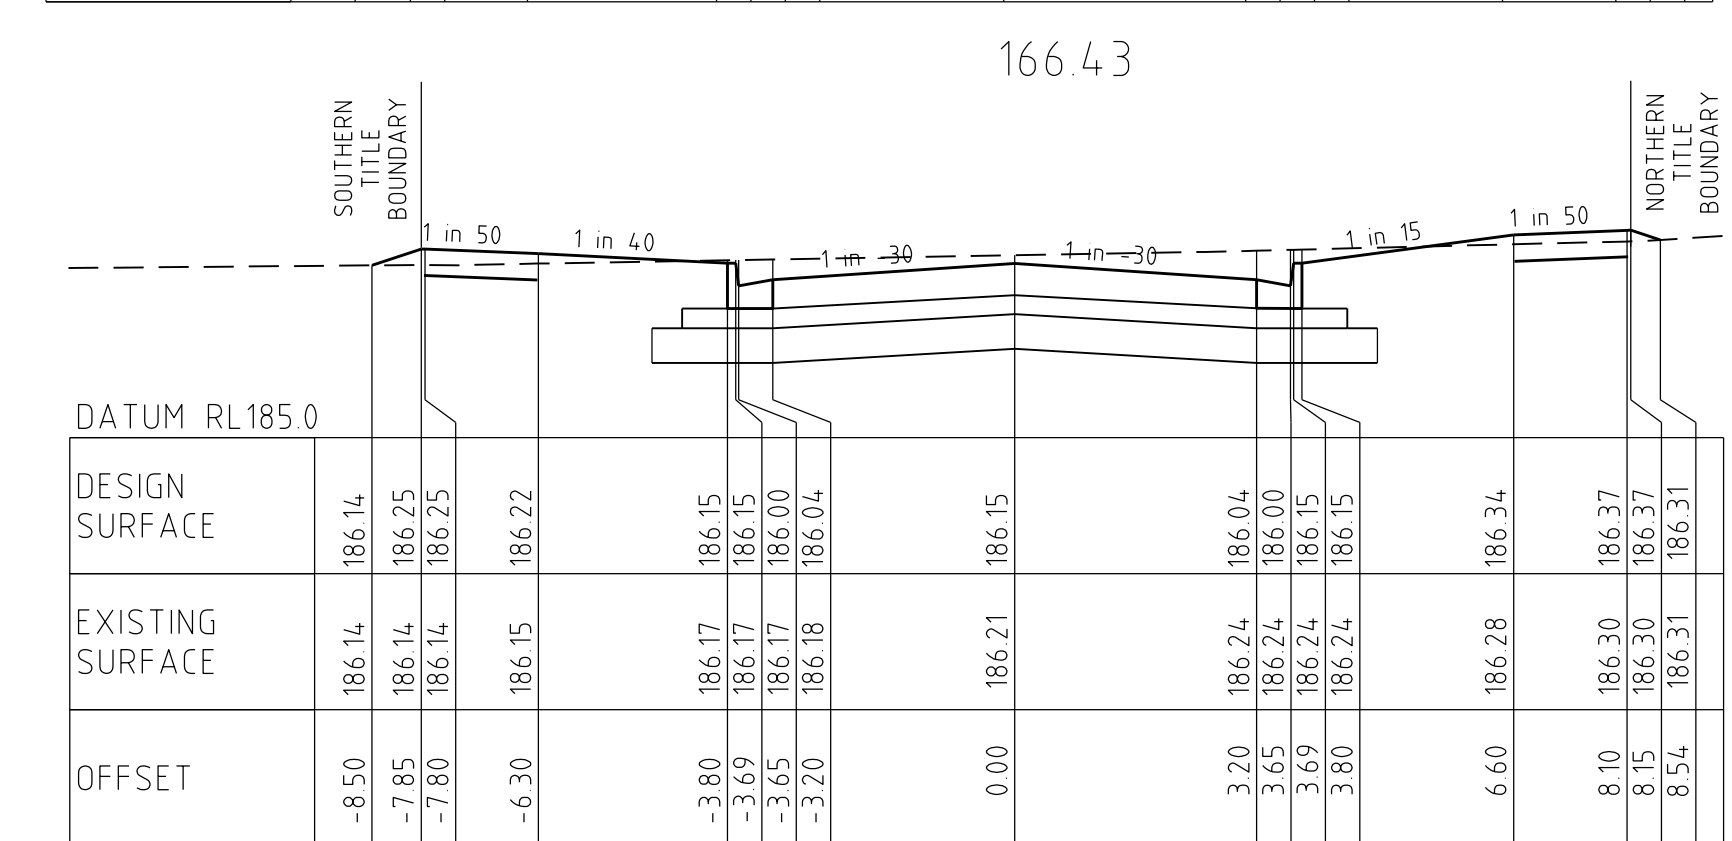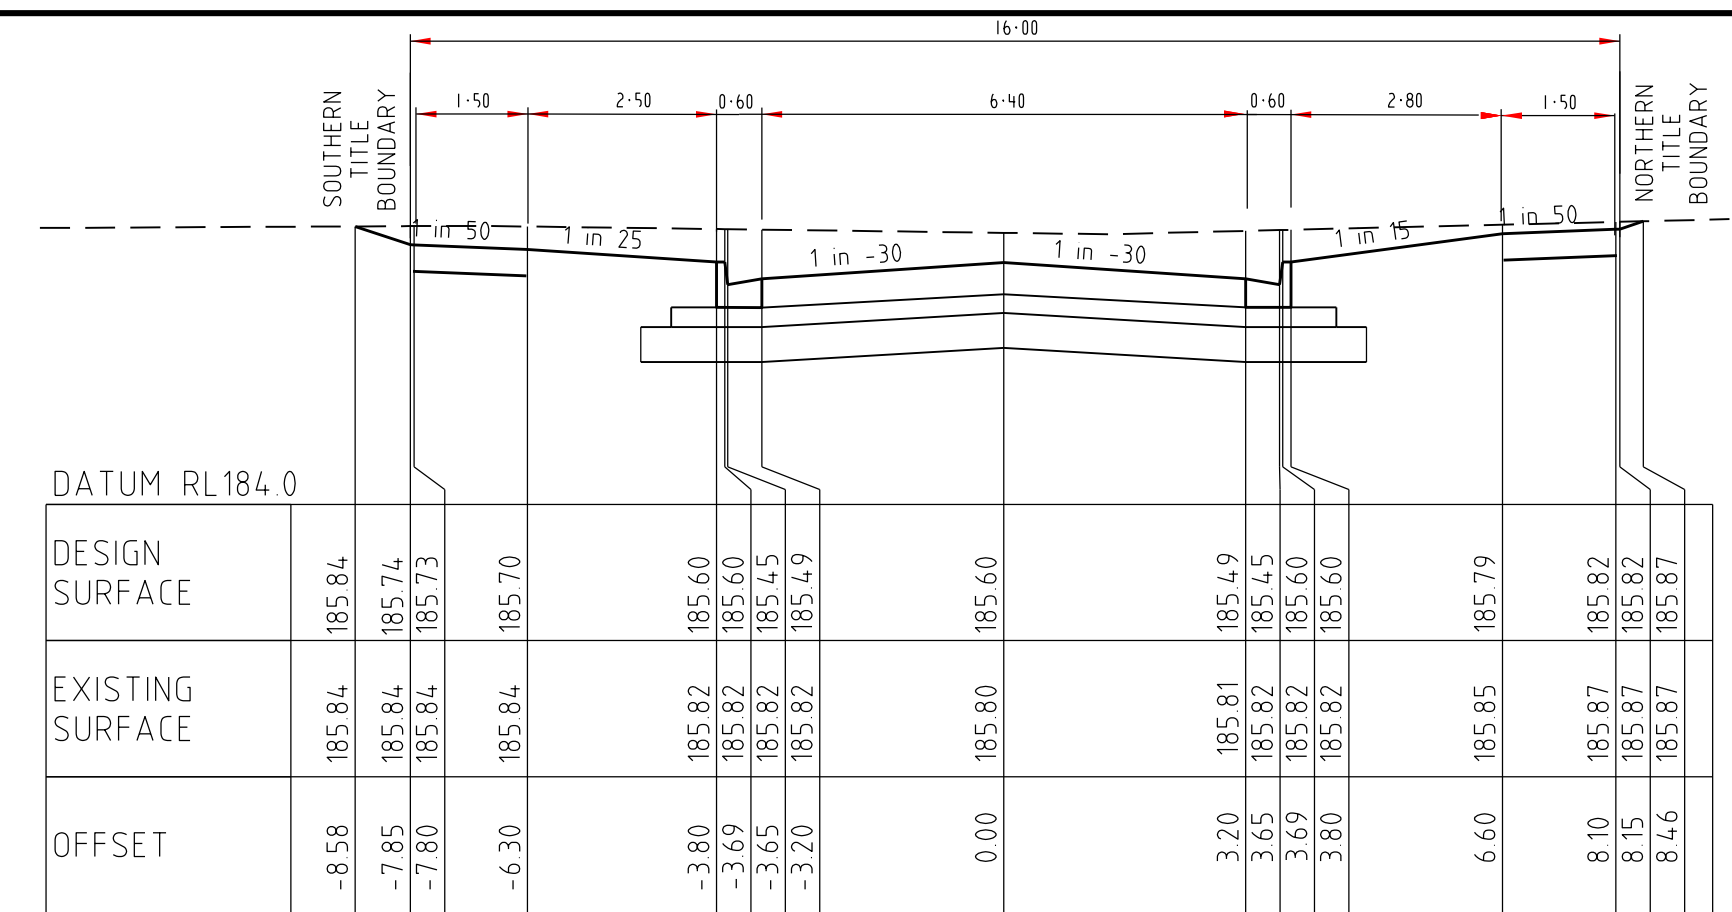


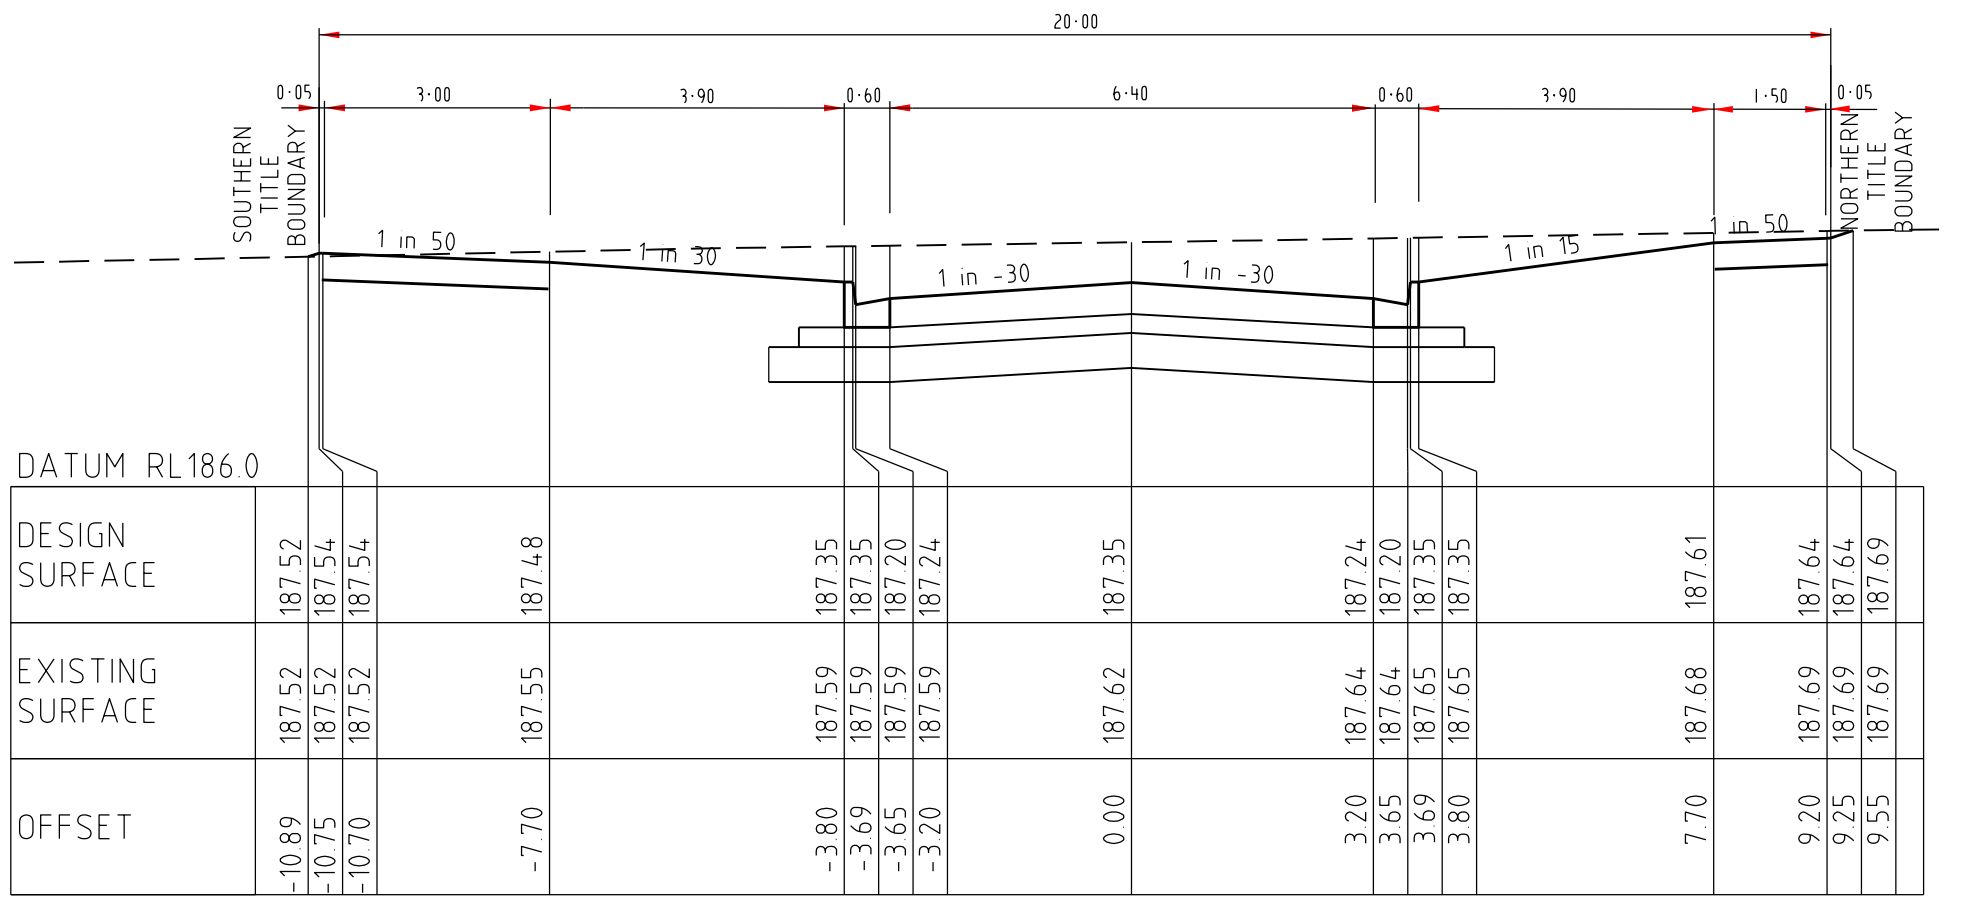


398.69

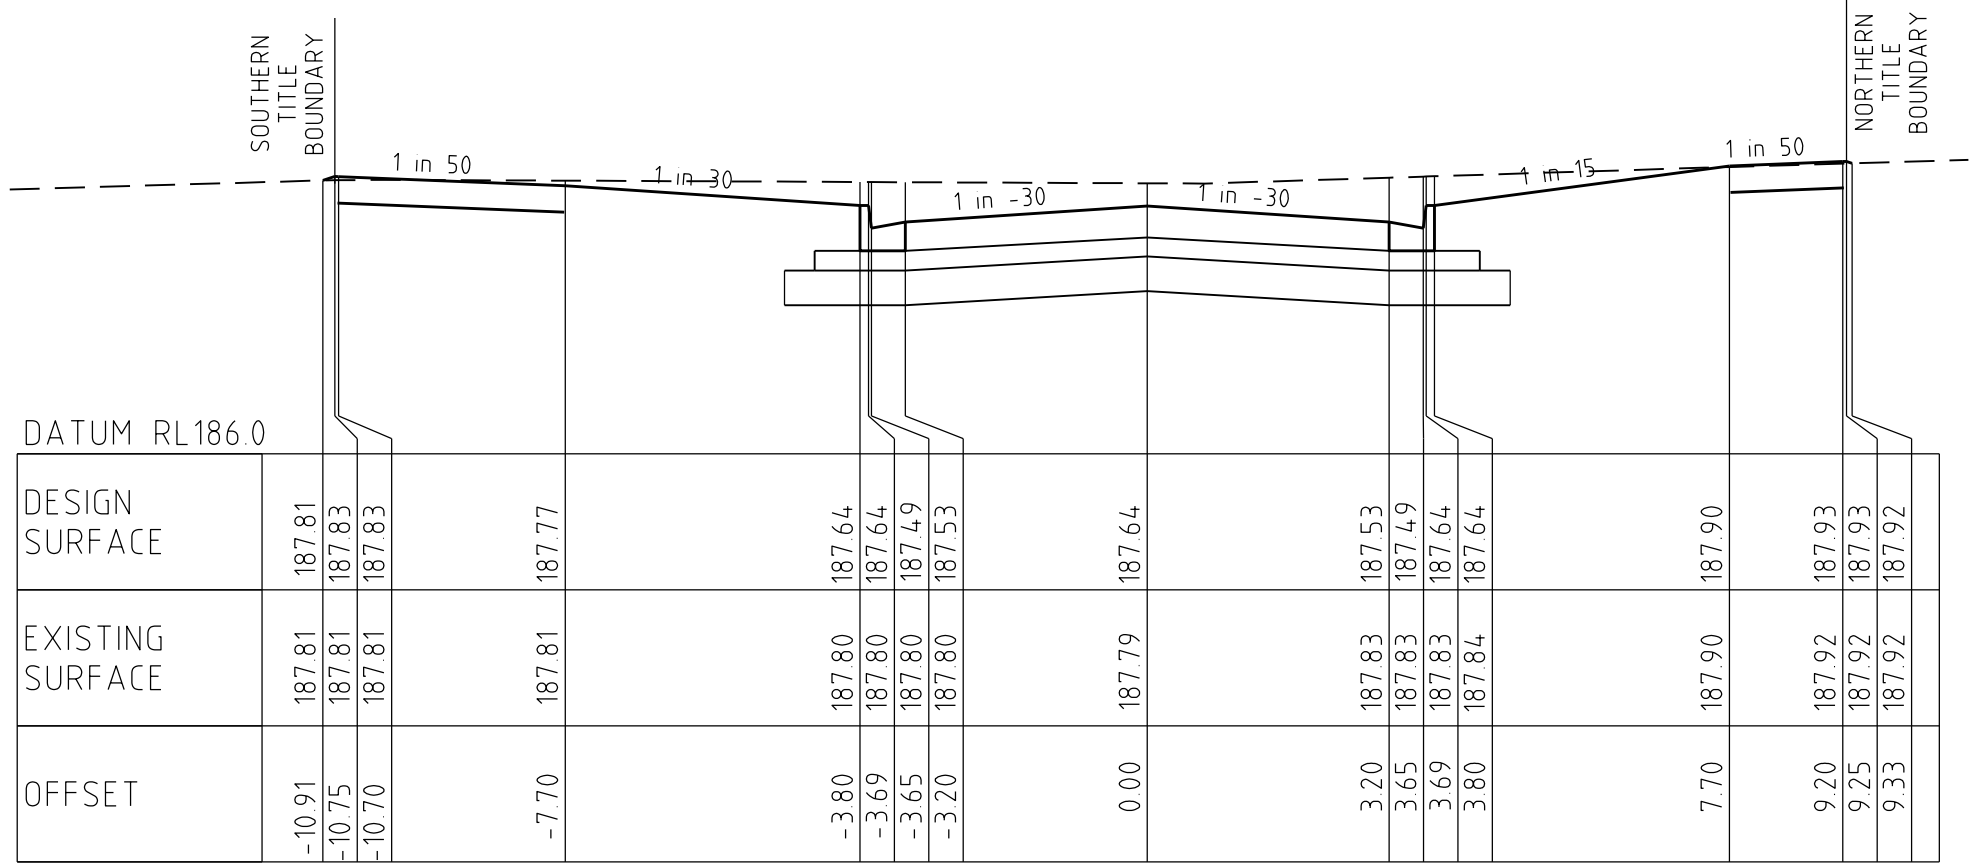


380.69

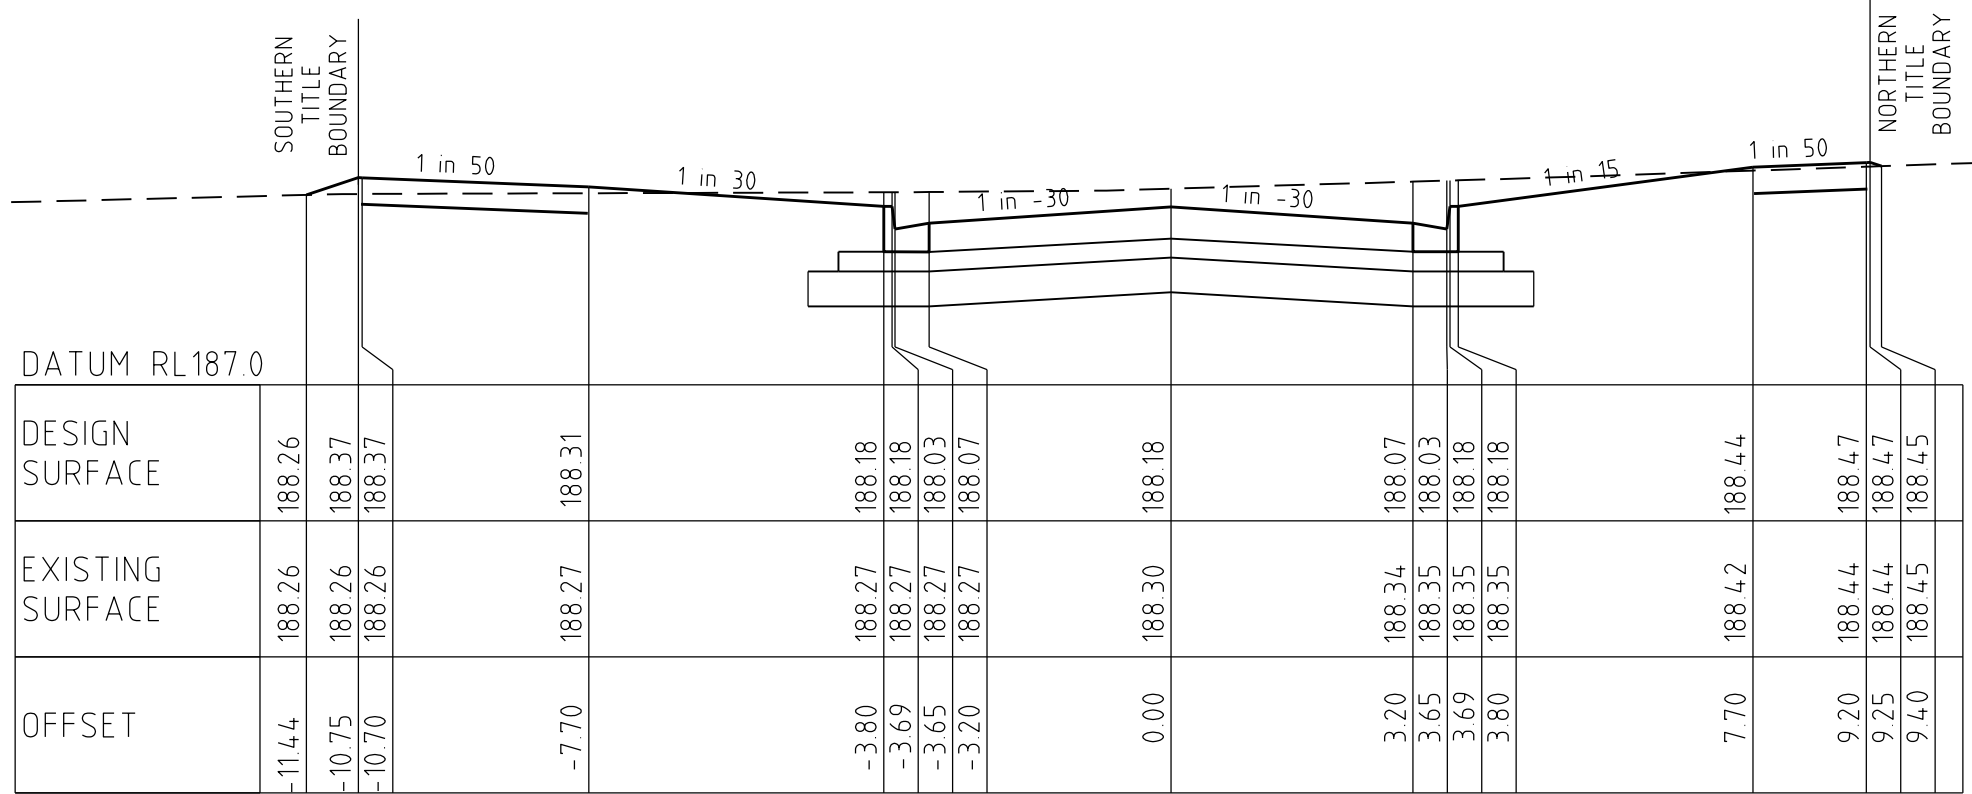

350.69

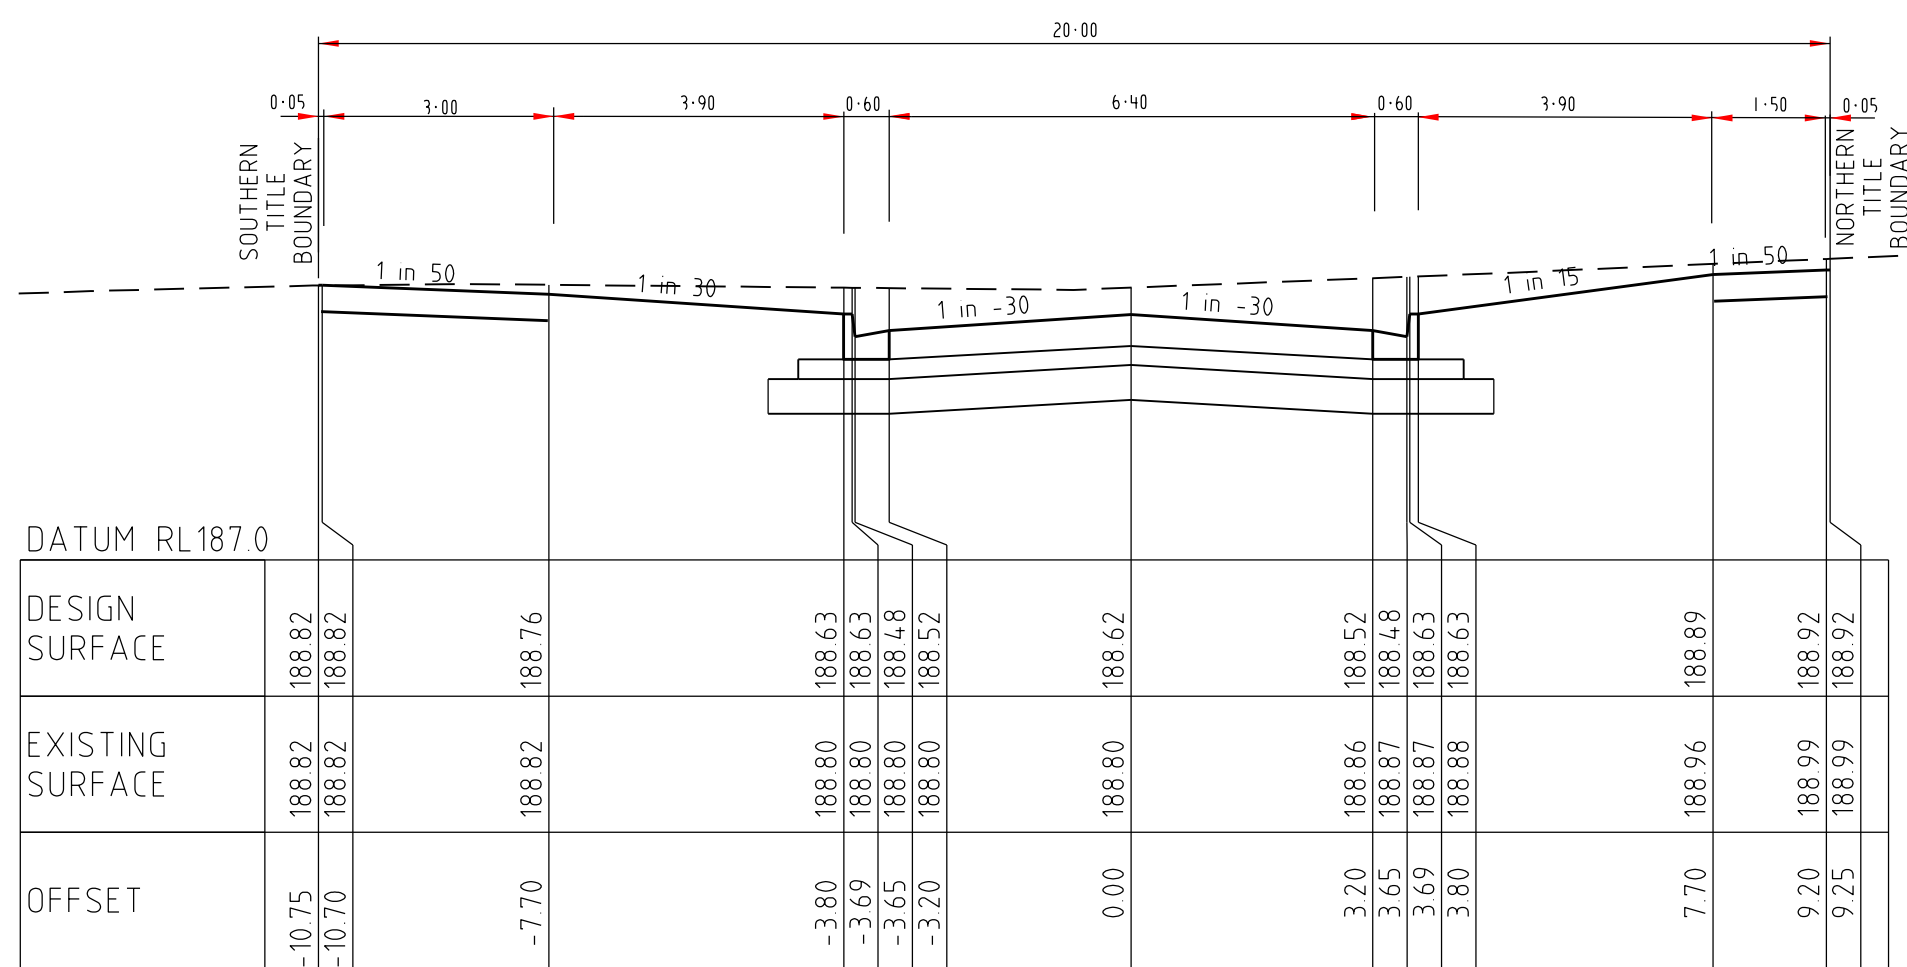


327.03

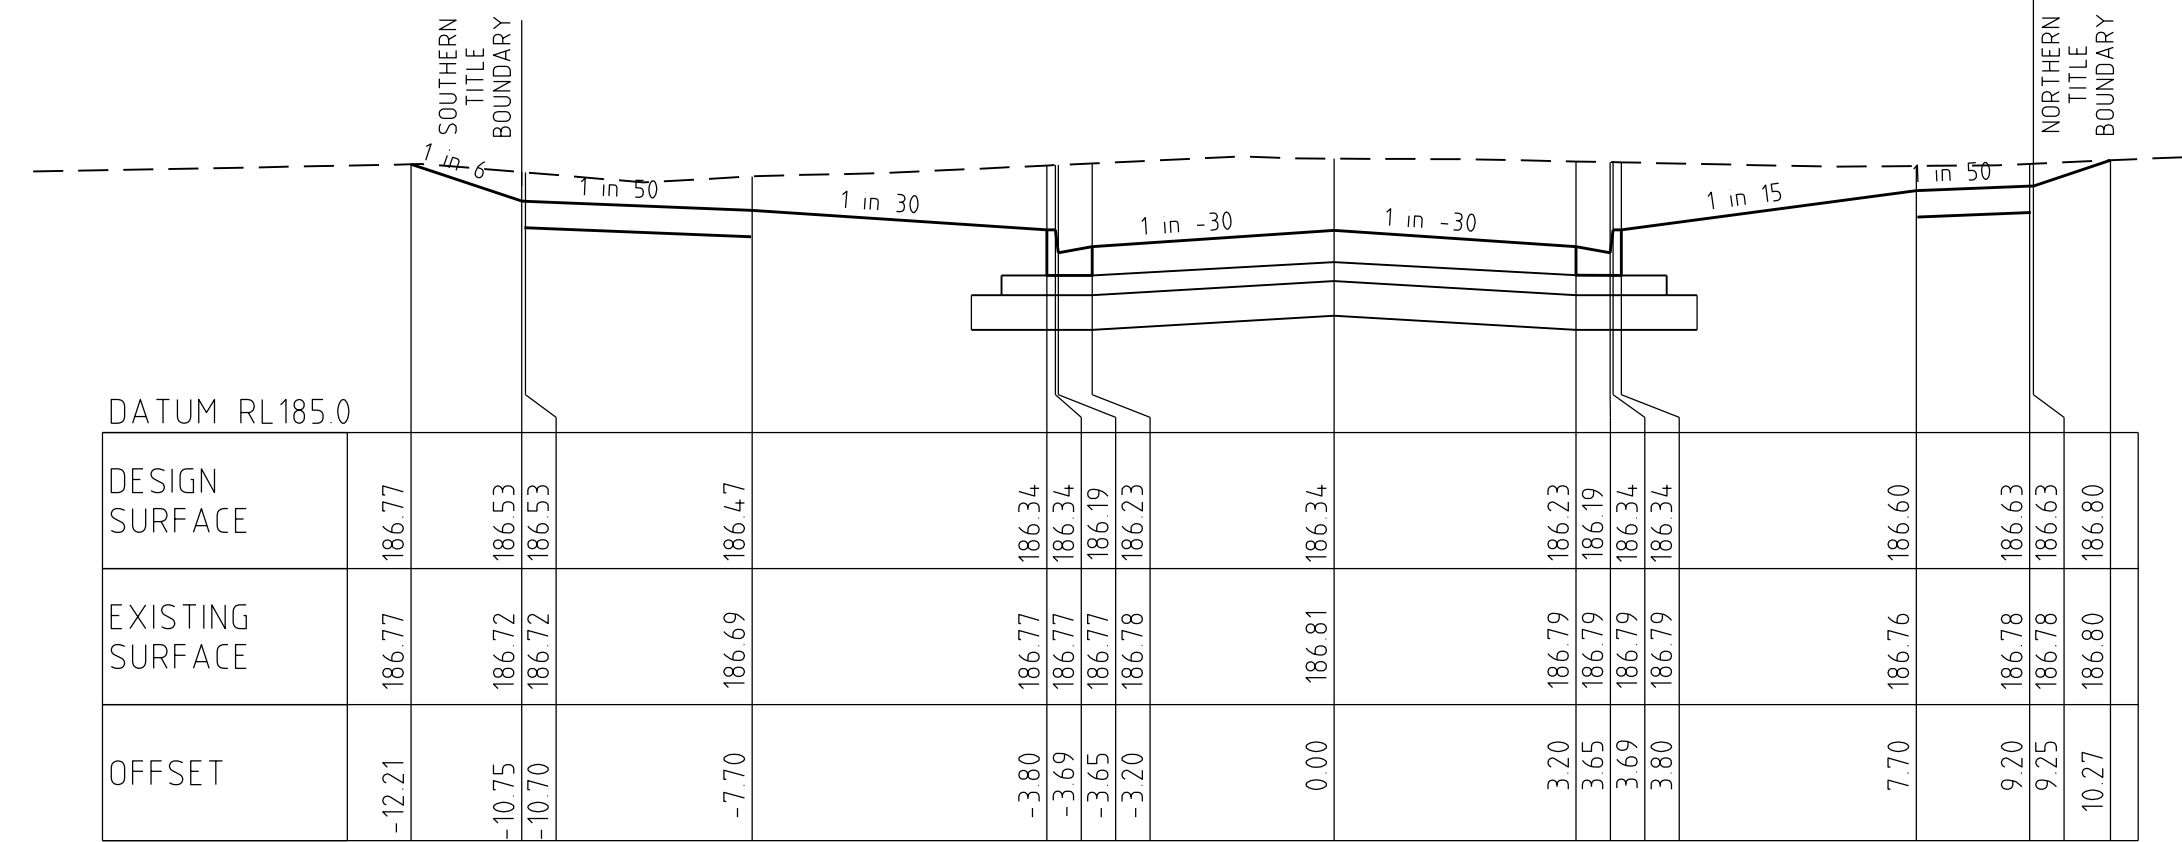


461.69

AS CONSTRUCTED

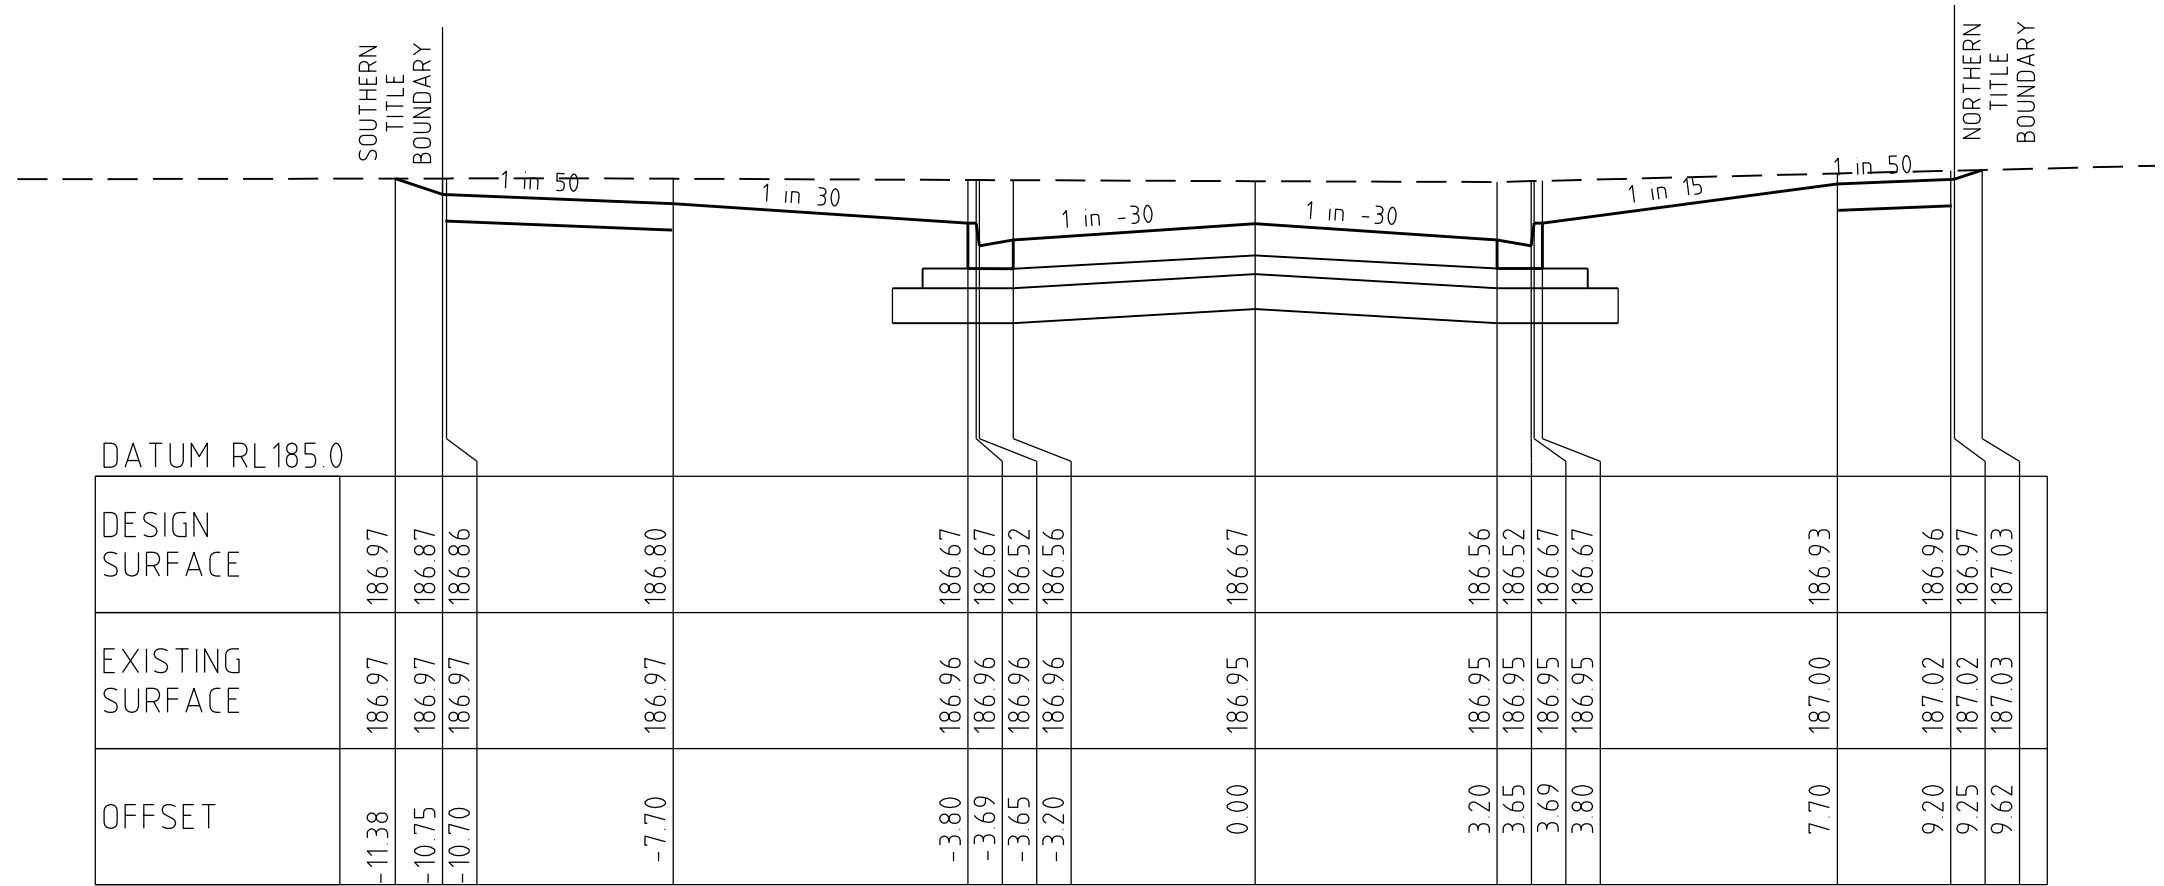

440.88


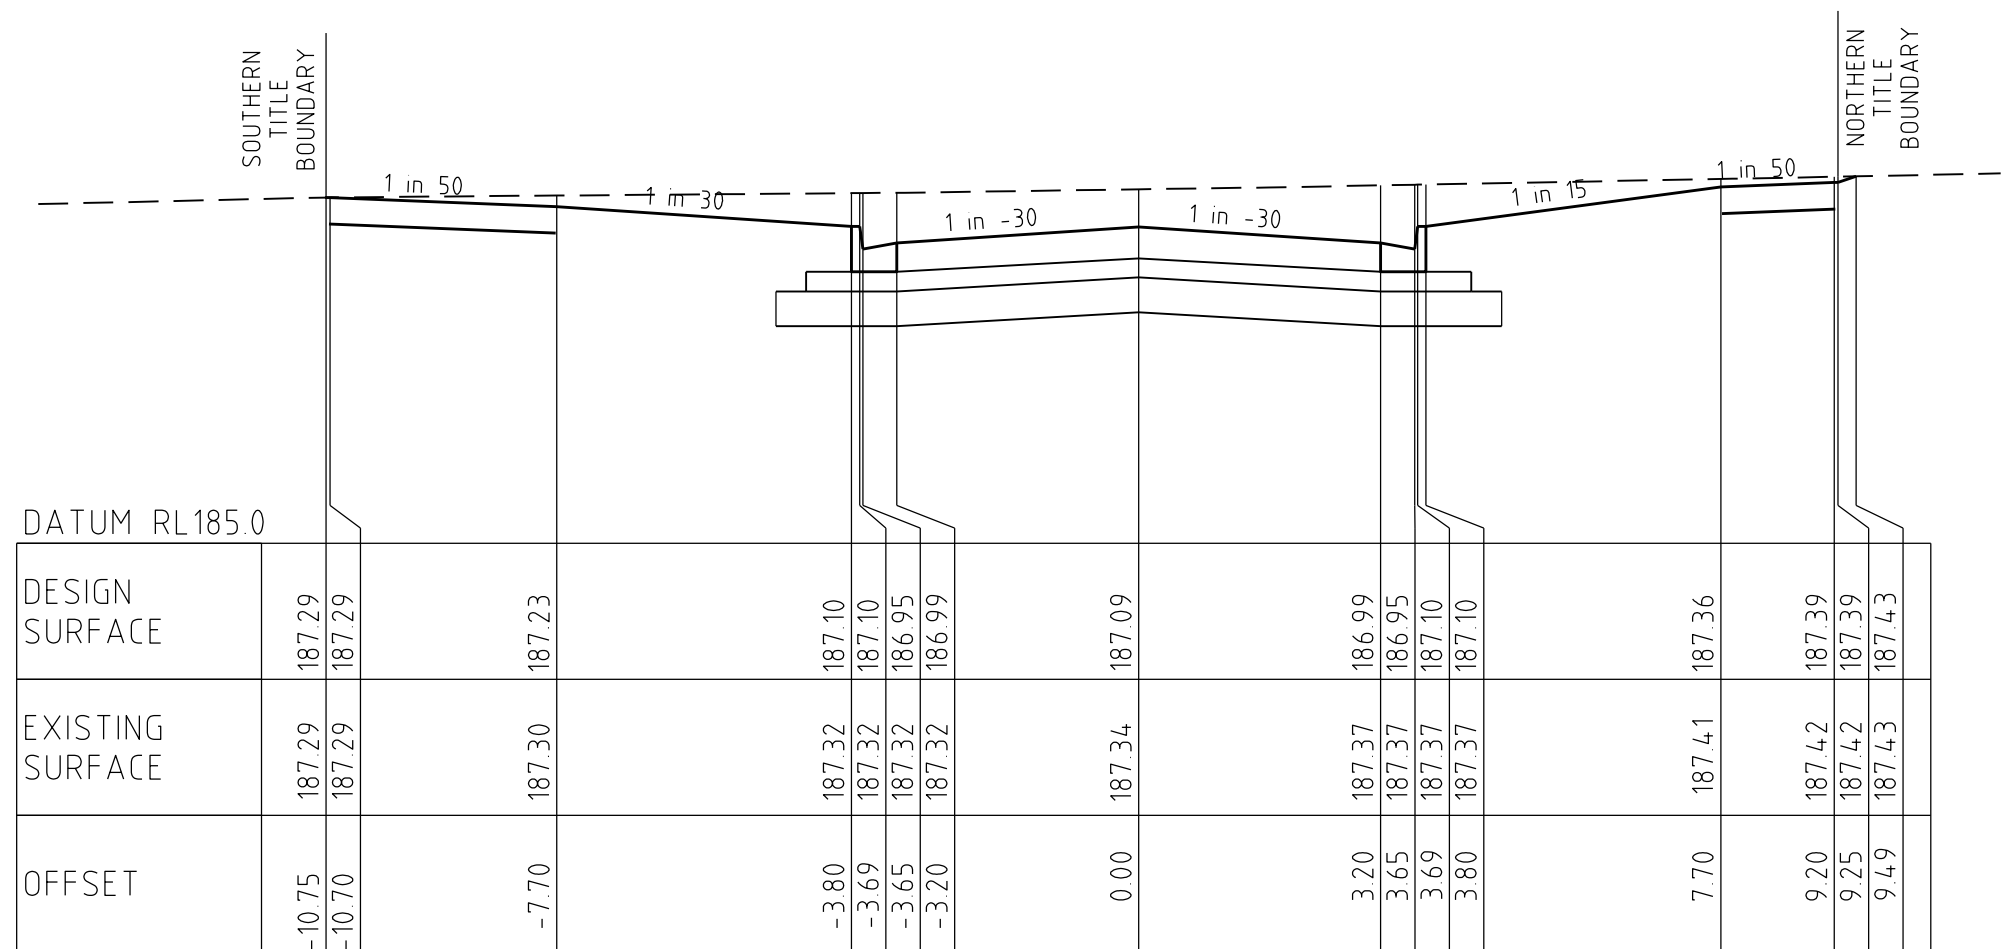


414.69

BRIGHTON AVENUE


CROSS SECTIONS

SCALE HORIZONTAL 1:100
VERTICAL 1:50

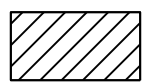
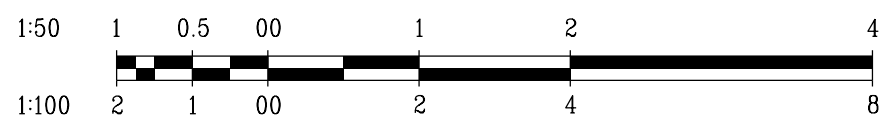


CRUSHED ROCK BACKFILL

AMENDMENTS				breese pitt dixon pty. ltd. land surveyors civil engineers		1/19 cato street hawthorn east, 3123 telephone 8823 2300 fax no. 8823 2310	
		MELWAY REF. 388-C-10		RATHDOWNE ESTATE STAGE 1 BRIGHTON AVENUE		MUNICIPALITY WHITTLESEA	
		SURVEY SPIIRE				REFERENCE 9365 E/I	
		DESIGN SS					
		DRAWN SS					
VER	DATE	REMARKS		CHECKED	SCALE AS SHOWN	DATUM AHD	DATE JAN '17
A	19-12-17	ISSUED FOR CONSTRUCTION					
				SHEET 12 OF 19		A	




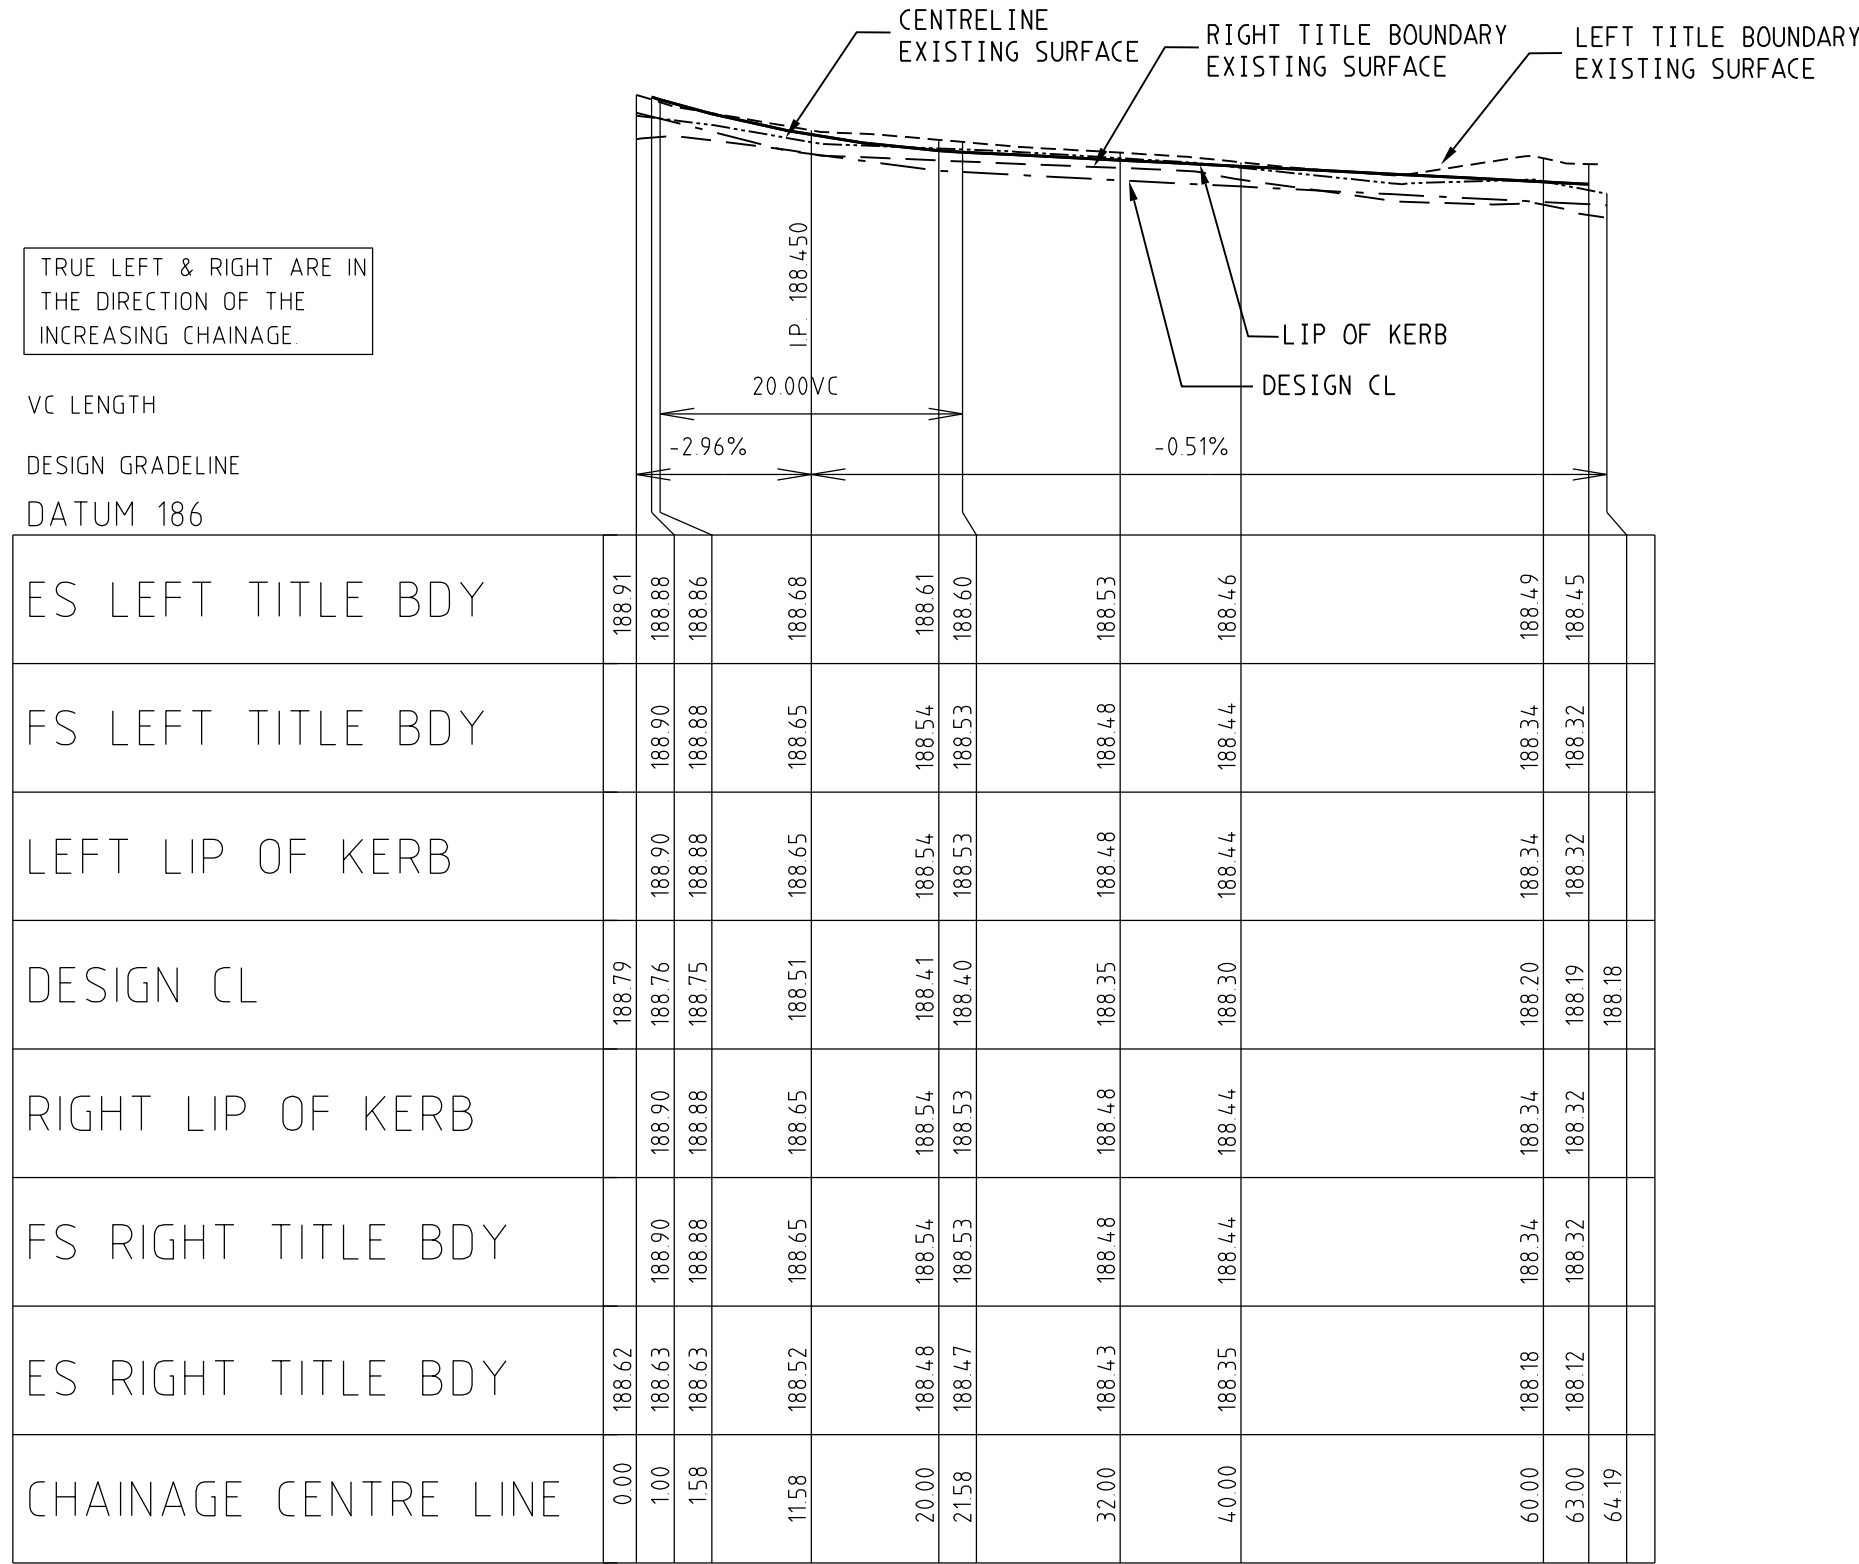


AS CONSTRUCTED

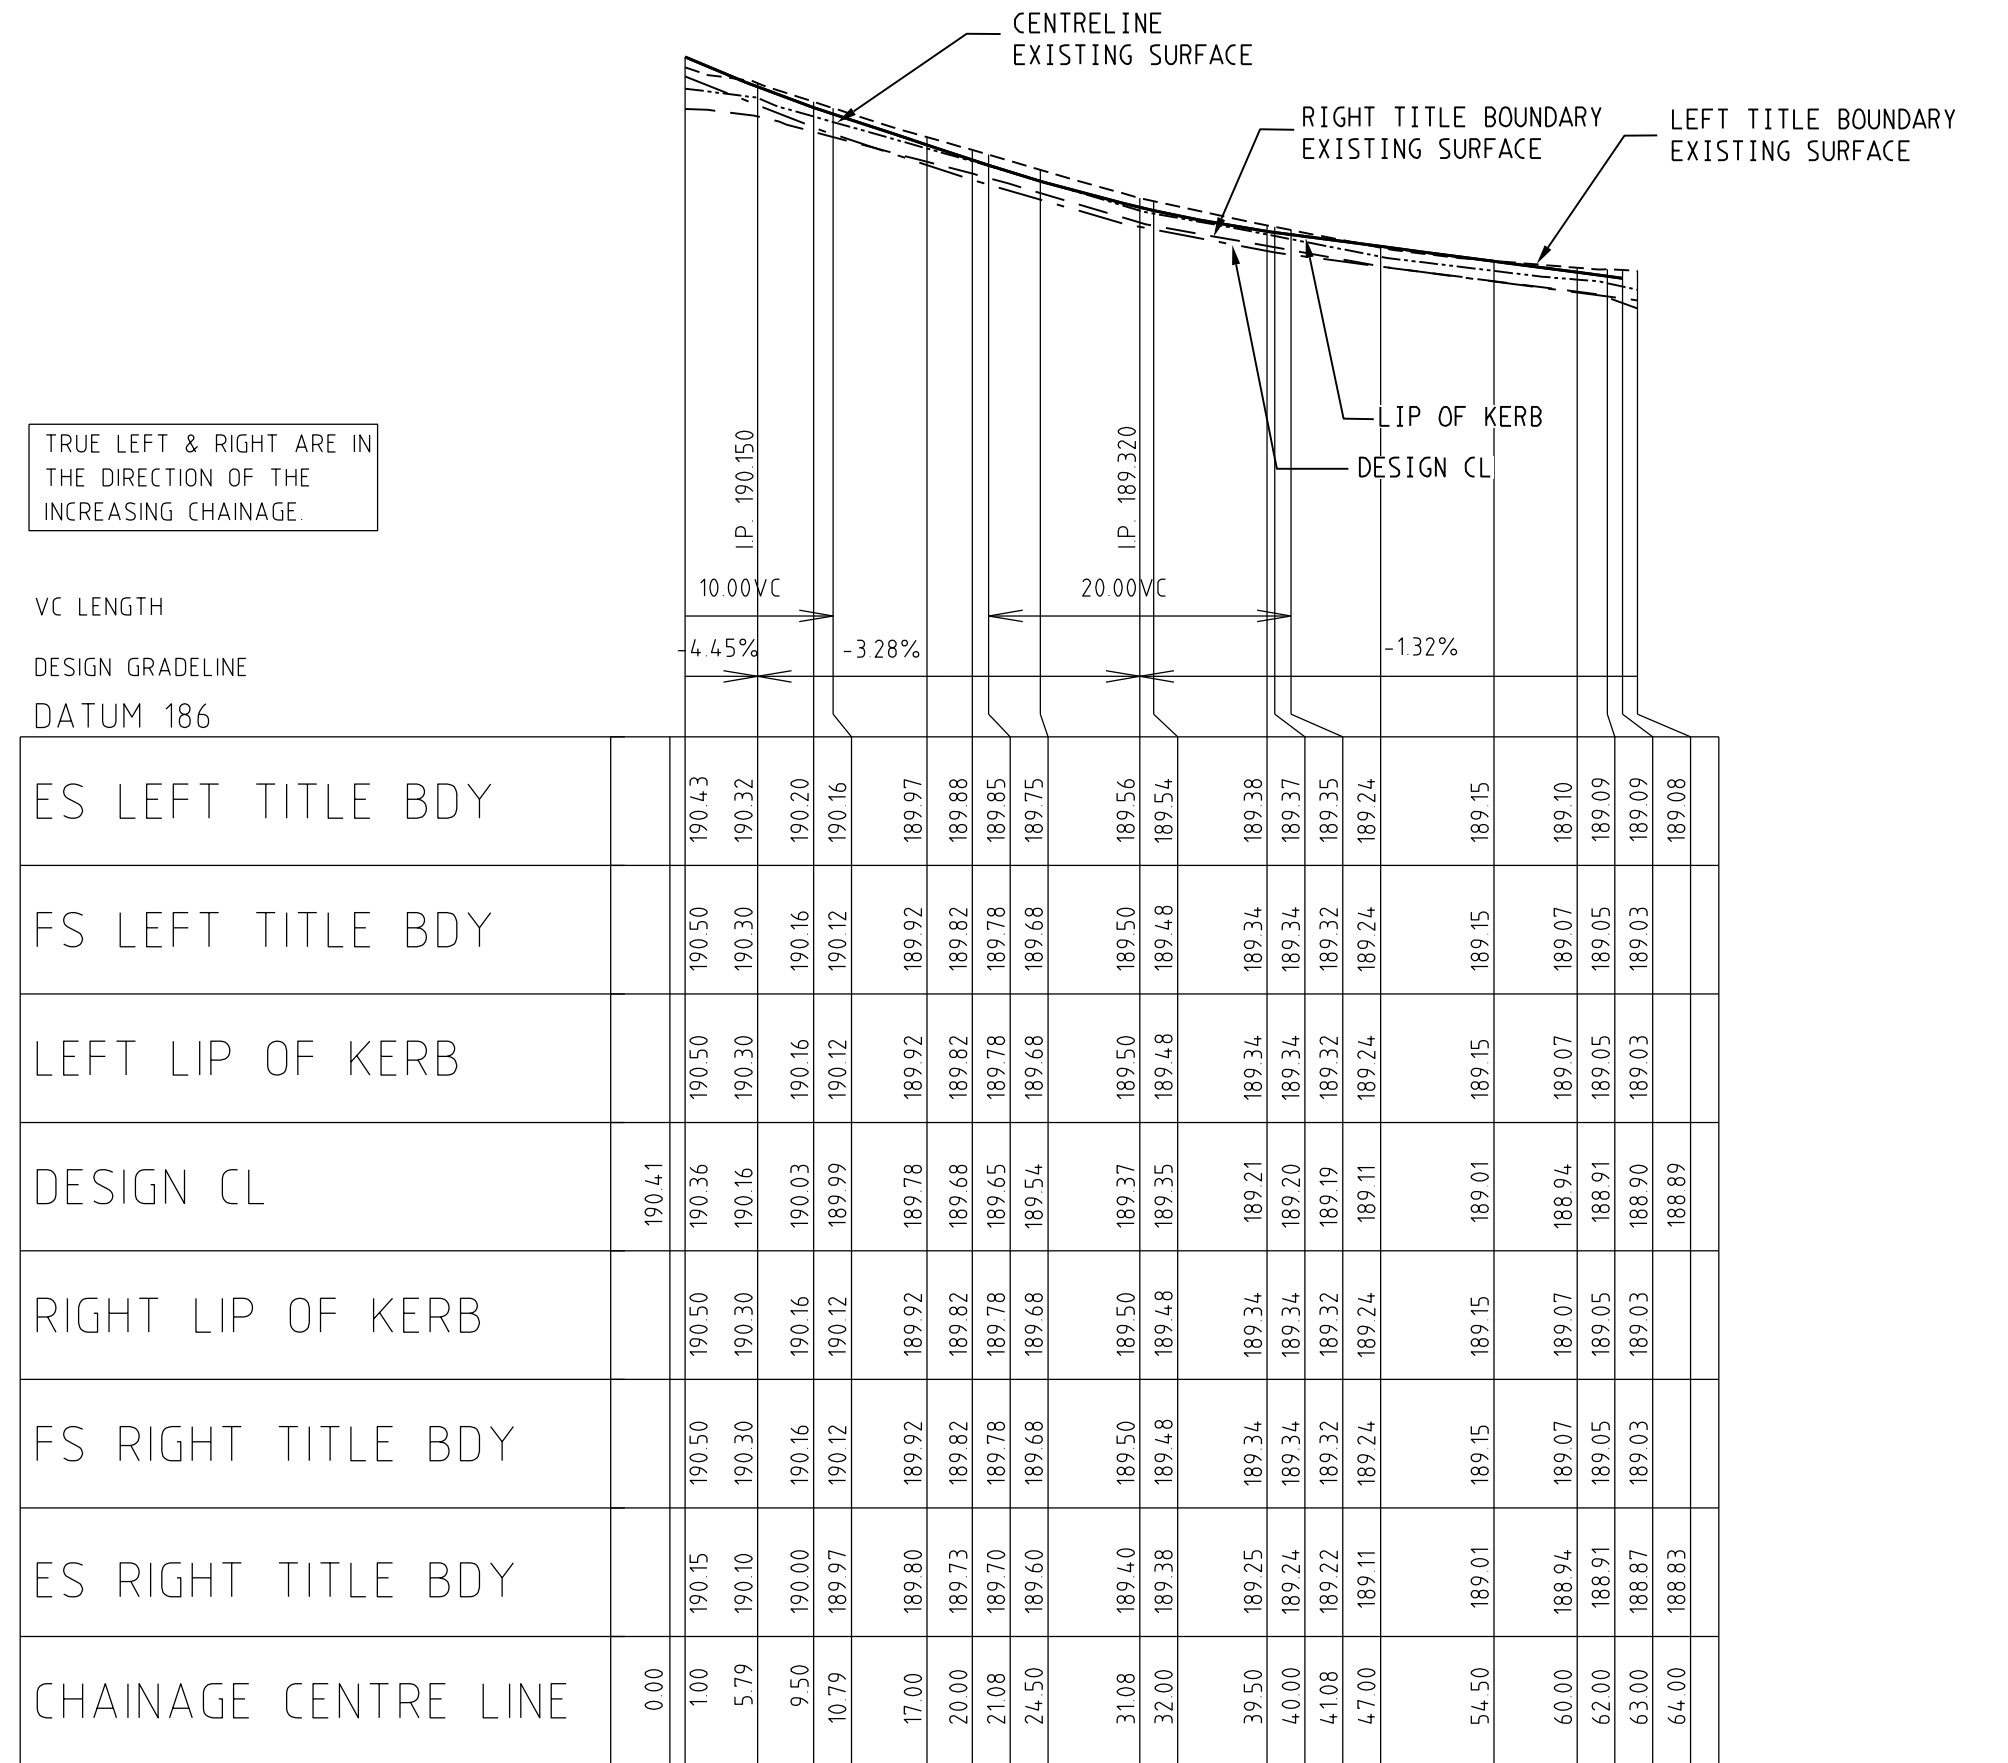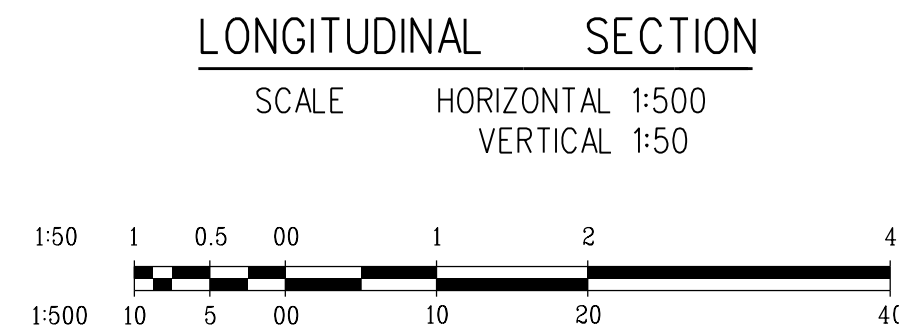

LONGITUDINAL SECTION


SCALE HORIZONTAL 1:500
VERTICAL 1:50

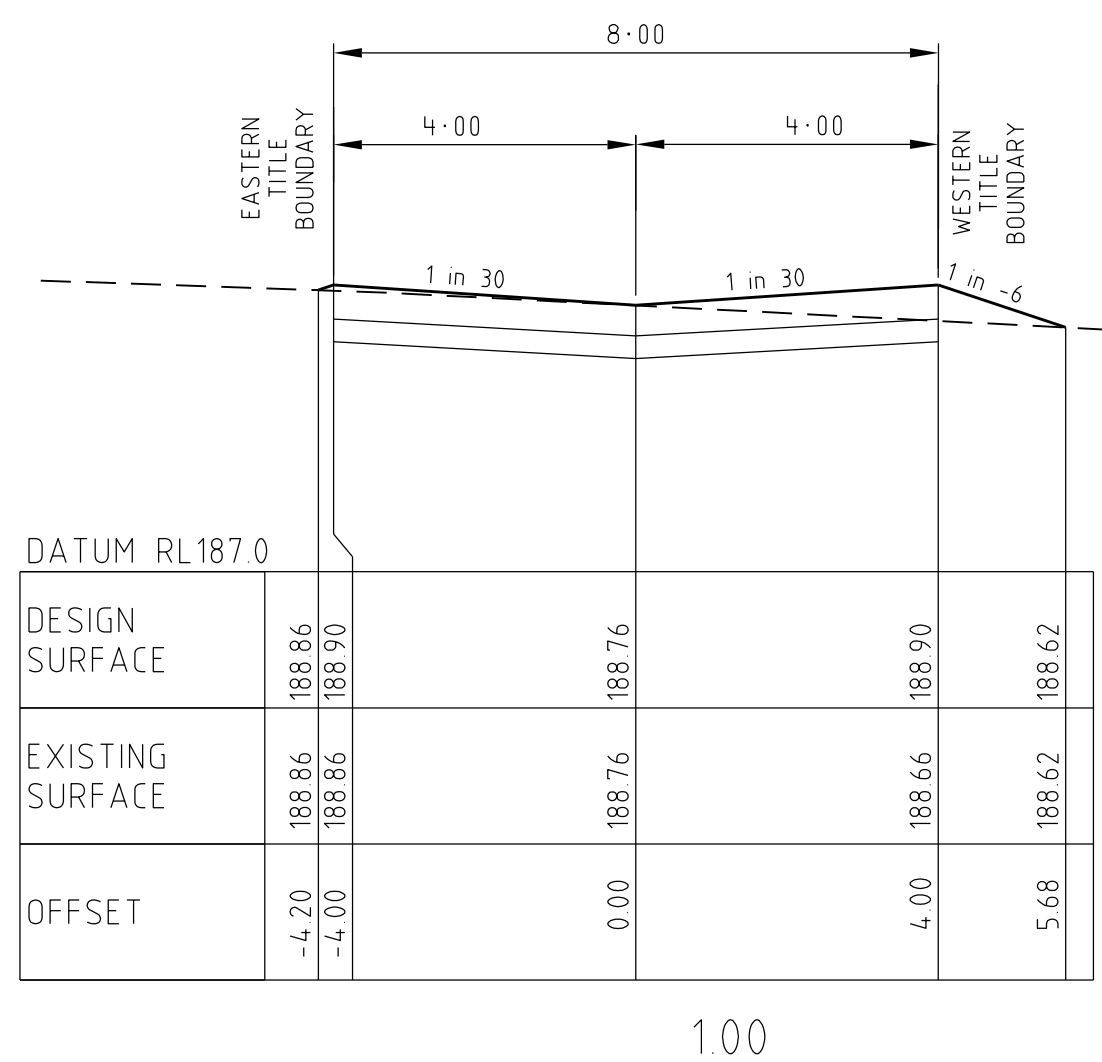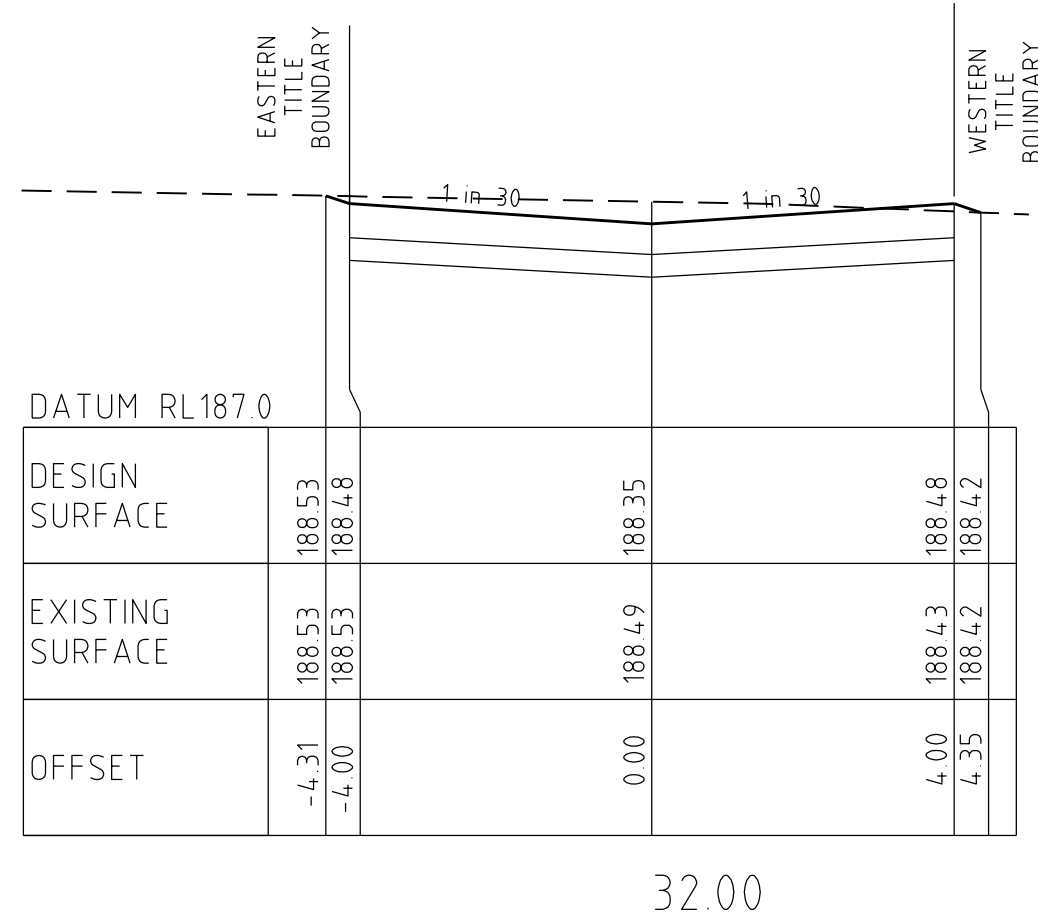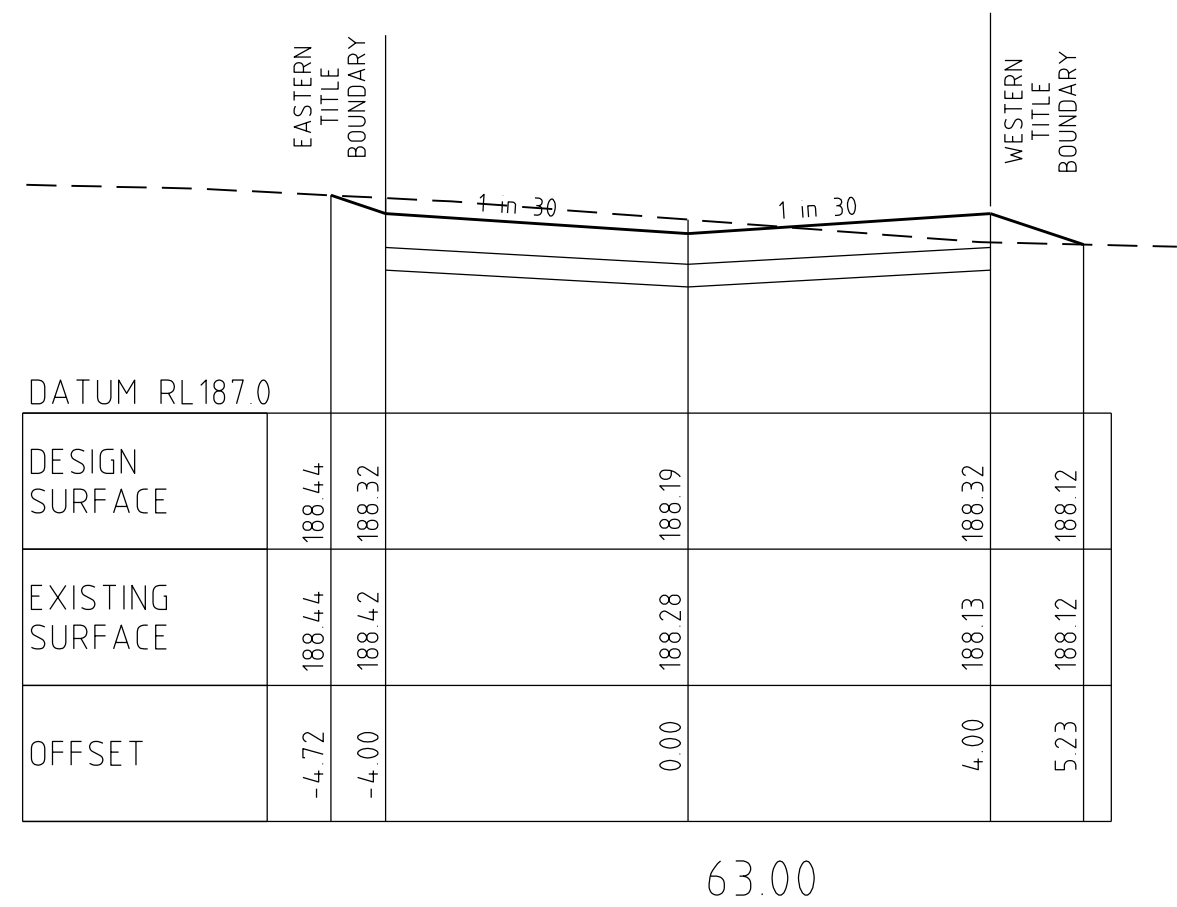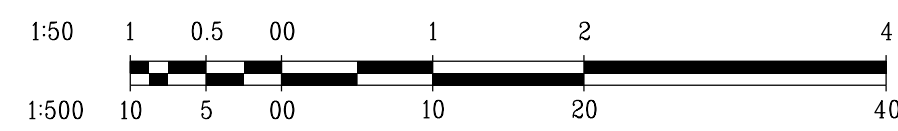





SUMMERS LANE

CROSS SECTIONS

SCALE HORIZONTAL 1:100
VERTICAL 1:50

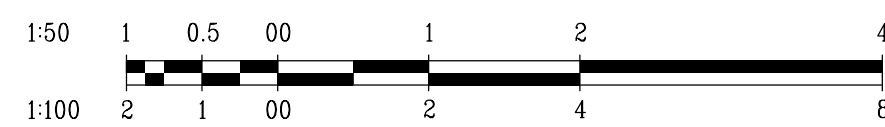









CRUSHED ROCK BACKFILL


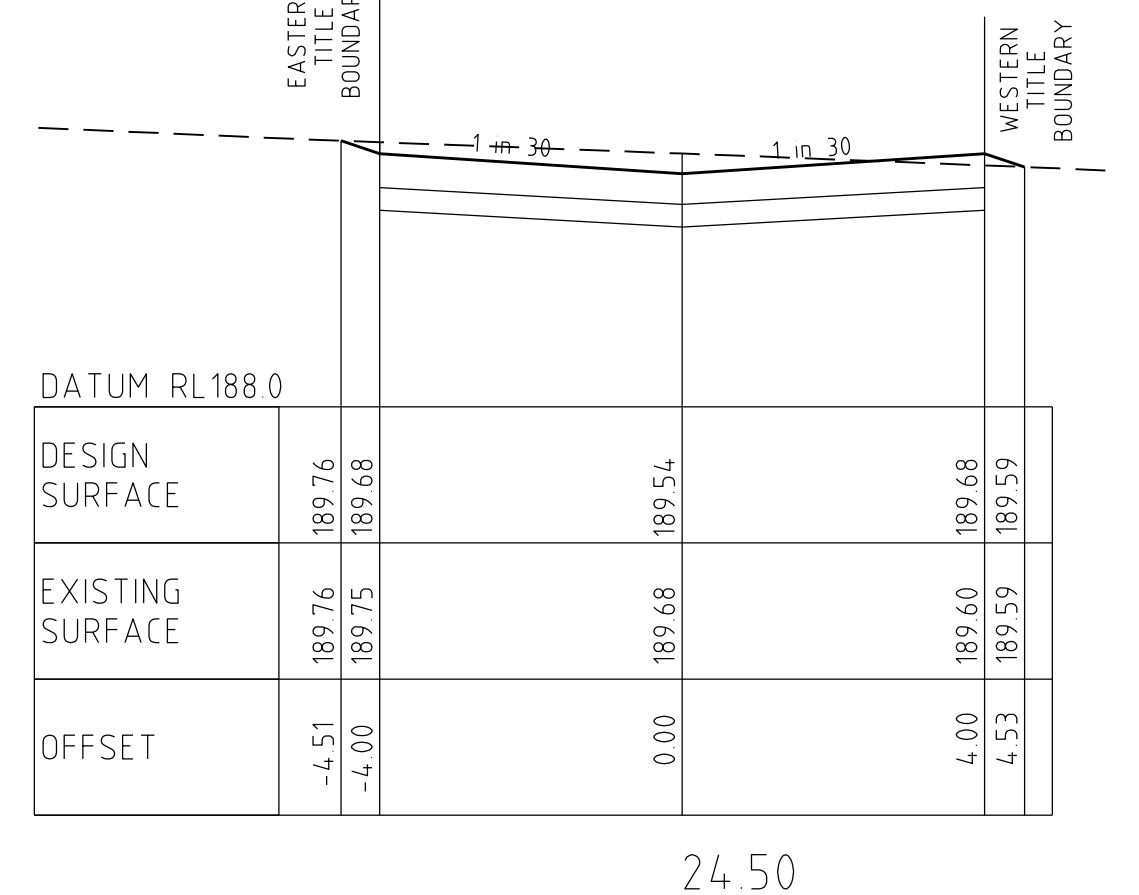
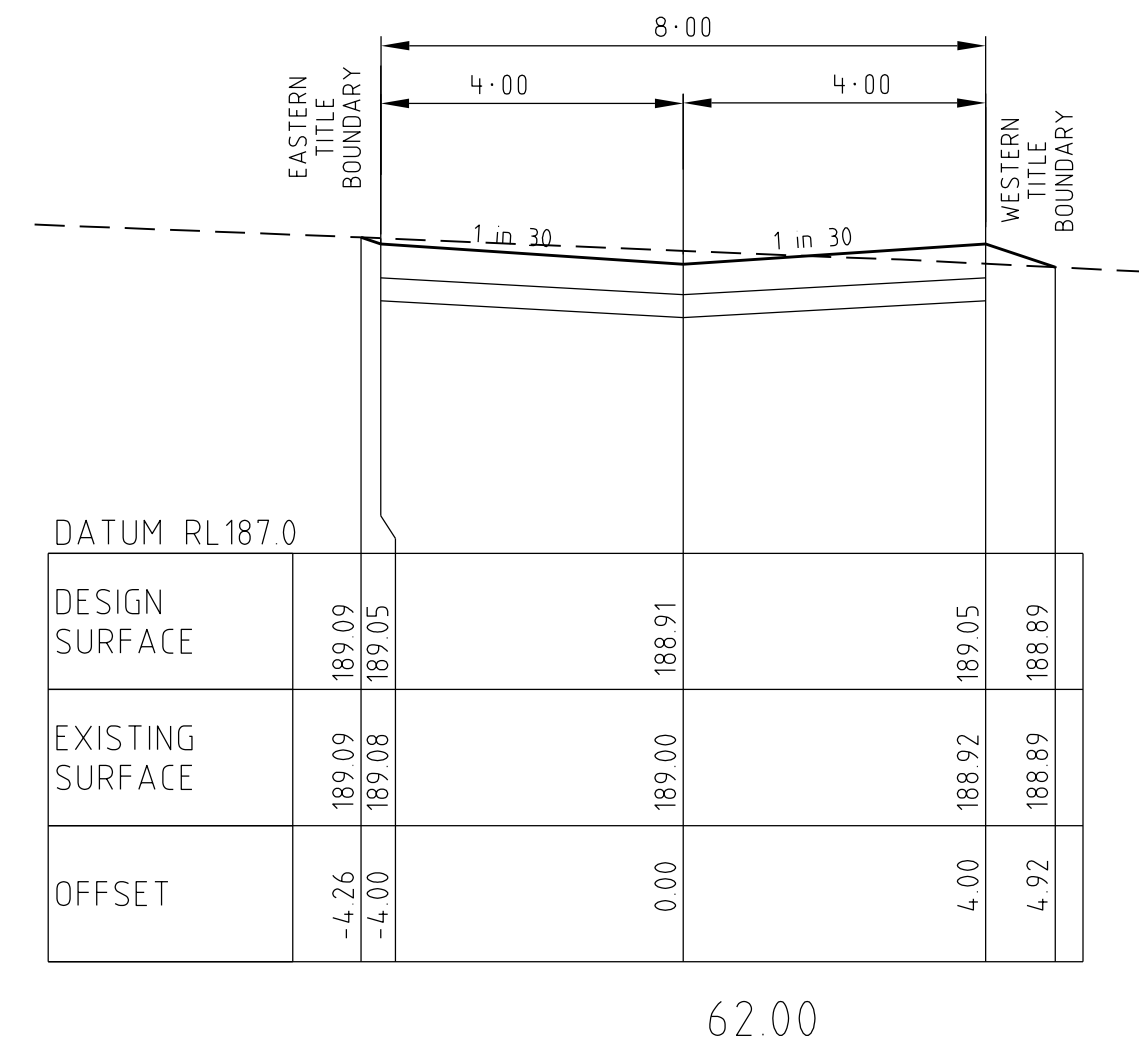
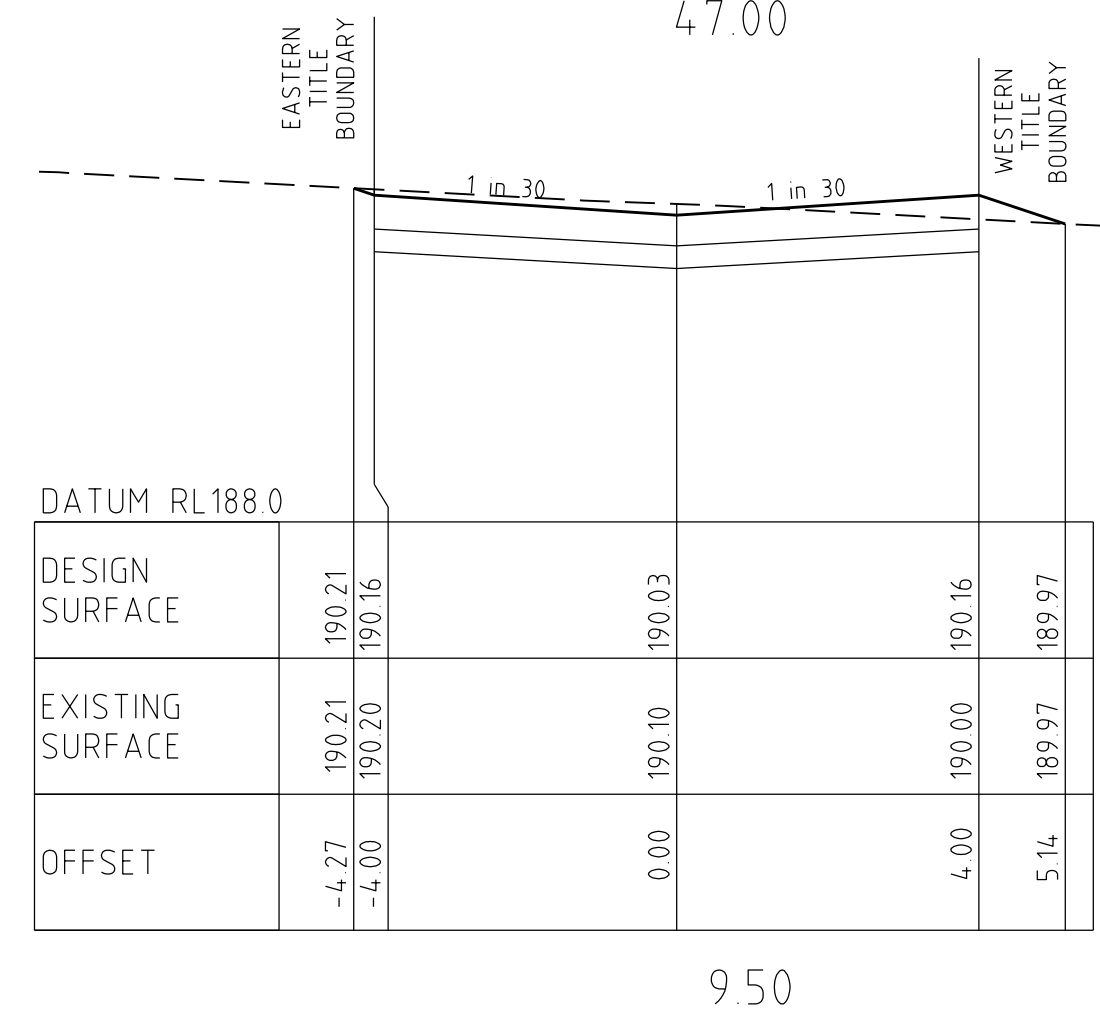
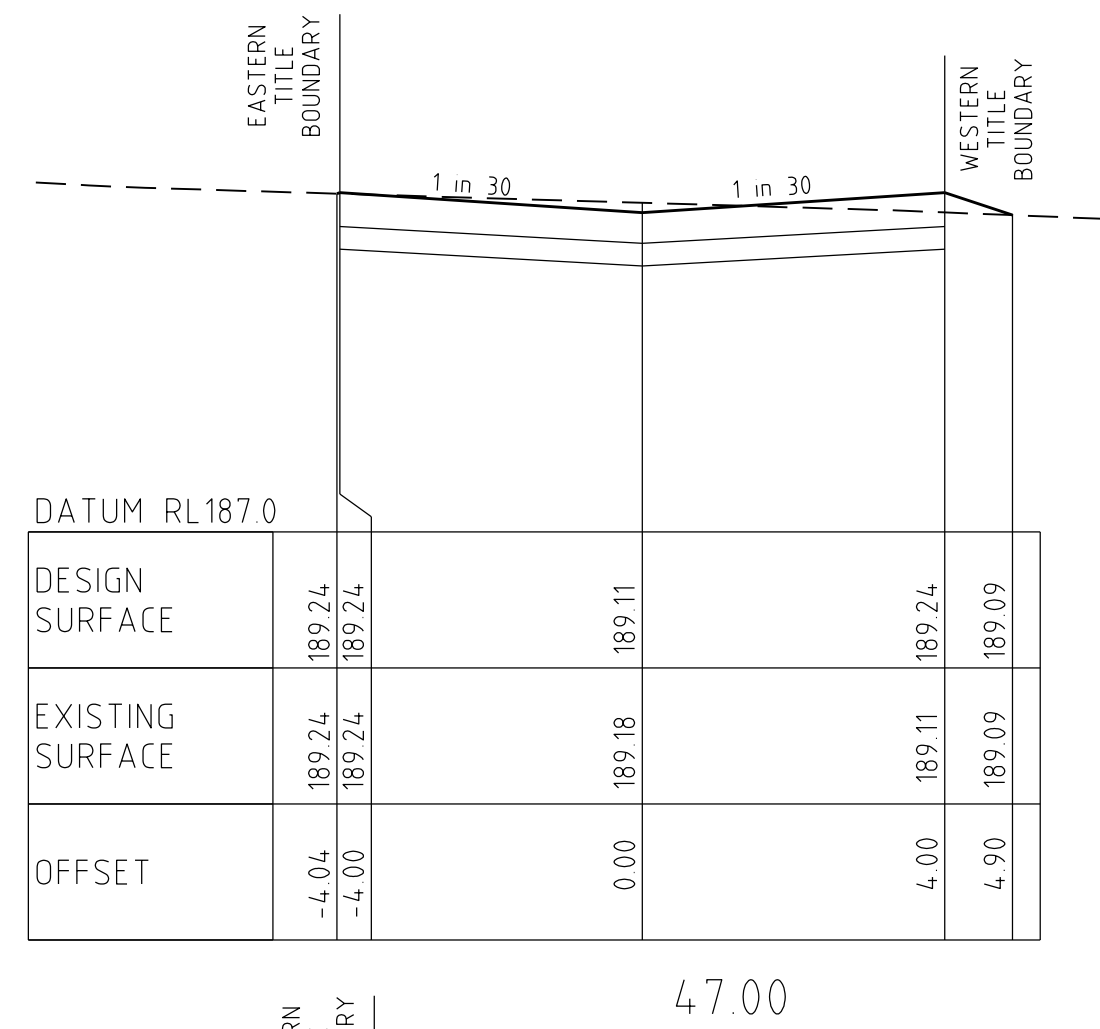


AMENDMENTS					breese pitt dixon pty. ltd.		1/19 cato street hawthorn east, 3123 telephone 8823 2300 fax no. 8823 2310			
					land surveyors		civil engineers			
					MELWAY REF. 388-C-10		MUNICIPALITY WHITTLESEA			
					SURVEY SPIIRE		REFERENCE 9365 E/I			
				DESIGN SS	RATHDOWNE ESTATE STAGE 1 MEMENTO LANE AND SUMMERS LANE					
				DRAWN SS						
VER	DATE	REMARKS			CHECKED	SCALE AS SHOWN	DATUM AHD	DATE JAN '17	SHEET 14 OF 19	A

Project File: 17

J:\VAP\65\Eng\Stage 1\REDI_RIN_L15XPL04SL.dgn

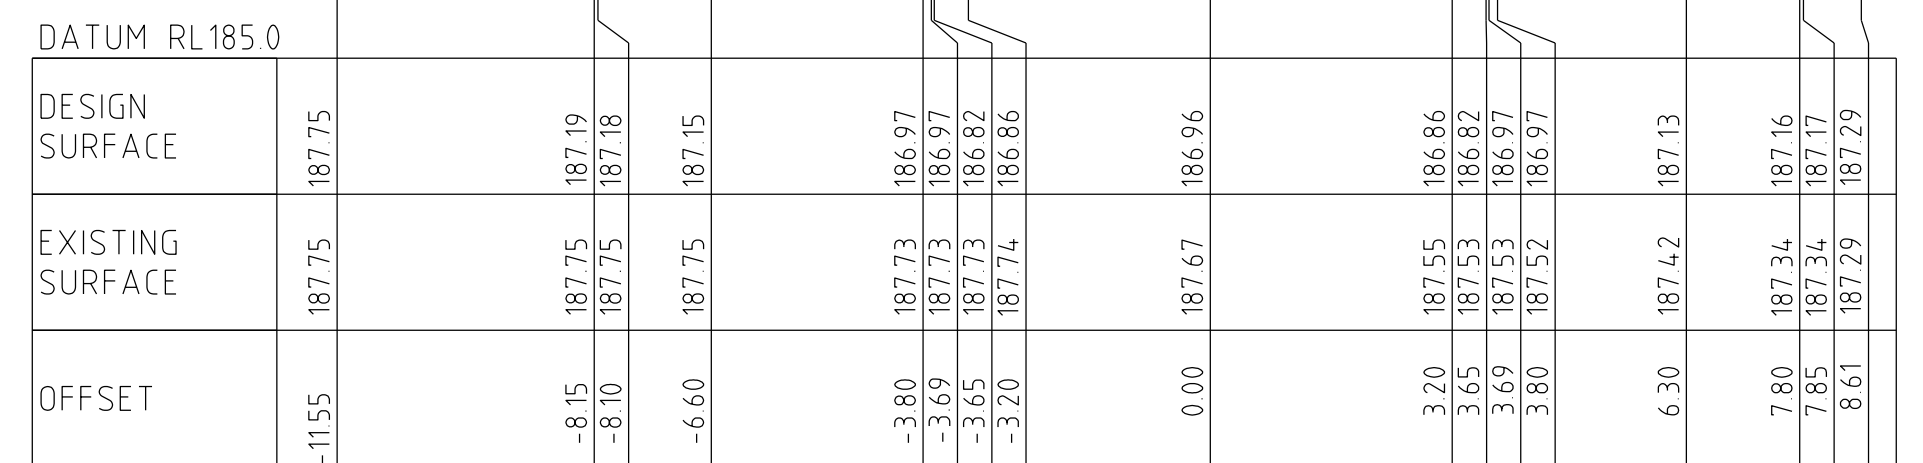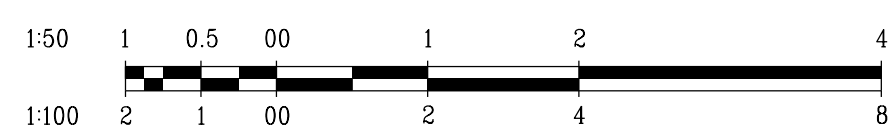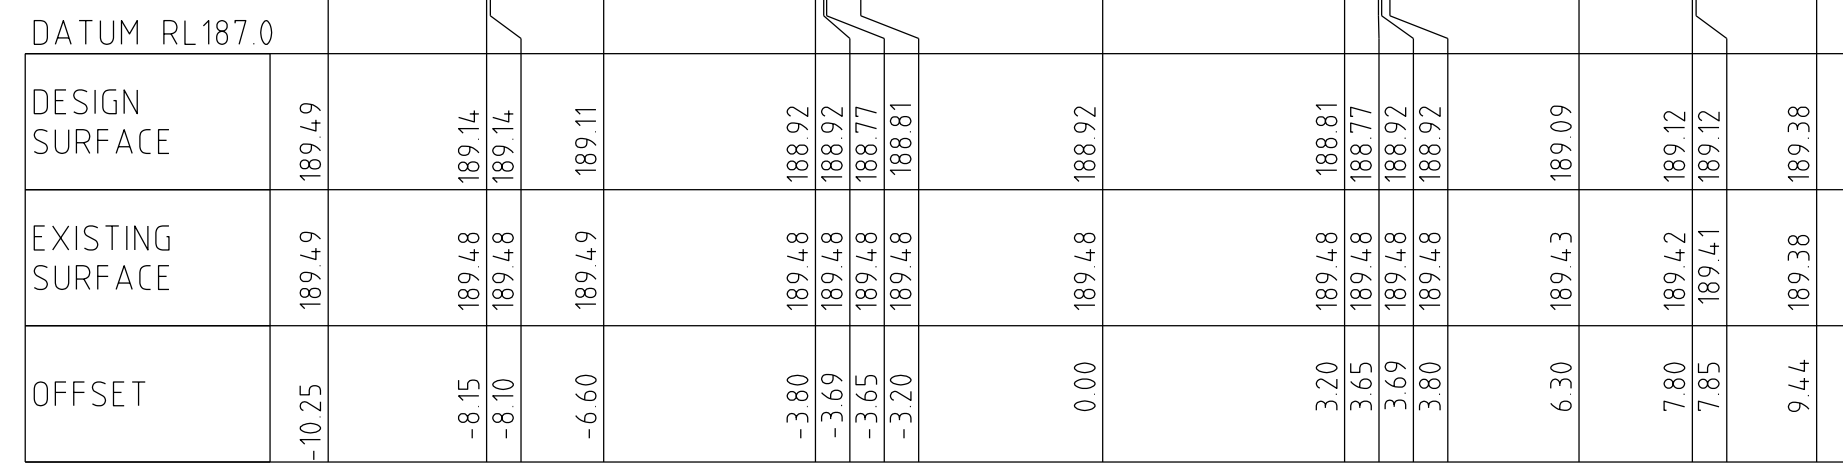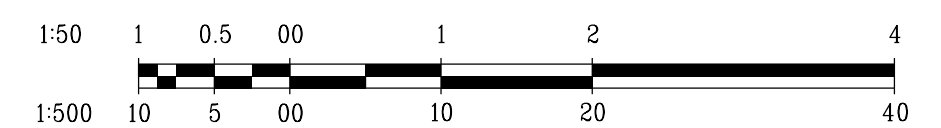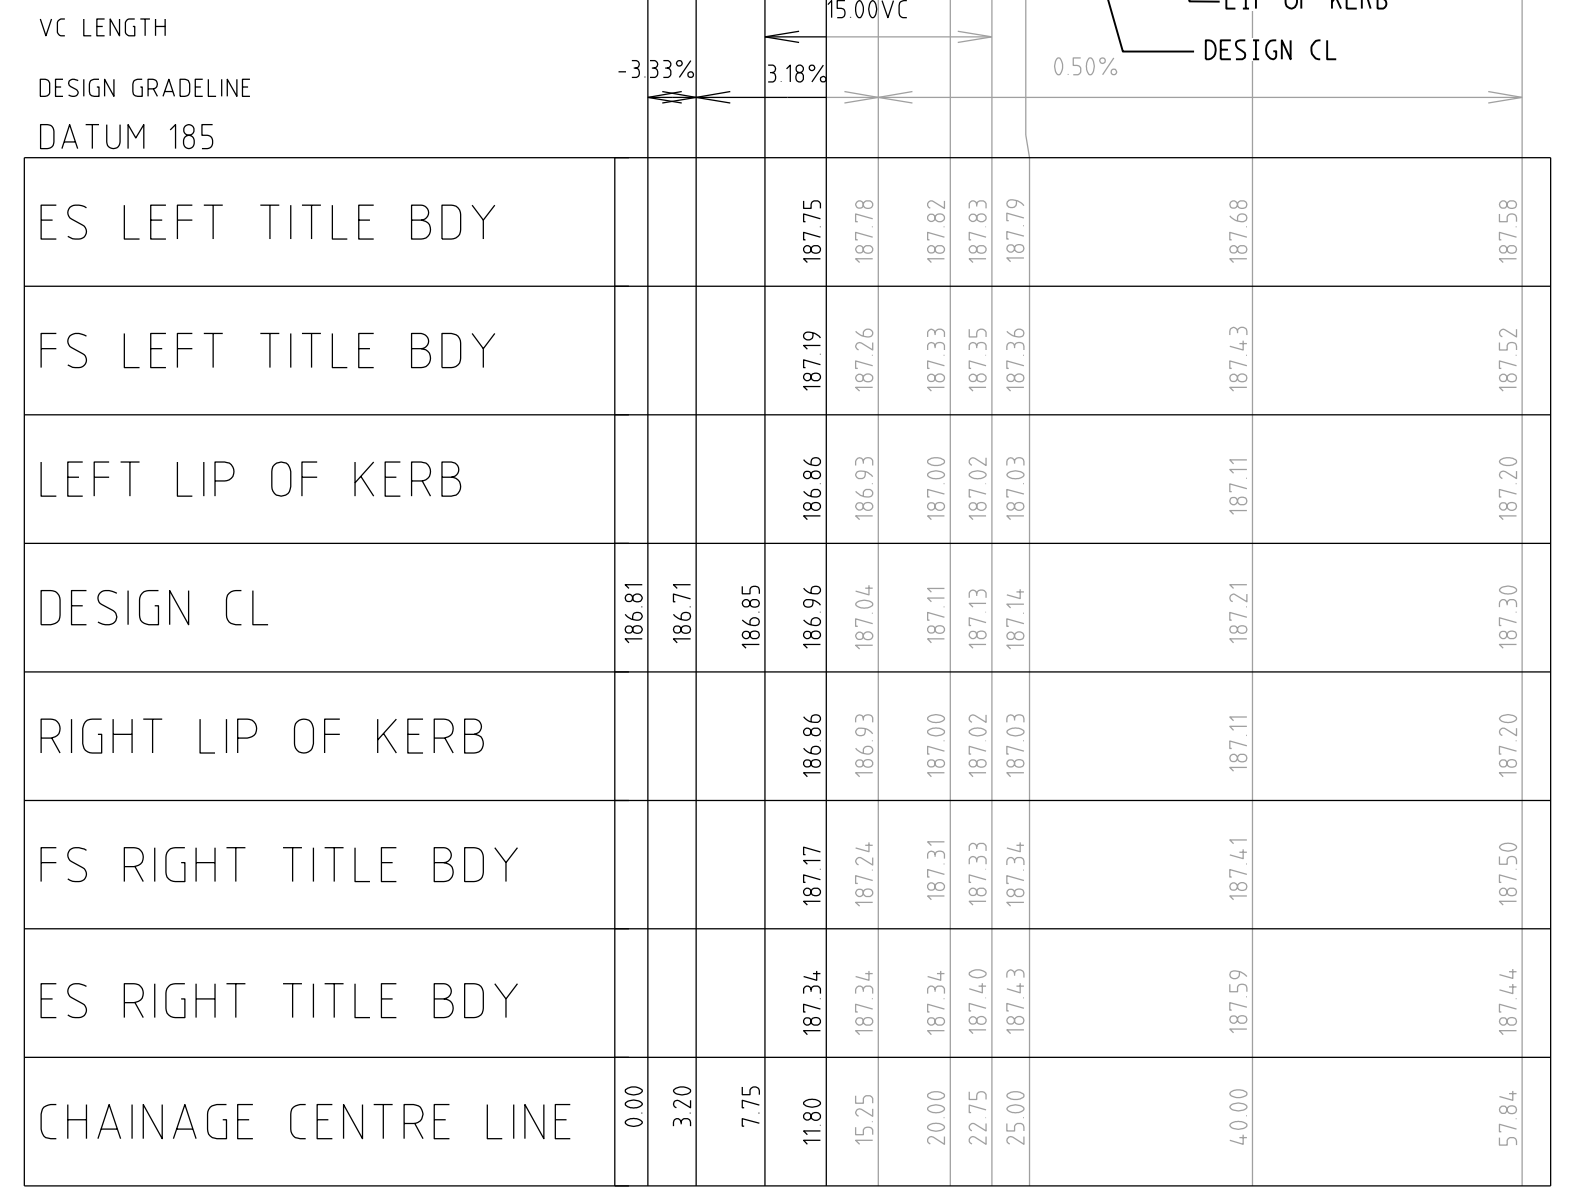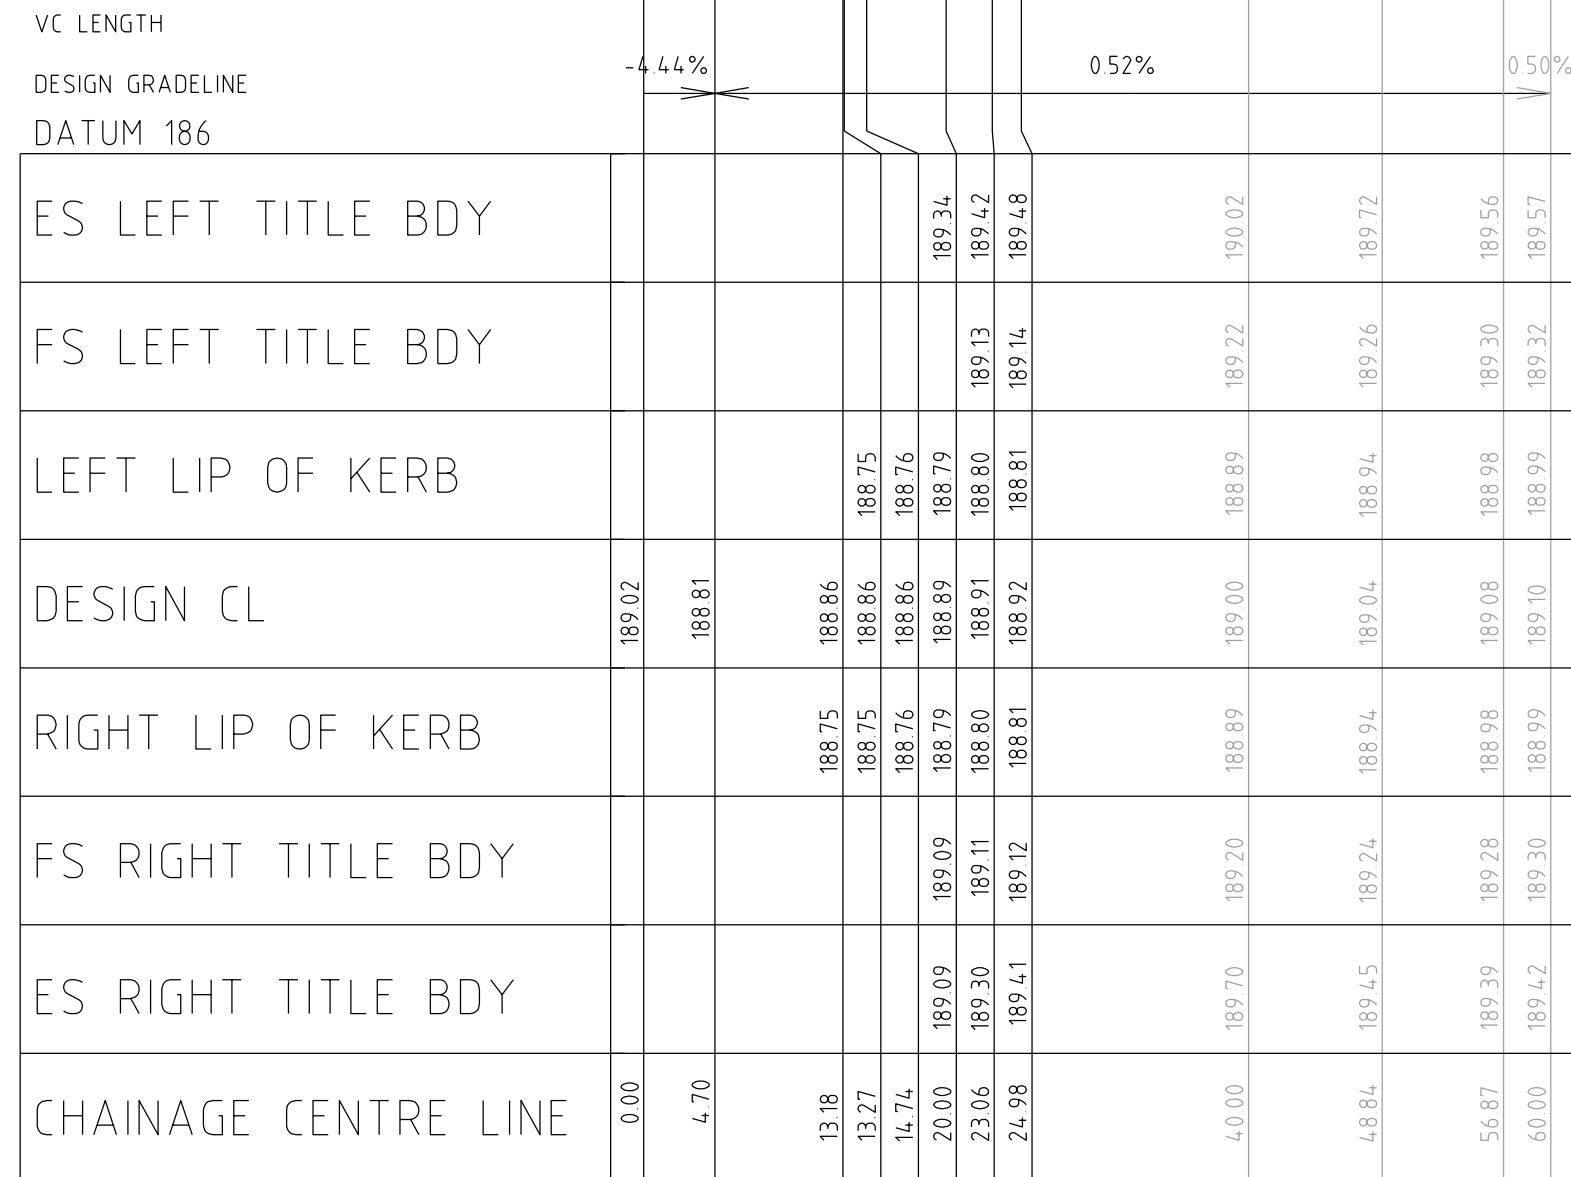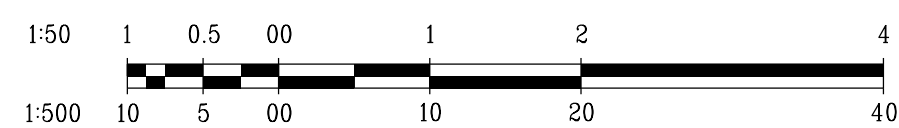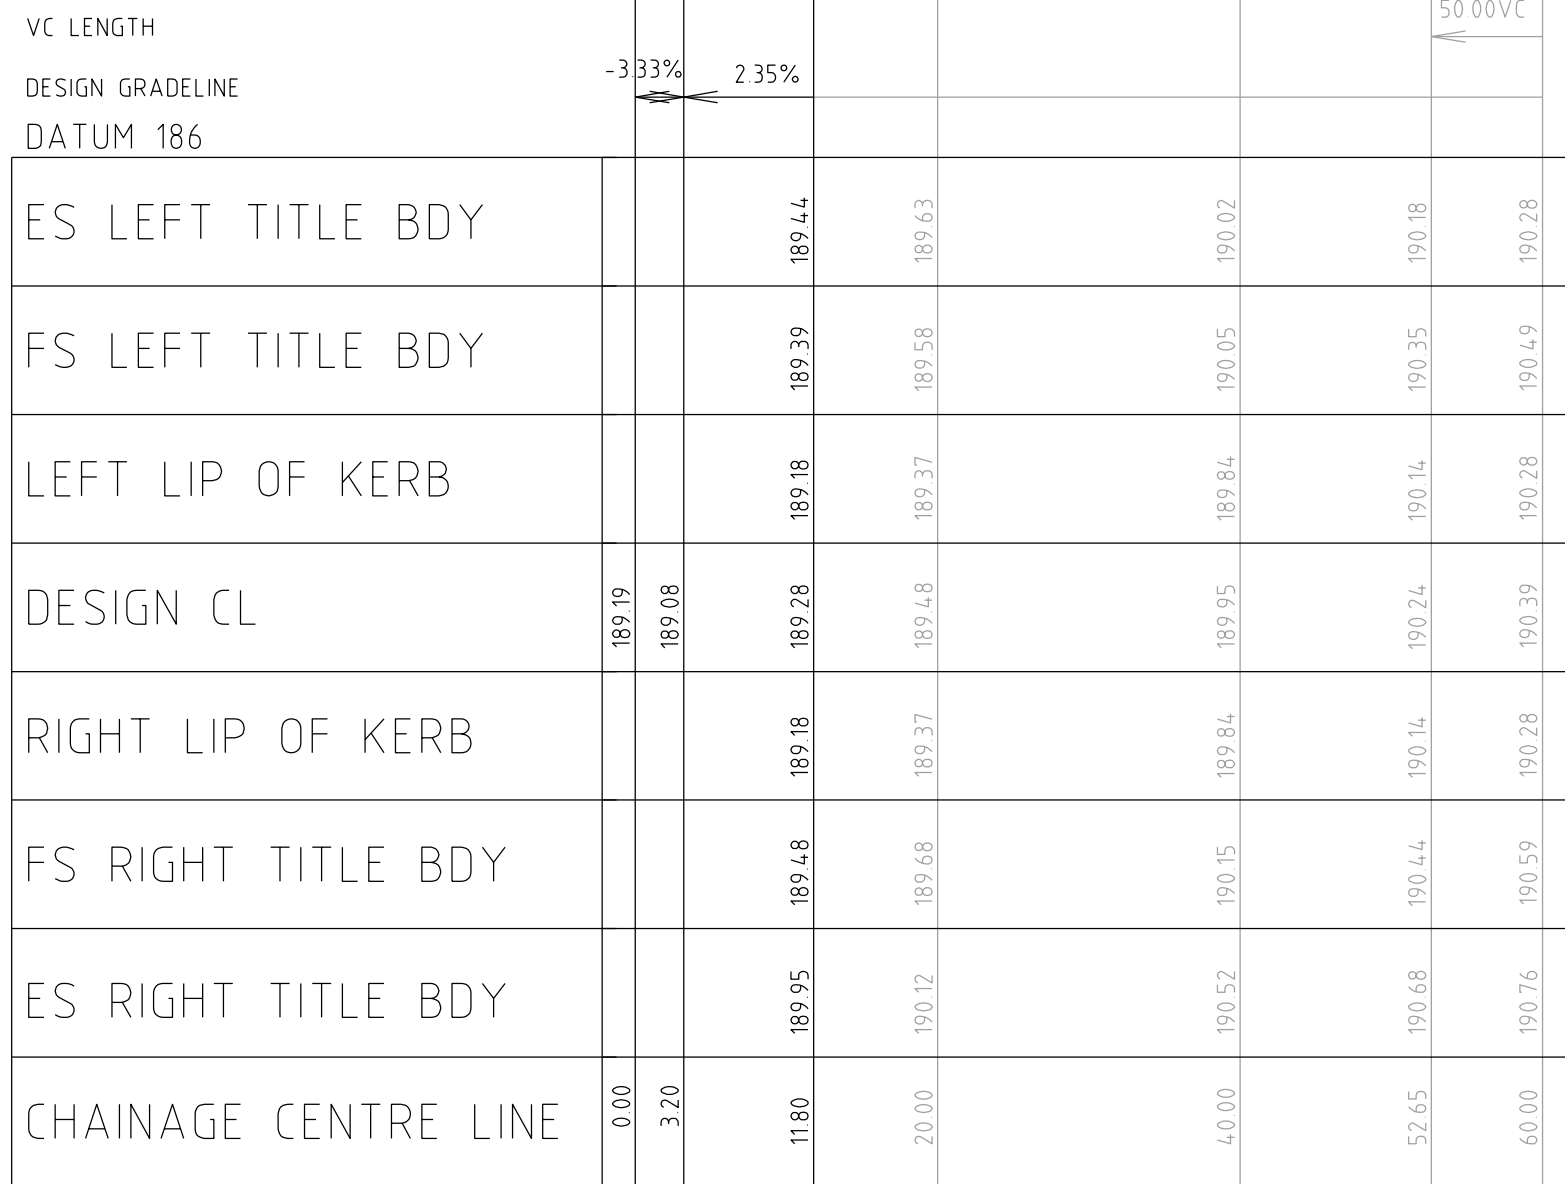
J:\H9365\Eng\Stage 1\EQ1_R15_LS\SBSTC.dgn

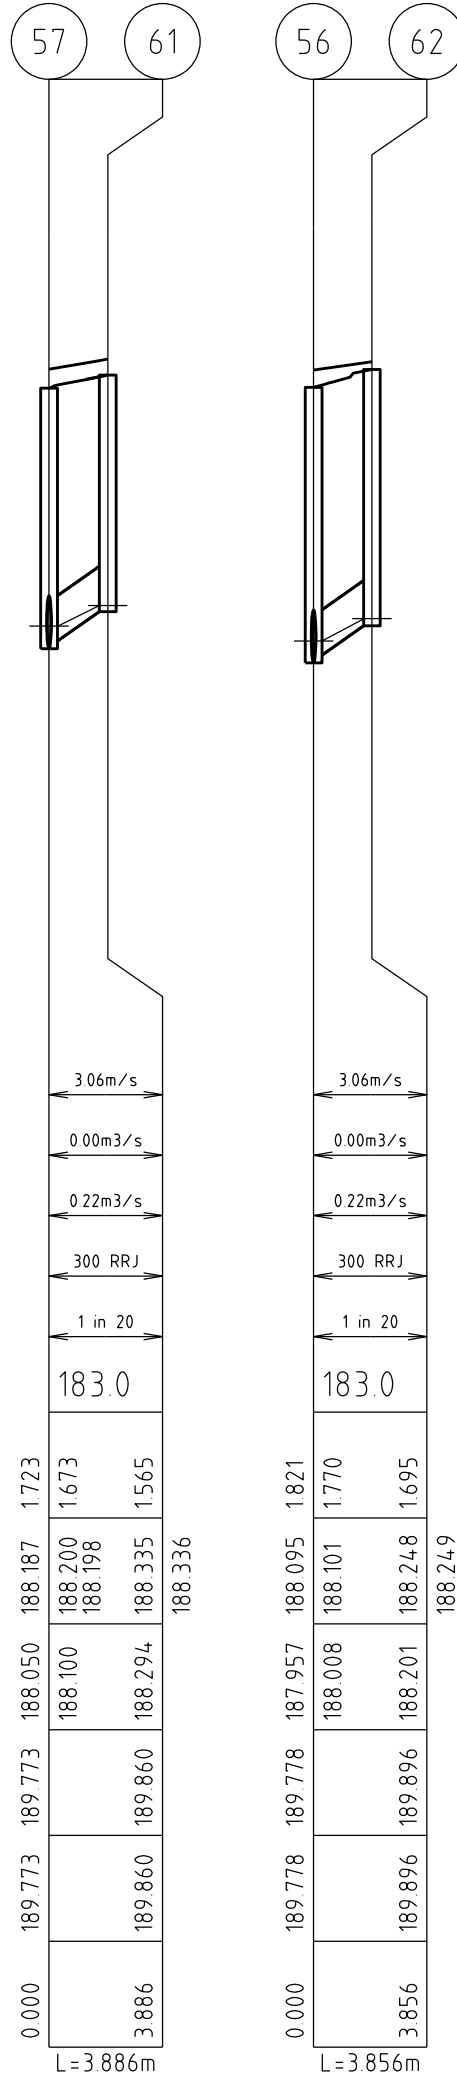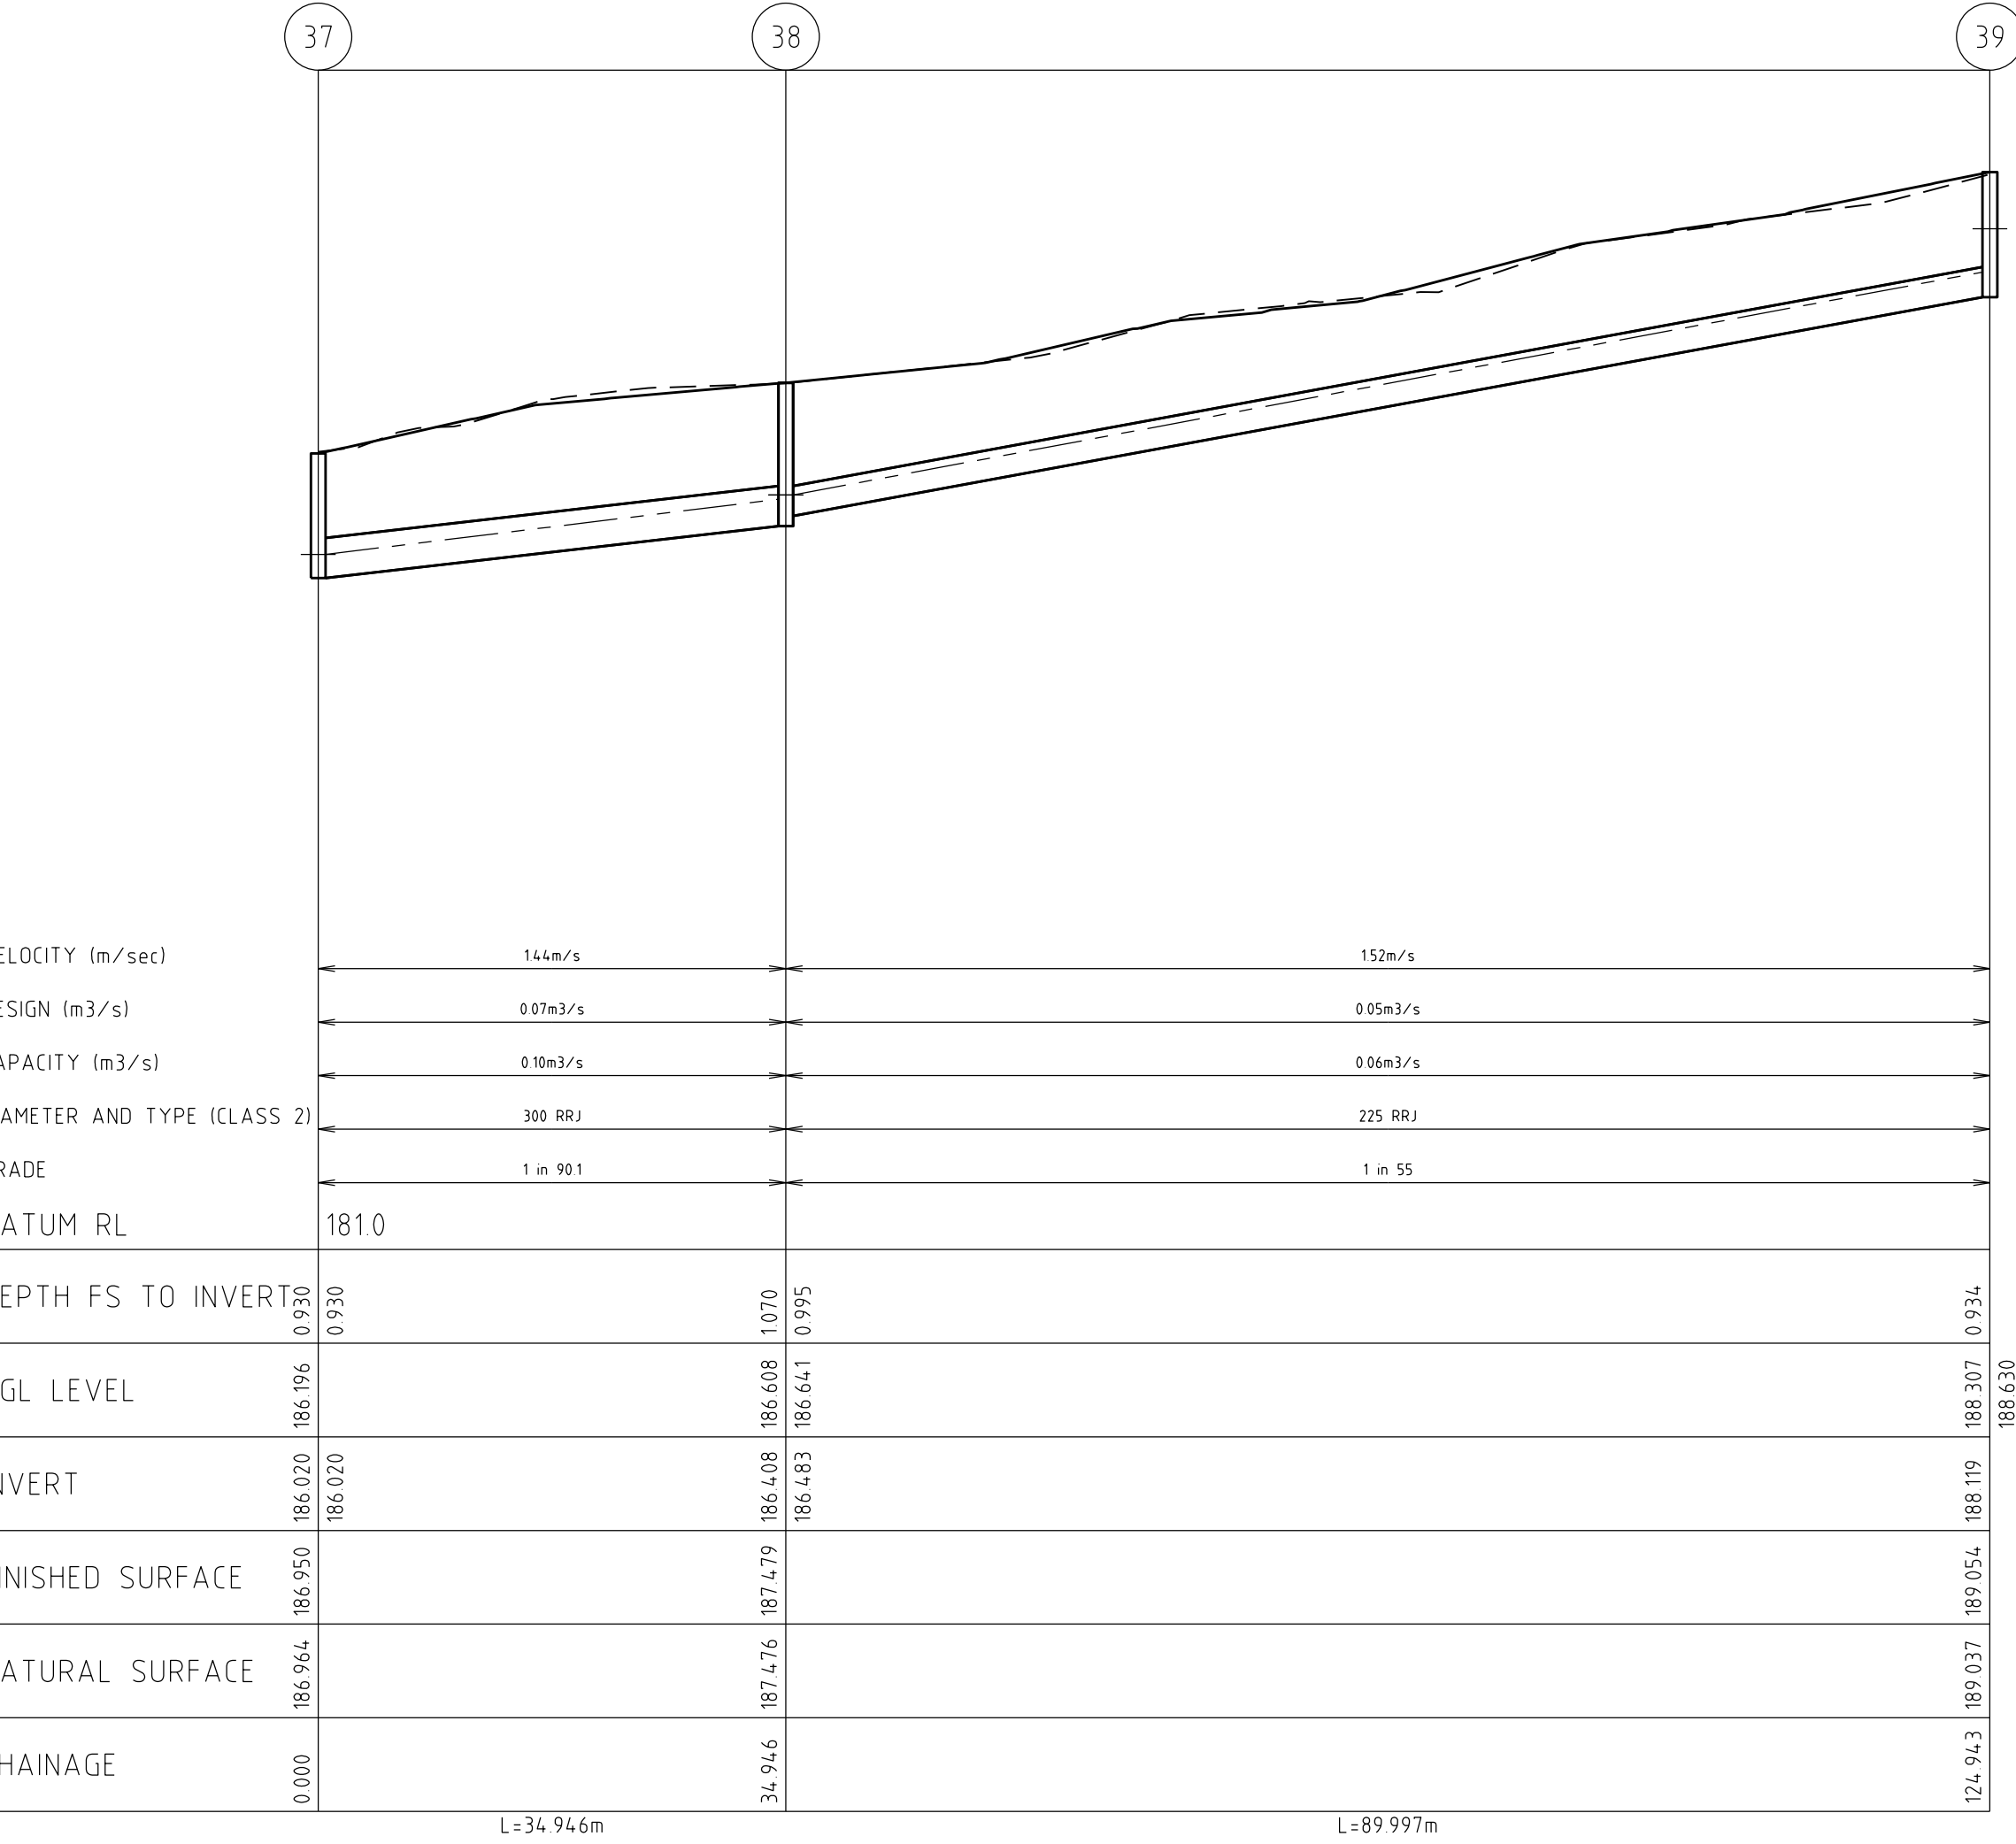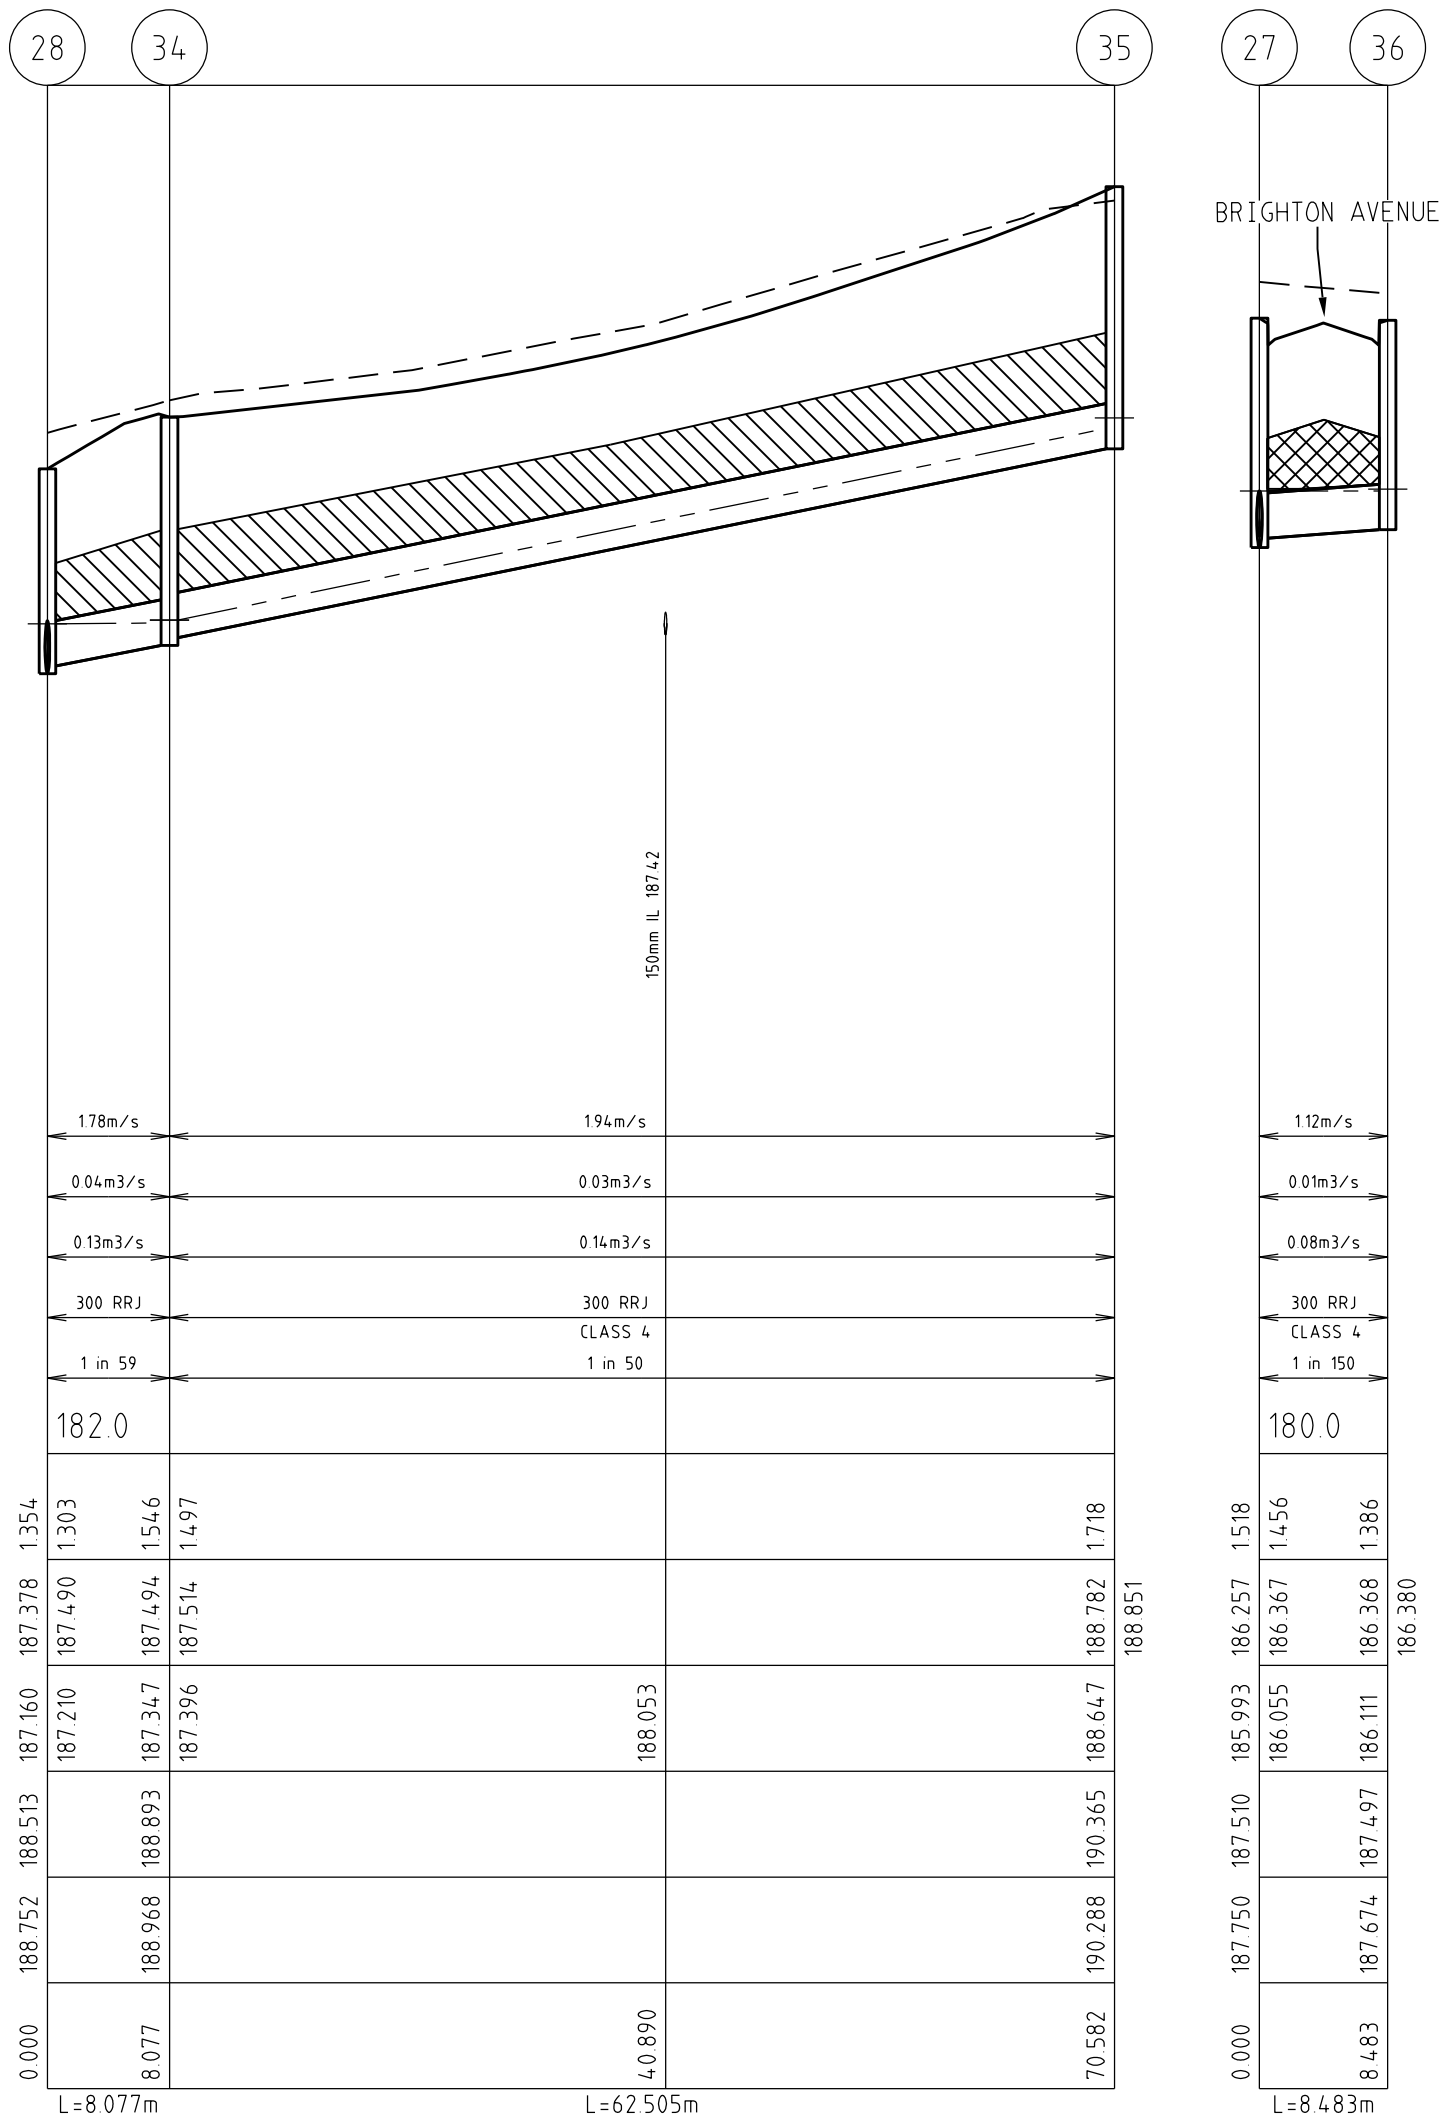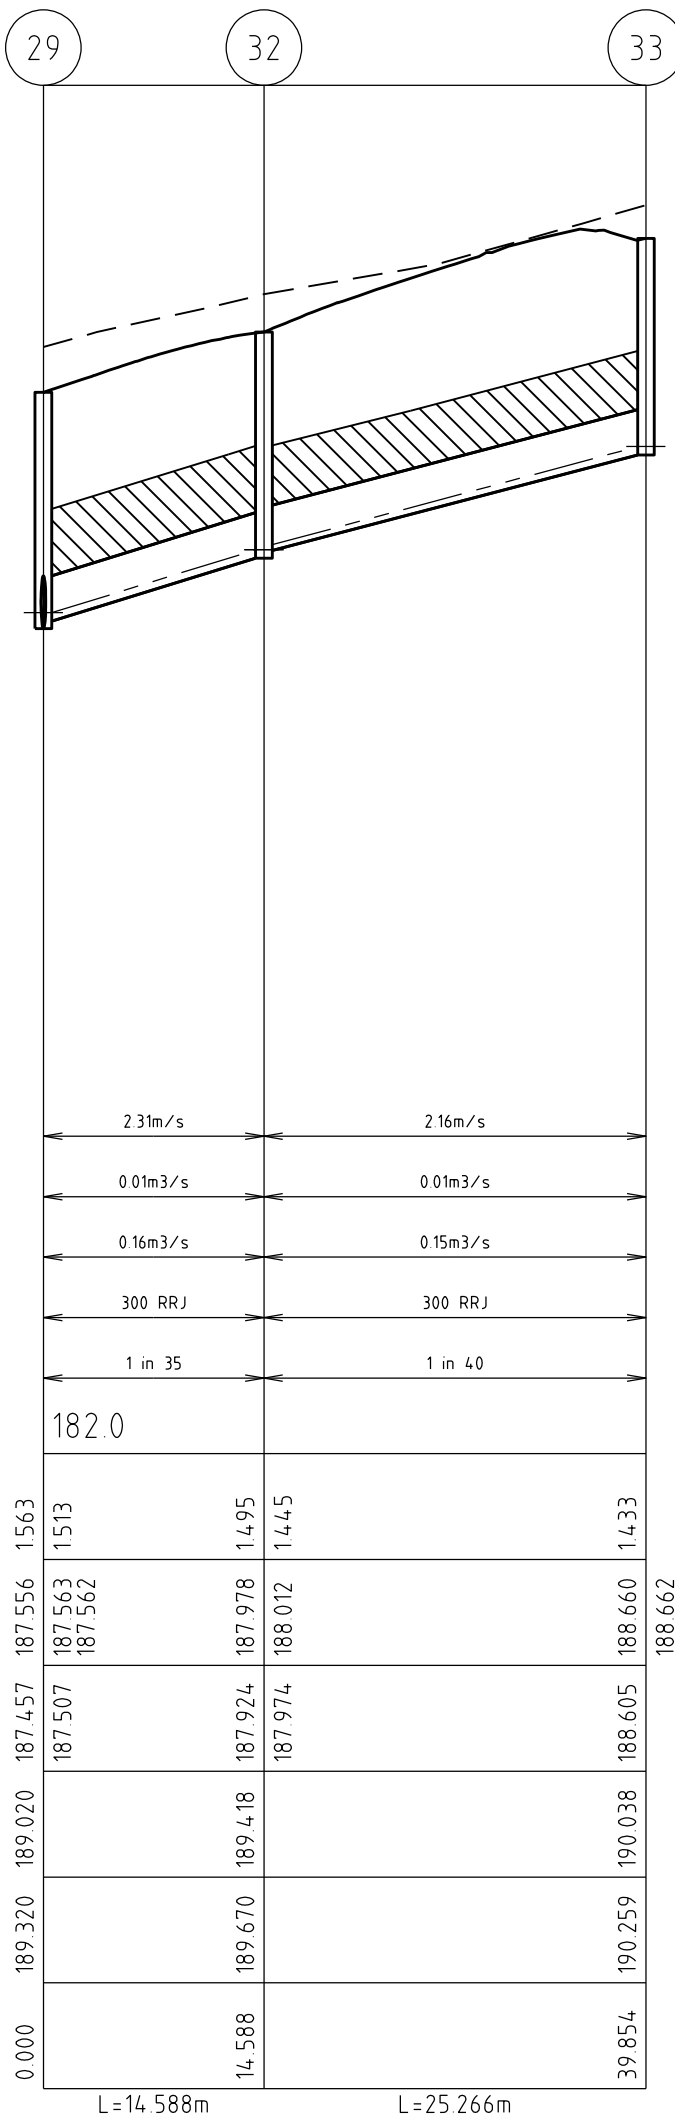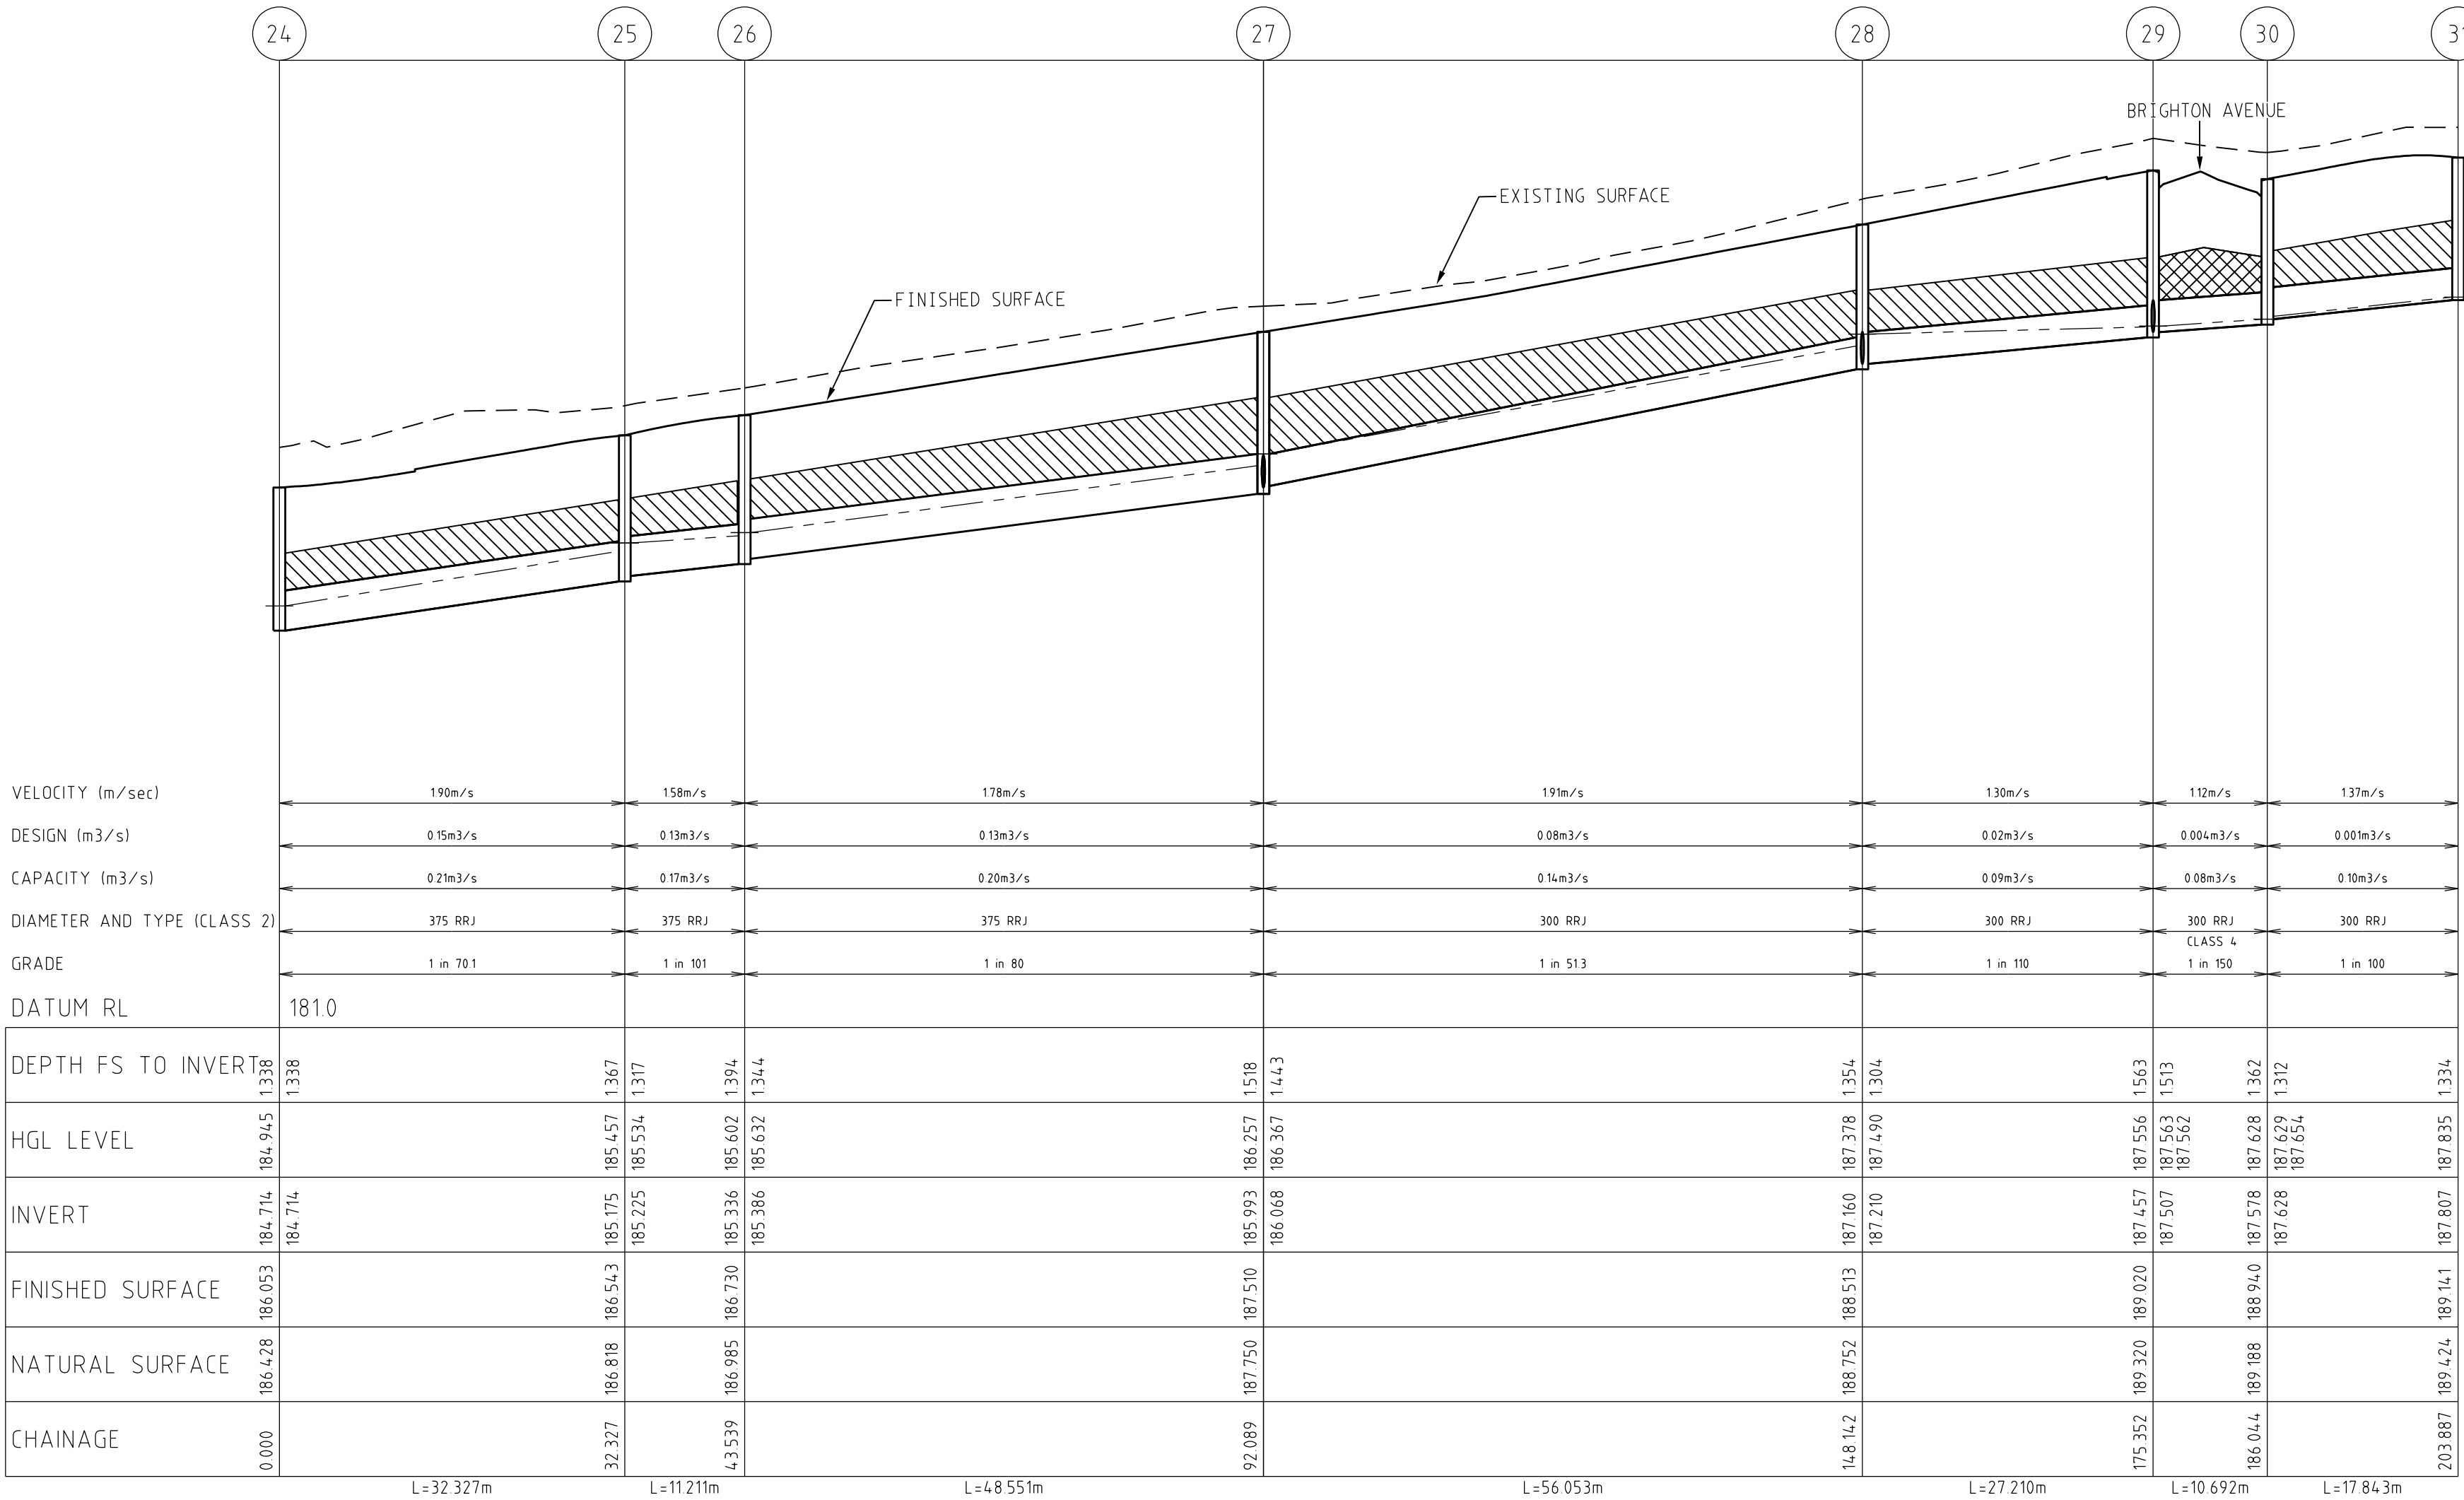

AS CONSTRUCTED

DRAINAGE LONGITUDINAL SECTIONS

SCALE HORIZONTAL 1:500 VERTICAL 1:50

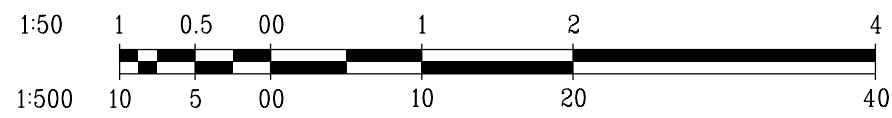

SCHEDULE NOTES:-

- WHERE PIT HAUNCHING IS REQUIRED, INTERNAL PIT WALL DIMENSIONS MUST ALLOW 50mm CLEARANCE EACH SIDE OF PIPE OUTSIDE DIAMETER, INCLUDING ANGULAR PIPE ENTRY TO PIT. MINIMUM DIMENSIONS OF PIT BASE ARE TO BE AS PER SIZES SPECIFIED IN THE PIT SCHEDULE. TOP OF PIT OPENING FOR ALL HAUNCHED PITS TO BE 900mm x 600mm.
- PIT BASE TO BE SHAPED TO MATCH LOWER HALF OF PIPE WHERE DROP ACROSS PIT IS LESS THAN 50mm.
- PROVIDE BICYCLE SAFE "V" SHAPED CLASS D GRATE (600mm MIN WIDTH).




INDICATES CRUSHED ROCK BACKFILL CLASS 2




INDICATES CRUSHED ROCK BACKFILL CLASS 3

--- INDICATES 5YR HGL

AMENDMENTS					breese pitt dixon pty. ltd. land surveyors civil engineers		1/19 coto street hawthorn east, 3123 telephone 8823 2300 fax no. 8823 2310							
	C	12-03-19	PIT LINES 57-61 & 56-62 ADDED	MELWAY REF.	388-C-10	RATHDOWNE ESTATE STAGE 1 DRAINAGE LONGITUDINAL SECTION		MUNICIPALITY						
	B	11-05-18	PIPE CLASS 34-35 AMENDED	SURVEY	SPIIRE			WHITTLESEA						
	A	19-12-17	ISSUED FOR CONSTRUCTION	DESIGN	SS			REFERENCE						
				DRAWN	SS			9365 E/I						
VER	DATE	REMARKS		CHECKED		SCALE	AS SHOWN	DATUM	AHD	DATE	JAN '17	SHEET	17 OF 19	C

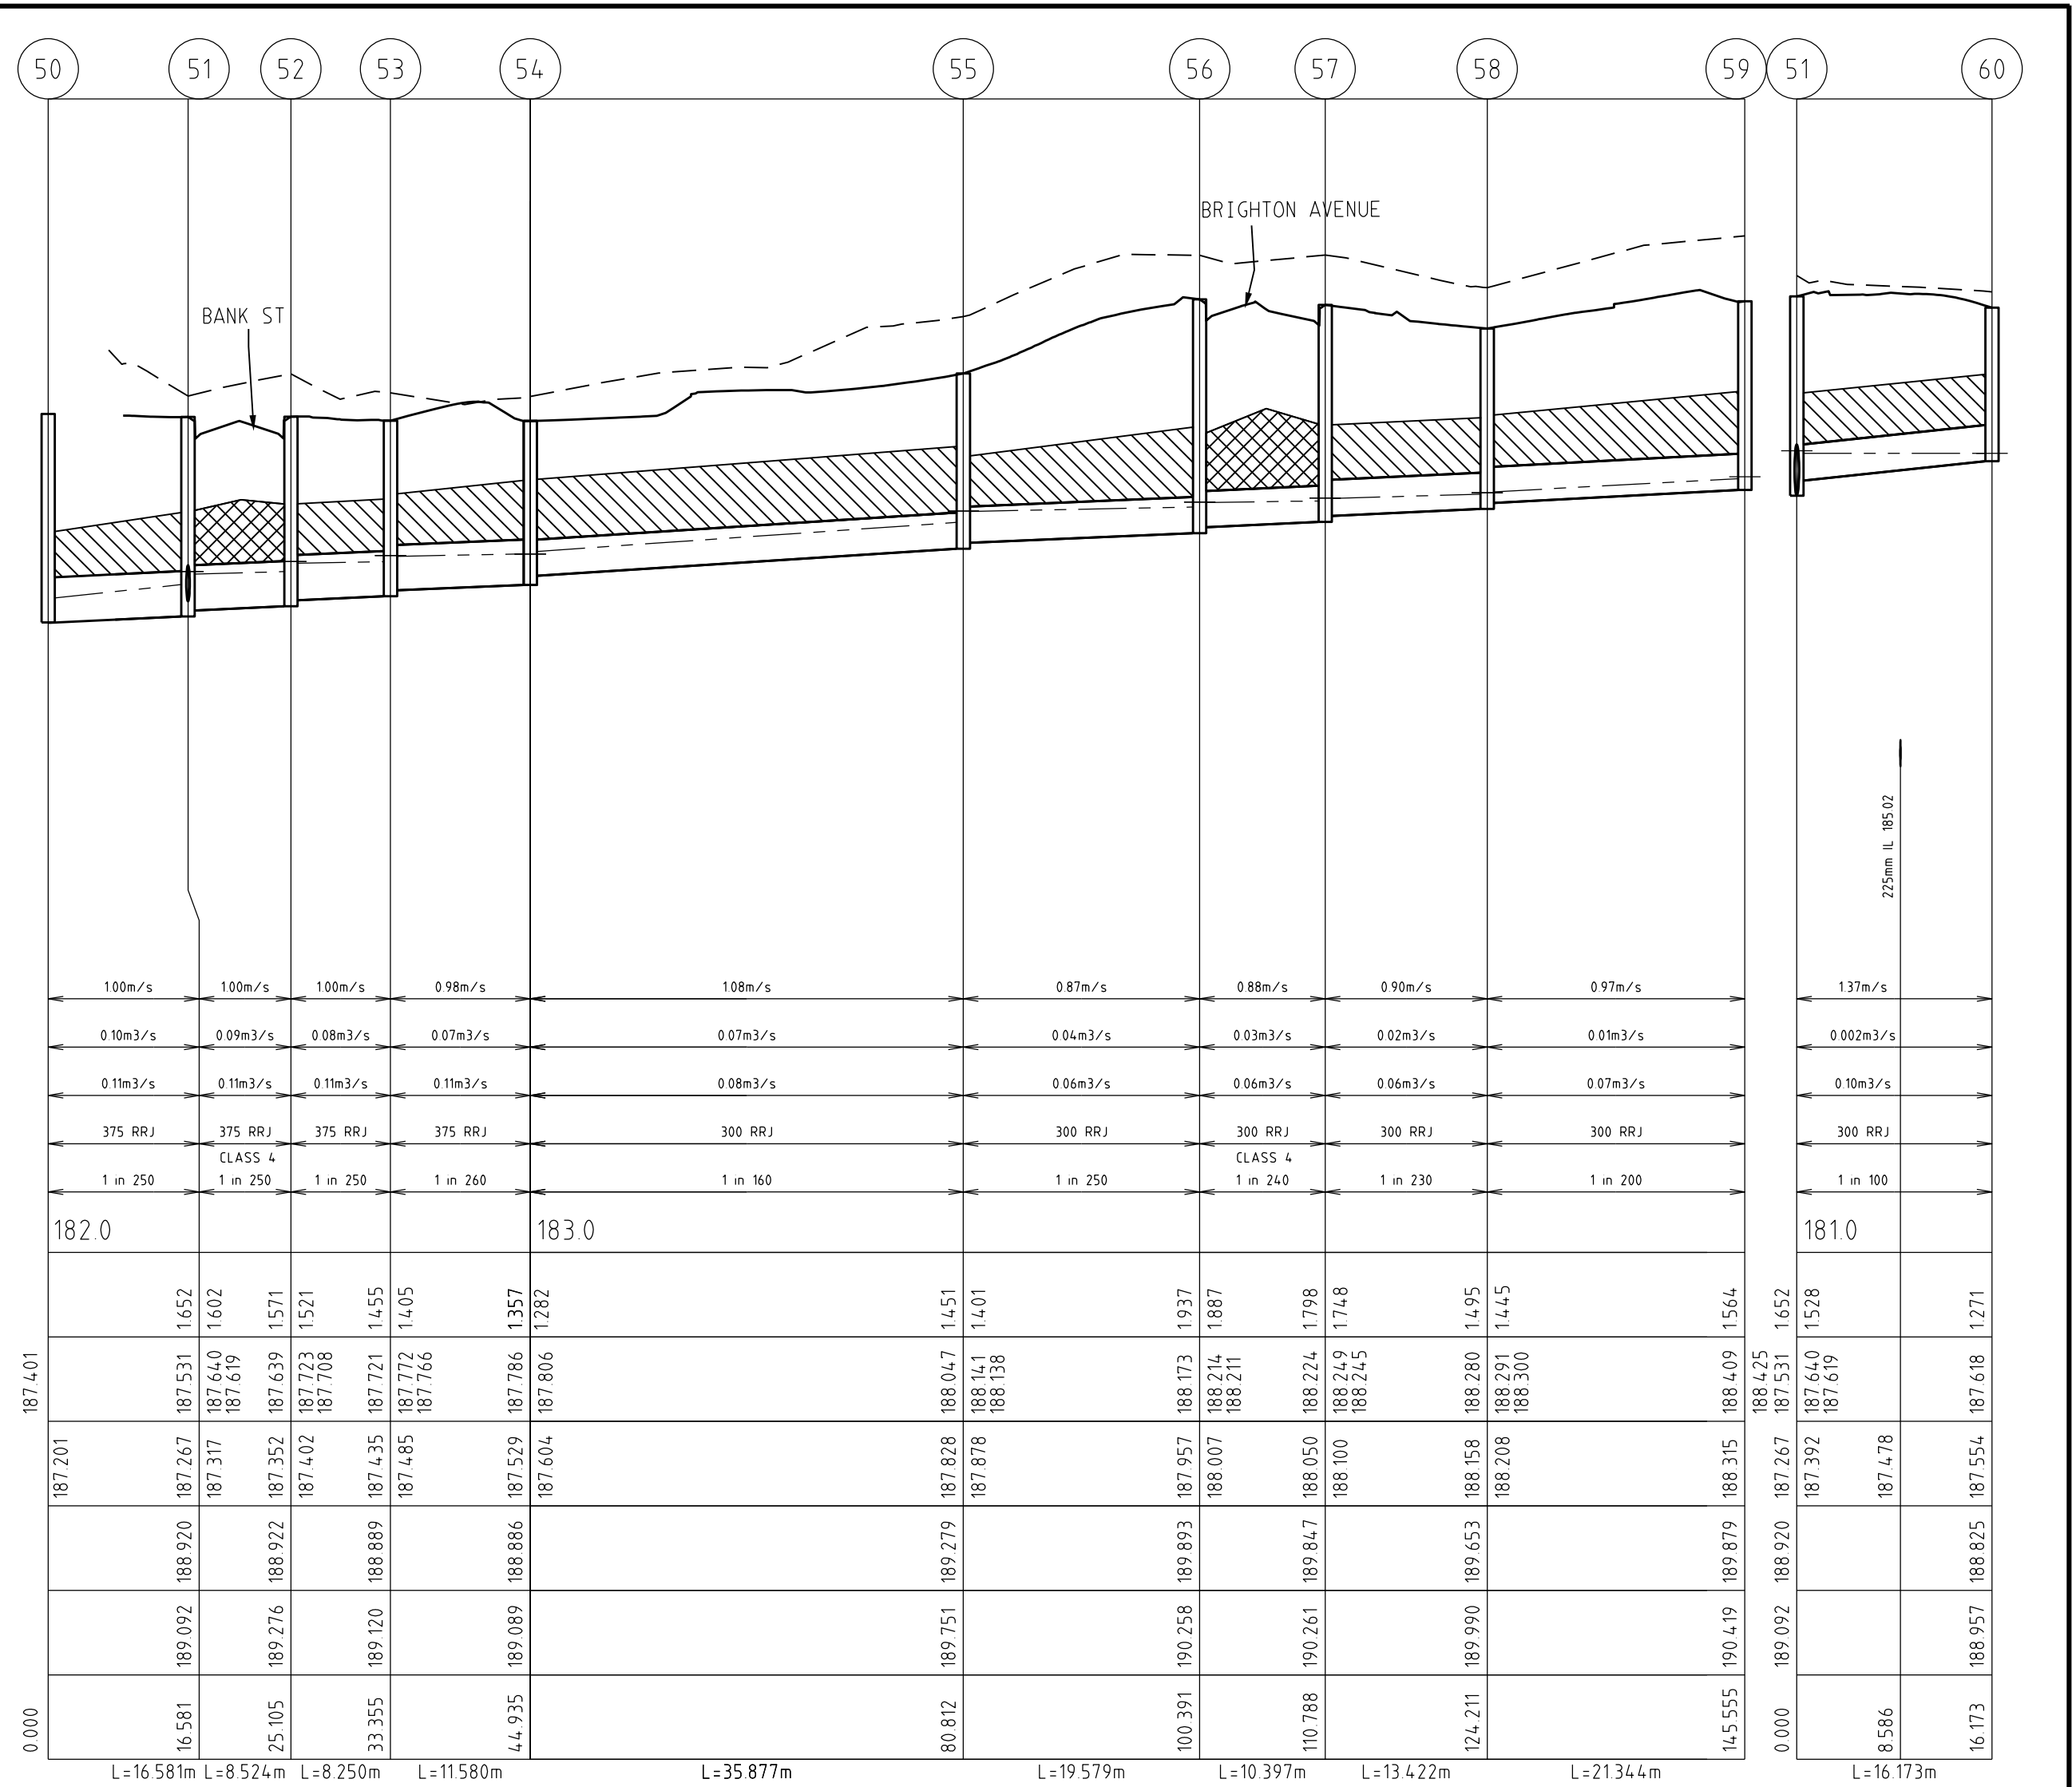


PIT SCHEDULE										
PIT No.	PIT DESCRIPTION	LENGTH	WIDTH	INLET		OUTLET		TOP PIT RL	DEPTH INVERT	REMARKS
				INVERT	DIA	INVERT	DIA			
41	GRADED ENTRY PIT (B2)	900	900	186.79	600	186.74	600	188.64	1.90	EDCM STD DWG 601 (HAUNCHED)
42	GRADED ENTRY PIT (B2)	900	900	187.09	300	188.35	600	190.09	1.74	EDCM STD DWG 601 (HAUNCHED)
43	GRADED ENTRY PIT (B2)	900	900	189.05	300	189.00	600	191.01	2.01	EDCM STD DWG 601, TYPE D GATIC LID
44	GRADED ENTRY PIT (B2)	900	600	189.15	300	189.10	300	190.94	1.84	EDCM STD DWG 601
45	GRADED ENTRY PIT (B2)	900	600			189.05	300	190.86	1.63	EDCM STD DWG 601
46	GRADED ENTRY PIT (B2)	900	600			187.19	300	188.62	1.43	EDCM STD DWG 601
47	GRADED ENTRY PIT (B2)	900	600			188.76	300	190.08	1.32	EDCM STD DWG 601
48	END PIPE					189.71	600	191.42	1.71	BLANK END
50	END PIPE			187.201	375					TEMPORARY SANDBAG ENDWALL
51	GRADED ENTRY PIT (B2)	900	600	187.317	375	187.267	375	188.92	1.652	EDCM STD DWG 601
52	GRADED ENTRY PIT (B2)	900	600	187.392	300					
53	GRADED ENTRY PIT (B2)	900	600	187.402	375	187.352	375	188.922	1.571	EDCM STD DWG 601
54	GRADED ENTRY PIT (B2)	900	600	187.485	375	187.435	375	188.889	1.455	EDCM STD DWG 601
55	GRADED ENTRY PIT (B2)	900	600	187.604	300	187.529	375	188.886	1.357	EDCM STD DWG 601
56	GRADED ENTRY PIT (B2)	900	600	187.878	300	187.828	300	189.279	1.451	EDCM STD DWG 601
57	JUNCTION PIT	900	600	188.007	300	187.957	300	189.893	1.937	EDCM STD DWG 605
58	JUNCTION PIT	900	600	188.100	300	188.050	300	189.847	1.798	EDCM STD DWG 605
59	GRADED ENTRY PIT (B2)	900	600	188.208	300	188.158	300	189.653	1.445	EDCM STD DWG 601
60	GRADED ENTRY PIT (B2)	900	600			188.315	300	189.879	1.564	EDCM STD DWG 601
61	GRADED ENTRY PIT (B2)	900	600			187.554	300	188.825	1.271	EDCM STD DWG 601
62	GRADED ENTRY PIT (B2)	900	600			188.294	300	189.860	1.565	EDCM STD DWG 601
61	GRADED ENTRY PIT (B2)	900	600			188.201	300	189.896	1.695	EDCM STD DWG 601

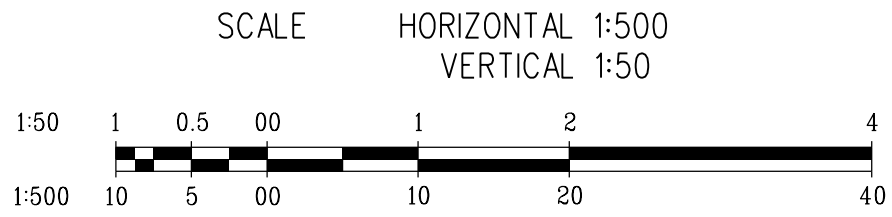

1. WHERE PIT HAUNCHING IS REQUIRED, INTERNAL PIT WALL DIMENSIONS MUST ALLOW 50mm CLEARANCE EACH SIDE OF PIPE OUTSIDE DIAMETER, INCLUDING ANGULAR PIPE ENTRY TO PIT. MINIMUM DIMENSIONS OF PIT BASE ARE TO BE AS PER SIZES SPECIFIED IN THE PIT SCHEDULE. TOP OF PIT OPENING FOR ALL HAUNCHED PITS TO BE 900mm x 600mm.
2. PIT BASE TO BE SHAPED TO MATCH LOWER HALF OF PIPE WHERE DROP ACROSS PIT IS LESS THAN 50mm.
3. PROVIDE BICYCLE SAFE "V" SHAPED CLASS D GRATE (600mm MIN WIDTH).

— - — INDICATES 5YR HGL

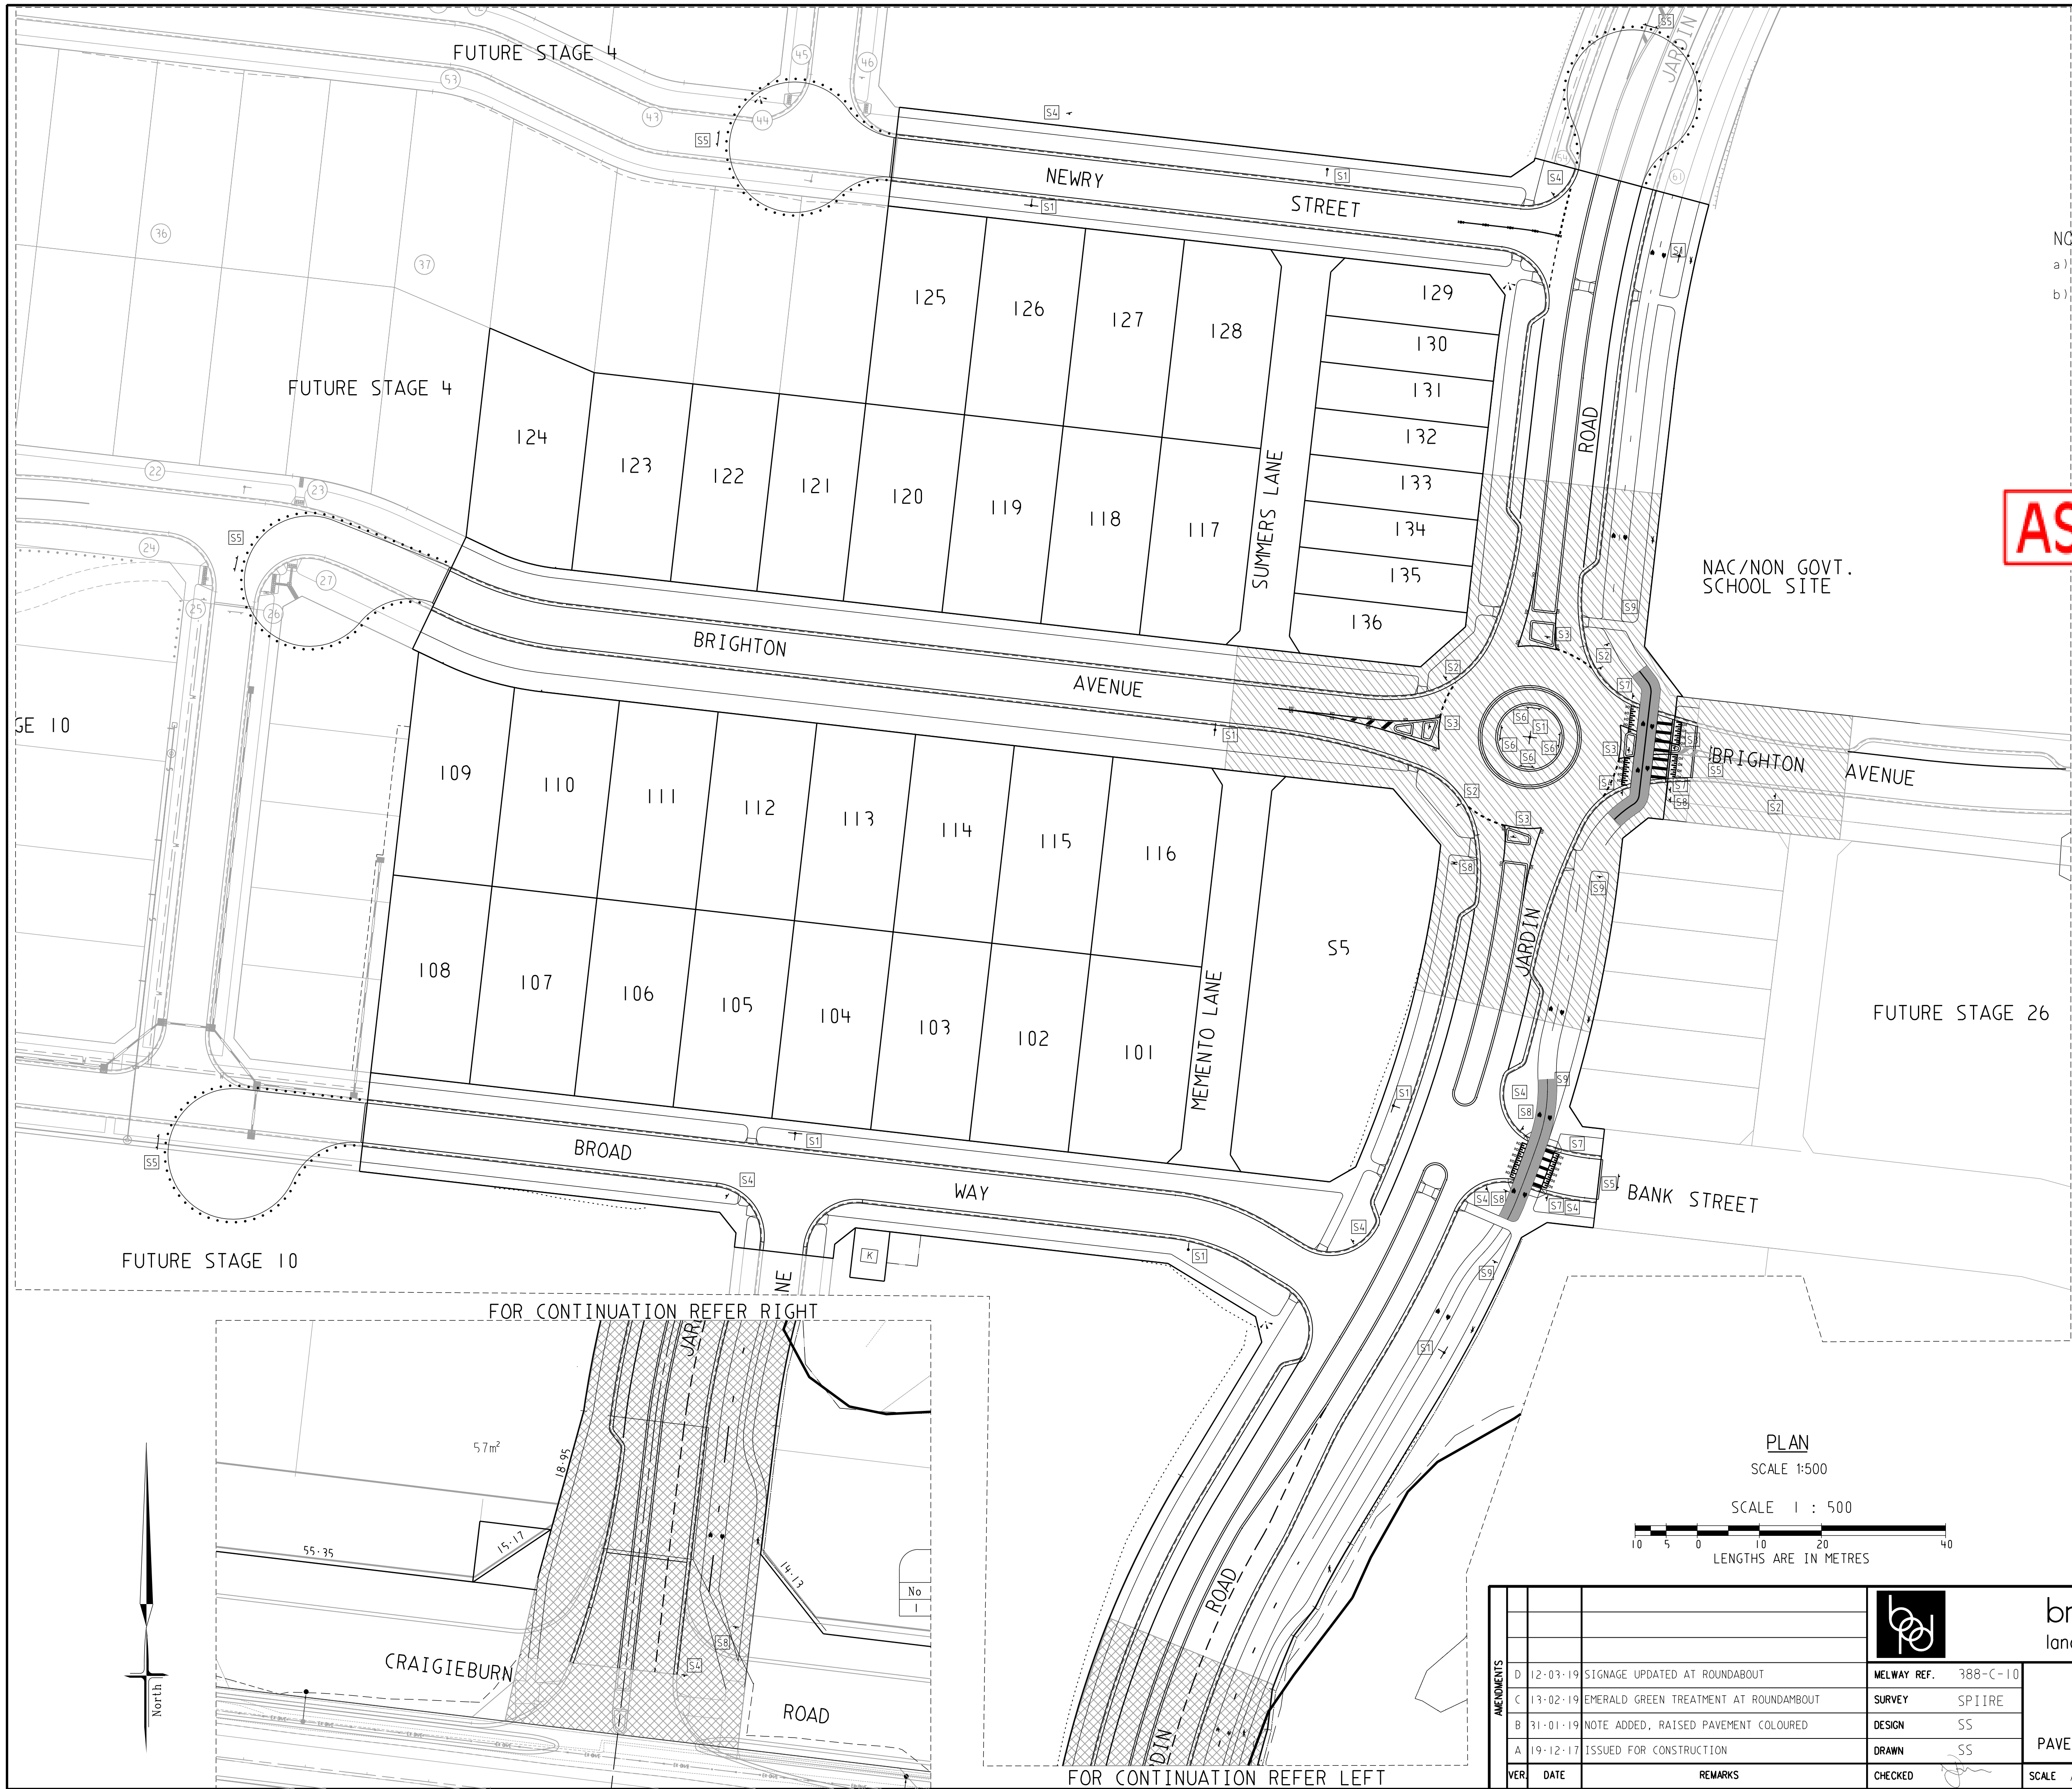

- NOTES
- a) ALL SIGNS TO BE SLEEVED USING A SL27 SLEEVE.
 - b) RAISED CONCRETE PAVEMENT AND BICYCLE PATH SHOWN SHADED TO BE COLOURED EMERALD GREEN G13 AND MEET REQUIREMENTS SET OUT IN VICROADS SPECIFICATIONS SECTION 431 - COLOURED SURFACE TREATMENTS.

AS CONSTRUCTED

PAVEMENT LEGEND

- EXTENT OF ROUNDABOUT PAVEMENT
- EXTENT OF INTERSECTION PAVEMENT

SIGNAGE & LINEMARKING LEGEND

- S1 "STREET" SIGN
- S2 "ROUNDABOUT" SIGN (R1-3)
- S3 "KEEP LEFT" SIGN (R2-3L)
- S4 "GIVE WAY" SIGN (R1-2A)
- S5 "NO ROAD" SIGN & "HAZARD" SIGN (G9-18)
- S6 HAZARD BOARD (D4-1-1)
- S7 PEDESTRIAN CROSSING SIGN (R3-1)
- S8 BICYCLE / PEDESTRIAN WARNING (W6-9) & W8-23
- S9 SEGREGATED FOOTWAY (R8-3)

PLAN
SCALE 1:500
SCALE 1 : 500
LENGTHS ARE IN METRES

AMENDMENTS				breese pitt dixon pty. ltd. land surveyors civil engineers			1/19 coto street hawthorn east, 3123 telephone 8823 2300 fax no. 8823 2310						
D	12-03-19	SIGNAGE UPDATED AT ROUNDABOUT	MELWAY REF.	388-C-10	RATHDOWNE ESTATE STAGE 1 PAVEMENT, SIGNAGE AND LINE MARKING PLAN			MUNICIPALITY	WHITTLESEA				
C	13-02-19	EMERALD GREEN TREATMENT AT ROUNDABOUT	SURVEY	SPIIRE				REFERENCE					
B	31-01-19	NOTE ADDED, RAISED PAVEMENT COLOURED	DESIGN	SS				9365 E/1					
A	19-12-17	ISSUED FOR CONSTRUCTION	DRAWN	SS									
VER	DATE	REMARKS	CHECKED		SCALE	AS SHOWN	DATUM	AHD	DATE	JAN'17	SHEET	19 OF 19	D