




Levels Table			
No.	Min. Fill	Max. Fill	Colour
1	0.3	0.6	
2	0.6	1.0	
3	1.0	2.0	
4	2.0	3.0	

NOTES: FILL DEPTHS ARE A COMPARISON BETWEEN EXISTING SURFACE & BULK EARTHWORKS CONCEPT DESIGN SURFACE

AS SUBMITTED TO GTS	SA	HB	06/02/23
REV	DES	DWG	CHK AUTH DATE
	REVISION		



Tomkinson
 SURVEY > ENGINEERING > PLANNING > PROJECT MANAGEMENT
 HEAD OFFICE: 57 MYERS STREET BENDIGO PH 03 5445 8700
 ABN 11 103 336 358 WWW.TOMKINSON.COM

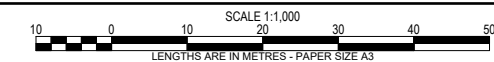

© COPYRIGHT THE INFORMATION CONTAINED ON THIS DRAWING IS THE INTELLECTUAL PROPERTY OF TOMKINSON GROUP. COPYING OR USING THIS DRAWING IN WHOLE OR IN PART WITHOUT THE EXPRESS WRITTEN PERMISSION OF TOMKINSON GROUP INFRINGES COPYRIGHT



IMAGINE STAGE 15
DUKES LANE STRATHFIELDSAYE
 AS CONSTRUCTED FILL PLAN
 CITY OF GREATER BENDIGO REF: DS/188/216
 STRATHFIELDSAYE HOLDINGS PTY LTD
 DWG STATUS: **AS CONSTRUCTED** PROJECT & DWG No: 1065315FP01/01 REV: A

NOTE: THIS IS AN UNCONTROLLED DOCUMENT AND WILL NOT BE UPDATED. IT IS THE RESPONSIBILITY OF THE USER TO CONFIRM THAT THIS IS A CURRENT COPY AND SUITABLE FOR THE PROPOSED USE - THIS SHEET MUST BE READ IN CONJUNCTION WITH ALL SHEETS OF THIS SET AND ANY ACCOMPANYING DOCUMENTS
 PLOT DATE: 06/02/2023 FILE: C:\TZ\DATA\TOMKINSON\1065315 - STRATHFIELDSAYE - IMAGINE STAGE 15_2861ENG000CAD\ASCON1065315 AC FLL PLAN REV A.DWG