


Levels Table			
No.	Min. Fill	Max. Fill	Colour
1	0.3	0.6	
2	0.6	1.0	
3	1.0	2.0	
4	2.0	3.0	
5	3.0	4.0	

NOTES: FILL DEPTHS ARE A COMPARISON BETWEEN EXISTING SURFACE & BULK EARTHWORKS CONCEPT DESIGN SURFACE

B	ADD IN POWER TRENCH FILLING IN LOT 1633	-	ZD	JM	24/08/23
A	AS SUBMITTED TO GTS	-	ZD	JM	26/05/23
REV	REVISION	DES	DWG	CHK	DATE

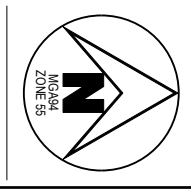

Tomkinson
 SURVEY > ENGINEERING > PLANNING > PROJECT MANAGEMENT
 HEAD OFFICE: 57 MYERS STREET BENDIGO PH 03 5445 8700
 ABN 11 103 336 358 WWW.TOMKINSON.COM



SCALE 1:1,000
 LENGTHS ARE IN METRES - PAPER SIZE A3

© COPYRIGHT THE INFORMATION CONTAINED ON THIS DRAWING IS THE INTELLECTUAL PROPERTY OF TOMKINSON GROUP. COPYING OR USING THIS DRAWING IN WHOLE OR IN PART WITHOUT THE EXPRESS WRITTEN PERMISSION OF TOMKINSON GROUP INFRINGES COPYRIGHT

IMAGINE STAGE 16
DUKES LANE STRATHFIELDSAYE
 AS CONSTRUCTED FILL PLAN
 CITY OF GREATER BENDIGO REF: DS/188/216
 STRATHFIELDSAYE HOLDINGS PTY LTD
 DWG STATUS: **AS CONSTRUCTED** PROJECT & DWG No: 1065316FP01/01

NOTE: THIS IS AN UNCONTROLLED DOCUMENT AND WILL NOT BE UPDATED. IT IS THE RESPONSIBILITY OF THE USER TO CONFIRM THAT THIS IS A CURRENT COPY AND SUITABLE FOR THE PROPOSED USE. THIS SHEET MUST BE READ IN CONJUNCTION WITH ALL SHEETS OF THIS SET AND ANY ACCOMPANYING DOCUMENTS. PLOT DATE: 24/08/2023 FILE: C:\TZ\DATA\TOMKINSON\12DS011065316 - STRATHFIELDSAYE - IMAGINE STAGE 16_2882ENGIN000CADASCON1065316 AC FLL PLAN REV 16.DWG