


Levels Table							
No.	Min. Level	Max. Level	Colour	No.	Min. Level	Max. Level	Colour
1	-5.0	-2.0	Light Purple	6	0.0	0.3	Light Green
2	-2.0	-1.0	Dark Purple	7	0.3	0.6	Yellow-Green
3	-1.0	-0.6	Blue	8	0.6	1.0	Orange
4	-0.6	-0.3	Light Blue	9	1.0	2.0	Red-Orange
5	-0.3	0.0	Cyan	10	2.0	5.0	Red

NOTES: CUT & FILL DEPTHS ARE A COMPARISON BETWEEN EXISTING SURFACE (100mm STRIPPED) & AS CONSTRUCTED EARTHWORKS SURFACE CONTRACTOR TO ENSURE A CLEAN BASE IS ACHIEVED PRIOR TO ANY FILLING.
 NS LEVELS ARE ORIGINAL AS-SURVEYED EXISTING SURFACE LEVELS PRIOR TO STRIPPING & FS LEVELS ARE FINAL FINISHED SURFACE LEVELS AFTER TOPSOILING ETC

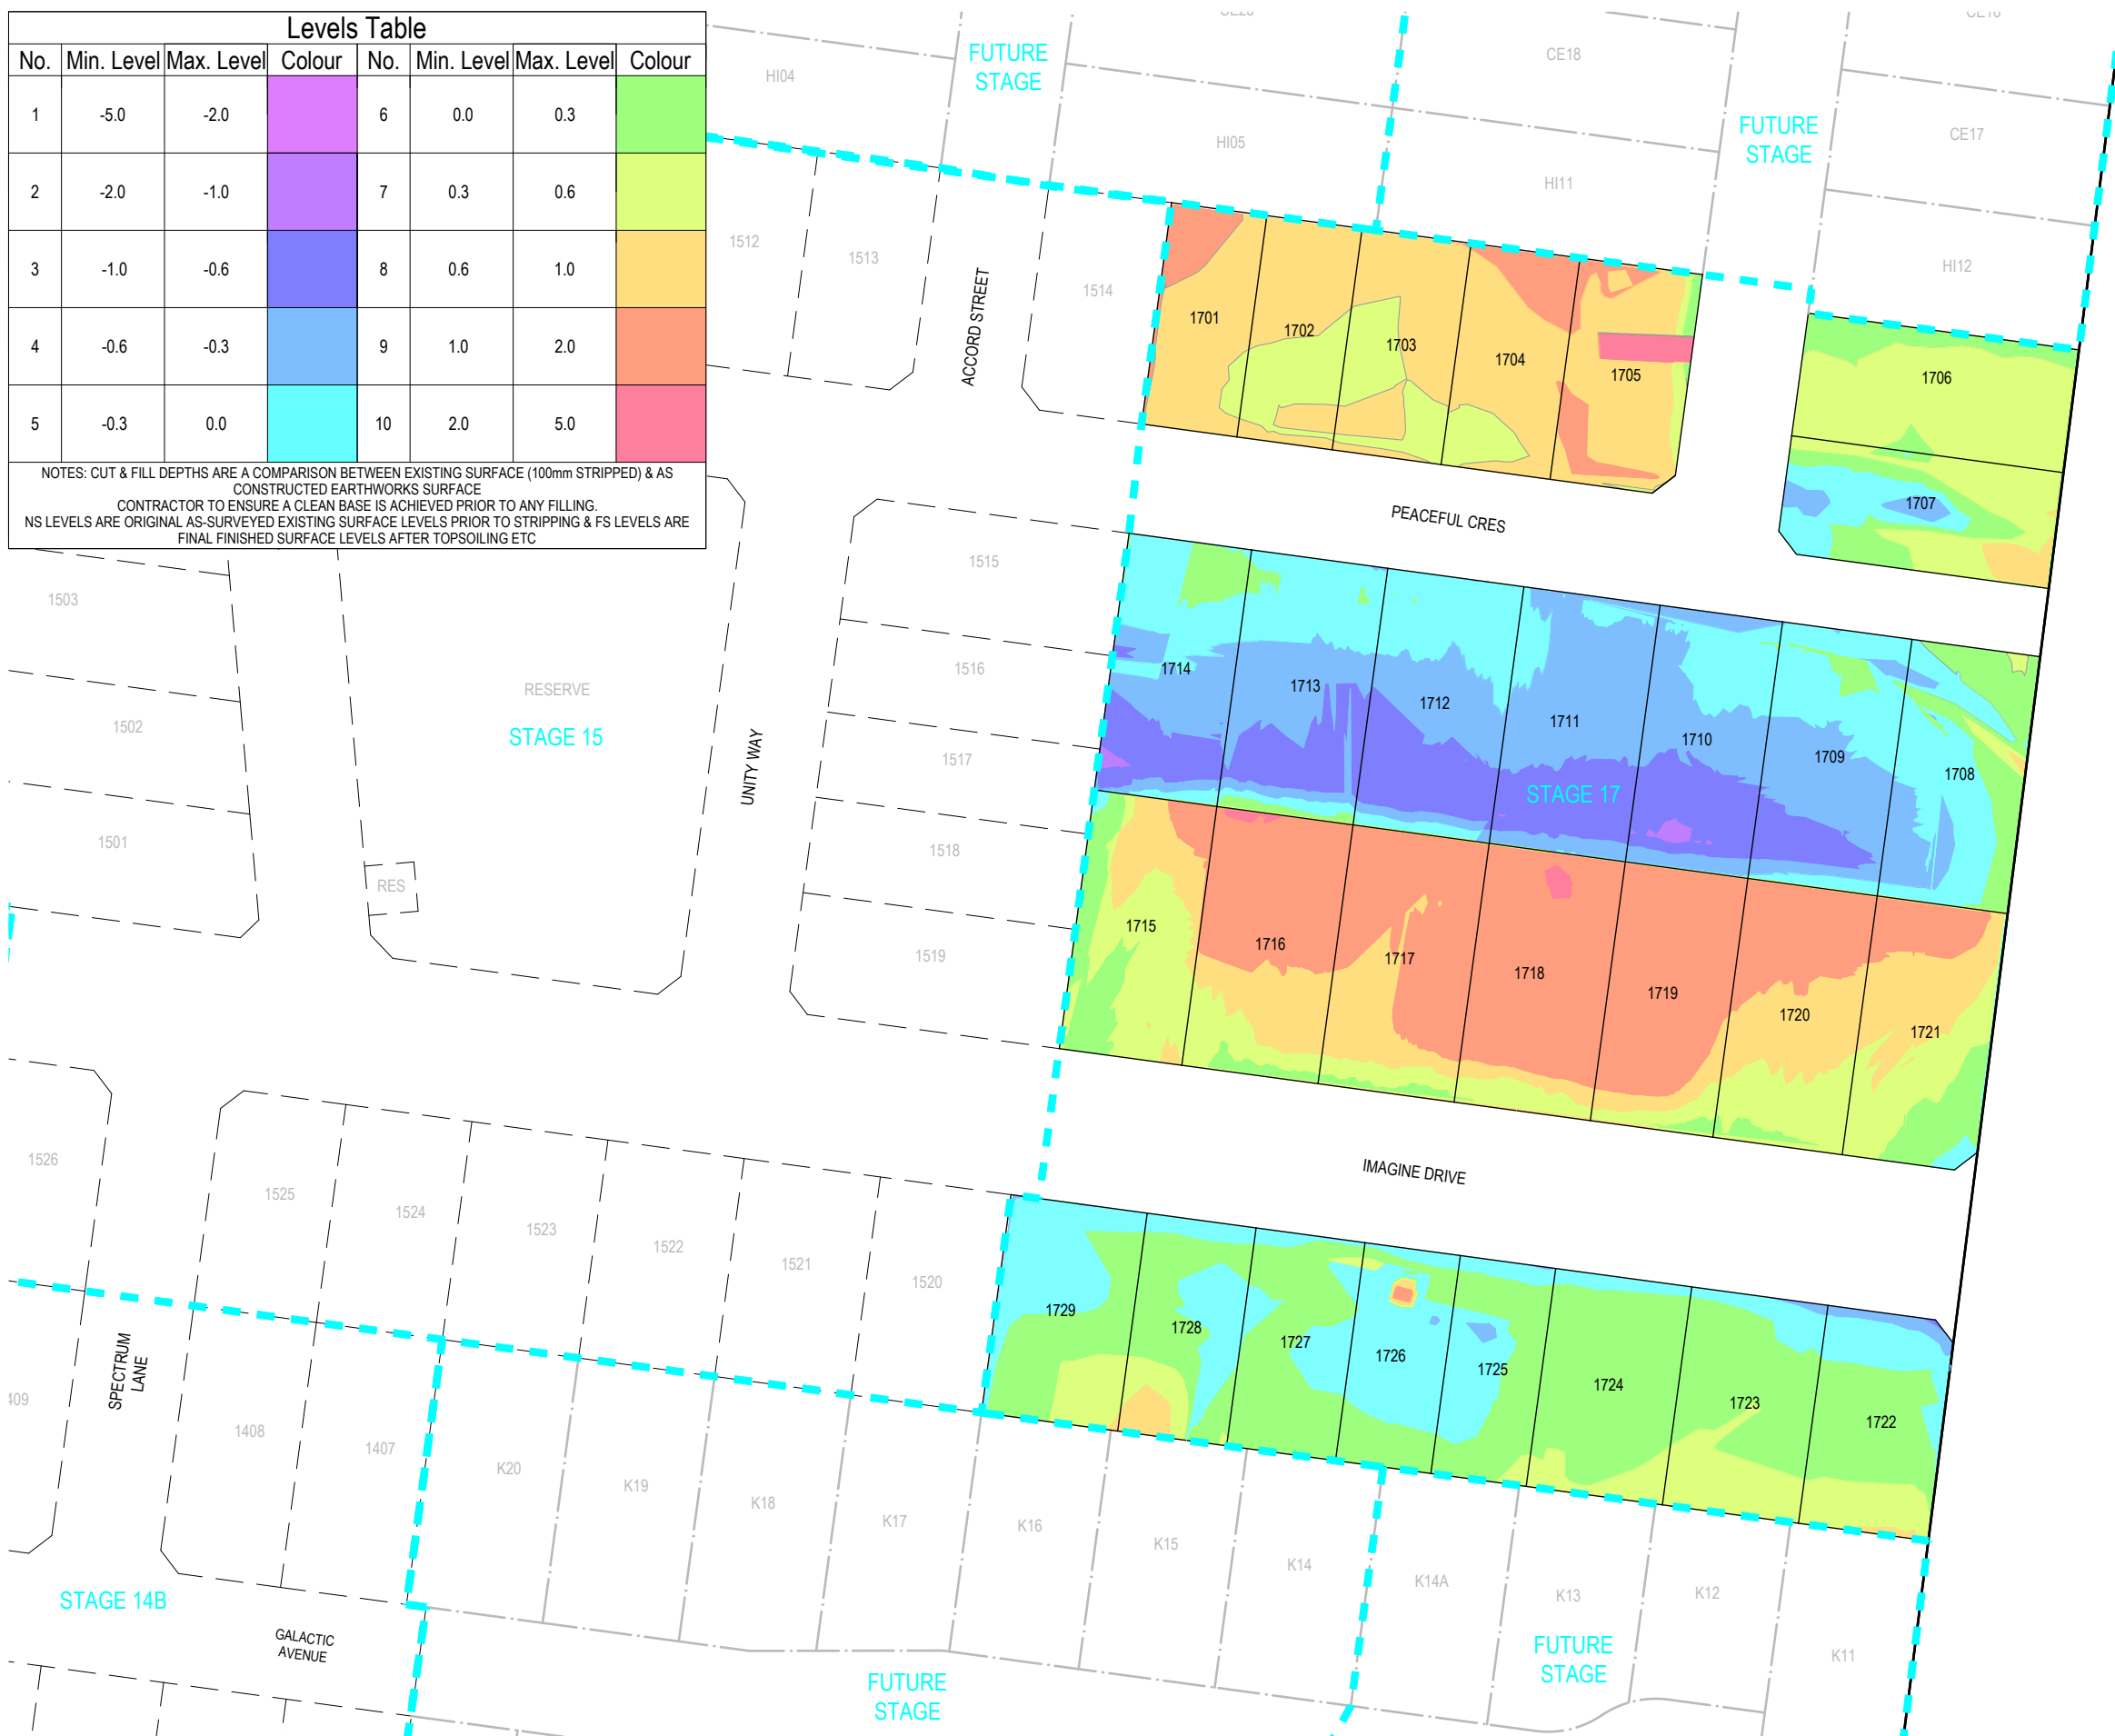

AS SUBMITTED TO CLIENT	SR	HB	19/10/23
REV	REVISION	DES	DWG
		CHK	DATE



Tomkinson
 SURVEY > ENGINEERING > PLANNING > PROJECT MANAGEMENT
 HEAD OFFICE: 57 MYERS STREET BENDIGO PH 03 5445 8700
 ABN 11 103 336 358 WWW.TOMKINSON.COM



SCALE 1:1,000
 LENGTHS ARE IN METRES - PAPER SIZE A3

© COPYRIGHT THE INFORMATION CONTAINED ON THIS DRAWING IS THE INTELLECTUAL PROPERTY OF TOMKINSON GROUP. COPYING OR USING THIS DRAWING IN WHOLE OR IN PART WITHOUT THE EXPRESS WRITTEN PERMISSION OF TOMKINSON GROUP INFRINGES COPYRIGHT

DIAL BEFORE YOU DIG
 www.100.com.au

COMPASS ASSURANCE
 ISO 9001 QUALITY

IMAGINE STAGE 17
IMAGINE DRIVE, STRATHFIELDSAYE
 AS CONSTRUCTED CUT & FILL PLAN
 CITY OF GREATER BENDIGO REF: DS/188/216
 STRATHFIELDSAYE HOLDINGS PTY LTD

DWG STATUS: **AS CONSTRUCTED** PROJECT & DWG No: 1065317FP01/01 REV: A

NOTE: THIS IS AN UNCONTROLLED DOCUMENT AND WILL NOT BE UPDATED. IT IS THE RESPONSIBILITY OF THE USER TO CONFIRM THAT THIS IS A CURRENT COPY AND SUITABLE FOR THE PROPOSED USE. THIS SHEET MUST BE READ IN CONJUNCTION WITH ALL SHEETS OF THIS SET AND ANY ACCOMPANYING DOCUMENTS. PLOT DATE: 19/10/2023 FILE: C:\12\DATA\TOMKINSON\1065317 - STRATHFIELDSAYE - IMAGINE STAGE 17_2828\ENGIN\00\CAD\AS CON1065317 AC CUT & FILL PLAN (COLOURED)\REV.DWG