

REVISION	DATE	ISSUE DESCRIPTION	DRAWN	CHECKED	APPROVED
4	21/02/20	AS CONSTRUCTED	C.R.	M.T.	T.P.
3	11/12/19	SHIFTED LOT 57 DRIVEWAY CROSSOVER LOCATION	C.R.	M.T.	T.P.
2	07/11/19	LOT 67 CROSSOVER RELOCATION & LOT 84 GWR CONDUIT MOVED	M.T.	M.T.	T.P.
1	05/09/19	SHIFTED LOT 76 DRIVEWAY & UPGRADE PIT 68 LID TO HD	S.D.	M.T.	T.P.
0	21/02/19	CONSTRUCTION ISSUE	M.T.	M.T.	T.P.
B	06/02/19	COUNCIL COMMENTS DATED 1/2/19	M.T.	M.T.	T.P.
A	19/11/18	ISSUED FOR APPROVAL	S.D.	M.T.	T.P.







DRAWING TITLE  
**WANDANA ESTATE - STAGE 5  
LAYOUT PLAN**

STATUS  
**AS CONSTRUCTED**

SCALE AT A1 1:500 @ A1	DRAWN S. DAVIES	DESIGNED M. TROUNCE
PROJECT ENGINEER A. WALE	PROJECT MANAGER T. PALIOS	DATE FIRST ISSUE NOVEMBER 2018
PROJECT No. <b>180363.5</b>	DRAWING No. <b>R200</b>	REVISION <b>4</b>



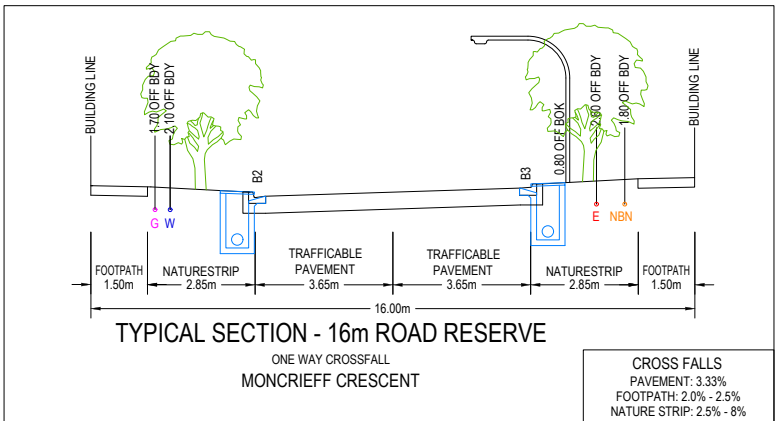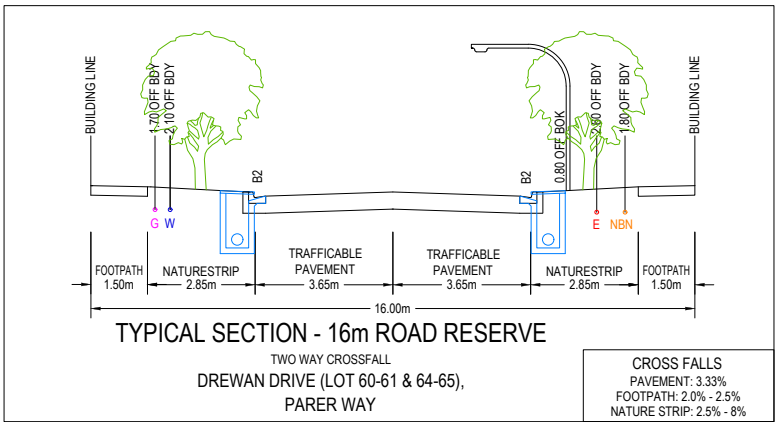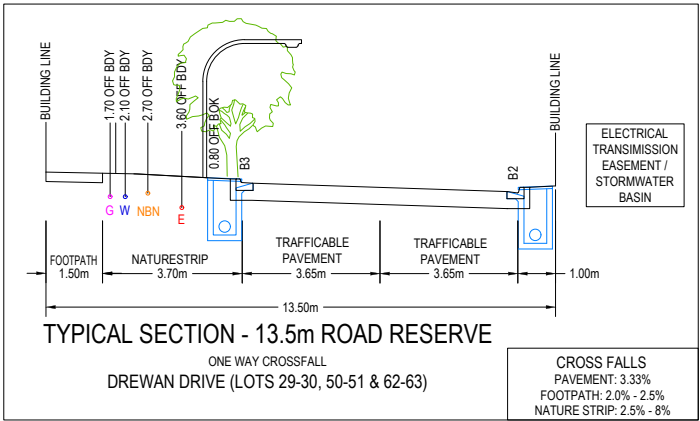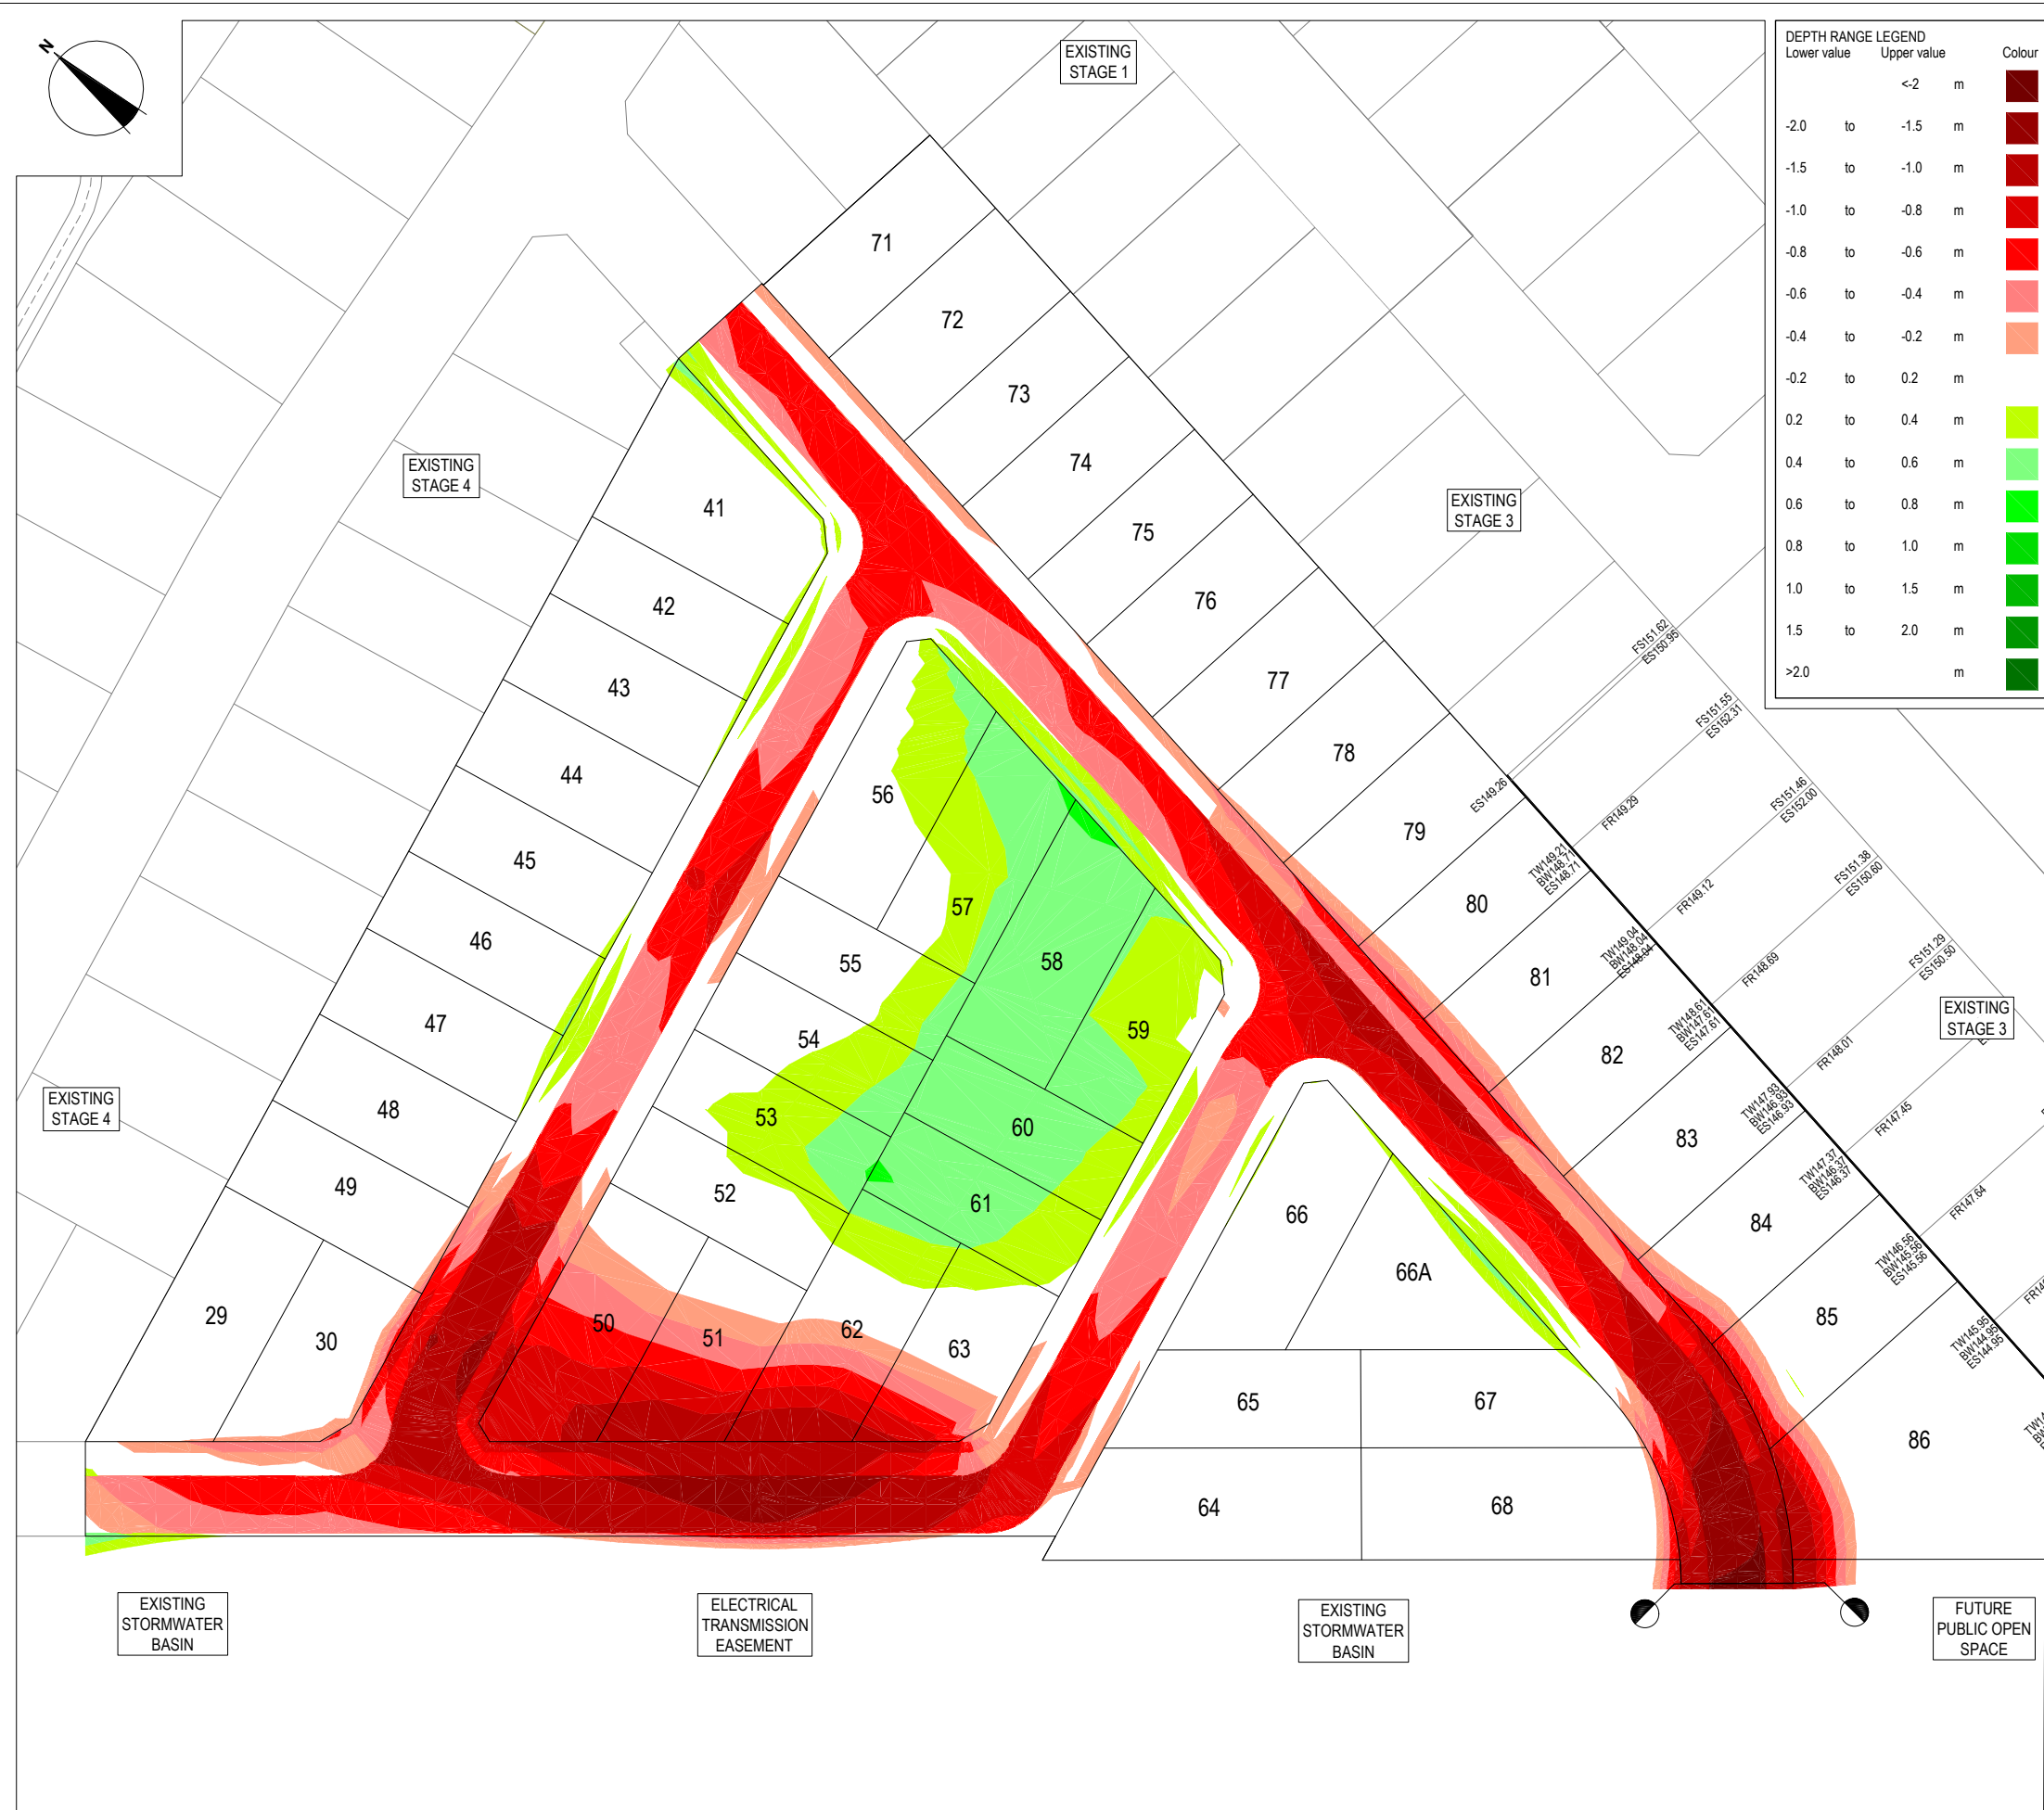

SIGNED (CONSULTANT)  
SIGNED (CONTRACTOR)

1:500 10 5 0 10 20 A1  
1:1000

REVISION	DATE	ISSUE DESCRIPTION	DRAWN	CHECKED	APPROVED
1	21/02/20	AS CONSTRUCTED	C.R.	M.T.	T.P.
0	21/02/19	CONSTRUCTION ISSUE	M.T.	M.T.	T.P.
B	06/02/19	COUNCIL COMMENTS DATED 1/2/19	M.T.	M.T.	T.P.
A	19/11/18	ISSUED FOR APPROVAL	S.D.	M.T.	T.P.

villawood  
properties  
Communities Designed for Living

creo  
CONSULTANTS  
Level 7, 176 Wellington Parade  
East Melbourne, VIC, Australia 3002

WANDANA  
Wandana Heights

DRAWING TITLE  
WANDANA ESTATE - STAGE 5  
EARTHWORKS PLAN

STATUS  
AS CONSTRUCTED

SCALE AT A1 1:500 @ A1	DRAWN S. DAVIES	DESIGNED M. TROUNCE
PROJECT ENGINEER A. WALE	PROJECT MANAGER T. PALIOS	DATE FIRST ISSUE NOVEMBER 2018
PROJECT No. 180363.5	DRAWING No. R201	REVISION 1