


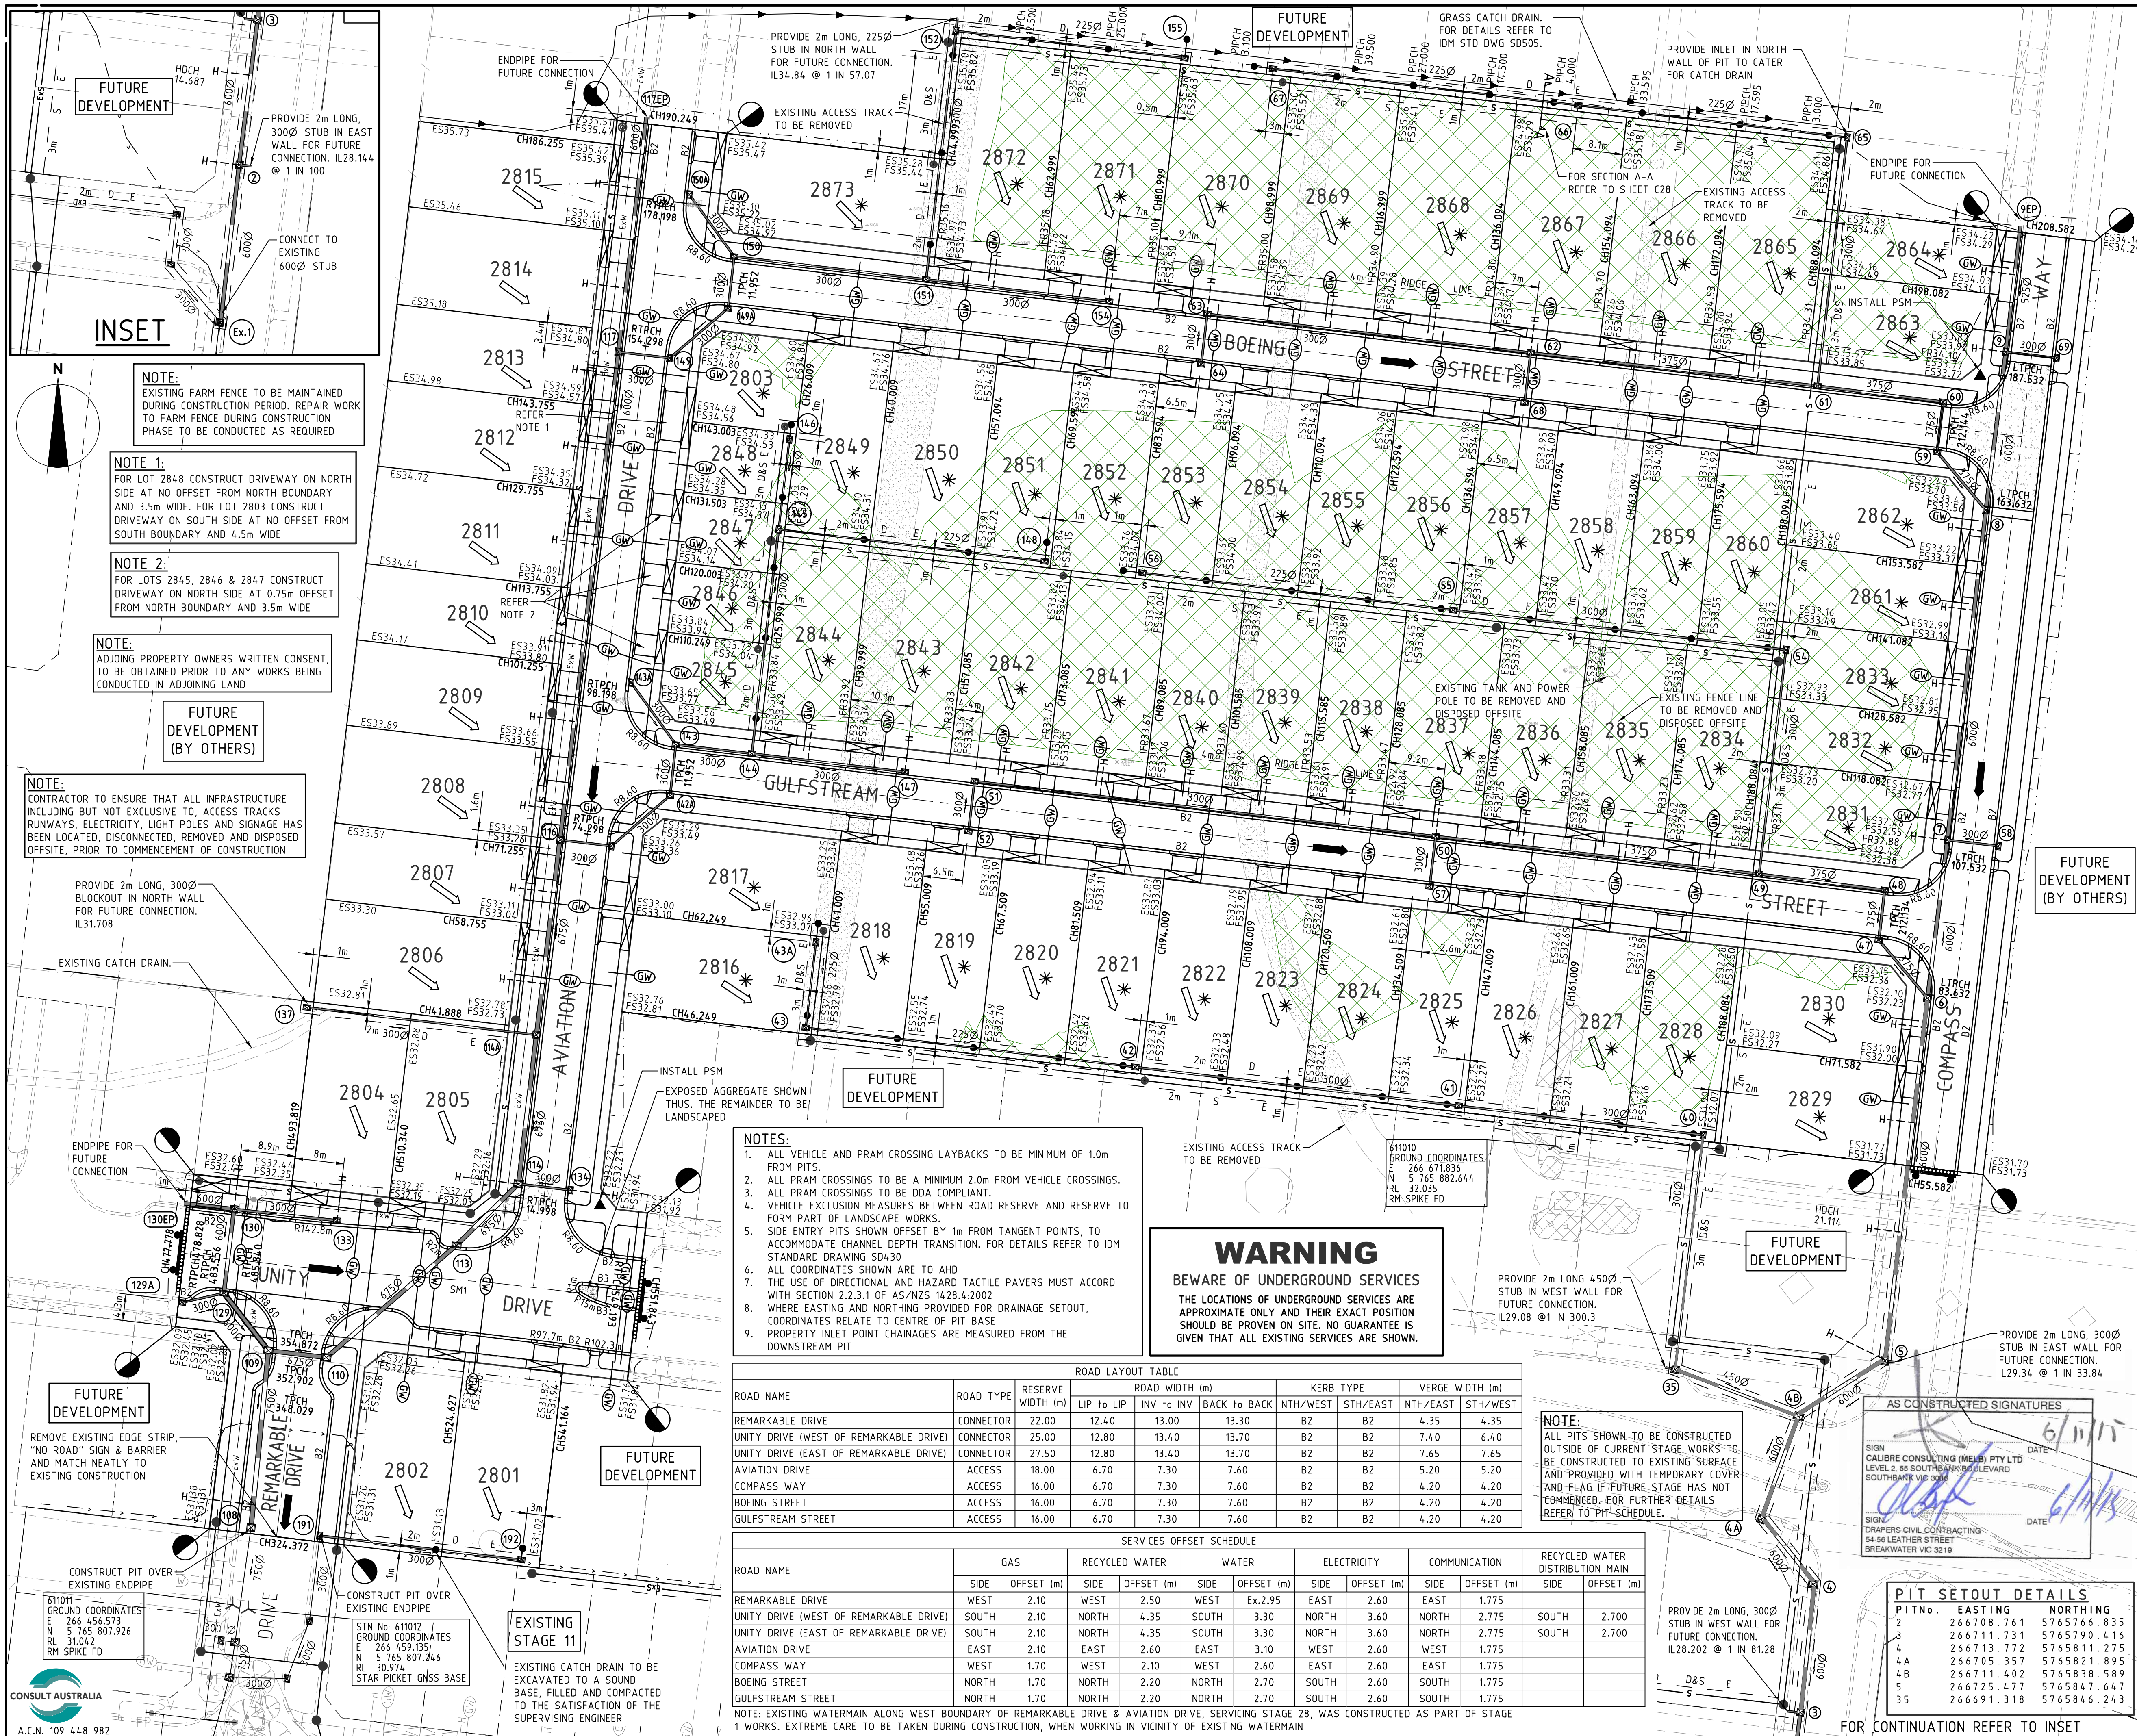

LEGEND

- E Electricity (Underground)
- G Gas
- T Telstra
- W Water
- SD Stormwater Drain, Pit and Property Inlet
- SW Swale Drain
- SM Sewer, Maintenance Structures and Property Connection
- HD House Drain
- GW Gas & Water Conduits
- TP Tactile Paver - Directional
- TH Tactile Paver - Hazard
- Ex E Existing Electricity (Underground)
- Ex H Existing Electricity (Overhead)
- Ex G Existing Gas
- Ex T Existing Telstra
- Ex W Existing Water
- Ex D Existing Stormwater Drain
- Ex S Existing Sewer
- Ex H Existing House Drain
- Ex T Existing Tree to Remain
- Ex R Existing Tree to be Removed
- Ex S Existing Swale Drain

14.134
F5140.35
FR157.40
TW159.30
BW159.30

- Existing Surface Level
- Finished Building Line Level
- Finished Ridge Line Level
- Top of Retaining Wall
- Bottom of Retaining Wall
- Retaining Wall
- Intersection Threshold Treatment
- Level 1 Fill > 200mm Deep
- Ex. Level 1 Fill > 200mm Deep
- Future Level 1 > 200mm Deep
- Proposed Driveway
- Allotment to be graded evenly in direction of fall to levels indicated
- Direction of Fall
- Overland Flow
- Permanent Survey Mark
- Temporary Bench Mark
- Concrete Edge Strip with Subsoil Drain underneath "No Road" sign and Barrier
- Building Envelope
- Limit of Works

AC	04/11/15	AS CONSTRUCTED
10	27/08/15	EXISTING LEVEL 1 FILL SHOWN ON LOTS 2827-2828
9	09/07/15	FUTURE PIP'S RELATED
8	03/07/15	LOT 2809 SERVING AMENDED
7	01/07/15	LOT 2809 DRIVEWAY RELOCATED
6	18/05/15	HOUSE DRAIN ADDED TO PIT 134
5	15/05/14	LOT 2841 DRIVEWAY RELOCATED
4	13/05/15	STUB FROM PIT 2 AMENDED
3	04/05/15	UNITY DRIVE AMENDED
2	28/04/15	ALTITUDE WAY ROAD NAME CHANGED TO COMPASS WAY
1	24/04/15	HOUSE DRAIN ADDED NORTH OF PIT 108
0	14/04/15	CONSTRUCTION ISSUE
D	01/04/15	DRAINAGE AMENDMENTS
REV	DATE	COMMENTS

COMMUNITIES DESIGNED FOR LIVING

PROJECT

MT DUNEED

STAGE 28

©2014 www.calibreconsulting.co

CALIBRE CONSULTING (MELB) PTY LTD
Level 2, 55 Southbank Boulevard
Southbank VIC 3006 T 03 9203 9000

LAYOUT PLAN

1:500 10 5 0 10 20 A1
1:1000

SCALE @ A1	DRAWN	DESIGNED
1:500	R.TALASILIA	R.KOZUL

PROJECT ENGINEER	PROJECT MANAGER	DATE FIRST ISSUE
J.CONSIGLIO	T.PALIOS	JAN 2015

AS CONSTRUCTED

SIGNED	DATE

DRAWING NUMBER	REVISION
M100611.28-C02	AC

PIT SETOUT DETAILS

PIT NO.	EASTING	NORTHING
2	266708.761	5765766.835
3	266711.731	5765790.416
4	266713.772	5765811.275
4A	266705.357	5765821.895
4B	266711.402	5765838.589
5	266725.477	5765847.647
35	266691.318	5765846.243