



LEGEND:

	COLOURED CONCRETE PAVEMENT		STREET TREE - <i>Acer truncatum</i> x <i>A. platanooides</i> 'Warrenred'		SEAT ON CONCRETE BASE (FROM COMMERCIAL SYSTEMS (TYP1 - TM4035 - WITH ARM RESTS AND TYP2 - TM4050 WITHOUT
	TUSCAN TOPPINGS FINISH		STREET TREE - <i>Pyrus calleryana</i> x <i>P. betulaeifolia</i> 'Edgewood'		BOLLARDS
	SOFT FALL MULCH		STREET TREE - <i>Acer negundo</i> 'Sensation' (150 Litre)		INTERPRETATION SIGN
	CONCRETE BY CIVIL CONTRACTOR		STREET TREE - <i>Ulmus parvifolia</i> 'Todd'		FLAGPOLES BY OTHERS
	GRASS AREAS HYDROSEED		FEATURE TREE		SCULPTURAL ELEMENT BY OTHERS
	KIKUYU TURF		EXISTING TREE TO BE RETAINED		STEEL EDGE
	MULCHED PLANTED AREAS		STREET TREE - <i>Corymbia eximia nana</i>		TIMBER EDGE
	400x400x50 PAVERS		STREET TREE - <i>Eucalyptus leucoxylon</i> ssp. <i>megalocarpa</i>		CONTRACTION JOINT AT 3m INTERVAL
	SEWER COVER				EXPANSION JOINT AT 12m INTERVAL
	STREET SIGN LOCATION				STAGE BOUNDARY
	CROSS OVER LOCATION				INDIGENOUS PLANTS ARE TO BE OBTAINED FROM APPROVED SUPPLIER AND BE OF LOCAL PROVENANCE
	UNDERGROUND WiFi				
	UNDERGROUND ELEC				

PLANT SCHEDULE STAGE 3A					
CODE	SPECIES	COMMON NAME	PLANT S/m2	COMP %	PLANT SIZE
ADVANCE TREE PLANTING STREETSCAPES					
PYR cal CH	<i>Pyrus calleryana</i> Chanticleer	ORNAMENTAL PEAR	AS SHOWN		45 Litre 30mm CAL 2.5m HIGH
PYR cal CH	<i>Ulmus parviflora</i> 'Todd'	CHINESE ELM	AS SHOWN		45 Litre 30mm CAL 2.5m HIGH
			TOTAL PLANTS		

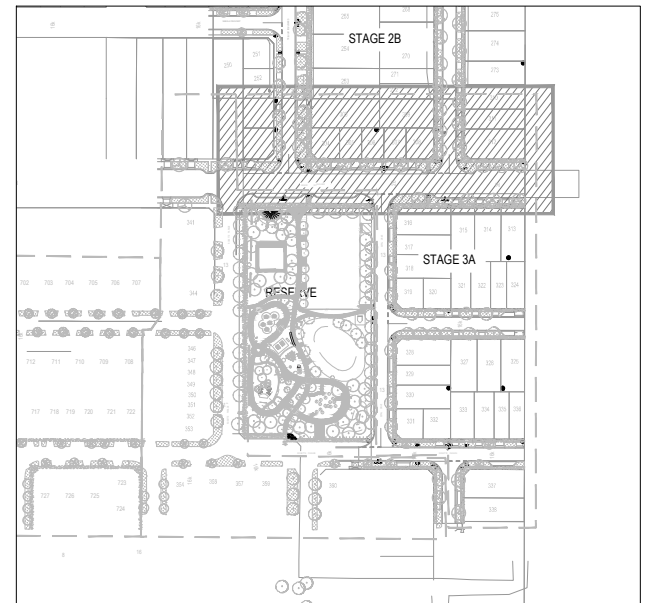

LOCATION PLAN  
1:2000

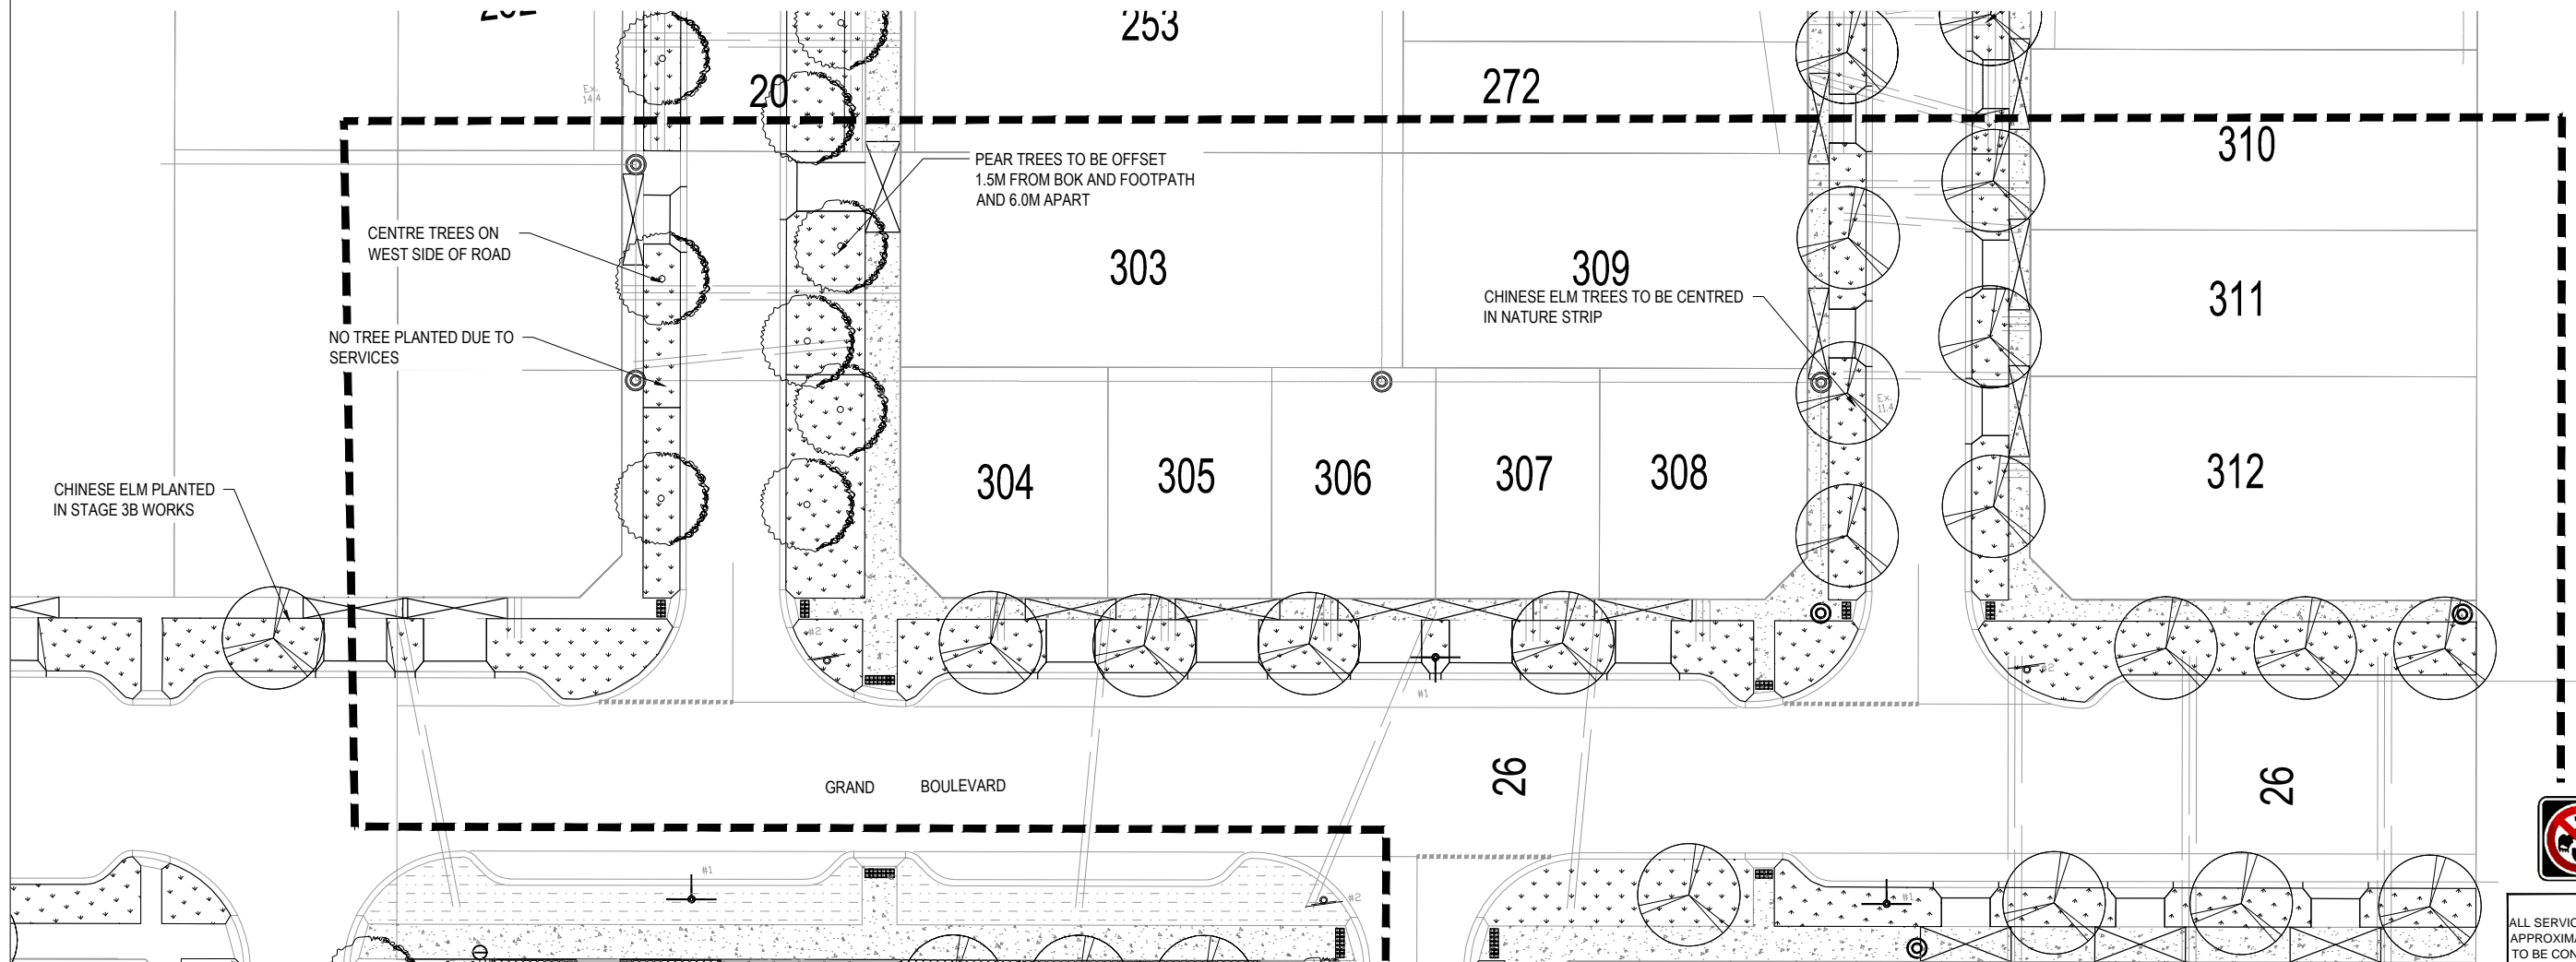

FOR CONTINUATION REFER DRAWING 31-28513-L346



WARNING  
ALL SERVICES SHOWN ON THIS DRAWING ARE APPROXIMATE ONLY AND EXACT LOCATION IS TO BE CONFIRMED ON SITE BY CONTRACTOR PRIOR TO COMMENCEMENT OF ANY WORKS.

AS BUILT





A	FIRST ISSUE	GC	GC	SG	16.03.14	
No	Revision	Note: * indicates signatures on original issue of drawing or last revision of drawing	Drawn	Job Manager	Project Director	Date



DO NOT SCALE	Drawn G.CATER	Designer G. CATER
Conditions of Use. This document may only be used by GHD's client (and any other person who GHD has agreed can use this document) for the purpose for which it was prepared and must not be used by any other person or for any other purpose.	Drafting Check	Design Check
	Approved (Project Director)	Date
	Scale 1:250	This Drawing must not be used for Construction unless signed as Approved


Client	VILLAWOOD PROPERTIES
Project	TRILLIUM DEVELOPMENT
Title	STAGE 3A - STREETSCAPE GENERAL LANDSCAPE WORKS SHEET 1 OF 4
Original Size	A1
Drawing No:	31-28513-L345
Rev:	A

LEGEND:

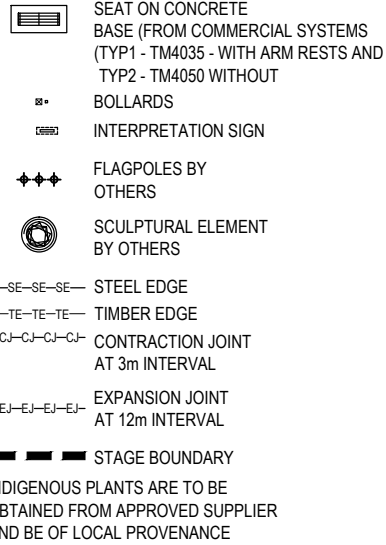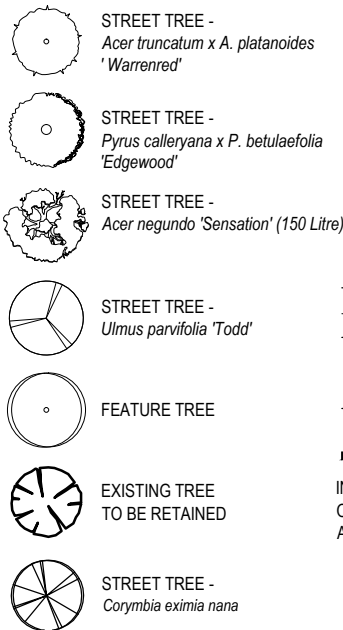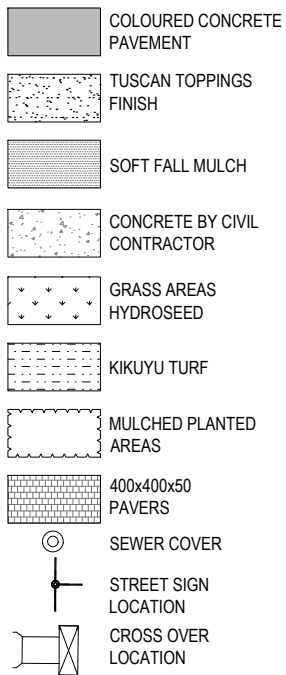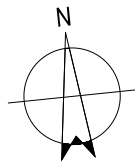


PLANT SCHEDULE STAGE 3A

CODE	SPECIES	COMMON NAME	PLANT S/m2	COMP %	PLANT SIZE
ADVANCE TREE PLANTING STREETSCAPES					
PYR cal CH	Pyrus calleryana Chanticleer	ORNAMENTAL PEAR	AS SHOWN		45 Litre 30mm CAL 2.5m HIGH
					TOTAL PLANTS

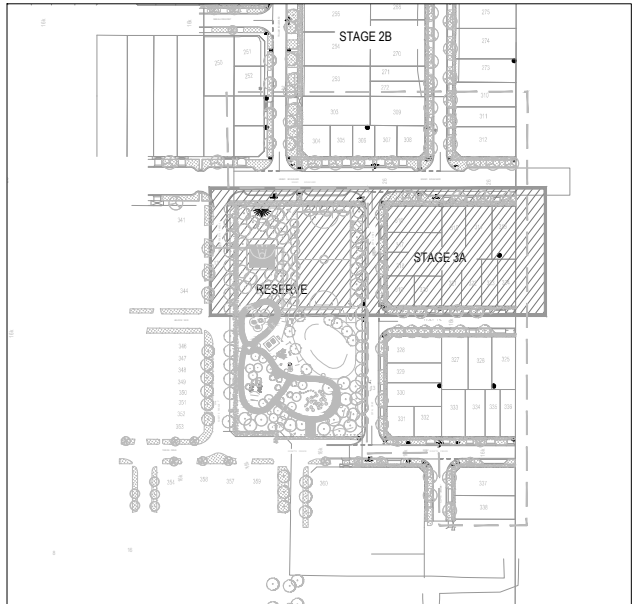

LOCATION PLAN  
1:2000

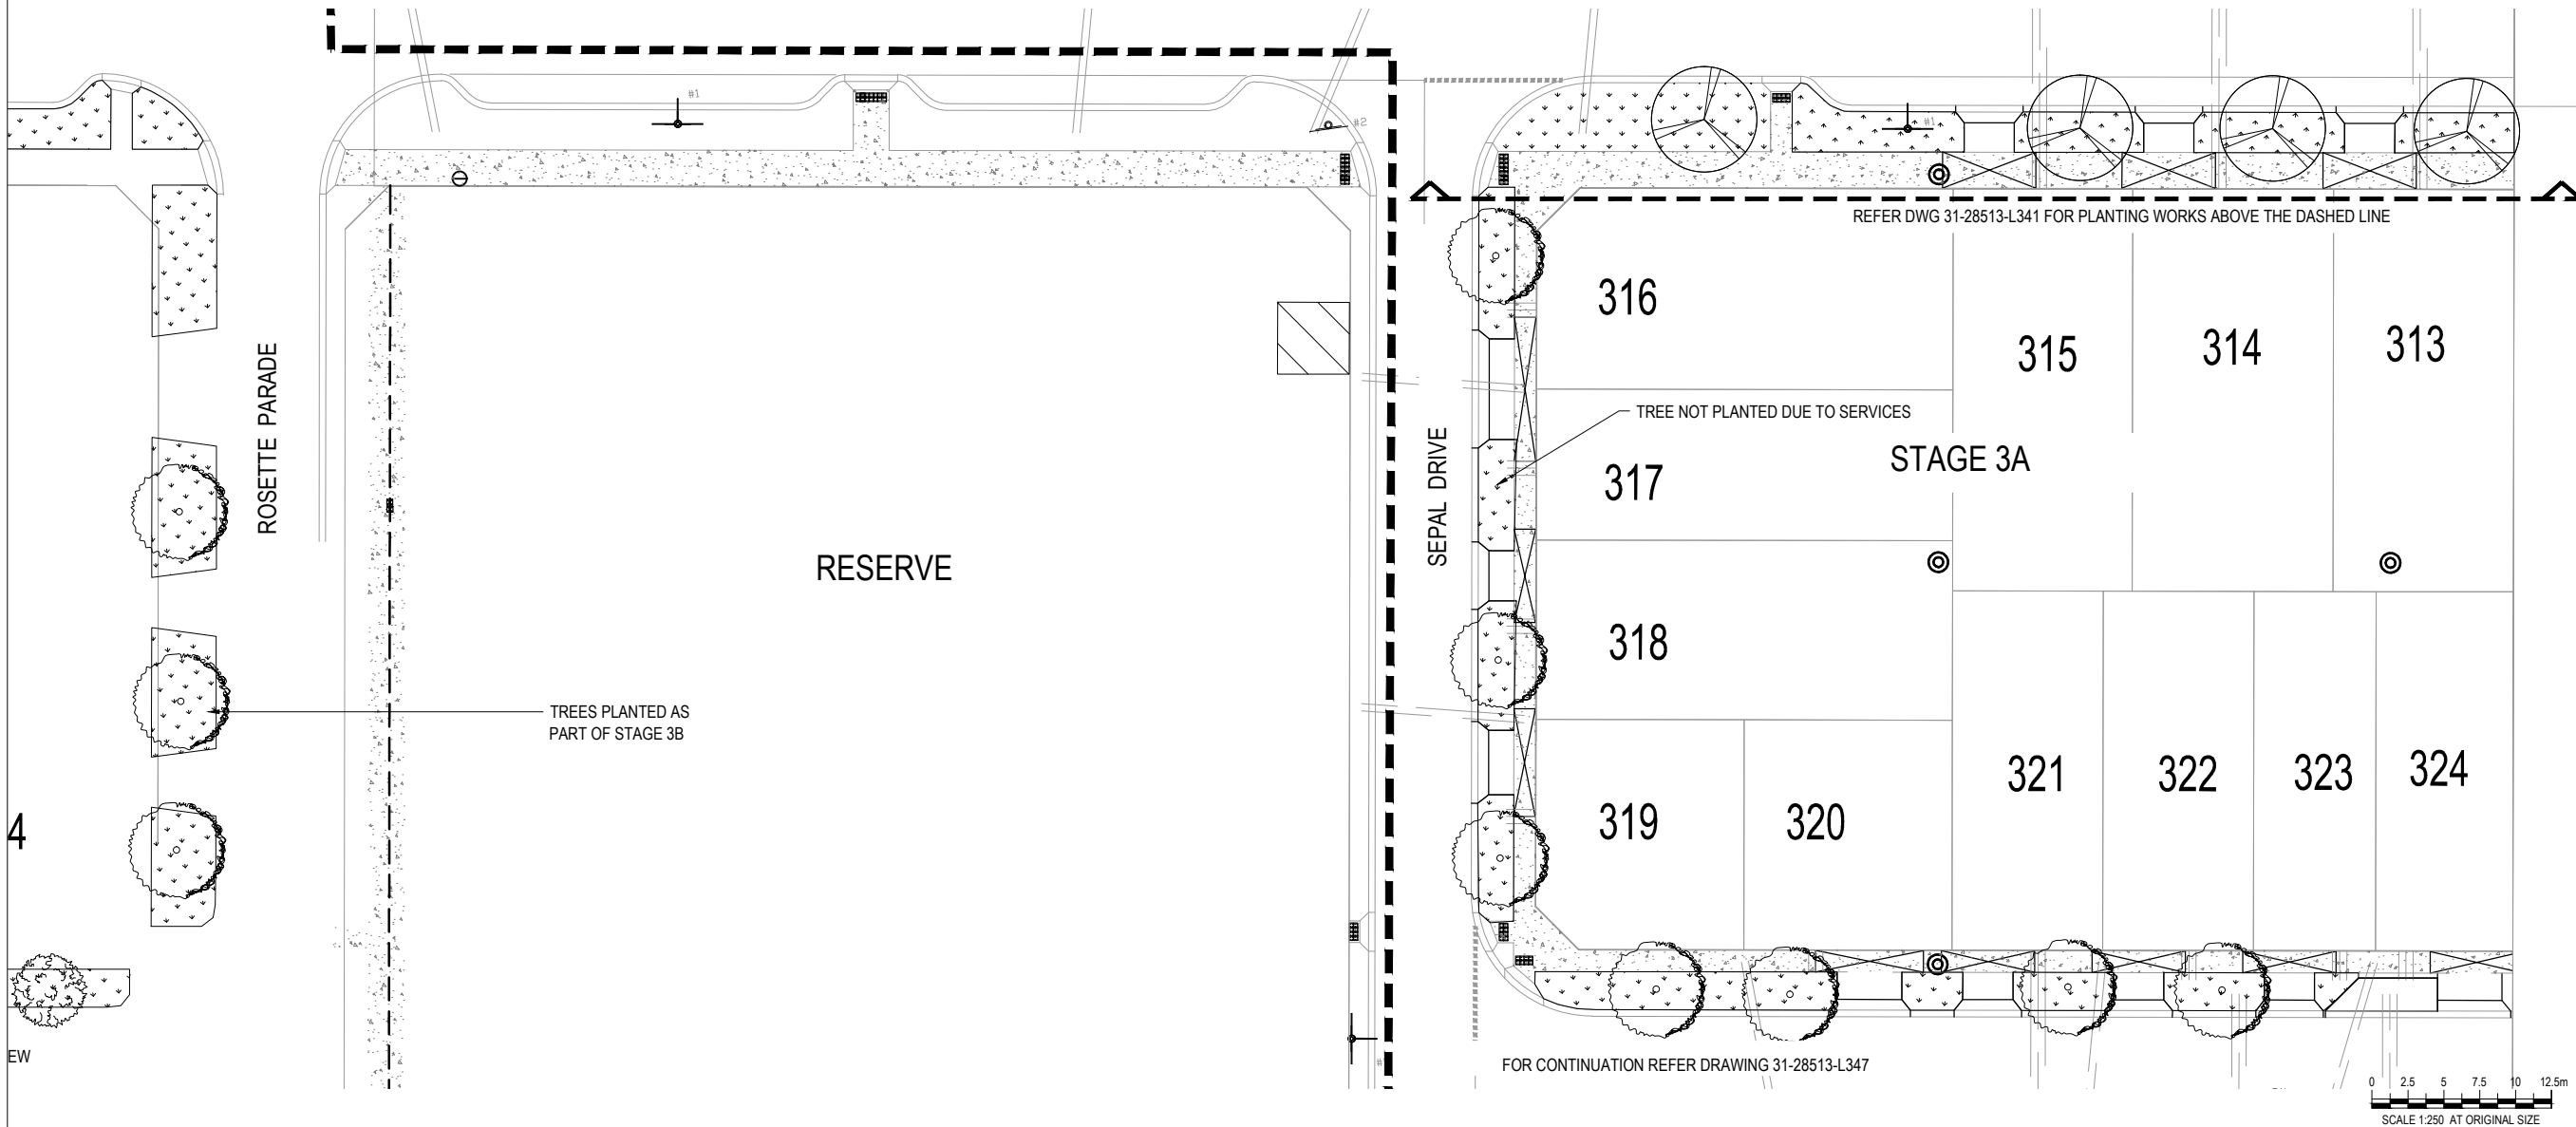

No	Revision	Note: * indicates signatures on original issue of drawing or last revision of drawing	Drawn	Job Manager	Project Director	Date
A	FIRST ISSUE		GC	GC	SG	16.10.14



Level 8, 180 Lonsdale Street, Melbourne VIC 3000 Australia  
T 61 3 8687 8000 F 61 3 8687 8111  
E mel@mail@ghd.com.au W www.ghd.com










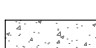






 
 






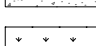


 


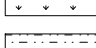

DO NOT SCALE

Conditions of Use.  
This document may only be used by GHD's client (and any other person who GHD has agreed can use this document) for the purpose for which it was prepared and must not be used by any other person or for any other purpose.


Drawn	Designer
Drafting Check	Design Check
Approved (Project Director)	Date
Scale 1:250	This Drawing must not be used for Construction unless signed as Approved

Client	VILLAWOOD PROPERTIES
Project	TRILLIUM DEVELOPMENT
Title	STAGE 3A - STREETSCAPE GENERAL LANDSCAPE WORKS SHEET 2 OF 4
Original Size	A1
Drawing No:	31-28513-L346
Rev:	A


A diagram of a compass rose. A circle represents the compass face. A vertical line passes through the center, with the letter 'N' at the top. A horizontal line also passes through the center. A magnetic needle is shown as a line with a black arrowhead pointing towards the bottom of the circle, slightly to the left of the vertical line.

 	COLOURED CONCRETE PAVEMENT		STREET TREE - <i>Acer truncatum</i> x <i>A. platanoides</i> 'Warrenred'		SEAT ON CONCRETE BASE (FROM COMMERCIAL SYSTEMS (TYP1 - TM4035 - WITH ARM RESTS AND TYP2 - TM4050 WITHOUT
	TUSCAN TOPPINGS FINISH		STREET TREE - <i>Pyrus calleryana</i> x <i>P. betulaefolia</i> 'Edgewood'		BOLLARDS
	SOFT FALL MULCH		STREET TREE - <i>Acer negundo</i> 'Sensation' (150 Litre)		INTERPRETATION SIGN
	CONCRETE BY CIVIL CONTRACTOR		STREET TREE - <i>Ulmus parvifolia</i> 'Todd'		FLAGPOLES BY OTHERS
	GRASS AREAS HYDROSEED		FEATURE TREE		SCULPTURAL ELEMENT BY OTHERS
	KIKUYU TURF		—SE—SE—SE—		STEEL EDGE
	MULCHED PLANTED AREAS		—TE—TE—TE—		CONTRACTION JOINT AT 3m INTERVAL
	400x400x50 PAVERS				EXPANSION JOINT AT 12m INTERVAL
	SEWER COVER		STREET TREE - <i>Eucalyptus leucoxylon</i> ssp. <i>megalocarpa</i>		STAGE BOUNDARY
	STREET SIGN LOCATION				INDIGENOUS PLANTS ARE TO BE OBTAINED FROM APPROVED SUPPLIER AND BE OF LOCAL PROVENANCE
	CROSS OVER LOCATION				

CODE	SPECIES	COMMON NAME	PLANT S/m2	COMP %	PLANT SIZE
ADVANCE TREE PLANTING STREETSCAPES					
EUC leu	Eucalyptus leucoxylon ssp. megalocarpa	LARGE FRUITED SA BLUE GUM	AS SHOWN		45 Litre 30mm CAL 2.5m HIGH
ULM par	<i>Ulmus parviflora 'Todd'</i>	CHINESE ELM	AS SHOWN		45 Litre 30mm CAL 2.5m HIGH
					TOTAL PLANTS

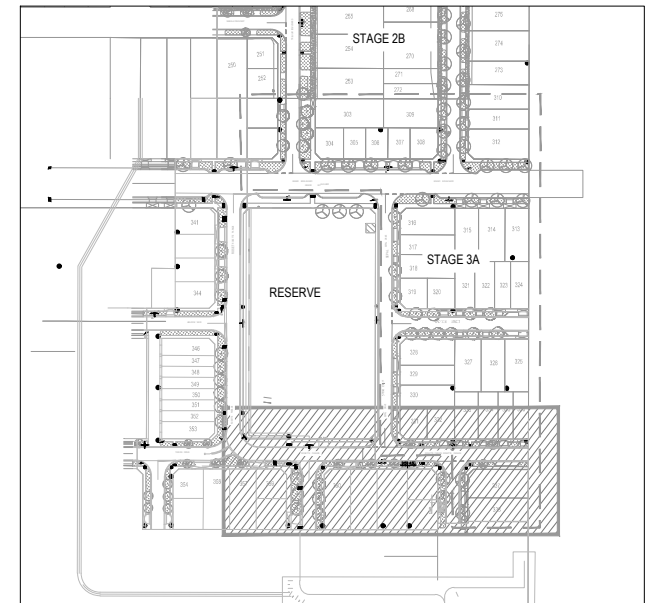

# LOCATION PLAN

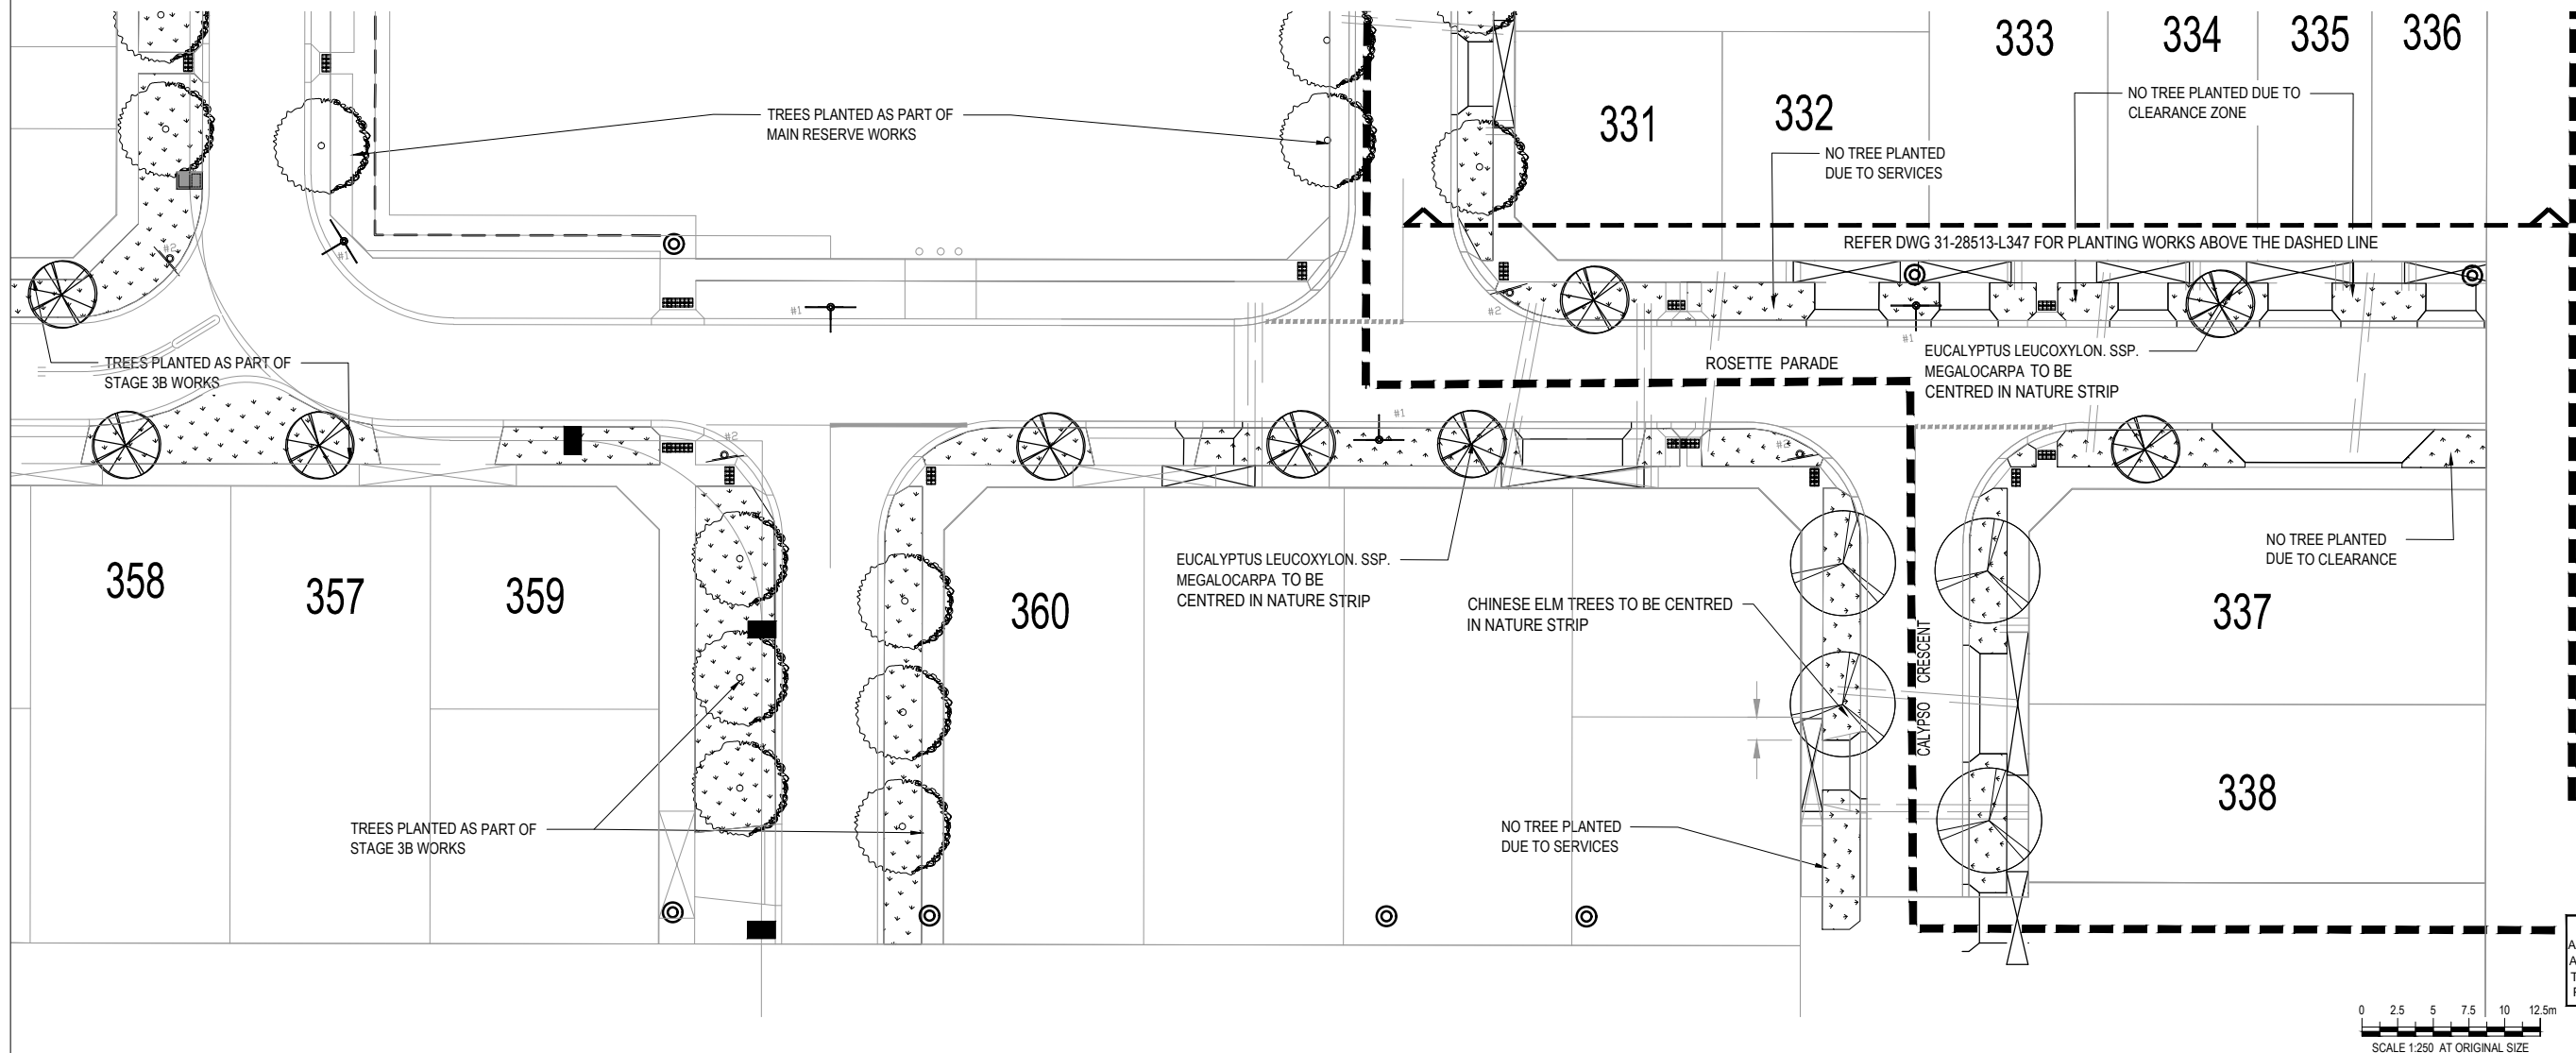

**WARNING**  
ALL SERVICES SHOWN ON THIS DRAWING ARE  
APPROXIMATE ONLY AND EXACT LOCATION IS  
TO BE CONFIRMED ON SITE BY CONTRACTOR  
PRIOR TO COMMENCEMENT OF ANY WORKS.

## AS BUILT

A	FIRST ISSUE	GC	GC	SG	16.03.14	
No	Revision	Note: * indicates signatures on original issue of drawing or last revision of drawing	Drawn	Job Manager	Project Director	Date



Level 8, 180 Lonsdale Street, Melbourne VIC 3000 Australia  
T 61 3 8687 8000 F 61 3 8687 8111  
E [melmail@ghd.com.au](mailto:melmail@ghd.com.au) W [www.ghd.com](http://www.ghd.com)

**Conditions of Use.** This document may only be used by GHD's client (and any other person who GHD has agreed can use this document) for the purpose for which it was prepared and must not be used by any other person or for any other purpose.

Drawn	Designer
Drafting Check	Design Check
Approved (Project Director) Date	
Scale 1:250	This Drawing must not be used for Construction unless stated as otherwise.










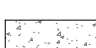






 
 






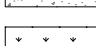


 


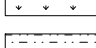
Client	VILLAWOOD PROPERTIES
Project	TRILLIUM DEVELOPMENT
Title	STAGE 3A - STREETSCAPE GENERAL LANDSCAPE WORKS SHEET 4 OF 4

Original Size **A1** Drawing No: **31-28513-L348**


ev: **A**




A diagram of a compass rose. A circle represents the compass face. A vertical line passes through the center, with the letter 'N' at the top. A horizontal line also passes through the center. A magnetic needle is shown as a line with a black arrowhead pointing towards the bottom of the circle, slightly to the left of the vertical line.

 	COLOURED CONCRETE PAVEMENT		STREET TREE - <i>Acer truncatum</i> x <i>A. platanoides</i> 'Warrenred'		SEAT ON CONCRETE BASE (FROM COMMERCIAL SYSTEMS (TYP1 - TM4035 - WITH ARM RESTS AND TYP2 - TM4050 WITHOUT
	TUSCAN TOPPINGS FINISH		STREET TREE - <i>Pyrus calleryana</i> x <i>P. betulaefolia</i> 'Edgewood'		BOLLARDS
	SOFT FALL MULCH		STREET TREE - <i>Acer negundo</i> 'Sensation' (150 Litre)		INTERPRETATION SIGN
	CONCRETE BY CIVIL CONTRACTOR		STREET TREE - <i>Ulmus parvifolia</i> 'Todd'		FLAGPOLES BY OTHERS
	GRASS AREAS HYDROSEED		FEATURE TREE		SCULPTURAL ELEMENT BY OTHERS
	KIKUYU TURF		—SE—SE—SE—		STEEL EDGE
	MULCHED PLANTED AREAS		—TE—TE—TE—		CONTRACTION JOINT AT 3m INTERVAL
	400x400x50 PAVERS				EXPANSION JOINT AT 12m INTERVAL
	SEWER COVER		STREET SIGN LOCATION		STAGE BOUNDARY
	CROSS OVER LOCATION		STREET TREE - <i>Eucalyptus leucoxylon</i> ssp. <i>megalocarpa</i>		INDIGENOUS PLANTS ARE TO BE OBTAINED FROM APPROVED SUPPLIER AND BE OF LOCAL PROVENANCE

CODE	SPECIES	COMMON NAME	PLANT S/m2	COMP %	PLANT SIZE
ADVANCE TREE PLANTING STREETSCAPES					
EUC leu	Eucalyptus leucoxylon ssp. megalocarpa	LARGE FRUITED SA BLUE GUM	AS SHOWN		45 Litre 30mm CAL 2.5m HIGH
ULM par	<i>Ulmus parviflora 'Todd'</i>	CHINESE ELM	AS SHOWN		45 Litre 30mm CAL 2.5m HIGH
					TOTAL PLANTS

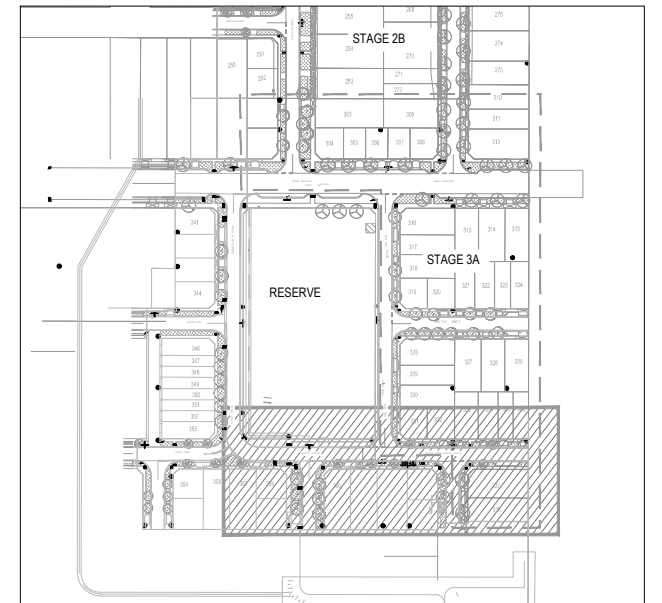

# LOCATION PLAN

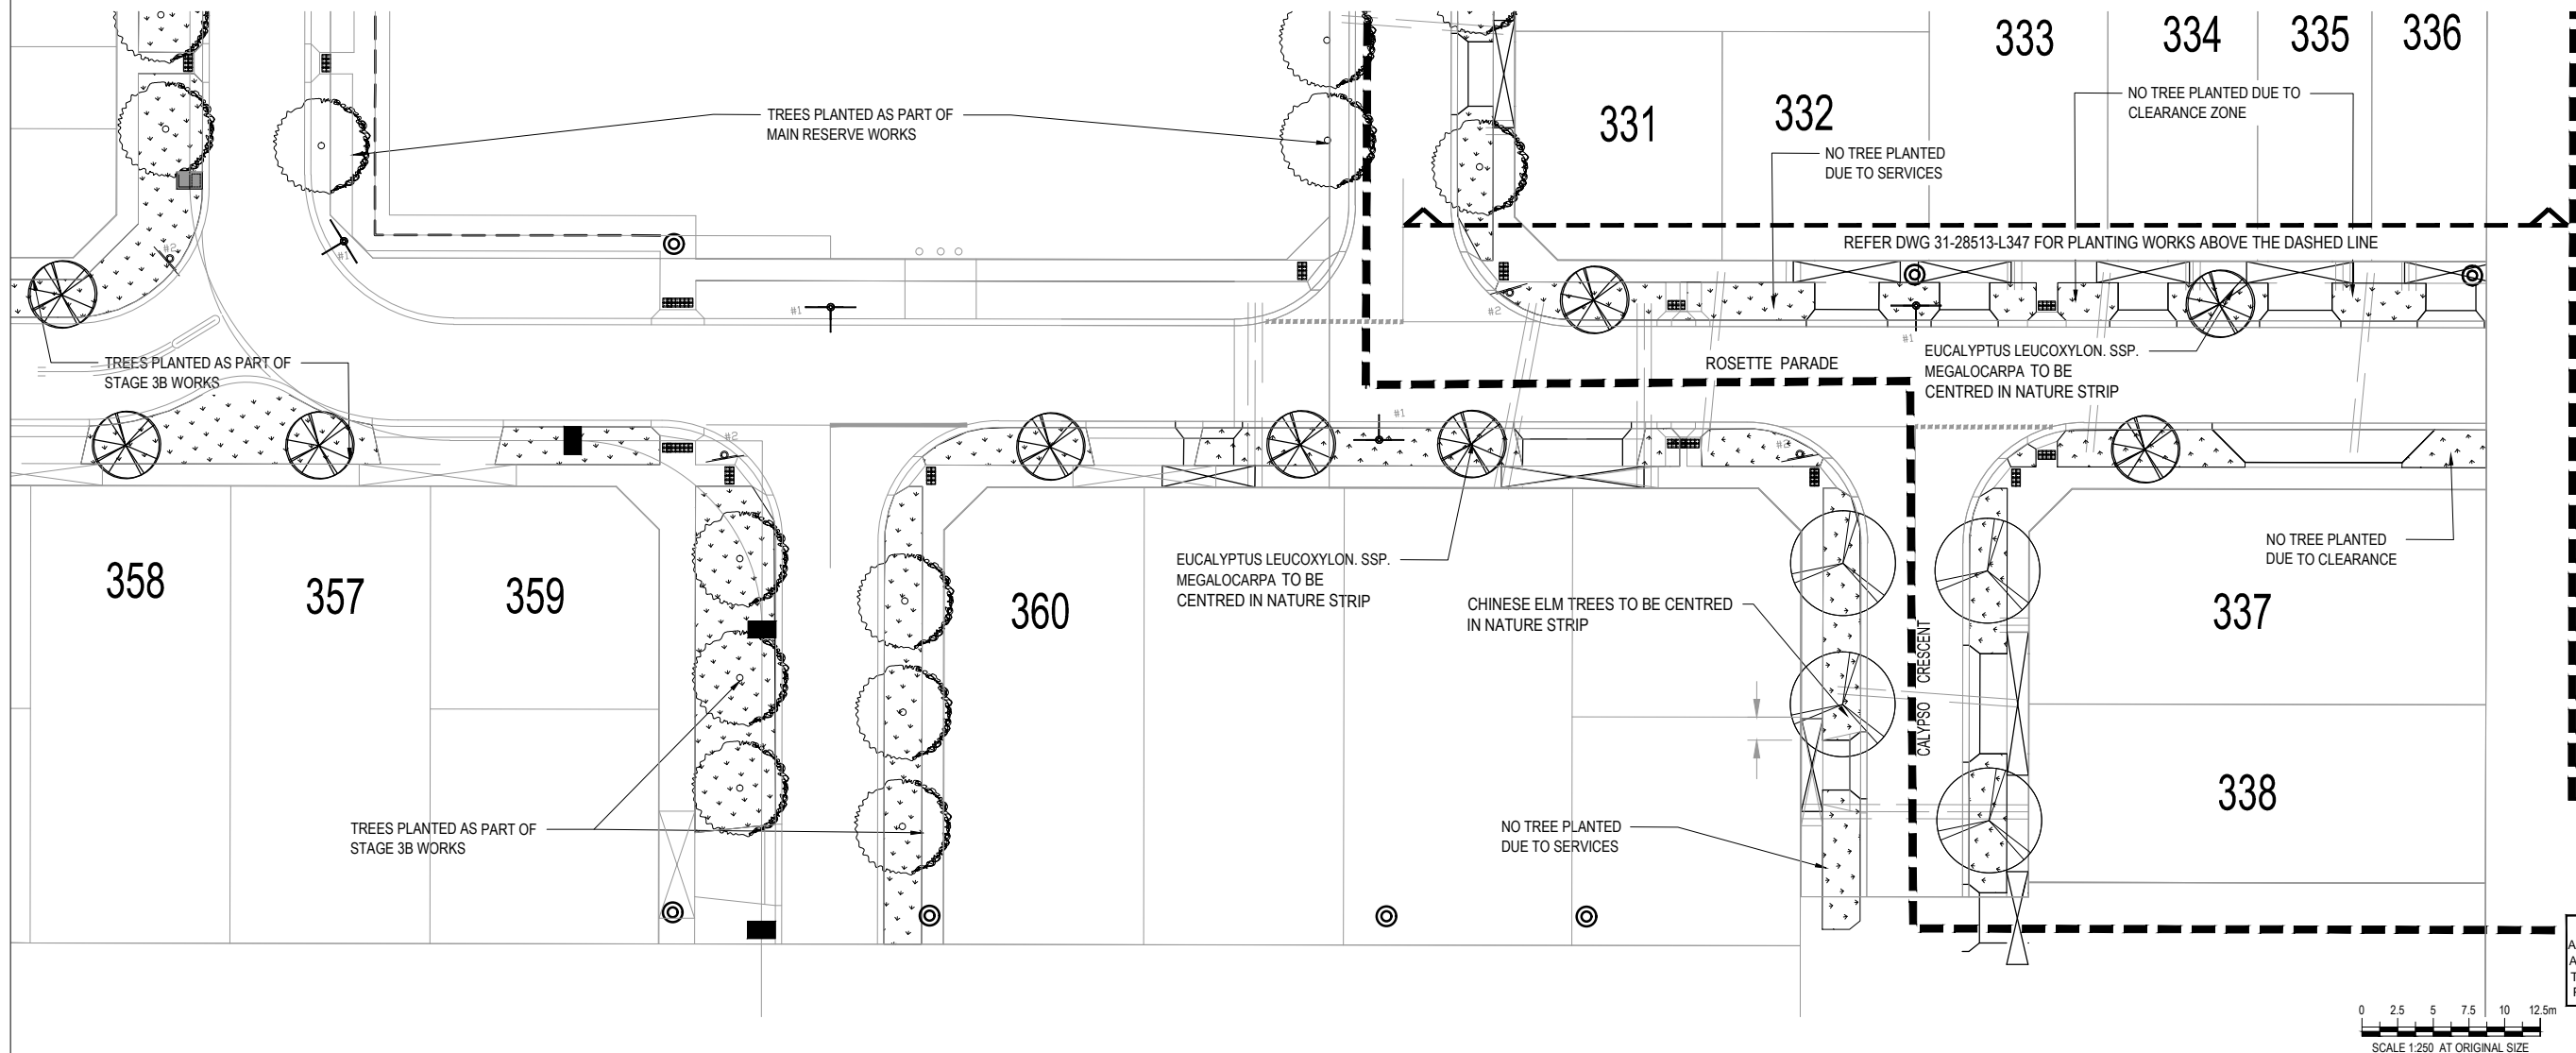

**WARNING**  
ALL SERVICES SHOWN ON THIS DRAWING ARE  
APPROXIMATE ONLY AND EXACT LOCATION IS  
TO BE CONFIRMED ON SITE BY CONTRACTOR  
PRIOR TO COMMENCEMENT OF ANY WORKS.

## AS BUILT

A	FIRST ISSUE	GC	GC	SG 16.03.14
No	Revision    Note: * indicates signatures on original issue of drawing or last revision of drawing	Drawn	Job Manager	Project Director Date



Level 8, 180 Lonsdale Street, Melbourne VIC 3000 Australia  
T 61 3 8687 8000 F 61 3 8687 8111  
E [melmail@ghd.com.au](mailto:melmail@ghd.com.au) W [www.ghd.com](http://www.ghd.com)

**Conditions of Use.** This document may only be used by GHD's client (and any other person who GHD has agreed can use this document) for the purpose for which it was prepared and must not be used by any other person or for any other purpose.

Drawn	Designer
Drafting Check	Design Check
Approved (Project Director) Date	
Scale 1:250	This Drawing must not be used for Construction unless stated as otherwise.

Client	VILLAWOOD PROPERTIES
Project	TRILLIUM DEVELOPMENT
Title	STAGE 3A - STREETSCAPE GENERAL LANDSCAPE WORKS SHEET 4 OF 4

Original Size **A1** Drawing No: **31-28513-L348**

ev: **A**