


NOTE: FINISHED SURFACE LEVELS ARE A COMPARISON BETWEEN THE SURVEYED SURFACE LEVEL DATED 15/12/2017 FOLLOWING SITE CLEARING AND THE SURVEYED FINISHED SURFACE LEVEL DATED 22/01/2018. THE EXISTANCE OF PAST DISTURBED SOIL OR FILL BY OTHERS IS NOT KNOWN OR REFERRED TO IN THIS PLAN AND PURCHASERS ARE REFERRED TO SITE CLASSIFICATION REPORTS FOR EACH LOT BY GTS REFERENCE 17C 0847.

MIN FILL	MAX FILL	HATCHING
0.30	0.60	[Cross-hatch pattern]
0.60	0.90	[Diagonal hatch pattern]
0.90	1.20	[Dotted pattern]
1.20	1.60	[Hexagonal pattern]

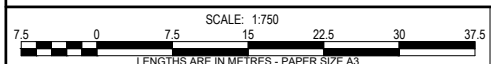

Principal KFLAT PROJECTS PTY LTD

**AS
CONSTRUCTED**

Tomkinson Group
 Project Managers Development Planners
 Licensed Surveyors Civil Engineers
 Tel: (03) 5445 8700 / 1300 350 580 Fax: (03) 5441 3648
 PO Box 421, Bendigo 3552 57 Myers Street, Bendigo 3550
 web: www.tomkinson.com email: bendigo@tomkinson.com

VOGUE			
316-318 HIGH STREET, KANGAROO FLAT			
FILL COMPARISON PLAN			
E	AMEND AS PER CLIENTS COMMENTS	BM	RK 18/04/18
D	AMEND AS PER CLIENTS COMMENTS	BM	RK 18/04/18
C	AMEND AS PER CLIENTS COMMENTS	BM	RK 17/04/18
B	AMEND AS PER CLIENTS COMMENTS	BM	RK 16/04/18
REV		DESIGNED	DRAFTED
		CHECKED	DATE

Municipality & Ref:
 CITY OF
 GREATER BENDIGO
 PP REF DS/100/2016

SHT 1 of 1 REV E

Drawing No.
1110601-FILL PLAN

NOTE: THIS PLAN IS AN UNCONTROLLED DOCUMENT AND WILL NOT BE UPDATED. IT IS THE RESPONSIBILITY OF THE USER TO CONFIRM THAT THIS IS A CURRENT COPY AND SUITABLE FOR THE PROPOSED USE. THIS SHEET MUST BE READ IN CONJUNCTION WITH ALL SHEETS OF THIS SET AND ANY ACCOMPANYING DOCUMENTS. PLOT DATE: 18/04/2018 FILE: F:\JOB DATA\1100-1199\1106-F-PROJECTS-KANGAROO FLAT\ENGINEERING\CIVIL\3D SURFACE COMPARISONS\1110601 - EARTHWORKS FILL PLAN REV.DWG