

GENERAL NOTES

This fill plan shows details of works affecting the natural surface of the land, being fill placed on the land to the extent and depth shown on this plan.


The depth of fill is based on the design finished surface as well as information provided by Landform Surveys

This plan does not show any other fill which may have been placed on the land.

Any grading or spreading to correct minor surface irregularities less than 300mm in depth is not shown.

Depths shown are not recommended foundation depths.

FILL DEPTHS

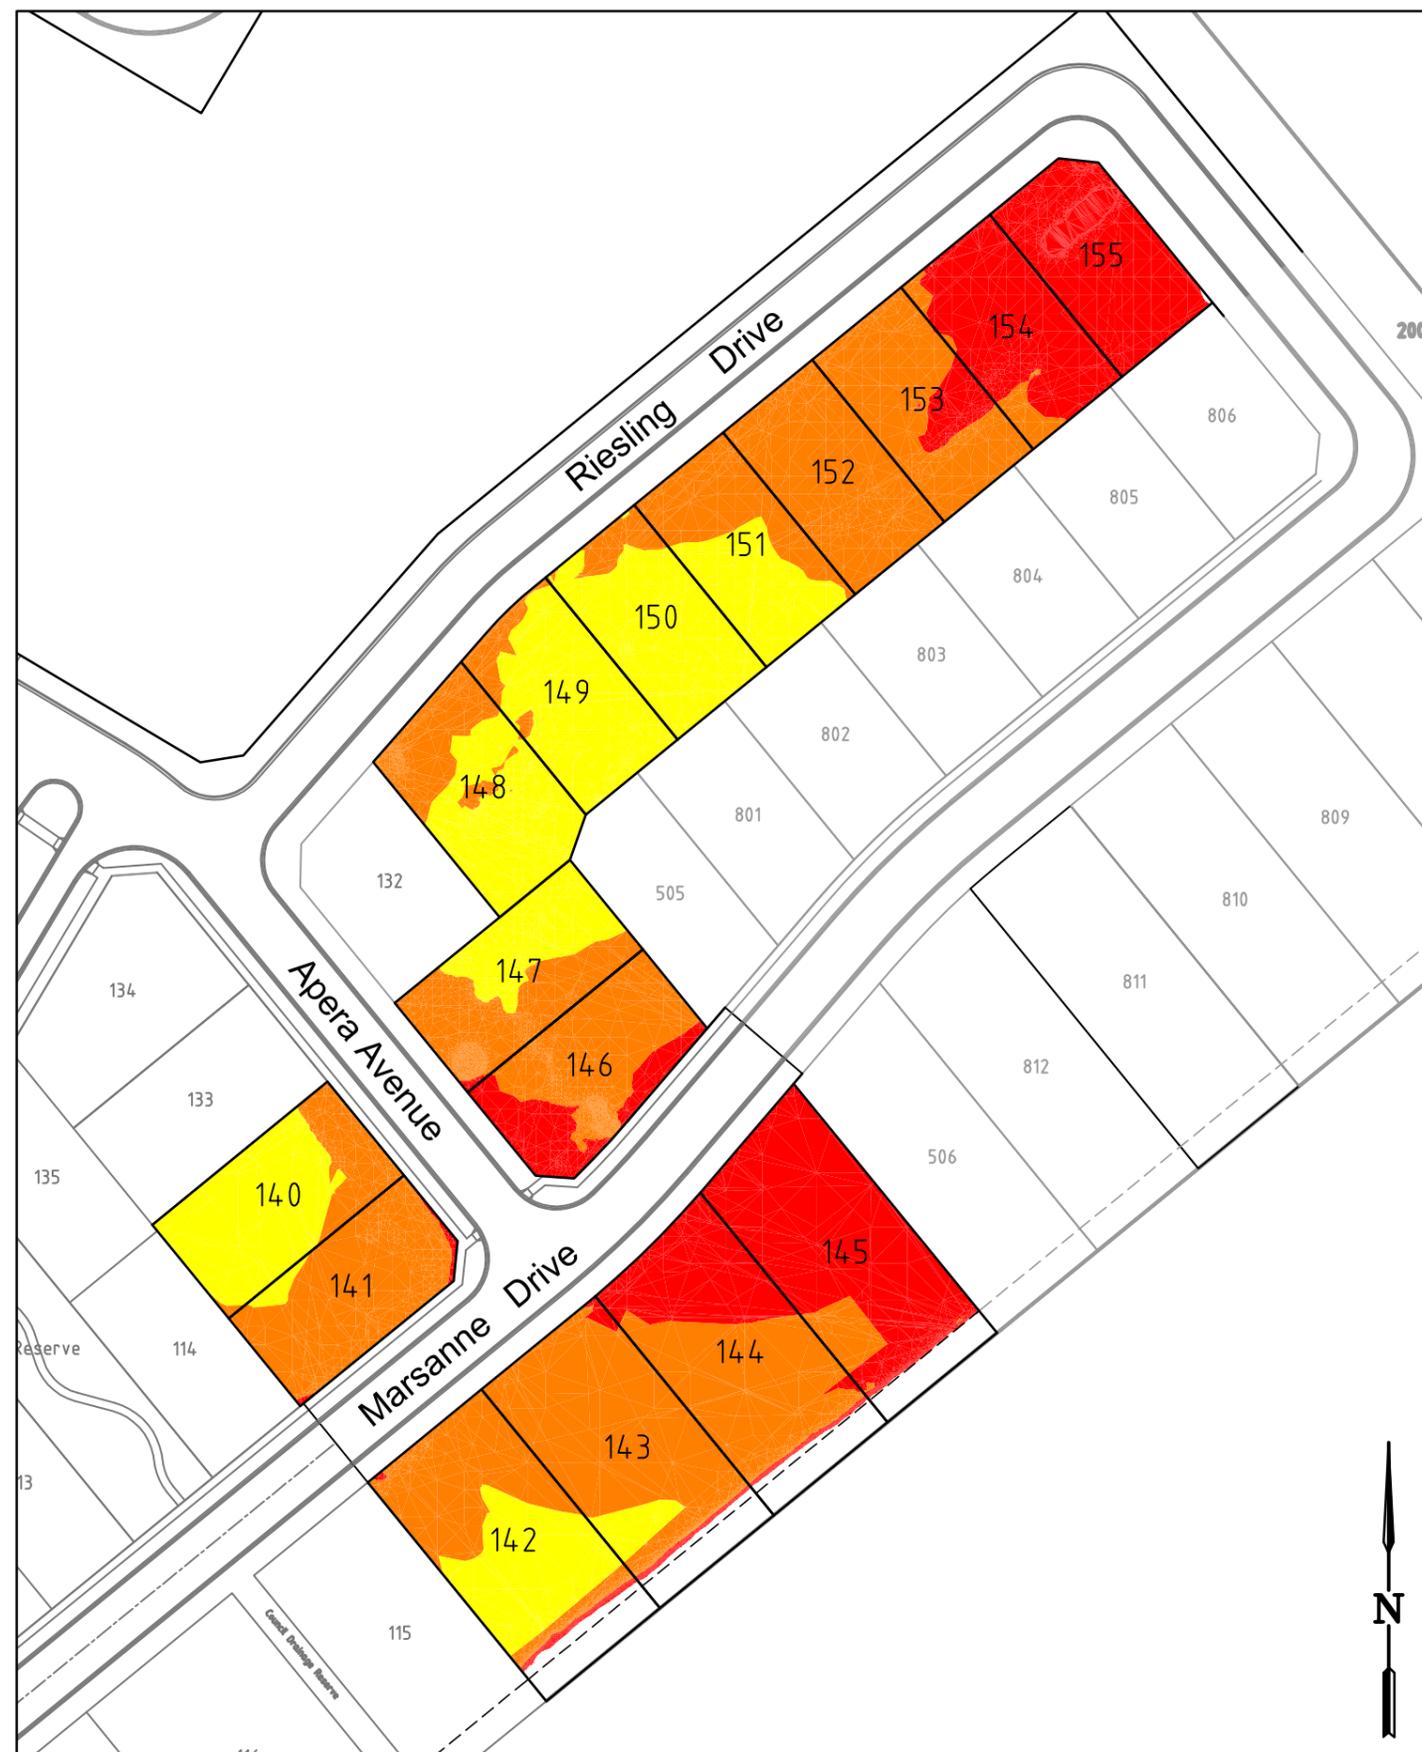

6		
5		
4		
3		
2		
1	Original Issue	6/4/2018
0	Draft	-
Ver	Revision Description	Date

Designed	Checked
R. Dawborn	N. Bowe
Apr 2018	Apr 2018
Approved	

Notes/Legend

TERRACO
Civil Engineers
Project Managers
Development Consultants

Terraco P/L
ABN 12 681 695 776
Corner Jewell Court
& Rowena Street
Bendigo Vic 3550
Ph: 03 5442 5799
Fax: 03 5441 5506
E: info@terraco.com.au

Scale (m)	H 1:1250 0 12.5 25
All lengths are in metres and all levels are to Australian Height Datum (Original Sheet Size is A3)	
Drawing file:	LTO Ref:
17127 Fill.dwg	-

Murray River Council - Moama				
Villawood Properties Pty Ltd				
Lakeview Estate - Stage 7				
Preliminary Lot Fill Plan				
Council Ref:	Our Ref:	Version	Sheet	
DA 173/11	17127	1	1 of 1	