

- LEGEND - LAYOUT PLAN**
- STORMWATER DRAIN, PIT & PROPERTY INLET PIT
 - EXISTING STORMWATER DRAIN
 - EXISTING HOUSE DRAIN
 - SWALE DRAIN
 - SEWER & MAINTENANCE STRUCTURES
 - EXISTING SEWER
 - HOUSE DRAIN
 - SERVICE CONDUITS
 - PROPOSED ELECTRICITY (UNDERGROUND)
 - PROPOSED GAS
 - PROPOSED OPTIC FIBRE
 - PROPOSED TELSTRA
 - PROPOSED WATER
 - PROPOSED RECYCLED WATER
 - EXISTING ELECTRICITY (UNDERGROUND)
 - EXISTING ELECTRICITY (OVERHEAD)
 - EXISTING GAS
 - EXISTING OPTIC FIBRE
 - EXISTING TELSTRA
 - EXISTING WATER
 - EXISTING RECYCLED WATER
 - EXISTING SURFACE LEVEL
 - FS140.35 FINISHED BUILDING LEVEL
 - FR157.40 FINISHED RIDGE LINE LEVEL
 - DIRECTION OF FALL
 - OVERLAND FLOW
 - ALLOTMENT TO BE GRADED EVENLY IN DIRECTION OF FALL TO LEVELS INDICATED
 - CONCRETE EDGE STRIP WITH SUBSOIL DRAIN, "NO ROAD" SIGN & BARRIER
 - LIMIT OF WORKS
 - EXISTING TREE TO BE REMOVED
 - EXISTING TREE TO REMAIN
 - PROPOSED PAVEMENT, KERB & CHANNEL, FOOTPATH & CROSS OVER
 - PROPOSED PAVEMENT, KERB & CHANNEL, FOOTPATH & HEAVY DUTY CROSS OVER
 - RIDGE LINE
 - EXISTING CONTOURS (200mm INCREMENT)
 - TACTILE PAVERS

NOTE:
CONTRACTOR IS TO VERIFY ALL CONNECTION LEVELS PRIOR TO COMMENCEMENT OF WORKS AND NOTIFY CREO CIVIL IF THERE ARE DIFFERENCES

NOTE: STREET TREE LOCATIONS SHOWN ARE INDICATIVE ONLY. ULTIMATE LOCATION IS TO BE PROVIDED/CONFIRMED BY LANDSCAPE ARCHITECTS

WARNING
BEWARE OF UNDERGROUND & OVERHEAD SERVICES
The locations of underground & overhead services are approximate only & their exact position should be proven on site. No guarantee is given that all existing services are shown. Locate all underground services before commencement of works
BEFORE YOU DIG
www.byda.com.au

REVISION	DATE	ISSUE DESCRIPTION	DRAWN	CHECKED	APPROVED
1	11/02/26	UPDATED LAYOUT - SONE LANE SHIFTED	M.P.	A.W.	E.S.
0	27/11/25	ISSUED FOR CONSTRUCTION	M.P.	A.W.	E.S.
D	30/09/25	UPDATED TENDER INFORMATION	M.P.	A.W.	E.S.
C	12/09/25	ISSUED FOR TENDER	A.W.	A.W.	M.T.
B	14/08/25	TGSI ADDED ON ISHTAR STREET - COUNCIL COMMENTS	M.P.	A.W.	M.T.
A	23/07/25	ISSUED FOR APPROVAL	M.P.	A.W.	M.T.

villawood
properties
Communities Designed for Living


creo
CIVIL
Suite 1, 2 Bloomsbury Street
Newtown, VIC, Australia 3220

ALAMORA
parnet

ALAMORA - STAGE 32
LAYOUT PLAN

ISSUED FOR CONSTRUCTION
SCALE @ A1 : 1:500
0 5 10 20 30

DESIGNED	PROJECT ENGINEER	
M.PLANT	A.WALE	
DRAWN	PROJECT MANAGER	
M.PLANT	M.TROUNCE	
PROJECT No.	DRAWING No.	REVISION
200282.32	R201	1

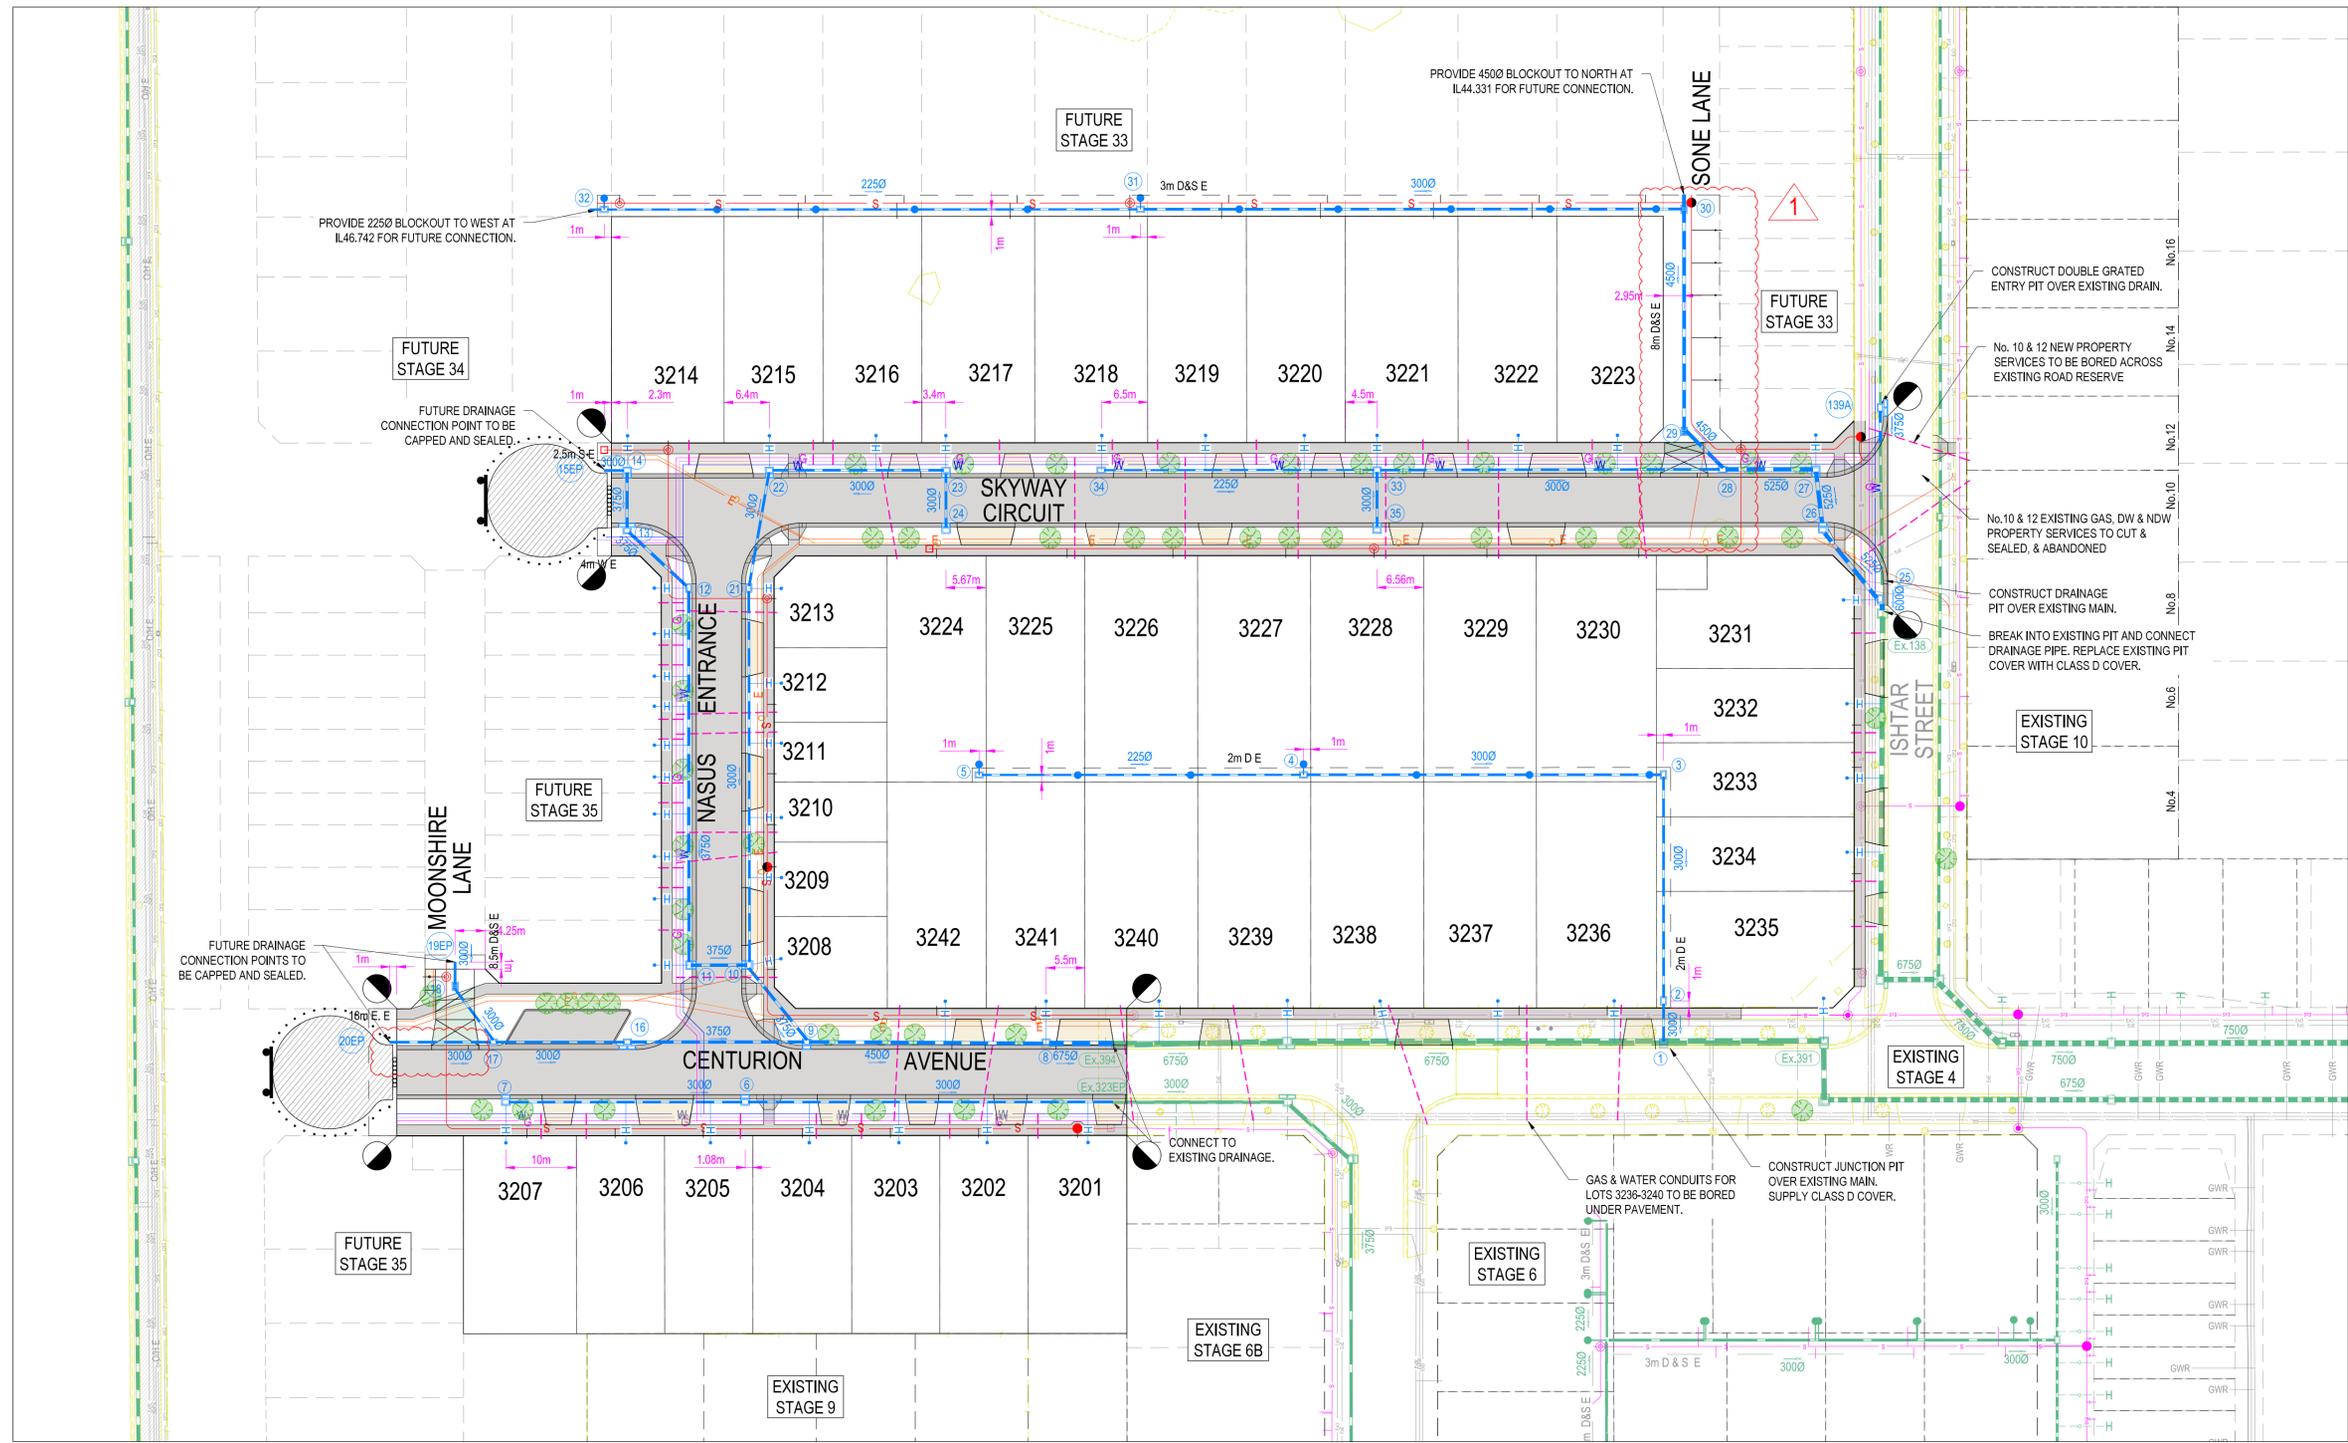

LEGEND - SERVICES PLAN

- STORMWATER DRAIN, PIT & PROPERTY INLET
- EXISTING STORMWATER DRAIN
- SEWER & MAINTENANCE STRUCTURES
- EXISTING SEWER
- HOUSE DRAIN
- SERVICE CONDUITS
- PROPOSED ELECTRICITY (UNDERGROUND)
- PROPOSED GAS
- PROPOSED OPTIC FIBRE
- PROPOSED TELSTRA
- PROPOSED WATER
- PROPOSED RECYCLED WATER
- EXISTING ELECTRICITY (UNDERGROUND)
- EXISTING ELECTRICITY (OVERHEAD)
- EXISTING GAS
- EXISTING OPTIC FIBRE
- EXISTING TELSTRA
- EXISTING WATER
- EXISTING RECYCLED WATER
- PROPOSED PAVEMENT, KERB & CHANNEL, FOOTPATH & DRIVEWAY
- STORMWATER PIT SETOUT POINT

- SUPPLEMENTARY NOTES:**
- ENSURE PROPERTY CONNECTIONS HAVE MINIMUM 1m OFFSET FROM VEHICLE CROSSINGS.
 - LOTS 3231-3240 TO BE SUPPLIED FROM CONNECTIONS TO EXISTING SERVICES.
 - LOT 3235 PROPERTY CONNECTION TO BE CONSTRUCTED TO EX. PIT 391 IN ACCORDANCE WITH EDM703.
 - WHERE DRAINAGE & SEWER PIPE ARE IN CLOSE PROXIMITY, COMPACTION TO BE IN ACCORDANCE WITH SD6-10. DRAIN LINE 30-31-32.

SERVICES OFFSET SCHEDULE

ROAD NAME	GAS		RECYCLED WATER		POTABLE WATER		OPTIC FIBRE		ELECTRICITY		PUBLIC LIGHTING	
	SIDE	OFFSET	SIDE	OFFSET	SIDE	OFFSET	SIDE	OFFSET	SIDE	OFFSET	SIDE	OFFSET
CENTURION AVENUE	S	2.10	S	2.60	S	3.10	N	1.80	N	2.50	N	1.00*
NASUS ENTRANCE	W	2.10	W	2.60	W	3.10	E	1.80	E	2.40	E	1.00*
SKYWAY CIRCUIT (LOT 3215-3223)	N	2.10	N	2.60	N	3.10	S	1.80	S	2.40	S	1.00*
SKYWAY CIRCUIT (LOT 3214)	S	1.85	S	2.25	S	2.70	N	1.80	N	2.40	N	1.00*
MOONSHIRE LANE	-	-	-	-	-	-	-	-	W	1.20	-	-
SONE LANE	-	-	-	-	-	-	-	-	E	2.00	-	-

1. * DENOTES OFFSET FROM BACK OF KERB.

NOTE:
STREET TREE LOCATIONS SHOWN ARE INDICATIVE ONLY. ULTIMATE LOCATION IS TO BE PROVIDED & CONFIRMED BY LANDSCAPE ARCHITECTS

WARNING
BEWARE OF UNDERGROUND & OVERHEAD SERVICES

THE LOCATIONS OF UNDERGROUND & OVERHEAD SERVICES ARE APPROXIMATE ONLY & THEIR EXACT POSITION SHOULD BE PROVEN ON SITE. NO GUARANTEE IS GIVEN THAT ALL EXISTING SERVICES ARE SHOWN. LOCATE ALL UNDERGROUND SERVICES BEFORE COMMENCEMENT OF WORKS

BEFORE YOU DIG

www.byda.com.au

REVISION	DATE	ISSUE DESCRIPTION	DRAWN	CHECKED	APPROVED
1	11/02/26	UPDATED LAYOUT - SONE LANE SHIFTED	M.P.	A.W.	E.S.
0	27/11/25	ISSUED FOR CONSTRUCTION	M.P.	A.W.	E.S.
E	30/09/25	UPDATED TENDER INFORMATION	M.P.	A.W.	E.S.
D	12/09/25	ISSUED FOR TENDER	A.W.	A.W.	M.T.
C	27/08/25	SD6-10 NOTE ADDED - COUNCIL COMMENTS	A.W.	A.W.	M.T.
B	14/08/25	WATER & GAS MOVED CLEAR OF VEHICLE CROSSOVER - COUNCIL COMMENTS	M.P.	A.W.	M.T.
A	23/07/25	ISSUED FOR APPROVAL	M.P.	A.W.	M.T.

CLIENT

villawood properties
Communities Designed for Living

creo CIVIL

Suite 1, 2 Bloomsbury Street
Newtown, VIC, Australia 3220

ALAMORA
Tarnait


DRAWING TITLE
ALAMORA - STAGE 32
SERVICES PLAN

STATUS
ISSUED FOR CONSTRUCTION

SCALE @ A1 : 1:500



0 5 10 20 30

DESIGNED	PROJECT ENGINEER	
M.PLANT	A.WALE	
DRAWN	PROJECT MANAGER	
M.PLANT	M.TROUNCE	
PROJECT No.	DRAWING No.	REVISION
200282.32	R202	1

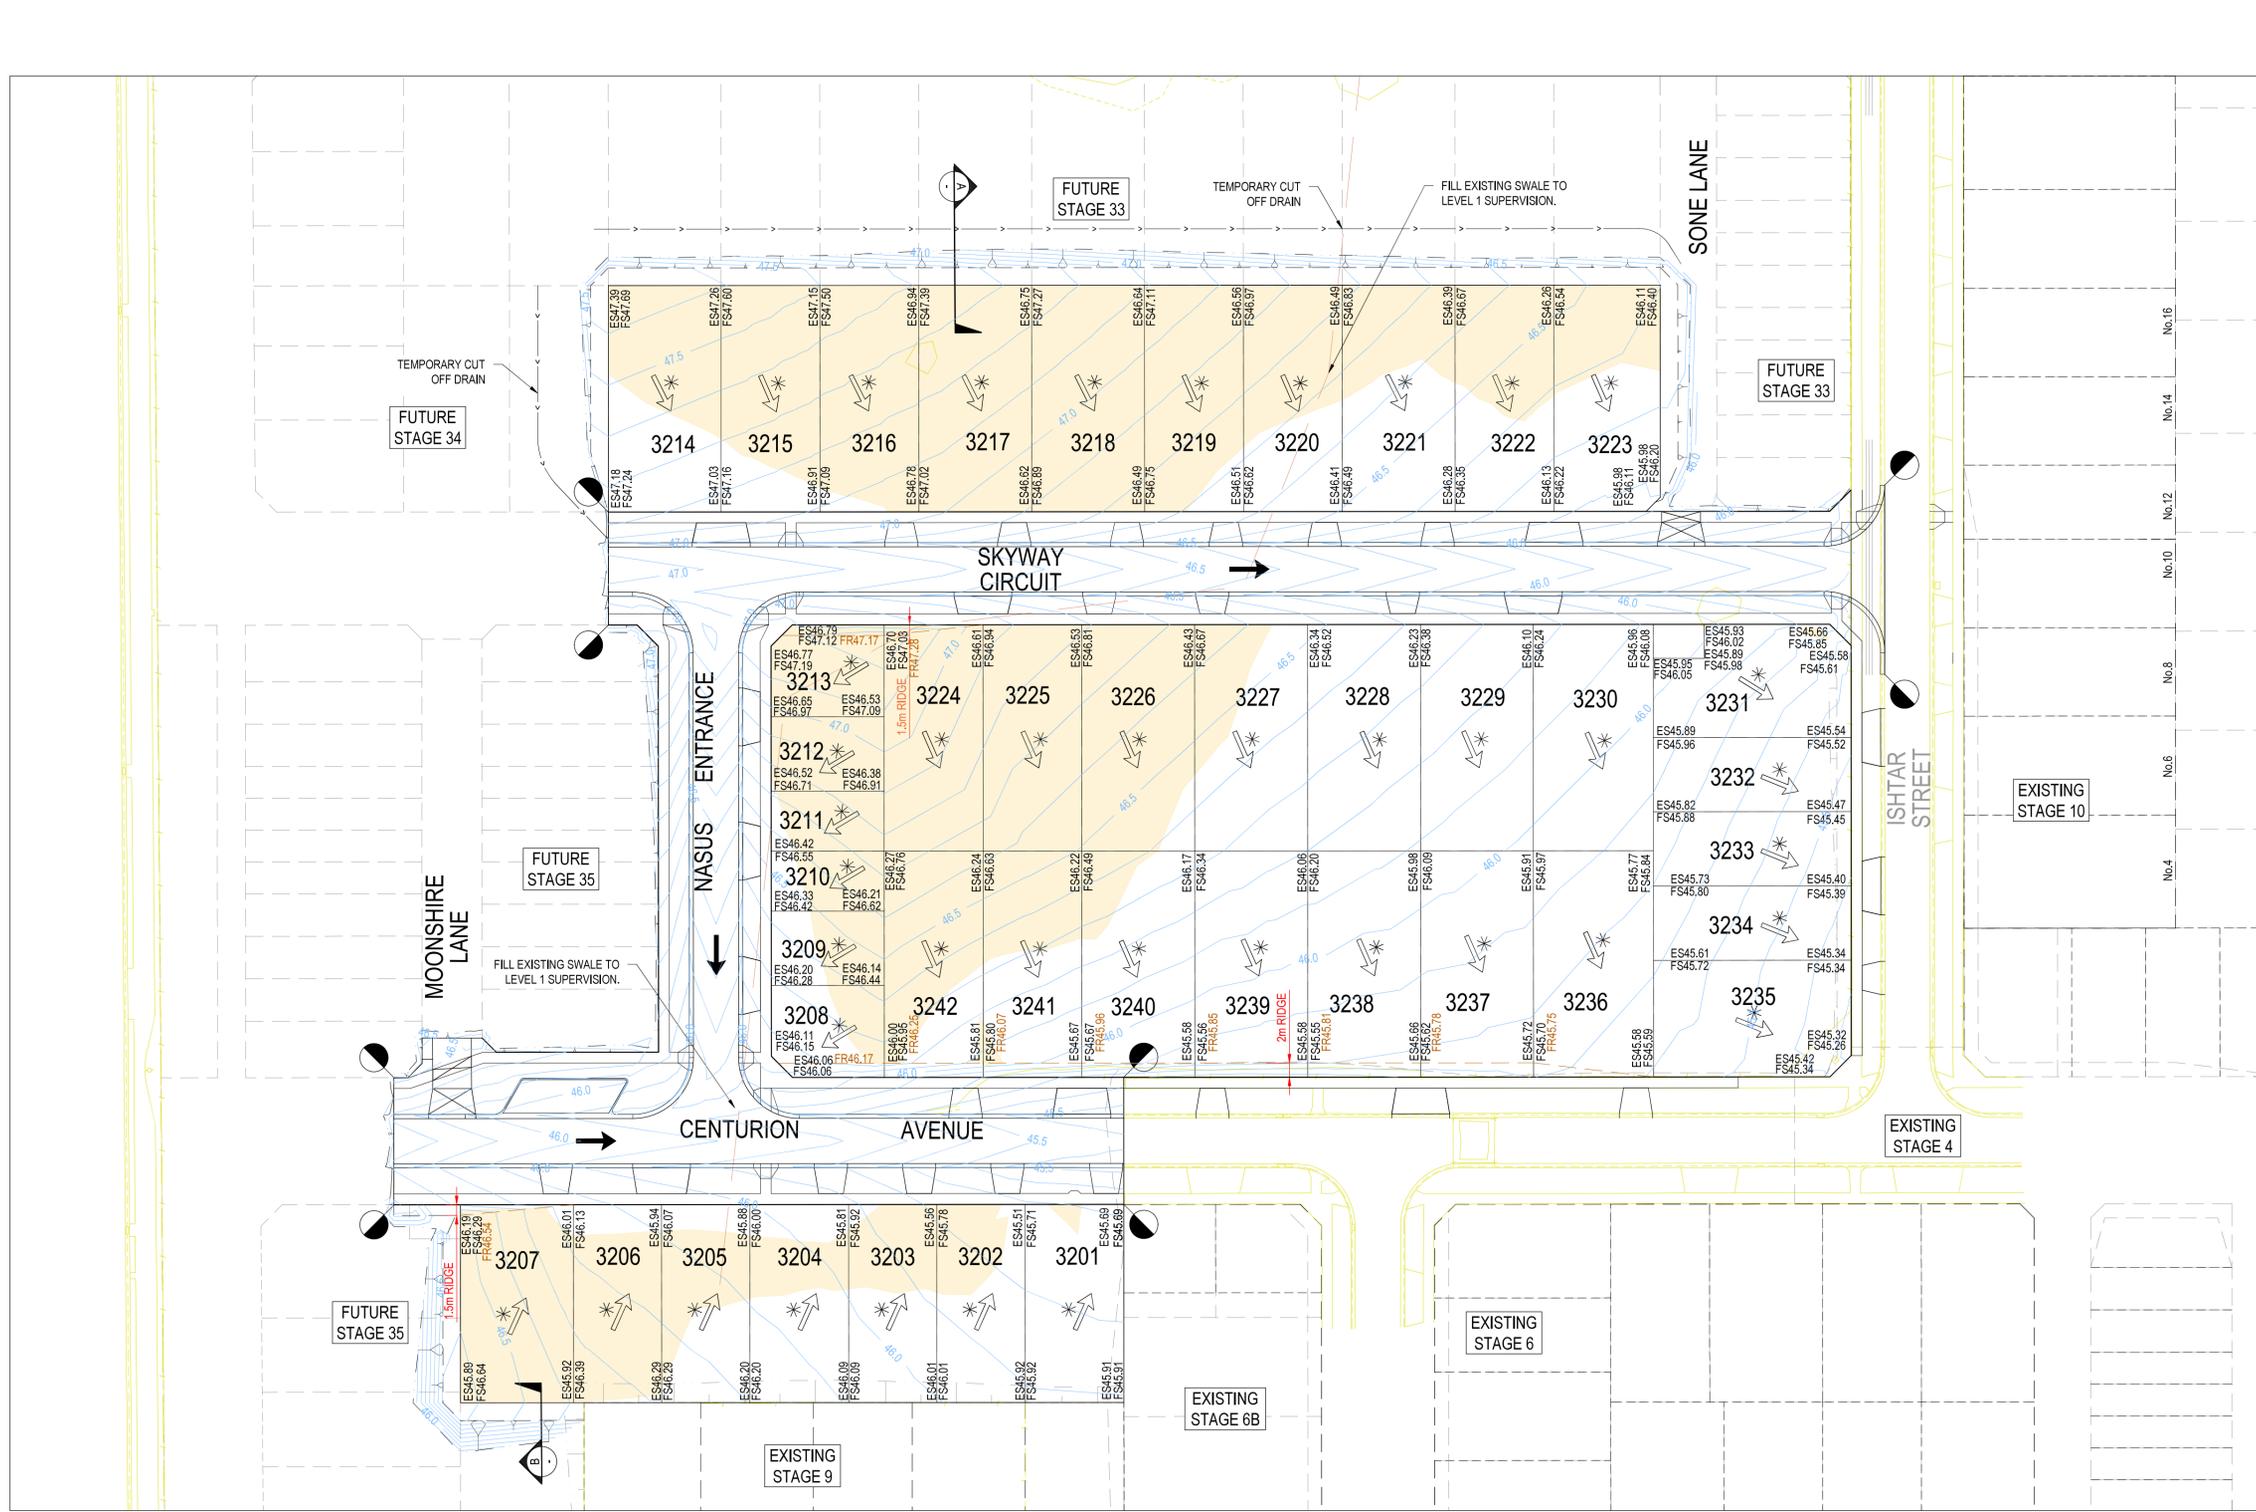

LEGEND - EARTHWORKS PLAN

- RIDGE LINE
- TOE OF BATTER
- SWALE DRAIN
- ES141.34 EXISTING SURFACE LEVEL
- FS140.35 FINISHED BUILDING LINE LEVEL
- FR157.40 FINISHED RIDGE LINE LEVEL
- TW159.30 TOP OF RETAINING WALL
- BW159.30 BOTTOM OF RETAINING WALL
- RETAINING WALL
- STRUCTURAL FILL > 200mm DEEP
- EX. STRUCTURAL FILL > 200mm DEEP
- DIRECTION OF FALL
- OVERLAND FLOW
- ALLOTMENT TO BE GRADED EVENLY IN DIRECTION OF FALL TO LEVELS INDICATED
- 0.10m CONTOUR

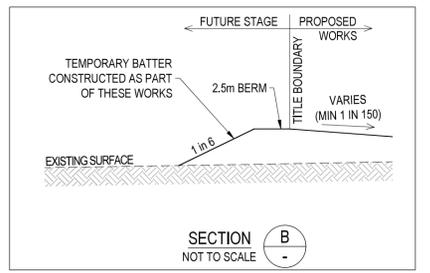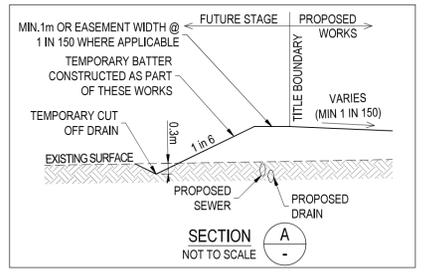

WARNING
BWARE OF UNDERGROUND & OVERHEAD SERVICES
The locations of underground & overhead services are approximate only & their exact position should be proven on site. No guarantee is given that all existing services are shown. Locate all underground services before commencement of works
BEFORE YOU DIG
www.byda.com.au

REVISION	DATE	ISSUE DESCRIPTION	DRAWN	CHECKED	APPROVED
0	27/11/25	ISSUED FOR CONSTRUCTION	MP	AW	ES
B	12/09/25	ISSUED FOR TENDER	AW	AW	MT
A	23/07/25	ISSUED FOR APPROVAL	MP	AW	MT

villawood properties
Communities Designed for Living

creo CIVIL
Suite 1, 2 Bloomsbury Street
Newtown, VIC, Australia 3220

ALAMORA
Tarnait

ALAMORA - STAGE 32
EARTHWORKS PLAN

ISSUED FOR CONSTRUCTION
SCALE @ A1 : 1:500
0 5 10 20 30

DESIGNED	M.PLANT	PROJECT ENGINEER	A.WALE
DRAWN	M.PLANT	PROJECT MANAGER	M.TROUNCE
PROJECT No.	200282.32	DRAWING No.	R203
REVISION			0