



CIVIL GEOTECHNICAL SERVICES
ABN 26 474 013 724
PO Box 678 Croydon Vic 3136
Telephone: 9723 0744 Facsimile: 9723 0799

22nd March 2022

Our Reference: 21516:NB1174

Winslow Constructors Pty Ltd
50 Barry Road
CAMPBELLFIELD VIC 3061

Dear Sirs/Madams,

**RE: LEVEL 1 EARTHWORKS INSPECTION AND TESTING
RATHDOWNE – STAGE 9 (WOLLERT)**

Please find attached our Report No's 21516/R001 and 21516/R002 which relate to the field density testing that was conducted within the filled allotments at the above subdivision. The level 1 inspections and associated field density testing was performed in March 2022.

The inspections and testing of the earthworks was undertaken in general accordance with the Level 1 requirements of AS 3798 - Guidelines on Earthworks for Commercial and Residential Developments.

The site inspection and testing was performed by experienced geotechnicians from this office. Any areas that were deemed unsatisfactory were reworked and retested under their supervision. The testing was performed to the relevant Australian Standards and the accompanying test reports carry NATA endorsement. The attached compaction results, which were located randomly throughout the fill profile, are considered to be representative of the bulk fill materials that were placed across the reported allotments by Winslow Constructors during the aforementioned period. The approximate locations of the field density tests can be seen on the attached plan (Figure 1).

We are of the view that the bulk fill materials that have been placed across the reported allotments by Winslow Constructors during the aforementioned period can be considered as having been placed in a controlled manner to a minimum density ratio of 95% (standard compactive effort).


Please contact the undersigned if you require any additional information.

Civil Geotechnical Services





A handwritten signature in blue ink, appearing to be 'Nick Brock', written over a light blue circular stamp.

Nick Brock

FIGURE 1

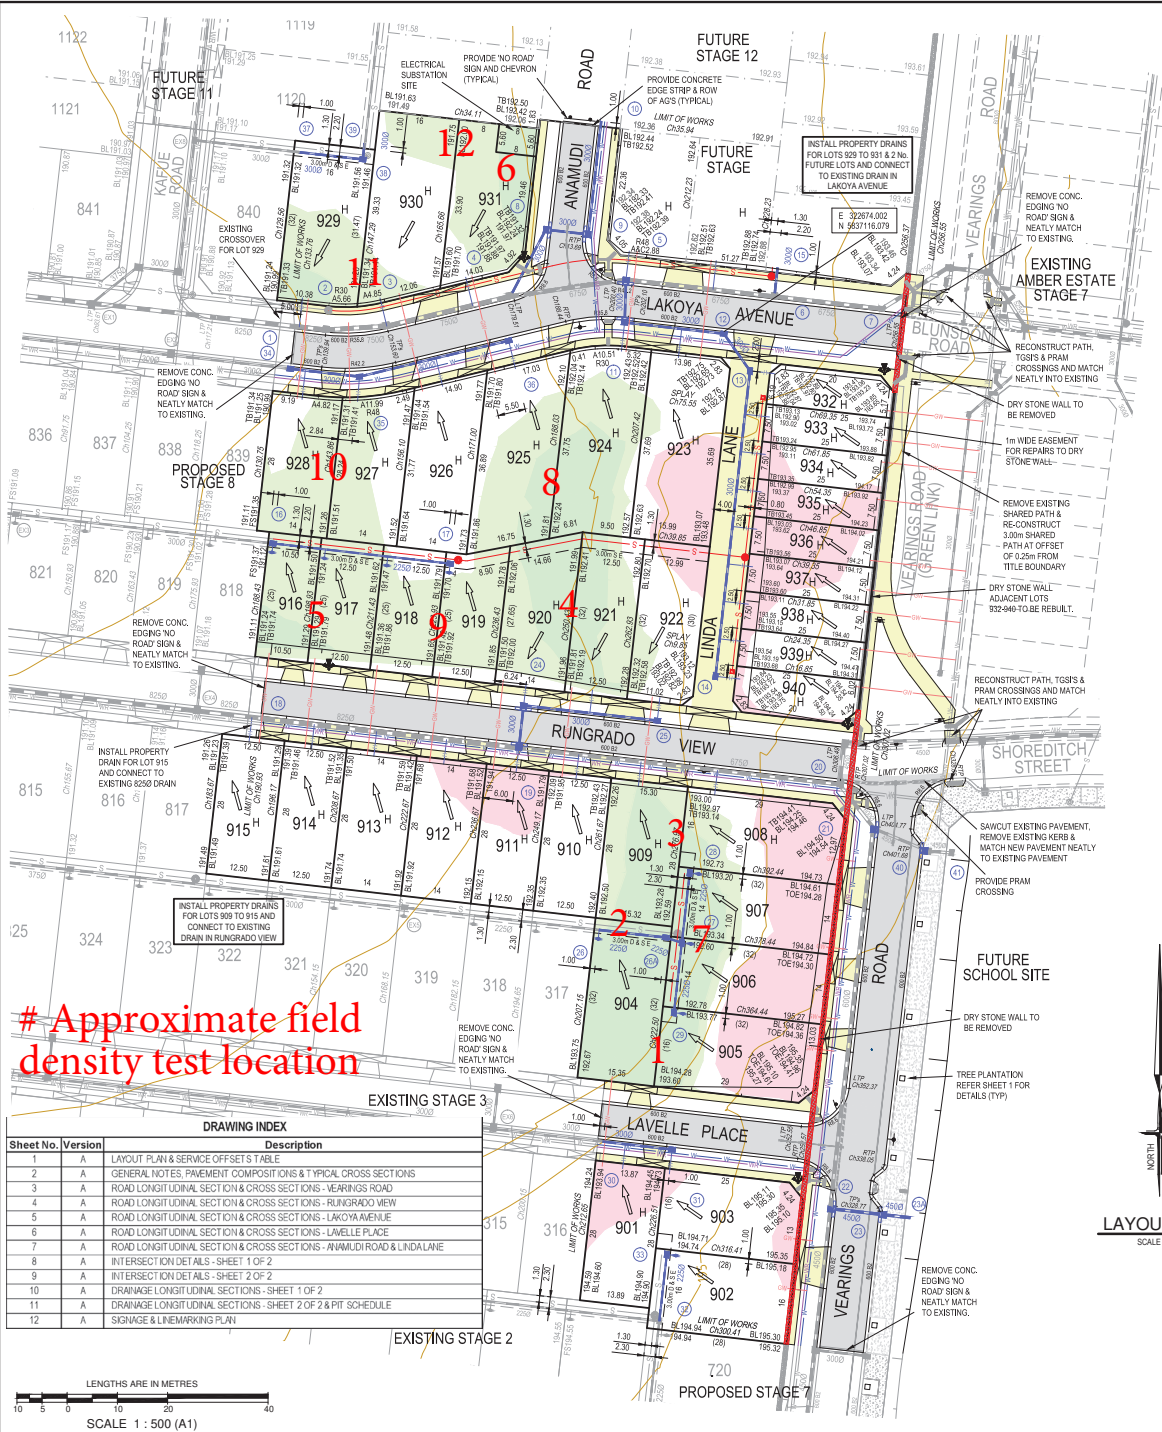

Approximate field density test location

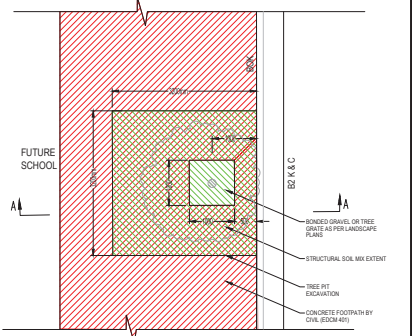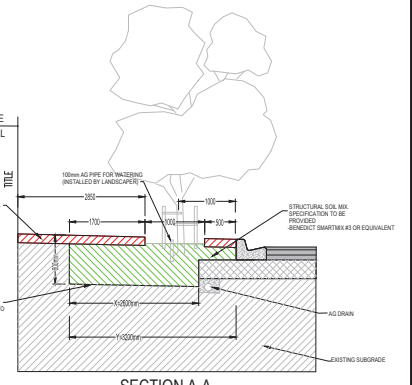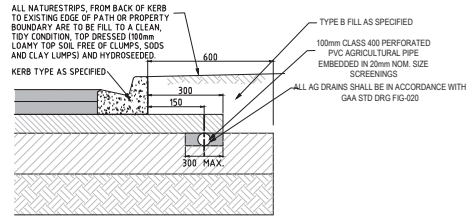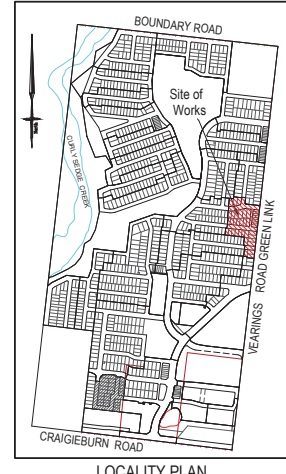

SERVICE OFFSETS AND LOCATION TABLE

ROAD NAME	ROAD RESERVE	POTABLE WATER		NON-POTABLE WATER		GAS		ELECTRICITY		TELECOMMUNICATIONS		BOK		
		SIDE	OFFSET	SIDE	OFFSET	SIDE	OFFSET	POLE SIDE	UG CABLE SIDE	POLE SIDE	OFFSET	SIDE	OFFSET	
VEERINGS ROAD	20.6m	W	2.80	W	2.30	W	1.80	0.90°	W	4.00	W	3.50	4.65 E	6.05 W
LAKOYA AVENUE	18m	S	3.20	S	2.70	S	2.20	0.90°	N	2.60	N	1.80	5.20 N	5.20 S
RUNGRADO VIEW	16m	S	3.10	S	2.60	S	2.10	0.90°	N	2.60	N	1.80	4.05 N	4.35 S
ANAMUDI ROAD	16m	E	3.20	E	2.70	E	2.20	0.90°	W	2.60	W	1.80	4.35 E	4.05 W
LAVELLE PLACE	16m	S	3.20	S	2.70	S	2.20	0.90°	N	2.60	N	1.85	4.05 N	4.35 S
LOTS 932 TO 940	-	E	Ex 2.55	E	Ex 2.10	E	Ex 1.70	-	E	Ex 3.55	E	Ex 3.10	-	-

1. TELETRA AND ELECTRICITY CABLES ARE TO BE CONSTRUCTED IN A COMMON TRENCH IN ACCORDANCE WITH ELECTRICITY AUTHORITY STANDARD DRAWINGS.
2. GAS AND WATER MAINS ARE TO BE CONSTRUCTED IN A COMMON TRENCH.
3. *DISTRICTS OFFSET FROM BACK OF KERB

WARNING
BEWARE OF UNDERGROUND SERVICES
THE LOCATIONS OF UNDERGROUND SERVICES ARE APPROXIMATE ONLY AND THEIR EXACT POSITION SHOULD BE PROVEN ON SITE. NO GUARANTEE IS GIVEN THAT ALL EXISTING SERVICES ARE SHOWN.

- ATTENTION TO CONTRACTOR**
- IT IS THE CONTRACTORS RESPONSIBILITY TO ENSURE THAT THE DIGITAL PLAN, PROVIDED FOR SETOUT PURPOSES, MATCHES THE TBM COORDINATES SHOWN.
 - Contractor to ensure that the site is pegged by a licensed surveyor and/or set out checked by a licensed surveyor prior to underground infrastructure being installed.
 - Where concrete works abut a sewer access chamber or similar structure, an expansion joint of approved material shall be provided between the two faces.

SYMBOL LEGEND

Drains	Pre-Trip	Ex/Natural/FS Level	+3.50
Sewer < 3000		FS @ Building Level	+3.50
Sewer > 3000		Top/Toe of Batter	+3.50
Water (DW)		Top Ret. Wall Level	+1.05
Water (NDW)		100yr Flood Level	+1.05
House Drain		Fill Proposed (>0.3m/20.3m)	
Property Inlet		Cut Proposed	
Street Sign		Asphalt Surface Prop	
PSM		Concrete Surface Prop (Paths/Driveways/Sidings)	
Rock Ret Wall		Tree To Be Removed	
Sewer Ret Wall		Tree To Be Retained with Tree Protection Zone (TPZ)	
Conduits 50mm			
Conduits 100mm			
Street Tree without/with Passive Irrigation (Refer Detail)			
Ex Drain			
Ex Water D/W/NDW			
Ex Sewer/Gas			
Ex Elec/Comm			

LAYOUT PLAN
SCALE 1:500

breese pitt dixon pty. ltd. land surveyors civil engineers		1/19 cato street hawthorn east, 3123 telephone 8823 2300 fax no. 8823 2310
MELWAY REF. 388 C-10 SURVEY BPD DESIGN M.A. DRAWN M.A.		MUNICIPALITY WHITTLESEA REFERENCE 9365 / 9
RATHDOWNE ESTATE STAGE 9 LAYOUT PLAN & SERVICE OFFSET TABLE		SHEET 1 OF 12
A 07-07-21 ISSUED FOR CONSTRUCTION	VER DATE REMARKS	SCALE AS SHOWN DATUM AHD DATE NOV '20



COMPACTION ASSESSMENT

Job No 21516
 Report No 21516/R001
 Date Issued 22/03/2022

CIVIL GEOTECHNICAL SERVICES

6 - 8 Rose Avenue, Croydon 3136

Client	WINSLOW CONSTRUCTORS PTY LTD (CAMPBELLFIELD)	Tested by	AC
Project	RATHDOWNE - STAGE 9	Date tested	11/03/22
Location	WOLLERT	Checked by	JHF

Feature	EARTHWORKS	Layer thickness	200 mm	Time:	08:01
---------	------------	-----------------	--------	-------	-------

Test procedure AS 1289.2.1.1 & 5.8.1

Test No		1	2	3	4	5	6
Location		REFER TO FIGURE 1	REFER TO FIGURE 1	REFER TO FIGURE 1	REFER TO FIGURE 1	REFER TO FIGURE 1	REFER TO FIGURE 1
Approximate depth below FSL							
Measurement depth	mm	175	175	175	175	175	175
Field wet density	t/m ³	1.87	1.85	1.87	1.87	1.87	1.91
Field moisture content	%	18.0	20.5	18.1	17.2	17.8	18.0

Test procedure AS 1289.5.7.1

Test No		1	2	3	4	5	6
Compactive effort		Standard					
Oversize rock retained on sieve	mm	19.0	19.0	19.0	19.0	19.0	19.0
Percent of oversize material	wet	0	0	0	0	0	0
Peak Converted Wet Density	t/m ³	1.96	1.95	1.90	1.95	1.96	2.00
Adjusted Peak Converted Wet Density	t/m ³	-	-	-	-	-	-
Optimum Moisture Content	%	20.0	22.5	20.5	16.5	19.5	17.5

Moisture Variation From Optimum Moisture Content	2.0% dry	2.0% dry	2.0% dry	0.5% wet	2.0% dry	0.5% wet
--------------------------------------------------	----------	----------	----------	----------	----------	----------

density and moisture ratio results relate only to the soil to the depth of test and not to the full depth of the layer

Density Ratio (R _{HD})	%	95.5	95.0	98.5	96.0	95.5	95.5
-----------------------------------	---	------	------	------	------	------	------

Material description

No 1 - 6 Clay Fill

AVRLOT HILF V1.10 MAR 13



NATA Accredited Laboratory No 9909
 Accredited for compliance with
 ISO/IEC 17025 - Testing

Approved Signatory : Justin Fry



COMPACTION ASSESSMENT

Job No 21516
 Report No 21516/R002
 Date Issued 22/03/2022

CIVIL GEOTECHNICAL SERVICES

6 - 8 Rose Avenue, Croydon 3136

Client	WINSLOW CONSTRUCTORS PTY LTD (CAMPBELLFIELD)	Tested by	AC
Project	RATHDOWNE - STAGE 9	Date tested	15/03/22
Location	WOLLERT	Checked by	JHF

Feature	EARTHWORKS	Layer thickness	200 mm	Time:	09:03
---------	------------	-----------------	--------	-------	-------

Test procedure AS 1289.2.1.1 & 5.8.1

Test No		7	8	9	10	11	12
Location		REFER TO FIGURE 1	REFER TO FIGURE 1	REFER TO FIGURE 1	REFER TO FIGURE 1	REFER TO FIGURE 1	REFER TO FIGURE 1
Approximate depth below FSL							
Measurement depth	mm	175	175	175	175	175	175
Field wet density	t/m ³	1.84	1.82	1.82	1.86	1.88	1.91
Field moisture content	%	20.5	23.0	18.4	21.2	18.6	18.3

Test procedure AS 1289.5.7.1

Test No		7	8	9	10	11	12
Compactive effort		Standard					
Oversize rock retained on sieve	mm	19.0	19.0	19.0	19.0	19.0	19.0
Percent of oversize material	wet	0	0	0	0	0	0
Peak Converted Wet Density	t/m ³	1.91	1.91	1.91	1.96	1.92	2.00
Adjusted Peak Converted Wet Density	t/m ³	-	-	-	-	-	-
Optimum Moisture Content	%	22.5	25.0	18.0	23.5	20.5	20.5

Moisture Variation From Optimum Moisture Content	2.0% dry	2.0% dry	0.5% wet	2.0% dry	2.0% dry	2.0% dry
--------------------------------------------------	----------	----------	----------	----------	----------	----------

density and moisture ratio results relate only to the soil to the depth of test and not to the full depth of the layer

Density Ratio (R _{HD})	%	96.0	95.0	95.5	95.5	98.0	95.5
-----------------------------------	---	------	------	------	------	------	------

Material description

No 7 - 12 Clay Fill

AVRLOT HILF V1.10 MAR 13



NATA Accredited Laboratory No 9909
 Accredited for compliance with
 ISO/IEC 17025 - Testing

Approved Signatory : Justin Fry