




STAGE	# of Lots
3	37
4	79
5A	36
5B	13
9	44
10	50


A	6.04.2024	INITIAL ISSUE	DEL	L	22.04.2025	STAGE 4 - LOT 467	DEL		
B	3.04.2024	STAGE 4 - LOTS 468 TO 473 ADDED	DEL	M	23.04.2025	STAGE 5 & 6 COMBINED & RENUMBERED	DEL		
C	4.04.2024	STAGING CHANGED & STAGE 3 RENUMBERED	DEL	N	13.05.2025	STAGE 5 - LOT 529	DEL		
D	11.06.2024	STAGE 3 - LOT 307	DEL	O	26.07.2025	STAGES 9 & 10 ADDED	DEL		
E	14.06.2024	STAGE 3 - LOTS 408 & 464	DEL	P	08.09.2025	STAGE 10 - LOT 543 RENUMBERED TO 1058	DEL		
F	31.07.2024	STAGE 3 - LOTS 313 & 314	DEL	Q	22.10.2025	STAGES 9 & 10 REDESIGNED	DEL		
G	16.08.2024	STAGE 3 - LOTS 301 TO 303	DEL	R	10.12.2025	STAGE 5 - LOT 509	DEL		
H	20.11.2024	STAGE 4 - RENUMBERED	DEL	S		STAGE 9 - LOTS 901 TO 904, 909 TO 914, 919 TO 923 & 944	DEL		
I	2.12.2024	STAGE 4 - LOTS 460 TO 467	DEL			STAGE 10 - LOTS 101 TO 1009 & 1031 TO 1035	DEL		
J	8.01.2025	STAGE 4 - LOTS 431 TO 434 & 479	DEL				DEL		
REV	DATE	DESCRIPTION	CALC	FIELD	REV	DATE	DESCRIPTION	CALC	FIELD
ADDITIONS, AMENDMENTS AND APPROVALS					ADDITIONS, AMENDMENTS AND APPROVALS				

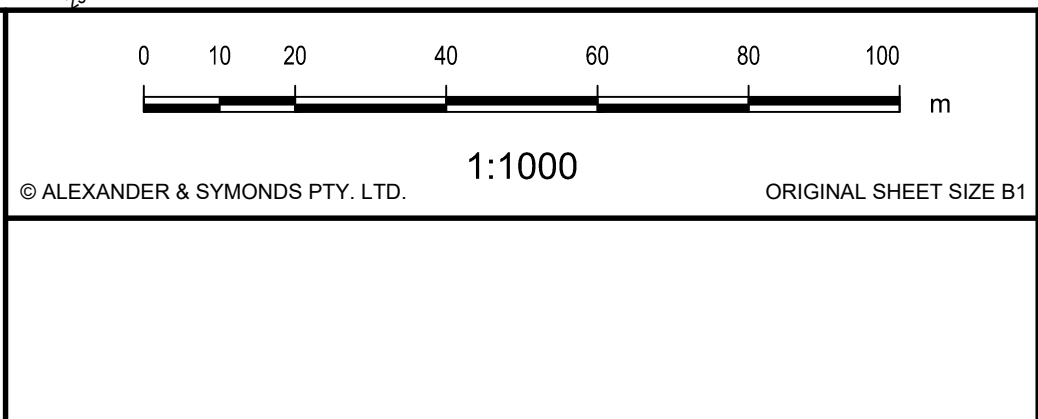

Alexander & Symonds Pty Ltd
Kaurna Country
Level 1, 62 The Parade, Norwood,
South Australia 5067
ABN 93007 753 988

T (08) 8130 1666
W www.alexander.com.au
E adelaide@alexander.com.au

+ Property + Land Development +
+ Construction + Mining +
+ Spatial Information Management +

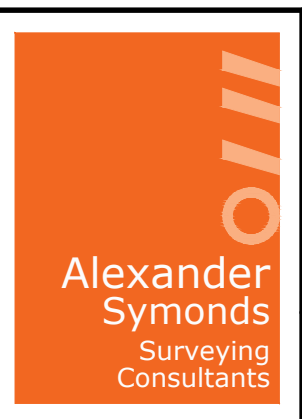

STAGES 3,4,5,6, 9 & 10 WILLIAM LAKES PEGGING PLAN		DRAWING No.	SHEET 1 OF 1	REVISION
		21A1311CAD ST 3, 4, 5, 6, 9 & 10 Rev S		S