


A	6.04.2024	INITIAL ISSUE	DEL
B	3.04.2024	STAGE 4 - LOTS 468 TO 473 ADDED	DEL
C	4.04.2024	STAGING CHANGED & STAGE 3 RENUMBERED	DEL
D	11.06.2024	STAGE 3 - LOT 307	DEL
E	14.06.2024	STAGE 4 - LOTS 408 & 464	DEL
F	31.07.2024	STAGE 3 - LOTS 313 & 314	DEL
G	16.08.2024	STAGE 3 - LOTS 301 TO 303	DEL
		STAGE 4 - RENUMBERED	DEL
REV	DATE	DESCRIPTION	CALC FIELD
ADDITIONS, AMENDMENTS AND APPROVALS			

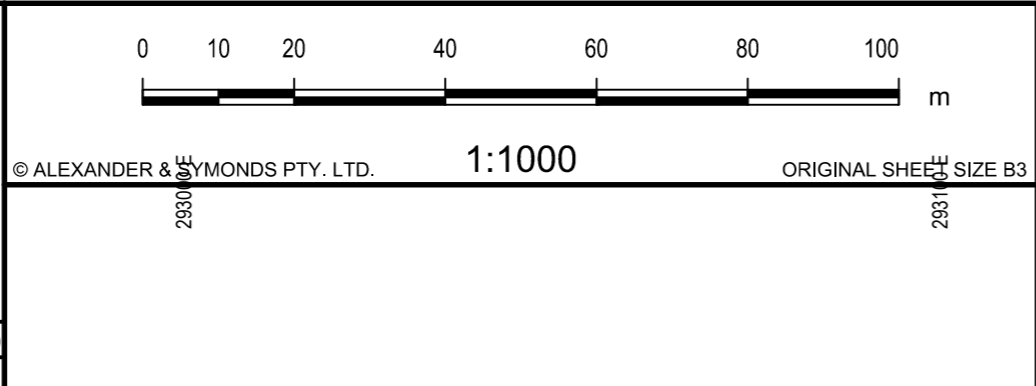

Alexander & Symonds Pty Ltd
 11 King William Street Kent Town,
 South Australia 5067
 PO Box 1000 Kent Town, SA 5071
 ABN 93007 753 988

T (08) 8130 1666
 F (08) 8362 0099
 W www.alexander.com.au
 E adelaide@alexander.com.au

+ Property + Land Development +
 + Construction + Mining +
 + Spatial Information Management +



STAGE 4 WILLIAM LAKES PEGGING PLAN

DRAWING No. 21A1311CAD ST 4 Rev G SHEET 1 OF 1 REVISION G