


A1

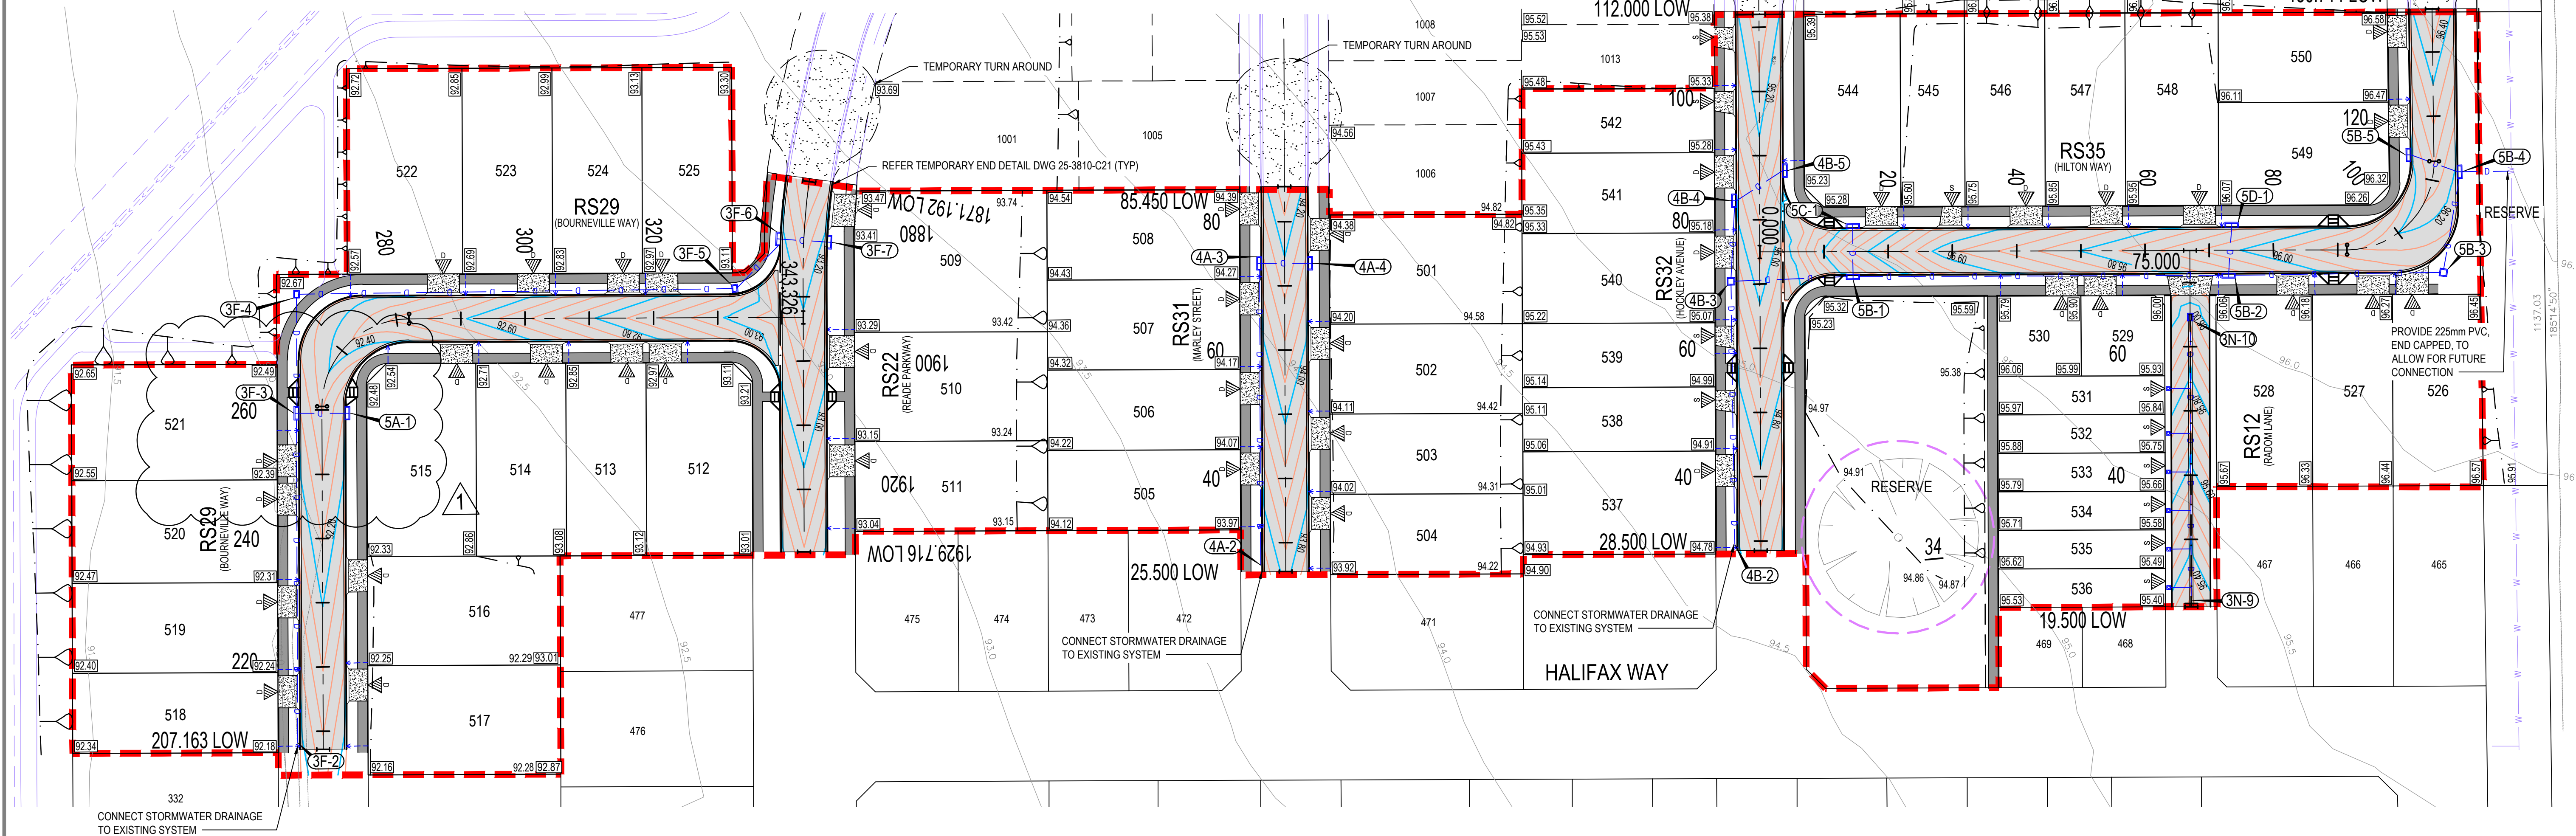

LEGEND

PROPOSED

	ROAD CENTRELINE		STORMWATER DRAIN
	150 HIGH BARRIER KERB AND GUTTER		STORMWATER KERB OUTLET
	1000 WIDE EDGE STRIP		ALLOTMENT STORMWATER CONNECTION
	600 WIDE SPOON DRAIN		SIDE ENTRY PIT (SEP DOUBLE)
	AC PAVEMENT		JUNCTION BOX (JB)
	FOOTPATH		GRADED INLET PIT (GIP)
	KERB RAMP		MAJOR SURFACE CONTOUR (0.2m INCREMENT)
	INDICATIVE DRIVEWAY LOCATION (D=DOUBLE, S=SINGLE)		MINOR SURFACE CONTOUR (0.05m INCREMENT)
	DRIVEWAY CROSSOVER		EARTHWORKS BATTER (1 in 5 UNO)
	DESIGN LEVEL		STAGE BOUNDARY
	EXISTING LEVEL		


FUTURE

	KERB
	FOOTPATH
	KERB RAMP
	DRIVEWAY LOCATION
	DRIVEWAY CROSSOVER
	STORMWATER DRAIN
	SIDE ENTRY PIT
	JUNCTION BOX
	SWALE INVERT
	BATTER LINE

EXISTING

	SURFACE CONTOUR
	TREE TO BE RETAINED
	TREE PROTECTION ZONE (TPZ)
	TREE ID. REFER REPORT ATSG772-EDWRDPTA

SCALE

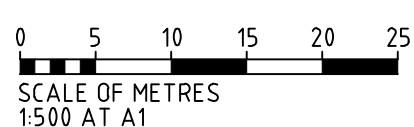

COORDINATES / DATUM

MGA 2020 ZONE 54 / AHD

DESIGNED

GK

DRAWN

GK

APPROVED

CHECKED

MLC

CHECKED

MLC

DATE

CLIENT

ROSEWORTHY DEVELOPMENTS PTY LTD

Colliers

GREENHILL

LEVEL 1, 178 FULLARTON ROAD
DULWICH SA 5065
08 8406 1300
www.greenhillaustralia.com.au

THIS DRAWING REMAINS THE PROPERTY OF GREENHILL ENGINEERS PTY LTD. AND
MAY NOT BE COPIED IN ANY WAY WITHOUT PRIOR APPROVAL FROM THIS COMPANY.
© GREENHILL ENGINEERS PTY LTD.

STATUS: FOR CONSTRUCTION

WILLIAM LAKES STAGE 5
HORROCKS HIGHWAY, GAWLER BELT
GENERAL CONSTRUCTION AND STORMWATER PLAN

DRAWING NUMBER

25-3810-C02

REVISION

1

REV	DATE	DESCRIPTION	DES	DRN
1	07.08.26	DRIVEWAY UPDATED LOT 521	GK	CK
0	21.01.26	ISSUED FOR CONSTRUCTION	GK	GK

REVISION HISTORY

100 MILLIMETRES ON ORIGINAL DRAWING

FOR NOTES REFER DRG 24-3516-C01

CAD FILE NAME: 25-3810-C02