
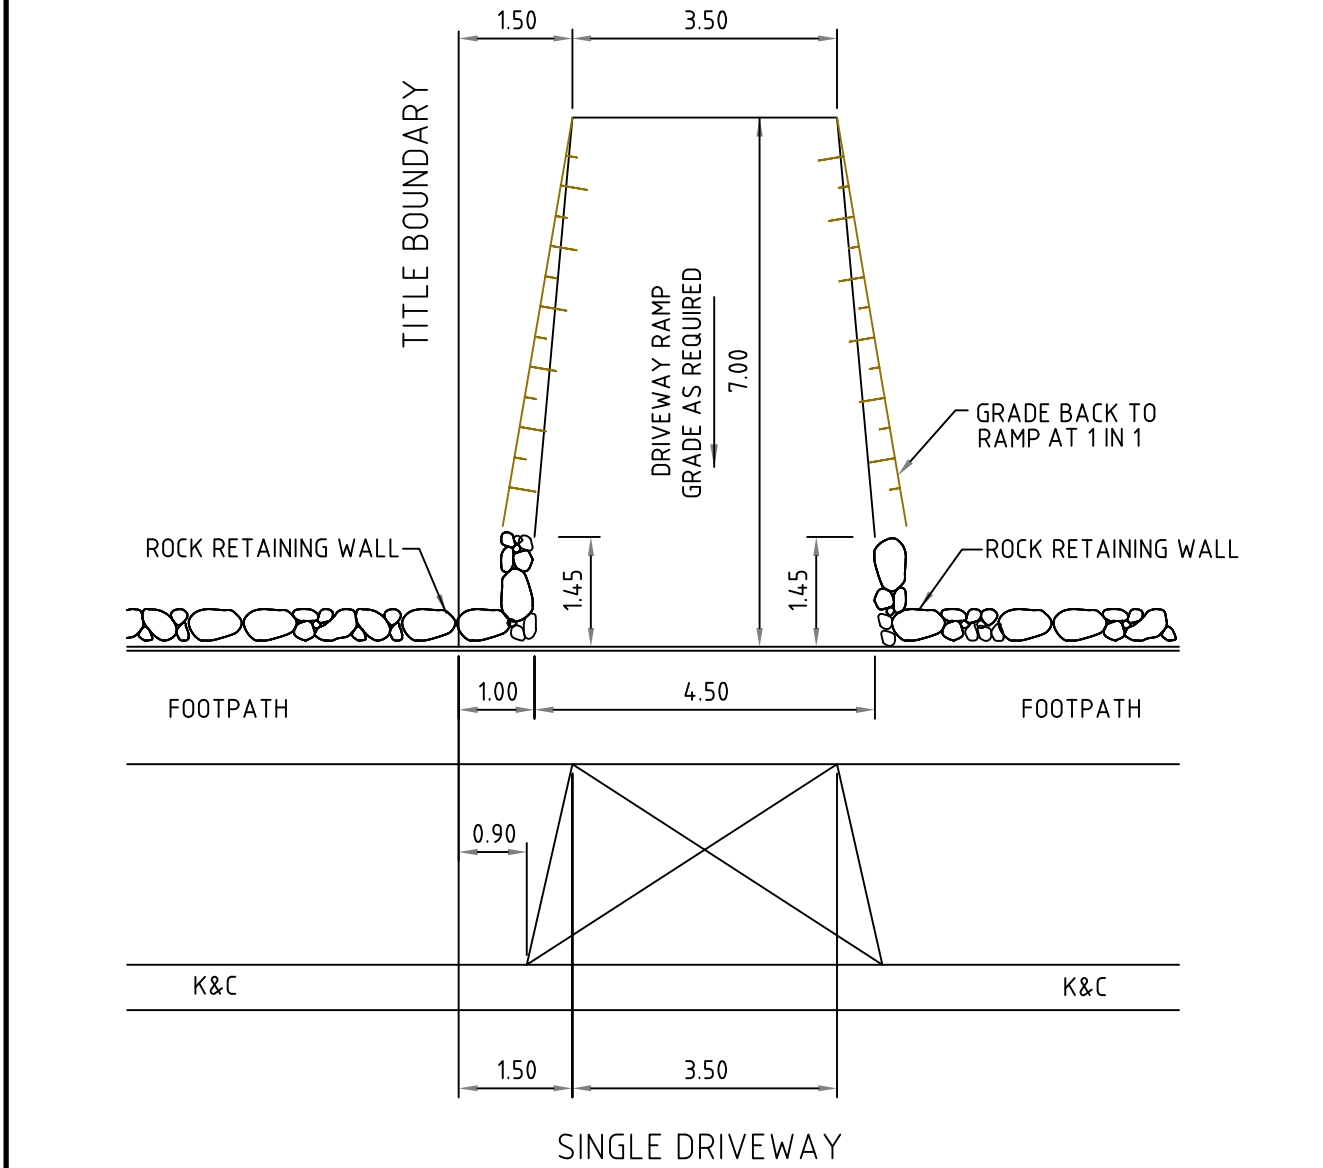


file name: 371629_000CR900.dwg, layout: asps, C9000, plotted by: Thanh Nguyen, file location: G:\371629\000\Cr\001\A1.dwg, plot date: 16/04/2025, 4:43 PM, Sheet 16 of 17 Sheets

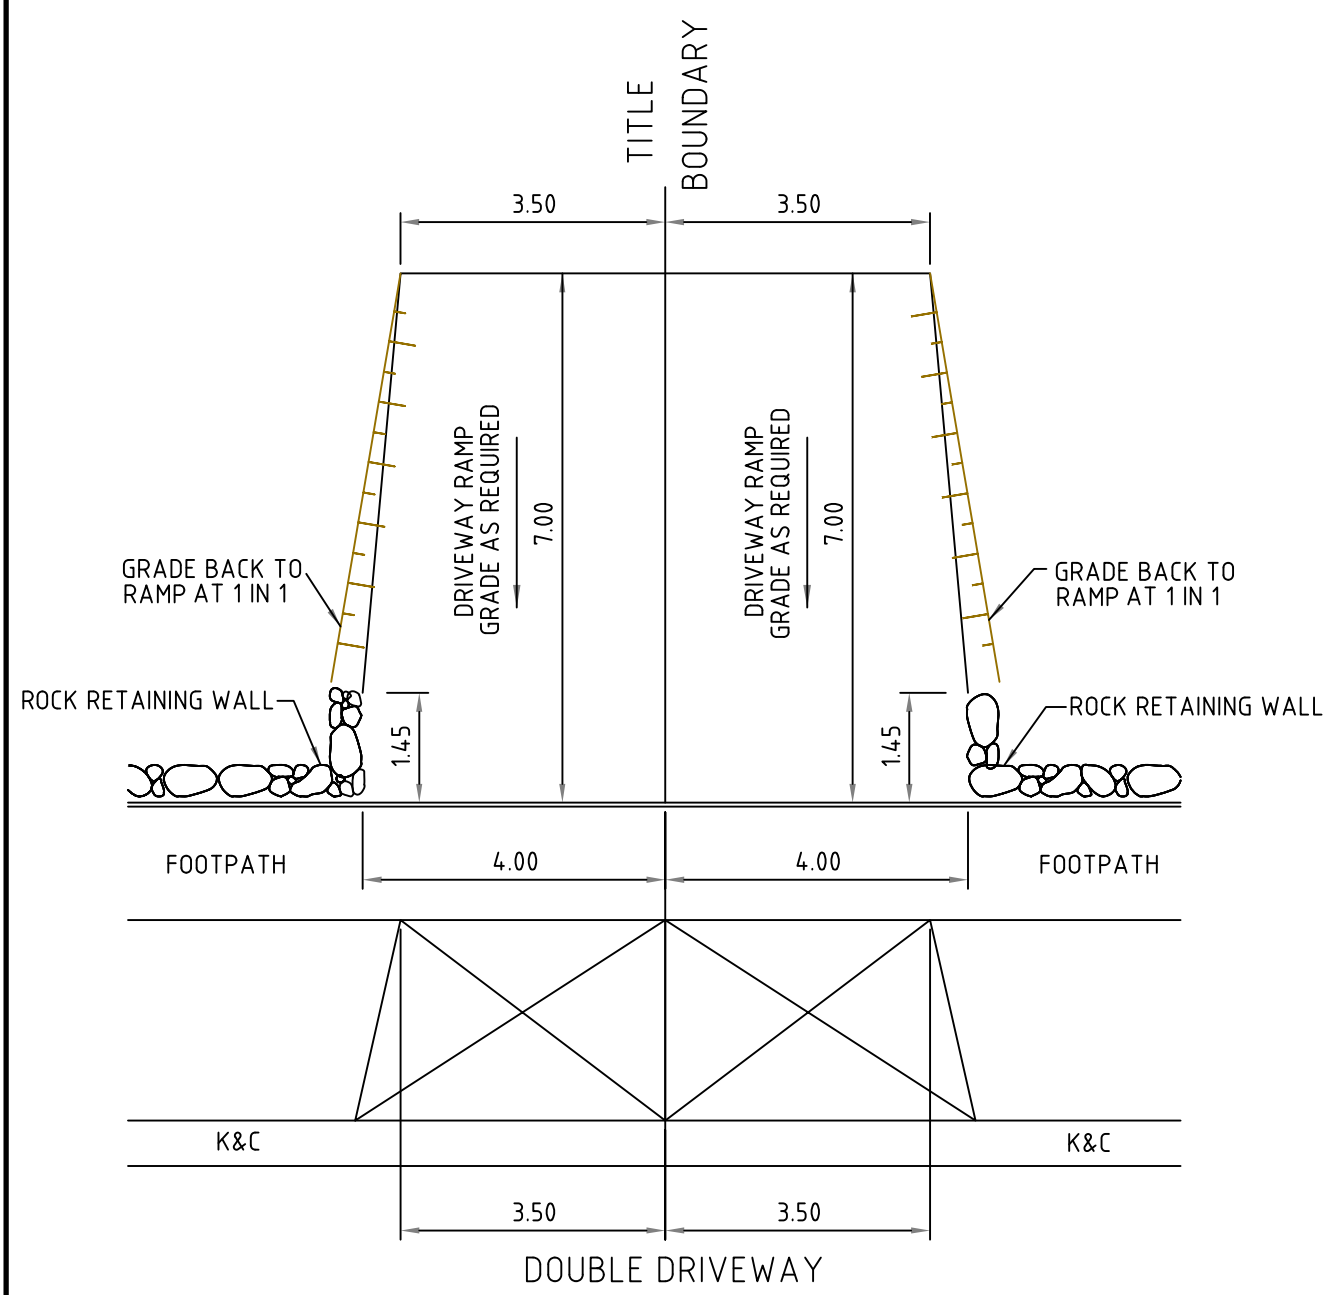

ROCK RETAINING WALL TYPICAL DETAIL


NOT TO SCALE

- NOTE:
FOR RETAINING WALL DETAILS REFER TO 'SHERWOOD GRANGE RETAINING WALLS DWG 3410 S01-S07'
- NOTE:
THE RETAINING WALL PLAN IS NOT PART OF THE SUBDIVISIONAL WORKS OR APPROVAL. IT IS SUBJECT TO SEPARATE APPROVAL. THIS SHEET IS SUPPLEMENTARY TO THE ENGINEERING DRAWINGS.
- NOTE:
FOR LEVELS OF RETAINING WALLS FRONTING STREETS, REFER TO RELEVANT ROAD/STREET LONGITUDINAL SECTIONS
- NOTE:
AG DRAINS BEHIND RETAINING WALLS TO DISCHARGE INTO PROPERTY DRAINAGE CONNECTIONS

LEGEND


- EXISTING CONCRETE SLEEPER RETAINING WALL
EXISTING ROCK RETAINING WALL
EXISTING ROCK RETAINING WALL WITH FENCE
FUTURE CONCRETE SLEEPER RETAINING WALL
CONCRETE SLEEPER RETAINING WALL
ROCK RETAINING WALL
ROCK RETAINING WALL WITH FENCE

Rev	Amendments	Approved	Date
2	RETAINING WALL ALIGNMENTS AMENDED		M.T-S 16/04/25
1	RETAINING WALLS AMENDED		M.T-S 29/04/24
0	ISSUED FOR CONSTRUCTION		M.T-S 25/03/24
A	ISSUED TO COUNCIL		M.T-S 15/12/23

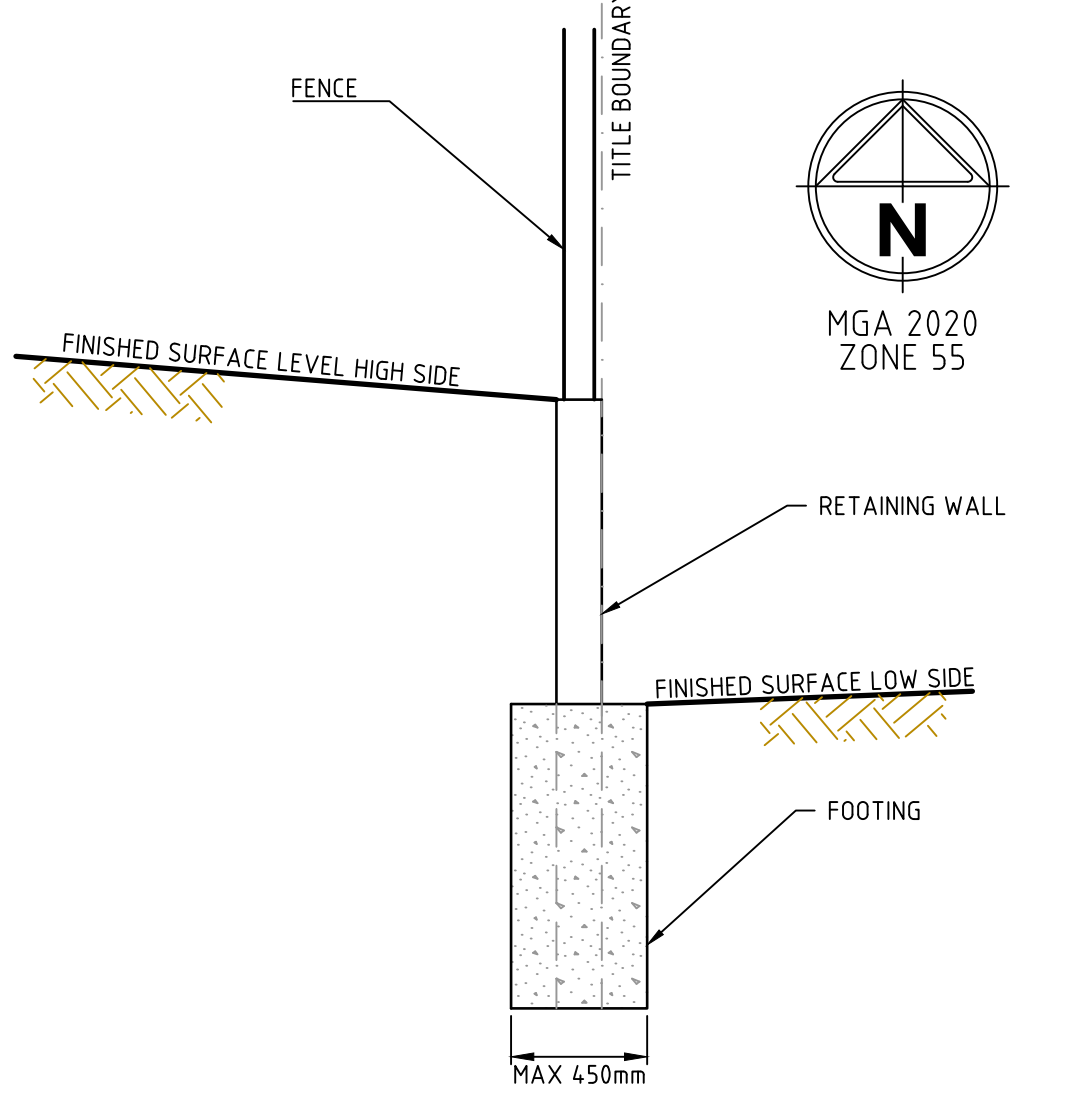


SLEEPER RETAINING WALL TYPICAL DETAIL

NOT TO SCALE

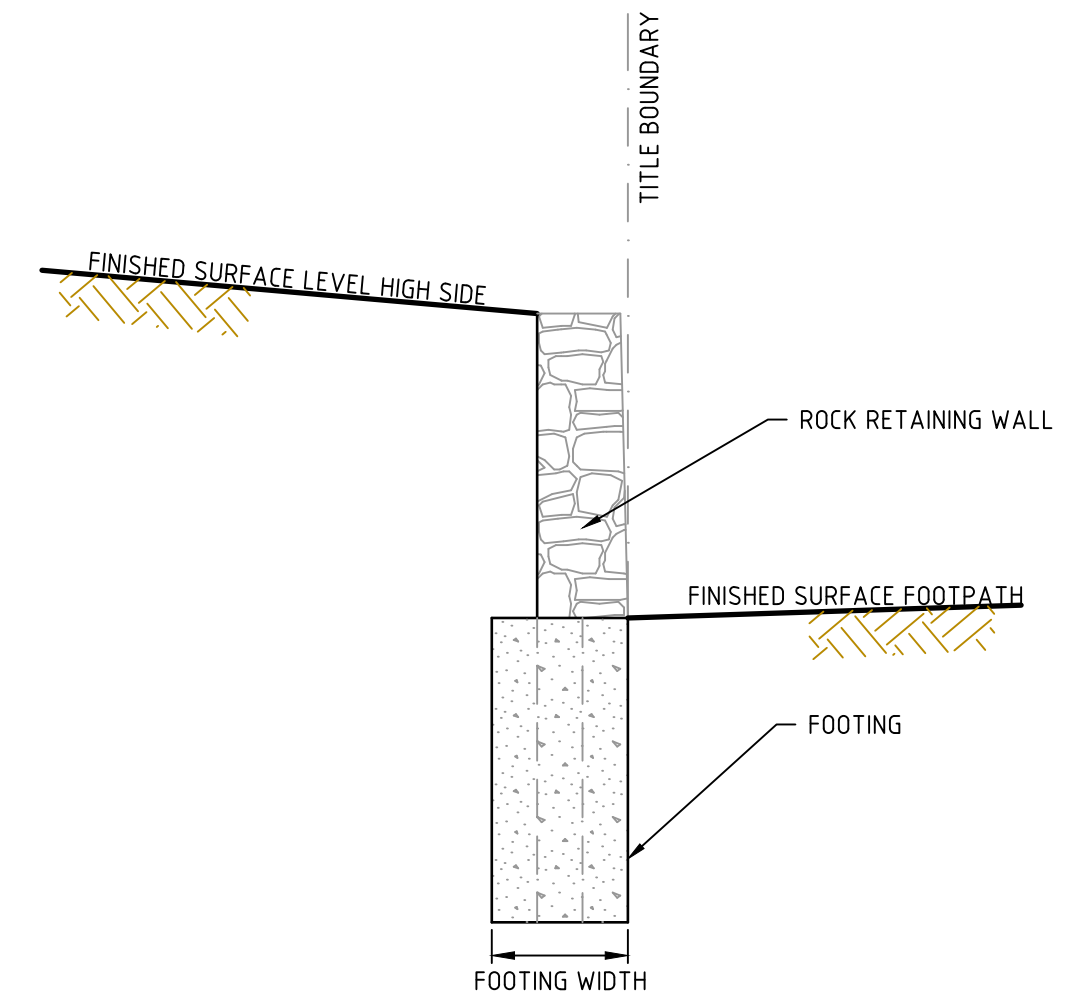

ROCK RETAINING WALL TYPICAL DETAIL

NOT TO SCALE

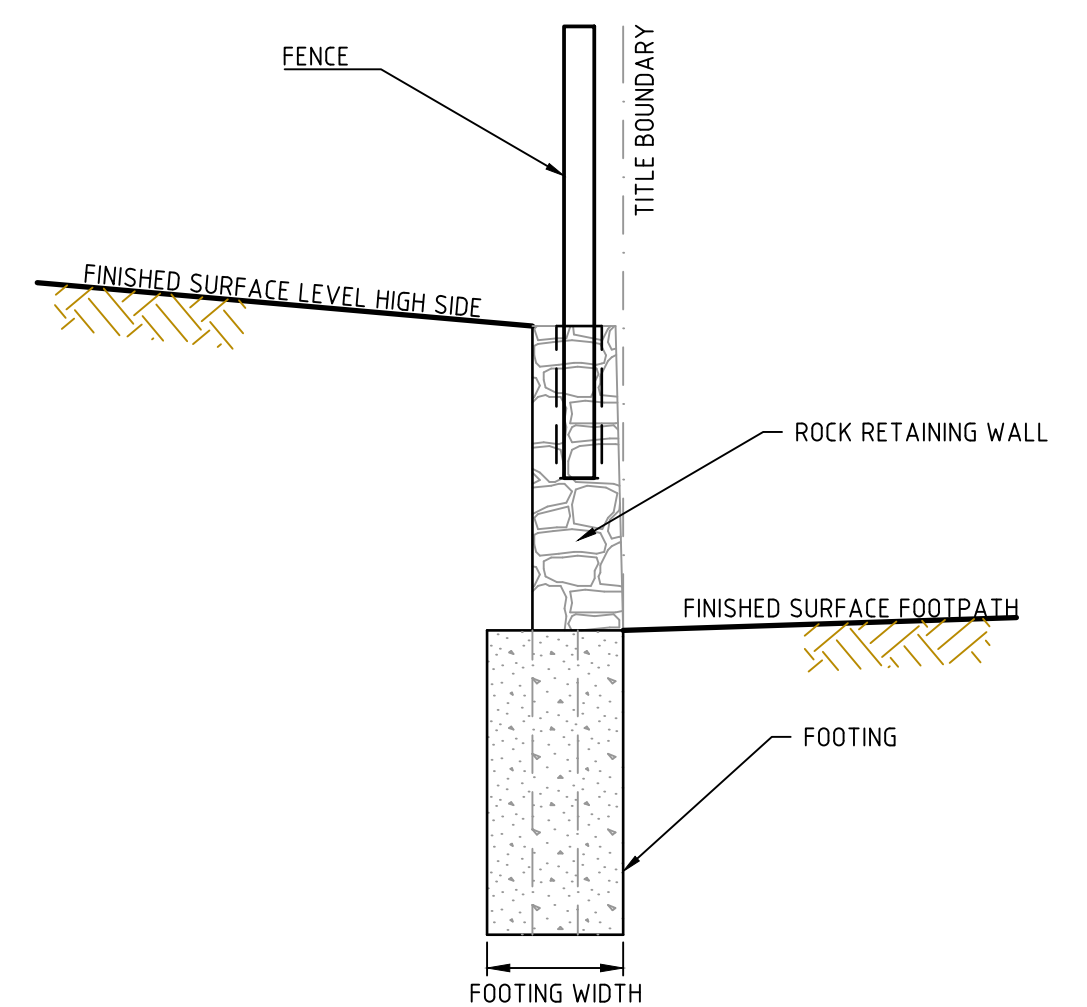

ROCK RETAINING WALL TYPICAL DETAIL (WITH PROVISION FOR FENCING)

NOT TO SCALE

System Certified

© Spiire Australia Pty Ltd All Rights Reserved
This document is produced by Spiire Australia Pty Ltd solely for the benefit of and use by the client in accordance with the terms of the retainer. Spiire Australia Pty Ltd does not and shall not assume any responsibility or liability whatsoever to any third party arising out of any use or reliance by third party on the content of this document.

spiire

L6 414 LA TROBE STREET PO BOX 16084 MELBOURNE
VICTORIA 8007 AUSTRALIA T 61 3 9993 7888
spiire.com.au ABN 55 050 029 635

Sherwood Grange

Designed
T. NGUYEN

Checked
L. TRAN

Authorised
M. TOOMER-SMITH

Date
15/12/23


SHERWOOD GRANGE
STAGE 8B
ROAD AND DRAINAGE
RETAINING WALLS - SHEET 1
HUME CITY COUNCIL
RACECOURSE ROAD HOLDING PTY LTD

CONSTRUCTION


Drg No
321629-000CR900

Rev
2


NOTE:
THE RETAINING WALL PLAN IS NOT PART OF THE
SUBDIVISIONAL WORKS OR APPROVAL. IT IS SUBJECT TO
SEPARATE APPROVAL, THIS SHEET IS SUPPLEMENTARY
TO THE ENGINEERING DRAWINGS.

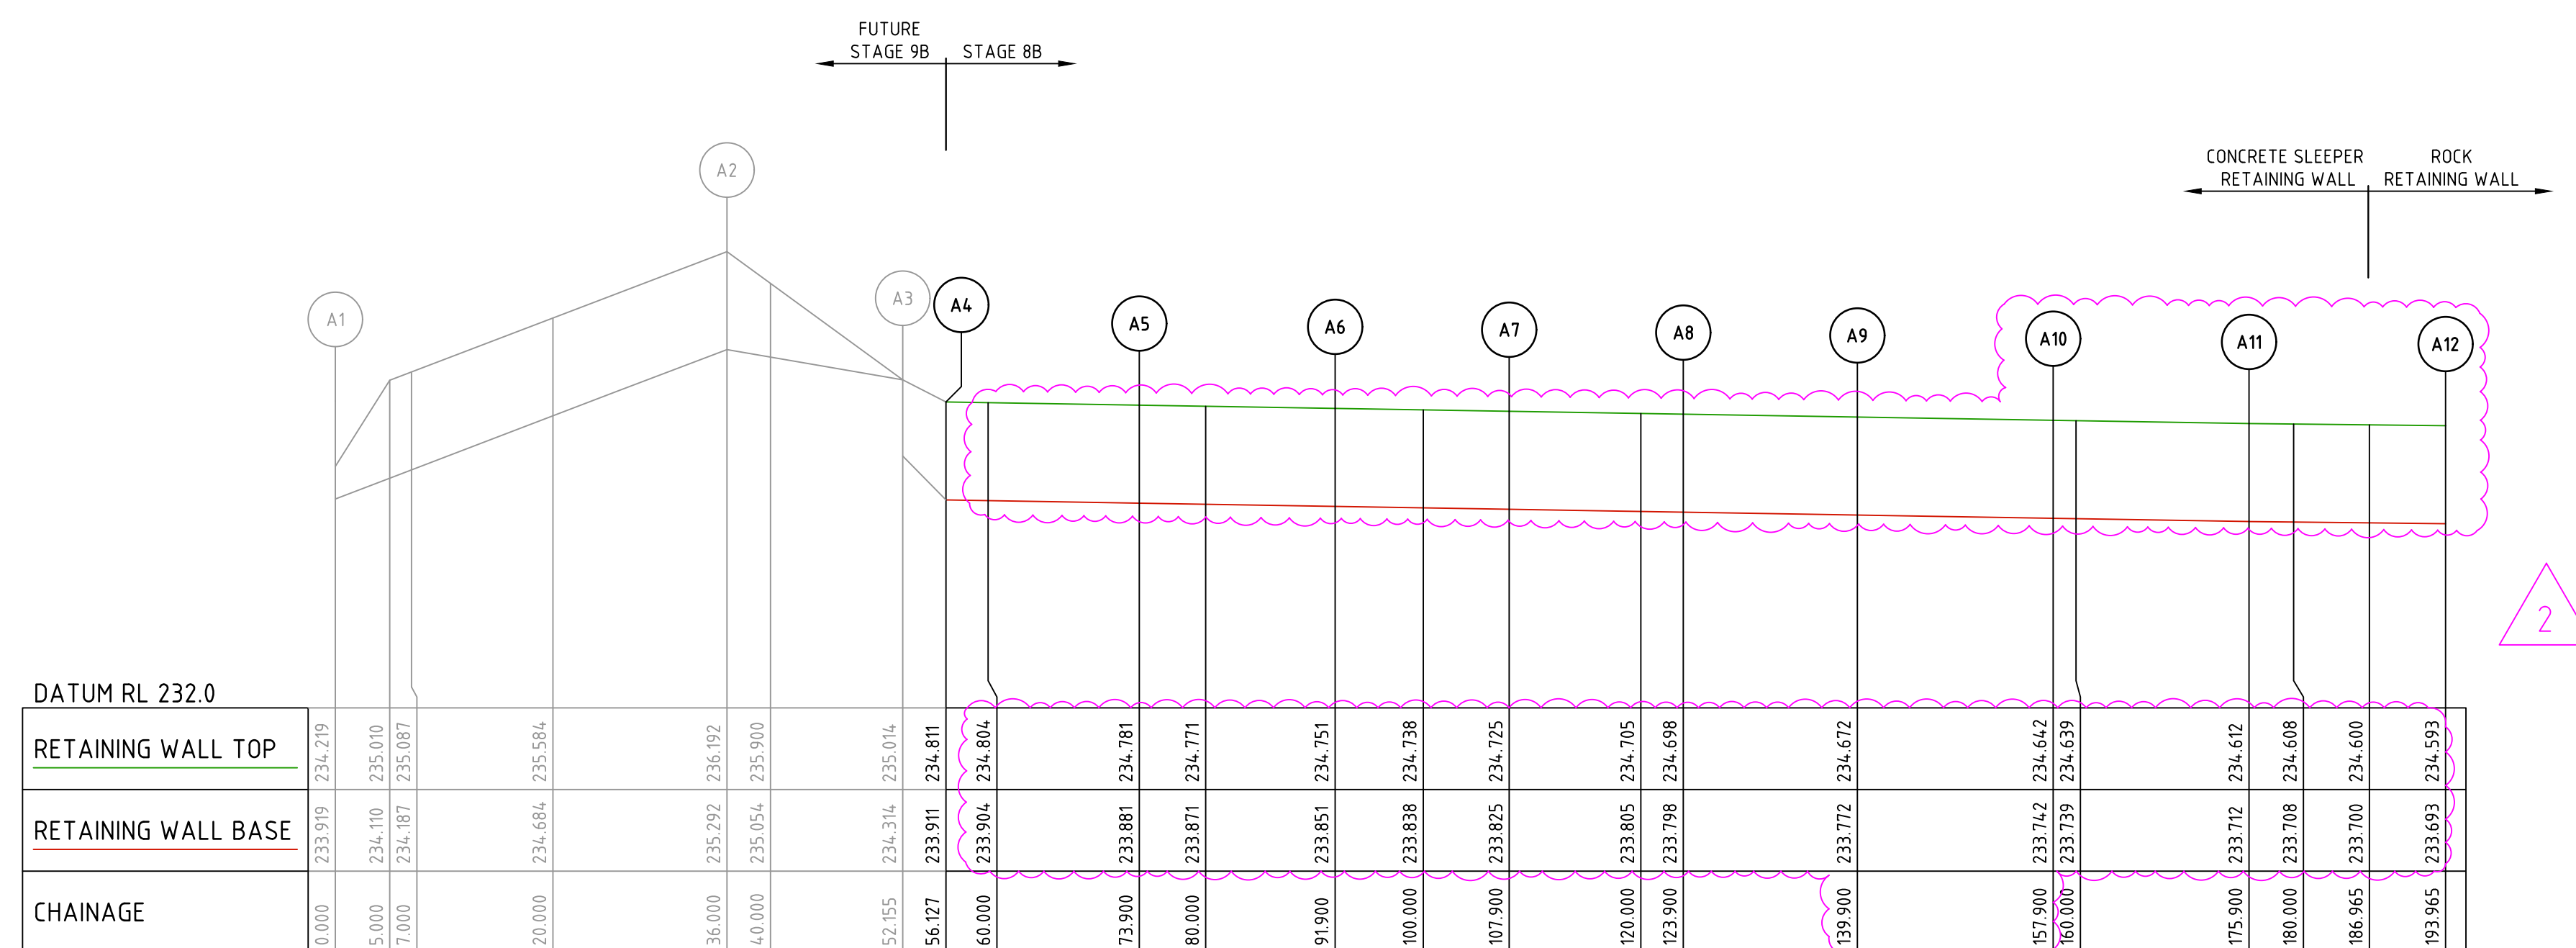


RETAINING WALL A

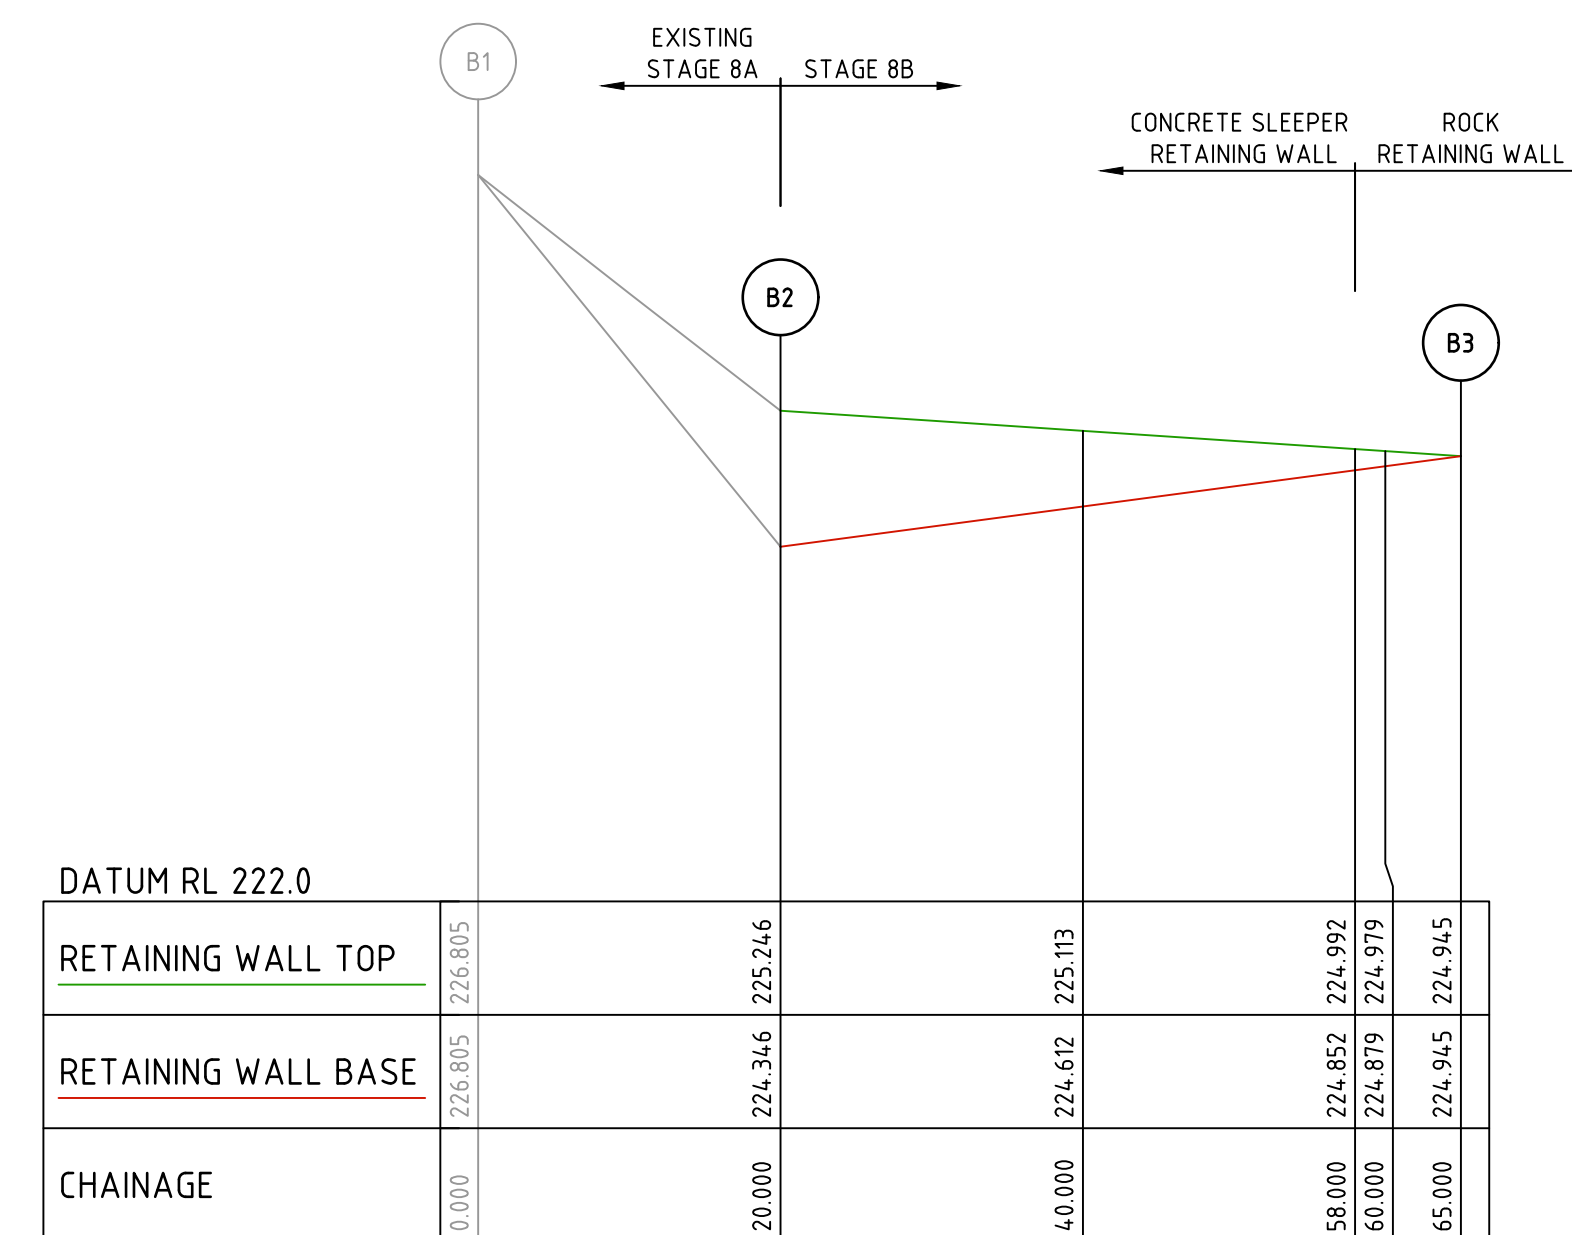

RETAINING WALL B

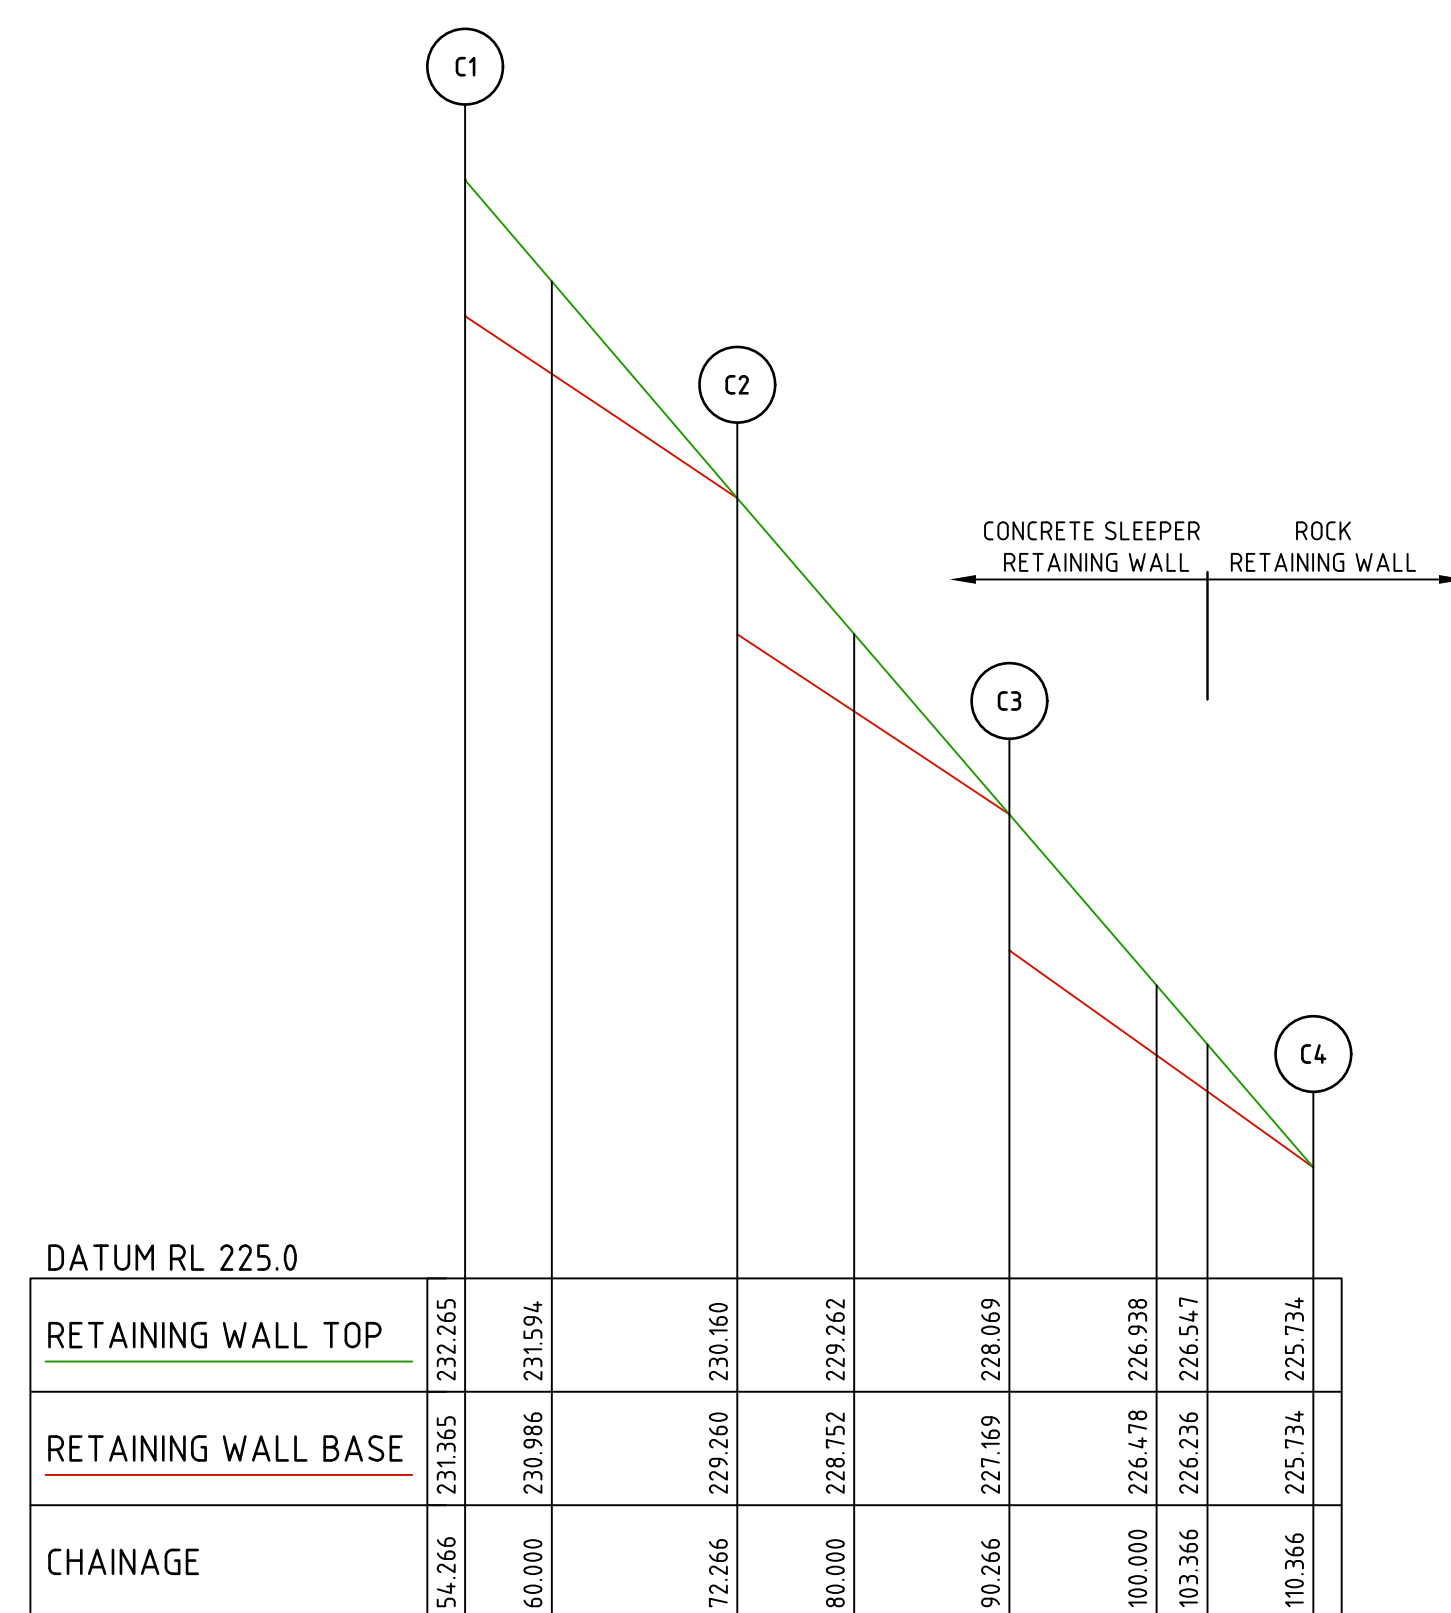


RETAINING WALL C

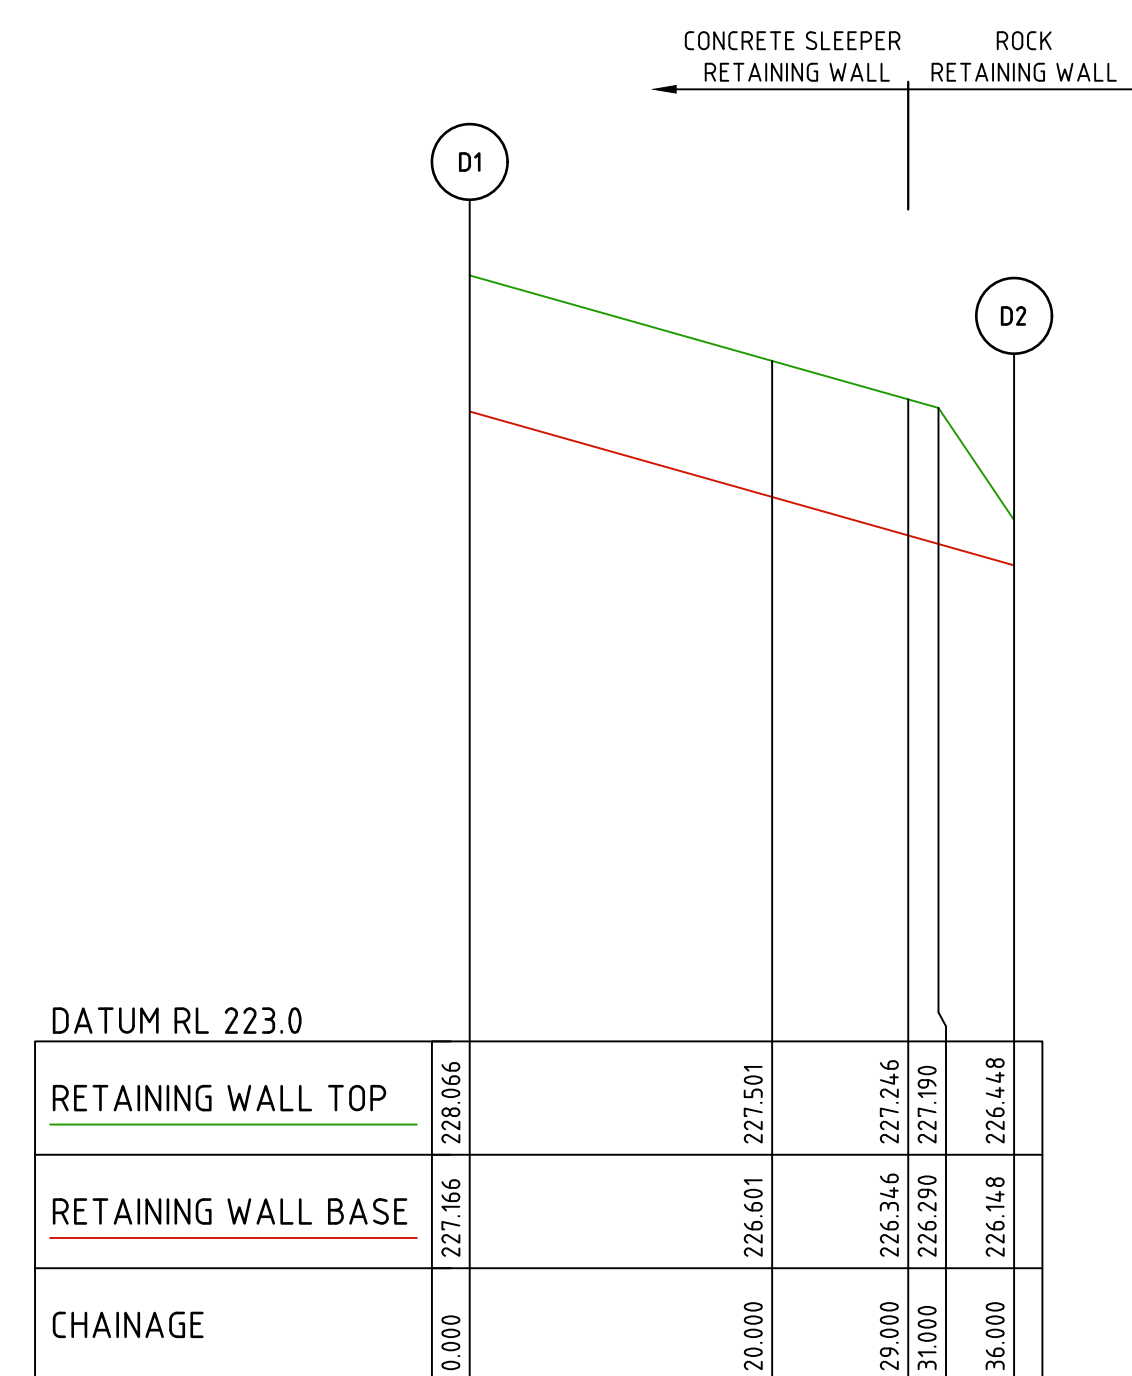

RETAINING WALL D

File name: 321629-000CE900.dwg, last modified: 12/15/2023 11:03:31 AM			
File location: \\aspire\media\data\321629\321629-000CE900.dwg			
2	RETAINING WALL A AMENDED	M.T-S	16/04/25
1	RETAINING WALL A AMENDED	M.T-S	29/04/24
0	ISSUED FOR CONSTRUCTION	M.T-S	25/03/24
A	ISSUED TO COUNCIL	M.T-S	15/12/23
Rev	Amendments	Approved	Date

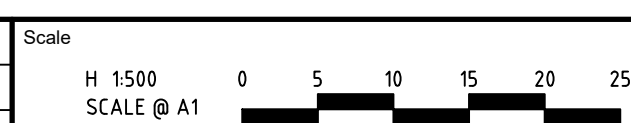

© Spiire Australia Pty Ltd All Rights Reserved
This document is produced by Spiire Australia Pty Ltd solely for the benefit of and use by the client in accordance with the terms of the retainer. Spiire Australia Pty Ltd does not and shall not assume any responsibility or liability whatsoever to any third party arising out of any use or reliance by third party on the content of this document.



L6 414 LA TROBE STREET PO BOX 16084 MELBOURNE
VICTORIA 8007 AUSTRALIA T 61 3 9993 7888
spiire.com.au ABN 55 050 029 635



Designed	Checked
T. NGUYEN	L. TRAN
Authorised	Date
M. TOOMER-SMITH	15/12/23

**SHERWOOD GRANGE
STAGE 8B
ROAD AND DRAINAGE
RETAINING WALLS - SHEET 2
HUME CITY COUNCIL
RACECOURSE ROAD HOLDING PTY LTD**

CONSTRUCTION	Drg No	Rev
	321629-000CR901	2