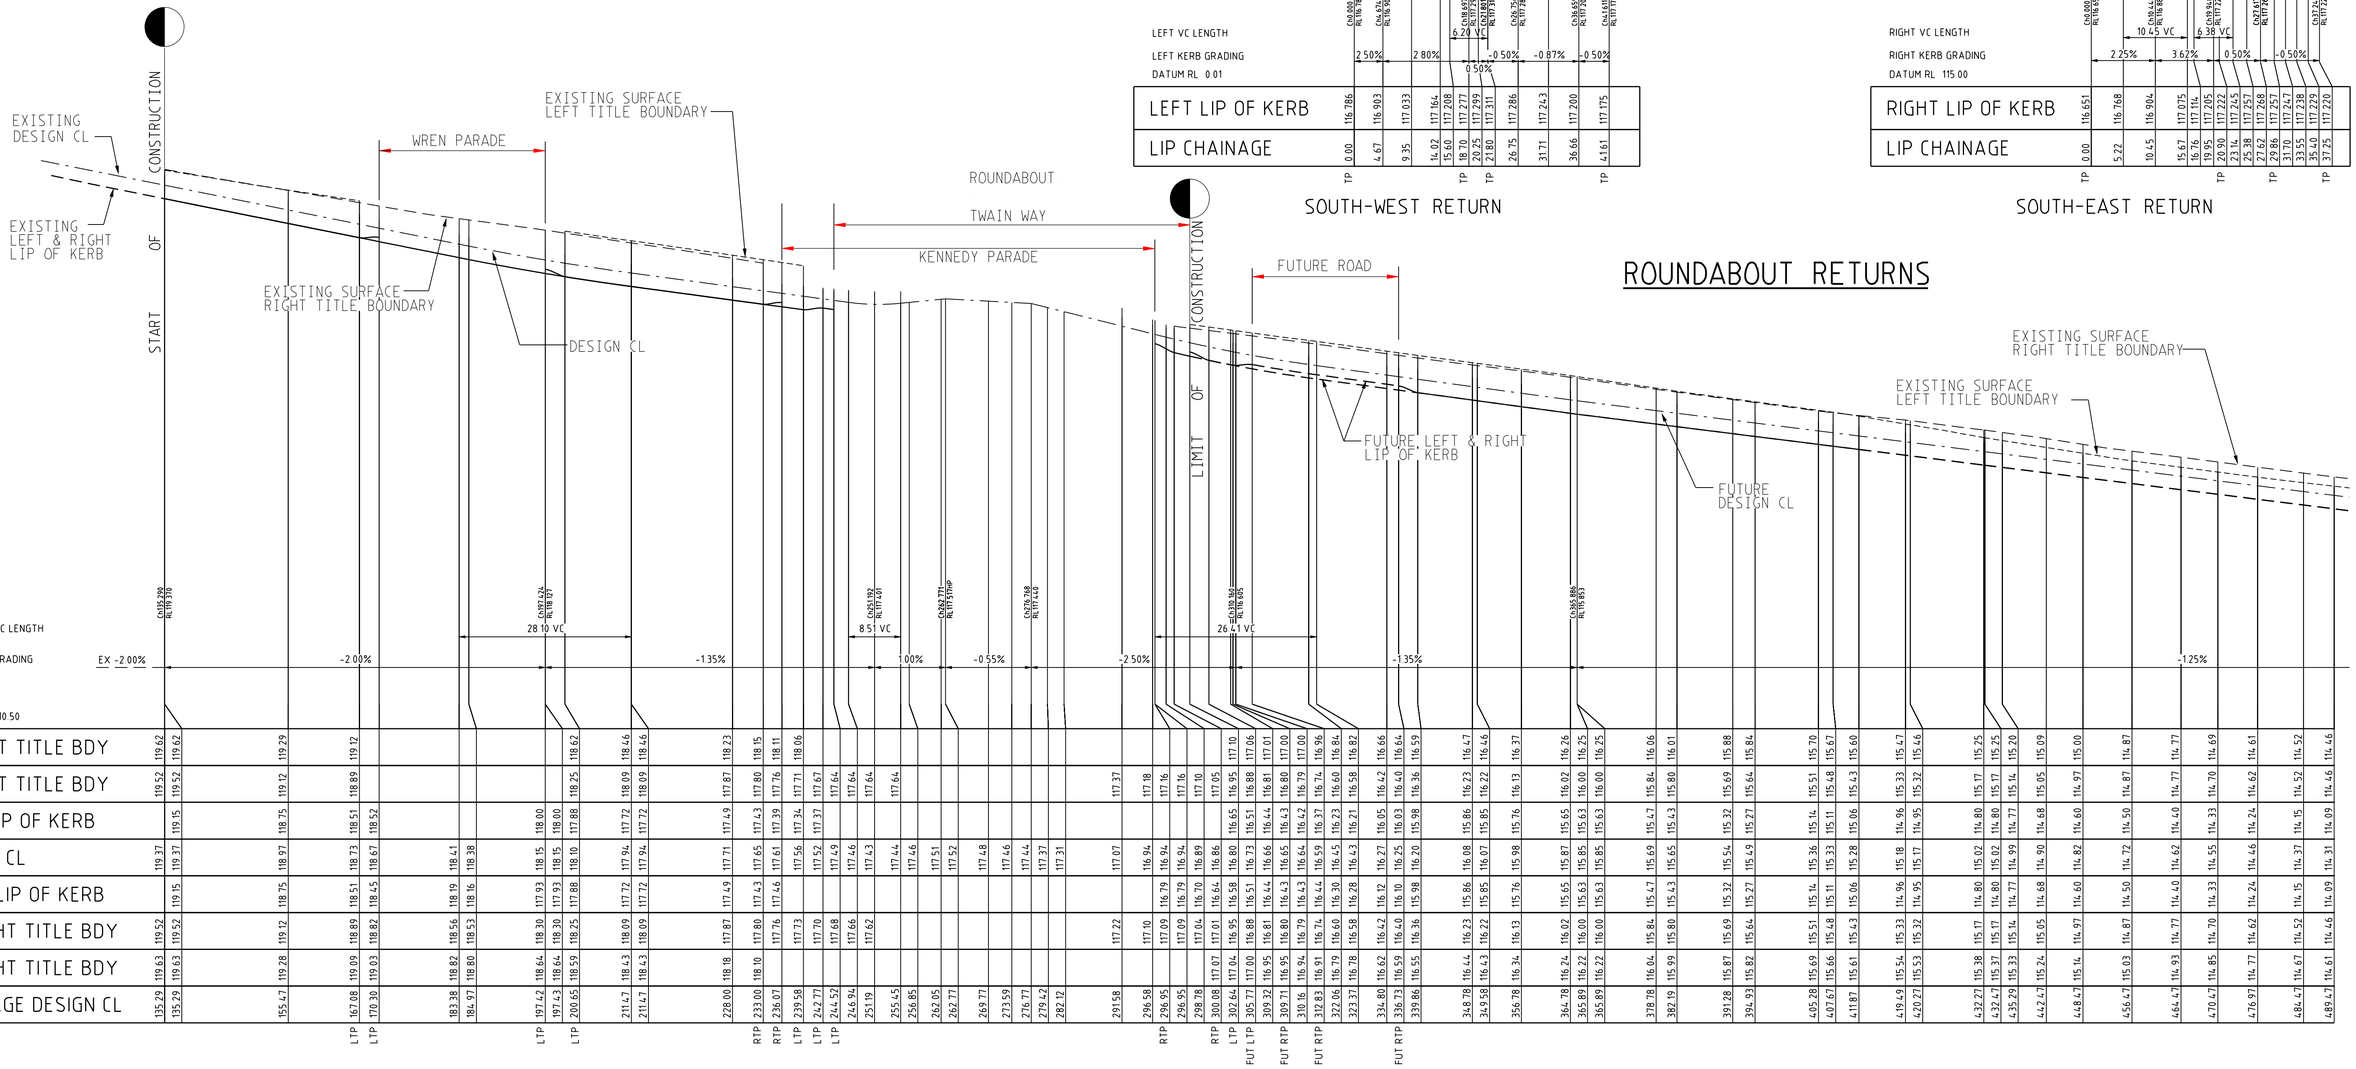

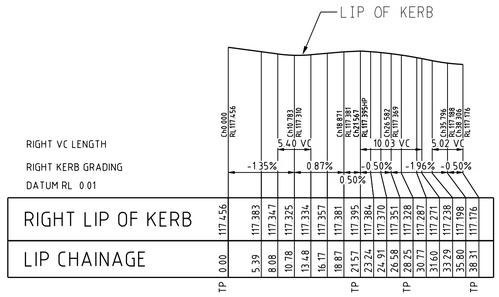

NORTH-WEST RETURN

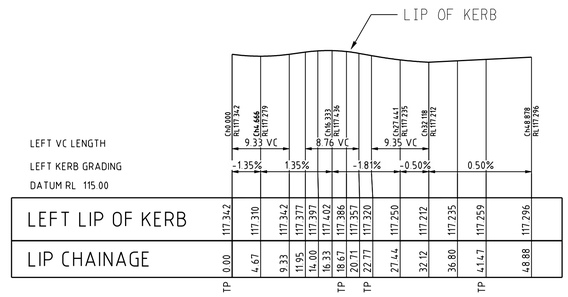

NORTH-EAST RETURN

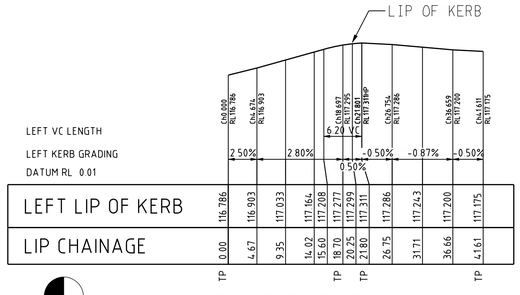

SOUTH-WEST RETURN

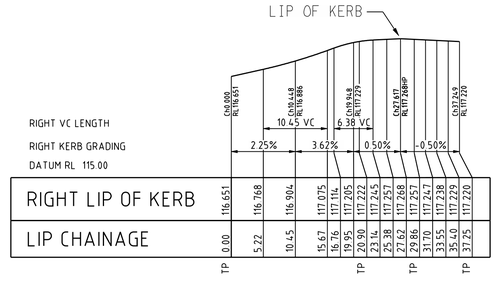

SOUTH-EAST RETURN

ROUNDABOUT RETURNS

ASPIRE BOULEVARD

LONGITUDINAL SECTION
SCALE HORIZONTAL 1:500
VERTICAL 1:50

AS CONSTRUCTED

AMENDMENTS			
VER.	DATE	REMARKS	
A	23/04/14	ISSUED FOR CONSTRUCTION.	

breese pitt dixon pty. ltd.
land surveyors civil engineers

1/19 cato street
hawthorn east, 3123
telephone 8823 2300
fax no. 8823 2310

MELWAY REF.	356-D-2
SURVEY	BPD
DESIGN	IB
DRAWN	IB
CHECKED	

ASPIRE ESTATE
STAGE 8

MUNICIPALITY: MELTON
REFERENCE: 8226 E/8

SCALE AS SHOWN | DATUM AHD | DATE FEB'14 | SHEET 5 OF 15 | A

I:\V8226\ENG\STG8\E8_RD05_ASLS.DGN
Plotted:24-Apr-2014