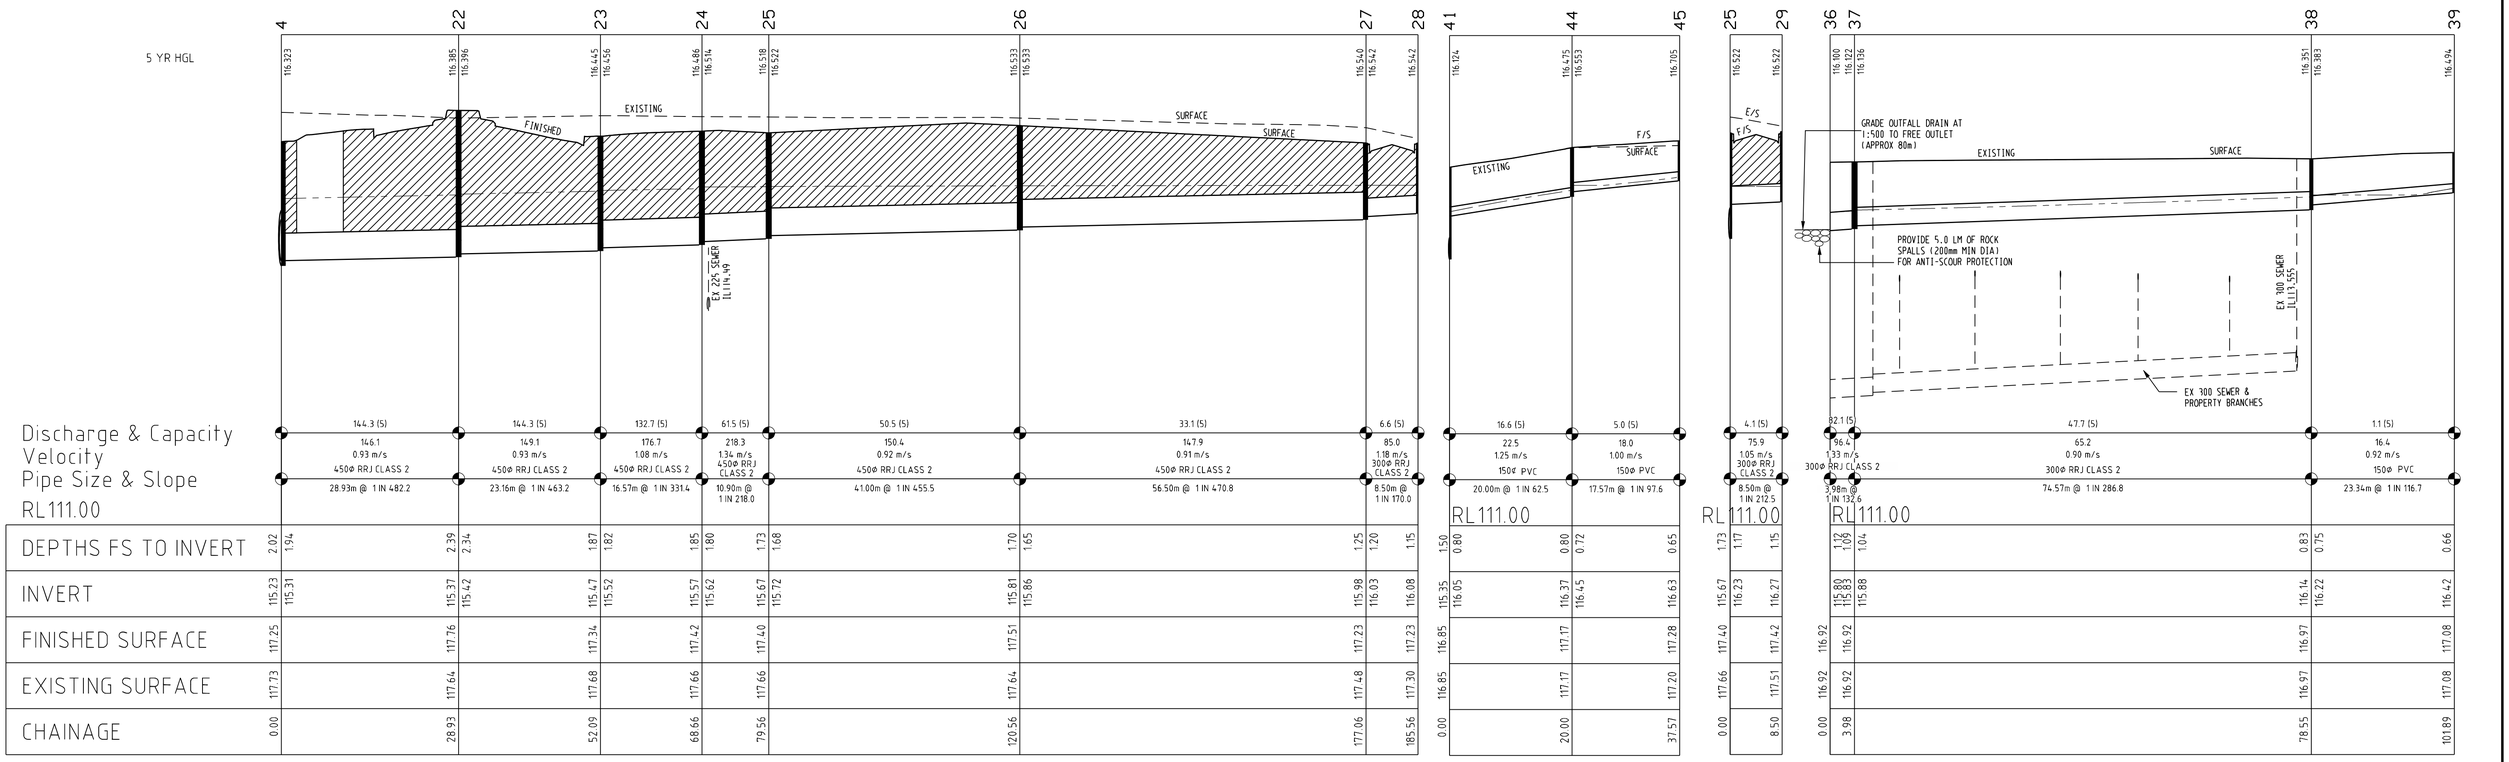

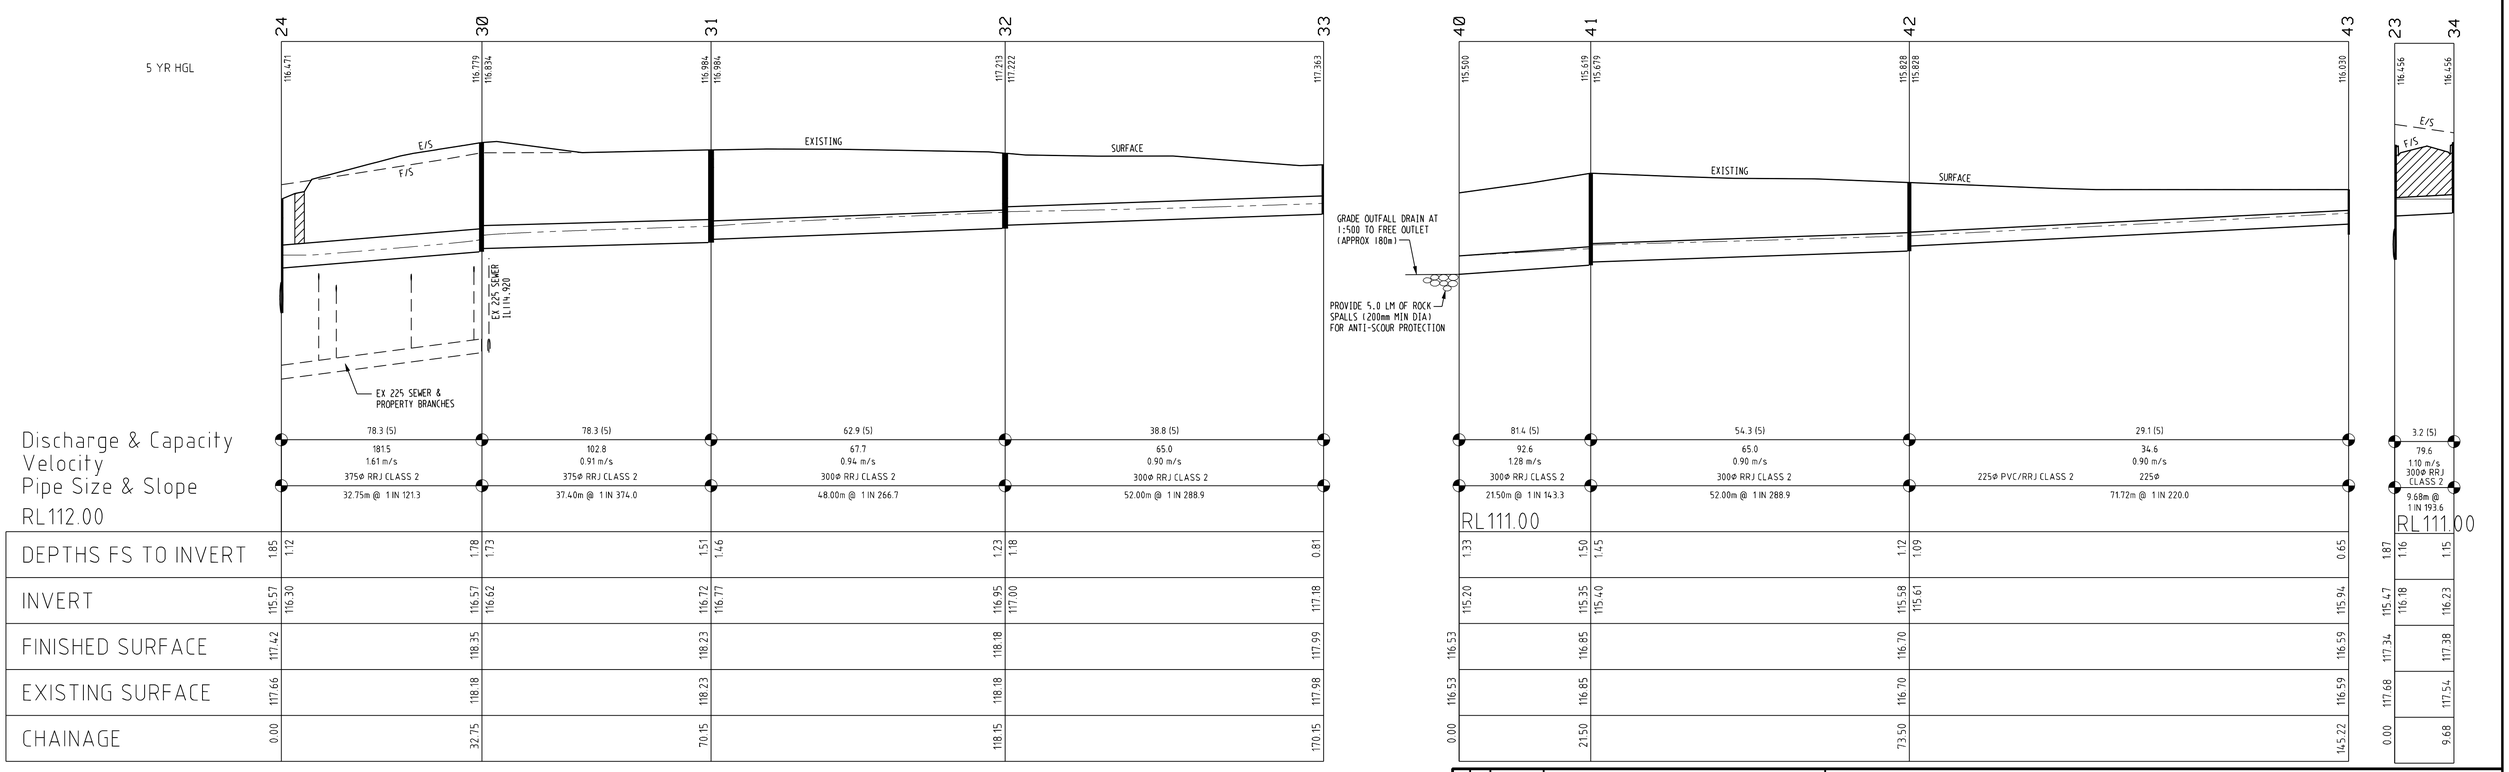

INDICATES CRUSHED ROCK BACKFILL

INDICATES 5YR HGL

DRAINAGE LONGITUDINAL SECTIONS

SCALE HORIZONTAL 1:500
VERTICAL 1:50

AS CONSTRUCTED

VER.	DATE	REMARKS
C	10/09/14	PIT 43 RELOCATED
B	28/08/14	PIT 43 RELOCATED
A	23/04/14	ISSUED FOR CONSTRUCTION.

AMENDMENTS

breese pitt dixon pty. ltd.
land surveyors civil engineers
1/19 cato street
hawthorn east, 3123
telephone 8823 2300
fax no. 8823 2310

MELWAY REF. 356-D-2
SURVEY BPD
DESIGN IB
DRAWN IB
CHECKED

ASPIRE ESTATE
STAGE 8

MUNICIPALITY MELTON
REFERENCE 8226 E/8

SCALE AS SHOWN | DATUM AHD | DATE FEB'14 | SHEET 13 OF 15 | C

I:\8226\ENG\STG8\E8_RD13_DRN2.dgn
Plotted:10/09/2014