

CIVIL GEOTECHNICAL SERVICES ABN 26 474 013 724 PO Box 678 Croydon Vic 3136 Telephone: 9723 0744 Facsimile: 9723 0799

26th August 2022

Our Reference: 22197:NB1268

Winslow Constructors Pty Ltd 50 Barry Road CAMPBELLFIELD VIC 3061

Dear Sirs/Madams,

RE: LEVEL 1 EARTHWORKS INSPECTION AND TESTING ASPIRE – STAGE 29 (PLUMPTON)

Please find attached our Report No's 22197/R001 and 22197/R002 which relate to the field density testing that was conducted within the filled allotments at the above subdivision. The level 1 inspections and associated field density testing was performed in August 2022.

The inspections and testing of the earthworks was undertaken in general accordance with the Level 1 requirements of AS 3798 - Guidelines on Earthworks for Commercial and Residential Developments.

The site inspection and testing was performed by experienced geotechnicians from this office. Any areas that were deemed unsatisfactory were reworked and retested under their supervision. The testing was performed to the relevant Australian Standards and the accompanying test reports carry NATA endorsement. The attached compaction results, which were located randomly throughout the fill profile, are considered to be representative of the bulk fill materials that were placed across the reported allotments by Winslow Constructors during the aforementioned period. The approximate locations of the field density tests can be seen on the attached plan (Figure 1).


We are of the view that the bulk fill materials that have been placed across the reported allotments by Winslow Constructors during the aforementioned period can be considered as having been placed in a controlled manner to a minimum density ratio of 95% (standard compactive effort).

Please contact the undersigned if you require any additional information.

Civil Geotechnical Services

Nick Brock

FIGURE 1

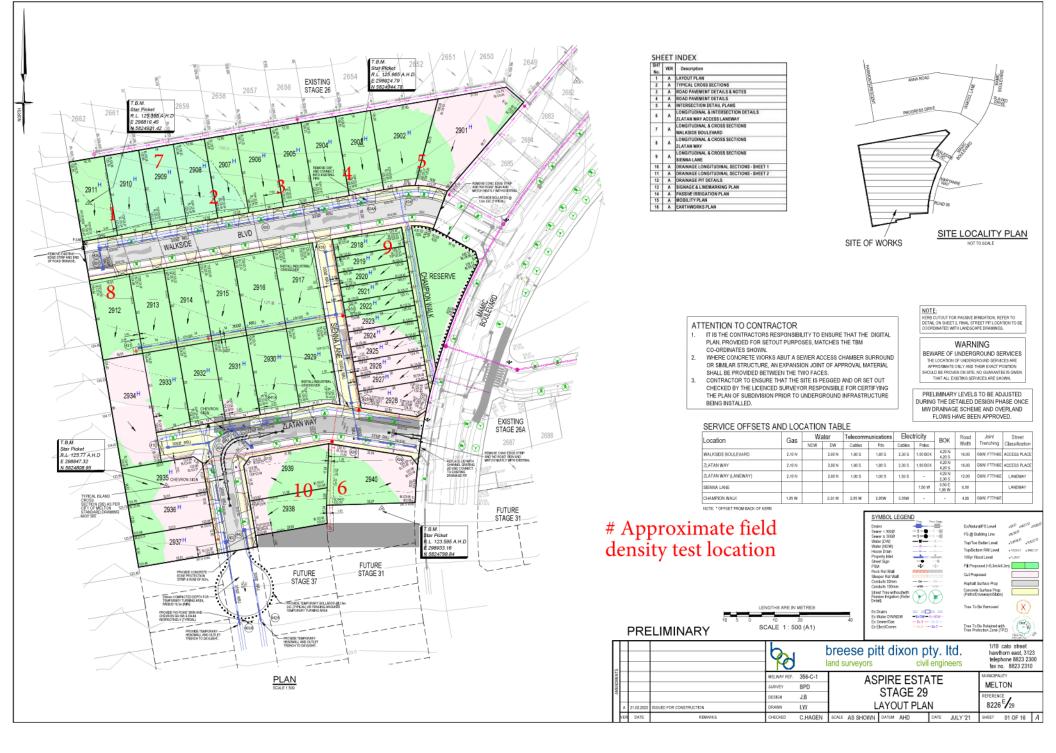



COMPACTION ASSESSMENT

CIVIL GEOTEO	WINSLOW CONSTRUCTORS PTY LTD (CAMPBELLFIELD) Tested by AM ASPIRE - STAGE 29 Date tested 22/08/22		
6 - 8 Rose Aveni	6 - 8 Rose Avenue, Croydon 3136		26/08/2022
Client	WINSLOW CONSTRUCTORS PTY LTD (CAMPBELLFIELD)	Tested by	AM
Project	ASPIRE - STAGE 29	Date tested	22/08/22
Location	PLUMPTON	Checked by	JHF

Feature

EARTHWORKS

Layer thickness

200 mm

Time: 14:22

Test procedure AS 1289.2.1.1 & 5.8.1

Test No		1	2	3	4	5	6
Location							
		REFER	REFER	REFER	REFER	REFER	REFER
		то	то	то	то	то	то
		FIGURE 1	FIGURE 1	FIGURE 1	FIGURE 1	FIGURE 1	FIGURE
Approximate depth below FSL							
Measurement depth	mm	175	175	175	175	175	175
Field wet density	t∕m³	1.96	1.96	1.93	1.94	1.94	1.92
Field moisture content	%	26.9	27.3	28.0	28.6	31.3	29.3
Test No		1	2	3 Star	4 dard	5	6
Compactive effort	Standard						
Oversize rock retained on sieve	mm	19.0	19.0	19.0	19.0	19.0	19.0
Percent of oversize material	wet	0	0	0	0	0	0
Peak Converted Wet Density	t/m³	1.97	1.97	1.97	1.93	1.97	1.95
Adjusted Peak Converted Wet Density	t/m³	-	-	-	-	-	-
Optimum Moisture Content	%	27.0	28.0	28.0	29.5	31.5	29.5
Moisture Variation From		0.0%	0.5%	0.0%	1.0%	0.0%	0.0%
Optimum Moisture Content			dry		dry		
density and moisture ratio results	relate o	only to the so	il to the dept	h of test and	not to the ful	depth of the	layer
		99.0	99.0	98.0	100.5	98.0	98.5

Material description

No 1 - 6 Clay Fill



NATA Accredited Laboratory No 9909 Accredited for compliance with ISO/IEC 17025 - Testing AVRLOT HILF V1.10 MAR 13



COMPACTION ASSESSMENT

CIVIL GEOTE	CHNICAL SERVICES	Job No Report No	22197 22197/R002
6 - 8 Rose Avenı	ie, Croydon 3136	Date Issued	26/08/2022
Client	WINSLOW CONSTRUCTORS PTY LTD (CAMPBELLFIELD)	Tested by	AM
Project	ASPIRE - STAGE 29	Date tested	23/08/22
Location	PLUMPTON	Checked by	JHF

 Feature
 EARTHWORKS
 Layer thickness
 200 mm
 Time: 14:31

Test procedure AS 1289.2.1.1 & 5.8.1

Test No	- I	7	8	9	10	-	-	
Location		REFER TO FIGURE 1	REFER TO FIGURE 1	REFER TO FIGURE 1	REFER TO FIGURE 1			
Approximate depth below FSL		'	'	'	├ ────′	 '		
Measurement depth	тт	175	175	175	175	-	-	
Field wet density	t∕m³	1.93	1.91	1.91	1.94	-	-	
Field moisture content	%	26.1	26.0	27.3	27.1	-	-	
Test procedure AS 1289.5.7.1 Test No Compactive effort		7	8	9 Stan	10 ndard	-	-	
•	'	Standard						
Oversize rock retained on sieve	mm	19.0	19.0	19.0	19.0	-		
Percent of oversize material	wet t/m³	0 1.96	0 1.93	0	0 1.96	-	-	
Peak Converted Wet Density Adjusted Peak Converted Wet Density	t/m³ t/m³	1.90	1.93	1.92	1.90	-	-	
Optimum Moisture Content	<i>v</i> 11* %	29.0	27.0	27.0	27.5	-		
Moisture Variation From Optimum Moisture Content		2.5% dry	1.0% dry	0.0%	0.5% dry	-	-	
density and moisture ratio results r		-	-			depth of the	; layer	
Density Ratio (R _{HD})	%	99.0	99.0	99.0	99.0	- '	-	

Material description

No 7 - 10 Clay Fill



NATA Accredited Laboratory No 9909 Accredited for compliance with ISO/IEC 17025 - Testing

AVRLOT HILF V1.10 MAR 13

Approved Signatory : Justin Fry