



CIVIL GEOTECHNICAL SERVICES
ABN 26 474 013 724
PO Box 678 Croydon Vic 3136
Telephone: 9723 0744 Facsimile: 9723 0799

10th June 2022

Our Reference: 22127:NB1275

Winslow Constructors Pty Ltd
50 Barry Road
CAMPBELLFIELD VIC 3061

Dear Sirs/Madams,

RE: LEVEL 1 EARTHWORKS INSPECTION AND TESTING
DELARAY – STAGE 19B (CLYDE NORTH)

Please find attached our Report No 22127/R001 which relates to the field density testing that was conducted within the filled allotments at the above subdivision. The level 1 inspections and associated field density testing was performed in March 2022.

The inspections and testing of the earthworks was undertaken in general accordance with the Level 1 requirements of AS 3798 - Guidelines on Earthworks for Commercial and Residential Developments.

The site inspection and testing was performed by experienced geotechnicians from this office. Any areas that were deemed unsatisfactory were reworked and retested under their supervision. The testing was performed to the relevant Australian Standards and the accompanying test reports carry NATA endorsement. The attached compaction results, which were located randomly throughout the fill profile, are considered to be representative of the bulk fill materials that were placed across the reported allotments by Winslow Constructors during the aforementioned period. The approximate locations of the field density tests can be seen on the attached plan (Figure 1).


We are of the view that the bulk fill materials that have been placed across the reported allotments by Winslow Constructors during the aforementioned period can be considered as having been placed in a controlled manner to a minimum density ratio of 95% (standard compactive effort).

Please contact the undersigned if you require any additional information.

Civil Geotechnical Services

Nick Brock

FIGURE 1

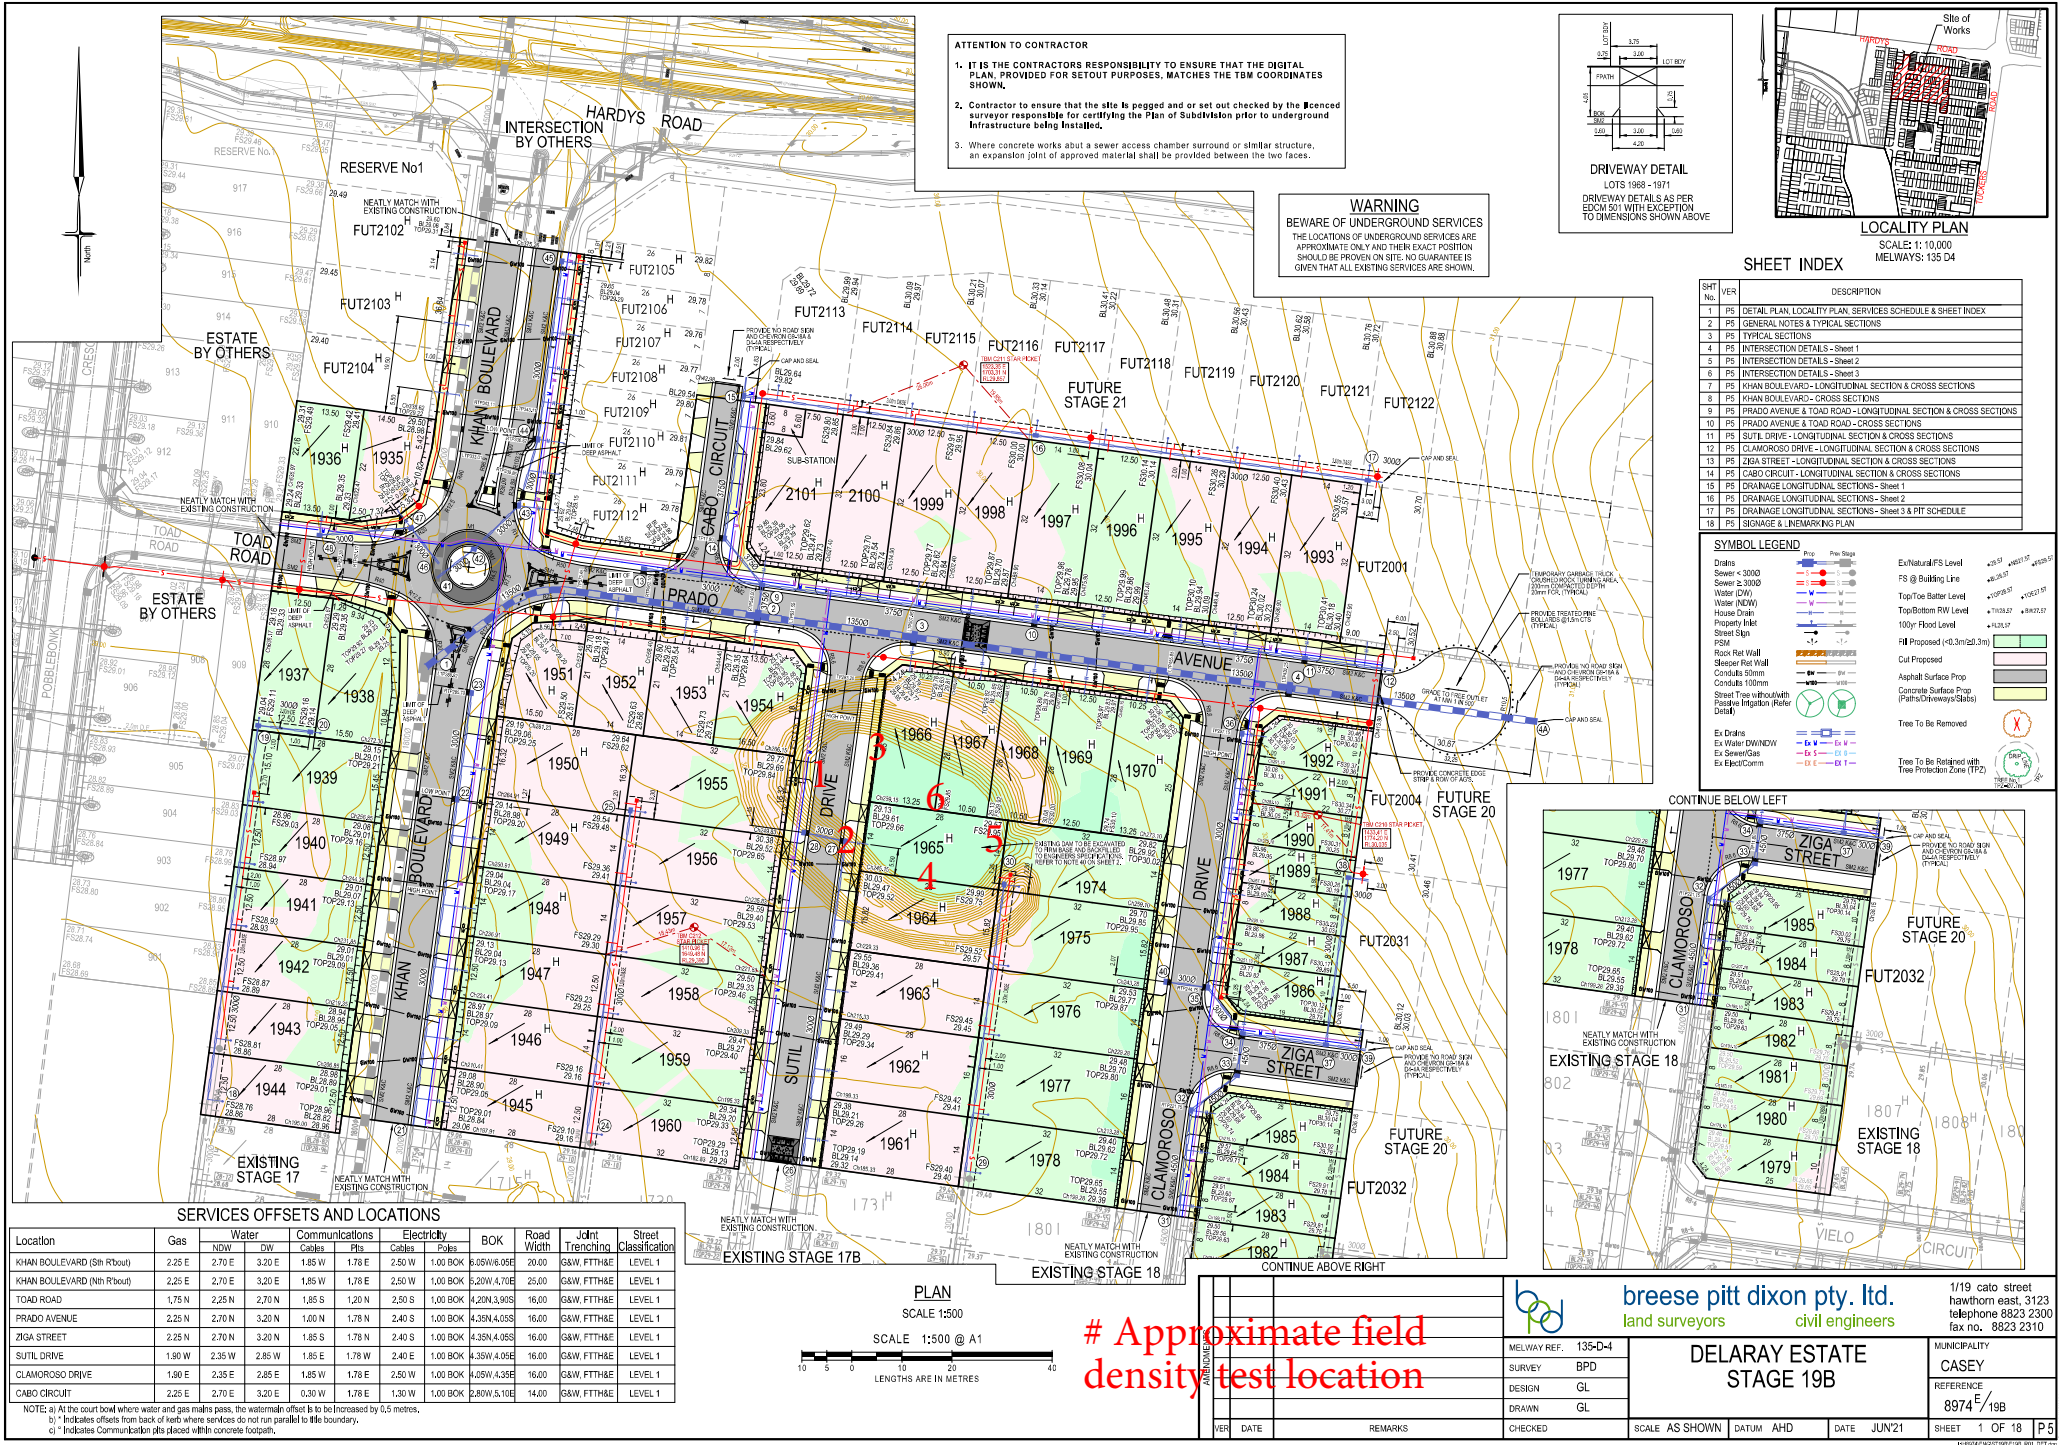

Approximate field density test location



COMPACTION ASSESSMENT

CIVIL GEOTECHNICAL SERVICES

6 - 8 Rose Avenue, Croydon 3136

Job No 22127
Report No 22127/R001
Date Issued 20/04/2022

Client	WINSLOW CONSTRUCTORS PTY LTD (CAMPBELLFIELD)	Tested by	SB
Project	DELARAY - STAGE 19B	Date tested	28/03/22
Location	CLYDE NORTH	Checked by	JHF

Feature	DAM BACKFILL	Layer thickness	200 mm	Time: 12:00
---------	--------------	-----------------	--------	-------------

Test procedure AS 1289.2.1.1 & 5.8.1

Test No	1	2	3	4	5	6
Location	REFER TO FIGURE 1	REFER TO FIGURE 1	REFER TO FIGURE 1	REFER TO FIGURE 1	REFER TO FIGURE 1	REFER TO FIGURE 1
Approximate depth below FSL	0.8	0.6	0.4	0.2	fsl	fsl
Measurement depth	175	175	175	175	175	175
Field wet density	1.93	1.94	1.94	1.95	1.97	1.93
Field moisture content	23.3	24.3	23.1	24.1	21.9	22.7

Test procedure AS 1289.5.7.1

Test No	1	2	3	4	5	6
Compactive effort	Standard					
Oversize rock retained on sieve	19.0	19.0	19.0	19.0	19.0	19.0
Percent of oversize material	0	0	0	0	0	0
Peak Converted Wet Density	1.97	1.97	1.98	1.98	1.99	1.97
Adjusted Peak Converted Wet Density	-	-	-	-	-	-
Optimum Moisture Content	24.0	24.5	24.0	24.5	22.5	23.5

Moisture Variation From Optimum Moisture Content	0.5% dry	0.5% dry	1.0% dry	0.5% dry	0.5% dry	1.0% dry
--	----------	----------	----------	----------	----------	----------

density and moisture ratio results relate only to the soil to the depth of test and not to the full depth of the layer

Density Ratio (R_{HD})	98.0	98.5	98.0	98.5	99.5	98.0
----------------------------	------	------	------	------	------	------

Material description

No 1 - 6 Clay Fill

AVRLOT HILF V1.10 MAR 13



NATA Accredited Laboratory No 9909
Accredited for compliance with
ISO/IEC 17025 - Testing

Approved Signatory : Justin Fry