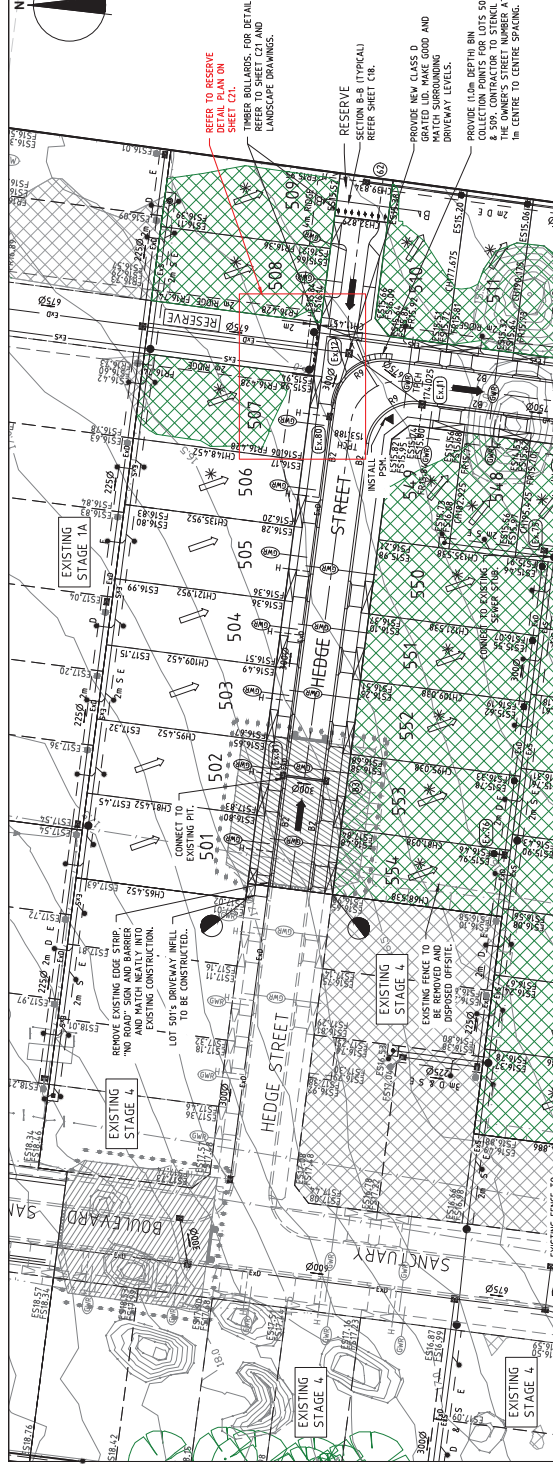
[illegible]