



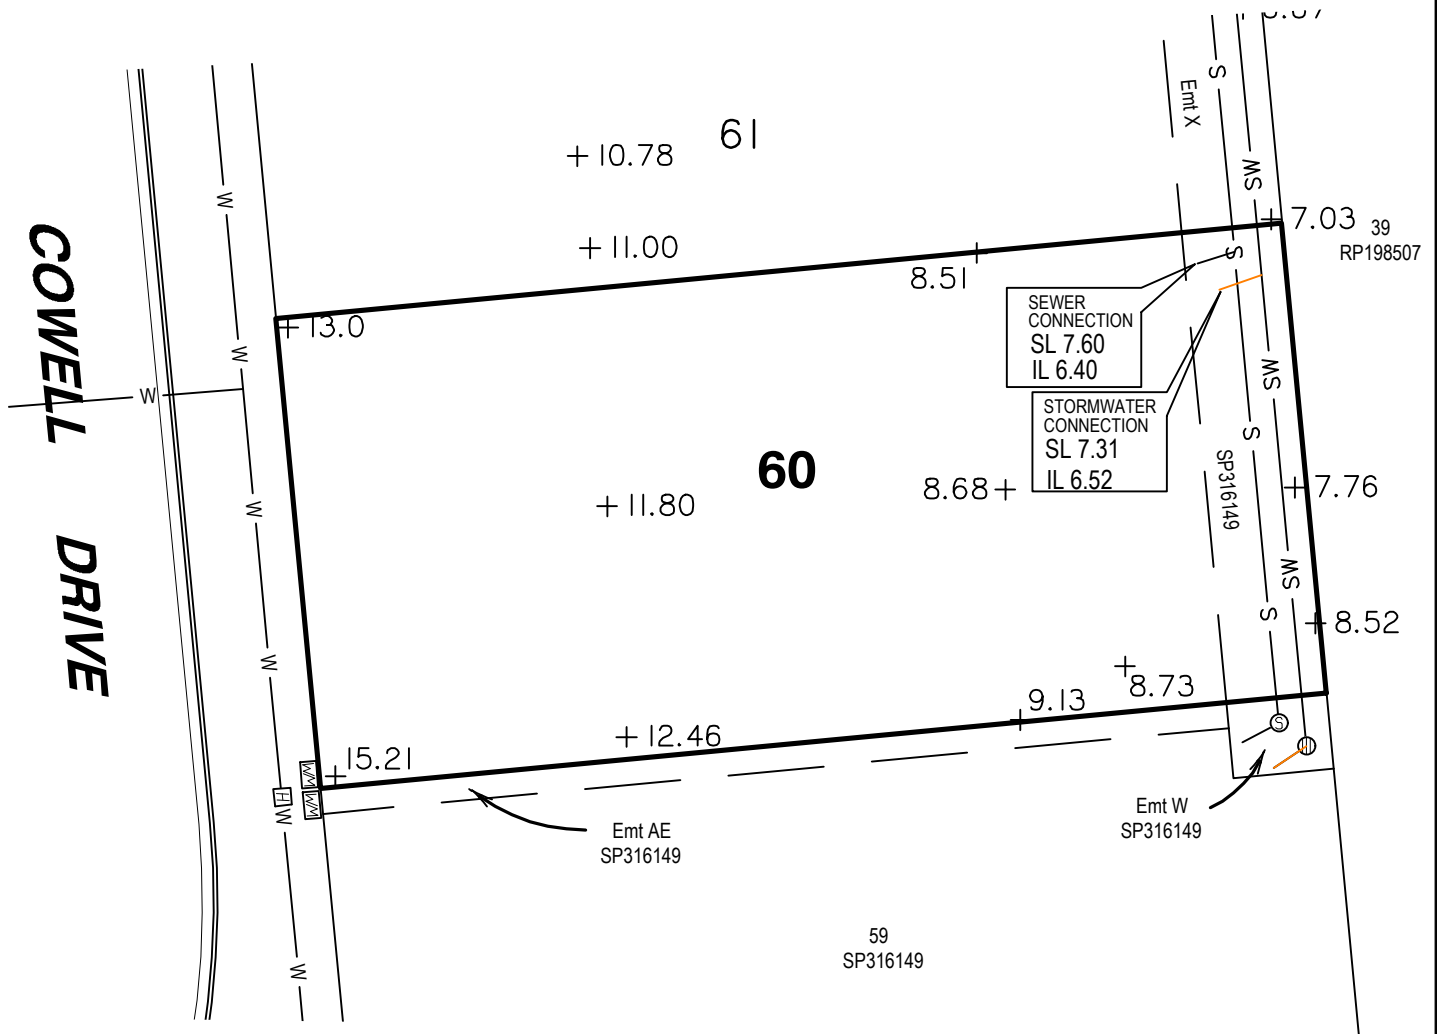

LEGEND

- SEWER MANHOLE
- STORMWATER MANHOLE/ MAINTENANCE SHAFT
- GULLY TRAP
- FIELD INLET
- WATER METER
- FIRE HYDRANT
- STORMWATER SWALE
- WATER PIPE
- SEWER
- SURFACE LEVEL
- INVERT LEVEL
- SURFACE LEVEL
- DRIVEWAY / FOOTPATH
- KERB & CHANNEL
- ROOFWATER DRAINAGE PIPE
- ROOFWATER KERB ADAPTOR
- ROOFWATER KERB ADAPTOR WITH CONNECTION TO LOT

Scale 1:300 - Lengths are in Metres.

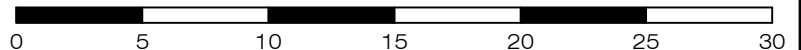

gassman
development
perspectives

planning | environment | landscape | engineering | survey

T: 3807 3333 | F: 3287 5461 | www.gassman.com.au

Gold Coast & Logan | 76 Business Street, Yatala QLD | PO Box 392, Beenleigh 4207

Client

Burleigh Heads Estate Pty Ltd

Project **SERVICE LOCATION SKETCH PLAN**

LOT 60 on SP329478

Stage 3, The Arbour Burleigh
Cowell Drive, Burleigh Heads

Real Property Description:

Lot 60 on SP329478

Locality **BURLEIGH HEADS**

Local Govt **GOLD COAST CITY COUNCIL**

Scale (on A4 original)

1:300

Issue Date **06/04/2023**

Meridian **SP329478**

Level Datum **AHD**

Drawn **S. Holt**

Date Drafted **06/04/2023**


Checked **A.Geraghty**

REFERENCE No. **5967-3**

PLAN No. **5967 S SK LOT 60**




COWELL DRIVE

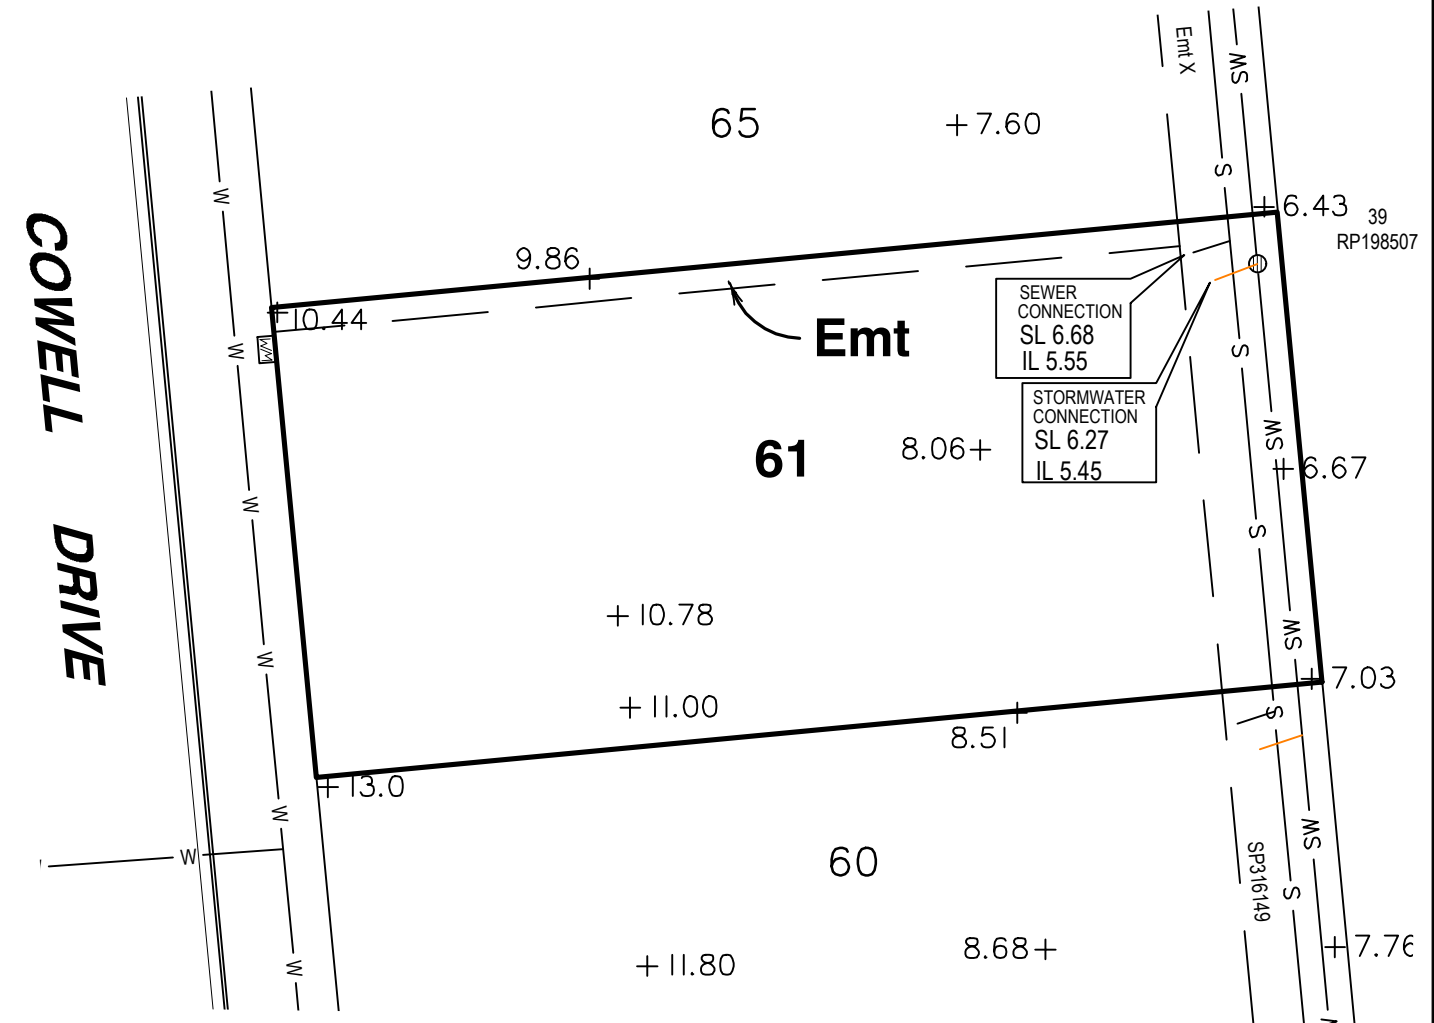

LEGEND

- SEWER MANHOLE
- STORMWATER MANHOLE/ MAINTENANCE SHAFT
- GULLY TRAP
- FIELD INLET
- WATER METER
- FIRE HYDRANT
- STORMWATER
- STORMWATER SWALE
- WATER PIPE
- SEWER
- + 3.44 SURFACE LEVEL
- IL INVERT LEVEL
- SL SURFACE LEVEL
- DRIVEWAY / FOOTPATH
- KERB & CHANNEL
- ROOFWATER DRAINAGE PIPE
- ROOFWATER KERB ADAPTOR
- ROOFWATER KERB ADAPTOR WITH CONNECTION TO LOT

Scale 1:300 - Lengths are in Metres.

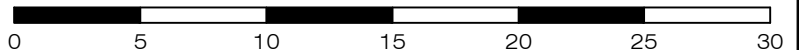

gassman
development
perspectives

planning | environment | landscape | engineering | survey

T: 3807 3333 | F: 3287 5461 | www.gassman.com.au

Gold Coast & Logan | 76 Business Street, Yatala QLD | PO Box 392, Beenleigh 4207

Client

Burleigh Heads Estate Pty Ltd

Project **SERVICE LOCATION SKETCH PLAN**

LOT 61 on SP329478

Stage 3, The Arbour Burleigh
Cowell Drive, Burleigh Heads

Real Property Description:

Lot 61 on SP329478

Locality **BURLEIGH HEADS**

Local Govt **GOLD COAST CITY COUNCIL**

Scale (on A4 original)

1:300

Issue Date **06/04/2023**

Meridian **SP329478**

Level Datum **AHD**


Drawn **S. Holt**

Date Drafted **06/04/2023**

Checked **A.Geraghty**

REFERENCE No. **5967-3**


PLAN No. **5967 S SK LOT 61**

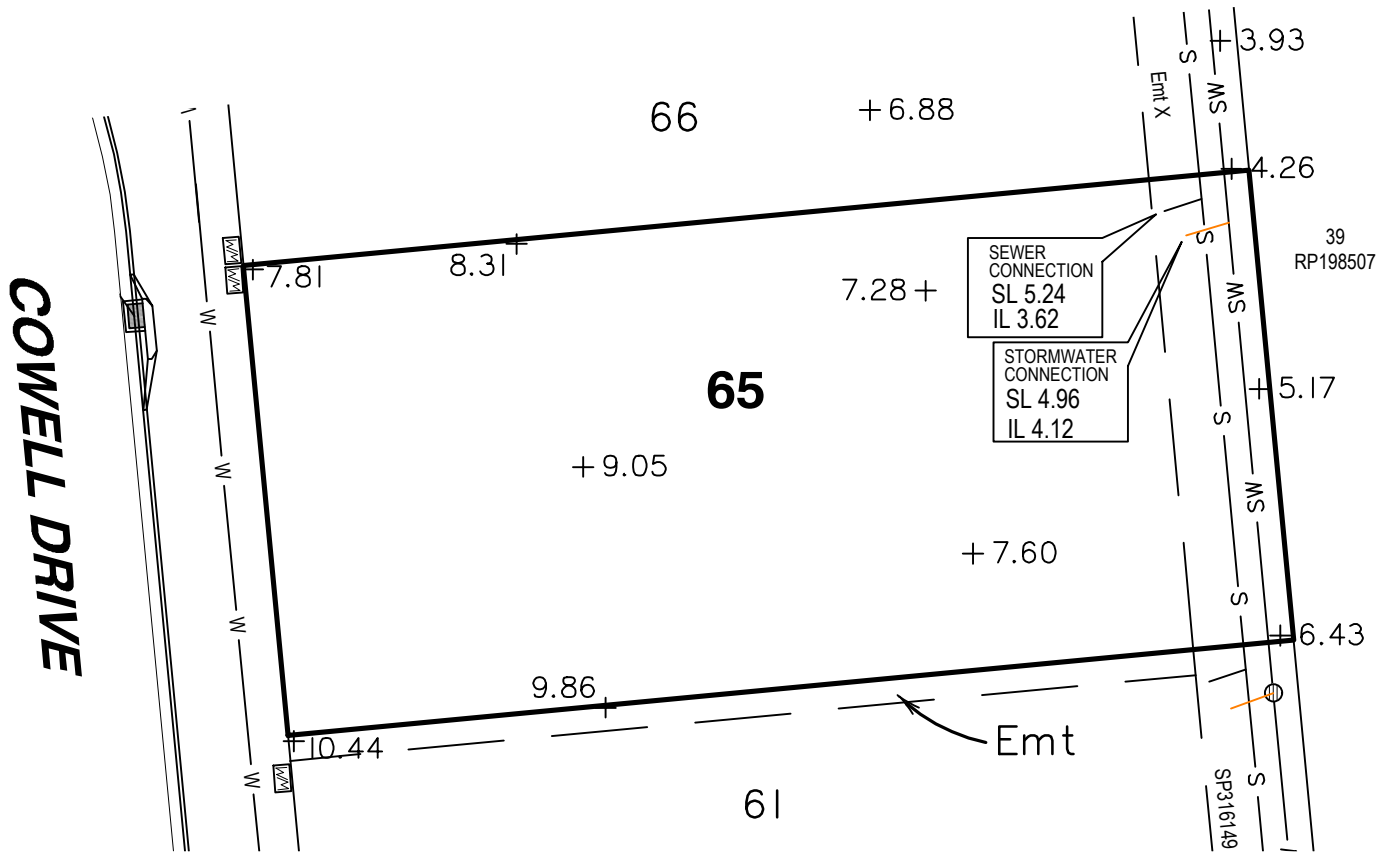

LEGEND

- SEWER MANHOLE
- STORMWATER MANHOLE/
MAINTENANCE SHAFT
- GULLY TRAP
- FIELD INLET
- WATER METER
- FIRE HYDRANT
- STORMWATER
STORMWATER SWALE
- WATER PIPE
- SEWER
- + 3.44 SURFACE LEVEL
- IL INVERT LEVEL
- SL SURFACE LEVEL
- DRIVEWAY / FOOTPATH
- KERB & CHANNEL
- ROOFWATER DRAINAGE PIPE
- ROOFWATER KERB ADAPTOR
- ROOFWATER KERB ADAPTOR
WITH CONNECTION TO LOT

Scale 1:300 - Lengths are in Metres.

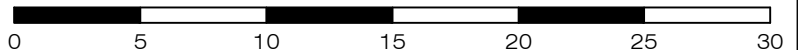

gassman
development
perspectives

planning | environment | landscape | engineering | survey

T: 3807 3333 | F: 3287 5461 | www.gassman.com.au

Gold Coast & Logan | 76 Business Street, Yatala QLD | PO Box 392, Beenleigh 4207

Client

Burleigh Heads Estate Pty Ltd

Project **SERVICE LOCATION SKETCH PLAN**

LOT 65 on SP329478

Stage 3, The Arbour Burleigh
Cowell Drive, Burleigh Heads

Real Property Description:

Lot 65 on SP329478

Locality **BURLEIGH HEADS**

Local Govt **GOLD COAST
CITY COUNCIL**

Scale (on A4 original)

1:300

Issue Date **06/04/2023**

Meridian **SP329478**

Level Datum **AHD**

Drawn **S. Holt**

Date Drafted **06/04/2023**


Checked **A. Geraghty**

REFERENCE No. **5967-3**

PLAN No. **5967 S SK LOT 65**




COWELL DRIVE

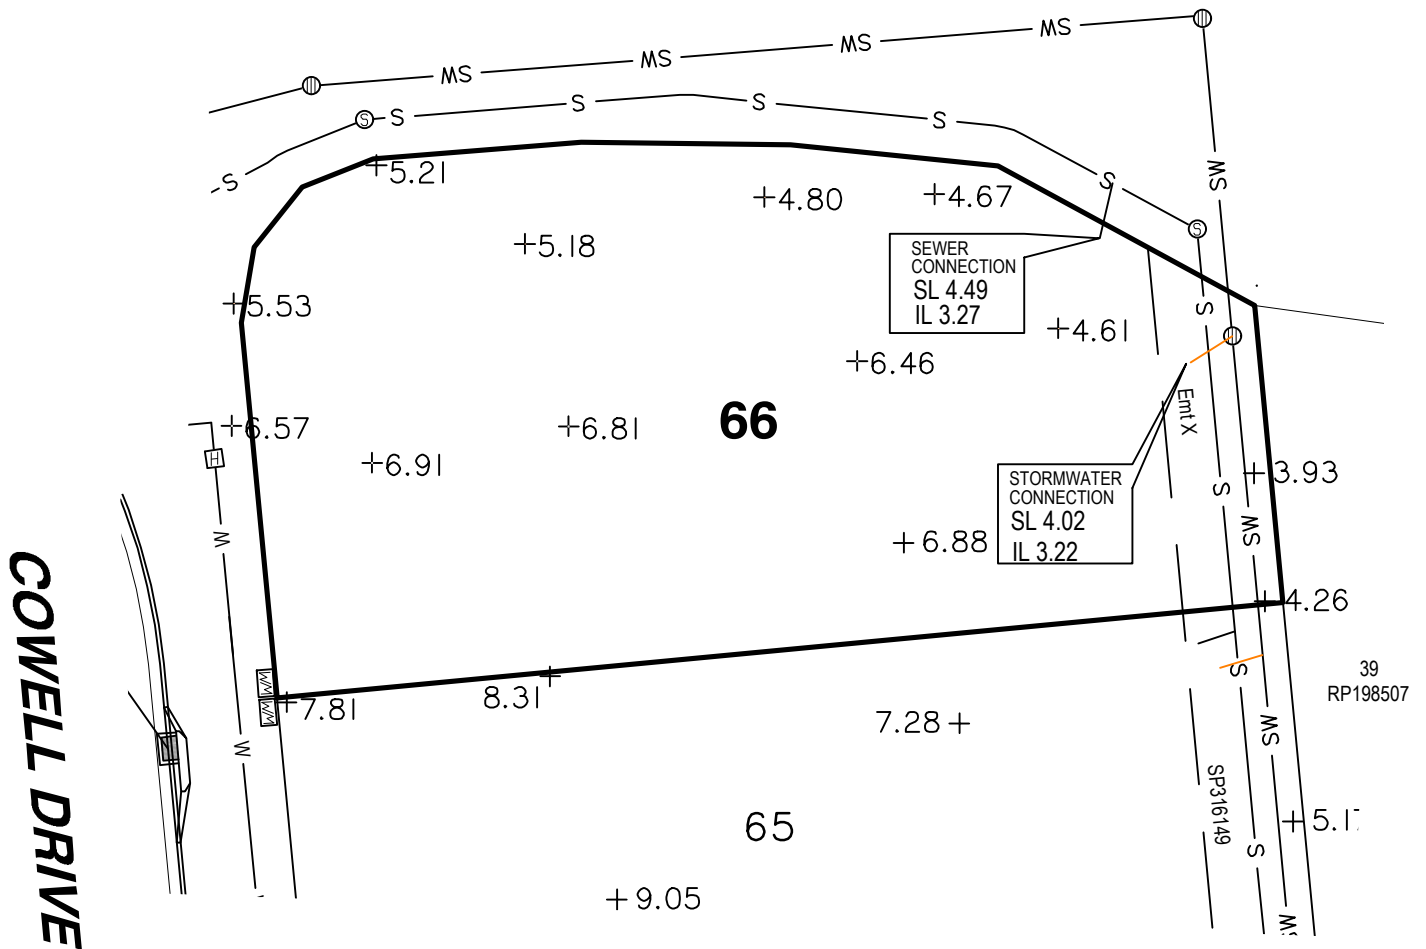

LEGEND

- SEWER MANHOLE
- STORMWATER MANHOLE/ MAINTENANCE SHAFT
- GULLY TRAP
- FIELD INLET
- WATER METER
- FIRE HYDRANT
- STORMWATER SWALE
- WATER PIPE
- SEWER
- + 3.44 SURFACE LEVEL
- IL INVERT LEVEL
- SL SURFACE LEVEL
- DRIVEWAY / FOOTPATH
- KERB & CHANNEL
- ROOFWATER DRAINAGE PIPE
- ROOFWATER KERB ADAPTOR
- ROOFWATER KERB ADAPTOR WITH CONNECTION TO LOT

Scale 1:300 - Lengths are in Metres.

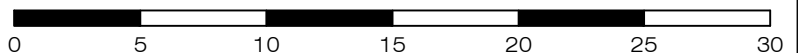

gassman
development
perspectives

planning | environment | landscape | engineering | survey

T: 3807 3333 | F: 3287 5461 | www.gassman.com.au

Gold Coast & Logan | 76 Business Street, Yatala QLD | PO Box 392, Beenleigh 4207

Client

Burleigh Heads Estate Pty Ltd

Project

SERVICE LOCATION SKETCH PLAN

LOT 66 on SP329478

Stage 3, The Arbour Burleigh
Cowell Drive, Burleigh Heads

Real Property Description:

Lot 66 on SP329478

Locality BURLEIGH HEADS

Local Govt GOLD COAST
CITY COUNCIL

Scale (on A4 original)

1:300

Issue Date 06/04/2023

Meridian SP329478

Level Datum AHD

Drawn S. Holt

Date Drafted 06/04/2023

Checked A. Geraghty

REFERENCE No. **5967-3**

PLAN No. **5967 S SK LOT 66**