





'TREENET' INLET AS PER MANUFACTURERS SPECIFICATION. TO BE PLACED ON THE HIGH SIDE OF THE TREE (INSTALLED BY CIVIL CONTRACTOR). CAP END FOR FUTURE CONNECTION BY LANDSCAPING CONTRACTOR.

600 B2 KERB (INSTALLED BY CIVIL CONTRACTOR)

MINIMUM 1200 AS DETERMINED BY THE LANDSCAPE ARCHITECT

1500 - FOOTPATH

LOT BOUNDARY

50

REFER TO LANDSCAPE ARCHITECT'S DRAWINGS FOR TREE PASSIVE IRRIGATION DETAILS. (TO BE INSTALLED BY LANDSCAPE CONTRACTOR)

**PASSIVE IRRIGATION INLET SECTION**  
SCALE - 1:20

'TREENET' INLET AS PER MANUFACTURERS SPECIFICATION. TO BE PLACED IN THE HIGH SIDE OF THE TREE PIT. (INSTALLED BY CIVIL CONTRACTOR). CAP END FOR FUTURE CONNECTION BY LANDSCAPING CONTRACTOR.

FOOTPATH

MINIMUM 1200 AS DETERMINED BY THE LANDSCAPE ARCHITECT

REFER TO LANDSCAPE ARCHITECT'S DRAWINGS FOR TREE LOCATION AND TREE PASSIVE IRRIGATION DETAILS. (TO BE INSTALLED BY LANDSCAPE CONTRACTOR)


**TREE PIT SECTION**

600 B2 KERB (INSTALLED BY CIVIL CONTRACTOR)


**PASSIVE IRRIGATION INLET DETAIL**  
SCALE - 1:20

NOTE:  
LOCATION OF "TREENET" INLET TO BE COORDINATED WITH FINAL COUNCIL ENDORSED LANDSCAPE ARCHITECTS DRAWINGS.


STREET TREE PASSIVE IRRIGATION DETAILED TO BE APPROVED SEPARATELY. ROAD PAVEMENTS MUST

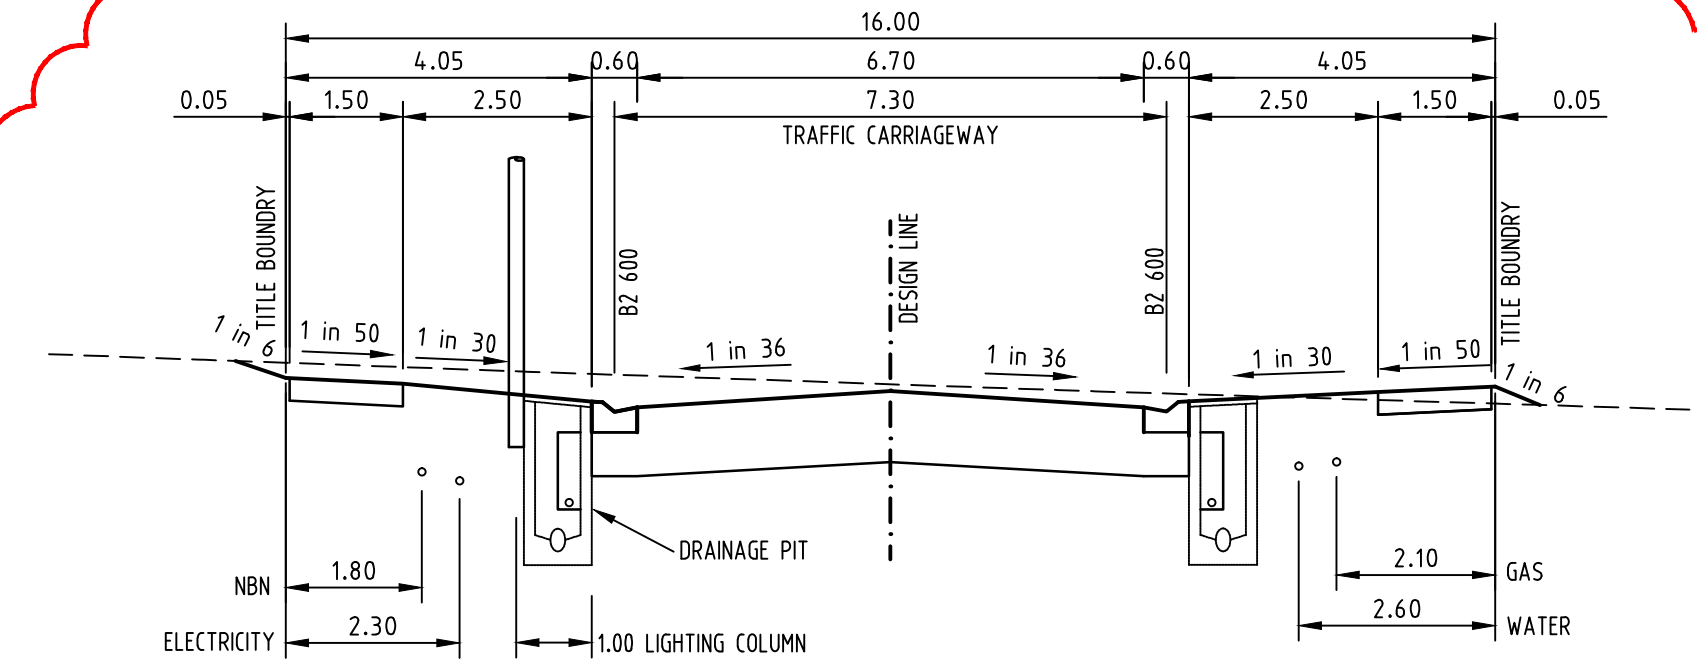


**ANNA ROAD & PROGRESS DRIVE (WEST OF FAIRMONT CRESCENT)**  
**16.0m ROAD RESERVE**

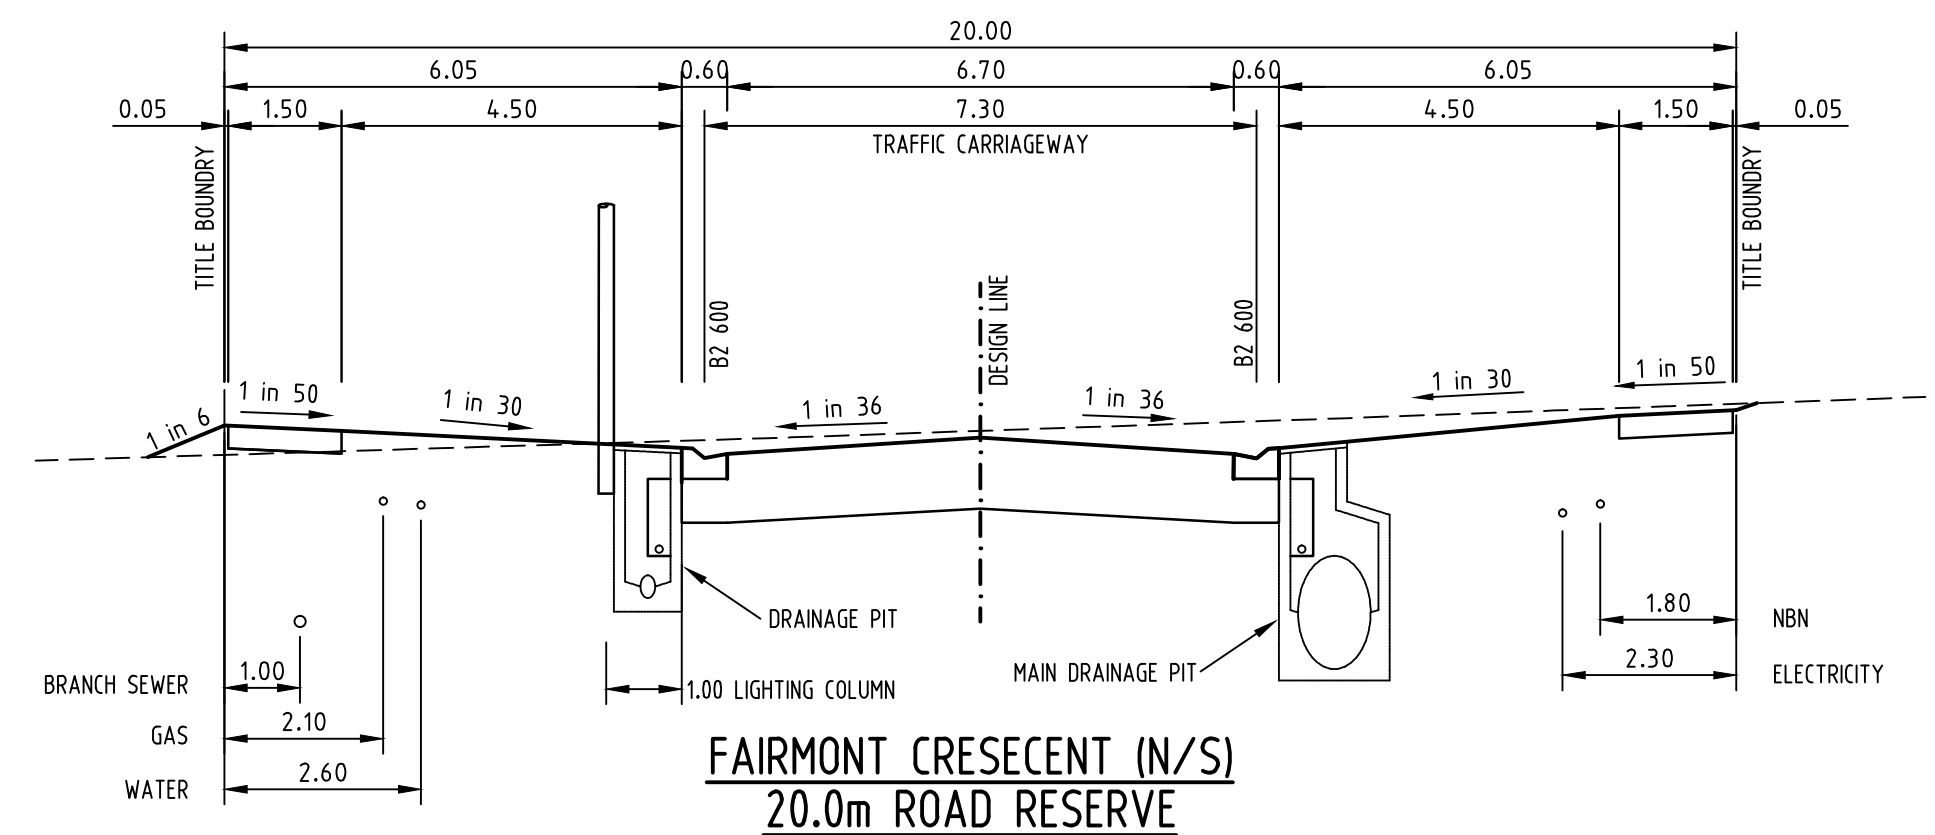


**FAIRMONT CRESCENT (N/S)**  
**20.0m ROAD RESERVE**

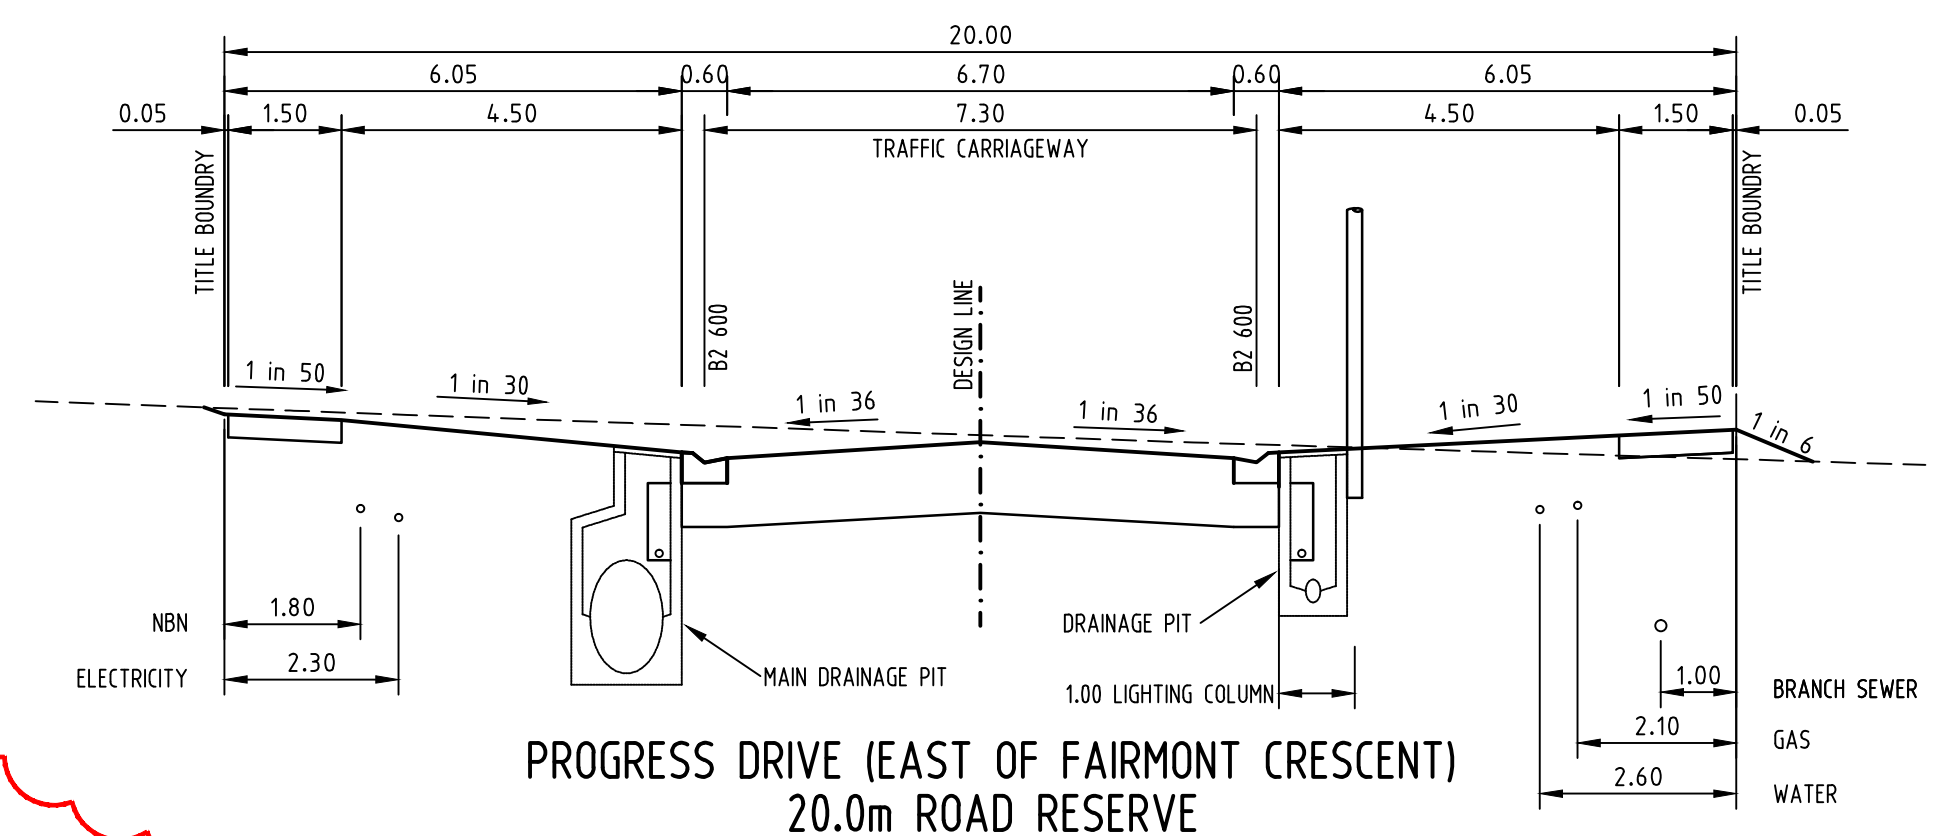


**PROGRESS DRIVE (EAST OF FAIRMONT CRESCENT)**  
**20.0m ROAD RESERVE**

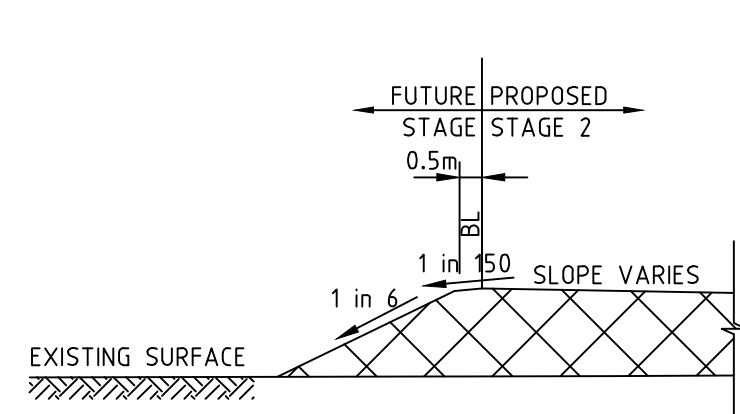

**TYPICAL SECTION**  
**WHEN IN FILL ON BOUNDARY**  
**OF FUTURE STAGE**  
NOT TO SCALE

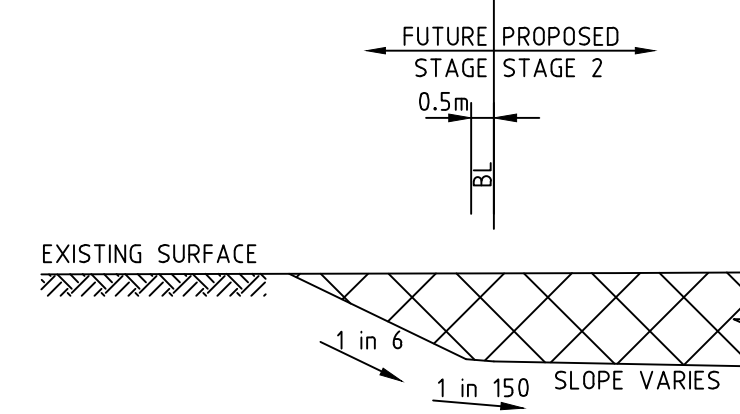

**TYPICAL SECTION**  
**WHEN IN CUT ON BOUNDARY**  
**OF FUTURE STAGE**  
NOT TO SCALE

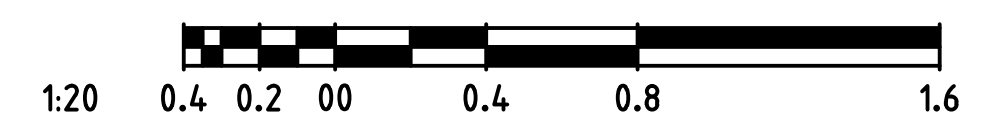


AMENDMENTS					breese pitt dixon pty. ltd.		1/19 cato street hawthorn east, 3123 telephone 8823 2300 fax no. 8823 2310	
				MELWAY REF.	354 C12	ASPIRE ESTATE STAGE 26 TYPICAL SECTIONS & DETAILS		MUNICIPALITY MELTON
				SURVEY	BPD			REFERENCE 8226 E/26
				DESIGN	JGB			
				DRAWN	MSJ	SCALE AS SHOWN		DATE OCT '19
VER	DATE	REMARKS	CHECKED	TBA				SHEET 2 OF 4
						DATUM AHD		P4






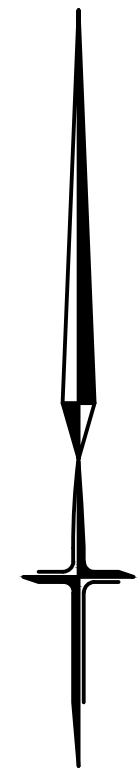
PLAN  
SCALE 1:500

  
APPROVED  
FUNCTIONAL LAYOUT PLANS  
Inoka S  
ENGINEERING SERVICES  
Date: 17/02/2020

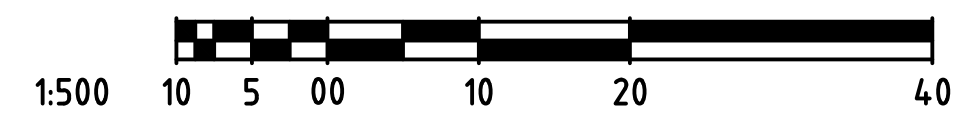


AMENDMENTS					breese pitt dixon pty. ltd. land surveyors civil engineers			1/19 cato street hawthorn east, 3123 telephone 8823 2300 fax no. 8823 2310					
				MELWAY REF.	354 C12	ASPIRE ESTATE STAGE 26 PARKING PLAN			MUNICIPALITY MELTON				
			SURVEY	BPD	REFERENCE 8226 E/26								
			DESIGN	JGB									
			DRAWN	MSJ									
VER.	DATE	REMARKS	CHECKED	TBA	SCALE	AS SHOWN	DATUM	AHD	DATE	OCT '19	SHEET	3 OF 4	P4







REFER RIGHT

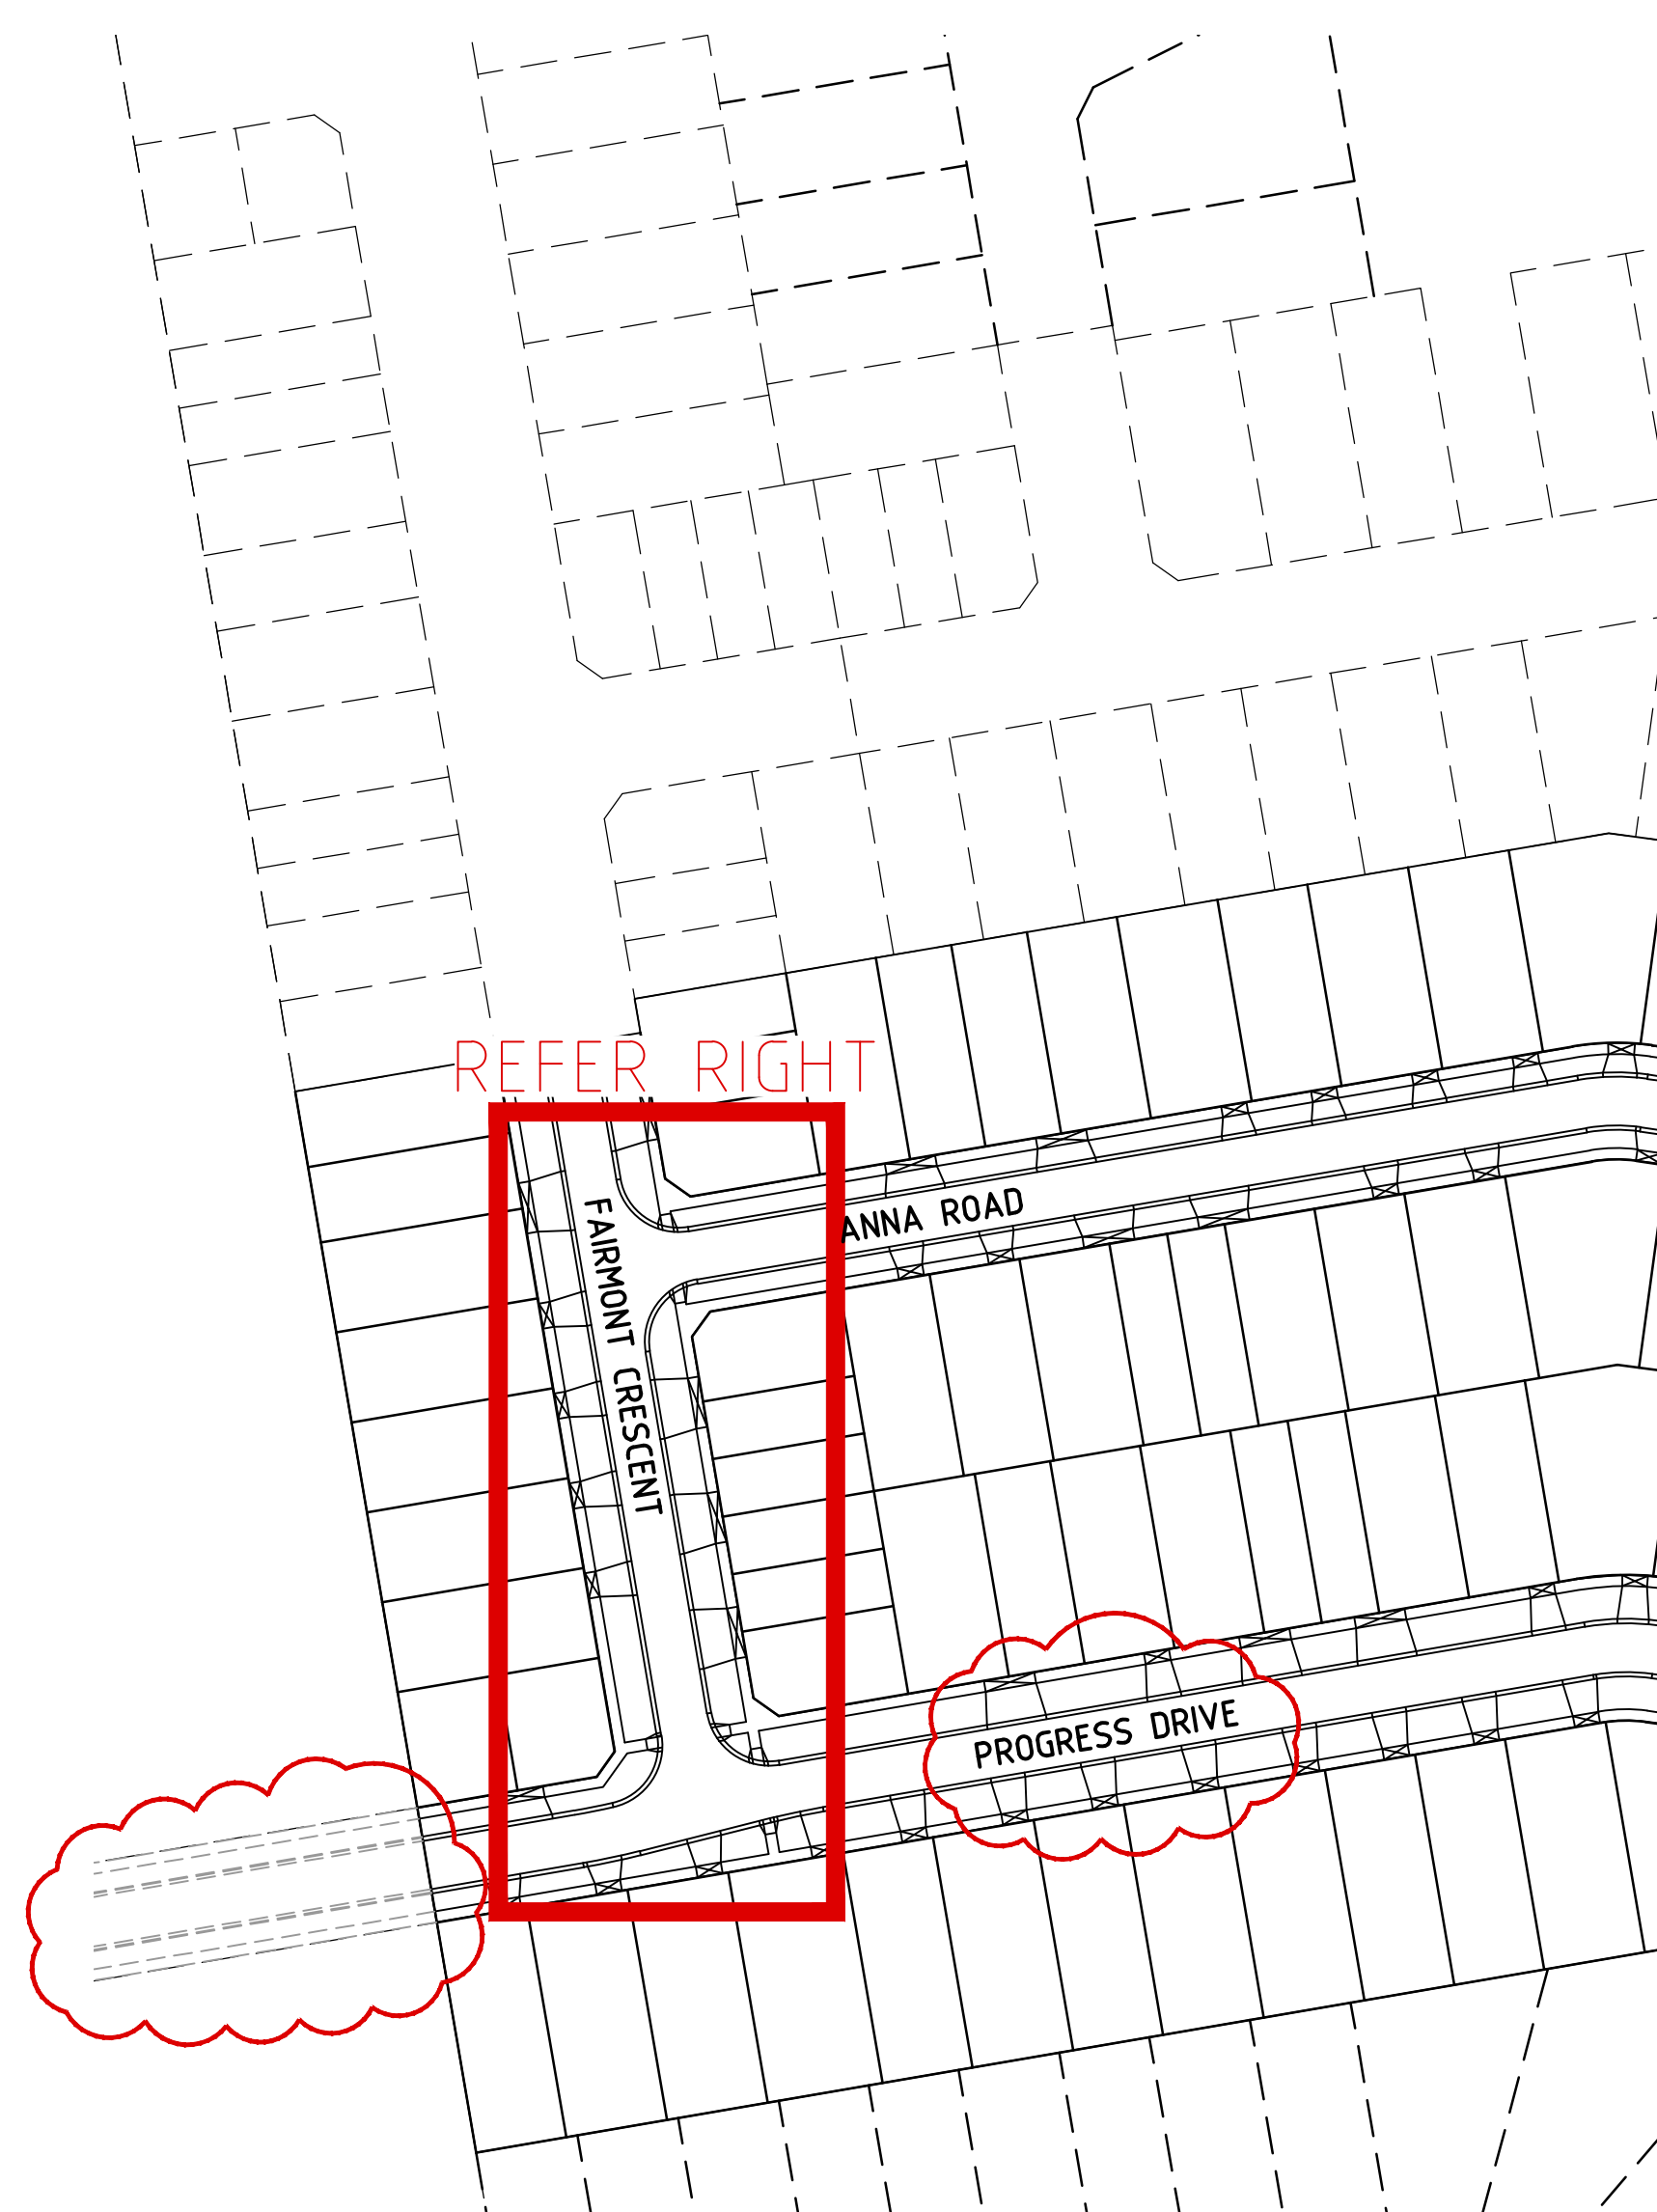



LOCALITY PLAN  
SCALE - 1:1000

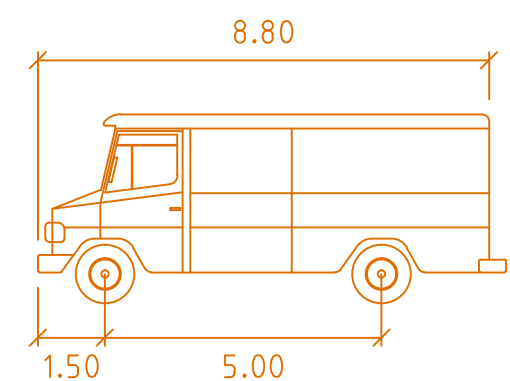


SERVICE VEHICLE meters  
Width : 2.50  
Track : 2.50  
Lock to Lock Time : 6.00  
Steering Angle : 38.70

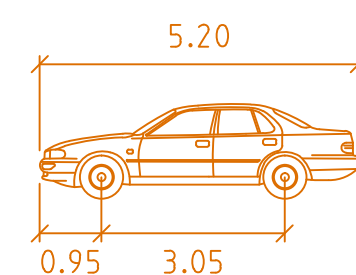

CAR meters  
Width : 1.94  
Track : 1.84  
Lock to Lock Time : 6.0  
Steering Angle : 33.5

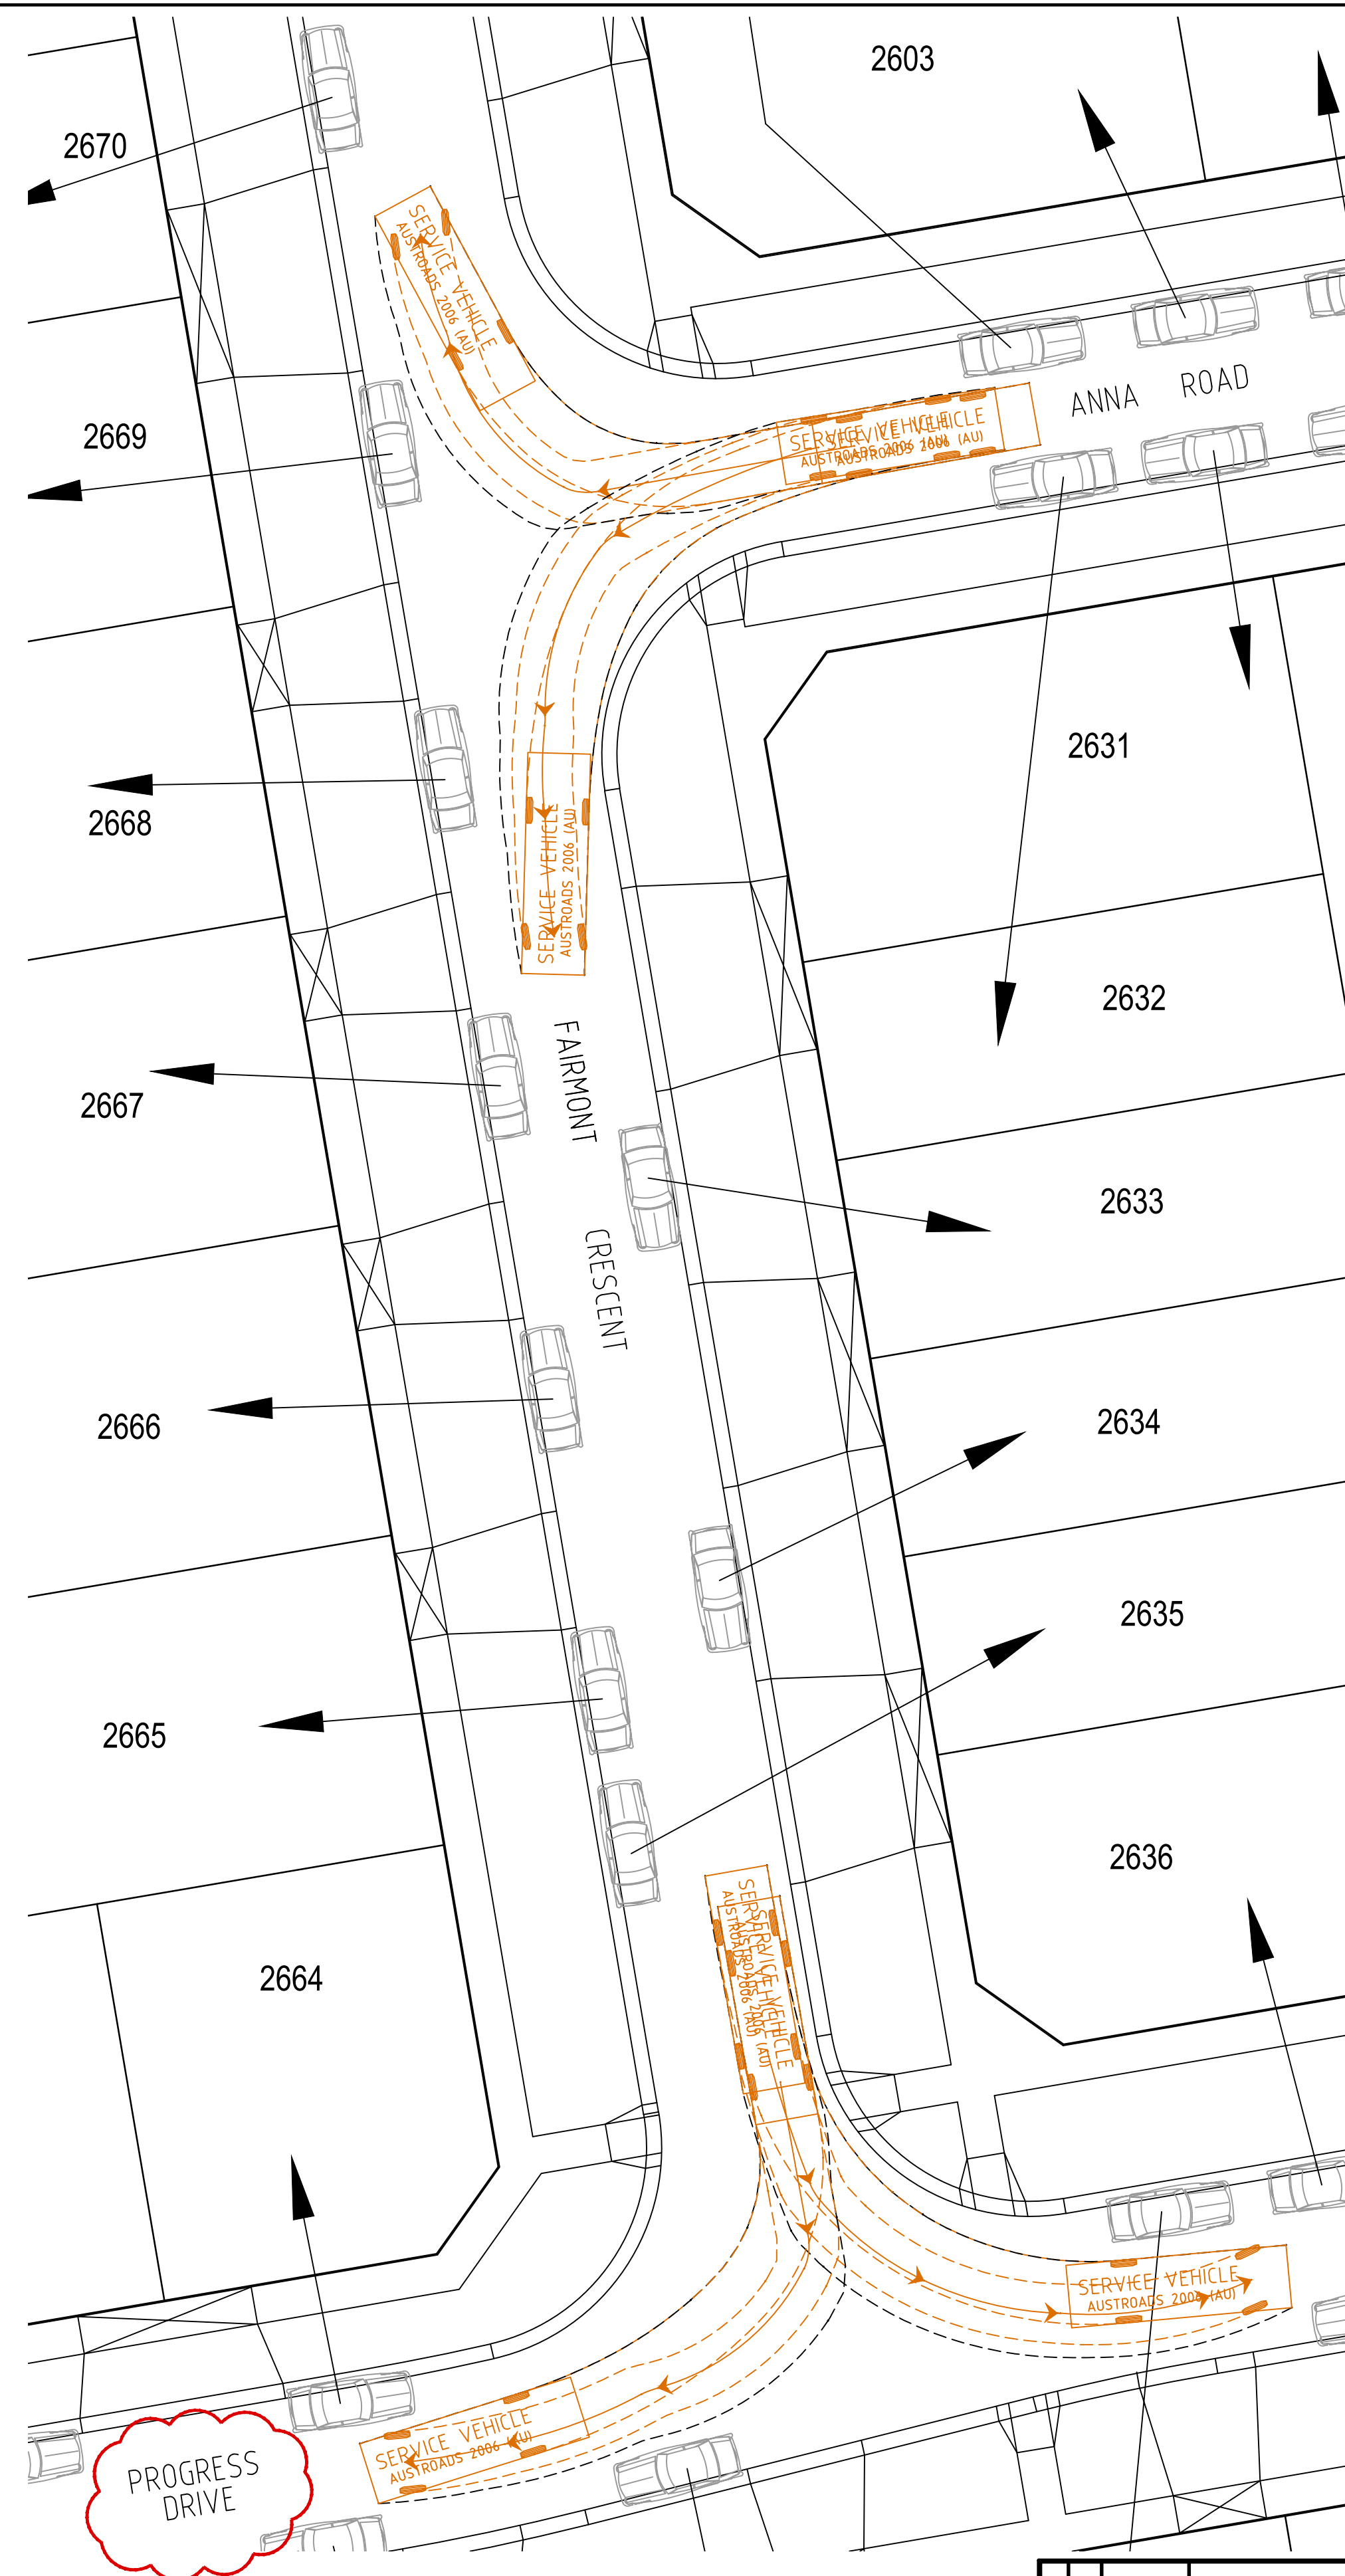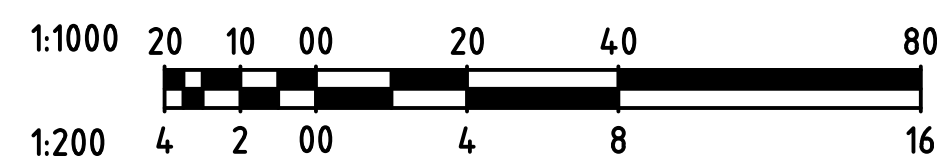

TURNING MOVEMENTS  
SCALE 1:200

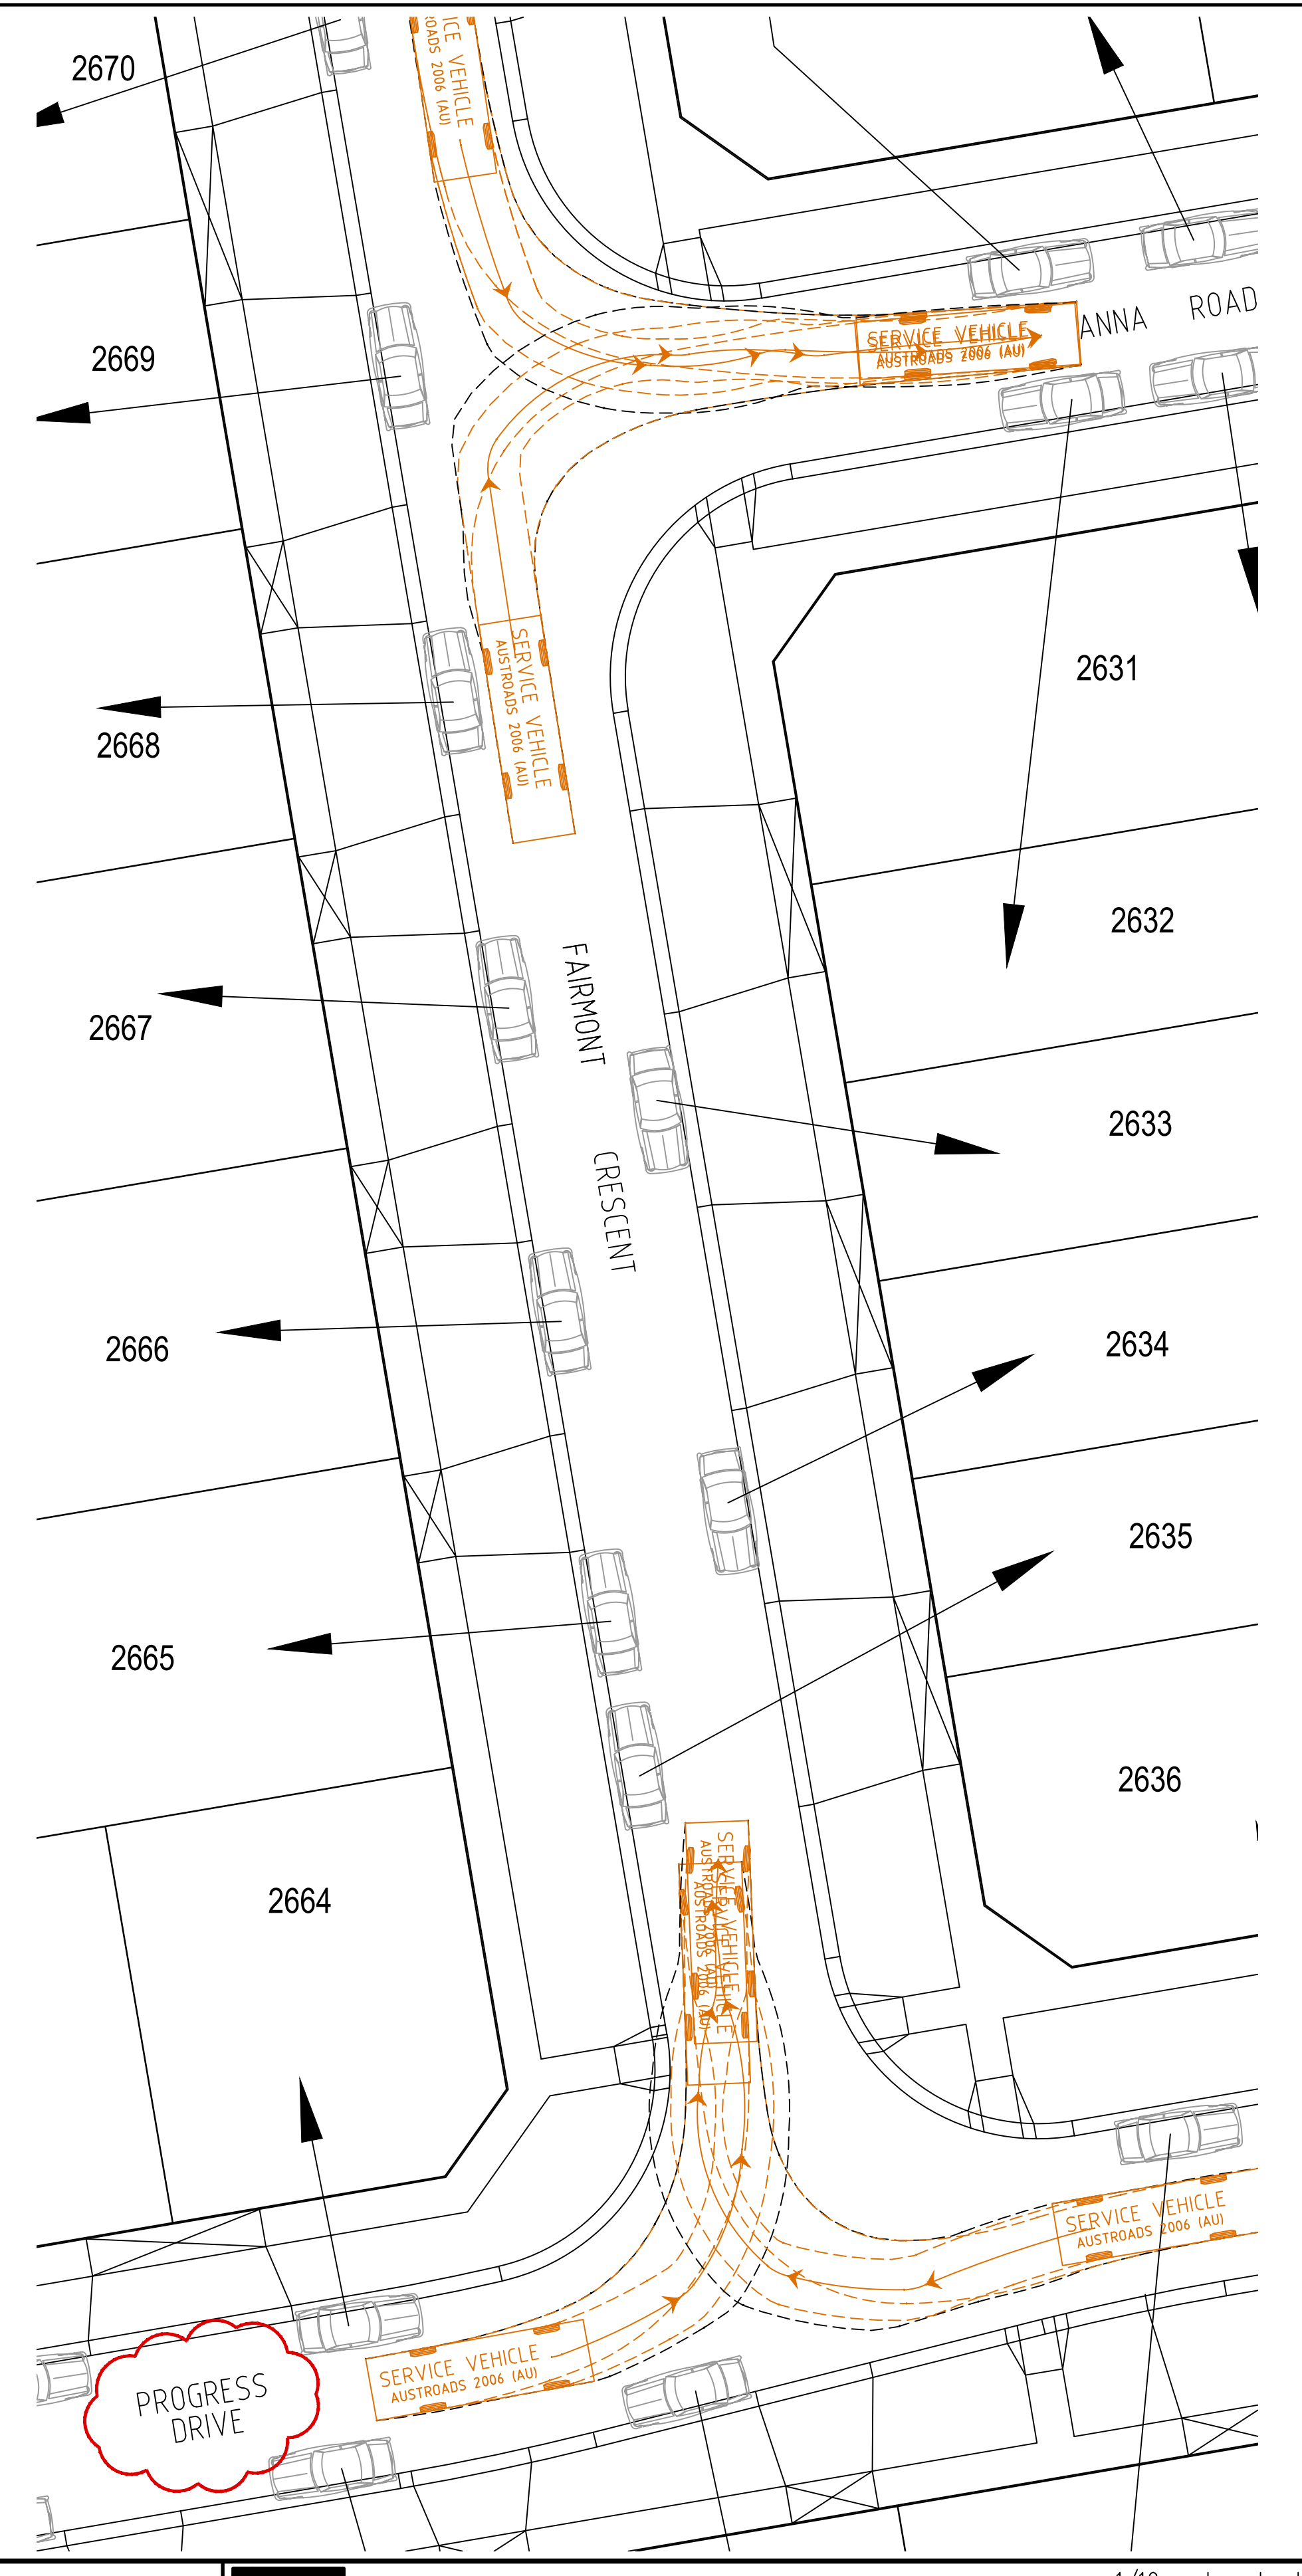

--	--	