



CIVIL GEOTECHNICAL SERVICES
ABN 26 474 013 724
PO Box 678 Croydon Vic 3136
Telephone: 9723 0744 Facsimile: 9723 0799

13th April 2022

Our Reference: 22141:NB1209

Winslow Constructors Pty Ltd
50 Barry Road
CAMPBELLFIELD VIC 3061

Dear Sirs/Madams,

RE: LEVEL 1 EARTHWORKS INSPECTION AND TESTING
REDSTONE – STAGE 5A (SUNBURY)

Please find attached our Report No's 22141/R001 and 22141/R002 which relate to the field density testing that was conducted within the filled allotments at the above subdivision. The level 1 inspections and associated field density testing was performed in April 2022.

The inspections and testing of the earthworks was undertaken in general accordance with the Level 1 requirements of AS 3798 - Guidelines on Earthworks for Commercial and Residential Developments.

The site inspection and testing was performed by experienced geotechnicians from this office. Any areas that were deemed unsatisfactory were reworked and retested under their supervision. The testing was performed to the relevant Australian Standards and the accompanying test reports carry NATA endorsement. The attached compaction results, which were located randomly throughout the fill profile, are considered to be representative of the bulk fill materials that were placed across the reported allotments by Winslow Constructors during the aforementioned period. The approximate locations of the field density tests can be seen on the attached plan (Figure 1).


We are of the view that the bulk fill materials that have been placed across the reported allotments by Winslow Constructors during the aforementioned period can be considered as having been placed in a controlled manner to a minimum density ratio of 95% (standard compactive effort).

Please contact the undersigned if you require any additional information.

Civil Geotechnical Services


Nick Brock

FIGURE 1

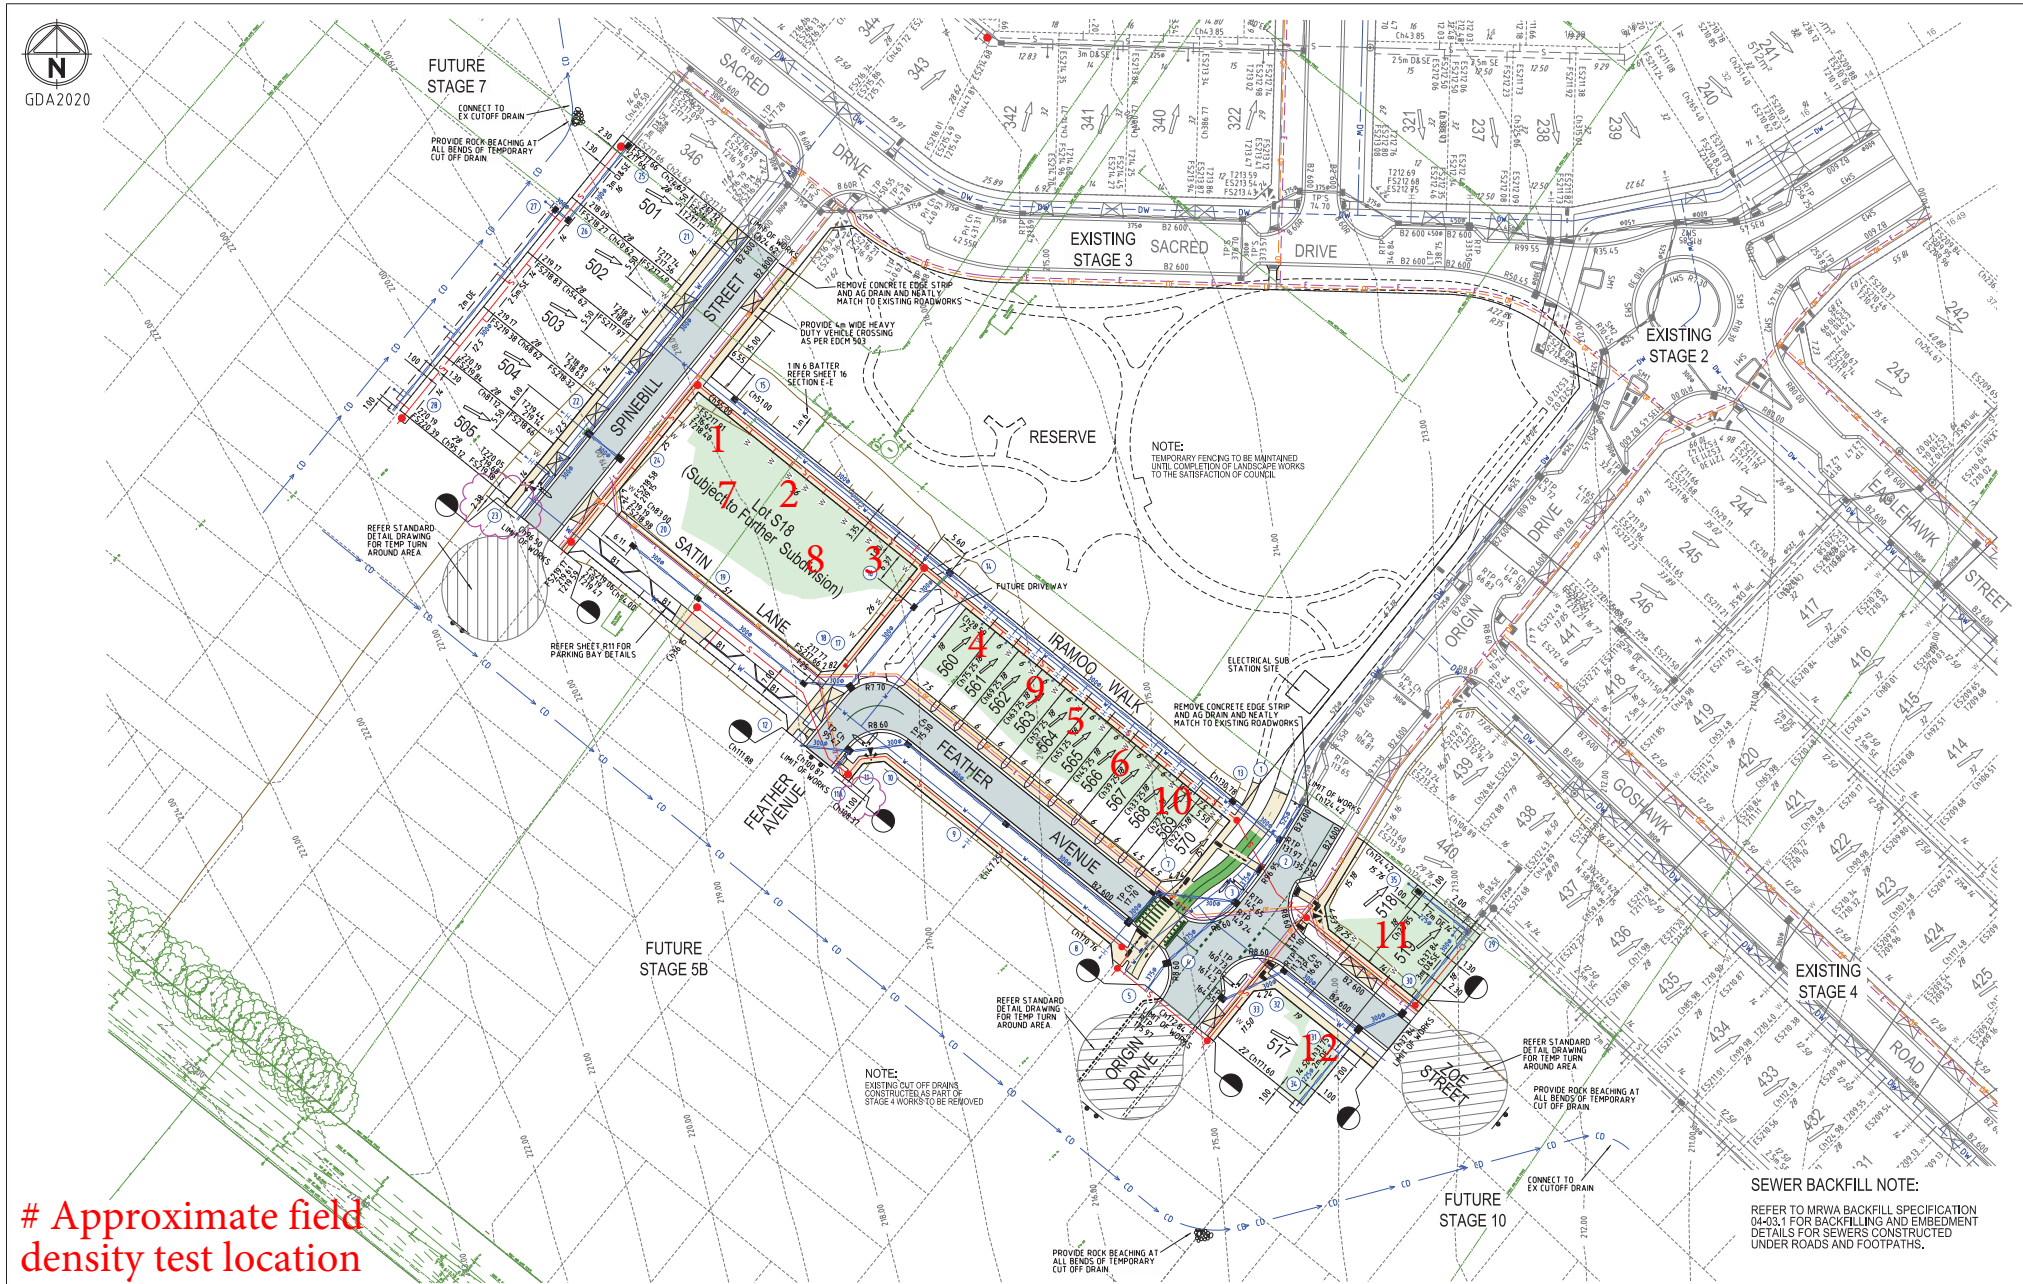

Approximate field density test location

| Rev | Amendments | Approved | Date |
|-----|-------------------------------------|----------|----------|
| 1 | ENDPIES 11A AND 23 DIMENSIONS ADDED | M.T.S | 12/01/22 |
| 0 | CONSTRUCTION ISSUE | M.T.S | 12/01/22 |

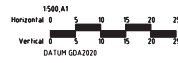

© Spiire Australia Pty Ltd All Rights Reserved
 This document is provided by Spiire Australia Pty Ltd solely for the benefit of and use by the client in accordance with the terms of the contract. Spiire Australia Pty Ltd does not and shall not assume any responsibility or liability whatsoever to any third party relying on or any use of or reference to this plan on the content of this document.

spiire.com.au ABN 55 050 029 635

Villawood Communities Designed for Living
 Designed: R. WENBER
 Authorised: M. TOOMER-SMITH

Redstone.
 Your world awaits
 Checked: D. CAMERON
 Date: 21/05/21

REDSTONE ESTATE
STAGE 5A
ROAD & DRAINAGE FACE PLAN
 VILLAWOOD PROPERTIES
 HUME CITY COUNCIL
CONSTRUCTION Dwg No **305916R02** Rev **1**



COMPACTION ASSESSMENT

CIVIL GEOTECHNICAL SERVICES

6 - 8 Rose Avenue, Croydon 3136

Job No 22141
Report No 22141/R001
Date Issued 13/04/2022

| | | | |
|----------|----------------------------------------------|-------------|----------|
| Client | WINSLOW CONSTRUCTORS PTY LTD (CAMPBELLFIELD) | Tested by | AM |
| Project | REDSTONE ESTATE - STAGE 5A | Date tested | 06/04/22 |
| Location | SUNBURY | Checked by | JHF |

| | | | | |
|---------|------------|-----------------|--------|-------------|
| Feature | EARTHWORKS | Layer thickness | 200 mm | Time: 09:26 |
|---------|------------|-----------------|--------|-------------|

Test procedure AS 1289.2.1.1 & 5.8.1

| Test No | 1 | 2 | 3 | 4 | 5 | 6 |
|------------------------------------|-------------------|-------------------|-------------------|-------------------|-------------------|-------------------|
| Location | REFER TO FIGURE 1 | REFER TO FIGURE 1 | REFER TO FIGURE 1 | REFER TO FIGURE 1 | REFER TO FIGURE 1 | REFER TO FIGURE 1 |
| Approximate depth below FSL | | | | | | |
| Measurement depth mm | 175 | 175 | 175 | 175 | 175 | 175 |
| Field wet density t/m ³ | 1.98 | 1.98 | 1.96 | 1.97 | 1.98 | 1.97 |
| Field moisture content % | 21.1 | 27.0 | 20.5 | 21.9 | 25.5 | 27.3 |

Test procedure AS 1289.5.7.1

| Test No | 1 | 2 | 3 | 4 | 5 | 6 |
|------------------------------------------------------|----------|------|------|------|------|------|
| Compactive effort | Standard | | | | | |
| Oversize rock retained on sieve mm | 19.0 | 19.0 | 19.0 | 19.0 | 19.0 | 19.0 |
| Percent of oversize material wet | 0 | 0 | 0 | 0 | 0 | 0 |
| Peak Converted Wet Density t/m ³ | 2.03 | 2.00 | 2.02 | 2.00 | 2.03 | 2.07 |
| Adjusted Peak Converted Wet Density t/m ³ | - | - | - | - | - | - |
| Optimum Moisture Content % | 23.5 | 30.0 | 23.0 | 24.5 | 28.0 | 28.5 |

| | | | | | | |
|--------------------------------------------------|----------|----------|----------|----------|----------|----------|
| Moisture Variation From Optimum Moisture Content | 2.5% dry | 2.5% dry | 2.5% dry | 2.5% dry | 2.5% dry | 1.0% dry |
|--------------------------------------------------|----------|----------|----------|----------|----------|----------|

density and moisture ratio results relate only to the soil to the depth of test and not to the full depth of the layer

| | | | | | | | |
|----------------------------|---|------|------|------|------|------|------|
| Density Ratio (R_{HD}) | % | 97.5 | 99.0 | 97.0 | 98.5 | 97.5 | 95.0 |
|----------------------------|---|------|------|------|------|------|------|

Material description

No 1 - 6 Clay Fill

AVRLOT HILF V1.10 MAR 13



NATA Accredited Laboratory No 9909
Accredited for compliance with
ISO/IEC 17025 - Testing

Approved Signatory : Justin Fry



COMPACTION ASSESSMENT

CIVIL GEOTECHNICAL SERVICES

6 - 8 Rose Avenue, Croydon 3136

Job No 22141
Report No 22141/R002
Date Issued 13/04/2022

| | | | |
|----------|----------------------------------------------|-------------|----------|
| Client | WINSLOW CONSTRUCTORS PTY LTD (CAMPBELLFIELD) | Tested by | AM |
| Project | REDSTONE ESTATE - STAGE 5A | Date tested | 07/04/22 |
| Location | SUNBURY | Checked by | JHF |

| | | | | |
|---------|------------|-----------------|--------|-------------|
| Feature | EARTHWORKS | Layer thickness | 200 mm | Time: 16:30 |
|---------|------------|-----------------|--------|-------------|

Test procedure AS 1289.2.1.1 & 5.8.1

| Test No | 7 | 8 | 9 | 10 | 11 | 12 |
|------------------------------------|-------------------|-------------------|-------------------|-------------------|-------------------|-------------------|
| Location | REFER TO FIGURE 1 | REFER TO FIGURE 1 | REFER TO FIGURE 1 | REFER TO FIGURE 1 | REFER TO FIGURE 1 | REFER TO FIGURE 1 |
| Approximate depth below FSL | | | | | | |
| Measurement depth mm | 175 | 175 | 175 | 175 | 175 | 175 |
| Field wet density t/m ³ | 1.78 | 1.77 | 1.78 | 1.78 | 1.71 | 1.73 |
| Field moisture content % | 17.7 | 19.8 | 19.4 | 24.0 | 17.0 | 19.8 |

Test procedure AS 1289.5.7.1

| Test No | 7 | 8 | 9 | 10 | 11 | 12 |
|------------------------------------------------------|----------|------|------|------|------|------|
| Compactive effort | Standard | | | | | |
| Oversize rock retained on sieve mm | 19.0 | 19.0 | 19.0 | 19.0 | 19.0 | 19.0 |
| Percent of oversize material wet | 0 | 0 | 0 | 0 | 0 | 0 |
| Peak Converted Wet Density t/m ³ | 1.78 | 1.83 | 1.97 | 1.78 | 1.77 | 1.79 |
| Adjusted Peak Converted Wet Density t/m ³ | - | - | - | - | - | - |
| Optimum Moisture Content % | 20.0 | 22.0 | 22.0 | 25.0 | 19.0 | 21.0 |

| | | | | | | |
|--------------------------------------------------|----------|----------|----------|----------|----------|----------|
| Moisture Variation From Optimum Moisture Content | 2.5% dry | 2.0% dry | 2.5% dry | 1.5% dry | 2.5% dry | 1.5% dry |
|--------------------------------------------------|----------|----------|----------|----------|----------|----------|

density and moisture ratio results relate only to the soil to the depth of test and not to the full depth of the layer

| | | | | | | | |
|----------------------------|---|-------|------|------|-------|------|------|
| Density Ratio (R_{HD}) | % | 100.0 | 97.0 | 90.5 | 100.0 | 96.5 | 96.5 |
|----------------------------|---|-------|------|------|-------|------|------|

Material description

No 7 - 12 Clay Fill

AVRLOT HILF V1.10 MAR 13



NATA Accredited Laboratory No 9909
Accredited for compliance with
ISO/IEC 17025 - Testing

Approved Signatory : Justin Fry