


- ### LEGEND
- Electricity (Underground)
 - Gas
 - Telstra
 - Water
 - Stormwater Drain, Pit and Property Inlet (PIP)
 - Swale Drain
 - Sewer, Maintenance Structures and Property Connection
 - House Drain
 - Gas & Water Conduits
 - Tactile Paver - Directional
 - Tactile Paver - Hazard
 - Existing Electricity (Underground)
 - Existing Electricity (Overhead)
 - Existing Gas
 - Existing Telstra
 - Existing Water
 - Existing Stormwater Drain
 - Existing Sewer
 - Existing House Drain
 - Existing Tree to Remain
 - Existing Tree to be Removed
 - Existing Swale Drain
 - Existing Surface Level
 - Finished Building Line Level
 - Finished Ridge Line Level
 - Top of Retaining Wall
 - Bottom of Retaining Wall
 - Retaining Wall
 - Intersection Threshold Treatment
 - Level 1 Fill > 200mm Deep
 - Ex. Level 1 Fill > 200mm Deep
 - Proposed Driveway
 - Allotment to be graded evenly in direction of fall to levels indicated
 - Direction of Fall
 - Overland Flow
 - Permanent Survey Mark
 - Temporary Bench Mark
 - Concrete Edge Strip with Subsoil Drain underneath "No Road" sign and Barrier
 - Building Envelope
 - Limit of Works
 - VAHR Extents

REV	DATE	ISSUE FOR TENDER	COMMENTS
AC	23/10/13	AS CONSTRUCTED ISSUE	
3	23/10/13	LOT 116 DRIVEWAY MOVED TO SOUTHERN SIDE	
2	9/07/2013	DRAIN 66 TO 67 AMENDED	
1	24/05/13	LOTS 136 TO 140 ADDED	
0	03/04/13	ISSUED FOR CONSTRUCTION	
B	29/10/13	ISSUE FOR TENDER	

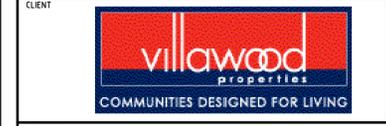

BROWN CONSULTING (VIC) PTY LTD
 Engineers, Town Planners and Surveyors
 Level 2, 55 Southbank Boulevard
 Southbank VIC 3006 T 03 9203 9000

TITLE



SCALE @ A1	DRAWN	DESIGNED
1:500	L.CHAPPLE	R.KOZUL
PROJECT ENGINEER	PROJECT MANAGER	DATE FIRST ISSUE
J.CONSIGLIO	T.PALIOS	

AS CONSTRUCTED

SIGNED	DATE
DRAWING NUMBER	REVISION
M100611-01-C03	AC

WARNING
 BEWARE OF UNDERGROUND SERVICES
 THE LOCATIONS OF UNDERGROUND SERVICES ARE APPROXIMATE ONLY AND THEIR EXACT POSITION SHOULD BE PROVEN ON SITE. NO GUARANTEE IS GIVEN THAT ALL EXISTING SERVICES ARE SHOWN.

