


Notations	
Survey Completed	14 January 2016
Title Peg	■
Pin in Concrete	●
Nail on top of Fence	●
Stake Placed	■
Electrical Sub Station	■
Pedestrian Path	---
Project	
Aspire Hillside	
Details	
Stage 11A and Stage 12 Final Peg	
Plan of Subdivision	
PS 732038R PS 734546K	
Surveyor	
CT	
Job Number	
27089-113/123	

Bosco Jonson Pty Ltd
 A.B.N 15 169 138 827
 P.O. Box 5075, South Melbourne, Vic 3205
 16 Eastern Road, South Melbourne
 Vic 3205 Australia
 Tel 03) 9699 1400 Fax 03) 9699 5992

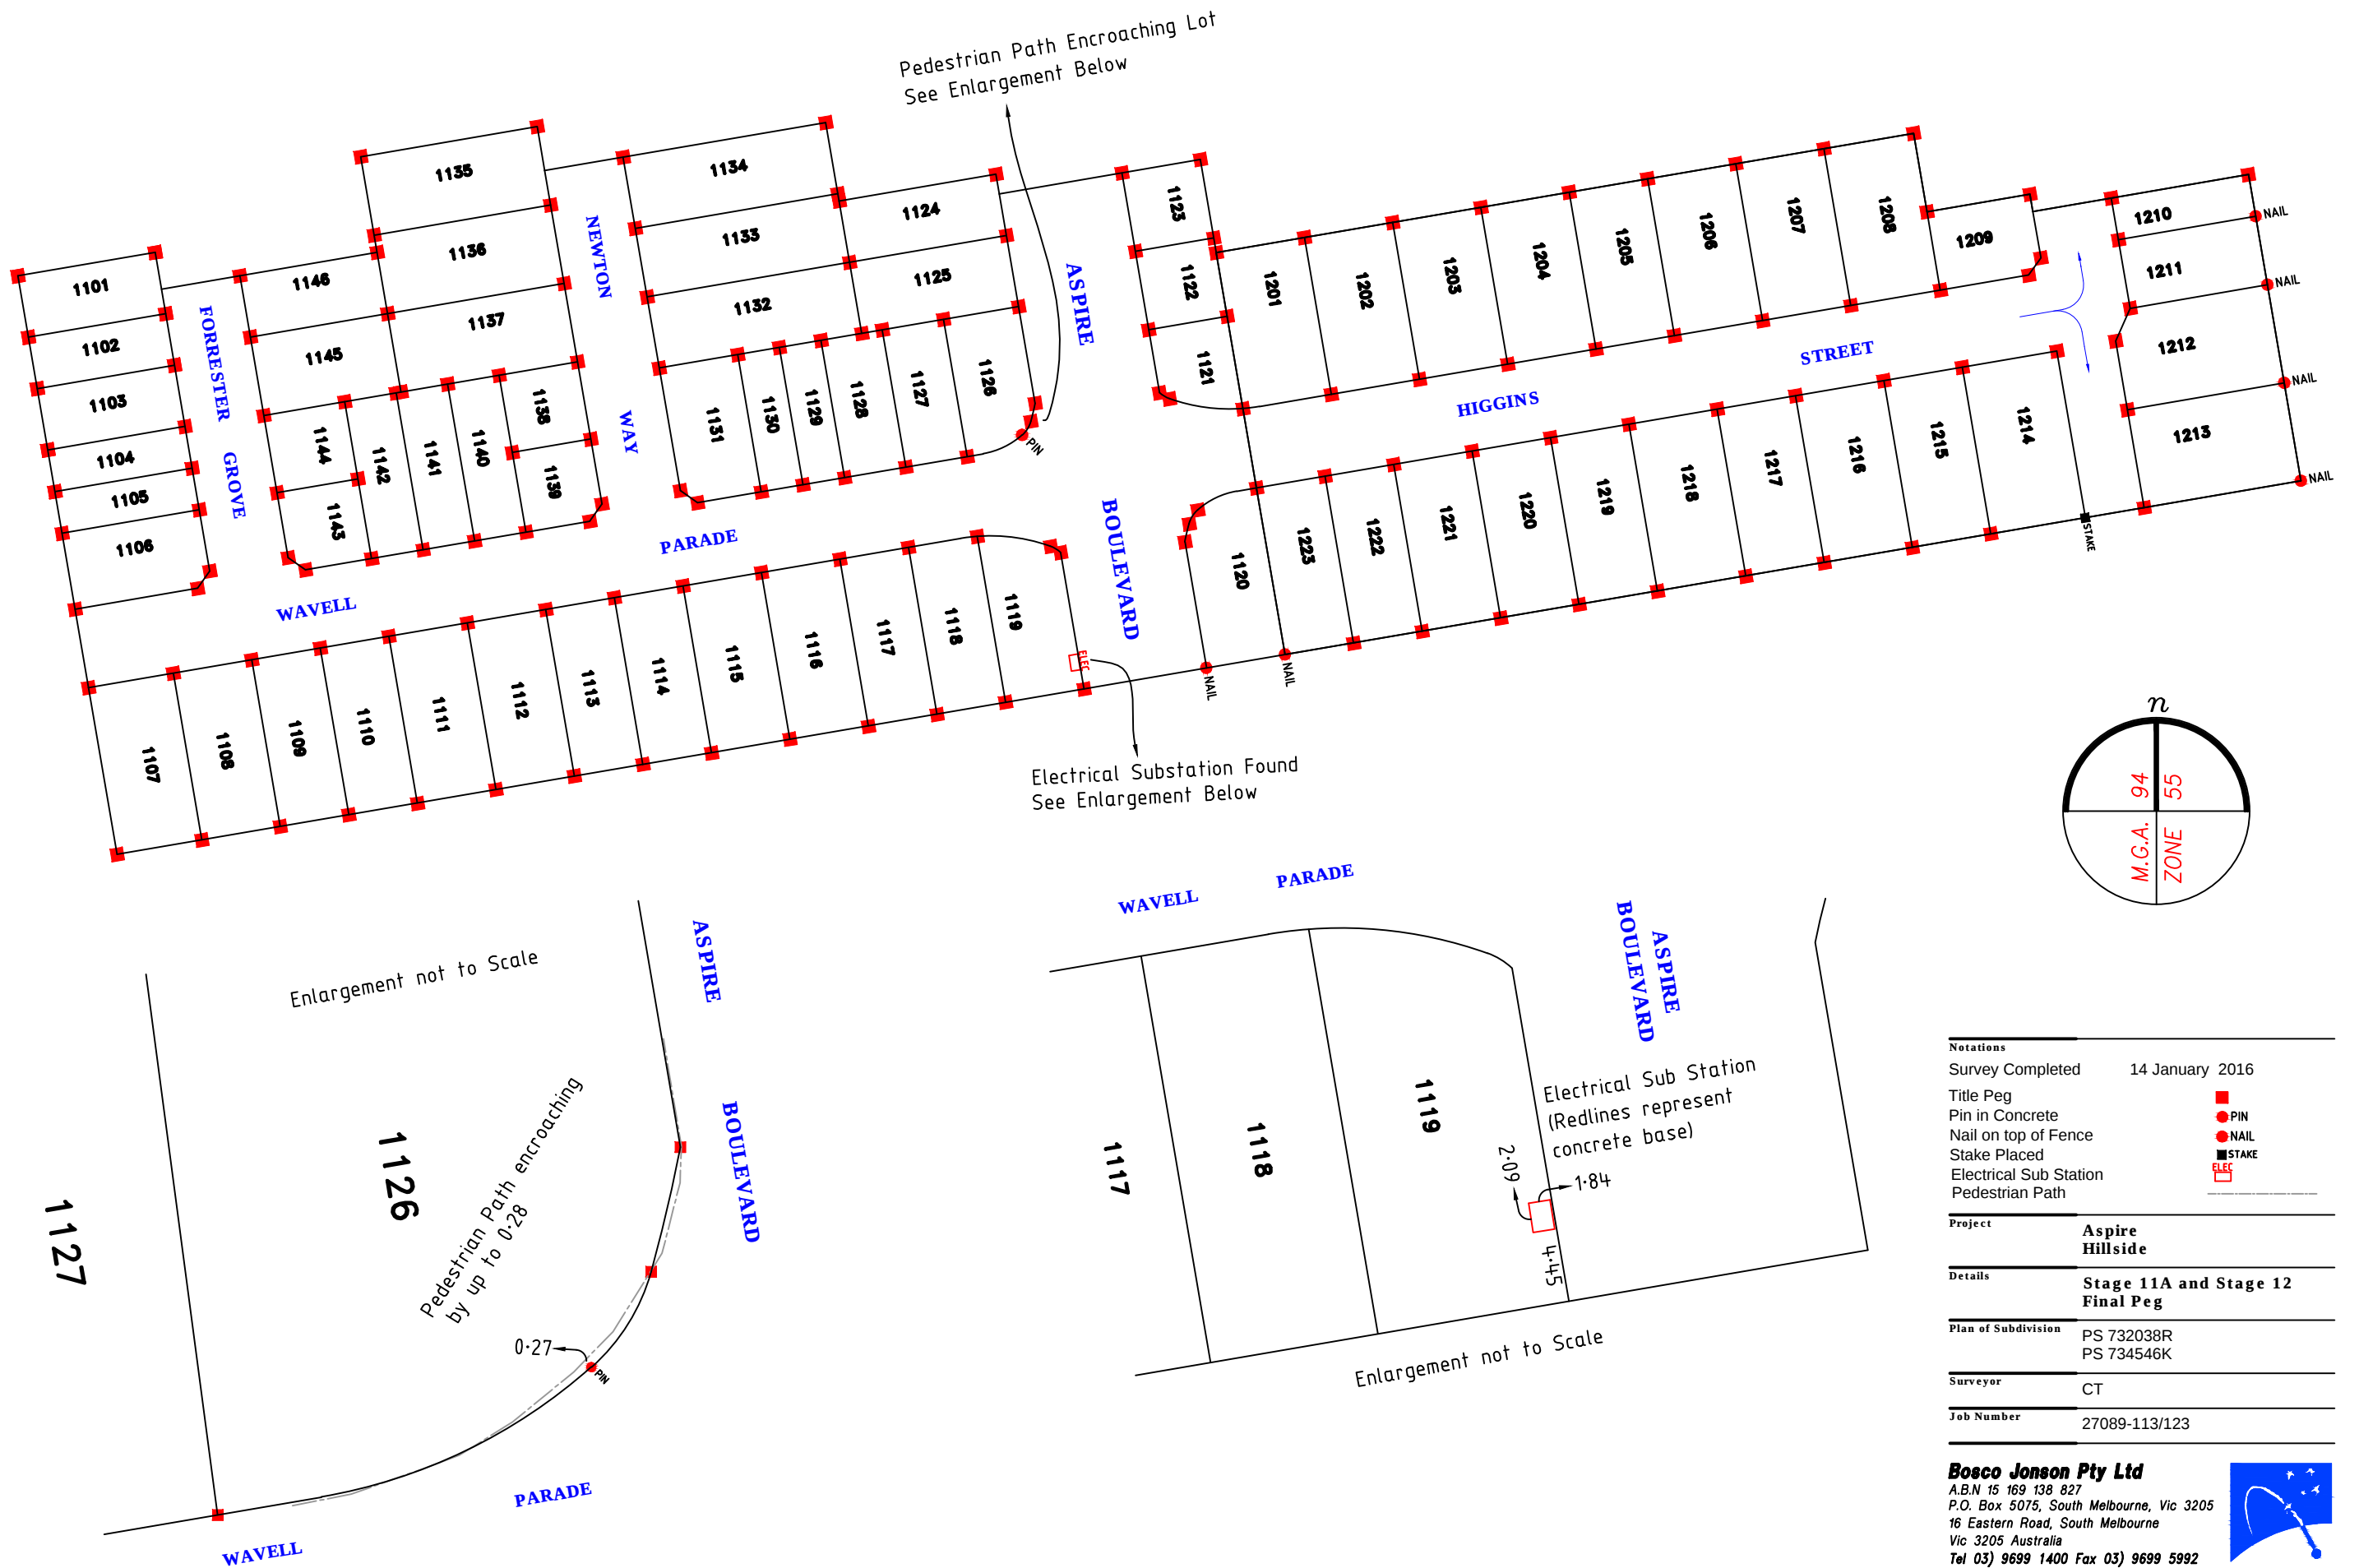