

GENERAL NOTES

This fill plan shows details of works affecting the natural surface of the land, being fill placed on the land to the extent and depth shown on this plan.

The depth of fill is based on the design finished surface as well as information provided by Landform Surveys


This plan does not show any other fill which may have been placed on the land.

Any grading or spreading to correct minor surface irregularities less than 300mm in depth is not shown.

Depths shown are not recommended foundation depths.



FILL DEPTHS

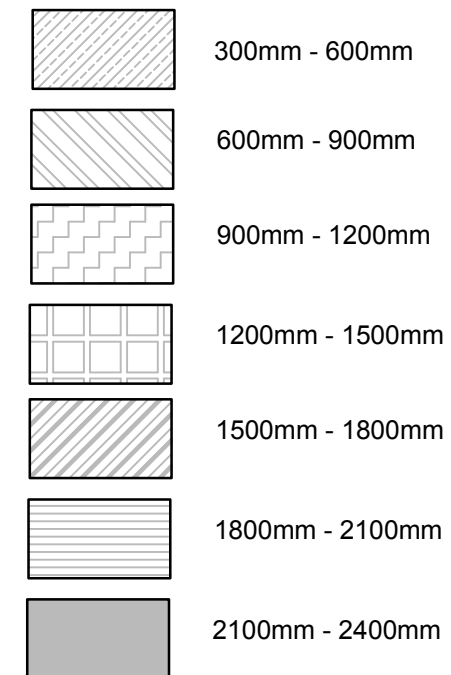

- These plans are design plans and are provided as a guide only.
- No guarantee is provided in relation to their accuracy as they will NOT reflect any changes or alterations which may have occurred during construction.
- Service locations are indicative and MUST be confirmed with the relevant Authority.
- No responsibility is accepted for any damages or financial loss incurred due to the use of these plans.

6			Designed	Checked	Notes/Legend
5			R. Dawborn	N. Bowe	
4			May 2018	May 2018	
3			Approved		
2					
1	Original Issue	24/5/2018			
0	Draft	-			
Ver	Revision Description	Date			

TERRACO
Civil Engineers
Project Managers
Development Consultants

Terraco P/L
ABN 12 681 695 776
Corner Jewell Court
& Rowena Street
Bendigo Vic 3550
Ph: 03 5442 5799
Fax: 03 5441 5506
E: info@terraco.com.au

Scale (m)	
All lengths are in metres and all levels are to Australian Height Datum (Original Sheet Size is A3)	
Drawing file: 17002 Final Fill.dwg	LTO Ref: -

Murray River Council - Moama
Villawood Properties Pty Ltd
Lakeview Estate - Stage 6
Final Lot Fill Plan

Council Ref: DA 173/11	Our Ref: 17002	Version 1	Sheet 1 of 1
---------------------------	-------------------	--------------	-----------------