

DRAPERS CIVIL
CONTRACTING PTY LTD

ARMSTRONG ESTATE
STAGE 32

MT. DUNED

Report On

LEVEL 1
SURVEILLANCE
& COMPACTION CONTROL
OF EARTHWORKS

*Carried Out
By*



Project No.: 1862/118

11th September 2017
Project No.: 1862/118

Drapers Civil Contracting Pty Ltd
PO Box 287
Belmont, Vic 3216
Attention: - Mr. Chris Nation

Dear Sir,

RE: Armstrong Estate Stage 32 - Earthworks

Introduction & Scope

At the request of Drapers Civil Contracting Pty Ltd, Geotechnical Laboratories has carried out inspection and testing of the above mentioned site from the 26th of August 2016 to the 28th of February 2017 where a residential development is being constructed. Inspection and testing of stripping, material quality and compaction control tests were carried out to comply with the requirements of AS 3798 Appendix B, Level 1.

The following documentation was submitted to Geotechnical Laboratories by Drapers Civil Contracting Pty Ltd and was used to determine compliance of earthworks in conjunction with the requirements of AS 3798 – 2007 (See Appendix A).

(1). Standard Faceplan Layout Drawing No. M100611.32-BE01 – Rev. A

General site works involved the placement of fill, using on-site derived clays, to bring the fill area to the required finished levels as indicated on the faceplan drawings.

Site Preparation

Site inspections were undertaken on the 25th of August 2016, the 8th of September 2016 and the 21st of February 2017 confirming that selected areas to be filled were completely stripped of all vegetation and topsoil prior to filling. The brown silty topsoils had been stockpiled around the site for later removal off-site.

Proof roll inspections were performed throughout the project duration to ensure no significant soft areas were present prior to filling.

Material

It is understood that the fill material used was sourced from on-site excavations, mainly drainage trenches and road boxing.

The materials are best described as **CLAY fill, brown, orange-brown, slightly sandy, slightly moist to moist considered to be of medium plasticity with fine to coarse gravel of a basalt origin.**

The fill material is consistent with the naturally occurring soils for this region.

Source material was deemed a **Suitable Material** in accordance with the guidelines set out in AS 3798 - 2007 Section 4.4.

Compaction of Fill Material

A sheepsfoot compactor placed material in horizontal loose layers of approximately 200-250mm. The sheepsfoot compactor also performed compaction of the clay fill operating in a criss-cross pattern where possible.

The moisture condition of the fill was closely monitored and moisture conditioning procedures were applied to bring the material closer to its Standard Optimum Moisture Content (AS 1289 5.7.1). Moisture conditioning was carried out using a water cart and mixing with the compactor prior to sheepsfoot rolling.

Compaction Testing

Compaction control testing was performed on-site using a Nuclear Densometer in accordance with AS 1289 5.8.1. Laboratory reference densities were determined from material sampled at each test site location using the Hilf Rapid Compaction Method in accordance with AS 1289 5.7.1.

A total of forty two compaction tests were performed on the earthworks. Results are presented in Appendix A of this report.

Testing frequencies were in accordance with **AS 3798 - 2007 Table 8.1** for **Large Scale Operations**.

Acceptance of fill layers for minimum relative compaction was based on the requirements of **AS 3798 - 2007 Table 5.1 Item 1. Residential**. As a result the compliance criteria adopted by Geotechnical Laboratories was a hlf density ratio not less than 95 percent of the maximum hlf density value as determined by the Standard Hlf Rapid Compaction Method in accordance with AS 1289 5.7.1.

No moisture criteria was specified.

Test results indicate that the above mentioned requirements have been successfully achieved.

Remarks

So far as can be determined, Drapers Civil Contracting Pty Ltd has satisfactorily complied with the compaction and construction processes required for the structural filling of this site. As such structural filling placed on this site by Drapers Civil Contracting Pty Ltd from the 26th of August 2016 to the 28th of February 2017 can be categorised as CONTROLLED FILL in accordance with AS 2870-2011.

Note: Test results and controlled fill certification relates only to fill placed by Drapers Civil Contracting Pty Ltd and for earthworks completed at the time of testing. Any previous or subsequent earthworks will require a separate evaluation.

Yours Faithfully
GEOTECHNICAL LABORATORIES



Sam Loza
Laboratory Manager

DRAPERS CIVIL
CONTRACTING PTY LTD

ARMSTRONG ESTATE
STAGE 32

MT. DUNEED


Report On

LEVEL 1
SURVEILLANCE
& COMPACTION CONTROL
OF EARTHWORKS

*Carried Out
By*



APPENDIX A

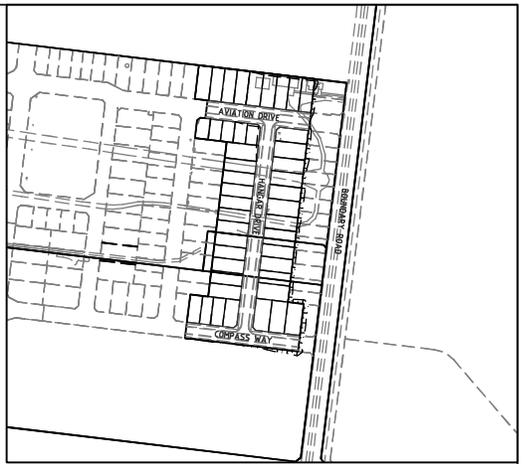

LOCALITY PLAN

WARNING

BEWARE OF UNDERGROUND SERVICES
THE LOCATION OF UNDERGROUND SERVICES ARE NOT SHOWN ON THIS PLAN. ANY SERVICES ARE TO BE LOCATED BY OTHERS. THE LOCATION OF UNDERGROUND SERVICES ARE NOT SHOWN ON THIS PLAN. ANY SERVICES ARE TO BE LOCATED BY OTHERS.






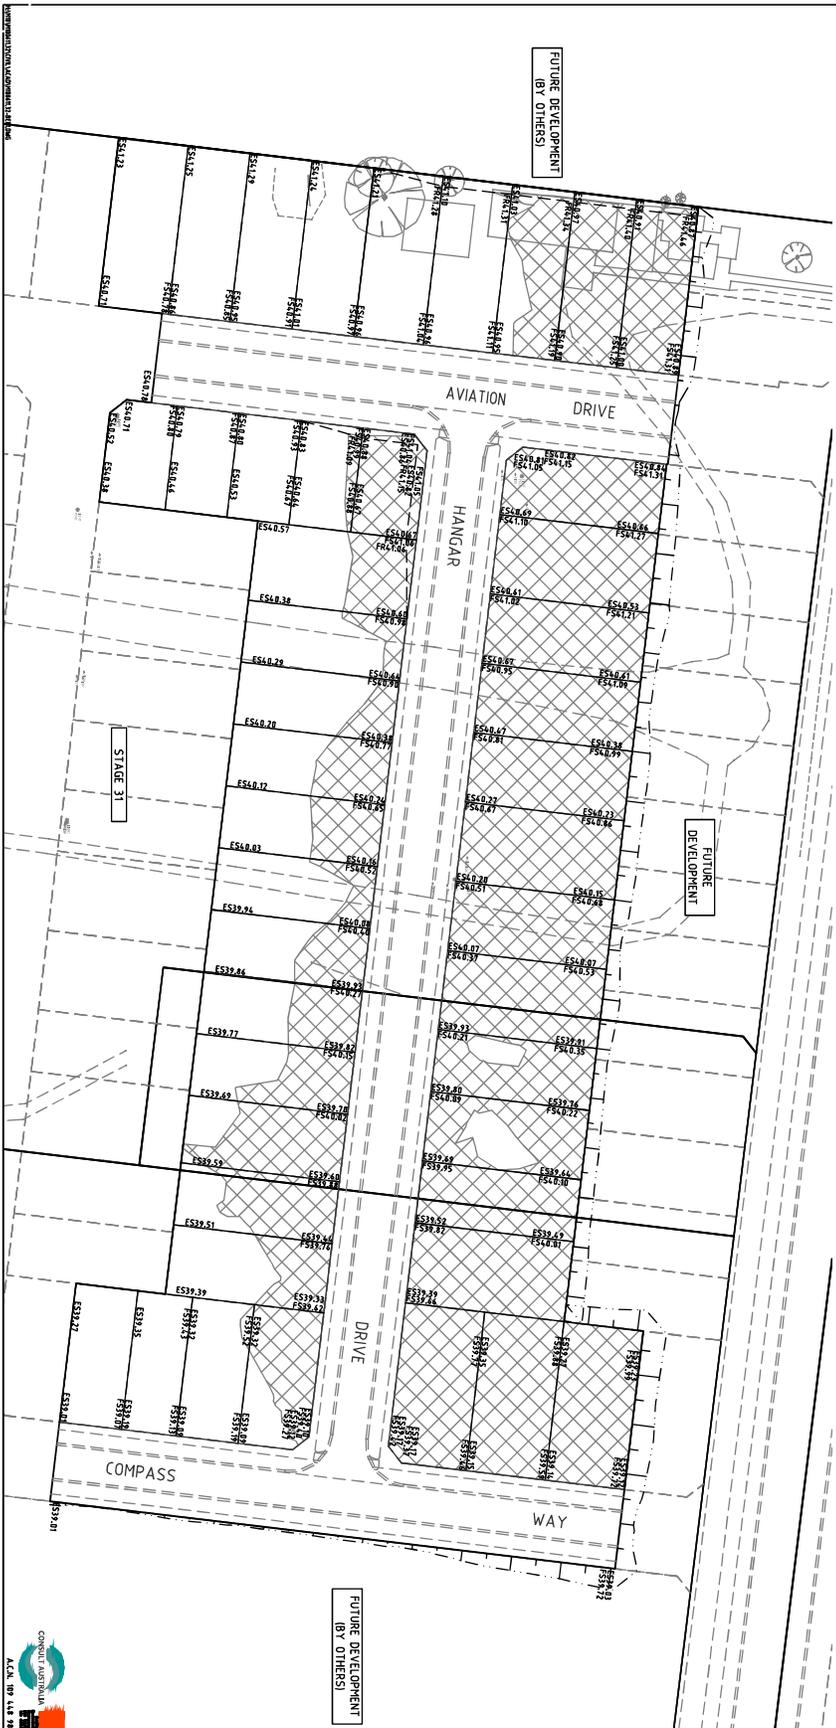

LEGEND

















GEOTECHNICAL LABORATORIES
 ACN 102 571 077
 Factory 1/8-10 Catalina Drive, Tullamarine Vic 3043
 PO Box 184 Keller VIC 3036
 PH: (03) 9335 1225 Fax: (03) 9335 1775

DAILY SUMMARY - FIELD DENSITY TESTS


REPORT NO.: # 1861/217
 LOCATION: DRAPERS - Armstrong Estate Stage 32

DATE OF TESTS	TEST NUM.	TEST LOCATION	FIELD WET DENSITY (t/m ³)	FIELD MOISTURE CONTENT (%)	HILF DENSITY RATIO STANDARD (%)	STANDARD PCWD OR APCWD (t/m ³)	STANDARD OPTIMUM MOISTURE CONTENT (%)	PROBE DEPTH SETTING (mm)	VARIATION FROM OPTIMUM MOISTURE CONTENT (%)	MOISTURE RATIO (%)	WET +19mm (%)	WET +37.5mm (%)	APPROX. DEPTH BELOW FINISH LEVEL (mm)
26/08/16	1	<i>Refer to #1861/218 for approx. test site locations.</i>	2.05	19.0	100.0	2.05	18.5	175	0.5 Wetter	102.5	0	0	200
26/08/16	2		2.13	19.5	103.5	2.06	19.5	175	0.0 Drier	100.0	0	0	200
26/08/16	3		2.01	21.0	100.0	2.00	21.0	175	0.0 Drier	100.0	0	0	0
-	-		-	-	-	-	-	-	-	-	-	-	-
-	-		-	-	-	-	-	-	-	-	-	-	-
-	-		-	-	-	-	-	-	-	-	-	-	-

NOTES: Onsite Clay Fill
 Test sites located - Geolab Procedure 4, Part 4.4.
 Start Time: 9:38am Finish Time: 10:00
 Compaction specimens sampled after compaction.

A Hilf Rapid Compaction test was carried out on a sample taken from each Field Density location to obtain the Compaction Parameters tabulated on this Report.
 Soil Layer thickness: 200mm
 Hilf Density Ratio and Hilf Moisture Variation, Hilf Adjusted (APCWD) & Peak (PCWD) Converted Wet Density AS 1289 5.7.1
 Moisture Content: AS 1289 2.1.1
 Compaction Test: AS 1289 5.7.1
 Field Density, Nuclear Gauge: AS 1289 5.8.1
 Materials Sampled : AS 1289 1.2.1 Clause 6.4(b)

SAM LOZA
 (Approved Signatory)
 Issue Date: 1/9/2016

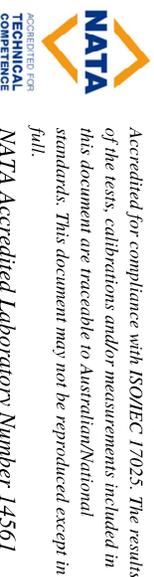



GEOTECHNICAL LABORATORIES
 ACN 102 571 077
 Factory 1/8-10 Catalina Drive, Tullamarine Vic 3043
 PO Box 184 Keller VIC 3036
 PH: (03) 9335 1225 Fax: (03) 9335 1775

DAILY SUMMARY - FIELD DENSITY TESTS

REPORT NO.: # 1861/219
 LOCATION: DRAPERS - Armstrong Estate Stage 32


DATE OF TESTS	TEST NUM.	TEST LOCATION	FIELD WET DENSITY (t/m ³)	FIELD MOISTURE CONTENT (%)	HILF DENSITY RATIO STANDARD (%)	STANDARD PCWD OR APCWD (t/m ³)	STANDARD OPTIMUM MOISTURE CONTENT (%)	PROBE DEPTH SETTING (mm)	VARIATION FROM OPTIMUM MOISTURE CONTENT (%)	MOISTURE RATIO (%)	WET +19mm (%)	WET +37.5mm (%)	APPROX. DEPTH BELOW FINISH LEVEL (mm)
29/08/16	1	<i>Refer to #1861/220 for approx. test site locations.</i>	2.07	18.0	101.0	2.04	20.0	175	2.0 Drier	90.5	0	0	400
29/08/16	2		2.13	16.0	101.0	2.11	15.5	175	0.5 Wetter	104.5	0	0	200
29/08/16	3		2.19	16.0	105.5	2.08	18.0	175	2.5 Drier	87.0	0	0	0
-	-		-	-	-	-	-	-	-	-	-	-	-
-	-		-	-	-	-	-	-	-	-	-	-	-
-	-		-	-	-	-	-	-	-	-	-	-	-

NOTES: Onsite Clay Fill
 Test sites located - Geolab Procedure 4, Part 4.4.
 Start Time: 11:50am Finish Time: 12:10pm
 Compaction specimens sampled after compaction.

A Hilf Rapid Compaction test was carried out on a sample taken from each Field Density location to obtain the Compaction Parameters tabulated on this Report.
 Soil Layer thickness: 200mm
 Hilf Density Ratio and Hilf Moisture Variation, Hilf Adjusted (APCWD) & Peak (PCWD) Converted Wet Density AS 1289 5.7.1
 Field Density, Nuclear Gauge: AS 1289 5.8.1
 Materials Sampled : AS 1289 1.2.1 Clause 6.4(b)

Moisture Content: AS 1289 2.1.1
 Compaction Test: AS 1289 5.7.1

SAM LOZA
 (Approved Signatory)
 Issue Date: 29/2016

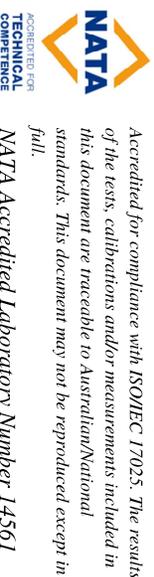



GEOTECHNICAL LABORATORIES
 ACN 102 571 077
 Factory 1/8-10 Catalina Drive, Tullamarine Vic 3043
 PO Box 184 Keller VIC 3036
 PH: (03) 9335 1225 Fax: (03) 9335 1775

DAILY SUMMARY - FIELD DENSITY TESTS


REPORT NO.: # 1861/221
 LOCATION: DRAPERS - Armstrong Estate Stage 32

DATE OF TESTS	TEST NUM.	TEST LOCATION	FIELD WET DENSITY (t/m ³)	FIELD MOISTURE CONTENT (%)	HILF DENSITY RATIO STANDARD (%)	STANDARD PCWD OR APCWD (t/m ³)	STANDARD OPTIMUM MOISTURE CONTENT (%)	PROBE DEPTH SETTING (mm)	VARIATION FROM OPTIMUM MOISTURE CONTENT (%)	MOISTURE RATIO (%)	WET +19mm (%)	WET +37.5mm (%)	APPROX. DEPTH BELOW FINISH LEVEL (mm)	
31/08/16	1	<i>Refer to #1861/222 for approx. test site locations.</i>	2.05	20.0	100.0	2.06	20.0	175	0.0	Wetter	101.0	0	0	200
31/08/16	2		2.14	18.0	100.5	2.13	17.5	175	0.0	Wetter	101.5	0	0	0
31/08/16	3		2.10	19.0	103.5	2.03	19.5	175	0.5	Drier	97.5	0	0	0
-	-	-	-	-	-	-	-	-	-	-	-	-	-	-
-	-	-	-	-	-	-	-	-	-	-	-	-	-	-
-	-	-	-	-	-	-	-	-	-	-	-	-	-	-

NOTES: Onsite Clay Fill
 Test sites located - Geolab Procedure 4, Part 4.4.
 Start Time: 10:26am Finish Time: 10:42am
 Compaction specimens sampled after compaction.

A Hilf Rapid Compaction test was carried out on a sample taken from each Field Density location to obtain the Compaction Parameters tabulated on this Report.
 Soil Layer thickness: 200mm
 Moisture Content: AS 1289 2.1.1
 Compaction Test: AS 1289 5.7.1
 Hilf Density Ratio and Hilf Moisture Variation, Hilf Adjusted (APCWD) & Peak (PCWD) Converted Wet Density AS 1289 5.7.1
 Field Density, Nuclear Gauge: AS 1289 5.8.1
 Materials Sampled : AS 1289 1.2.1 Clause 6.4(b)

SAM LOZA
 (Approved Signatory)
 Issue Date: 5/9/2016

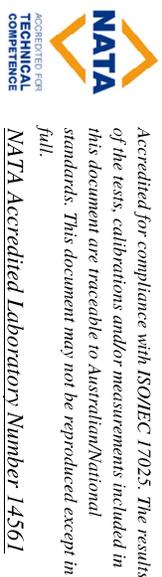



GEOTECHNICAL LABORATORIES
 ACN 102 571 077
 Factory 1/8-10 Catalina Drive, Tullamarine Vic 3043
 PO Box 184 Keilor VIC 3036
 PH: (03) 9335 1225 Fax: (03) 9335 1775

CLIENT: DRAPERS LOCATION: Armstrong Estate Stage 32 Sketch indicating approx. compaction test locations	DATE: 31/08/16	JOB No.: 1861/222
	OPERATOR: JC	CHECKED: CA
	SCALE: NTS	FIGURE No: -



GEOTECHNICAL LABORATORIES
 ACN 102 571 077
 Factory 1/8-10 Catalina Drive, Tullamarine Vic 3043
 PO Box 184 Keller VIC 3036
 PH: (03) 9335 1225 Fax: (03) 9335 1775

DAILY SUMMARY - FIELD DENSITY TESTS

REPORT NO.: # 1861/223
 LOCATION: DRAPERS - Armstrong Estate Stage 32

DATE OF TESTS	TEST NUM.	TEST LOCATION	FIELD WET DENSITY (t/m ³)	FIELD MOISTURE CONTENT (%)	HILF DENSITY RATIO STANDARD (%)	STANDARD PCWD OR APCWD (t/m ³)	STANDARD OPTIMUM MOISTURE CONTENT (%)	PROBE DEPTH SETTING (mm)	VARIATION FROM OPTIMUM MOISTURE CONTENT (%)	MOISTURE RATIO (%)	WET +19mm (%)	WET +37.5mm (%)	APPROX. DEPTH BELOW FINISH LEVEL (mm)	
2/09/16	1	Refer to #1861/224 for approx. test site locations.	1.99	20.5	101.0	1.97	23.5	175	3.0	87.0	0	0	0	
2/09/16	2		2.02	20.0	101.0	2.00	23.0	175	3.0	86.5	0	0	0	
2/09/16	3		2.06	20.5	102.0	2.02	23.5	175	3.0	87.5	0	0	0	
-	-		-	-	-	-	-	-	-	-	-	-	-	-
-	-		-	-	-	-	-	-	-	-	-	-	-	-
-	-		-	-	-	-	-	-	-	-	-	-	-	-

NOTES: Onsite Clay Fill
 Test sites located - Geolab Procedure 4, Part 4.4.
 Start Time: 9:45am Finish Time: 10:02am
 Compaaction specimens sampled after compaction.

A Hilf Rapid Compaction test was carried out on a sample taken from each Field Density location to obtain the Compaction Parameters tabulated on this Report.

Soil Layer thickness: 200mm
 Moisture Content: AS 1289 2.1.1
 Compaction Test: AS 1289 5.7.1

Hilf Density Ratio and Hilf Moisture Variation, Hilf Adjusted (APCWD) & Peak (PCWD) Converted Wet Density AS 1289 5.7.1

Field Density, Nuclear Gauge: AS 1289 5.8.1

Materials Sampled : AS 1289 1.2.1 Clause 6.4(b)


SAM LOZA
 (Approved Signatory)

Issue Date: 5/9/2016



Accredited for compliance with ISO/IEC 17025. The results of the tests, calibrations and/or measurements included in this document are traceable to Australian/National standards. This document may not be reproduced except in full.

NATA Accredited Laboratory Number 14561

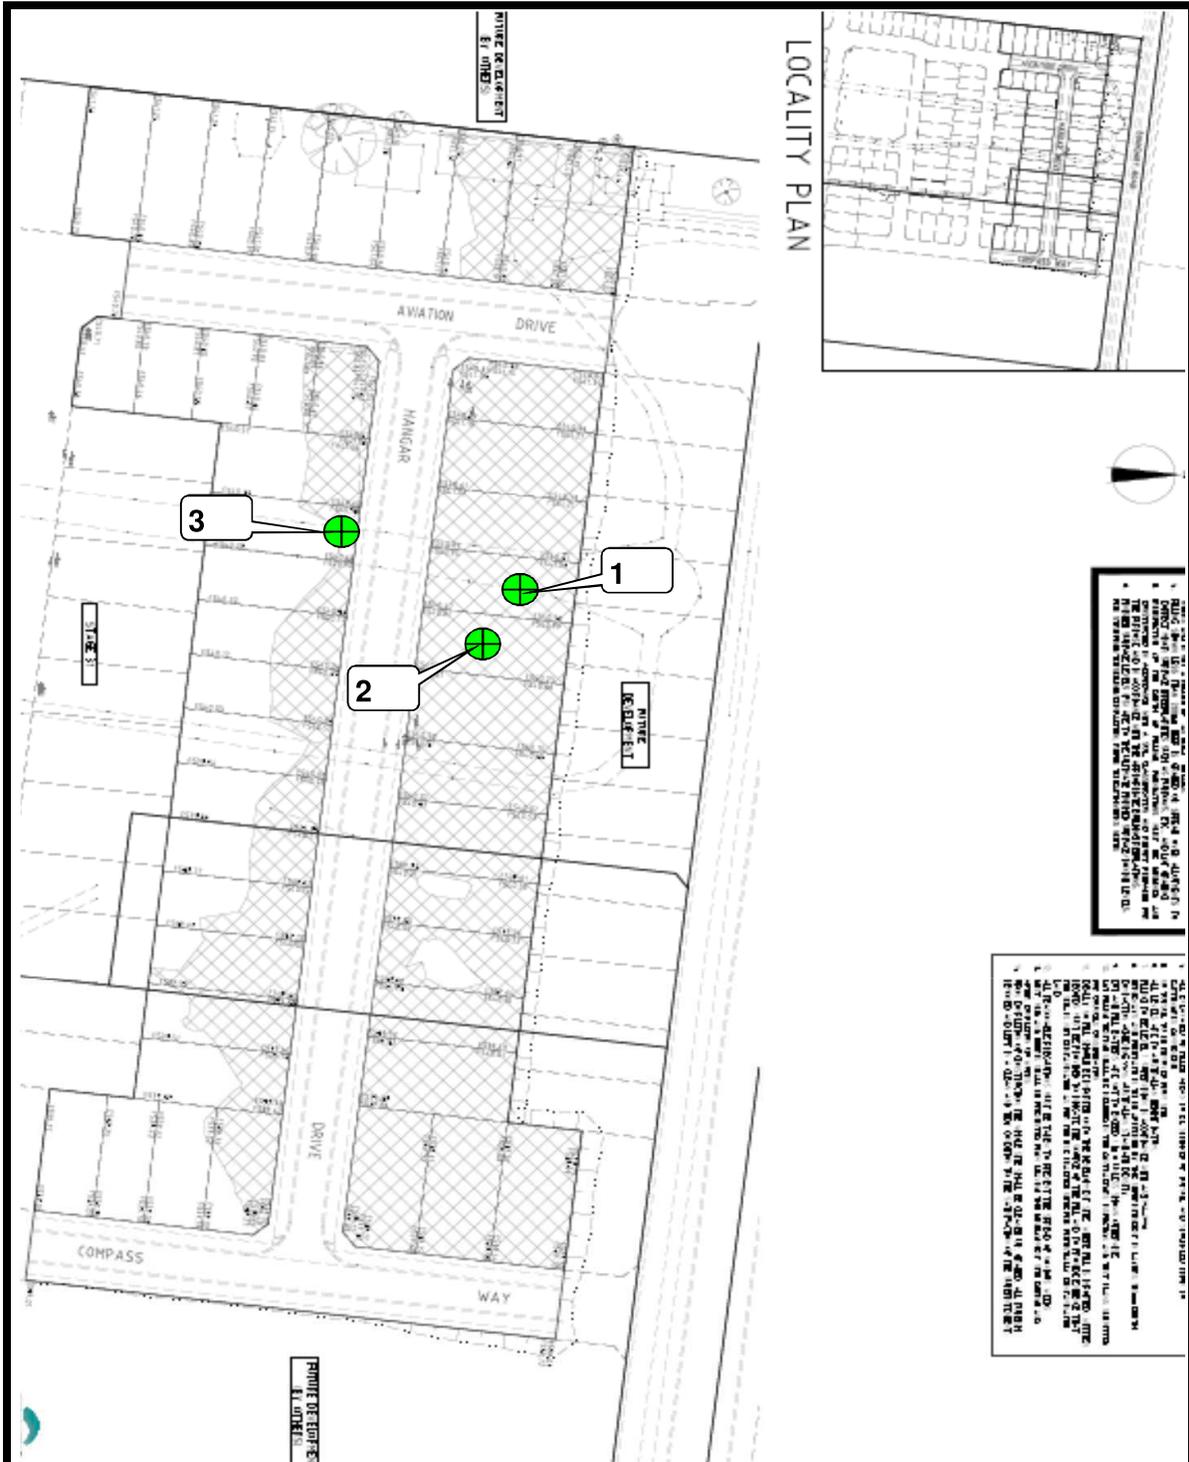

GEOTECHNICAL LABORATORIES
 ACN 102 571 077
 Factory 1/8-10 Catalina Drive, Tullamarine Vic 3043
 PO Box 184 Keilor VIC 3036
 PH: (03) 9335 1225 Fax: (03) 9335 1775

CLIENT: DRAPERS LOCATION: Armstrong Estate Stage 32 Sketch indicating approx. compaction test locations	DATE: 2/09/16	JOB No.: 1861/224
	OPERATOR: JC	CHECKED: CA
	SCALE: NTS	FIGURE No: -



GEOTECHNICAL LABORATORIES
 ACN 102 571 077
 Factory 1/8-10 Catalina Drive, Tullamarine Vic 3043
 PO Box 184 Keller VIC 3036
 PH: (03) 9335 1225 Fax: (03) 9335 1775

DAILY SUMMARY - FIELD DENSITY TESTS

REPORT NO.: # 1861/225
 LOCATION: DRAPERS - Armstrong Estate Stage 32

DATE OF TESTS	TEST NUM.	TEST LOCATION	FIELD WET DENSITY (t/m ³)	FIELD MOISTURE CONTENT (%)	HILF DENSITY RATIO STANDARD (%)	STANDARD PCWD OR APCWD (t/m ³)	STANDARD OPTIMUM MOISTURE CONTENT (%)	PROBE DEPTH SETTING (mm)	VARIATION FROM OPTIMUM MOISTURE CONTENT (%)	MOISTURE RATIO (%)	WET +19mm (%)	WET +37.5mm (%)	APPROX. DEPTH BELOW FINISH LEVEL (mm)	
6/09/16	1	<i>Refer to #1861/226 for approx. test site locations.</i>	1.96	24.0	99.5	1.97	24.0	175	0.0	Drier	99.0	0	0	0
6/09/16	2		1.99	23.5	100.5	1.98	23.5	175	0.0	Drier	100.0	0	0	0
6/09/16	3		1.93	24.0	99.0	1.95	24.0	175	0.0	Drier	99.0	0	0	0
-	-	-	-	-	-	-	-	-	-	-	-	-	-	-
-	-	-	-	-	-	-	-	-	-	-	-	-	-	-
-	-	-	-	-	-	-	-	-	-	-	-	-	-	-

NOTES: Onsite Clay Fill
 Test sites located - Geolab Procedure 4, Part 4.4.
 Start Time: 9:33am Finish Time: 9:57am
 Compaction specimens sampled after compaction.

A Hilf Rapid Compaction test was carried out on a sample taken from each Field Density location to obtain the Compaction Parameters tabulated on this Report.
 Soil Layer thickness: 200mm
 Hilf Density Ratio and Hilf Moisture Variation, Hilf Adjusted (APCWD) & Peak (PCWD) Converted Wet Density AS 1289 5.7.1
 Moisture Content: AS 1289 2.1.1
 Compaction Test: AS 1289 5.7.1
 Field Density, Nuclear Gauge: AS 1289 5.8.1
 Materials Sampled : AS 1289 1.2.1 Clause 6.4(b)


 SAM LOZA
 (Approved Signatory)
 Issue Date: 12/9/2016



Accredited for compliance with ISO/IEC 17025. The results of the tests, calibrations and/or measurements included in this document are traceable to Australian/National standards. This document may not be reproduced except in full.
 NATA Accredited Laboratory Number 14561



GEOTECHNICAL LABORATORIES
 ACN 102 571 077
 Factory 1/8-10 Catalina Drive, Tullamarine Vic 3043
 PO Box 184 Keller VIC 3036
 PH: (03) 9335 1225 Fax: (03) 9335 1775

DAILY SUMMARY - FIELD DENSITY TESTS

REPORT NO.: # 1861/229


LOCATION: DRAPERS - Armstrong Estate Stage 32

DATE OF TESTS	TEST NUM.	TEST LOCATION	FIELD WET DENSITY (t/m ³)	FIELD MOISTURE CONTENT (%)	HILF DENSITY RATIO STANDARD (%)	STANDARD PCWD OR APCWD (t/m ³)	STANDARD OPTIMUM MOISTURE CONTENT (%)	PROBE DEPTH SETTING (mm)	VARIATION FROM OPTIMUM MOISTURE CONTENT (%)	MOISTURE RATIO (%)	WET +19mm (%)	WET +37.5mm (%)	APPROX. DEPTH BELOW FINISH LEVEL (mm)
21/09/16	1	<i>Refer to #1861/230 for approx. test site locations.</i>	1.91	27.0	99.5	1.92	26.5	175	0.5 Wetter	101.0	0	0	200
21/09/16	2		1.96	23.5	97.0	2.02	23.5	175	0.0 Drier	100.0	0	0	0
21/09/16	3		1.91	22.5	95.0	2.00	22.5	175	0.0 Drier	99.0	0	0	0
-	-	-	-	-	-	-	-	-	-	-	-	-	-
-	-	-	-	-	-	-	-	-	-	-	-	-	-
-	-	-	-	-	-	-	-	-	-	-	-	-	-

NOTES: Onsite Clay Fill
 Test sites located - Geolab Procedure 4, Part 4.4.
 Start Time: 1:50pm Finish Time: 2:05pm
 Compaaction specimens sampled after compaction.

A Hilf Rapid Compaction test was carried out on a sample taken from each Field Density location to obtain the Compaction Parameters tabulated on this Report.
 Soil Layer thickness: 200mm
 Hilf Density Ratio and Hilf Moisture Variation, Hilf Adjusted (APCWD) & Peak (PCWD) Converted Wet Density AS 1289 5.7.1
 Moisture Content: AS 1289 2.1.1
 Compaction Test: AS 1289 5.7.1
 Field Density, Nuclear Gauge: AS 1289 5.8.1
 Materials Sampled : AS 1289 1.2.1 Clause 6.4(b)


 SAM LOZA
 (Approved Signatory)
 Issue Date: 27/9/2016

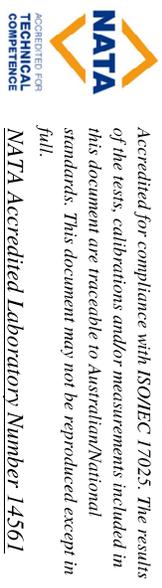



GEOTECHNICAL LABORATORIES
 ACN 102 571 077
 Factory 1/8-10 Catalina Drive, Tullamarine Vic 3043
 PO Box 184 Keller VIC 3036
 PH: (03) 9335 1225 Fax: (03) 9335 1775

DAILY SUMMARY - FIELD DENSITY TESTS

REPORT NO.: # 1861/234

LOCATION: DRAPERS - Armstrong Estate Stage 32

DATE OF TESTS	TEST NUM.	TEST LOCATION	FIELD WET DENSITY (t/m ³)	FIELD MOISTURE CONTENT (%)	HILF DENSITY RATIO STANDARD (%)	STANDARD PCWD OR APCWD (t/m ³)	STANDARD OPTIMUM MOISTURE CONTENT (%)	PROBE DEPTH SETTING (mm)	VARIATION FROM OPTIMUM MOISTURE CONTENT (%)	MOISTURE RATIO (%)	WET +19mm (%)	WET +37.5mm (%)	APPROX. DEPTH BELOW FINISH LEVEL (mm)	
22/09/16	1	<i>Refer to #1861/235 for approx. test site locations.</i>	1.99	24.0	102.0	1.95	24.0	175	0.0	Wetter	101.0	0	0	200
22/09/16	2		2.09	20.5	102.5	2.04	20.5	175	0.0	Wetter	101.0	0	0	200
22/09/16	3		2.08	21.0	102.0	2.04	21.5	175	0.0	Drier	99.0	0	0	200
-	-		-	-	-	-	-	-	-	-	-	-	-	-
-	-		-	-	-	-	-	-	-	-	-	-	-	-
-	-		-	-	-	-	-	-	-	-	-	-	-	-


NOTES: Onsite Clay Fill
 Test sites located - Geolab Procedure 4, Part 4.4.
 Start Time: 3:30pm Finish Time: 3:48pm
 Compaction specimens sampled after compaction.

A Hilf Rapid Compaction test was carried out on a sample taken from each Field Density location to obtain the Compaction Parameters tabulated on this Report.
 Soil Layer thickness: 200mm
 Hilf Density Ratio and Hilf Moisture Variation, Hilf Adjusted (APCWD) & Peak (PCWD) Converted Wet Density AS 1289 5.7.1
 Moisture Content: AS 1289 2.1.1
 Compaction Test: AS 1289 5.7.1
 Field Density, Nuclear Gauge: AS 1289 5.8.1
 Materials Sampled : AS 1289 1.2.1 Clause 6.4(b)


 SAM LOZA
 (Approved Signatory)
 Issue Date: 29/9/2016



Accredited for compliance with ISO/IEC 17025. The results of the tests, calibrations and/or measurements included in this document are traceable to Australian/National standards. This document may not be reproduced except in full.
 NATA Accredited Laboratory Number 14561

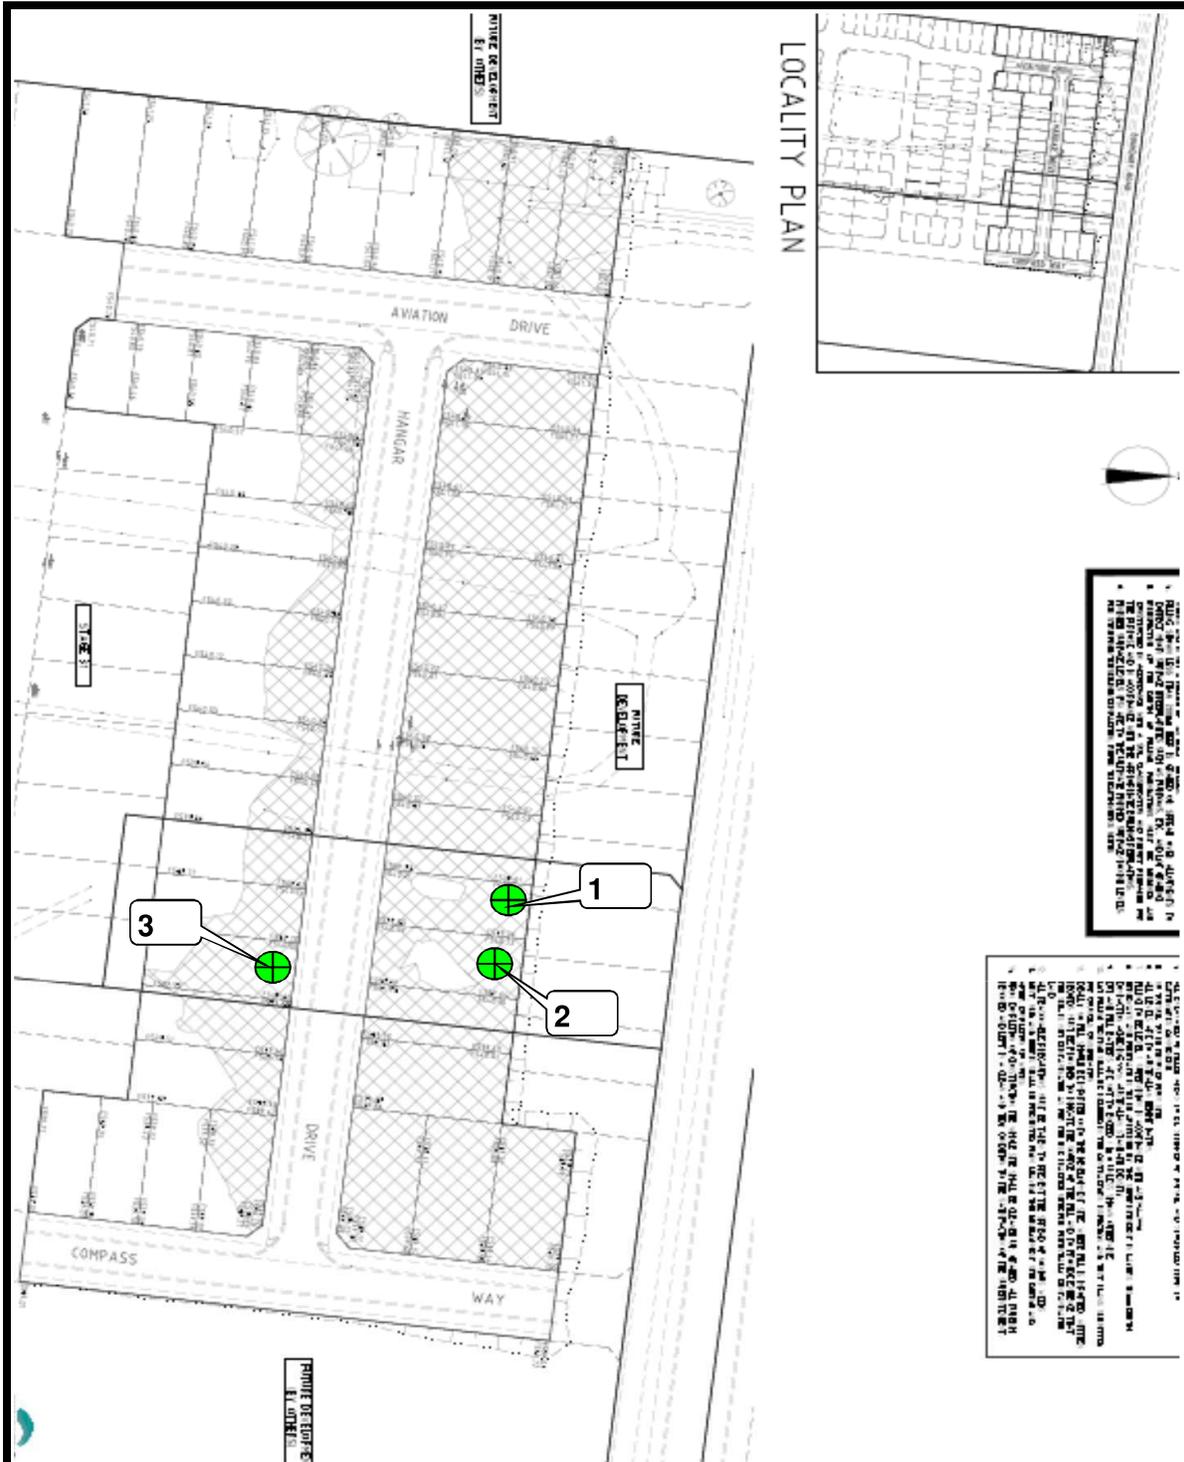

GEOTECHNICAL LABORATORIES

GEOTECHNICAL LABORATORIES
 ACN 102 571 077
 Factory 1/8-10 Catalina Drive, Tullamarine Vic 3043
 PO Box 184 Keilor VIC 3036
 PH: (03) 9335 1225 Fax: (03) 9335 1775

CLIENT: DRAPERS LOCATION: Armstrong Estate Stage 32 Sketch indicating approx. compaction test locations	DATE: 22/09/16	JOB No.: 1861/235
	OPERATOR: VR	CHECKED: JC
	SCALE: NTS	FIGURE No.: -



GEOTECHNICAL LABORATORIES
 ACN 102 571 077
 Factory 1/8-10 Catalina Drive, Tullamarine Vic 3043
 PO Box 184 Keller VIC 3036
 PH: (03) 9335 1225 Fax: (03) 9335 1775

DAILY SUMMARY - FIELD DENSITY TESTS

REPORT NO.: # 1861/236

LOCATION: DRAPERS - Armstrong Estate Stage 32

DATE OF TESTS	TEST NUM.	TEST LOCATION	FIELD WET DENSITY (t/m ³)	FIELD MOISTURE CONTENT (%)	HILF DENSITY RATIO STANDARD (%)	STANDARD PCWD OR APCWD (t/m ³)	STANDARD OPTIMUM MOISTURE CONTENT (%)	PROBE DEPTH SETTING (mm)	VARIATION FROM OPTIMUM MOISTURE CONTENT (%)	MOISTURE RATIO (%)	WET +19mm (%)	WET +37.5mm (%)	APPROX. DEPTH BELOW FINISH LEVEL (mm)	
23/09/16	1	<i>Refer to #1861/237 for approx. test site locations.</i>	2.03	21.5	100.5	2.02	21.5	175	0.0	Drier	100.0	0	0	200
23/09/16	2		2.13	19.5	103.0	2.07	21.0	175	1.5	Drier	93.0	0	0	200
23/09/16	3		2.06	22.0	102.0	2.02	21.0	175	1.0	Wetter	104.5	0	0	200
-	-	-	-	-	-	-	-	-	-	-	-	-	-	-
-	-	-	-	-	-	-	-	-	-	-	-	-	-	-
-	-	-	-	-	-	-	-	-	-	-	-	-	-	-

NOTES: Onsite Clay Fill
 Test sites located - Geolab Procedure 4, Part 4.4.
 Start Time: 12:25pm Finish Time: 12:42pm
 Compaction specimens sampled after compaction.

A Hilf Rapid Compaction test was carried out on a sample taken from each Field Density location to obtain the Compaction Parameters tabulated on this Report.

Soil Layer thickness: 200mm


Hilf Density Ratio and Hilf Moisture Variation, Hilf Adjusted (APCWD) & Peak (PCWD) Converted Wet Density AS 1289 5.7.1

Field Density, Nuclear Gauge: AS 1289 5.8.1

Materials Sampled : AS 1289 1.2.1 Clause 6.4(b)


 Accredited for compliance with ISO/IEC 17025. The results of the tests, calibrations and/or measurements included in this document are traceable to Australian/National standards. This document may not be reproduced except in full.
 NATA Accredited Laboratory Number 14561


 SAM LOZA
 (Approved Signatory)
 Issue Date: 29/9/2016

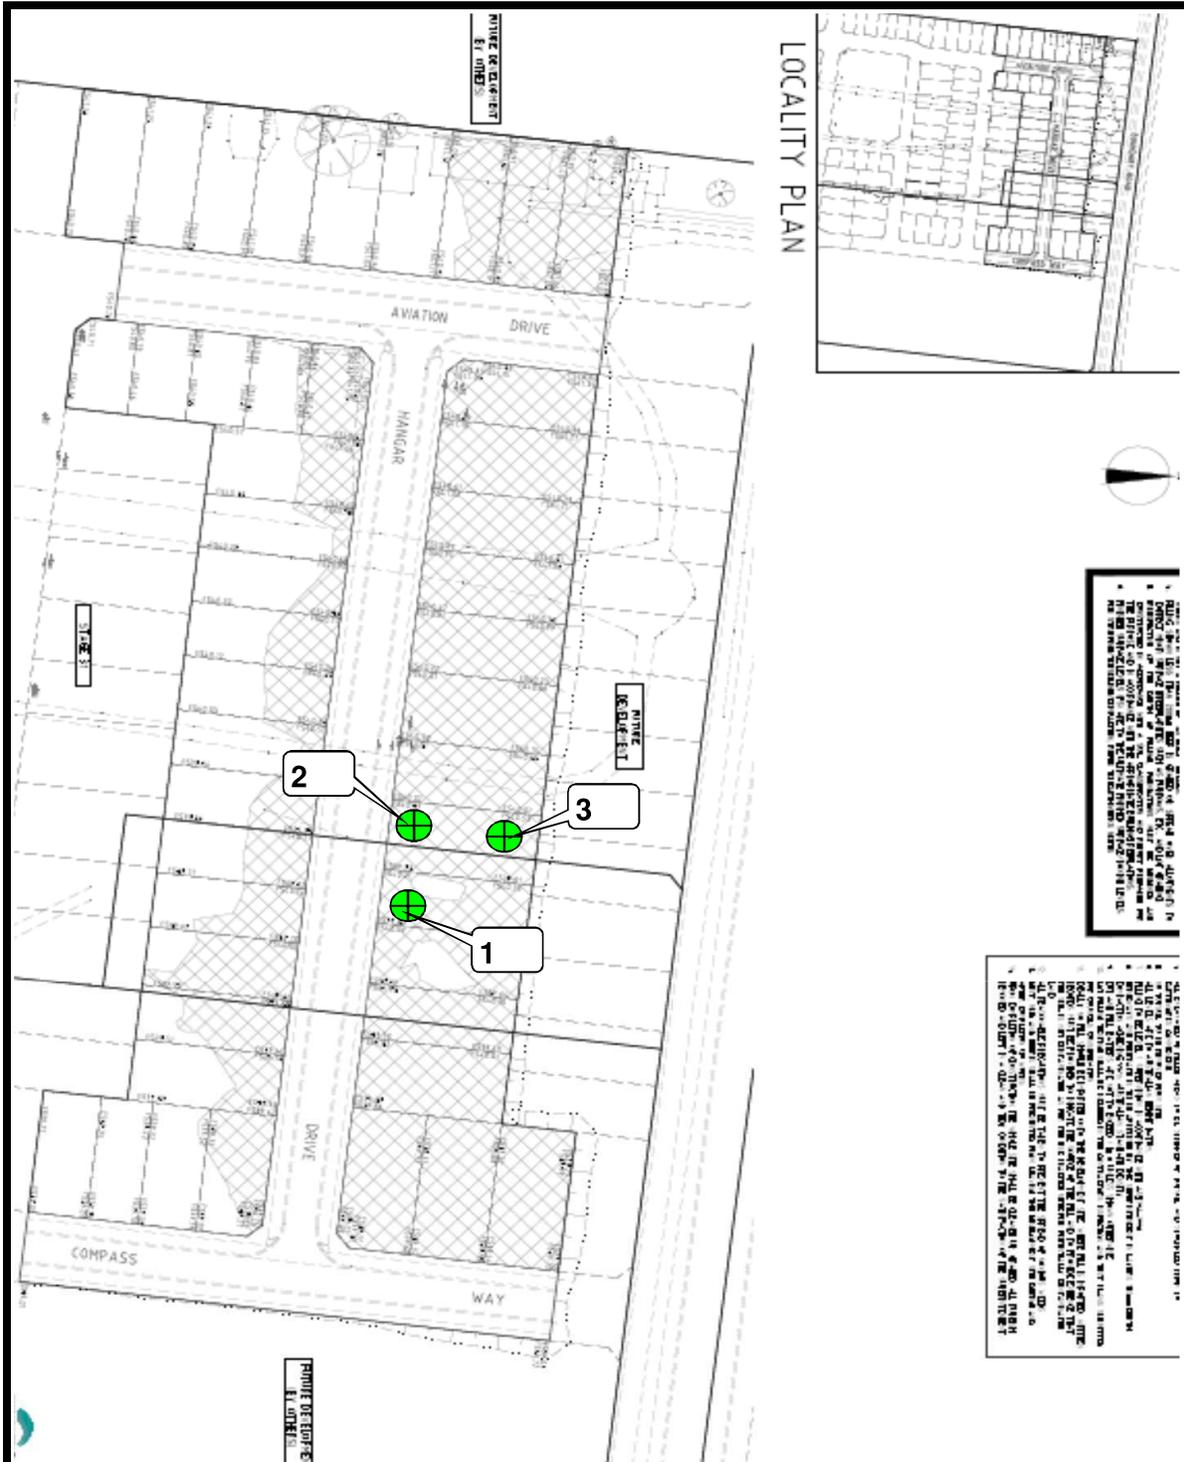

GEOTECHNICAL LABORATORIES
 ACN 102 571 077
 Factory 1/8-10 Catalina Drive, Tullamarine Vic 3043
 PO Box 184 Keilor VIC 3036
 PH: (03) 9335 1225 Fax: (03) 9335 1775

CLIENT: DRAPERS LOCATION: Armstrong Estate Stage 32 Sketch indicating approx. compaction test locations	DATE: 23/09/16	JOB No.: 1861/237
	OPERATOR: VR	CHECKED: JC
	SCALE: NTS	FIGURE No: -



GEOTECHNICAL LABORATORIES
 ACN 102 571 077
 Factory 1/8-10 Catalina Drive, Tullamarine Vic 3043
 PO Box 184 Keller VIC 3036
 PH: (03) 9335 1225 Fax: (03) 9335 1775

DAILY SUMMARY - FIELD DENSITY TESTS

REPORT NO.: # 1861/238

LOCATION: DRAPERS - Armstrong Estate Stage 32

DATE OF TESTS	TEST NUM.	TEST LOCATION	FIELD WET DENSITY (t/m ³)	FIELD MOISTURE CONTENT (%)	HILF DENSITY RATIO STANDARD (%)	STANDARD PCWD OR APCWD (t/m ³)	STANDARD OPTIMUM MOISTURE CONTENT (%)	PROBE DEPTH SETTING (mm)	VARIATION FROM OPTIMUM MOISTURE CONTENT (%)	MOISTURE RATIO (%)	WET +19mm (%)	WET +37.5mm (%)	APPROX. DEPTH BELOW FINISH LEVEL (mm)
26/09/16	1	<i>Refer to #1861/239 for approx. test site locations.</i>	1.99	26.0	99.5	2.01	26.0	175	0.0	100.0	0	0	200
26/09/16	2		1.96	25.5	98.0	2.00	25.5	175	0.5	101.0	0	0	200
26/09/16	3		1.96	21.5	97.0	2.02	22.0	175	0.5	98.0	0	0	200
-	-		-	-	-	-	-	-	-	-	-	-	-
-	-		-	-	-	-	-	-	-	-	-	-	-
-	-		-	-	-	-	-	-	-	-	-	-	-

NOTES: Onsite Clay Fill
 Test sites located - Geolab Procedure 4, Part 4.4.
 Start Time: 11:52am Finish Time: 12:08pm
 Compaaction specimens sampled after compaction.

A Hilf Rapid Compaction test was carried out on a sample taken from each Field Density location to obtain the Compaction Parameters tabulated on this Report.


Soil Layer thickness: 200mm

Hilf Density Ratio and Hilf Moisture Variation ,Hilf Adjusted (APCWD) & Peak (PCWD) Converted Wet Density AS 1289 5.7.1

Field Density, Nuclear Gauge: AS 1289 5.8.1

Materials Sampled : AS 1289 1.2.1 Clause 6.4(b)


 Accredited for compliance with ISO/IEC 17025. The results of the tests, calibrations and/or measurements included in this document are traceable to Australian/National standards. This document may not be reproduced except in full.
 NATA Accredited Laboratory Number 14561
 SAM LOZA (Approved Signatory)
 Issue Date: 3/10/2016

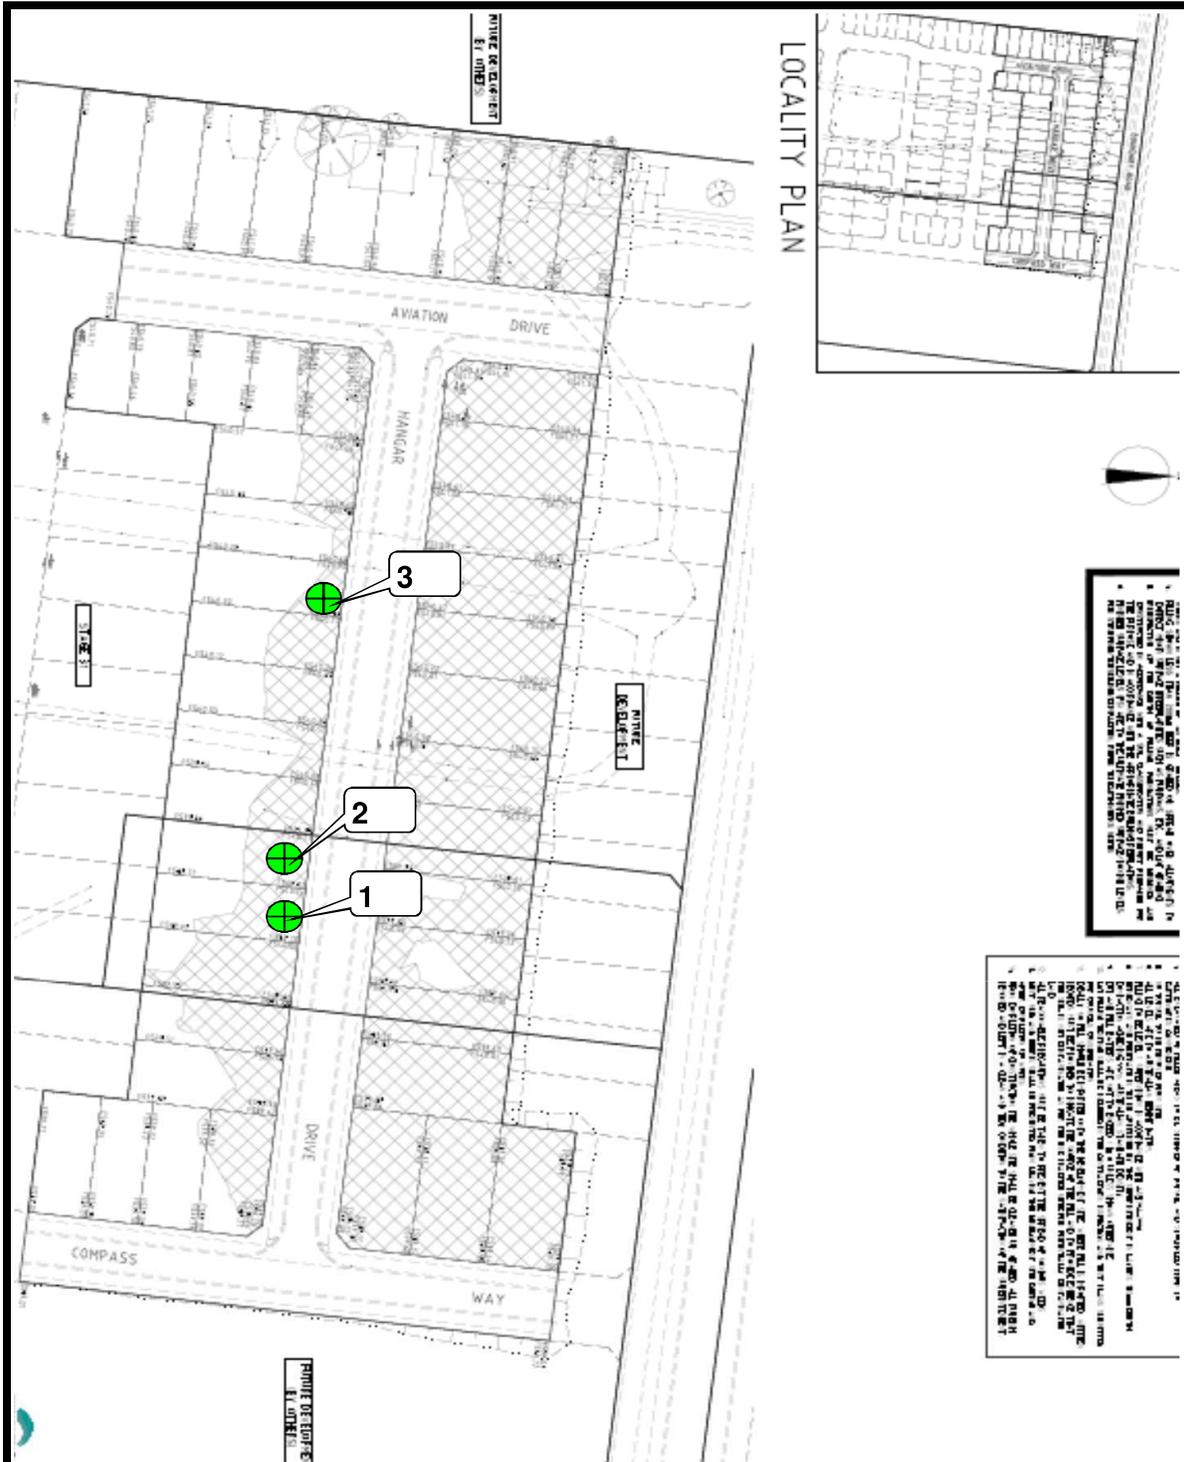

GEOTECHNICAL LABORATORIES
 ACN 102 571 077
 Factory 1/8-10 Catalina Drive, Tullamarine Vic 3043
 PO Box 184 Keilor VIC 3036
 PH: (03) 9335 1225 Fax: (03) 9335 1775

CLIENT: DRAPERS LOCATION: Armstrong Estate Stage 32 Sketch indicating approx. compaction test locations	DATE: 26/09/16	JOB No.: 1861/239
	OPERATOR: VR	CHECKED: JC
	SCALE: NTS	FIGURE No: -



GEOTECHNICAL LABORATORIES
 ACN 102 571 077
 Factory 1/8-10 Catalina Drive, Tullamarine Vic 3043
 PO Box 184 Keller VIC 3036
 PH: (03) 9335 1225 Fax: (03) 9335 1775

DAILY SUMMARY - FIELD DENSITY TESTS

REPORT NO.: # 1861/243
 LOCATION: DRAPERS - Armstrong Estate Stage 32


DATE OF TESTS	TEST NUM.	TEST LOCATION	FIELD WET DENSITY (t/m ³)	FIELD MOISTURE CONTENT (%)	HILF DENSITY RATIO STANDARD (%)	STANDARD PCWD OR APCWD (t/m ³)	STANDARD OPTIMUM MOISTURE CONTENT (%)	PROBE DEPTH SETTING (mm)	VARIATION FROM OPTIMUM MOISTURE CONTENT (%)	MOISTURE RATIO (%)	WET +19mm (%)	WET +37.5mm (%)	APPROX. DEPTH BELOW FINISH LEVEL (mm)
27/09/16	1	<i>Refer to #1861/244 for approx. test site locations.</i>	2.00	24.5	100.5	1.99	24.5	175	0.0 Wetter	101.0	0	0	0
27/09/16	2		1.95	25.0	99.5	1.95	25.5	175	0.5 Drier	99.0	0	0	0
27/09/16	3		2.01	22.0	102.5	1.97	23.0	175	1.0 Drier	96.0	0	0	0
-	-	-	-	-	-	-	-	-	-	-	-	-	-
-	-	-	-	-	-	-	-	-	-	-	-	-	-
-	-	-	-	-	-	-	-	-	-	-	-	-	-

NOTES: Onsite Clay Fill
 Test sites located - Geolab Procedure 4, Part 4.4.
 Start Time: 9:00am Finish Time: 9:24am
 Compaaction specimens sampled after compaction.

A Hilf Rapid Compaction test was carried out on a sample taken from each Field Density location to obtain the Compaction Parameters tabulated on this Report.
 Soil Layer thickness: 200mm
 Hilf Density Ratio and Hilf Moisture Variation, Hilf Adjusted (APCWD) & Peak (PCWD) Converted Wet Density AS 1289 5.7.1
 Field Density, Nuclear Gauge: AS 1289 5.8.1
 Materials Sampled : AS 1289 1.2.1 Clause 6.4(b)

Moisture Content: AS 1289 2.1.1
 Compaction Test: AS 1289 5.7.1

SAM LOZA
 (Approved Signatory)
 Issue Date: 5/10/2016

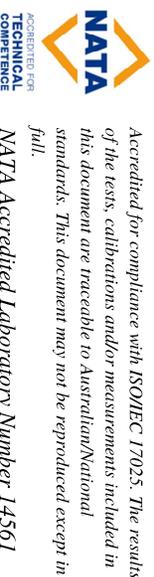



GEOTECHNICAL LABORATORIES
 ACN 102 571 077
 Factory 1/8-10 Catalina Drive, Tullamarine Vic 3043
 PO Box 184 Keller VIC 3036
 PH: (03) 9335 1225 Fax: (03) 9335 1775

DAILY SUMMARY - FIELD DENSITY TESTS

REPORT NO.: # 1861/245
 LOCATION: DRAPERS - Armstrong Estate Stage 32

DATE OF TESTS	TEST NUM.	TEST LOCATION	FIELD WET DENSITY (t/m ³)	FIELD MOISTURE CONTENT (%)	HILF DENSITY RATIO STANDARD (%)	STANDARD PCWD OR APCWD (t/m ³)	STANDARD OPTIMUM MOISTURE CONTENT (%)	PROBE DEPTH SETTING (mm)	VARIATION FROM OPTIMUM MOISTURE CONTENT (%)	MOISTURE RATIO (%)	WET +19mm (%)	WET +37.5mm (%)	APPROX. DEPTH BELOW FINISH LEVEL (mm)	
29/09/16	1	<i>Refer to #1861/246 for approx. test site locations.</i>	1.94	24.5	101.5	1.92	26.0	175	1.0	Drier	95.0	0	0	0
29/09/16	2		1.99	24.0	102.5	1.94	25.0	175	0.5	Drier	97.0	0	0	0
29/09/16	3		1.95	26.5	101.0	1.92	29.5	175	3.0	Drier	90.5	0	0	0
-	-	-	-	-	-	-	-	-	-	-	-	-	-	-
-	-	-	-	-	-	-	-	-	-	-	-	-	-	-
-	-	-	-	-	-	-	-	-	-	-	-	-	-	-

NOTES: Onsite Clay Fill
 Test sites located - Geolab Procedure 4, Part 4.4.
 Start Time: 11:20am Finish Time: 11:34am
 Compaction specimens sampled after compaction.

A Hilf Rapid Compaction test was carried out on a sample taken from each Field Density location to obtain the Compaction Parameters tabulated on this Report.
 Soil Layer thickness: 200mm
 Hilf Density Ratio and Hilf Moisture Variation, Hilf Adjusted (APCWD) & Peak (PCWD) Converted Wet Density AS 1289 5.7.1
 Moisture Content: AS 1289 2.1.1
 Compaction Test: AS 1289 5.7.1
 Field Density, Nuclear Gauge: AS 1289 5.8.1
 Materials Sampled : AS 1289 1.2.1 Clause 6.4(b)


 SAM LOZA
 (Approved Signatory)
 Issue Date: 7/10/2016



Accredited for compliance with ISO/IEC 17025. The results of the tests, calibrations and/or measurements included in this document are traceable to Australian/National standards. This document may not be reproduced except in full.
 NATA Accredited Laboratory Number 14561



GEOTECHNICAL LABORATORIES

GEOTECHNICAL LABORATORIES
 ACN 102 571 077
 Factory 1/8-10 Catalina Drive, Tullamarine Vic 3043
 PO Box 184 Keilor VIC 3036
 PH: (03) 9335 1225 Fax: (03) 9335 1775

CLIENT: DRAPERS LOCATION: Armstrong Estate Stage 32 Sketch indicating approx. compaction test locations	DATE: 29/09/16	JOB No.: 1861/246
	OPERATOR: VR	CHECKED: JC
	SCALE: NTS	FIGURE No: -



GEOTECHNICAL LABORATORIES
 ACN 102 571 077
 Factory 1/8-10 Catalina Drive, Tullamarine Vic 3043
 PO Box 184 Keller VIC 3036
 PH: (03) 9335 1225 Fax: (03) 9335 1775

DAILY SUMMARY - FIELD DENSITY TESTS

REPORT NO.: # 1861/260
 LOCATION: DRAPERS - Armstrong Estate Stage 32

DATE OF TESTS	TEST NUM.	TEST LOCATION	FIELD WET DENSITY (t/m ³)	FIELD MOISTURE CONTENT (%)	HILF DENSITY RATIO STANDARD (%)	STANDARD PCWD OR APCWD (t/m ³)	STANDARD OPTIMUM MOISTURE CONTENT (%)	PROBE DEPTH SETTING (mm)	VARIATION FROM OPTIMUM MOISTURE CONTENT (%)	MOISTURE RATIO (%)	WET +19mm (%)	WET +37.5mm (%)	APPROX. DEPTH BELOW FINISH LEVEL (mm)	
23/02/17	1	Refer to #1861/261 for approx. test site locations.	2.05	21.0	100.5	2.04	21.0	175	0.0	Drier	99.0	0	0	0
23/02/17	2		2.05	23.5	103.5	1.98	24.0	175	0.5	Drier	98.0	0	0	0
23/02/17	3		1.93	24.5	99.5	1.94	25.5	175	1.0	Drier	96.0	0	0	0
-	-	-	-	-	-	-	-	-	-	-	-	-	-	-
-	-	-	-	-	-	-	-	-	-	-	-	-	-	-
-	-	-	-	-	-	-	-	-	-	-	-	-	-	-

NOTES: Onsite Clay Fill
 Test sites located - Geolab Procedure 4, Part 4.4.
 Start Time: 12:28pm Finish Time: 12:52pm
 Compaction specimens sampled after compaction.

A Hilf Rapid Compaction test was carried out on a sample taken from each Field Density location to obtain the Compaction Parameters tabulated on this Report.
 Soil Layer thickness: 200mm
 Moisture Content: AS 1289 2.1.1
 Compaction Test: AS 1289 5.7.1
 Hilf Density Ratio and Hilf Moisture Variation, Hilf Adjusted (APCWD) & Peak (PCWD) Converted Wet Density AS 1289 5.7.1
 Field Density, Nuclear Gauge: AS 1289 5.8.1
 Materials Sampled : AS 1289 1.2.1 Clause 6.4(b)
 MICK CROWE (Approved Signatory)
 Issue Date: 20/3/2017



Accredited for compliance with ISO/IEC 17025. The results of the tests, calibrations and/or measurements included in this document are traceable to Australian/National standards. This document may not be reproduced except in full.
 NATA Accredited Laboratory Number 14561



**GEOTECHNICAL
LABORATORIES**

GEOTECHNICAL LABORATORIES
 ACN 102 571 077
 Factory 1/8-10 Catalina Drive, Tullamarine Vic 3043
 PO Box 184 Keilor VIC 3036
 PH: (03) 9335 1225 Fax: (03) 9335 1775

CLIENT: DRAPERS

DATE: 23/02/17

JOB No.: 1861/261

LOCATION: Armstrong Estate Stage 32

OPERATOR: JC

CHECKED: CA

Sketch indicating approx. compaction test locations

SCALE: NTS

FIGURE No: -



GEOTECHNICAL LABORATORIES
 ACN 102 571 077
 Factory 1/8-10 Catalina Drive, Tullamarine Vic 3043
 PO Box 184 Keller VIC 3036
 PH: (03) 9335 1225 Fax: (03) 9335 1775

DAILY SUMMARY - FIELD DENSITY TESTS


REPORT NO.: # 1861/262
 LOCATION: DRAPERS - Armstrong Estate Stage 32


DATE OF TESTS	TEST NUM.	TEST LOCATION	FIELD WET DENSITY (t/m ³)	FIELD MOISTURE CONTENT (%)	HILF DENSITY RATIO STANDARD (%)	STANDARD PCWD OR APCWD (t/m ³)	STANDARD OPTIMUM MOISTURE CONTENT (%)	PROBE DEPTH SETTING (mm)	VARIATION FROM OPTIMUM MOISTURE CONTENT (%)	MOISTURE RATIO (%)	WET +19mm (%)	WET +37.5mm (%)	APPROX. DEPTH BELOW FINISH LEVEL (mm)	
27/02/17	1	<i>Refer to #1861/263 for approx. test site locations.</i>	1.91	16.5	102.0	1.87	19.5	175	3.5	Drier	83.5	0	0	0
27/02/17	2		1.89	16.5	102.0	1.85	20.0	175	3.0	Drier	84.5	0	0	0
27/02/17	3		2.04	16.5	103.5	1.97	19.5	175	3.0	Drier	84.5	0	0	0
-	-	-	-	-	-	-	-	-	-	-	-	-	-	-
-	-	-	-	-	-	-	-	-	-	-	-	-	-	-
-	-	-	-	-	-	-	-	-	-	-	-	-	-	-

NOTES: Onsite Clay Fill
 Test sites located - Geolab Procedure 4, Part 4.4.
 Start Time: 8:45am Finish Time: 9:10am
 Compaction specimens sampled after compaction.

A Hilf Rapid Compaction test was carried out on a sample taken from each Field Density location to obtain the Compaction Parameters tabulated on this Report.
 Soil Layer thickness: 200mm
 Hilf Density Ratio and Hilf Moisture Variation, Hilf Adjusted (APCWD) & Peak (PCWD) Converted Wet Density AS 1289 5.7.1
 Moisture Content: AS 1289 2.1.1
 Compaction Test: AS 1289 5.7.1
 Field Density, Nuclear Gauge: AS 1289 5.8.1
 Materials Sampled : AS 1289 1.2.1 Clause 6.4(b)

MICK CROWE
 (Approved Signatory)
 Issue Date: 20/3/2017

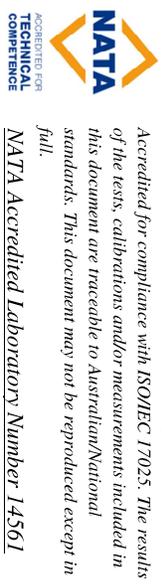

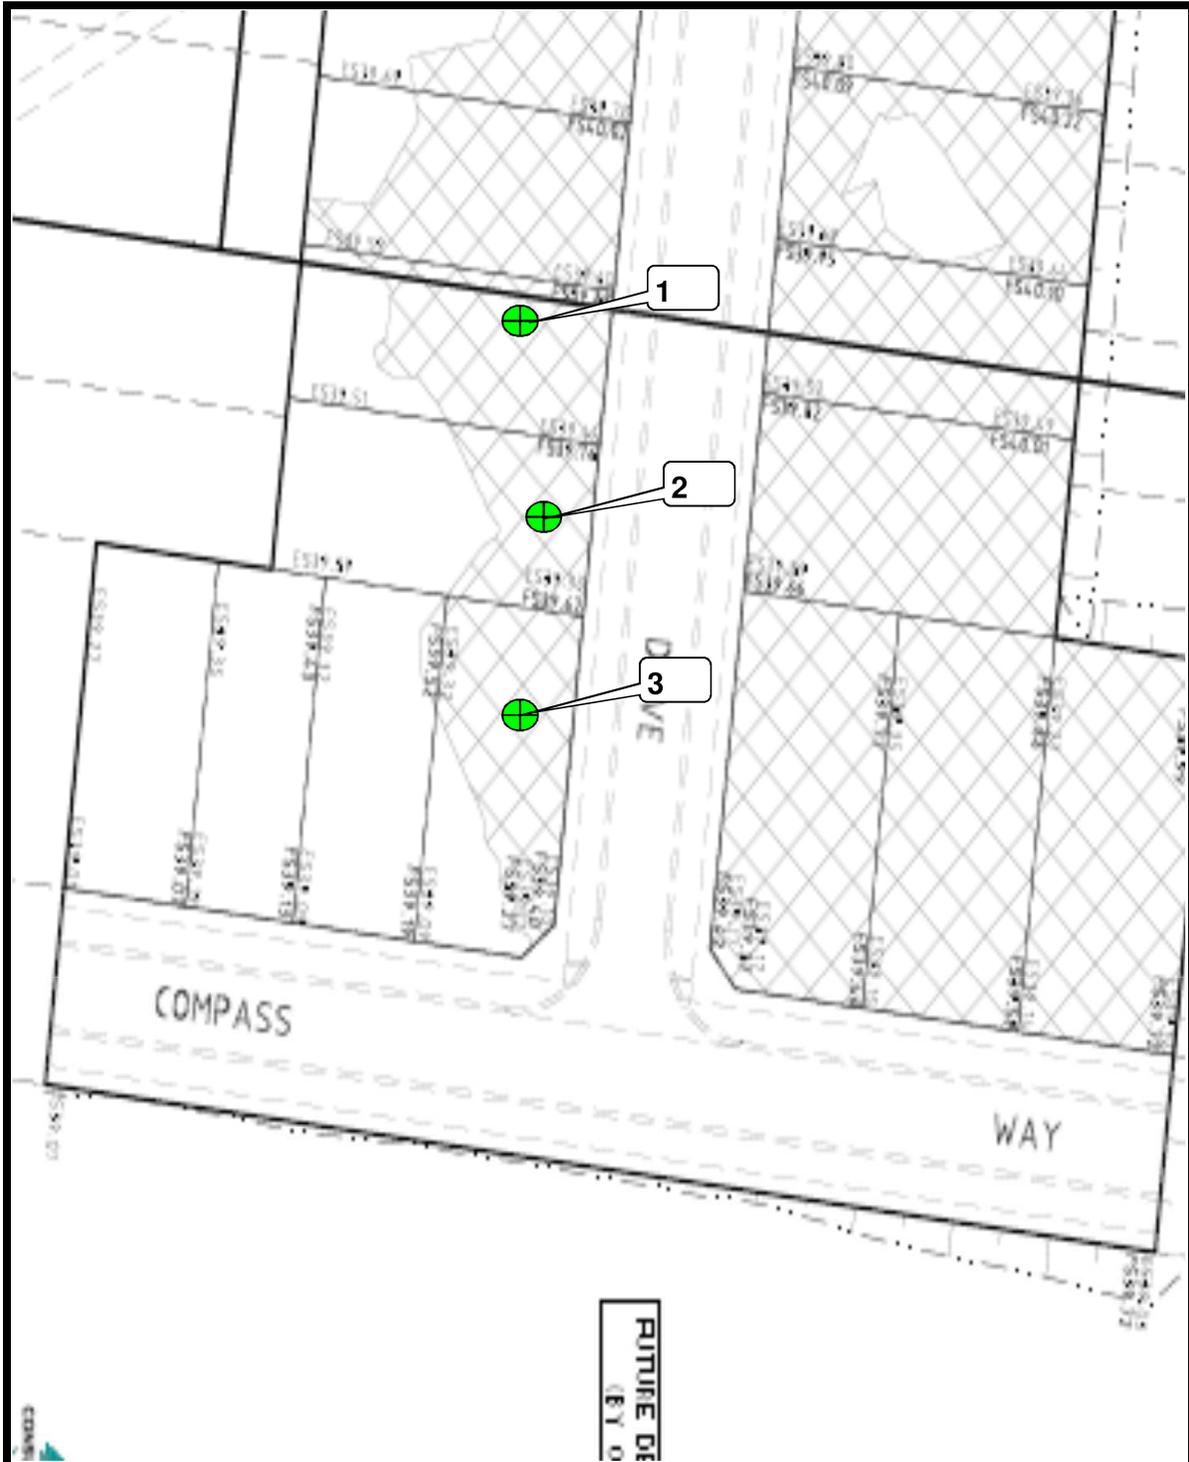

**GEOTECHNICAL
LABORATORIES**

GEOTECHNICAL LABORATORIES
 ACN 102 571 077
 Factory 1/8-10 Catalina Drive, Tullamarine Vic 3043
 PO Box 184 Keilor VIC 3036
 PH: (03) 9335 1225 Fax: (03) 9335 1775

CLIENT: DRAPERS

LOCATION: Armstrong Estate Stage 32

Sketch indicating approx. compaction test locations

DATE: 27/02/17

OPERATOR: JC

SCALE: NTS

JOB No.: 1861/263

CHECKED: BE

FIGURE No: -



GEOTECHNICAL LABORATORIES
 ACN 102 571 077
 Factory 1/8-10 Catalina Drive, Tullamarine Vic 3043
 PO Box 184 Keller VIC 3036
 PH: (03) 9335 1225 Fax: (03) 9335 1775

DAILY SUMMARY - FIELD DENSITY TESTS

REPORT NO.: # 1861/264

LOCATION: DRAPERS - Armstrong Estate Stage 32

DATE OF TESTS	TEST NUM.	TEST LOCATION	FIELD WET DENSITY (t/m ³)	FIELD MOISTURE CONTENT (%)	HILF DENSITY RATIO STANDARD (%)	STANDARD PCWD OR APCWD (t/m ³)	STANDARD OPTIMUM MOISTURE CONTENT (%)	PROBE DEPTH SETTING (mm)	VARIATION FROM OPTIMUM MOISTURE CONTENT (%)	MOISTURE RATIO (%)	WET +19mm (%)	WET +37.5mm (%)	APPROX. DEPTH BELOW FINISH LEVEL (mm)	
28/02/17	1	<i>Refer to #1861/265 for approx. test site locations.</i>	1.90	23.5	102.5	1.85	27.0	175	3.5	Drier	87.0	0	0	0
28/02/17	2		1.92	25.0	101.5	1.89	28.0	175	3.0	Drier	88.5	0	0	0
28/02/17	3		1.90	25.5	100.5	1.89	29.0	175	3.5	Drier	88.5	0	0	0
-	-	-	-	-	-	-	-	-	-	-	-	-	-	-
-	-	-	-	-	-	-	-	-	-	-	-	-	-	-
-	-	-	-	-	-	-	-	-	-	-	-	-	-	-

NOTES: Onsite Clay Fill

Test sites located - Geolab Procedure 4, Part 4.4.

Compaction specimens sampled after compaction.

Start Time: 12:10pm Finish Time: 12:32pm

A Hilf Rapid Compaction test was carried out on a sample taken from each Field Density location to obtain the Compaction Parameters tabulated on this Report.

Soil Layer thickness: 200mm

Hilf Density Ratio and Hilf Moisture Variation, Hilf Adjusted (APCWD) & Peak (PCWD) Converted Wet Density AS 1289 5.7.1

Field Density, Nuclear Gauge: AS 1289 5.8.1

Materials Sampled : AS 1289 1.2.1 Clause 6.4(b)


 Accredited for compliance with ISO/IEC 17025. The results of the tests, calibrations and/or measurements included in this document are traceable to Australian/National standards. This document may not be reproduced except in full.
 NATA Accredited Laboratory Number 14561

MICK CROWE
 (Approved Signatory)
 Issue Date: 20/3/2017



LOCALITY PLAN



**GEOTECHNICAL
LABORATORIES**

GEOTECHNICAL LABORATORIES
ACN 102 571 077
Factory 1/8-10 Catalina Drive, Tullamarine Vic 3043
PO Box 184 Keilor VIC 3036
PH: (03) 9335 1225 Fax: (03) 9335 1775

CLIENT: DRAPERS

LOCATION: Armstrong Estate Stage 32

Sketch indicating approx. compaction test locations

DATE: 28/02/17

OPERATOR: JC

SCALE: NTS

JOB No.: 1861/265

CHECKED: CA

FIGURE No: -